

ADDENDUM NO. 2

May 27, 2016

Marion Campus Sidewalk Replacement

Ivy Tech Community College
261 Commerce Drive
Marion, Indiana 46953

Prepared by:

GEA Architects, LLC

108 E. Jackson Street
Muncie, Indiana 47305-2806
765.289.9155
pkiser@geaarchitects.com


TO: ALL INTERESTED BIDDERS OF RECORD

This Addendum No. 1 forms part of the Contract Documents and modifies the original Bidding Documents dated May 19, 2016. Failure to acknowledge receipt of this addendum on the Supplement to Bid Form may subject Bidder to disqualification.

CHANGES TO THE DRAWING

Sheet A1.0

1. Move Keynote 6 to sidewalk boundary as shown in the partial site plan below - see revision cloud 2

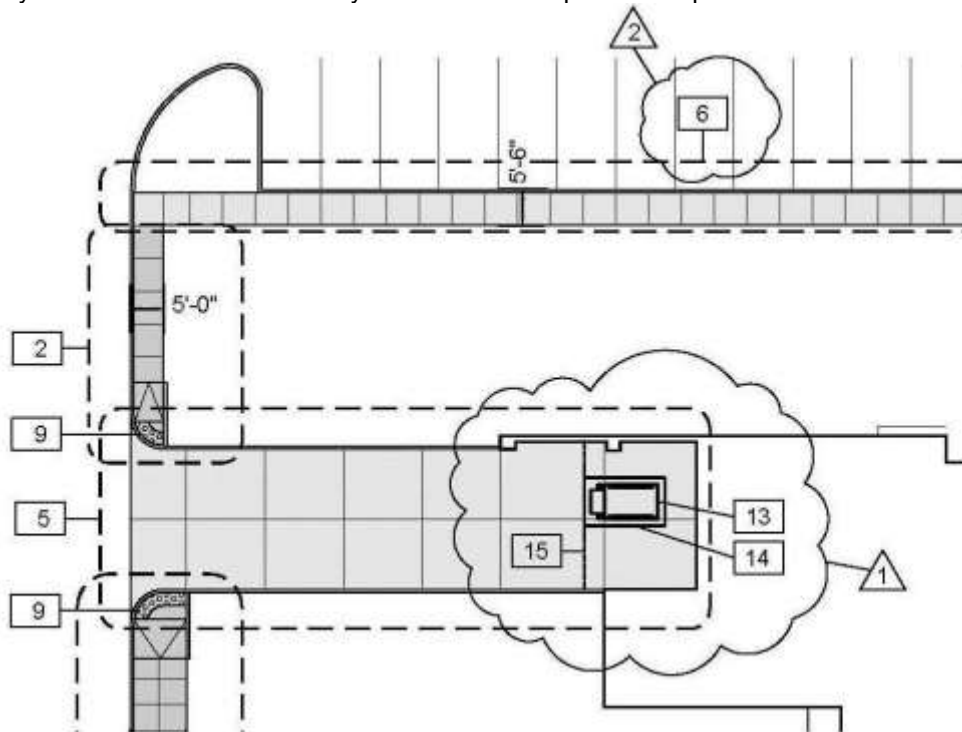

CLARIFICATIONS / GENERAL INFORMATION

1. The Owner has waived the mandatory status of pre-bid conference.

END OF ADDENDUM NUMBER TWO