

ADDENDUM NO. 1

June 3, 2016

Site Concrete Replacement Improvements Cowan Road Campus

Ivy Tech Community College
4301 South Cowan Road
Muncie, Indiana 47302

Prepared by:

GEA Architects, LLC

108 E. Jackson Street
Muncie, Indiana 47305-2806
765.289.9155
765.289.9214 fax
pkiser@geaarchitects.com

TO: ALL INTERESTED BIDDERS OF RECORD

This Addendum No. 1 forms part of the Contract Documents and modifies the original Bidding Documents dated May 18, 2016. Failure to acknowledge receipt of this addendum on the Supplement to Bid Form may subject Bidder to disqualification.

CHANGES TO THE DRAWING

Sheet A1.1

1. Sheet A1.1 is amended. The south most limit of the base bid area has been slightly adjusted (see attached).

CLARIFICATIONS / GENERAL INFORMATION


1. The Owner has waived the mandatory status of pre-bid conference. The following is a list of attendees who were at the pre-bid conference on Thursday, June 2, 2016:

<i>Name</i>	<i>Company</i>	<i>Email address</i>	<i>Phone #</i>
Stephanie Barber	Barber Contracting	Rodney_barber@frontier.com	765-744-0954
Marc Bibbs	Pridemark	mbibbs@pridemarkconstruction.com	765-748-7779
Tim Case	J.G. Case Const.	tim@jgcase.com	765-282-4953
Skyler Case	J.G. Case Const.	Skyler@jgcase.com	765-730-5450
Andy Ellis	GEA Architects	aellis@geaarchitects.com	765-289-9155

ATTACHMENTS: Revised base bid drawing.

END OF ADDENDUM NUMBER ONE

BASE BID IS
EXPANDED TO
INCLUDE THIS AREA

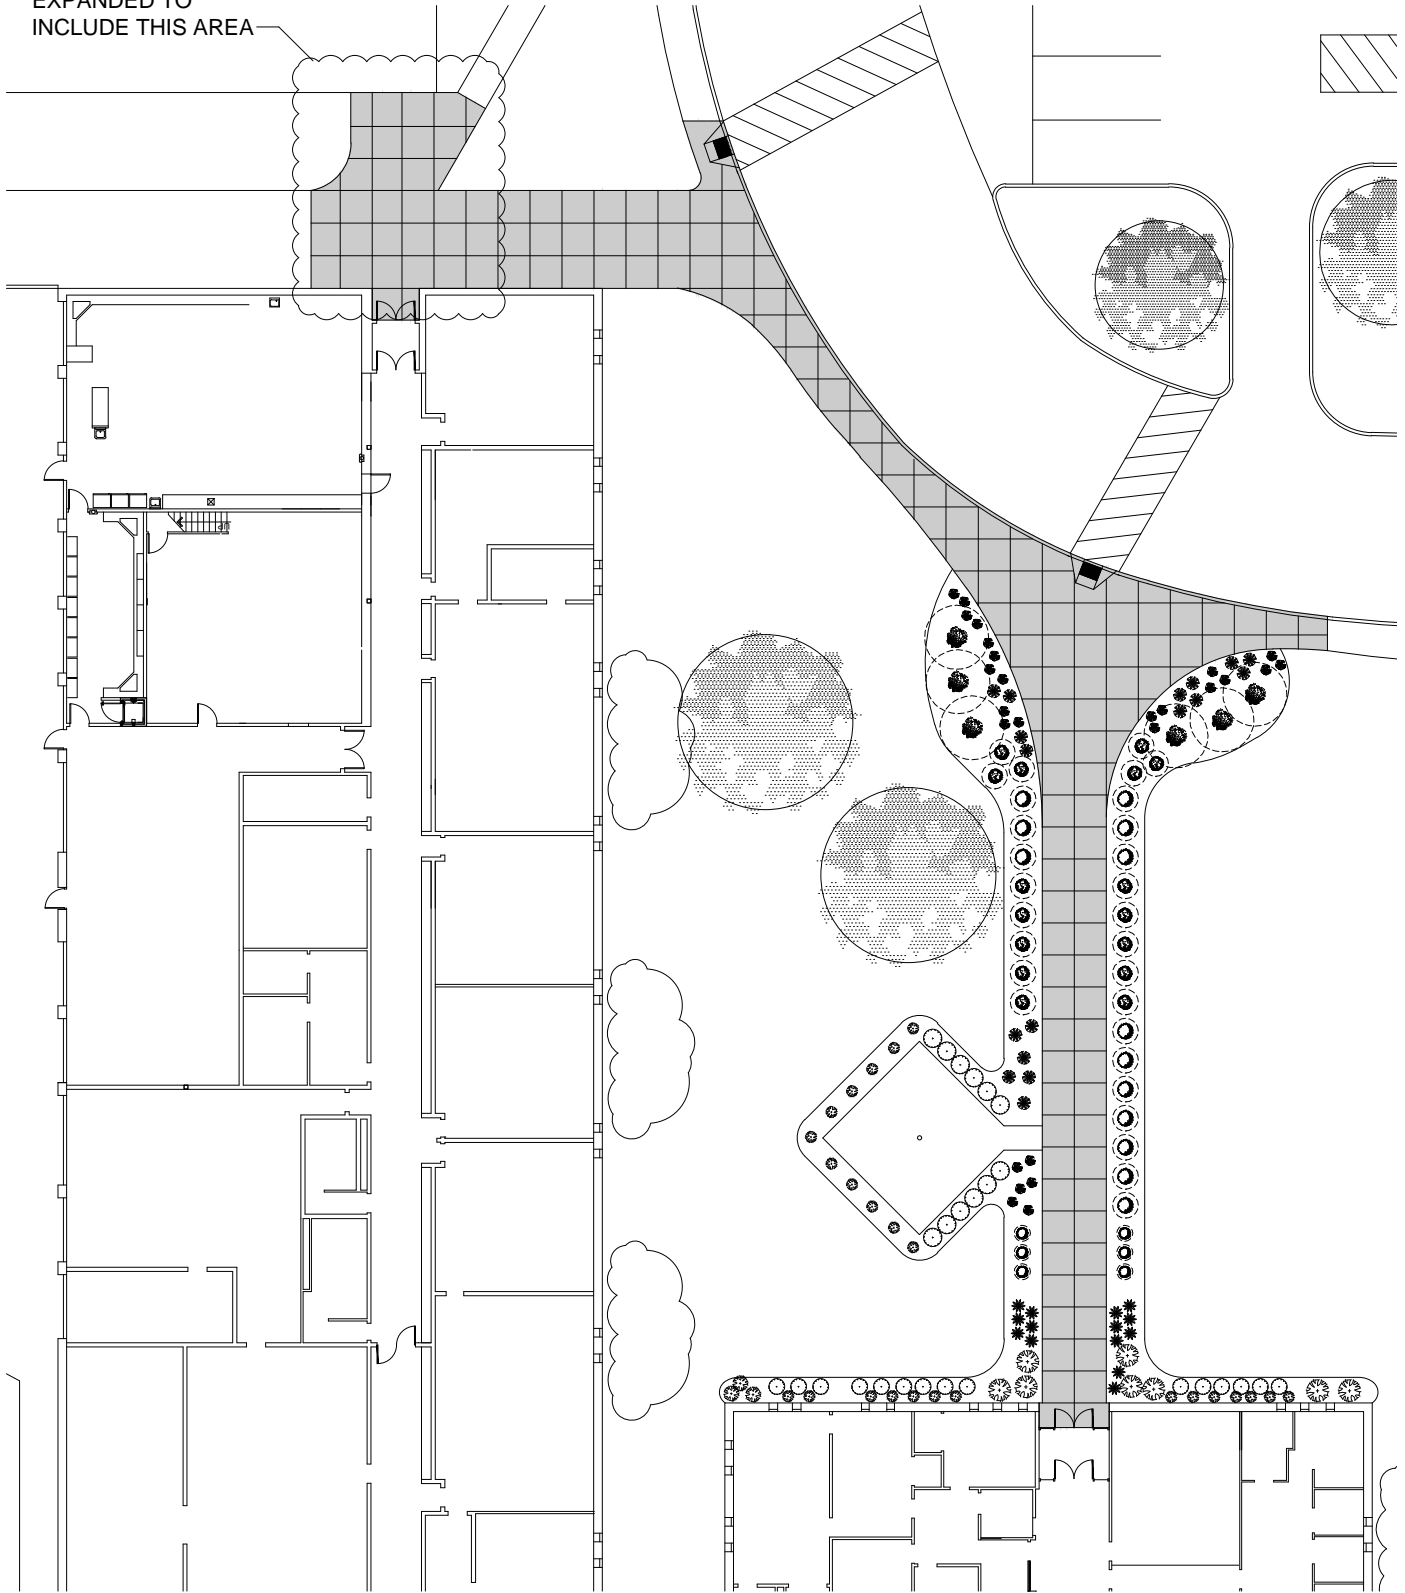

Base Bid

Scale: 1" = 30'-0"

