



ADDENUM AD 001

DATE 23-Jan-24

CLIENT NAME YWCA Northeast Indiana

PROJECT The Lofts

PROJECT NO. 230495

This Addendum is an addition to the Contract Documents for the above-referenced project issued on **January 11, 2024** and is provided in accordance with the Instructions to Bidders. Please acknowledge receipt of this document by inserting its number in the space provided in the bid form.

LOCATION	DESCRIPTION	ATTACHMENT
Sheet A2.02, floor plan notes	CHANGE: Note 6 to read "SEMI-RECESSED FIRE EXTINGUISHER CABINET, LOCATE NEW CABINET IN SAME LOCATION AS THE REMOVED CABINET"	None
Sheet A4.20, EX-C	CHANGE: Remove the notes for the PTAC units located in the curtainwall assembly. The PTAC units have been removed from the curtainwall assembly entirely and these areas will be infilled with GL-3 as shown.	None
Email bidding question	CLARIFICATION: WT1 to extend up full height of walls.	None
Email bidding question	CLARIFICATION: All broadloom carpet that is on the stairs needs to have the edges binded.	None
Email bidding question	CLARIFICATION: For the top of stairs condition where CPT meets LVT, nosing shall be used. Mannington Commercial Step Nosing 580; Color: 701 Black	None
Email bidding question	CLARIFICATION: At the transition between PCT and LVT, use Schluter VINPRO-S in anodized aluminum.	None
Email bidding question	CLARIFICATION: The transition between LVT and CPT is to be Mannington Commercial Fusion Transition Strip; Color: 701 Black	None
Email bidding question	CLARIFICATION: WOC2 to be unbacked and ordered as a rolled good and shall be applied to both tread and riser.	None
Specification 004171 Supplemental Bid Form	On page 1 of the Supplemental Bid Form, contractor is to write in their construction duration in the dark outlined box underneath BASE BID AMOUNT: \$ (Written)	None
SCO bidding questions	See the SCO addendum form with all changes and clarifications noted as they relate to MEP questions that were brought up during bidding	SCO Addendum No. 1

Submitted by:
BONA VITA ARCHITECTURE, INC.



A handwritten signature in black ink, appearing to read "THOMAS A. SALZER", written over the bottom portion of the professional seal.

Thomas A. Salzer, AIA
Founder/Architect

attachments:
as stated in column above

copies:
Contractor for distribution to all plan holders
MEP Engineer
Structural Engineer

Addendum

6534 Constitution Drive
Fort Wayne, IN 46804
(260) 436-9213
fax (260) 432-5481

ADDENDUM NO.	Addendum No. 1
DATE:	01/22/2024
PROJECT:	YWCA Northeast Indiana, Inc. YWCA The Lofts
COMMISSION NO.	SCO Engineering, LLC – 232722

The Contractor shall incorporate, into the Contract Documents and into his bid, the following changes and/or clarifications to the Drawings, Specifications and Scope of Work.

SPECIFICATIONS

Section 220523.12 – BALL VALVES FOR PLUMBING PIPING

1. Revise paragraph 2.1., I., 3., as follows:

“3. Ball Valves: Shall have extended operating handle of non-thermal-conductive materials, protective sleeve that allows operation of valve without breaking the vapor seal or disturbing insulation, and memory stops that are fully adjustable after insulation is applied, Nibco Nib-seal, or equal, handle extensions.

PLUMBING

Drawing P6.01

1. Delete sheet P6.01 in its entirety and insert the new sheet P6.01 dated 01-23-24 into the construction documents. Changes include, but not limited to:
 - a. Revise the Domestic Expansion Tank Schedule. Contractor shall provide and install a floor mounted expansion tank like Bell & Gossett model #ST-70VG as scheduled.

MECHANICAL

Drawing M2.01

1. Delete sheet M2.01 in its entirety and insert the new sheet M2.01 dated 01-23-24 into the construction documents. Changes include, but not limited to:
 - a. Contractor shall provide and install a horizontal-ducted mini-split unit to be installed in Stair 201 / Corridor 202 as shown on the attached new drawing. Contractor shall provide and install new exposed ductwork to be routed from new AC-5.1 and route for connection to the diffusers and grilles as shown, all diffusers and grilles are to be hard connected to

the ductwork. All exposed ductwork shall be double wall and internally lined with 1"-thick insulation and perforated liner. Contractor shall provide and install now ¾"Ø condensate drain piping that is to be routed up above the ceiling and shall tie into the condensate drain piping that is to be routed down within the wall from AC-1.1 located in Bedroom 204E.

Drawing M2.02

1. Delete sheet M2.02 in its entirety and insert the new sheet M2.02 dated 01-23-24 into the construction documents. Changes include, but not limited to:
 - a. Provide and install new roof curb and roof mounted air-cooled condensing unit as shown.

Drawing M6.01

1. Delete sheet M6.01 in its entirety and insert the new sheet M6.01 dated 01-23-24 into the construction documents. Changes include, but not limited to:
 - a. Revise the Mini-Split Air Conditioning/Heat Pump Unit Schedule. Contractor shall provide and install a horizontal-ducted mini-split unit to be installed in Stair 201 / Corridor 202 as scheduled.
 - b. Add the Diffuser Schedule to the sheet as shown.

ELECTRICAL


Drawing E3.01

1. Delete sheet E3.01 in its entirety and insert the new sheet E3.01 dated 01-23-24 into the construction documents; for power revisions for mechanical equipment, by others.

Drawing E6.01


1. Delete sheet E6.01 in its entirety and insert the new sheet E6.01 dated 01-23-24 into the construction documents; for revisions to panel schedules.

2/26/24 02:02:20 YWCA The Lofts
10/26/2023 2:28:01 PM
C:\Users\jha\Documents\2722 Main Center\02_Itm\@bon-ic.com\vt
Project Status

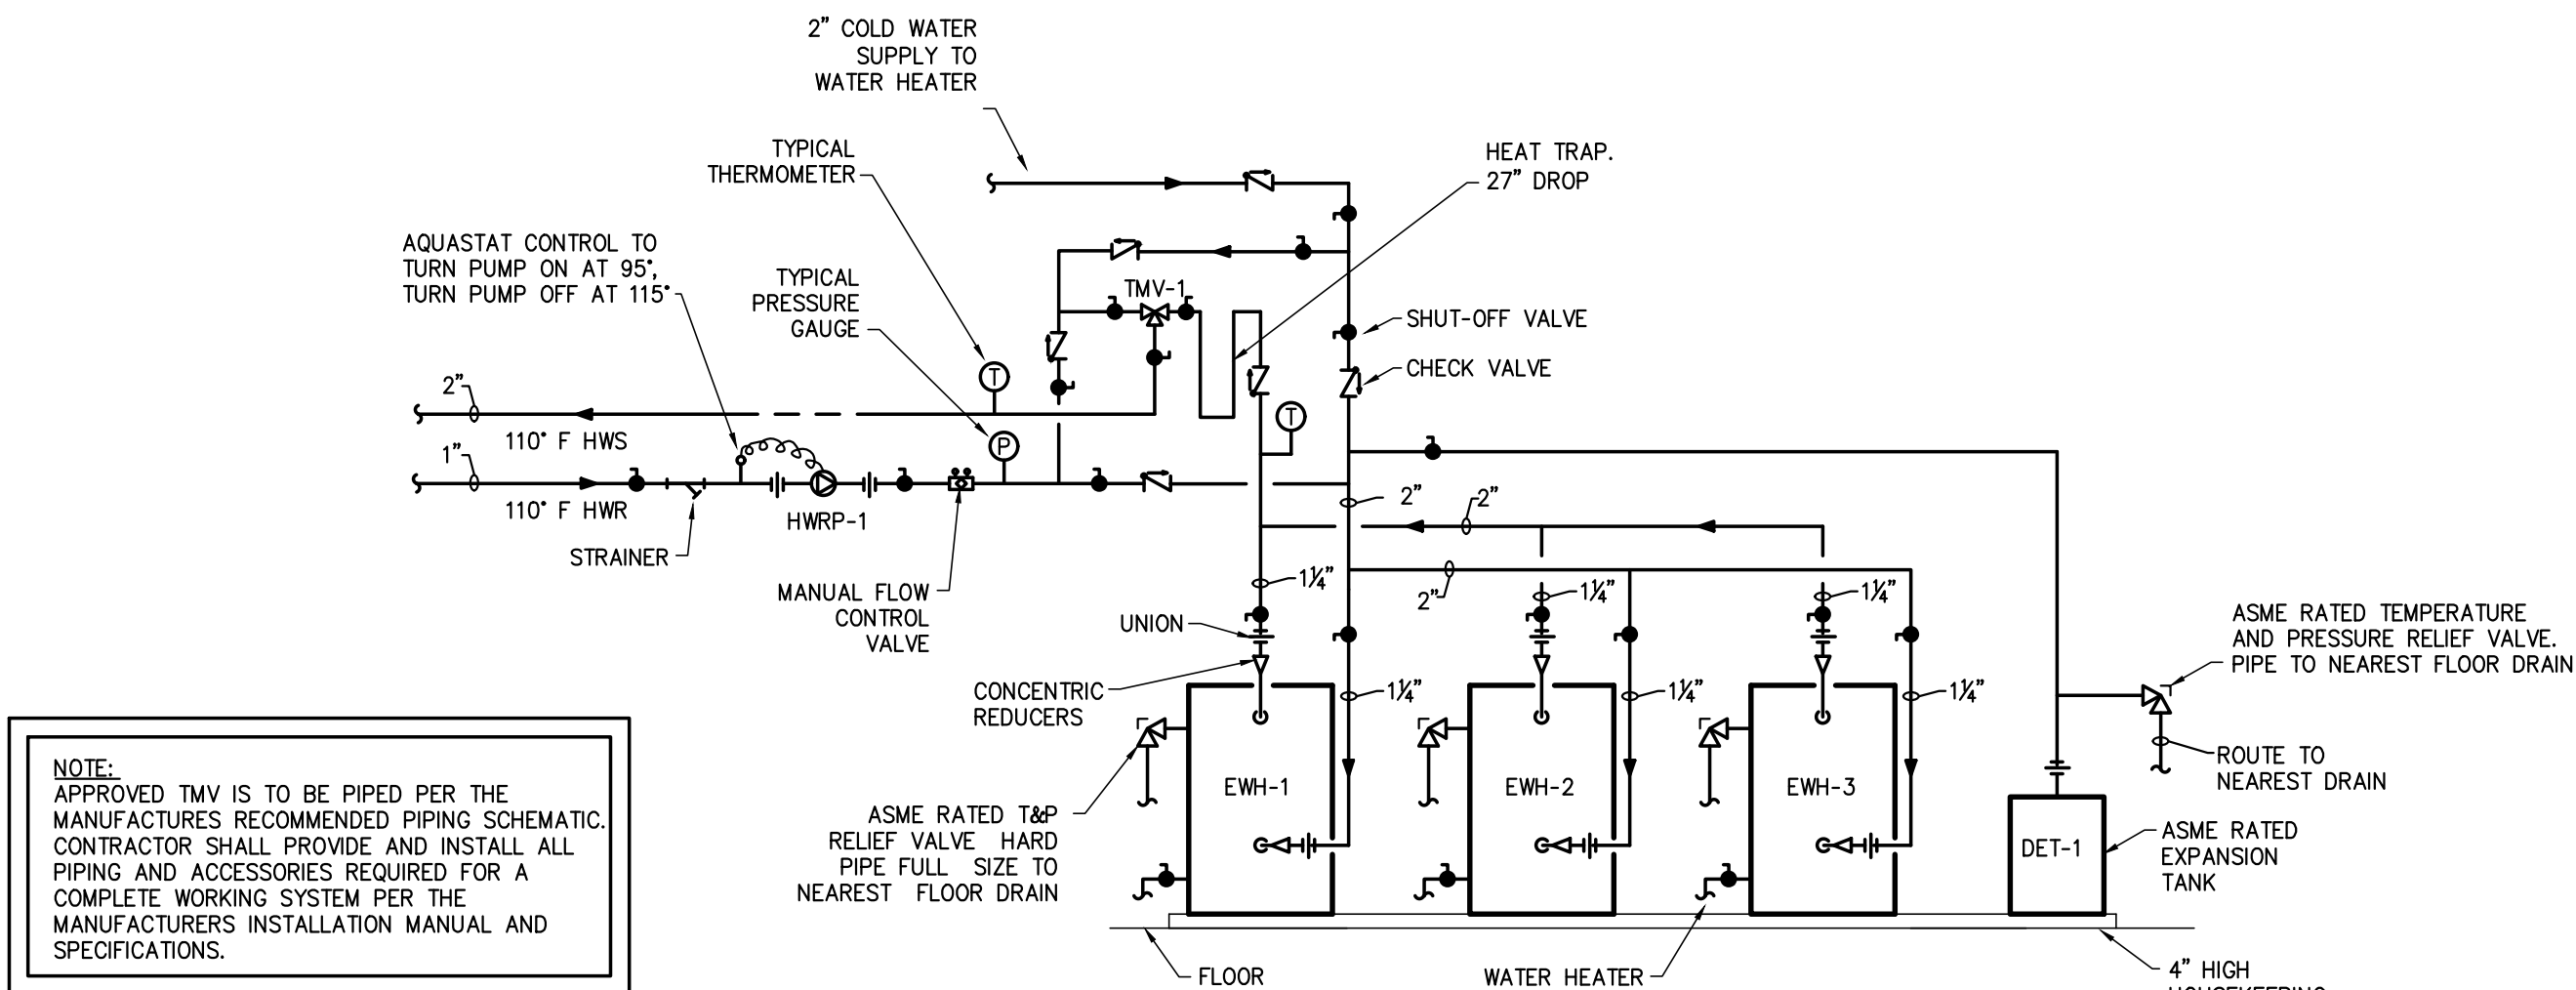

HOT WATER FLOW DIAGRAM


NOT TO SCALE

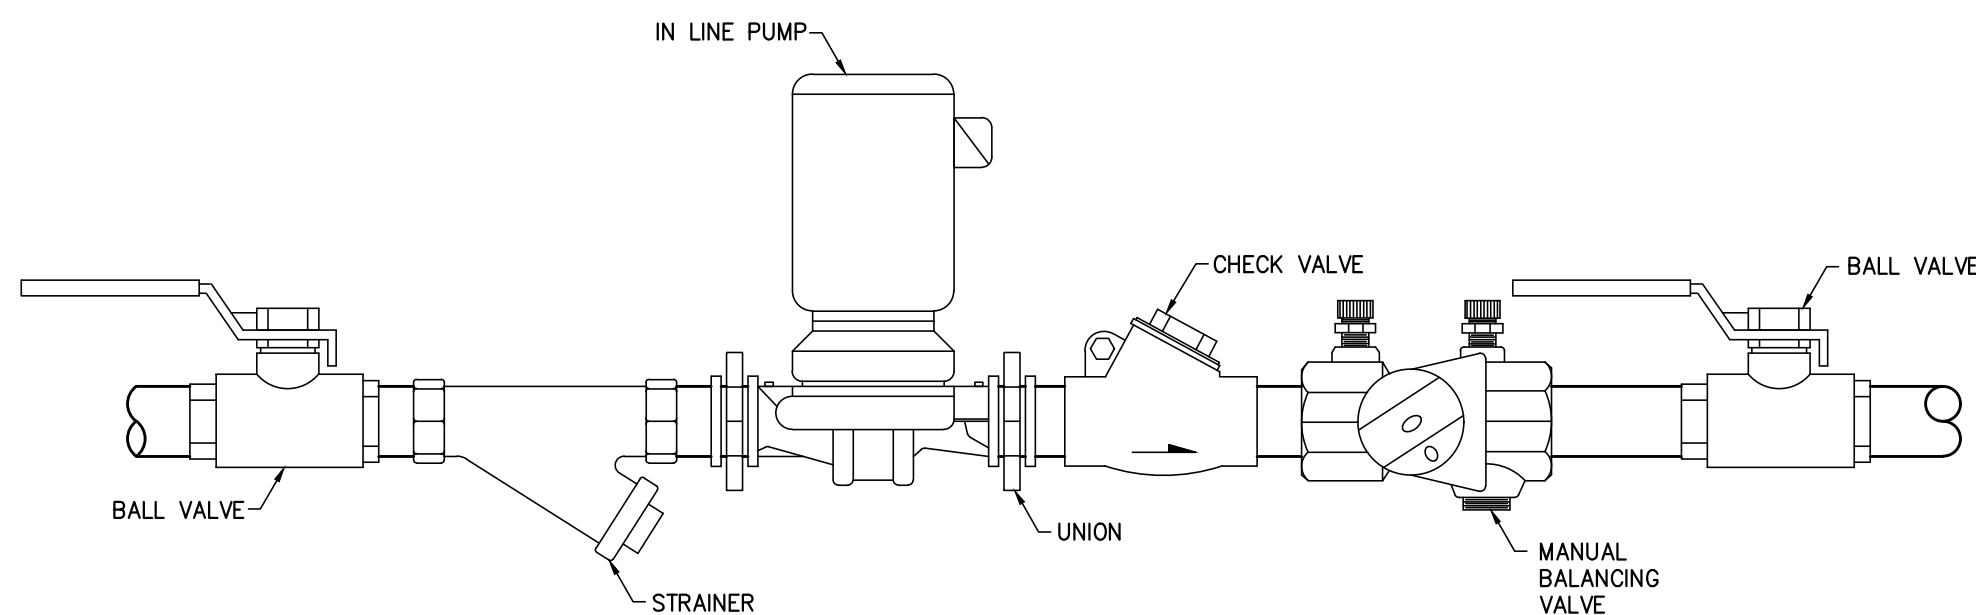

TYPICAL IN-LINE PUMP DETAIL


NOT TO SCALE

NOTE: ALL PIPING COMPONENTS, FITTINGS, VALVES AND PUMPS SHALL MEET THE MOST RECENT "NO LEAD" CODE.

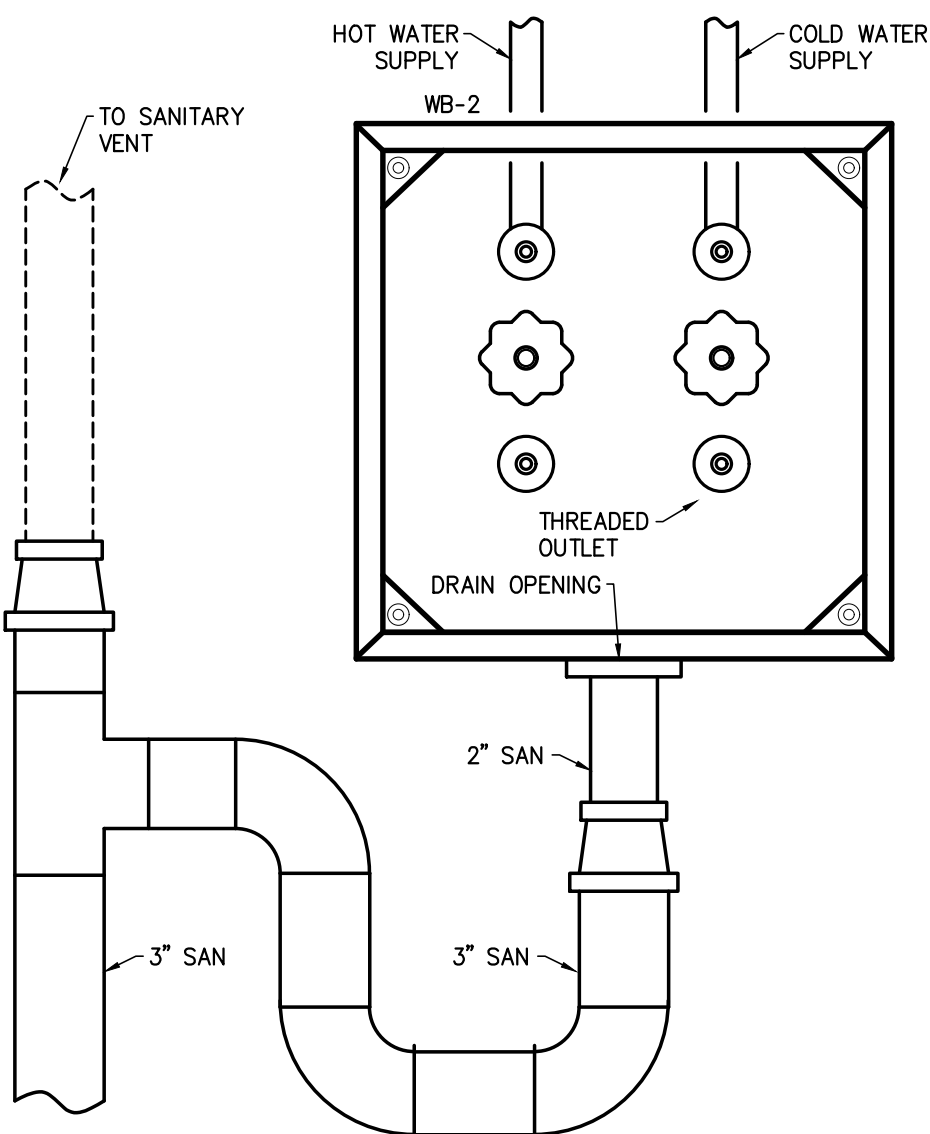


WALL BOX WITH DRAIN DETAIL (WB-2)

NOT TO SCALE

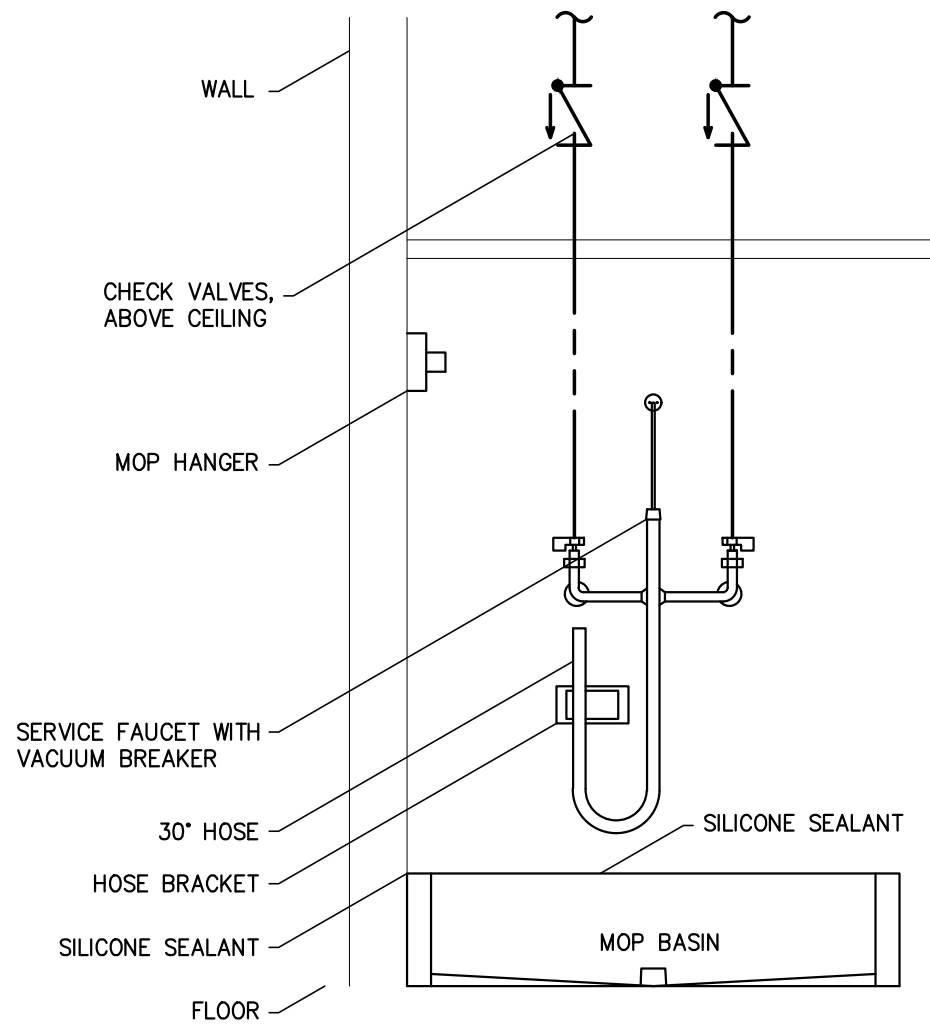


MOP BASIN DETAIL

NOT TO SCALE

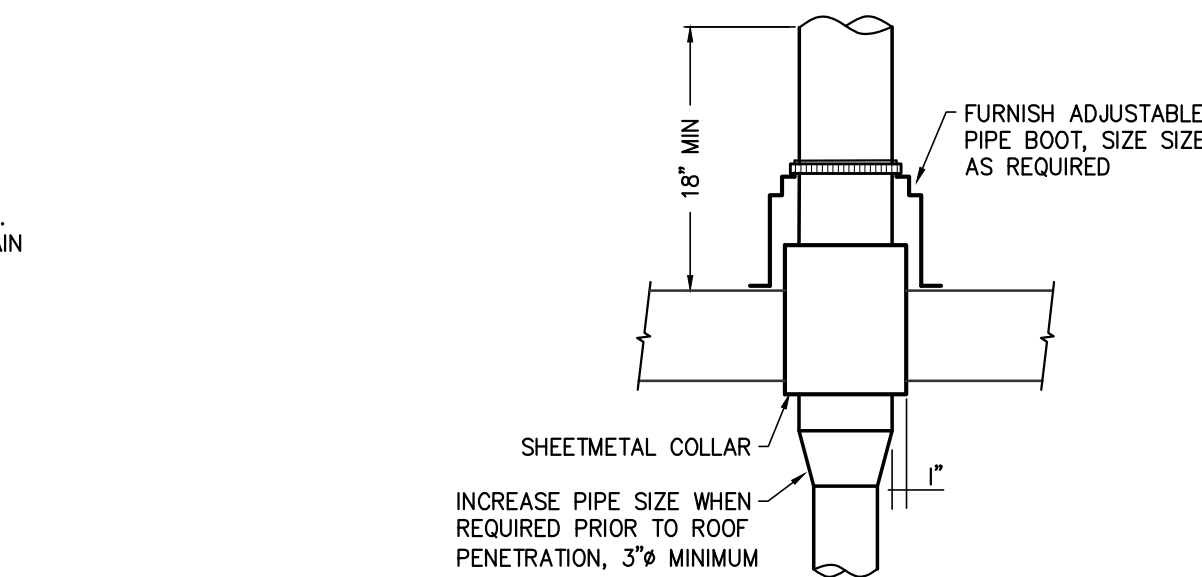

VENT THRU ROOF


NOT TO SCALE

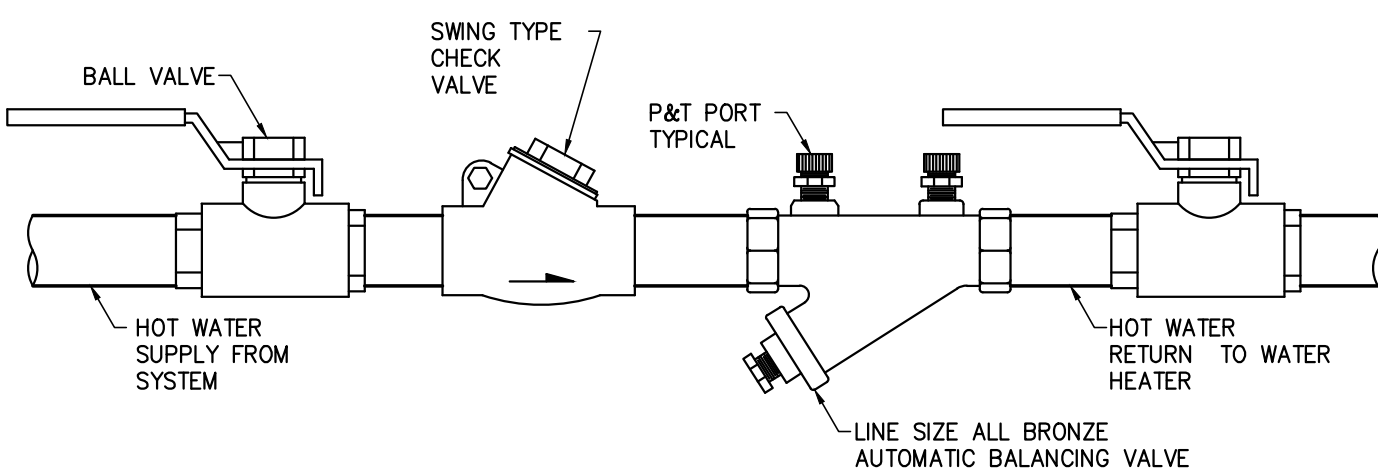

HOT WATER RETURN BALANCING STATION

NOT TO SCALE

NOTE: ALL PIPING COMPONENTS, FITTINGS, VALVES SHALL MEET THE MOST RECENT "NO LEAD" CODE.

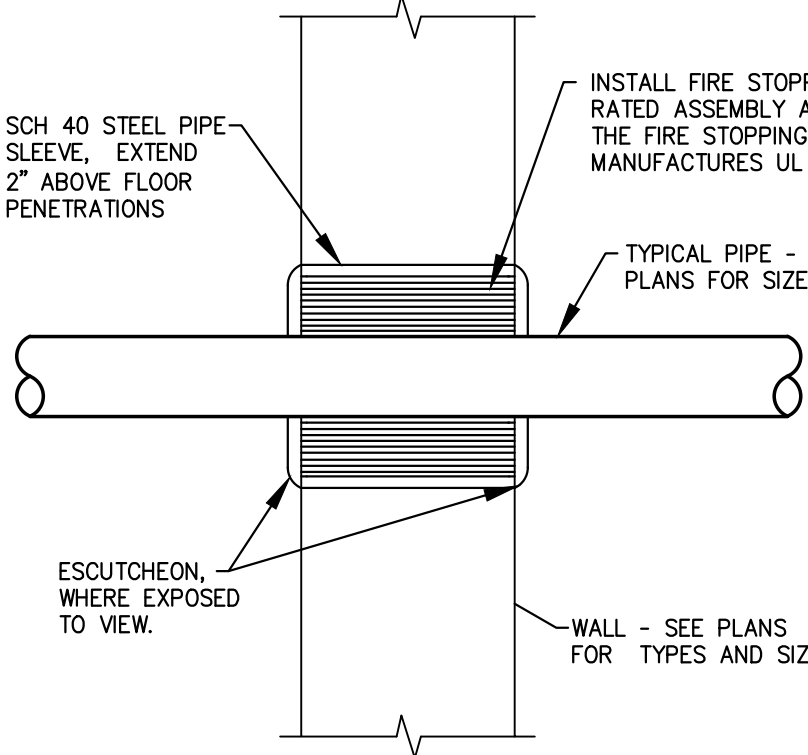

TYPICAL PIPING FIRE WALL FLOOR PENETRATION DETAIL

NOT TO SCALE

PLUMBING FIXTURE SCHEDULE

FIXTURE	MFR	MODEL	MFR	MODEL	TRIM	TYPE	PIPE CONNECTIONS				COLOR	REMARKS
							W	V	HW	CW		
WC-1	AMERICAN STANDARD	215AA.004	---	---	---	FLUSH TANK	3"	2"	---	1/2"	WHITE	1, 2
WC-1H	AMERICAN STANDARD	215AA.004	---	---	---	FLUSH TANK	3"	2"	---	1/2"	WHITE	1, 2, 3
L-1	AMERICAN STANDARD	476.028	CHICAGO	802-VE34VPABCP	---	LEVER HANDLE	1 1/2"	1 1/2"	1/2"	1/2"	WHITE	4, 5, 8
L-1H	AMERICAN STANDARD	476.028	CHICAGO	802-VE34VPABCP	---	LEVER HANDLE	1 1/2"	1 1/2"	1/2"	1/2"	WHITE	4, 5, 8, 9
S-1H	ELKAY	LRAD191865PD	T&S BRASS	B-1121-CR	---	LEVER HANDLE	2"	1 1/2"	1/2"	1/2"	STAINLESS	8, 9, 10
S-2H	ELKAY	LRAD291865PD	T&S BRASS	B-1121-CR	---	LEVER HANDLE	2"	1 1/2"	1/2"	1/2"	STAINLESS	8, 9, 10
S-3	ELKAY	DLK291810	T&S BRASS	B-1121-CR	---	LEVER HANDLE	2"	1 1/2"	1/2"	1/2"	STAINLESS	8, 9, 10
SH-1	AQUA BATH	AB8031-34TS	DELTA	T13H232	---	TUB / SHOWER HEAD	2"	1 1/2"	1/2"	1/2"	WHITE	11, 12
SH-1H	AQUA BATH	CR536TD-OT-FUS-3/4"	DELTA	T17H335-20	---	SHOWER HEAD W/HAND SHOWER	2"	1 1/2"	1/2"	1/2"	WHITE	13, 14, 15, 16
CO-1	JOSAM	35000-1-22	---	---	---	---	---	---	---	---	---	17, 18
CO-2	JOSAM	38900	---	---	---	---	---	---	---	---	---	19, 20, 21, 22
FD-1	JOSAM	30000-A	---	---	---	---	---	---	---	---	---	23
WB-1	IPS CORP	AB1200HA	CHICAGO	897-CRCP	---	FAUCET	3"	1 1/2"	1/2"	1/2"	WHITE	24, 25
WB-2	IPS CORP	MB1200HA	---	---	---	---	2"	---	3/4"	3/4"	WHITE	24, 25

REMARKS:

- PROVIDE UNIT WITH HEAVY DUTY, ELONGATED PLASTIC SEAT WITH CHECK HINGE.
- PROVIDE AND INSTALL UNIT WITH 3/8" ANGLE SUPPLY WITH STOPS AND SS BRAIDED SUPPLY LINE.
- UNIT IS TO BE ADA COMPLIANT, MOUNT 90" AT A MINIMUM OF 16.5" A.F.F.
- INSTALL SINK WITHIN COUNTER TOP AND CAULK AND SEAL FIXTURE WITH MOLD RESISTANT SILICONE SEALANT. COLOR TO BE SELECTED BY ARCHITECT.
- PROVIDE AND INSTALL WITH 17 GAUGE P-TRAP, BRAIDED STEEL SUPPLY LINES, ANGLE STOPS WITH HANDLES AND ESCUTCHEONS.
- PROVIDE AND INSTALL UNIT WITH PIPE WRAP KIT EQUAL TO TRIBORO OR PLUMBERSX PRO.
- UNIT IS TO BE MOUNTED PER ADA GUIDELINES, REFER TO ARCHITECTURAL PLANS FOR MOUNTING HEIGHT.
- PROVIDE AND INSTALL WITH 8" CENTERS, SATIN STAINLESS STEEL BASKET STRAINER WITH DRAIN ASSEMBLY, 17 GAUGE P-TRAP, AND ANGLE STOPS WITH HANDLES.
- INSTALL SINK WITHIN COUNTER TOP AND CAULK AND SEAL FIXTURE WITH MOLD RESISTANT SILICONE SEALANT. COLOR TO BE SELECTED BY ARCHITECT.
- PROVIDE AND INSTALL UNIT WITH IN-SINK MODEL BADGER 1 OR EQUIVALENT GARBAGE DISPOSAL.
- PROVIDE AND INSTALL ONE PIECE TUB/SHOWER UNIT FOR RIGHT OR LEFT HAND DRAIN AS CALLED FOR ON DRAWINGS.
- PROVIDE AND INSTALL UNIT WITH 1.75 GPM SHOWER HEAD, ASSE 1006 CERTIFIED PRESSURE BALANCING VALVE, TUB DIVERTER SPOUT, DRAIN ASSEMBLIES, AND CURTAIN ROD.
- PROVIDE AND INSTALL ONE PIECE, ADA COMPLIANT ROLL-IN SHOWER WITH TRENCH DRAIN AND 3/4" REDUCED SKIRT AND 1/2" HIGH THRESHOLD.
- PROVIDE AND INSTALL UNIT WITH DRAIN ASSEMBLY, FOLD UP SEAT, L-SHAPED GRAB BAR, VERTICAL GRAB BAR, COLLAPSIBLE DAM, CURTAIN ROD, AND SOAP DISH.
- PROVIDE AND INSTALL WITH THERMOSTATIC MIXING VALVE, DIVERTER VALVE, FIXED HEAD, HAND HELD SHOWER SPRAYER WITH 1.5 GPM FLOW RATE, AND SS ROSE.
- MOUNT 72" A.F.F. TO TOP OF SLIDE BAR. DIVERTER AND SLIDE BAR TO BE MOUNTED PER THE 2010 ADA GUIDELINES.
- CLEANOUTS SHALL BE SIZED PER PLANS.
- PROVIDE AND INSTALL UNIT FOR FINISHED FLOOR, ROUND TOP.
- FLOOR DRAINS SHALL BE SIZED PER PLANS.
- PROVIDE AND INSTALL UNIT WITH NIKALOY TOP.
- PROVIDE AND INSTALL UNIT WITH DEEP SEAL TRAP.
- PROVIDE AND INSTALL UNIT WITH SURE SEAL, INLINE FLOOR DRAIN TRAP SEAL.
- UNIT IS TO BE WHITE PVC WITH 1/4 TURN BALL VALVE AND INTEGRAL WATER HAMMER ARRESTOR.
- UNIT IS TO BE WHITE PVC WITH 1/4 TURN BALL VALVES AND INTEGRAL WATER HAMMER ARRESTORS.
- UNIT IS TO BE MULTI-BOX WASHING MACHINE BOX WITH AUXILIARY DRAIN BOX.

TEMPERATURE MIXING VALVE SCHEDULE

TAG	MANUFACTURER	MODEL	UNIT NUMBER	MIN. / MAX. FLOW (GPM)	DESIGN FLOW (GPM)	DESIGN PRESS. DROP (PSI)	OUTLET TEMP. (DEG. F)	SERVICE	REMARKS
TMV-1	LAMER	802	88008	0.5 / 35	32	10	110	110°F DOMESTIC HOT WATER	1, 2, 3

REMARKS:

- PROVIDE AND INSTALL UNIT WITH CHECK VALVES ON HOT AND COLD WATER SUPPLY, INTEGRAL OUTLET THERMOMETER AND SHUT-OFF VALVE ON TEMPERED WATER OUTLET.
- PROVIDE AND INSTALL AN EXPOSED ASSEMBLY WITH ROUGH BRASS FINISH.
- VALVE SHALL FAIL TO THE COLD SUPPLY.

RECIRCULATION PUMP SCHEDULE

TAG	MANUFACTURER	MODEL	SIZE	FLOW (GPM)	HEAD FT	MAX. RPM	HP	ELECTRICAL (V / PH)	SERVICE	REMARKS
HWRP-1	BELL & GOSSETT	ECODRC XL-N	55-45	7	45	4500	1/2	208/1	110°F DOMESTIC HOT WATER	1, 2, 3

REMARKS:

- PROVIDE AND INSTALL WET ROTOR INLINE PUMP WITH LEAD FREE STAINLESS STEEL BODY TO MEET THE MOST RECENT FEDERAL "NO LEAD" STANDARD OF NSF 61.
- PROVIDE AND INSTALL VARIABLE SPEED PUMP WITH ECM MOTOR.
- PROVIDE AND INSTALL PUMP WITH AQUASTAT, CIRCUIT SETTER, AND ALL CONTROLS FOR CONTROL OF PUMP. COORDINATE INSTALLATION WITH ELECTRICAL CONTRACTOR.

DOMESTIC EXPANSION TANK SCHEDULE

TAG	MANUFACTURER	MODEL	MAX. PRESSURE (PSI)	TANK VOL. (GAL)	ACCEPTANCE (GAL)	MOUNTING FLOOR	INLET SIZE	TYPE	REMARKS
DET-1	BELL & GOSSETT	ST-70WC	67	34	11	---	3/4"	DIAPHRAGM	1, 2, 3, 4

REMARKS:

- TANK SHALL BE ASME LABELED FOR 150 PSIG WORKING PRESSURE, 200 DEGREES F MAXIMUM OPERATING TEMPERATURE.
- TANK SHALL BE SPECIFICALLY DESIGNED FOR POTABLE HOT WATER SYSTEMS.
- CONTRACTOR TO VERIFY FILL PRESSURE PRIOR TO PLACING EXPANSION TANK INTO OPERATION.
- PROVIDE SAFETY RELIEF VALVE SIZED FOR THIS TANK.

ELECTRIC WATER HEATER SCHEDULE

TAG	MANUFACTURER	MODEL	ELEMENT (KW)	GALLON CAPACITY	90 DEG. RISE RECOVERY GPH	ELECTRICAL (V / PH)	LOCATION	REMARKS
EW-1	LOCHINVAR	LHC-11BP24	24.0	120	98	240 / 1 / 60	MECHANICAL W/OT	1 THRU 3
EW-2	LOCHINVAR	LHC-11BP24	24.0	120	98	240 / 1 / 60	MECHANICAL W/OT	1 THRU 3
EW-3	LOCHINVAR	LHC-11BP24	24.0	120	98	240 / 1 / 60	MECHANICAL W/OT	1 THRU 3


REMARKS:

- PROVIDE AND INSTALL UNIT WITH ASME TEMPERATURE AND PRESSURE RELIEF VALVE.
- UNIT IS TO BE PROVIDED WITH SIX 4000 WATT, IMMERSON HEATING ELEMENTS AND IS TO BE WIRED FOR SIMULTANEOUS OPERATION.
- SET INITIAL OUTLET TEMPERATURE TO MAINTAIN 140 DEGREES F.

WATER HAMMER ARRESTOR SCHEDULE

MARK	MANUFACTURE	MODEL #	MAX. FIXTURE UNIT CAPACITY	CONNECTION SIZE	REMARKS
A	SIoux CHIEF	652-A	1 TO 11	1/2"	1
B	SIoux CHIEF	653-B	12 TO 32	3/4"	1
C	SIoux CHIEF	654-C	33 TO 60	1"	1
D	SIoux CHIEF	655-D	61 TO 113	1 1/4"	1
E	SIoux CHIEF	656-E	114 TO 154	1 1/2"	1
F	SIoux CHIEF	657-F	155 TO 330	2"	1

- PLUMBING CONTRACTOR SHALL INSTALL SHOCK ABSORBER AT EACH WATER LINE SERVING A BANK OF PLUMBING FIXTURES. DOWNSTREAM OF MAIN SHUT-OFF VALVE PER ABOVE SCHEDULE OR AS SHOWN ON DESIGN DRAWINGS. INSTALL AS PER STANDARD PDI-WH 201.

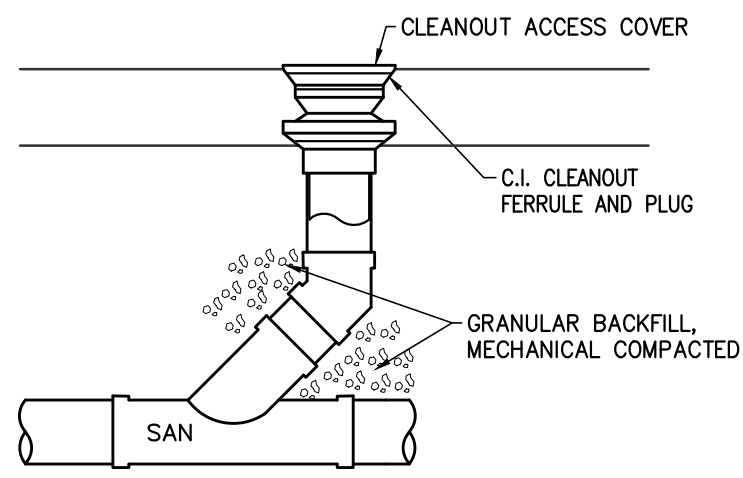

INTERIOR CLEANOUT DETAIL

NOT TO SCALE

BONA VITA

ARCHITECTURE

110 west main street, ste. 200

fort wayne, in 46802

p 260 | 471.9449

www.bonavitaarchitecture.com



SCO ENGINEERING, LLC
SOLUTIONS PROVIDED • PROBLEMS SOLVED

FORT WAYNE

815M Constitution Drive
Fort Wayne, IN 46804

(260) 436-6213

(260) 436-6481 fax

scor@scor-llc.com

A Project For:
YWCA Northeast Indiana, Inc.

YWCA The Lofts

1313 W. Washington Center Road, Fort Wayne, IN 46825

eliminating racism
empowering women
ywca
Northeast Indiana

mark	date	description
Δ	01-23-24	ADDENDUM NO. 1

This is an original design created by BONA VITA ARCHITECTURE. The ideas, concepts, designs, colors and materials included are represented in this document as owned by and presented for use on, and in connection with this specific project. None of the ideas, concepts, designs, plans and details shall be used or duplicated by any entity, person, or corporation for any purpose whatsoever without written permission of BONA VITA ARCHITECTURE, INC. Written dimensions on these drawings shall have precedence over notes, dimensions, callouts and verbal and be responsible for all dimensions and conditions on the job and BONA VITA ARCHITECTURE, INC. must be notified of any variation from the dimensions and conditions shown by these drawings. Bid drawings must be submitted to BONA VITA ARCHITECTURE for approval before fabrication.

Project Number 230495 (232722)


Date January 11, 2024

Drawn By BAB

Checked By BAB

PLUMBING
DETAILS AND
SCHEDULES

P6.01

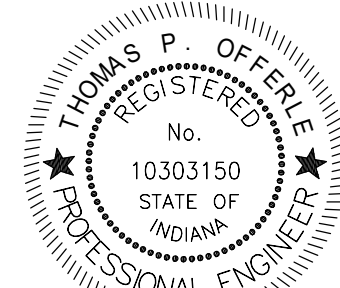

Thomas P. Offenberg


SCO ENGINEERING, LLC
SOLUTIONS PROVIDED • PROBLEMS SOLVED

FORT WAYNE
6034 Constitution Drive
Fort Wayne, IN 46804


(260) 436-9213
(260) 435-5481 fax
scosco@scosco.com

MECHANICAL PLAN NOTES


- 1 CONTRACTOR SHALL PROVIDE AND INSTALL A NEW THROUGH-THE-WALL PACKAGED TERMINAL AIR CONDITIONING UNIT WITHIN THE NEW CURTAIN WALL. MECHANICAL CONTRACTOR SHALL INTAL PTAC UNIT WITH MANUFACTURER PROVIDED SUB-BASE WITH 20 AMP RECEPTICAL FOR LEVELING OF UNIT. COORDINATE ALL WORK WITH GC AND ALL TRADES PRIOR TO THE INITIATION OF ANY WORK.
- 2 MECHANICAL CONTRACTOR SHALL CAP EXISTING HYDRONIC HOT/CILLED WATER PIPING UP WITHIN CONCEALED LOCATION AND ABANDON PIPING.
- 3 PROVIDE AND INSTALL NEW TEMPERATURE SENSOR IN LOCATION SHOWN. MECHANICAL CONTRACTOR SHALL PROVIDE AND INSTALL ALL CONTROL WIRING, RELAYS, AND ACCESSORIES AS REQUIRED FOR A COMPLETE AND FUNCTIONING SYSTEM. WIRING SHALL BE INSTALLED PER ELECTRICAL SPECIFICATIONS.
- 4 MECHANICAL CONTRACTOR SHALL PROVIDE AND INSTALL A NEW CEILING MOUNTED EXHAUST FAN. CONTRACTOR SHALL TE-IN NEW EXHAUST DUCT AND ROUTE FOR CONNECTION TO THE NEW FAN.
- 5 ROUTE REFRIGERANT PIPING UP ABOVE CEILING AT HIGHEST POSSIBLE ELEVATION AND ROUTE REFRIGERANT PIPING UP THROUGH ROOF FOR CONNECTION TO OUTDOOR CONDENSING UNIT. ROUTE REFRIGERANT LINESSET THROUGH NEW PATE PCA PIPE PENETRATION CURBS. UTILIZE PATE BOOTTS TO MAKE WEATHERTIGHT SEALS AROUND PIPES. APPLY UV COATING TO ARMAFLEX INSULATION INSTALLED OUTDOORS. CONTRACTOR SHALL PROVIDE ANY ADDITIONAL REQUIRED REFRIGERANT LINESETS AND REFRIGERANT FOR CONNECTION FROM FAN COIL TO OUTDOOR CONDENSING UNITS AS REQUIRED FOR EXTENDED LENGTHS. INSTALL PIPING PER MANUFACTURERS RECOMMENDATION.
- 6 PROVIDE AND INSTAL WALL MOUNTED INDOOR SPLIT AC UNIT. ROUTE REFRIGERANT LINES FROM UNIT UP THROUGH WALL AND WITHIN THE JOIST CAVITIES FOR CONNECTION TO CONDENSING UNIT ON ROOF. SIZE REFRIGERANT LINES PER MANUFACTURERS RECOMMENDATIONS. PROVIDE AND INSTALL WALL MOUNTED THERMOSTAT. ROUTE 3/4" CONDENSATE DRAIN PIPING FROM SPLIT SYSTEM AC UNIT DOWN THROUGH WALL TO FIRST FLOOR AND ROUTE ABOVE CEILING TO EXTERIOR WALL FOR TERMINATION TO THE EXTERIOR. CONTRACTOR SHALL CORE DRILL OPENING FOR CONDENSATE DRAIN FROM THE EXTERIOR SIDE OF THE BUILDING TO PROTECT BRICK FACE FROM PUNCH OUT WHILE INSTALLING PIPING. CONTRACTOR SHALL PROVIDE AND INSTALL CAULKING FOR A WEATHER TIGHT INSTALLATION. ARCHITECT SHALL APPROVE COLOR OF CAULKING. IT IS THE INTENT OF THESE DRAWINGS THAT ALL EXTERIOR TERMINATIONS SHALL BE MOUNTED SYMETRICALLY AND AT THE SAME ELEVATION. COORDINATE WITH ARCHITECT AND GENERAL CONTRACTOR PRIOR TO INSTALLATION.
- 7 4" DRYER EXHAUST AIR DUCT TO BE ROUTED FROM DRYER BOX AND IS TO BE ROUTED UP ABOVE CEILING SPACE WITHIN TRUSS SPACE FOR TERMINATION THROUGH SIDEWALL WITH MANUFACTURER RECOMMENDED RAIN CAP. PROVIDE ALL REQUIRED TRANSITIONS AND FITTINGS REQUIRED FOR INSTALLATION. MOUNT TERMINATION KIT AT HIGHEST POSSIBLE ELEVATION AND MAINTAIN REQUIRED CLEARANCES FROM ANY OPERABLE OPENING OR OUTSIDE AIR INTAKE AS REQUIRED BY INTERNATIONAL MECHANICAL CODE, INDIANA MECHANICAL CODE, ALL STATE AND LOCAL CODES, AND UTILITY REGULATIONS. CONTRACTOR SHALL CORE DRILL OPENING FOR EXHAUST DUCT FROM THE EXTERIOR SIDE OF THE BUILDING TO PROTECT BRICK FACE FROM PUNCH OUT WHILE INSTALLING DUCTWORK AND TERMINATION KIT. CONTRACTOR SHALL PROVIDE AND INSTALL CAULKING FOR A WEATHER TIGHT INSTALLATION. ARCHITECT SHALL APPROVE COLOR OF CAULKING. IT IS THE INTENT OF THESE DRAWINGS THAT ALL EXTERIOR TERMINATIONS SHALL BE MOUNTED SYMETRICALLY AND AT THE SAME ELEVATION. COORDINATE WITH ARCHITECT AND GENERAL CONTRACTOR PRIOR TO INSTALLATION.

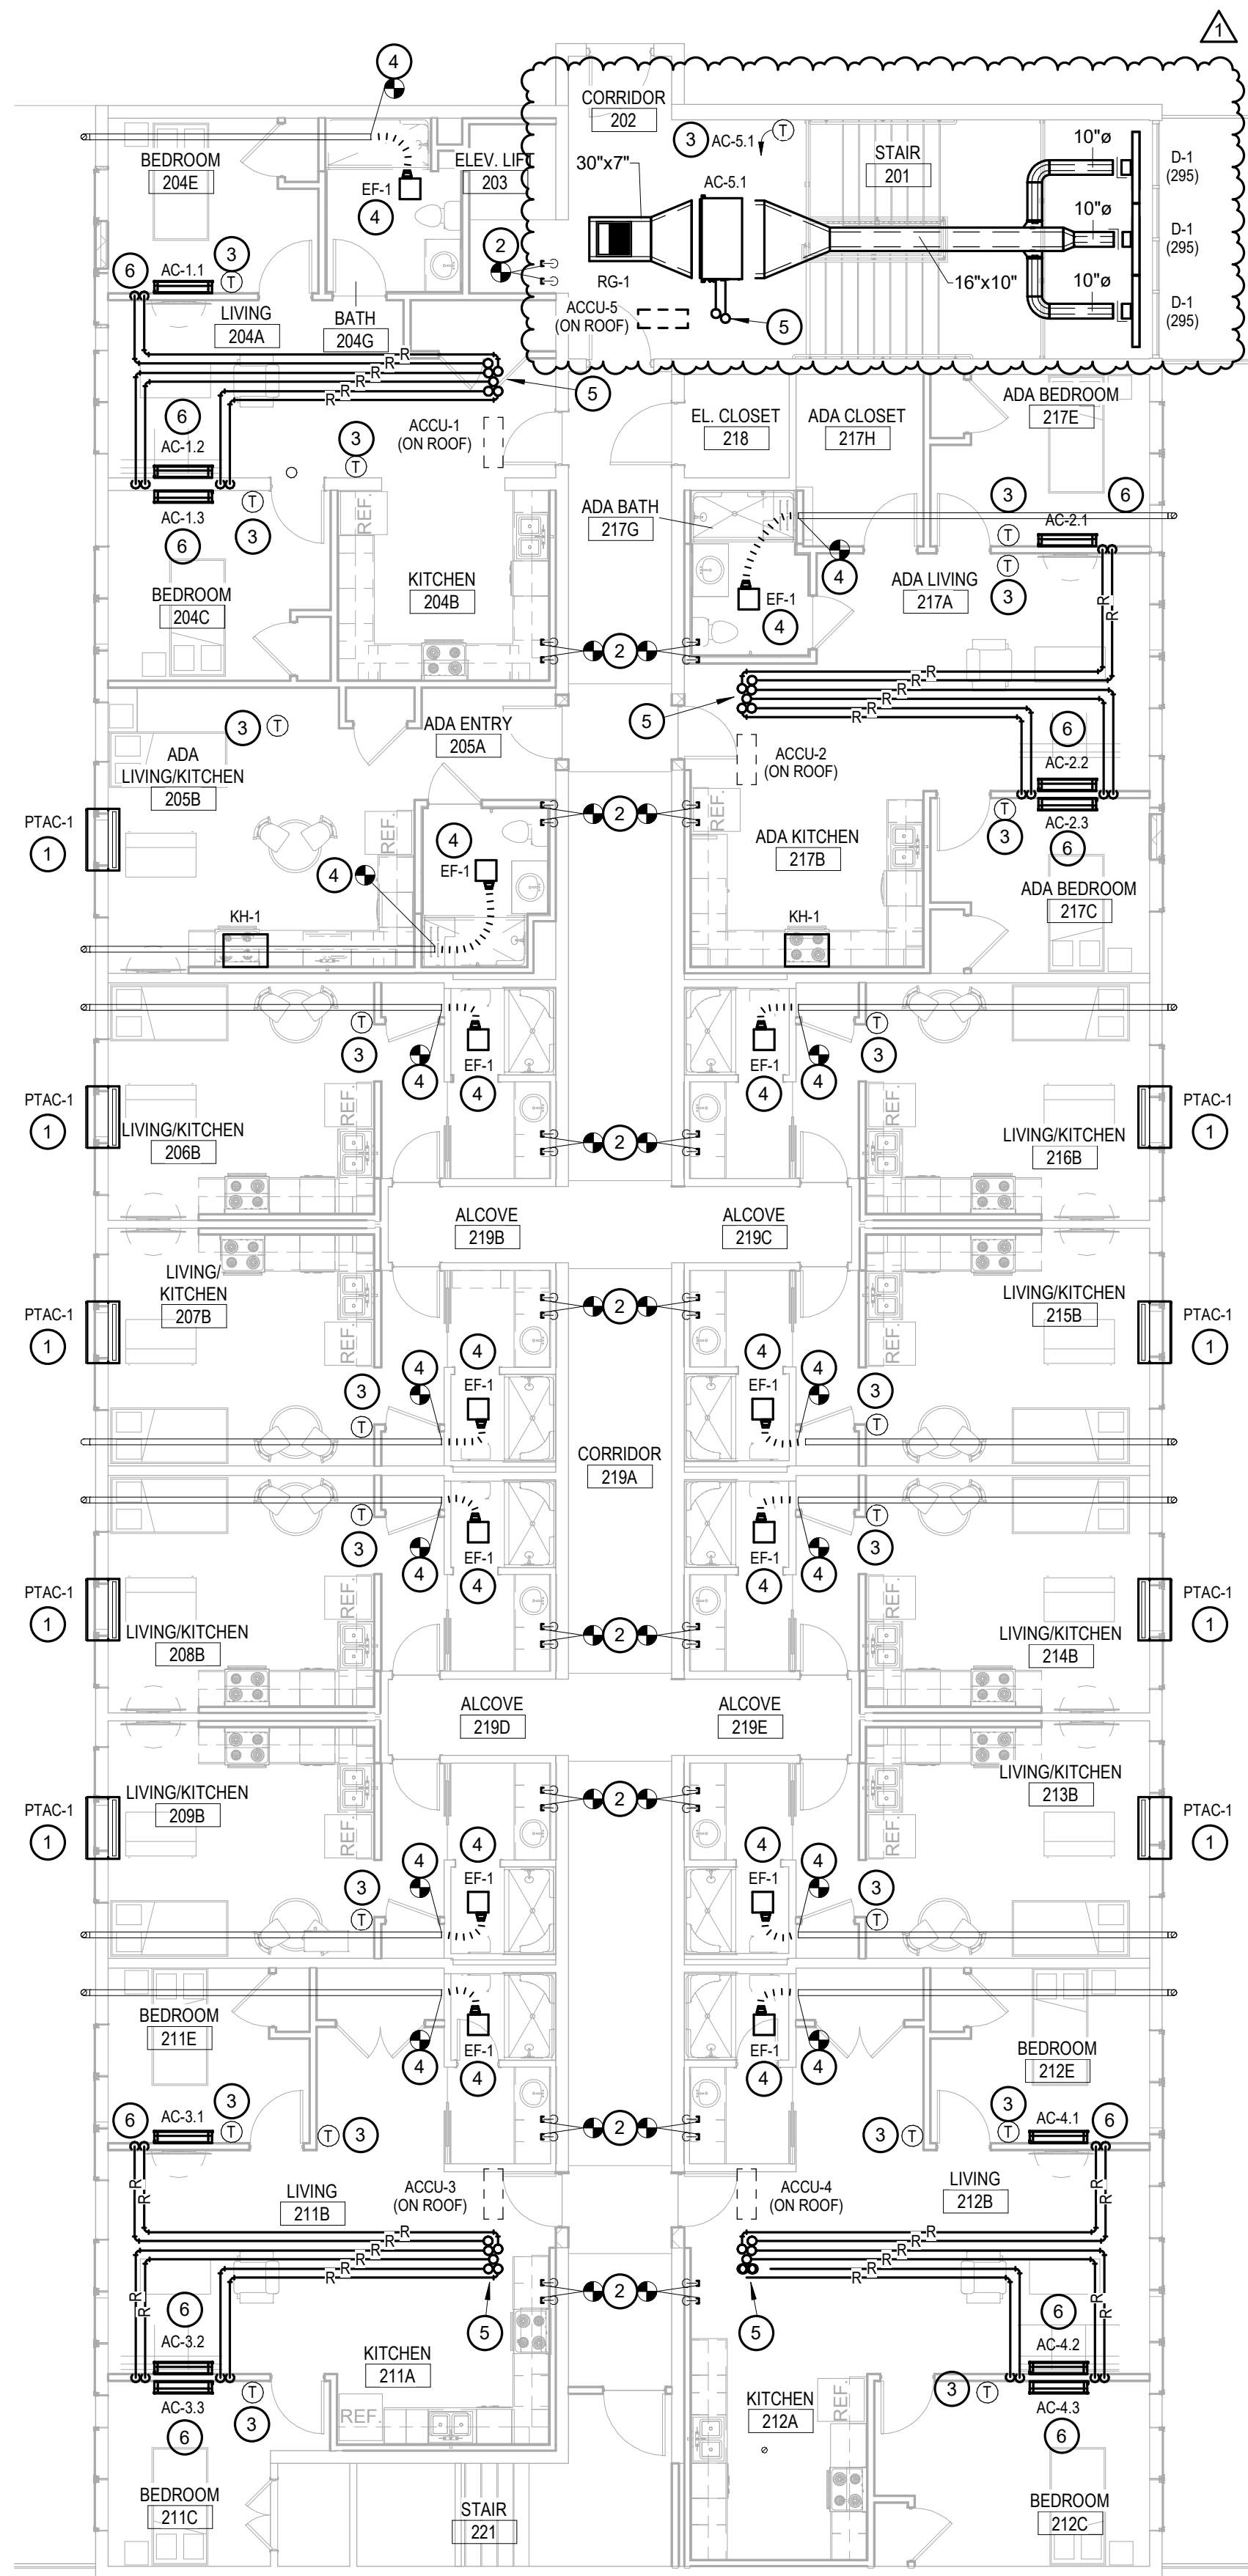


1 Second Floor Mechanical Plan - Overall
1/8" = 1'-0"

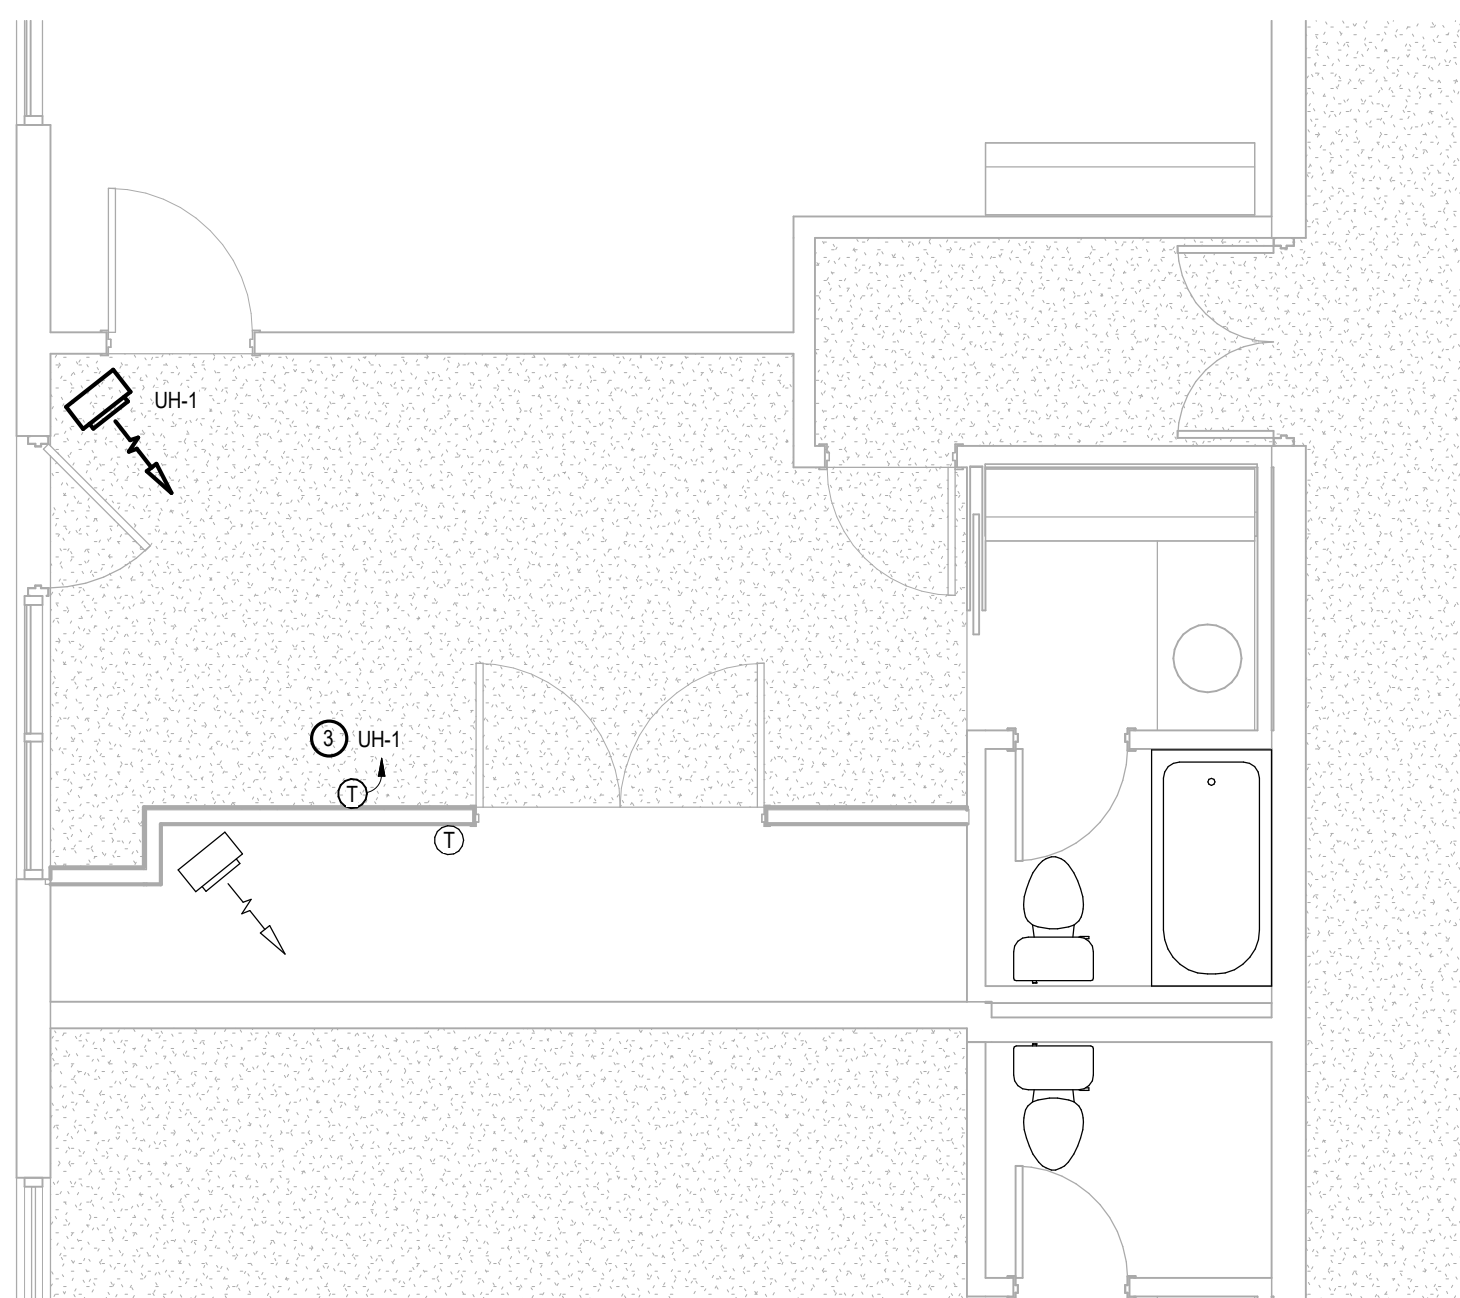


3 Partial First Floor Mechanical Plan - MECH Room
1/4" = 1'-0"

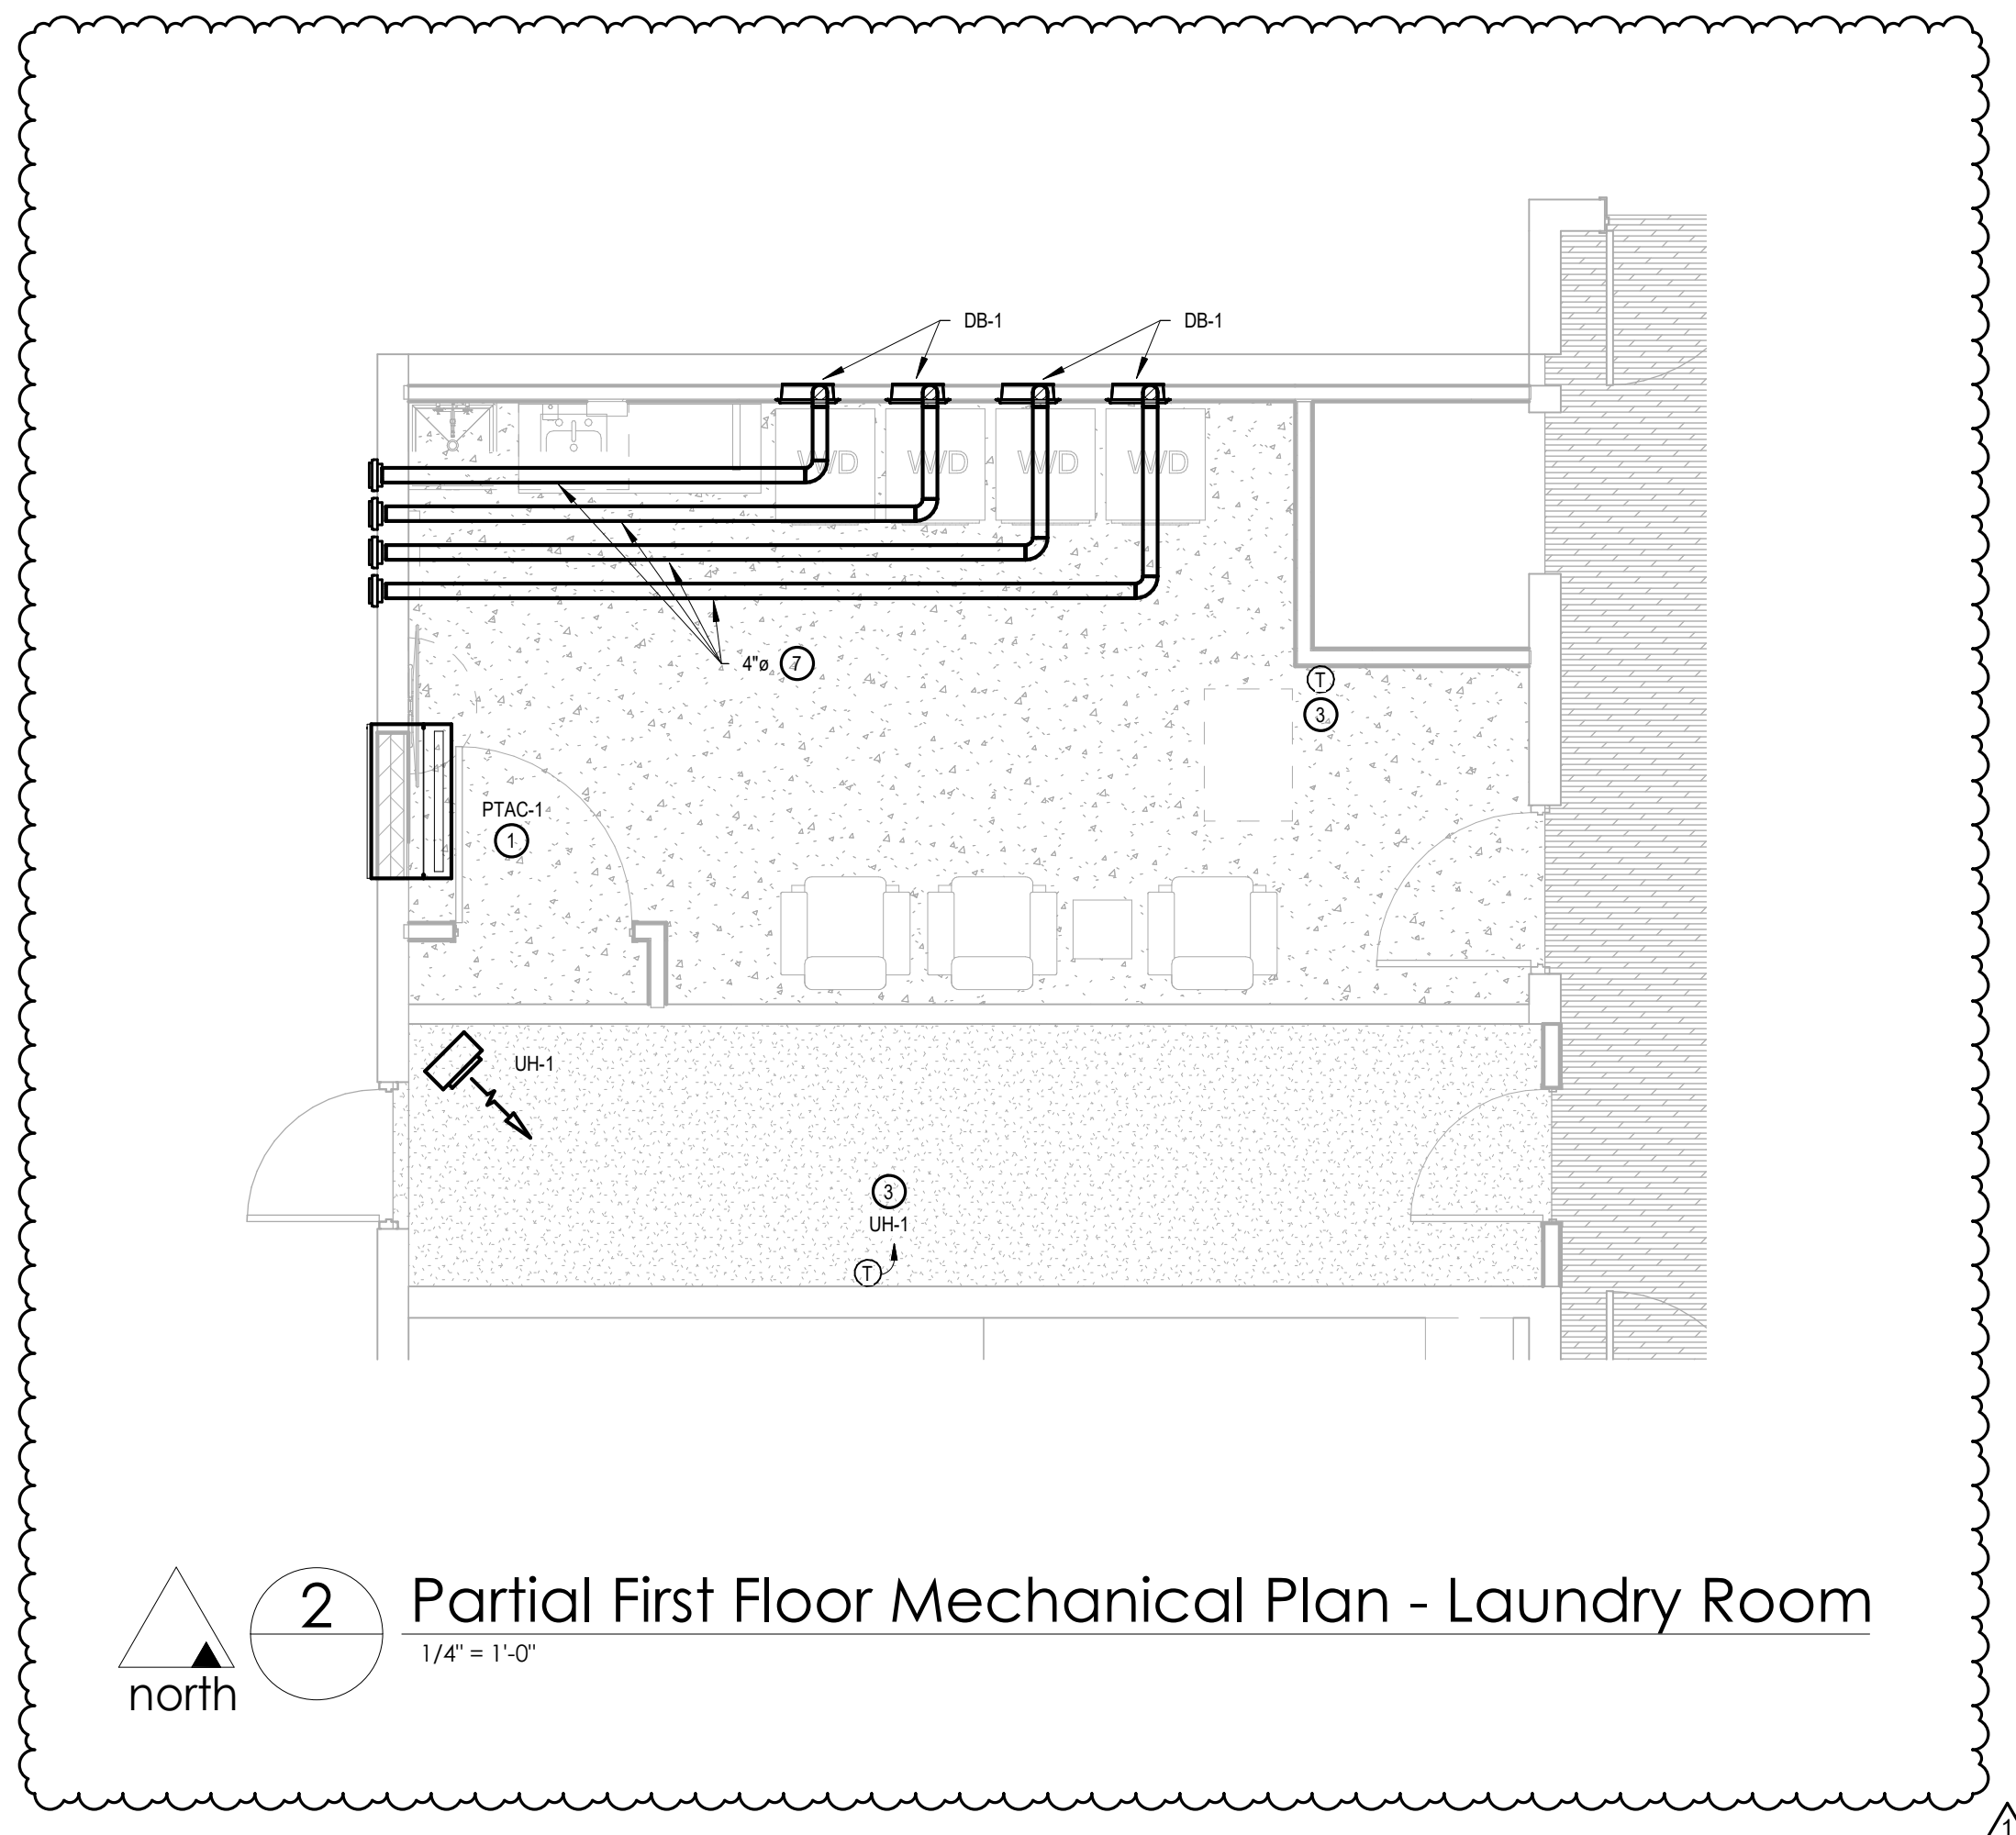

2 Partial First Floor Mechanical Plan - Laundry Room
1/4" = 1'-0"

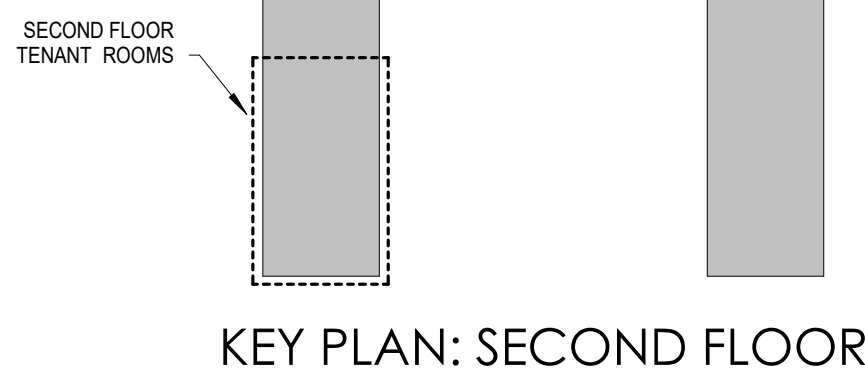

KEY PLAN: SECOND FLOOR

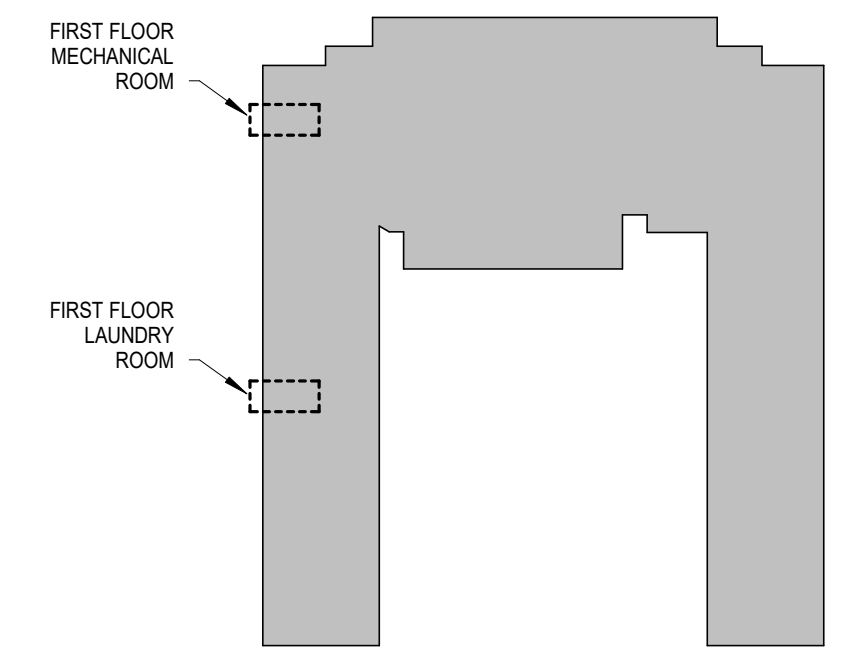

KEY PLAN: FIRST FLOOR

A Project For:

YWCA Northeast Indiana, Inc.

YWCA The Lofts

1313 W. Washington Center Road, Fort Wayne, IN 46825

eliminating racism
empowering women
ywca
Northeast Indiana

mark	date	description
1	01-022 -24	Addendum #1

This is an original design created by BONA VITA ARCHITECTURE. The ideas, concepts, designs, plans and details included or referenced in this document are owned by and are property of BONA VITA ARCHITECTURE, INC. and may not be reproduced, copied, or presented for use on, and in connection with this specific project. None of the ideas, concepts, designs, plans and details shall be used or disclosed to, by any person, firm, or corporation for any purpose without the written consent of BONA VITA ARCHITECTURE, INC. Written dimensions on these drawings shall have precedence over notes, dimensions, and details. Contractors shall apply and be responsible for all dimensions and conditions on the job and BONA VITA ARCHITECTURE, INC. must be notified of any deviation from the drawings and specifications prior to those drawings. Design drawings must be submitted to BONA VITA ARCHITECTURE, INC. for approval before construction.


Project Number 230495 (232722)

Date December 21, 2023

Drawn By RHH

Checked By BAB

First and Second Floor
Mechanical Plans

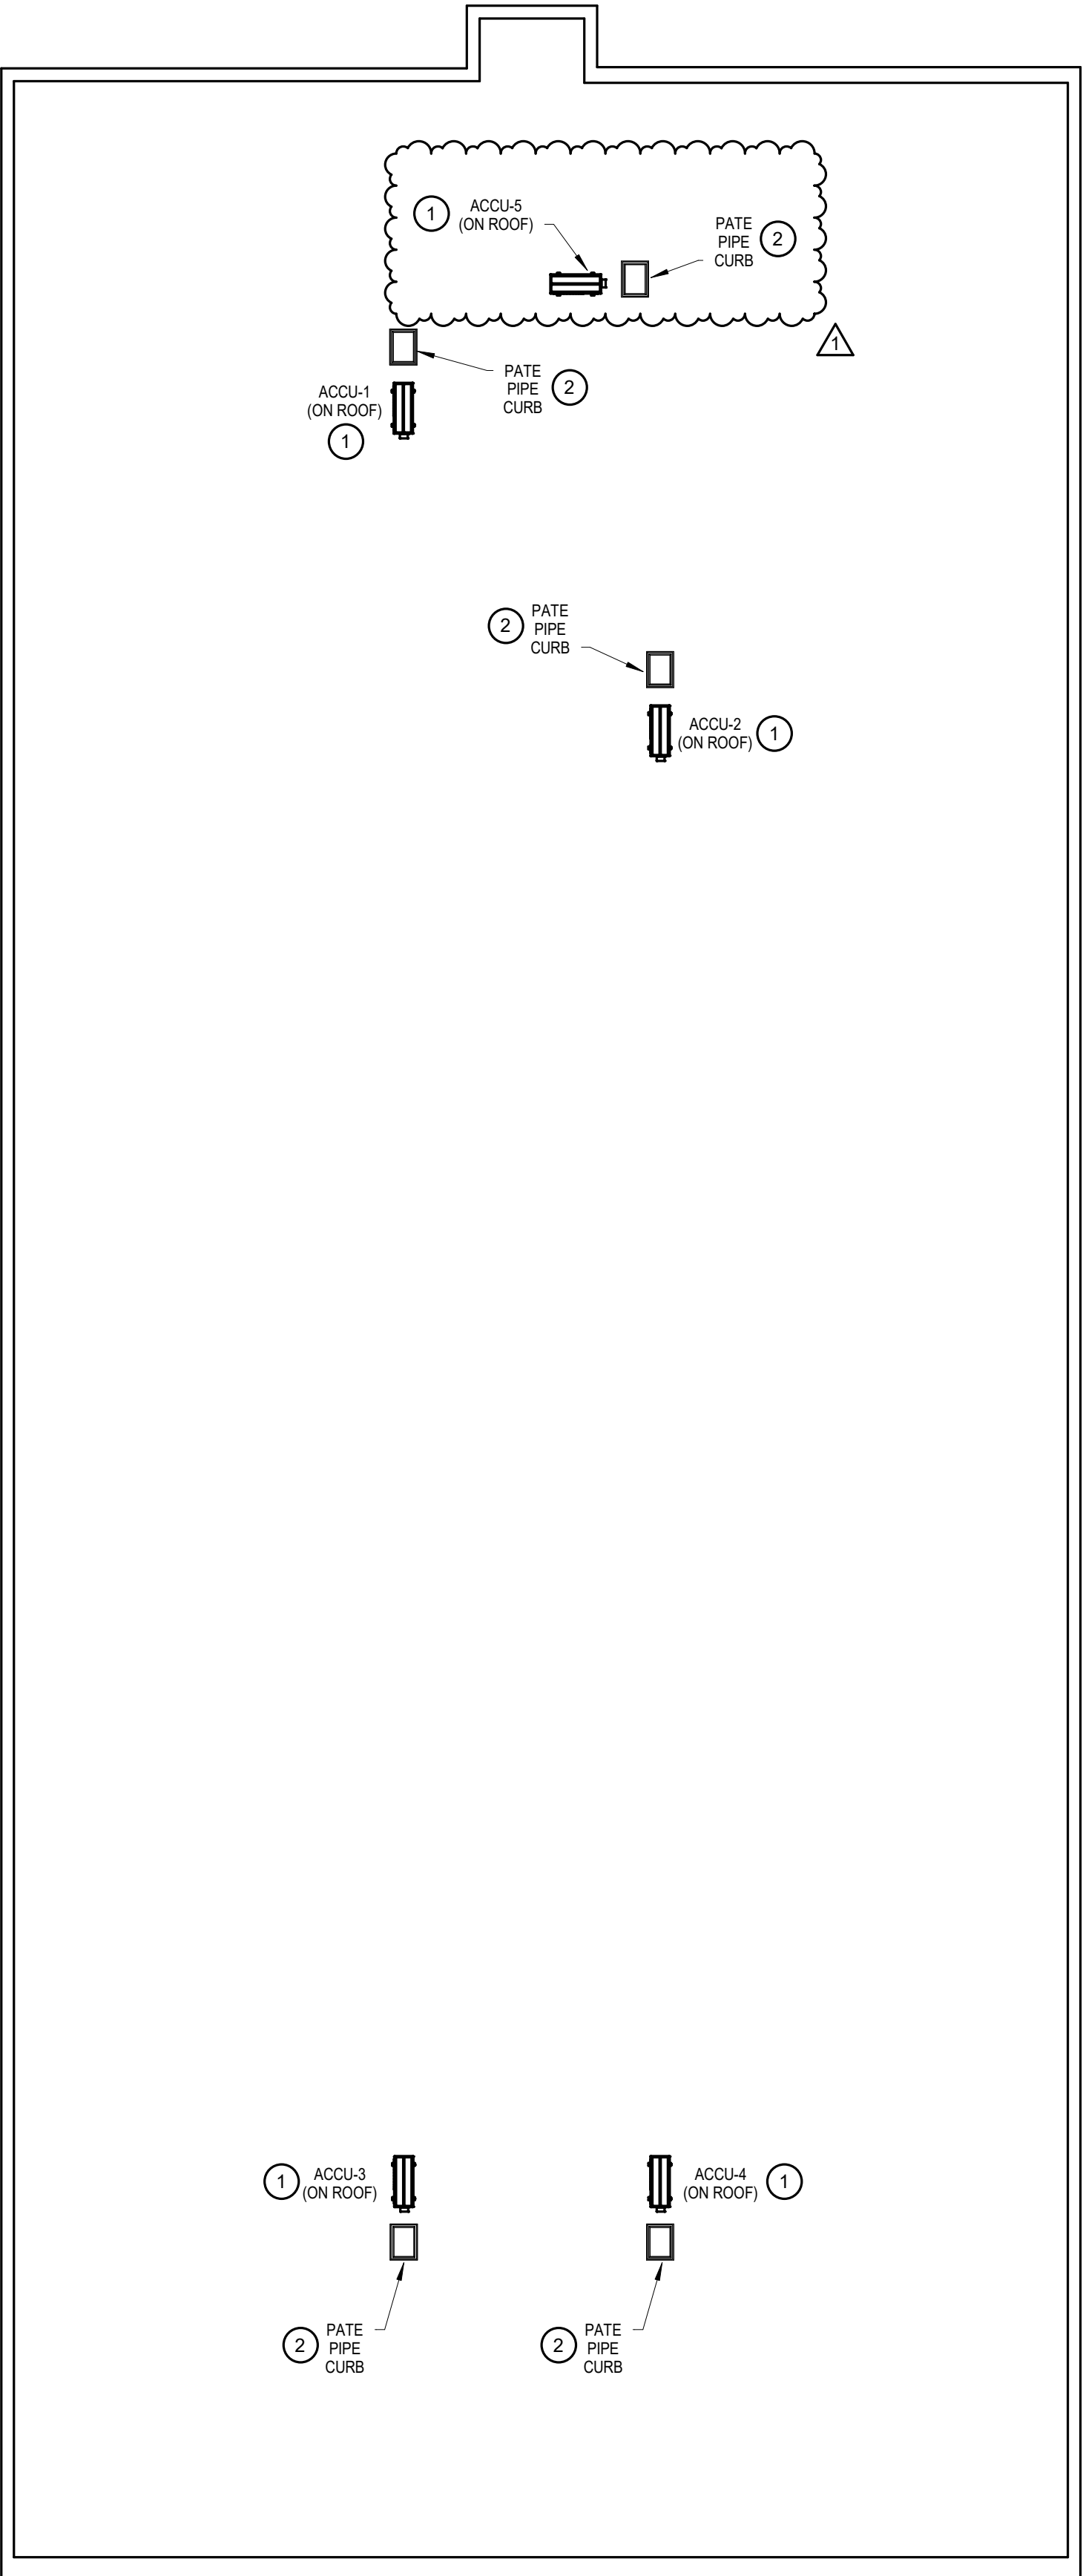

 1
Roof Mechanical Plan - Overall
1/8" = 1'-0"

MECHANICAL PLAN NOTES

- 1 PROVIDE AND INSTALL ACQU ACCORDING TO MANUFACTURERS REQUIREMENTS. INSTALL CONDENSING UNIT ON EQUIPMENT RAILS EQUAL TO PATE MODELS. INSTALL EQUIPMENT RAILS ON ROOF STRUCTURE AND FLASH INTO EXISTING ROOF. PROVIDE WITH STEEL SPRING ISOLATORS. ALLOW CLEARANCES FROM BUILDING STRUCTURE AS REQUIRED BY MANUFACTURER. COORDINATE LOCATION OF CONDENSING UNIT WITH WORK OF OTHER TRADES.
- 2 ROUTE REFRIGERANT LINESET THROUGH NEW PATE PCA PIPE PENETRATION CURB FOR CONNECTION TO MECHANICAL EQUIPMENT BELOW. UTILIZE PATE 'BOOTS' TO MAKE WEATHERTIGHT SEALS AROUND PIPES. APPLY 'UV COATING' TO ARMAFLEX INSULATION INSTALLED OUTDOORS. INSTALL PIPING PER MANUFACTURERS RECOMMENDATION.

**BONA
VITA**


ARCHITECTURE

110 west main street, ste. 200

fort wayne, in 46802

p 260 | 471.9449

www.bonavitaarchitecture.com

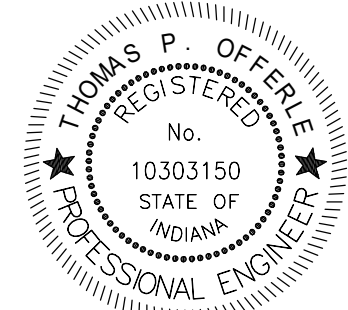

Thomas P. Hoffmann

SCO ENGINEERING, LLC
SOLUTIONS PROVIDED • PROBLEMS SOLVED

FORT WAYNE
SCO Construction Drive
Fort Wayne, IN 46804

(765) 436-9213
(765) 435-5481 fax
scow@sc-engine.com

A Project For:
YWCA Northeast Indiana, Inc.
YWCA The Lofts

1313 W. Washington Center Road, Fort Wayne, IN 46825

eliminating racism
empowering women
ywca
Northeast Indiana

mark	date	description
1	01-022 -24	Addendum #1

This is an original design created by BONA VITA ARCHITECTURE. The ideas, concepts, designs, plans and details included or referenced in this document are owned by and are property of BONA VITA ARCHITECTURE, INC. and may contain proprietary and confidential information. This document and its contents shall be used or disclosed to, by any person, firm, or corporation for any purpose whatsoever without written permission of BONA VITA ARCHITECTURE, INC. Written permission on these drawings shall have precedence over any other permission. Contractors shall verify and be responsible for all dimensions and conditions on the job and BONA VITA ARCHITECTURE, INC. shall not be held liable for any errors or omissions on the drawings and specifications for these drawings. These drawings must be submitted to BONA VITA ARCHITECTURE, INC. for approval before construction.

Project Number 230495 (232722)

Date December 21, 2023

Drawn By RHH

Checked By BAB


Roof Mechanical Plan

M2.02

2/26/24 10:29:20 AM YWCA The Lofts
C:\Users\jha\Documents\23272 Main Central 02_1\haa@bon-l.com.rvt
Project Status


UNIT HEATER & HANGER DETAIL

NOT TO SCALE (VERIFY HANGER DETAIL W/ MANUFACTURER'S DETAILS)

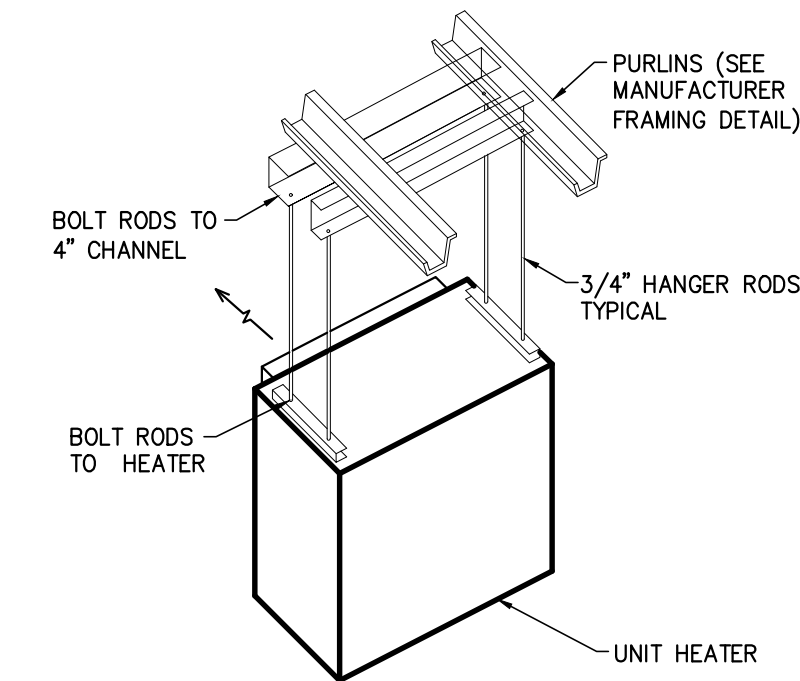


ROOF PIPING PENETRATION CURB DETAIL

NOT TO SCALE

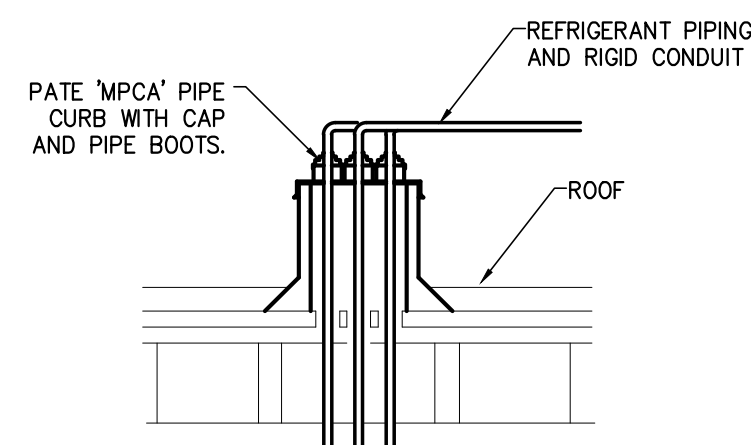


ACCU INSTALLATION DETAIL

NOT TO SCALE

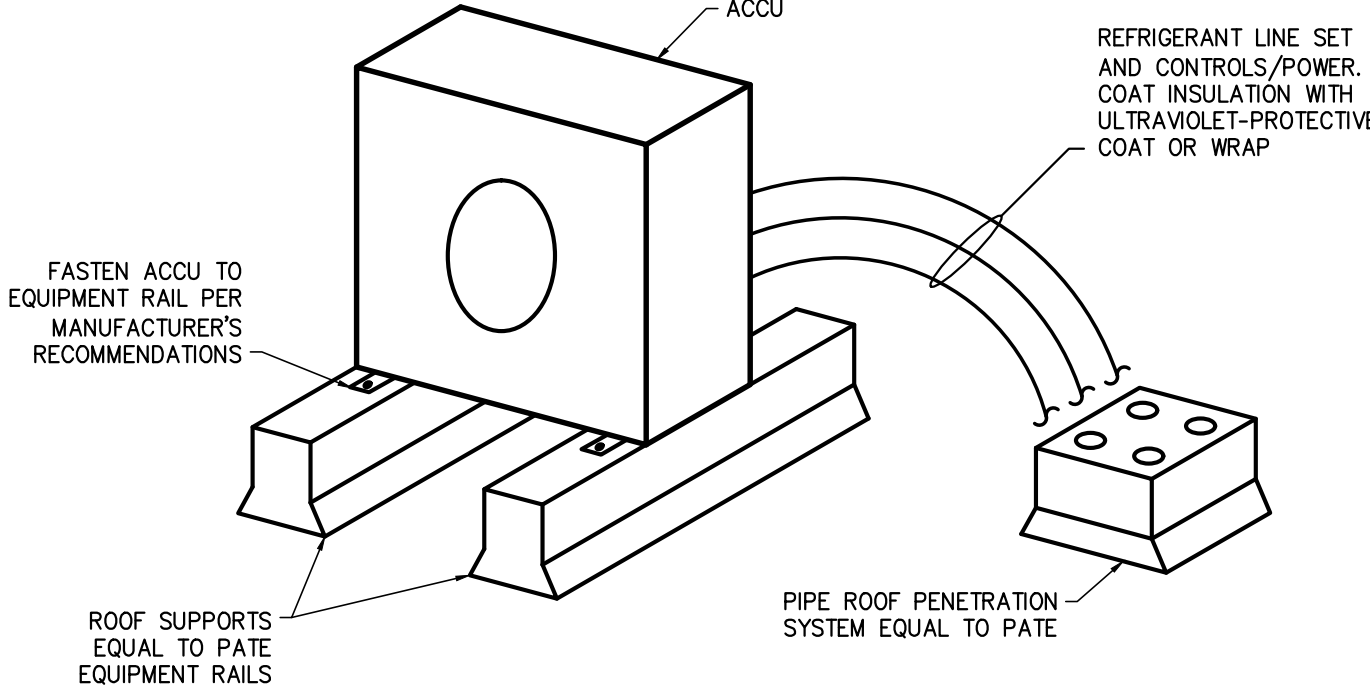

REFRIGERANT PIPING DETAIL

NOT TO SCALE

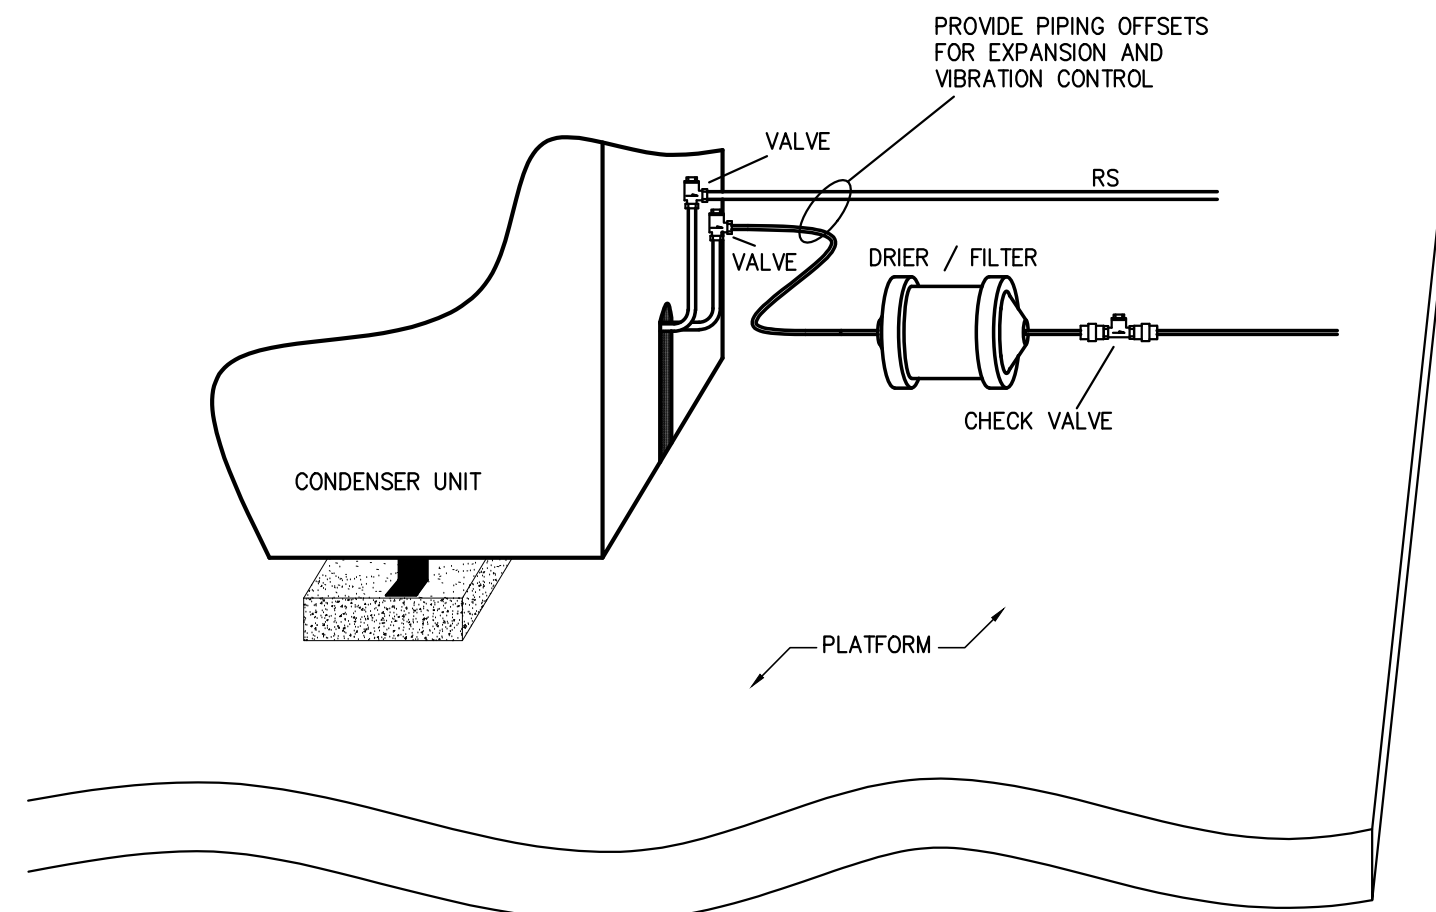

DIFFUSER SCHEDULE

TAG	MFG	MODEL	NECK	FACE	PATT	MAX CFM	MAX PD (TOTAL)	MAX NC	THROW (FEET)	MATERIAL	REMARKS
D-1	TITUS	TBD-80	10"	48" x 10"	1.5" WIDE, 4 SLOT	310	0.08	25	21	STEEL	2, 3, 4, 5
RG-1	TITUS	23RL	22" x 22"	32" x 10"	45° FIXED DEF.	775	0.07	20	-	STEEL	1, 2

REMARKS:

- PROVIDE ALL NECESSARY TRIM AND BORDERS FOR INSTALLATION INTO CEILING TYPES AND WALLS. REFER TO ARCHITECTURAL DRAWINGS FOR ROOM FINISHES.
- PROVIDE AND INSTALL DUCT TRANSITION FITTINGS AS REQUIRED FOR CONNECTION TO DIFFUSERS AND GRILLES.
- DIFFUSERS ARE TO BE HARD CONNECTED TO DUCTWORK AND RIGIDLY SUPPORTED FROM THE BUILDING STRUCTURE ABOVE.
- PROVIDE PLENUM DIFFUSER WITH OPTIONAL INTERNAL INSULATION. PROVIDE AND INSTALL INSULATION ON END CAPS.
- CUSTOM COLOR TO BE SELECTED BY ARCHITECT.

MINI-SPLIT AIR CONDITIONING / HEAT PUMP UNIT SCHEDULE

TAG	MFG	INDOOR UNIT MODEL	OUTDOOR UNIT MODEL	COOLING CAPACITY @ 95 DEG. F.	SEER	HEATING CAPACITY @ 47 DEG. F. BTUH	HEATING CAPACITY @ 17 DEG. F. BTUH	AIR FLOW CFM	MCA	MOCP	ELECTRIC V / PH / Hz	LOCATION	REMARKS	
AC-1.1	MITSUBISHI	NTXWS106B112AA	-	6,000	-	7,200	-	300	-	-	-	BEDROOM 204E	1, 2, 3, 4	
AC-1.2	MITSUBISHI	NTXWS12B112AA	-	12,000	-	14,400	-	380	-	-	-	LIVING 204A	1, 2, 3, 4	
AC-1.3	MITSUBISHI	NTXWS106B112AA	-	6,000	-	7,200	-	300	-	-	-	BEDROOM 204C	1, 2, 3, 4	
ACCU-1	MITSUBISHI	-	NTXMPH24A132CA	23,600	19.0	30,600	25,000	300	-	31.5	40	208/1/60	ROOF	5, 6, 7, 8, 9
AC-2.1	MITSUBISHI	NTXWS106B112AA	-	6,000	-	7,200	-	300	-	-	-	BEDROOM 217E	1, 2, 3, 4	
AC-2.2	MITSUBISHI	NTXWS12B112AA	-	12,000	-	14,400	-	380	-	-	-	LIVING 217A	1, 2, 3, 4	
AC-2.3	MITSUBISHI	NTXWS106B112AA	-	6,000	-	7,200	-	300	-	-	-	BEDROOM 217C	1, 2, 3, 4	
ACCU-2	MITSUBISHI	-	NTXMPH24A132CA	23,600	19.0	30,600	25,000	300	-	31.5	40	208/1/60	ROOF	5, 6, 7, 8, 9
AC-3.1	MITSUBISHI	NTXWS106B112AA	-	6,000	-	7,200	-	300	-	-	-	BEDROOM 211E	1, 2, 3, 4	
AC-3.2	MITSUBISHI	NTXWS12B112AA	-	12,000	-	14,400	-	380	-	-	-	LIVING 211A	1, 2, 3, 4	
AC-3.3	MITSUBISHI	NTXWS106B112AA	-	6,000	-	7,200	-	300	-	-	-	BEDROOM 211C	1, 2, 3, 4	
ACCU-3	MITSUBISHI	-	NTXMPH24A132CA	23,600	19.0	30,600	25,000	300	-	31.5	40	208/1/60	ROOF	5, 6, 7, 8, 9
AC-4.1	MITSUBISHI	NTXWS106B112AA	-	6,000	-	7,200	-	300	-	-	-	BEDROOM 212E	1, 2, 3, 4	
AC-4.2	MITSUBISHI	NTXWS12B112AA	-	12,000	-	14,400	-	380	-	-	-	LIVING 212A	1, 2, 3, 4	
AC-4.3	MITSUBISHI	NTXWS106B112AA	-	6,000	-	7,200	-	300	-	-	-	BEDROOM 212C	1, 2, 3, 4	
ACCU-4	MITSUBISHI	-	NTXMPH24A132CA	23,600	19.0	30,600	25,000	300	-	31.5	40	208/1/60	ROOF	5, 6, 7, 8, 9
AC-5.1	MITSUBISHI	PEAD-A30AAB	-	30,000	17.4	32,000	21,000	880	-	-	-	STAIR 201/CORRIDOR 202	2, 4, 8, 9, 10	
ACCU-5	MITSUBISHI	SUZ-KA30NAHZ	-	30,000	17.4	32,000	21,000	880	-	24	40	208/1/60	ROOF	2, 4, 8, 11

REMARKS:

- PROVIDE AND INSTALL WALL MOUNTED, INDOOR UNIT THAT IS TO BE POWERED FROM THE OUTDOOR UNIT WITH POWER FAILURE AUTOMATIC RESTART, AUTOMATIC CHANGE OVER, AND DISCONNECT SWITCH FOR INDOOR UNIT.
- PROVIDE AND INSTALL UNIT WITH CONDENSATE REMOVAL PUMP LIKE BLUE DIAMOND (ADVANCED) MINI CONDENSATE PUMP W/ RESERVOIR LIKE MODEL #W57-721 AND CONDENSATE DRAIN PAN LEVEL SENSOR/CONTROL FOR CONDENSATE REMOVAL.
- PROVIDE AND INSTALL ADDITIONAL CONTROL CABLE AS REQUIRED TO BE INSTALLED BETWEEN THE CONDENSATE PUMP AND RESERVOIR FOR CONDENSATE PUMP CONTROL.
- PROVIDE AND INSTALL WITH WHITE PVC "LINE HIDE" CONDUIT SYSTEM TO CONCEAL ALL PIPING/WIRING IN EXPOSED LOCATIONS.
- PROVIDE AND INSTALL UNIT WITH WALL MOUNTED, REMOTE WIRED THERMOSTAT LIKE MODEL #TAC-YT530RAU-4, SYSTEM CONTROL INTERFACE LIKE MODEL #MAC-534F-E, AND ALL REQUIRED ACCESSORIES AND INTERCONNECTING WIRING.
- PROVIDE AND INSTALL OUTDOOR MULTI-ZONE HEAT PUMP UNIT WITH VARIABLE SPEED INVERTER-DRIVEN COMPRESSOR, HYPER-HEATING PERFORMANCE, BUILT-IN BASE PAN HEATER, FAN MOTOR OVERHEATING/VOLTAGE PROTECTION, COMPRESSOR OVERCURRENT DETECTION, COMPRESSOR THERMAL PROTECTION, HIGH-PRESSURE PROTECTION, AND ALL DEVICES AND INTERLOCK WIRING REQUIRED FOR CONNECTION BETWEEN THE OUTDOOR AND INDOOR UNIT.
- PROVIDE AND INSTALL UNIT WITH OPTIONAL AIR OUTLET GRILLE FOR LOW AMBIENT OPERATION AND 18" TALL OUTDOOR UNIT STAND.
- ELECTRICAL CONTRACTOR SHALL PROVIDE AND INSTALL A DISCONNECT SWITCH FOR THE OUTDOOR UNIT. COORDINATE INSTALLATION LOCATION PRIOR TO THE INITIATION OF ANY WORK.
- PROVIDE AND INSTALL INSULATED REFRIGERATION LINESIZED PER MANUFACTURER'S RECOMMENDATIONS. INSULATION IS TO BE 1/2" THICK, EPDM LIKE ARMAFLEX UT SOLAR EPDM CLOSED CELL INSULATION.
- PROVIDE AND INSTALL UNIT WITH ALL REQUIRED TRANSFORMERS, WIRING, MOUNTING ACCESSORIES AND HARDWARE, AND ACCESSORIES AS REQUIRED FOR A FULLY FUNCTIONING SYSTEM.
- PROVIDE AND INSTALL HORIZONTAL-DUCTED INDOOR UNIT THAT IS TO BE POWERED FROM THE OUTDOOR UNIT WITH POWER FAILURE AUTOMATIC RESTART, AUTOMATIC CHANGE OVER, CONDENSATE DRAIN PAN LEVEL SENSOR/CONTROL, A
- PROVIDE AND INSTALL OUTDOOR UNIT WITH VARIABLE SPEED INVERTER DRIVEN COMPRESSOR, THREE POLE DISCONNECT SWITCH, ALL DEVICES AND INTERLOCK WIRING, AND ADVANCED WIND BAFFLE FOR LOW AMBIENT OPERATION.

PACKAGED TERMINAL AIR CONDITIONER SCHEDULE

TAG	MFG	MODEL	AIR FLOW MAX (CFM)	OUTSIDE AIR (CFM)	CAPACITY MBH	COOLING TEMP. F.	EER	HEAT PUMP CAP. (KW)	HEATING HEAT (KW)	STAGES	MCA	MOCP	ELECT. V / PH	REMARKS
PTAC-1	COMFORT-AIRE	PTHB12F130A	620	50	11.8	95°	10.6	10.5	3	1	7.3	20	208 / 1	1, 2

REMARKS:

- PROVIDE AND INSTALL UNIT WITH WASHABLE FILTER, WALL SLEEVE, ARCHITECTURAL ALUMINUM GRILLE, SUBBASE WITH 20 AMP RECEPTICAL, WIRED WALL STAT, AND 20S-230V NEMA 6-20P CORD WITH PLUG.
- FIELD VERIFY WALL SLEEVE PRIOR TO PURCHASE OF UNIT.

EXHAUST/VENTILATION FAN SCHEDULE

TAG	MFG	MODEL	CFM	HP	WATS	WV	SONES	ELECT. OPERATION	AREA SERVED	REMARKS
EF-1	SOLER & PALAU	POST10XP	10	0.5"	0.05	37.28	900	0.3 115/1	1 & 2 BEDROOM UNIT RRS	1, 2, 3

REMARKS:

- PROVIDE MULTI-SPEED, ENERGY STAR RATED FAN WITH HIGH/LOW SPEED DELAY TIMER.
- PROVIDE UNIT WITH INTERNAL MOUNTED SPEED CONTROL, DISCONNECT SWITCH, HUMIDITY SENSOR, ADJUSTABLE TIME DELAY, AND AUTO FLO FEATURE, AND BACKDRAFT DAMPER.
- PROVIDE WITH ALL REQUIRED MOUNTING HARDWARE FOR INSTALLATION INTO CEILING. REFER TO ARCHITECTURAL DRAWINGS FOR CEILING TYPES.

UNIT HEATER SCHEDULE

TAG	MFG	MODEL	TYPE	KW	MBH	CFM	ELECT	AMPS	LOCATION	REMARKS
UH-1	QMARK	MUH0321-PRO+	SUSPENDED - VERTICAL DOWN FLOW	3	10.2	350	208 / 1	11	MECHANICAL W101	1, 2, 3

REMARKS:

- PROVIDE WALL MOUNTED THERMOSTAT LIKE BERKO MODEL #M601W, LOW VOLTAGE CONTROL, TRANSFORMER, AND ACCESSORIES FOR A FULLY FUNCTIONING SYSTEM.
- PROVIDE AND INSTALL UNIT WITH 2-SPEED FAN SELECTOR SWITCH, AUTOMATIC THERMAL CUTOFF, NON-FUSED DISCONNECT SWITCH.
- PROVIDE AND INSTALL WITH MANUFACTURER SUPPLIED CEILING/WALL MOUNTING BRACKETS AND HARDWARE.

MECHANICAL EQUIPMENT

TAG: KH-1
TYPE: KITCHEN EXHAUST HOOD
MFR: BROWN
MODEL: 41000 SERIES UNDER-CABINET
SIZE: L / W / H = 30" / 17.5" / 6"
ELECT: 120 / 1 (HARDWIRED)
REMARKS: PROVIDE AND INSTALL TWO-SPEED, NON-DUCTED RANGE HOOD. PROVIDE WITH TWO-SPEED FAN SWITCH AND SPERATE LIGHT SWITCH ON FACE OF HOOD. PROVIDE UNIT WITH REMOVABLE COMBINATION GREASE/CHARCOAL FILTER. ARCHITECT TO SELECT COLOR FROM MANUFACTURER'S FULL LINE OF STANDARD COLORS.
TAG: DB-1
TYPE: METAL DRYER BOX
MFR: GUY GRAY
MODEL: DB350
REMARKS: PROVIDE AND INSTALL 22 GAUGE, ALUMINIZED STEEL DRYER BOX TO BE MOUNTED AT A MINIMUM ELEVATION OF 3'-0" A.F.F.

A Project For:
YWCA Northeast Indiana, Inc.
YWCA The Lofts

1313 W. Washington Center Road, Fort Wayne, IN 46825

eliminating racism
empowering women
ywca
Northeast Indiana

mark	date	description
△	01-23-24	ADDENDUM NO. 1

This is an original design created by BONA VITA ARCHITECTURE. The ideas, concepts, designs, colors and details included or referenced in this document are owned by and property of BONA VITA ARCHITECTURE, INC. and shall remain confidential, proprietary and presented for use on, and in connection with this specific project. None of the ideas, concepts, designs, plans and details shall be used or disclosed to, by any person, firm, or corporation for any purpose whatsoever without the written permission of BONA VITA ARCHITECTURE, INC. Written dimensions on these drawings shall have precedence over note dimensions. Contractors shall verify and be responsible for all dimensions and conditions on the job and BONA VITA ARCHITECTURE, INC. shall be notified of any variation from the dimensions and conditions shown by these drawings. Shop drawings must be submitted to BONA VITA ARCHITECTURE for approval before fabrication.

Project Number 230495 (232722)
Date January 11, 2024
Drawn By RHH
Checked By BAB

MECHANICAL
DETAILS AND
SCHEDULES

M6.01

**BONA
VITA**


ARCHITECTURE

110 west main street, ste. 200

fort wayne, in 46802

p 260 | 471.9449

www.bonavitaarchitecture.com

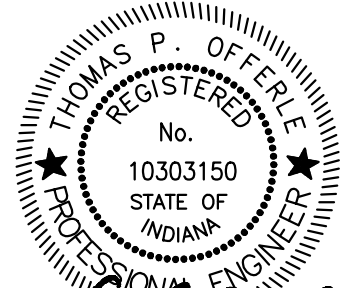


Thomas P. Hoffmann

SCO ENGINEERING, LLC
SOLUTIONS PROVIDED • PROBLEMS SOLVED

FORT WAYNE
6534 Comstock Drive
Fort Wayne, IN 46804

(260) 438-6213
(260) 438-6491 fax
scorfu@seo-llc.com

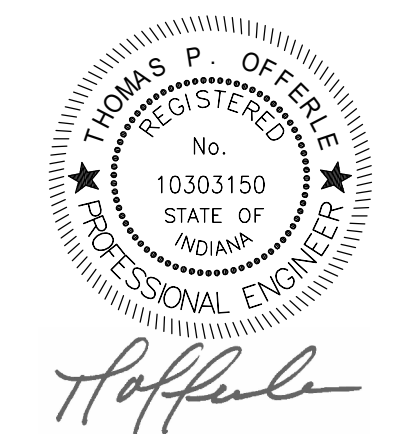

mark	date	description
1	01.23.24	Addendum #01

This is an original design created by BONA VITA ARCHITECTURE. The ideas, concepts, designs, plans and details included or referenced on this document are owned by and are the property of BONA VITA ARCHITECTURE, INC. and are not to be reproduced, copied, or otherwise used without the written consent of BONA VITA ARCHITECTURE, INC. Written dimensions on these drawings shall have precedence over notes, dimensions, or otherwise. Contractors shall verify and be responsible for all dimensions and conditions on the job and BONA VITA ARCHITECTURE, INC. shall not be held responsible for any errors or omissions on the drawings and specifications shown for these drawings. Drawings must be submitted to BONA VITA ARCHITECTURE, INC. for approval before construction.

Project Number 230495(232722)
Date January 11, 2024
Drawn By SJB
Checked By TPO


Second Floor Electrical Systems Plan

ELECTRICAL PLAN NOTES


- EQUIPMENT IS PROVIDED AND INSTALLED BY ANOTHER CONTRACTOR. ELECTRICAL CONTRACTOR SHALL REFER TO ARCHITECTURAL, CIVIL, STRUCTURAL, MECHANICAL, AND PLUMBING DRAWING SHEETS TO COORDINATE THE EXACT LOCATION OF EQUIPMENT WITH EQUIPMENT PROVIDER. ELECTRICAL CONTRACTOR SHALL TERMINATE EQUIPMENT AS REQUIRED WHERE NO STARTERS, DISCONNECTS, OR SWITCHES ARE INDICATED. THEY WILL BE FACTORY MOUNTED AND LOAD-SIDE WIRED.
- REFER TO SHEET E2.01 FOR MORE DETAILS.
- ELECTRICAL CONTRACTOR SHALL TERMINATE 3/4" 2-#10, 1-#10G FROM ACCU-5 TO ACC-5.1. COORDINATE ALL WORK WITH GENERAL CONTRACTOR FOR A COMPLETE AND FUNCTIONAL SYSTEM.
- TERMINATE TO RECEPTABLE CIRCUIT SERVING LIVING ROOM.
- EXISTING FIRE ALARM DEVICES PER PHASE-1 DOCUMENTS, TYPICAL.
- SMOKE DETECTOR WITH CONTROL MODULE BASE SHALL BE INTEGRATED WITH ELEVATOR CONTROLLER SUCH THAT UPON FIRE ALARM SYSTEM ACTIVATION, ELEVATOR TRAVELS TO PREDETERMINED FLOOR.
- 3/4" 2-#12, 1-#12G TERMINATED FOR A COMPLETE AND FUNCTIONAL SYSTEM.

PROVIDE AND INSTALL NEW FIRE ALARM DEVICES AS INDICATED ON DRAWINGS. DEVICES SHALL MATCH EXISTING MANUFACTURER. PROVIDE AND INSTALL ALL REQUIRED NEW INITIATION AND SIGNAL CIRCUITS. PROVIDE SHOP DRAWINGS FOR ALL DEVICES AND FIRE ALARM CIRCUITS. RE-PROGRAM AND RE-CERTIFY FIRE ALARM TO MEET ALL NATIONAL, STATE, AND LOCAL CODES FOR A COMPLETE AND FUNCTIONAL SYSTEM. COORDINATE ALL WORK WITH GENERAL CONTRACTOR.


THE ELECTRICAL CONTRACTOR IS TO COORDINATE ALL EXACT REQUIREMENTS WITH THE ELEVATOR INSTALLER PRIOR TO BID AND INCLUDE IN HIS BID ALL REQUIRED NEW COMPONENTS, FIRE ALARM DEVICES, CONTACTS, ETC., AS REQUIRED FOR A COMPLETELY FUNCTIONAL, CODE COMPLIANT INSTALLATION.

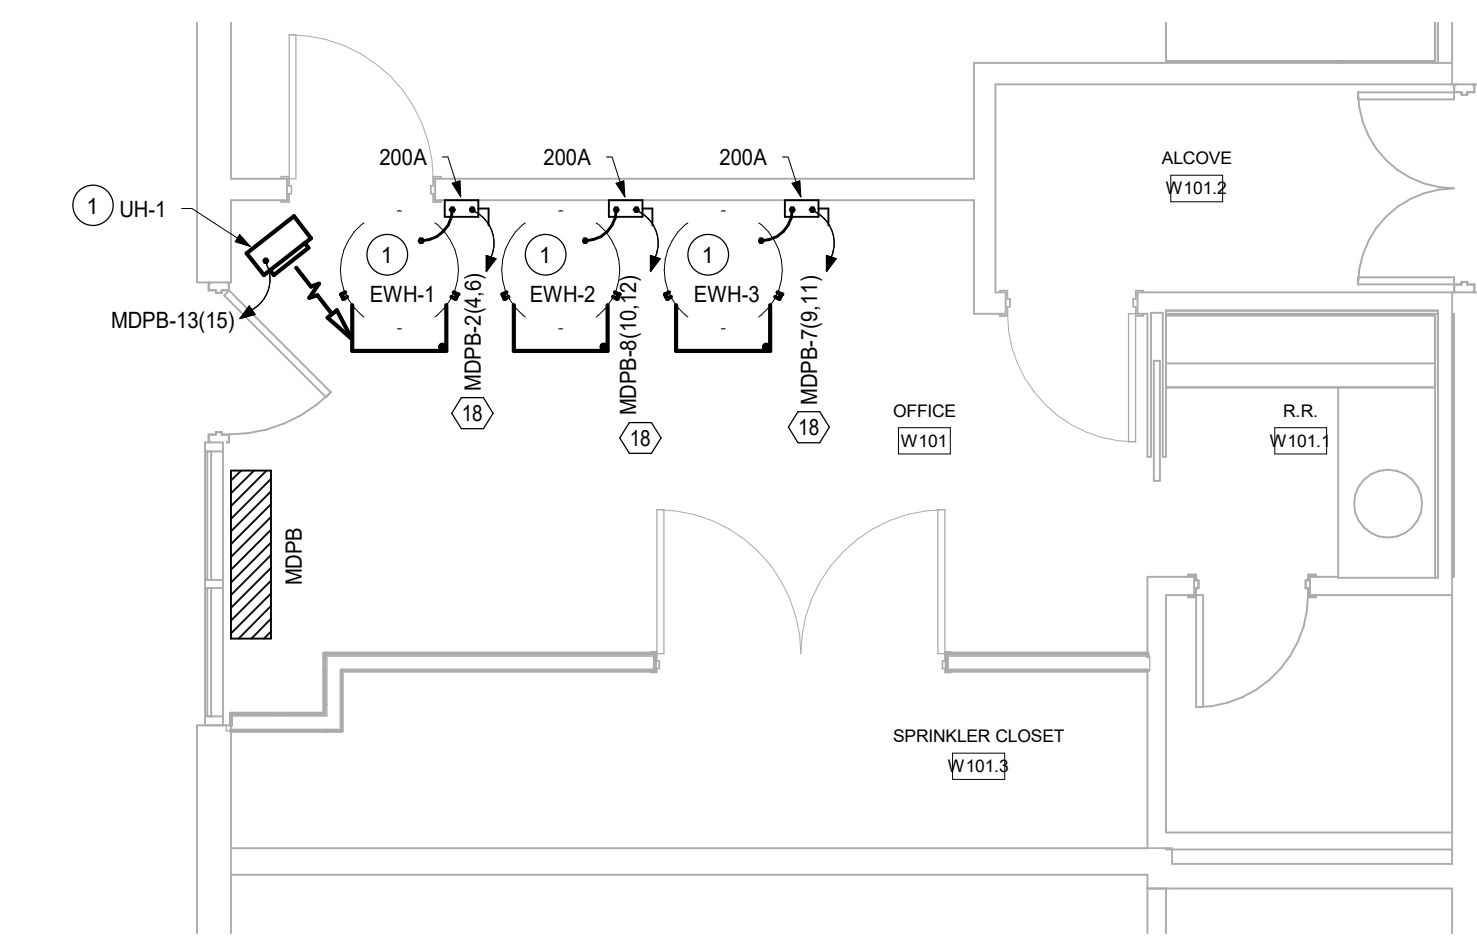


Partial First Floor
Electrical Systems Plan - Mechanical Room
1/4" = 1'-0"

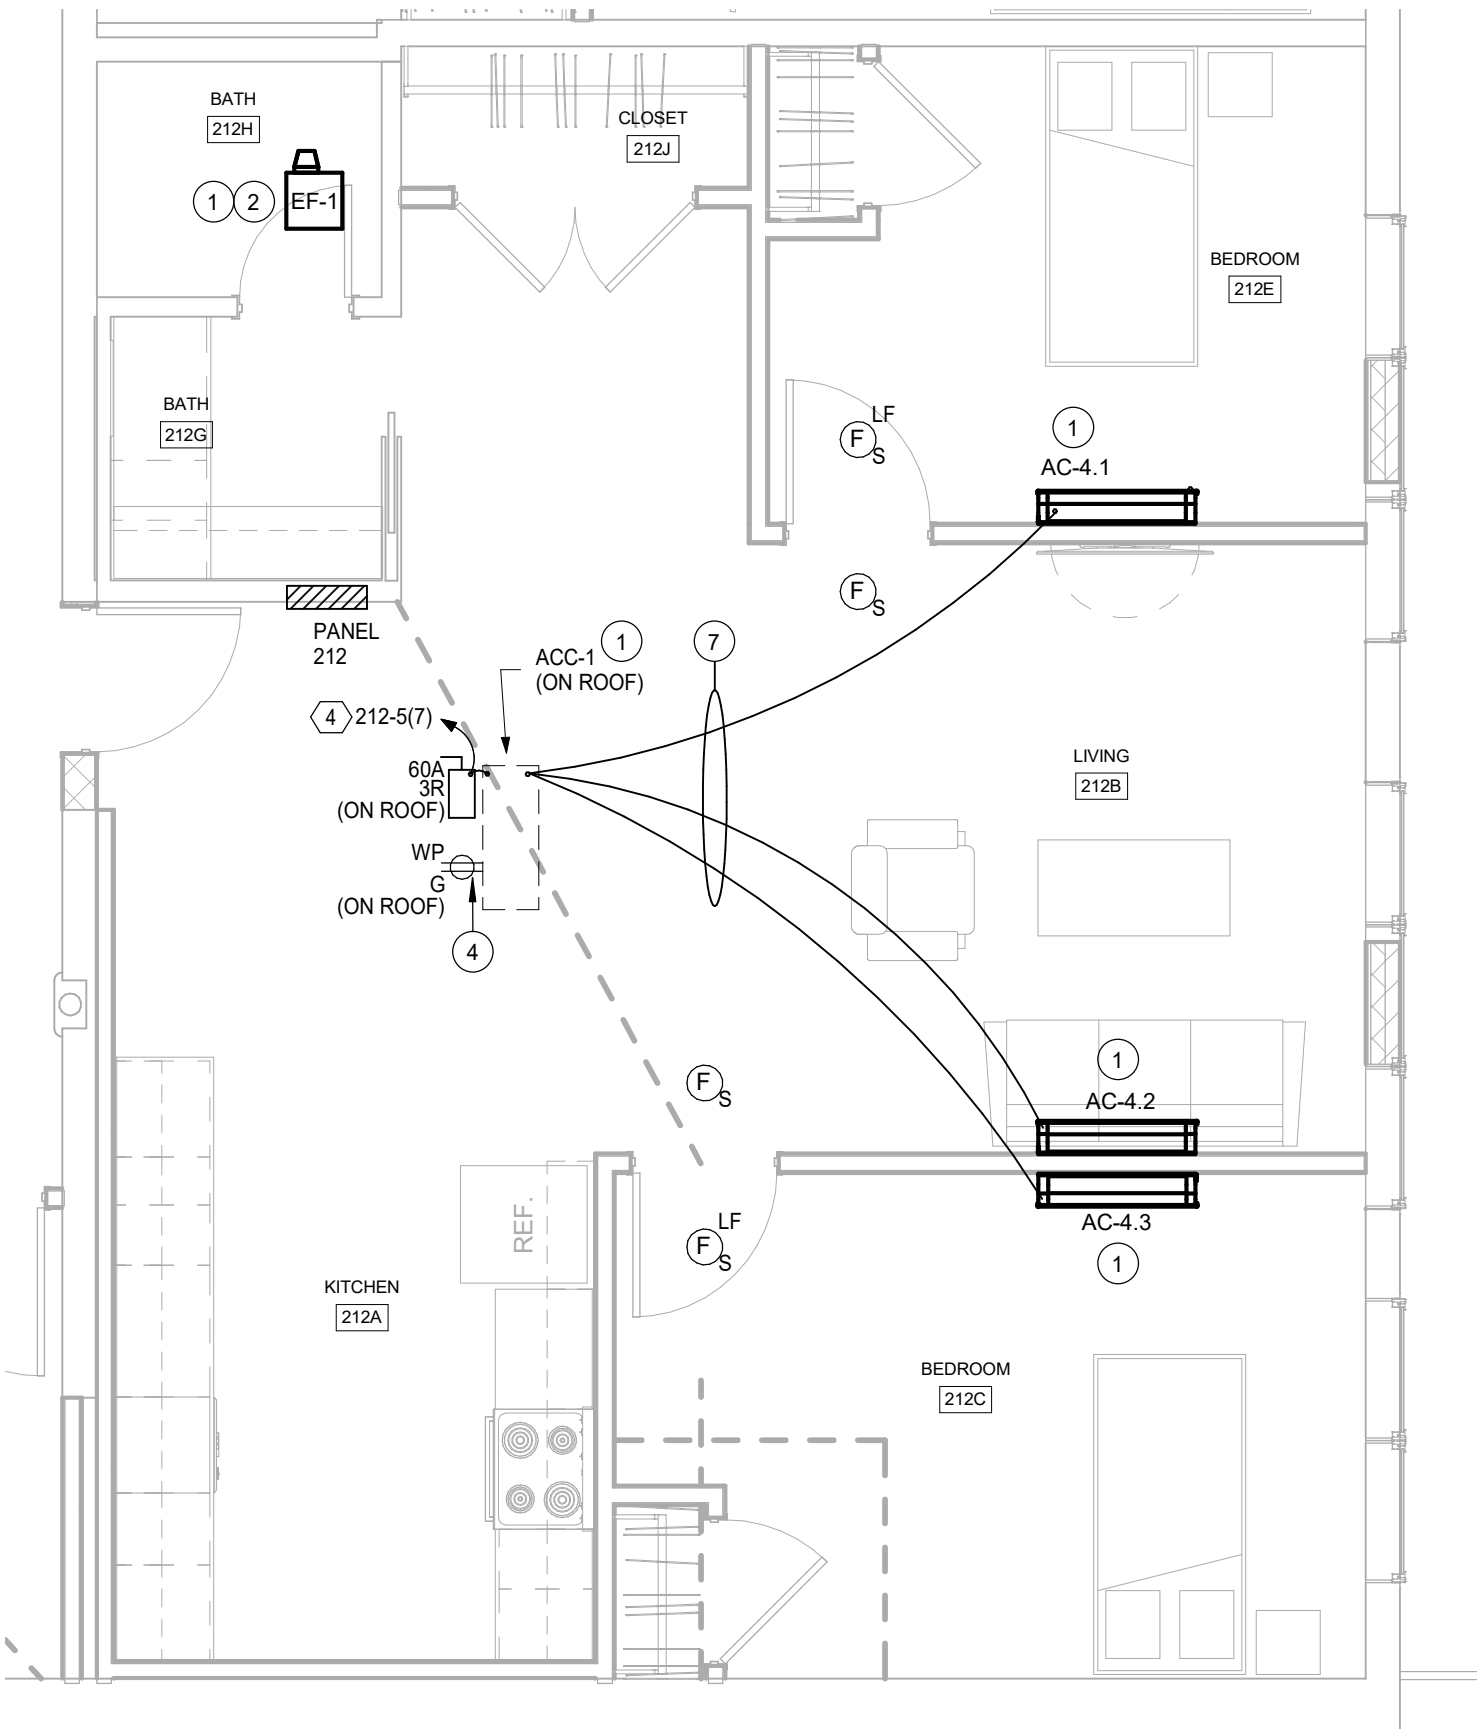


Partial Second Floor
Electrical Systems Plan - Room 212
1/4" = 1'-0"

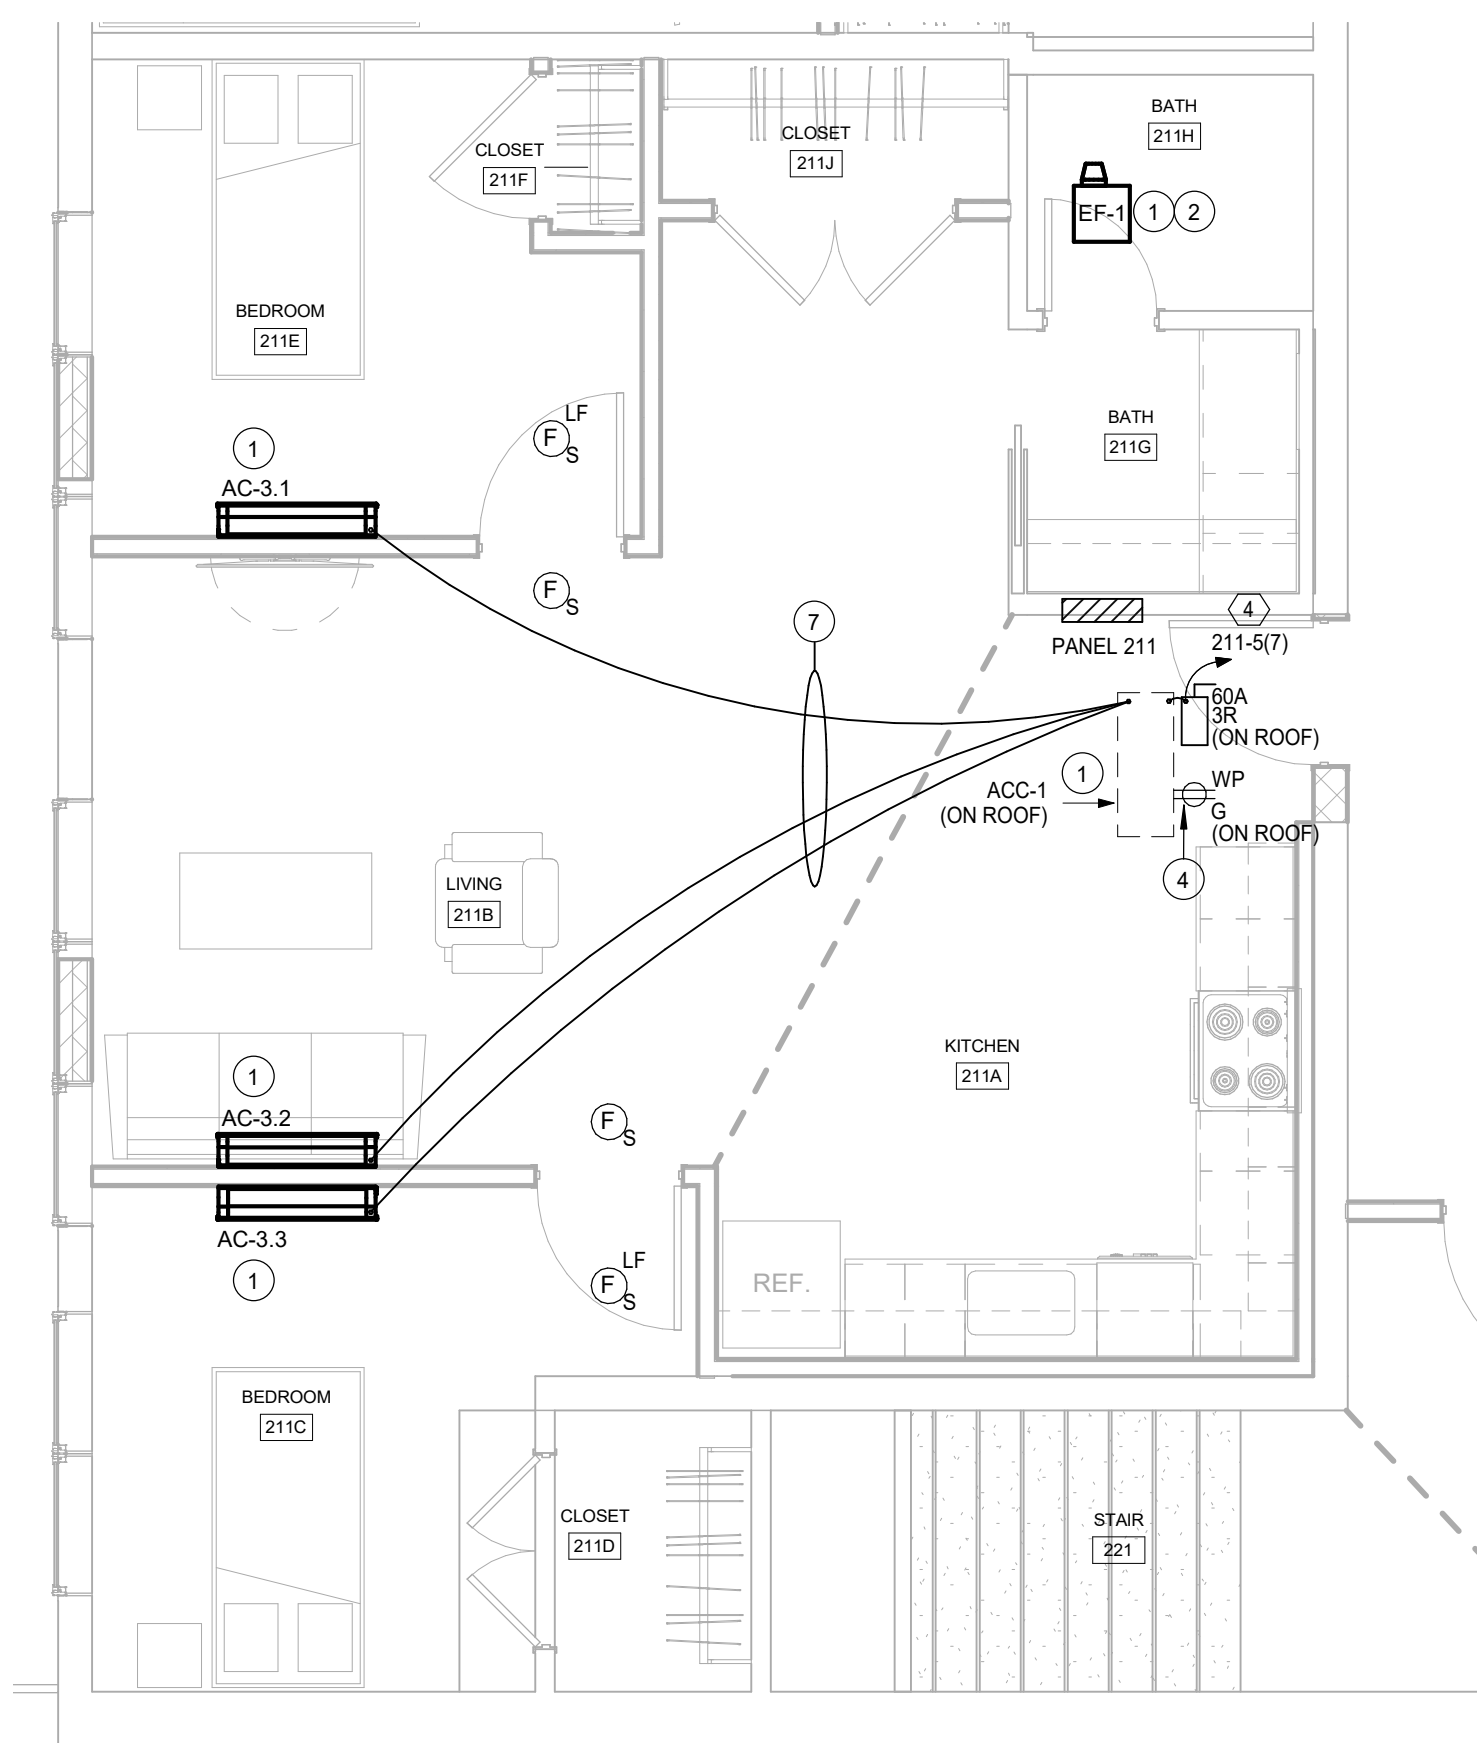


Partial Second Floor
Electrical Systems Plan - Room 211
1/4" = 1'-0"

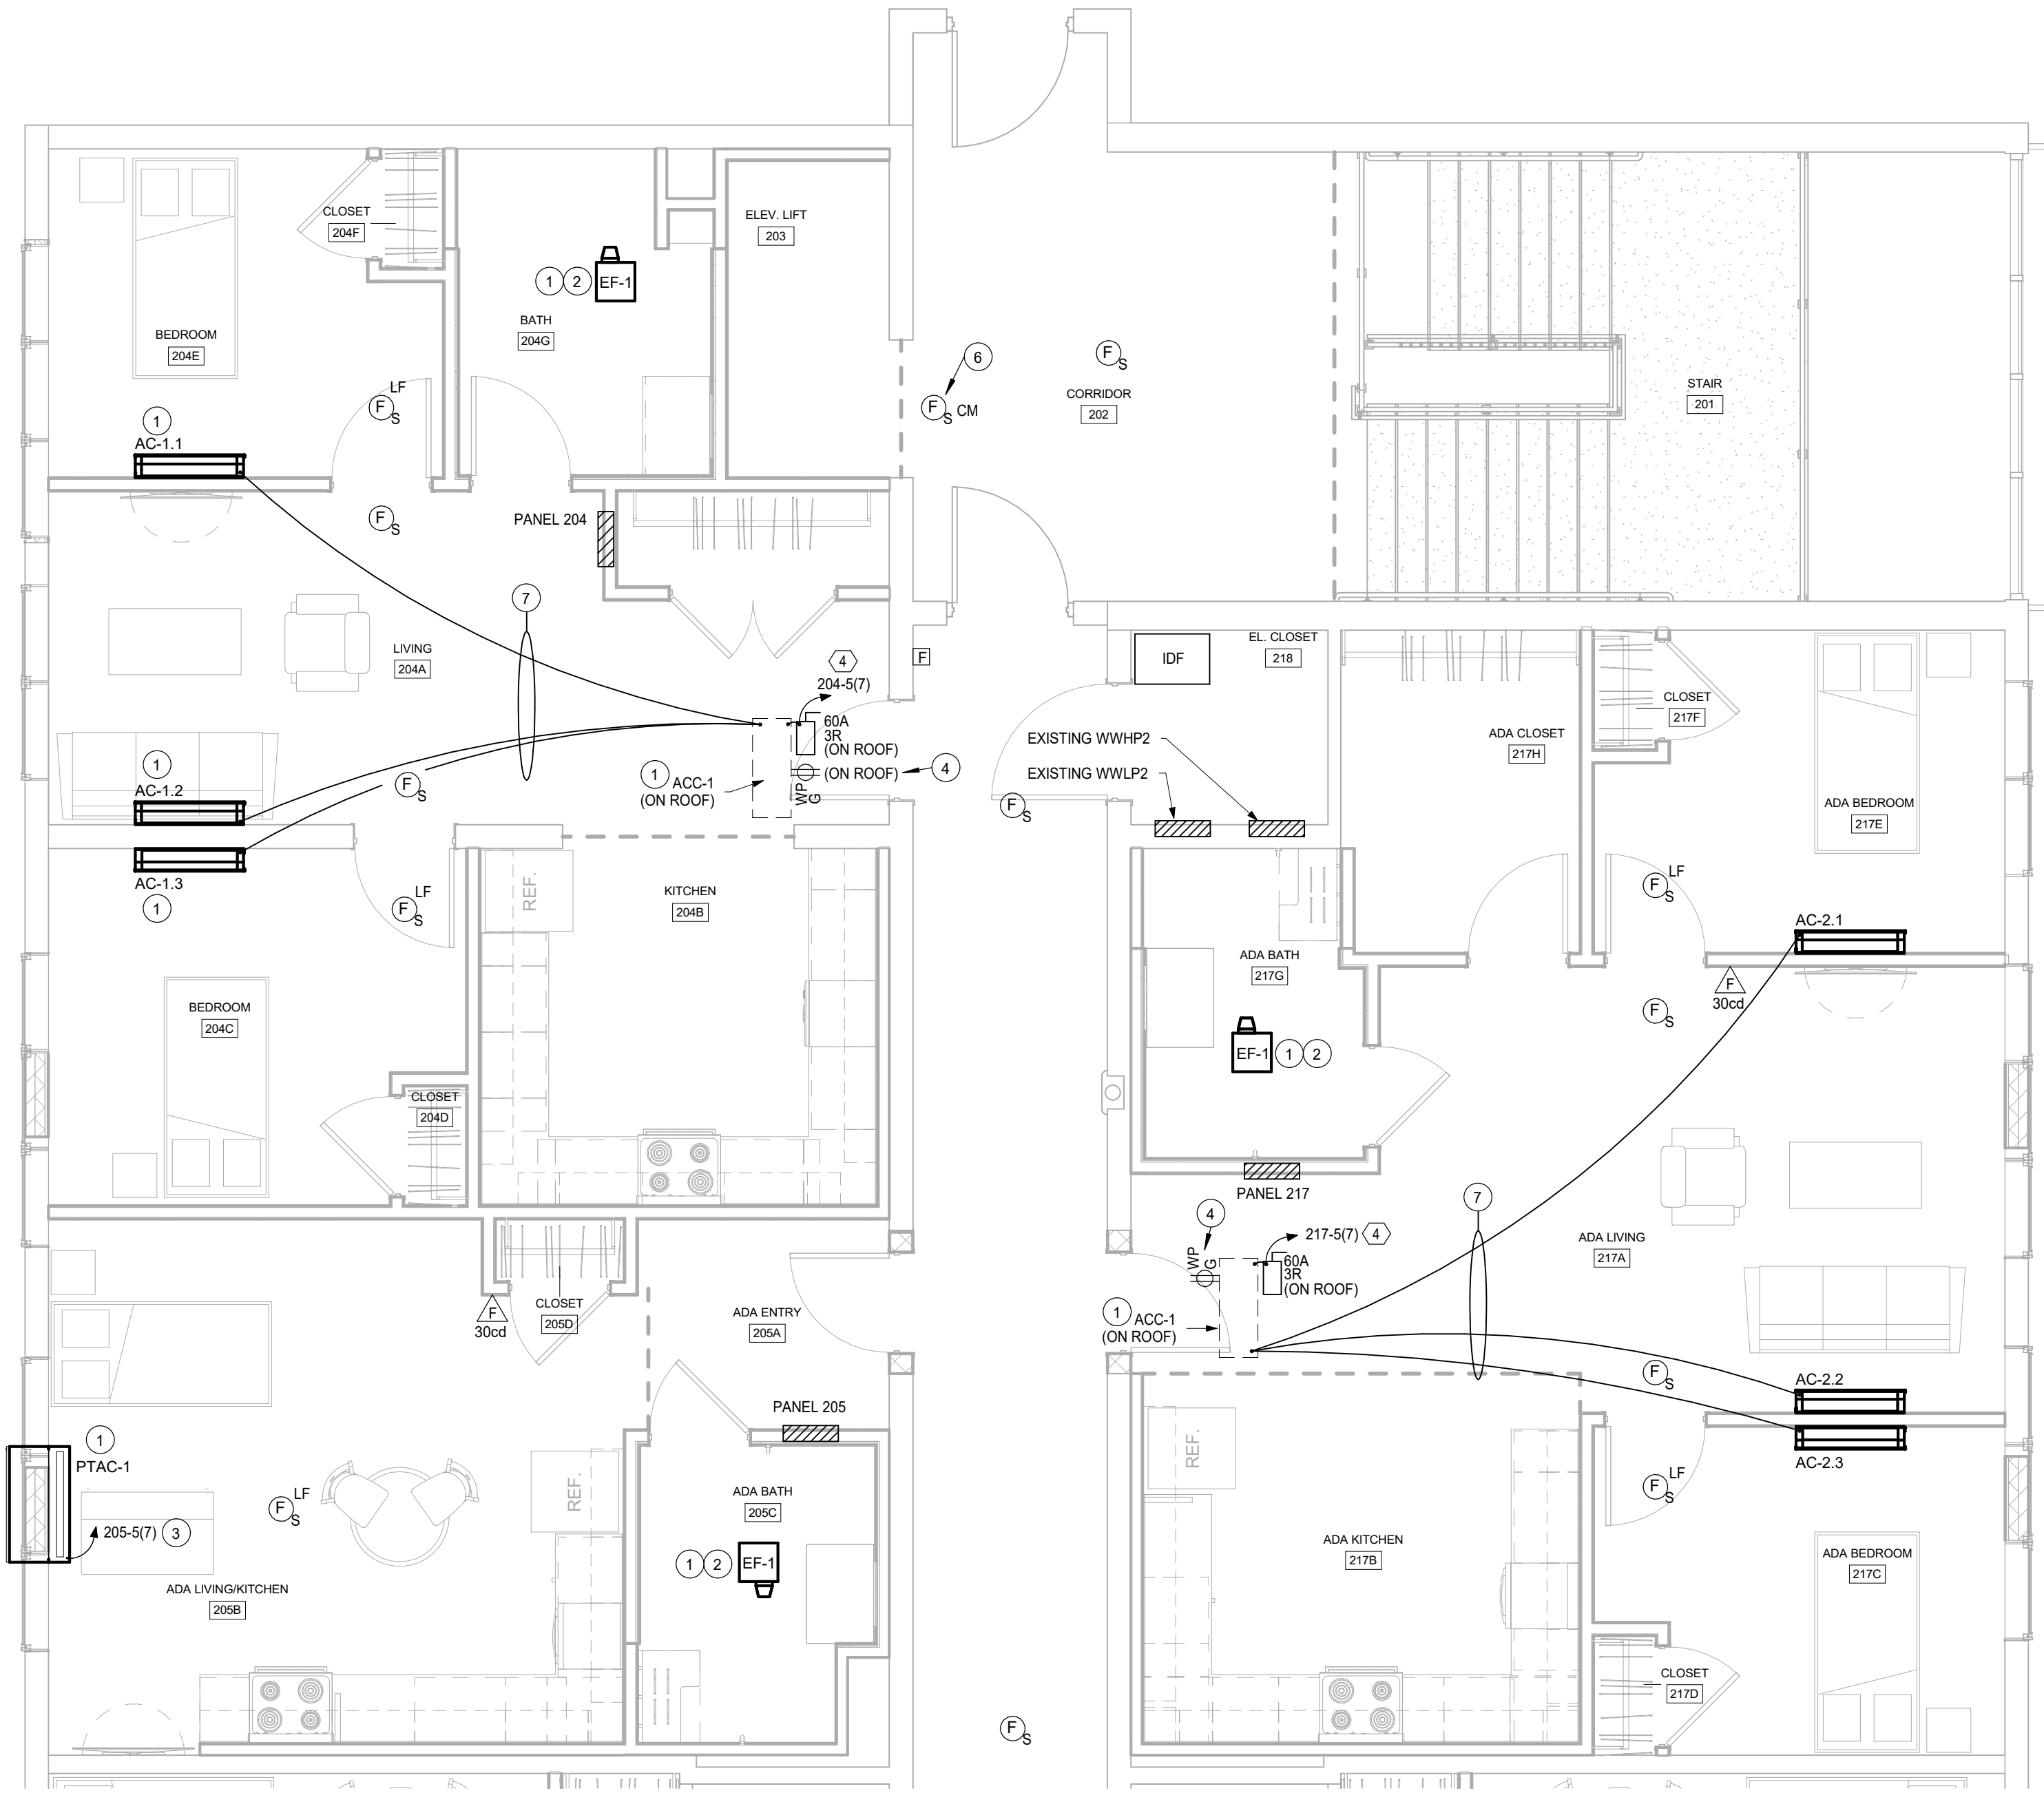


Partial Second Floor Electrical Systems Plan - ADA Rooms
1/4" = 1'-0"

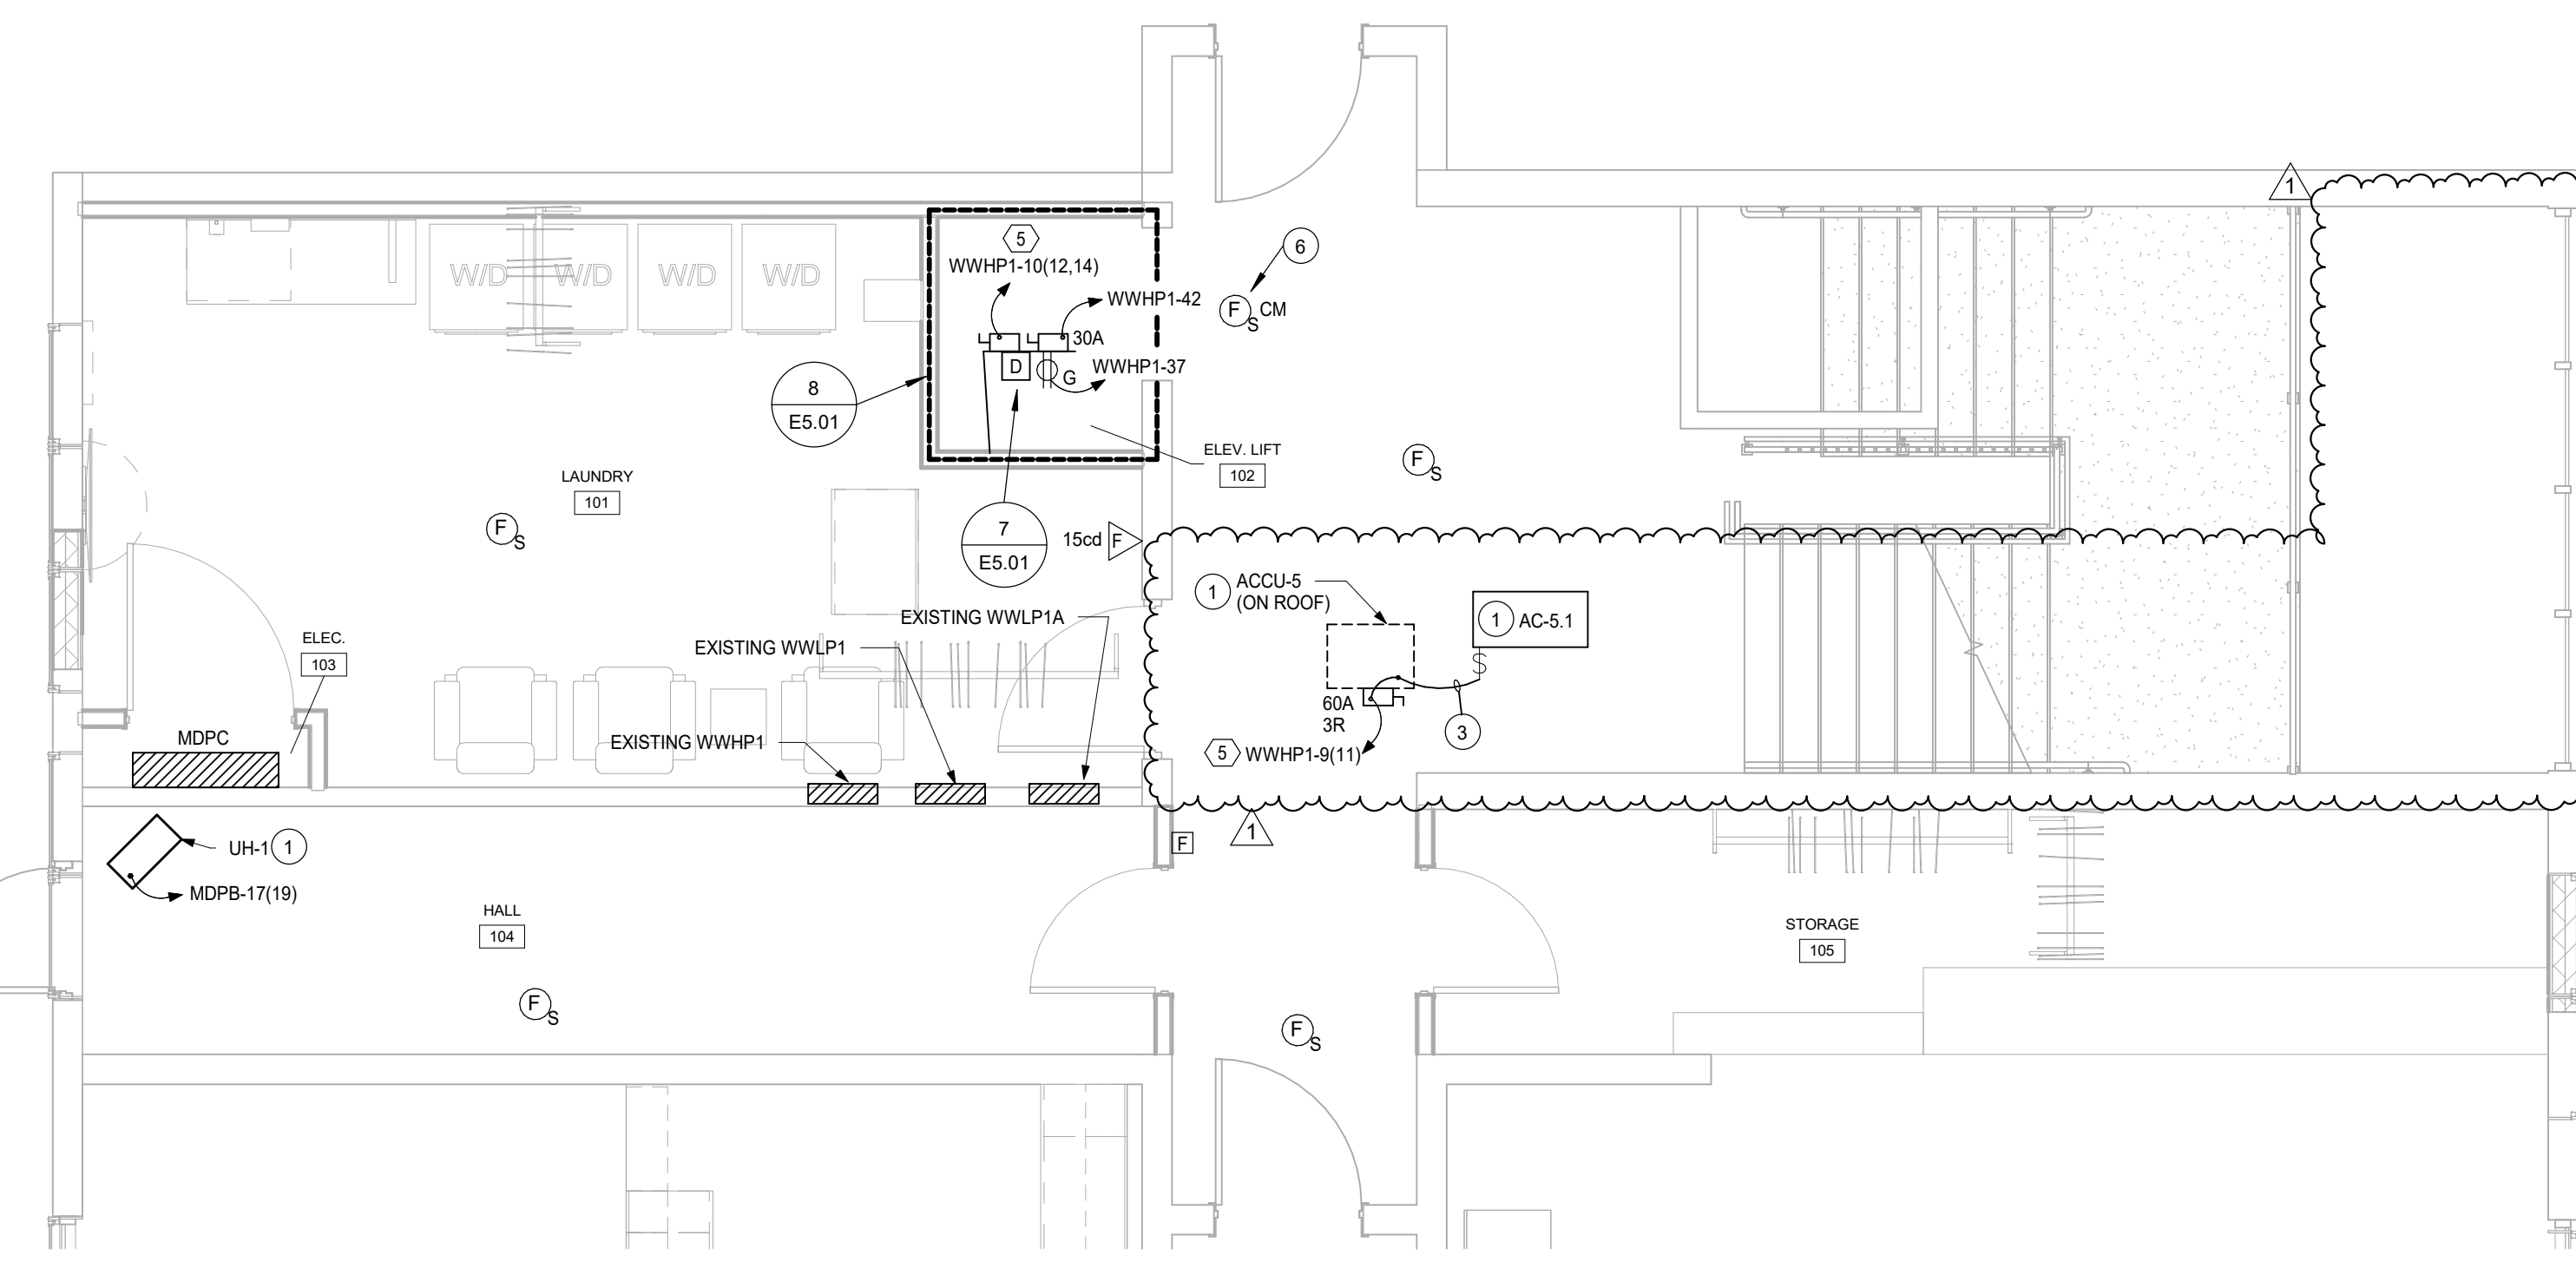


Partial First Floor Electrical Systems Plan - Laundry Room
1/4" = 1'-0"

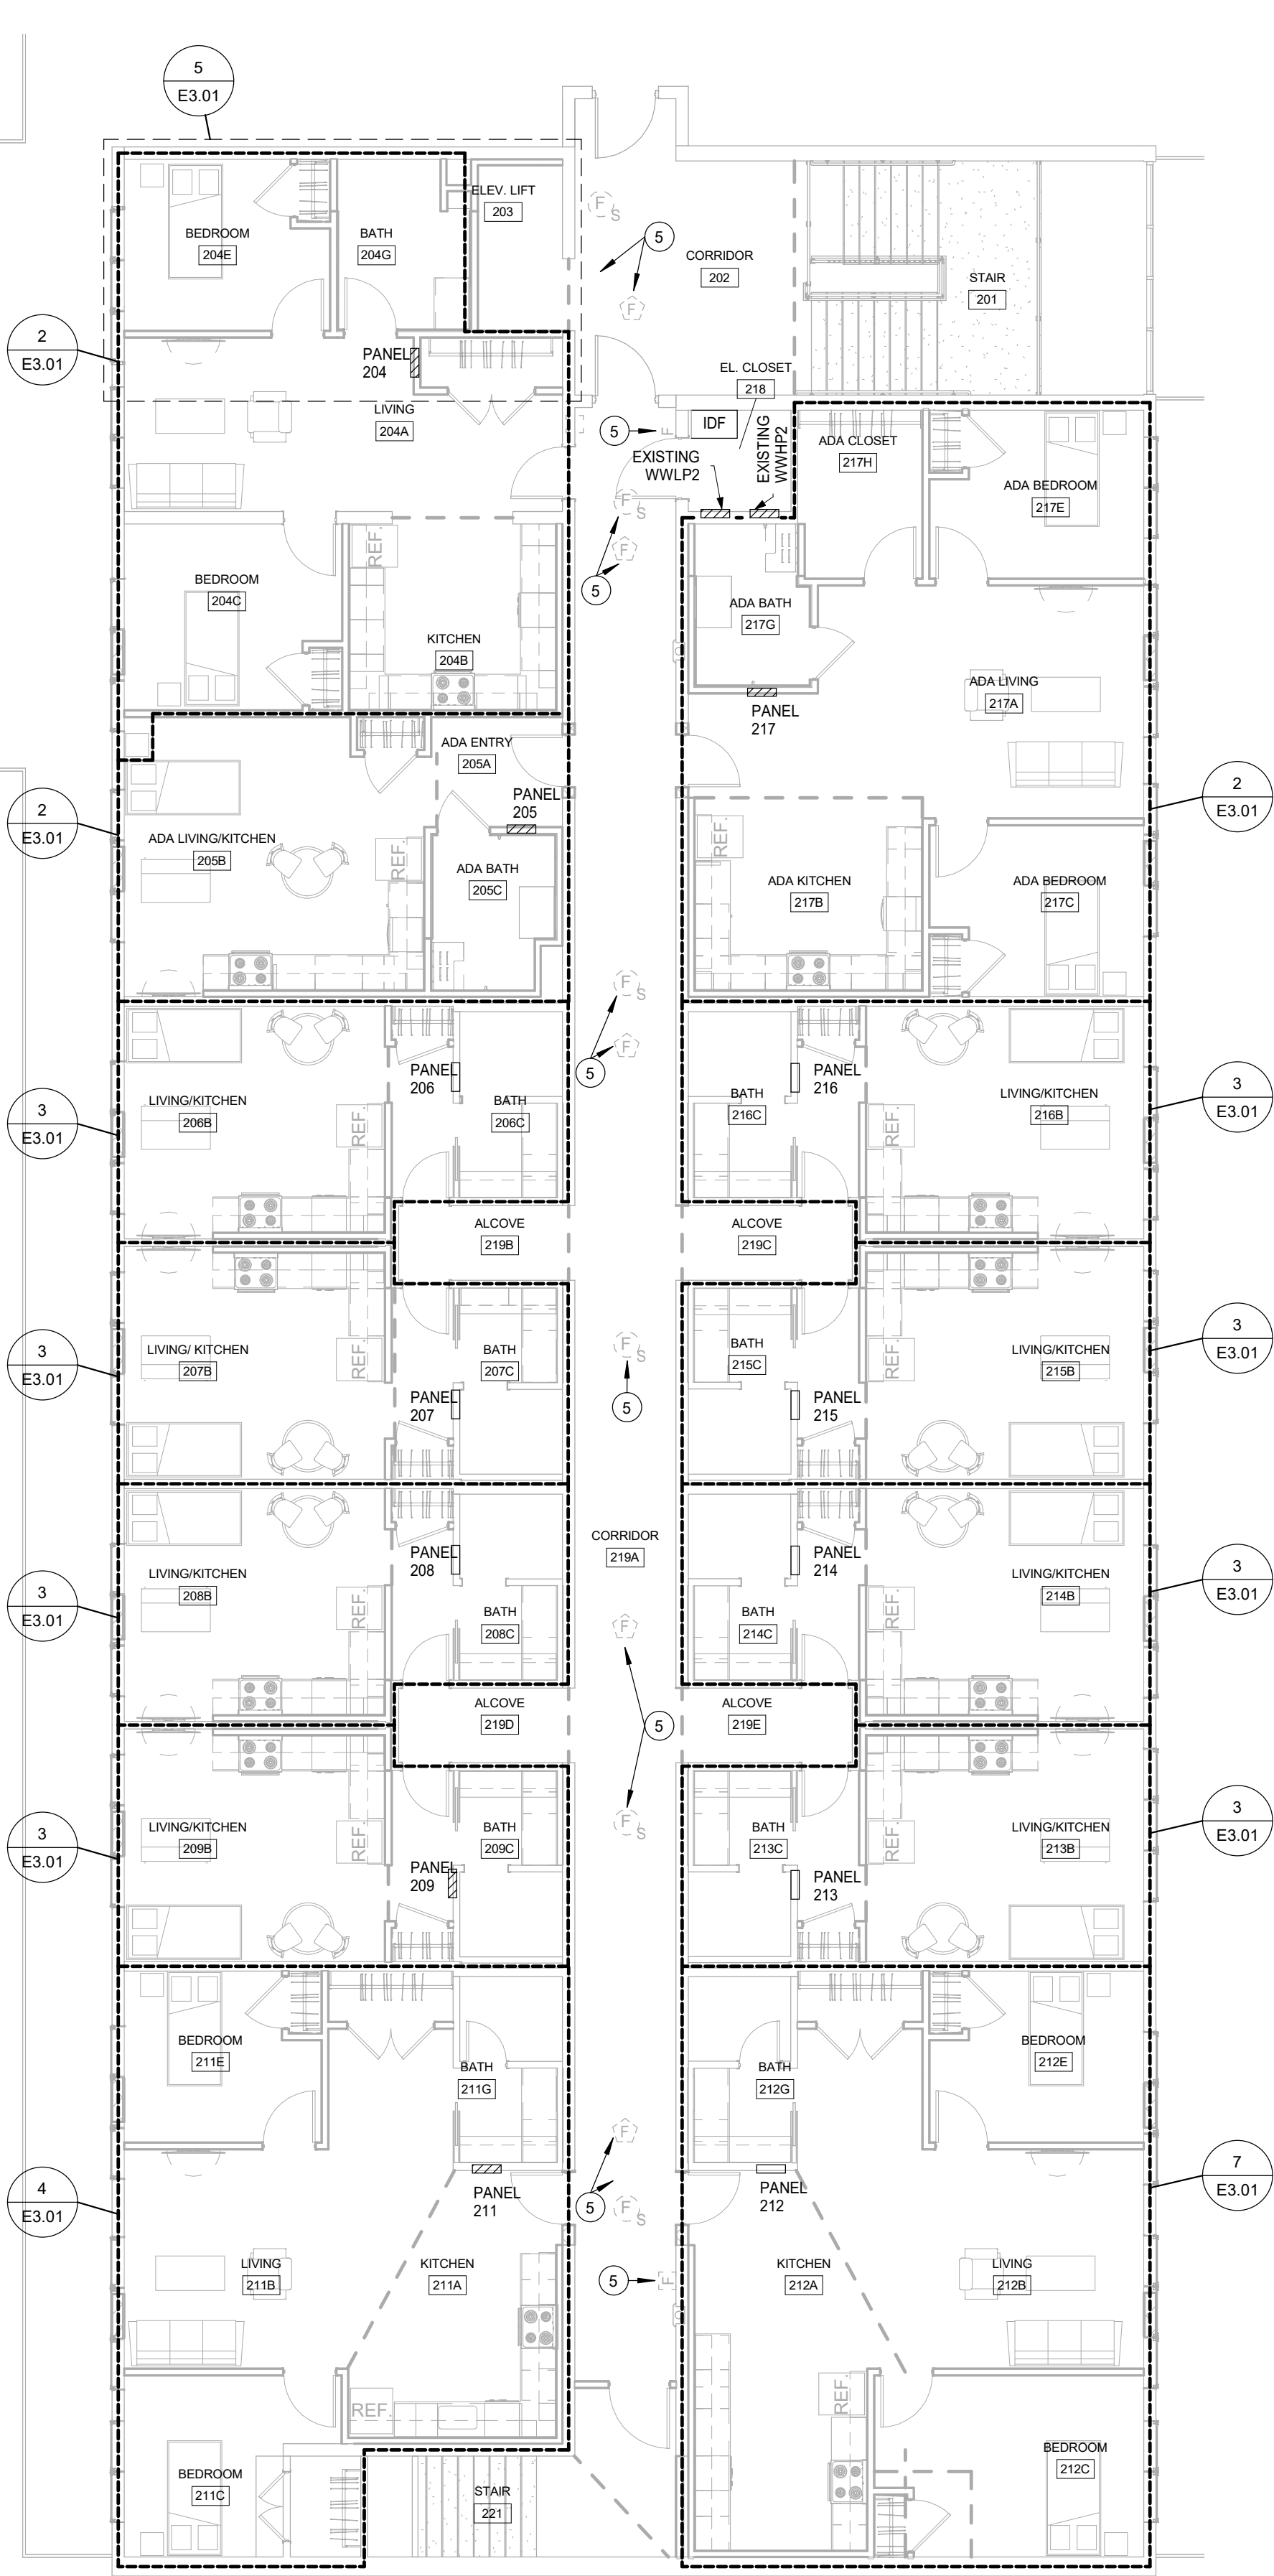

Second Floor Electrical Systems Plan - Overall
1/8" = 1'-0"

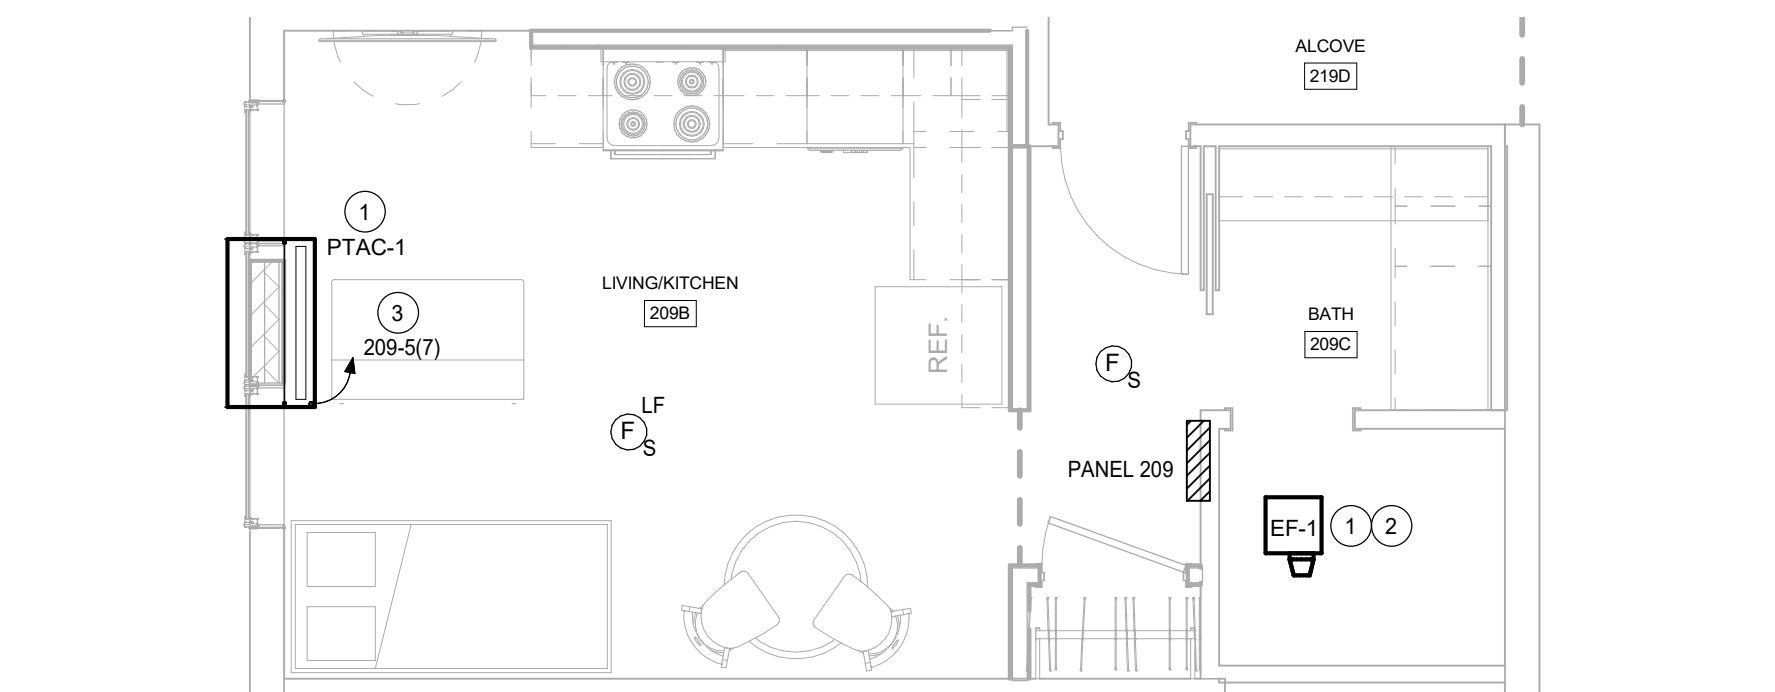

Partial Second Floor
Electrical Systems Plan - Typ. Single Room
1/4" = 1'-0"

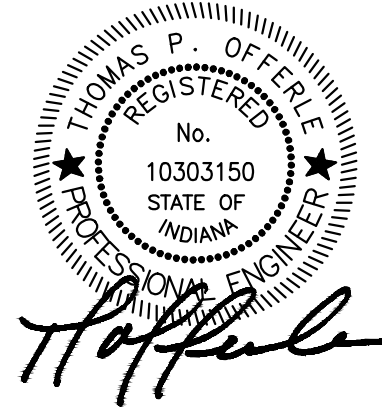

FORT WAYNE
6004 Conant Drive
Fort Wayne, IN 46804
(260) 438-0213
(260) 438-5481 fax
scor@scor-llc.com

A Project For:
YWCA Northeast Indiana, Inc.

YWCA The Lofts

1313 W. Washington Center Road, Fort Wayne, IN 46825

eliminating racism
empowering women
ywca
Northeast Indiana

mark	date	description
1	01.23.24	ADDENDUM #01

This is an original design created by BONA VITA ARCHITECTURE. The ideas, concepts, designs, plans and details included or incorporated in this document are owned by and presented for use on, and in connection with this specific project. None of the ideas, concepts, designs, plans and details shall be used or disclosed to any third party, in whole or in part, without the written permission of BONA VITA ARCHITECTURE, INC. Written permission on these drawings shall have precedence over oral directions. Corrections and updates shall be incorporated in all drawings and conditions on the job and BONA VITA ARCHITECTURE, INC. must be notified of any violation from the drawings and conditions shown by these drawings. Drawings must be submitted to BONA VITA ARCHITECTURE for approval before fabrication.

Project Number 230495 (232722)

Date January 11, 2024

Drawn By SJB

Checked By TPO

**ELECTRICAL
SCHEDULES**

E6.01

PANEL: 208 TYPE: NO MOUNT: FLUSH REMARKS:									
VOLTAGE: 208/120V, 1PH, 3W MLO: 125A AIC: 16K									
CKT NO.	BREAKER SIZE	LOAD DESCRIPTION	PHASE A (KVA)	PHASE B (KVA)	LOAD DESCRIPTION	BREAKER SIZE	CKT NO.	BREAKER SIZE	LOAD DESCRIPTION
1	50A/2P	RANGE	4.80		SPARE	20A/1P	2		
3				4.80	SPARE	20A/1P	4		
5	20A/2P	PTAC	1.20		APPLIANCES	20A/1P	6		
7			0.40	1.20	SPARE	20A/1P	8		
9	20A/1P	MICROWAVE	0.40		DISPOSAL	20A/1P	10		
11	20A/1P	REFRIGERATOR	0.20	0.40	DISHWASHER	20A/1P	12		
13	20A/1P	LTS: BATHROOM	0.12	1.20	R: BEDROOM	20A/1P	14		
15	20A/1P	LTS: BEDROOM	1.00	0.20	R: LIVING/BED	20A/1P	16		
17	20A/1P	SPARE		0.80	SPARE	20A/1P	18		

PANEL: 207 TYPE: NO MOUNT: FLUSH REMARKS:									
VOLTAGE: 208/120V, 1PH, 3W MLO: 125A AIC: 16K									
CKT NO.	BREAKER SIZE	LOAD DESCRIPTION	PHASE A (KVA)	PHASE B (KVA)	LOAD DESCRIPTION	BREAKER SIZE	CKT NO.	BREAKER SIZE	LOAD DESCRIPTION
1	50A/2P	RANGE	4.80		SPARE	20A/1P	2		
3				4.80	SPARE	20A/1P	4		
5	20A/2P	PTAC	1.20		APPLIANCES	20A/1P	6		
7			0.40	1.20	SPARE	20A/1P	8		
9	20A/1P	MICROWAVE	0.40		DISPOSAL	20A/1P	10		
11	20A/1P	REFRIGERATOR	0.20	0.40	DISHWASHER	20A/1P	12		
13	20A/1P	LTS: BATHROOM	0.12	1.20	R: BEDROOM	20A/1P	14		
15	20A/1P	LTS: BEDROOM	1.00	0.20	R: LIVING/BED	20A/1P	16		
17	20A/1P	SPARE		0.80	SPARE	20A/1P	18		

PANEL: 206 TYPE: NO MOUNT: FLUSH REMARKS:									
VOLTAGE: 208/120V, 1PH, 3W MLO: 125A AIC: 16K									
CKT NO.	BREAKER SIZE	LOAD DESCRIPTION	PHASE A (KVA)	PHASE B (KVA)	LOAD DESCRIPTION	BREAKER SIZE	CKT NO.	BREAKER SIZE	LOAD DESCRIPTION
1	50A/2P	RANGE	4.80		SPARE	20A/1P	2		
3				4.80	SPARE	20A/1P	4		
5	20A/2P	PTAC	1.20		APPLIANCES	20A/1P	6		
7			0.40	1.20	SPARE	20A/1P	8		
9	20A/1P	MICROWAVE	0.40		DISPOSAL	20A/1P	10		
11	20A/1P	REFRIGERATOR	0.20	0.40	DISHWASHER	20A/1P	12		
13	20A/1P	LTS: BATHROOM	0.12	1.20	R: BEDROOM	20A/1P	14		
15	20A/1P	LTS: BEDROOM	1.00	0.20	R: LIVING/BED	20A/1P	16		
17	20A/1P	SPARE		0.80	SPARE	20A/1P	18		

PANEL: 205 TYPE: NO MOUNT: FLUSH REMARKS:									
VOLTAGE: 208/120V, 1PH, 3W MLO: 125A AIC: 16K									
CKT NO.	BREAKER SIZE	LOAD DESCRIPTION	PHASE A (KVA)	PHASE B (KVA)	LOAD DESCRIPTION	BREAKER SIZE	CKT NO.	BREAKER SIZE	LOAD DESCRIPTION
1	50A/2P	RANGE	4.80		SPARE	20A/1P	2		
3				4.80	SPARE	20A/1P	4		
5	20A/2P	PTAC	1.20		APPLIANCES	20A/1P	6		
7			0.40	1.20	APPLIANCES	20A/1P	8		
9	20A/1P	MICROWAVE	0.40		DISPOSAL	20A/1P	10		
11	20A/1P	REFRIGERATOR	0.20	0.40	DISHWASHER	20A/1P	12		
13	20A/1P	LTS: BATHROOM	0.12	1.20	R: BEDROOM	20A/1P	14		
15	20A/1P	LTS: BEDROOM	0.80	0.20	R: LIVING/BED	20A/1P	16		
17	20A/1P	SPARE		0.80	HOOD	20A/1P	18		

PANEL: 204 TYPE: NO MOUNT: FLUSH REMARKS:									
VOLTAGE: 208/120V, 1PH, 3W MLO: 125A AIC: 16K									
CKT NO.	BREAKER SIZE	LOAD DESCRIPTION	PHASE A (KVA)	PHASE B (KVA)	LOAD DESCRIPTION	BREAKER SIZE	CKT NO.	BREAKER SIZE	LOAD DESCRIPTION
1	50A/2P	RANGE	4.80		SPARE	20A/1P	2		
3				4.80	SPARE	20A/1P	4		
5	40A/2P	ACCU-1	3.30		APPLIANCES	20A/1P	6		
7			0.80	3.30	APPLIANCES	20A/1P	8		
9	20A/1P	MICROWAVE	0.40		DISPOSAL	20A/1P	10		
11	20A/1P	REFRIGERATOR	0.20	0.40	DISHWASHER	20A/1P	12		
13	20A/1P	LTS: BATHROOM	0.12	1.20	R: BEDROOM	20A/1P	14		
15	20A/1P	LTS: BEDROOM	0.80	0.20	R: BEDROOM	20A/1P	16		
17	20A/1P	SPARE		0.40	SPARE	20A/1P	18		

PANEL: 214 TYPE: NO MOUNT: FLUSH REMARKS:									
VOLTAGE: 208/120V, 1PH, 3W MLO: 125A AIC: 16K									
CKT NO.	BREAKER SIZE	LOAD DESCRIPTION	PHASE A (KVA)	PHASE B (KVA)	LOAD DESCRIPTION	BREAKER SIZE	CKT NO.	BREAKER SIZE	LOAD DESCRIPTION
1	50A/2P	RANGE	4.80		SPARE	20A/1P	2		
3				4.80	SPARE	20A/1P	4		
5	20A/2P	PTAC	1.20		APPLIANCES	20A/1P	6		
7			0.40	1.20	SPARE	20A/1P	8		
9	20A/1P	MICROWAVE	0.40		DISPOSAL	20A/1P	10		
11	20A/1P	REFRIGERATOR	0.20	0.40	DISHWASHER	20A/1P	12		
13	20A/1P	LTS: BATHROOM	0.12	1.20	R: BEDROOM	20A/1P	14		
15	20A/1P	LTS: BEDROOM	1.00	0.20	R: LIVING/BED	20A/1P	16		
17	20A/1P	SPARE		0.80	SPARE	20A/1P	18		

PANEL: 213 TYPE: NO MOUNT: FLUSH REMARKS:									
VOLTAGE: 208/120V, 1PH, 3W MLO: 125A AIC: 16K									
CKT NO.	BREAKER SIZE	LOAD DESCRIPTION	PHASE A (KVA)	PHASE B (KVA)	LOAD DESCRIPTION	BREAKER SIZE	CKT NO.	BREAKER SIZE	LOAD DESCRIPTION
1	50A/2P	RANGE	4.80		SPARE	20A/1P	2		
3				4.80	SPARE	20A/1P	4		
5	20A/2P	PTAC	1.20		APPLIANCES	20A/1P	6		
7			0.40	1.20	SPARE	20A/1P	8		
9	20A/1P	MICROWAVE	0.40		DISPOSAL	20A/1P	10		
11	20A/1P	REFRIGERATOR	0.20	0.40	DISHWASHER	20A/1P	12		
13	20A/1P	LTS: BATHROOM	0.12	1.20	R: BEDROOM	20A/1P	14		
15	20A/1P	LTS: BEDROOM	1.00	0.20	R: LIVING/BED	20A/1P	16		
17	20A/1P	SPARE		0.80	SPARE	20A/1P	18		

PANEL: 212 TYPE: NO MOUNT: FLUSH REMARKS:									
VOLTAGE: 208/120V, 1PH, 3W MLO: 125A AIC: 16K									
CKT NO.	BREAKER SIZE	LOAD DESCRIPTION	PHASE A (KVA)	PHASE B (KVA)	LOAD DESCRIPTION	BREAKER SIZE	CKT NO.	BREAKER SIZE	LOAD DESCRIPTION
1	50A/2P	RANGE	4.80		SPARE	20A/1P	2		
3				4.80	SPARE	20A/1P	4		
5	40A/2P	ACCU-1	3.78		APPLIANCES	20A/1P	6		
7			0.40	3.78	APPLIANCES	20A/1P	8		
9	20A/1P	MICROWAVE	0.40		APPLIANCES	20A/1P	10		
11	20A/1P	REFRIGERATOR	0.20	0.40	DISPOSAL	20A/1P	12		
13	20A/1P	LTS: BATHROOM	0.12	1.20	DISHWASHER	20A/1P	14		
15	20A/1P	LTS: BEDROOM	0.20	0.50	R: BEDROOM	20A/1P	16		
17	20A/1P	SPARE		1.00	R: BEDROOM	20A/1P	18		

PANEL: 211 TYPE: NO MOUNT: FLUSH REMARKS:									
VOLTAGE: 208/120V, 1PH, 3W MLO: 125A AIC: 16K									
CKT NO.	BREAKER SIZE	LOAD DESCRIPTION	PHASE A (KVA)	PHASE B (KVA)	LOAD DESCRIPTION	BREAKER SIZE	CKT NO.	BREAKER SIZE	LOAD DESCRIPTION
1	50A/2P	RANGE	4.80		SPARE	20A/1P	2		
3				4.80	SPARE	20A/1P	4		
5	40A/2P	ACCU-1	3.78		APPLIANCES	20A/1P	6		
7			0.40	3.78	APPLIANCES	20A/1P	8		
9	20A/1P	MICROWAVE	0.40		APPLIANCES	20A/1P	10		
11	20A/1P	REFRIGERATOR	0.20	0.40	DISPOSAL	20A/1P	12		
13	20A/1P	LTS: BATHROOM	0.12	1.20	DISHWASHER	20A/1P	14		
15	20A/1P	LTS: BEDROOM	1.00	0.50	R: BEDROOM	20A/1P	16		
17	20A/1P	SPARE		1.00	R: BEDROOM	20A/1P	18		

PANEL: 209 TYPE: NO MOUNT: FLUSH REMARKS:									
VOLTAGE: 208/120V, 1PH, 3W MLO: 125A AIC: 16K									
CKT NO.	BREAKER SIZE	LOAD DESCRIPTION	PHASE A (KVA)	PHASE B (KVA)	LOAD DESCRIPTION	BREAKER SIZE	CKT NO.	BREAKER SIZE	LOAD DESCRIPTION
1	50A/2P	RANGE	4.80		SPARE	20A/1P	2		
3				4.80	SPARE	20A/1P	4		
5	20A/2P	PTAC	1.20		APPLIANCES	20A/1P	6		
7			0.40	1.20	APPLIANCES	20A/1P	8		
9	20A/1P	MICROWAVE	0.40		DISPOSAL	20A/1P	10		
11	20A/1P	REFRIGERATOR	0.20	0.40	DISHWASHER	20A/1P	12		
13	20A/1P	LTS: BATHROOM	0.12	1.20	R: BEDROOM	20A/1P	14		
15	20A/1P	LTS: BEDROOM	1.00	0.20	R: BEDROOM	20A/1P	16		
17	20A/1P	SPARE		0.80	R: LIVING/BED	20A/1P	18		

PANEL: 217 TYPE: NO MOUNT: FLUSH REMARKS:				VOLTAGE: 208/120V, 1PH, 3W MLO: 125A AIC: 16K			
CKT NO	BREAKER SIZE	LOAD DESCRIPTION	PHASE A (KVA)	PHASE B (KVA)	LOAD DESCRIPTION	BREAKER SIZE	CKT NO
1	50A/2P		4.80		SPARE	20A/1P	2
3				4.80			
5	40A/2P	ACCU-1	3.78		SPARE	20A/1P	4
7			0.80		APPLIANCES	20A/1P	6
				3.78			
				0.60	APPLIANCES	20A/1P	8
9	20A/1P	MICROWAVE	0.40				
			0.20		DISPOSAL	20A/1P	10
11	20A/1P	REFRIGERATOR	0.20	0.40			
			1.12	1.20	DISHWASHER	20A/1P	12
13	20A/1P	LTS: BATHROOM	0.10				
			0.02		R: BEDROOM	20A/1P	14
15	20A/1P	LTS: BEDROOM	0.02	0.40			
			1.00	1.00	R: BEDROOM	20A/1P	16
17	20A/1P	R: LIVING	1.00				
			1.00		HOOD	20A/1P	18