

ADDENDUM NO. 2

Penn High School Fieldhouse

Penn-Harris-Madison School Corporation
Mishawaka, Indiana

Project No. 222130.00

Index of Contents

Addendum No. 2, 16 items, 5 pages


New Project Manual Section: 26 33 23 – Battery Inverter Equipment

Revised Drawing Sheets: C2.2, C3.2, C3.3, C3.3A, C4.1, C4.2, S-004, S-11A, S-11B, S-11C, S-12B, S-522,
A-11B, A-12B, AC12B, AQ71A, AQ71B, AQ751, MV102, MV202, M-601, M-602, EP11C, EP12A, EP12C,
ET11B, ET12B, E-601, E-602, T-001, T-11A, T-11B, T-11C, T-12B, and T-503

February 1, 2024

I hereby certify that this Addendum was prepared by me or under my direct supervision and that I am a duly registered Architect/Engineer under the Laws of the State of Indiana.

FANNING/HOWEY ASSOCIATES, INC.
ARCHITECTS/ENGINEERS/CONSULTANTS

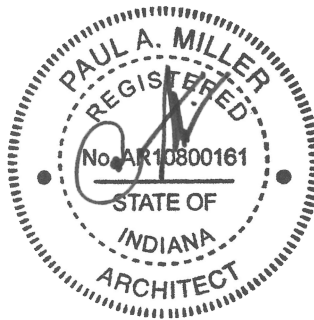

Paul A. Miller, License No. AR10800161
Expiration Date: 12/31/2025

TO: ALL BIDDERS OF RECORD

ADDENDUM NO. 2 to Drawings and Project Manual, dated January 10, 2024, for the Penn High School Fieldhouse for Penn-Harris-Madison School Corporation, 55900 Bittersweet Road, Mishawaka, Indiana 46545; as prepared by Fanning/Howey Associates, Inc., Indianapolis, Indiana.
This Addendum shall hereby be and become a part of the Contract Documents the same as if originally bound thereto.

The following clarifications, amendments, additions, revisions, changes, and modifications change the original Contract Documents only in the amount and to the extent hereinafter specified in this Addendum.

Each bidder shall acknowledge receipt of this Addendum in his proposal or bid.

NOTE: Bidders are responsible for becoming familiar with every item of this Addendum. (This includes miscellaneous items at the very end of this Addendum.)

RE: ALL BIDDERS

ITEM NO. 1. PROJECT MANUAL, TABLE OF CONTENTS

- A. Book 3, Page 00 01 10-2, DIVISION 26: Add Section 26 33 23 – Battery Inverter Equipment.

ITEM NO. 2. NEW PROJECT MANUAL SECTION

- A. New Project Manual Section 26 33 23 – Battery Inverter Equipment is included with and hereby made a part of this Addendum.

ITEM NO. 3. PROJECT MANUAL, SECTION 04 20 00 – UNIT MASONRY

- A. Add 2.6, B., 5., b., as follows:

“b. “Medium Ironspot 46 Velour”, by Endicott Clay Products Company.”

ITEM NO. 4. PROJECT MANUAL, SECTION 08 71 00 – DOOR HARDWARE

- A. Article 3.05: Hardware Group 14: Delete Door No. B211.
B. Article 3.05: Add new Hardware Group No. 14A as follows:

Hardware Group No. **14A**

For use on Door #(s):

B211

Provide each OPENING with the following:

QTY		DESCRIPTION	CATALOG NUMBER	FINISH	MFR
<u>3</u>	<u>EA</u>	<u>HINGE</u>	<u>5BB1 SIZE, QTY, NRP AS REQ'D (SEE SPECS)</u>	<u>652</u>	<u>IVE</u>
<u>1</u>	<u>EA</u>	<u>STOREROOM LOCK</u>	<u>L9080BDC 03A</u>	<u>626</u>	<u>SCH</u>
<u>1</u>	<u>EA</u>	<u>PERMANENT CORE</u>	<u>MARSHALL BEST SECURITY, 7-PIN, SMALL FORMAT INTERCHANGEABLE CORE</u>	<u>626</u>	<u>MAR</u>
<u>1</u>	<u>EA</u>	<u>SURFACE CLOSER</u>	<u>4040XP REG</u>	<u>689</u>	<u>LCN</u>

QTY		DESCRIPTION	CATALOG NUMBER	FINISH	MFR
<u>1</u>	<u>EA</u>	<u>KICK PLATE</u>	<u>8400 10" X 1 1/2" LDW B-CS</u>	<u>630</u>	<u>IVE</u>
<u>1</u>	<u>EA</u>	<u>WALL STOP</u>	<u>WS406/407CVX</u>	<u>630</u>	<u>IVE</u>
<u>3</u>	<u>EA</u>	<u>SILENCER</u>	<u>SR64</u>	<u>GRY</u>	<u>IVE</u>
<u>1</u>	<u>EA</u>	<u>DOOR CONTACT</u>	<u>679 SERIES</u>	<u>BLK</u>	<u>SCE</u>

ITEM NO. 5. PROJECT MANUAL, SECTION 08 87 23 – SAFETY AND SECURITY FILM

A. Replace 2.3, A., as follows:

- “A. 3M Safety S140 (SH14CLARL): Optically clear polyester film with a durable acrylic abrasion resistant coating over one surface and a pressure sensitive adhesive over the other. The adhesive is pressure-activated, not water-activated, and forms a physical bond, not chemical bond, to the glass. The film may be laminated to other clear polyester film layers to achieve the desired thickness of the film.
1. Physical / Mechanical Performance Properties:
 - a. Film Color: Clear.
 - b. Thickness: Nominal 14 mils.
 - c. Tensile Strength (ASTM D 882): 25,000 psi.
 - d. Break Strength (ASTM D 882) (Per Inch Width): 350 lbs.
 2. Uniformity: No noticeable pin holes, streaks, thin spots, scratches, banding or other optical defects.
 3. Variation in Total Transmission across the Width: Less than 2 percent over the average at any portion along the length.
 4. Identification: Labeled as to Manufacturer as listed in this Section.
 5. Solar Performance Properties: Film applied to 1/4 Inch thick clear glass.
 - a. Visible Light Transmission (ASTM E 903): 85 percent.
 - b. Ultraviolet Transmission (ASTM E 903): Less than 1 percent.
 6. Impact Resistance for Safety Glazing: Tested on 1/4 inch annealed glass.
 - a. Safety Rating (CPSC 16 CFR, Part 1201): Category II (400 ft.-lbs).
 7. Impact Resistance and Pressure Cycling:
 - a. Film shall pass impact of Medium Large Missile "C" and withstand subsequent pressure cycling (per ASTMs E 1996 and E 1886) at +/- 50 psf Design Pressure with use of 3M Impact Protection Adhesive attachment system.
 8. Forced Entry Protection: Independent lab testing according to UL 972 protocol (Multiple Impact Test).
 - a. Annealed Glass (1/4 inch) - Pass.”

ITEM NO. 6. PROJECT MANUAL, SECTION 09 67 66 – FLUID-APPLIED ATHLETIC FLOORING

A. Article 1.1, A., 1: Change “(PRF)” to “(UF).” Therefore, matching the List of Finishes.

ITEM NO. 7. PROJECT MANUAL, SECTION 10 14 23 – INTERIOR PANEL SIGNS

A. Add 2.6, A. 5., as follows:

- “5. Location: Vinyl letters are to be located on the glass transoms.”

ITEM NO. 8. PROJECT MANUAL, SECTION 11 52 13 – FRONT PROJECTION SCREENS

A. Replace second 2.3, A., as follows:

“B. Surface-Mounted, Metal Encased, Electrically Operated Screens: Motor-in-roller units designed and fabricated for surface mounting on wall or at ceiling, fabricated from formed steel sheet not less than 0.027 inch thick or aluminum extrusions; with flat back design and vinyl covering or baked-enamel finish. Provide units with end caps and universal mounting brackets, finished to match end caps.

1. Products:

- a. Da-Lite Screen Co., Inc.; Cosmopolitan Electrol.
- b. Draper Inc.; Targa.
- c. Alltec Screens; a brand of Altec Pro.
- d. Stewart Filmscreen Corporation; Model A ElectriScreen.

B. Replace 2.4, K., 1., as follows:

“1. Mounting Accessories: Provide manufacturer's heavy steel extension wall bracket to mount screen 6 inches from wall where wall mounting is indicated.”

C. Delete 2.4, K., 2., in its entirety.

ITEM NO. 9. PROJECT MANUAL, SECTION 12 24 13 – ROLLER WINDOW SHADES

A. Add 2.3, C., as follows:

“C. Light-Blocking Fabric: Opaque fabric, stain and fade resistant.

2. Shade Band Material: Polyester-cotton blend, 13.5 oz./sq.yd. min., .025 inches thick mm. Fire rating: NFPA 701. Green Spec. Listed.
3. Color: As selected by A/E from manufacturer's full range.
4. Location: Shades where indicated on interior window/opening locations.

ITEM NO. 10. PROJECT MANUAL, SECTION 12 48 26.01 – ENTRANCE CARPET TILE

A. Article 2.2, A., 1: Add “two-color” between “Provide” and “school” at beginning of sentence.

ITEM NO. 11. PROJECT MANUAL, SECTION 12 66 00 – TELESCOPING STANDS

A. Replace 2.5, A., 1., as follows:

“1. Material: Molded polyethylene plastic with contour seat surface.

1. Colors: Three colors will be selected as indicated on Drawings. Custom color to match school colors required.
2. Graphics: Colored seating layout shall be arranged in text graphic as indicated on Drawings.

ITEM NO. 12. PROJECT MANUAL, SECTION 13 34 19 – METAL BUILDING SYSTEMS

A. Replace 2.3, D., 1., as follows:

“1. Metal Roof Panel Assemblies:

- a. R-Value: R-30 total.
 - 1) 6 inch batt insulation between purlins.
 - 2) 3.5 inch batt insulation over the purlins with thermal break.”

B. Replace 2.6, B., 3., as follows:

“3. Location: Wall Insulation only.”

C. Replace 2.6, D., as follows:

“D. Roof Liner Insulation Retaining System: Liner system that permanently supports insulation and allows full depth and insulation width between and above purlins as indicated herein.

1. Roof liner system shall provide an OSHA compliant fall arrest system and protection from falling objects.
2. Manufacturer's standard polyethylene vapor retarder liner fabric, white.
 - a. Fabric liner composed of woven high-density polyethylene coated on both sides with polyethylene.
 - b. ASTM C1136, Types I through Type VI.
 - c. Perm Rating: Maximum of 0.02 per ASTM E96.
 - d. Surface Burning: Flame Spread Index of 0 and Smoke Development Index of less than 50, per ASTM E84.
 - e. Manufacturer's standard double sided tape and patch tape as required.
3. Galvanized metal support straps (bands).
 - a. Coated steel, width 1.0 inch, structural steel Grade 50 per ASTM C 653, exposed color, white.
 - b. Provide gridwork of steel retainer straps engineered for compliance with fall arrest system and insulation loading.
4. Metal Building Insulation, two layers.
 - a. Batt Insulation, ASTM C991, Type 1.
 - b. Surface Burning: Flame Spread Index less than 25 and Smoke Development Index less than 50 per ASTM E84.
 - c. Unfaced.
 - d. Thermal Resistance, total: R-30.
 - e. Thickness over purlins 3.5 inches.
 - f. Thermal Breaks: Extruded or expanded polystyrene thermal spacer blocks.
 - g. Insulation hangers: Manufacturer's standard as required.
5. Fasteners: Manufacturer's standard, color matched to liner system with sealing washers.
6. Manufacturers:
 - a. “Simple Save System” by Thermal Design.
 - b. “ProLiner Branded Liner System by Therm-All.
 - c. “Energy Saver FP” by Silvercote Envelope Solutions.”

ITEM NO. 13. PROJECT MANUAL, SECTION 26 05 26 – GROUNDING AND BONDING FOR ELECTRICAL SYSTEMS

A. Add 1.3, B., 1., f., as follows:

“d. Ground rings.”

B. Add 3.5, K., as follows:

- “K. Ground Ring: Install a grounding conductor, electrically connected to each building structure ground rod and to each steel column, extending around the perimeter of building.
1. Install tinned-copper conductor not less than No. 2/0 AWG for ground ring and for taps to building steel.
 2. Bury ground ring not less than 24 inches from building foundation.”

ITEM NO. 14. PROJECT MANUAL, SECTION 28 31 11 – DIGITAL, ADDRESSABLE FIRE-ALARM SYSTEM

- A. Article 2.1, A: Delete subparagraphs 1, 2, 3, 4, 5, and 6, in their entirety.
- B. Add new subparagraph 2.1, A., 1., as follows:
 - “1. Simplex, a part of Johnson Controls.”

ITEM NO. 15. ACCEPTABLE MANUFACTURERS

The following manufacturers are to be considered acceptable manufacturers (suppliers and fabricators) for the Sections of the Specifications listed. Listed manufacturers are required to bid on products equal in type and design, size, function, and quality to that originally specified. Final decision as to equality of products specified versus those proposed shall be made by the Architect.

Section 08 45 13 – Structured-Polycarbonate-Panel Assemblies

- Major Industries/Kingspan, Wausau, Wisconsin
- Duo-Gard, Canton, Michigan

ITEM NO. 16. REVISED DRAWING SHEETS

- A. Drawing Sheets: C2.2, C3.2, C3.3, C3.3A, C4.1, C4.2, S-004, S-11A, S-11B, S-11C, S-12B, S-522, A-11B, A-12B, AC12B, AQ71A, AQ71B, AQ751, MV102, MV202, M-601, M-602, EP11C, EP12A, EP12C, ET11B, ET12B, E-601, E-602, T-001, T-11A, T-11B, T-11C, T-12B, and T-503 have been revised, dated 2/1/24, and is included with and hereby made a part of this Addendum. These Drawings supersede the original documents.


END OF ADDENDUM

PHMSC FIELDHOUSE – FINAL SITE PLAN (PHASE 1)
PART OF THE SOUTHWEST, AND NORTHWEST QUARTERS OF SECTION 6, TOWNSHIP 37 NORTH, RANGE 4 EAST,
PENN TOWNSHIP, ST. JOSEPH COUNTY, INDIANA.

KEYNOTES:

- (A) PROPOSED STANDARD DUTY HMA PAVEMENT (SEE SHEET C7.1)
- (B) PROPOSED HEAVY DUTY HMA PAVEMENT (SEE SHEET C7.1)
- (C) PROPOSED CONCRETE SIDEWALK
- (F) ADA PAVEMENT MARKINGS AND SIGN/POST. SEE DETAILS SHEET C7.1
- (G) ADA PAVEMENT MARKINGS PER ADA STANDARDS AND SPECIFICATIONS. SEE DETAIL SHEET C7.2
- (H) ADA PARKING SIGNAGE. SEE DETAIL SHEET C7.1
- (I) STANDARD UPRIGHT CONCRETE CURB. SEE DETAIL SHEET C7.0
- (J) PROPOSED CONCRETE ADA HANDICAP RAMP AND SIDEWALK AT CURB. SEE DETAIL SHEET C7.0
- (K) PROPOSED 14 STALL SURFACE MOUNTED "HITCH POST" BICYCLE RACK. SEE DETAIL SHEET C7.2
- (L) PROPOSED FLAGPOLE. SEE ARCHITECTURAL PLANS FOR DETAILS.
- (M) PROPOSED SITE LIGHTING. SEE ARCHITECTURAL PLANS FOR DETAILS.
- (N) PROPOSED SIGN. "W11-2A" – RAISED PEDESTRIAN CROSSING

A - Through Lane-Use Arrow

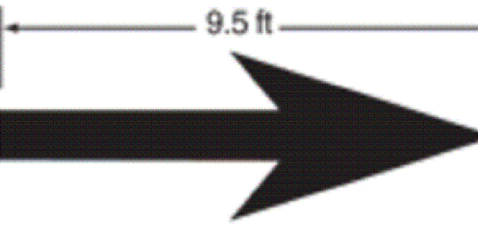






STRAIGHT LANE - USE ARROW DETAIL
(PER MUTCD 2009 EDITION - FHWA)

PROPOSED LEGEND

- PROPOSED INLET
- PROPOSED CLEAN OUT
- PROPOSED HYDRANT
- PROPOSED LIGHT
- PROPOSED MANHOLE
- PROPOSED VALVE
- PROPOSED POLE
- PROPOSED CATCH BASIN
- PROPOSED END SECTION
- PROPOSED ELEVATION
- TW TOP OF WALK
- TS BOTTOM OF CURB
- TP TOP OF PAVEMENT
- TC TOP OF CURB
- BC BOTTOM OF CURB
- PROPOSED WATER
- PROPOSED ELECTRIC
- PROPOSED GAS LINE
- PROPOSED TELEPHONE
- PROPOSED CONTOUR

EXISTING LEGEND

- SET P.K. NAIL
- FOUND IRON
- MEASURED DISTANCE
- RECORD DISTANCE
- PINE TREE
- BUSH
- TREE
- FOUNTAIN/IRR.
- BOLLARD/POLE
- LIGHT POLE
- UTILITY POLE
- GUY ANCHOR
- SIGN
- WELL
- VALVE
- FIRE HYDRANT
- CURB INLET
- DRYWELL
- SANITARY MANHOLE
- STORM MANHOLE
- CLEAN-OUT
- FIBER OPTIC MANHOLE
- GAS METER
- WATER MANHOLE
- END SECTION
- ELEC. VAULT
- ELEC. TRANSFORMER
- PHONE VAULT
- SPOT ELEVATION
- EX. ELEVATION
- WIRE FENCE
- CHAIN LINK FENCE
- WOOD FENCE
- ELECTRIC
- ELECTRIC
- PHONE
- GAS
- CABLE TV
- WATER
- FIBER OPTIC
- STORM LINE
- SANITARY LINE
- SOIL BORING
- WATER METER
- CABLE PED.
- PHONE PED.
- ELEC. PED.
- MAILBOX
- A/C UNIT

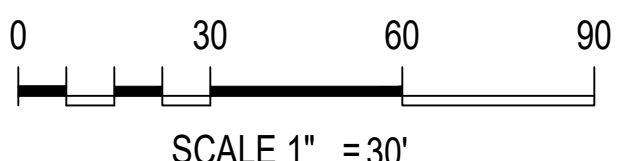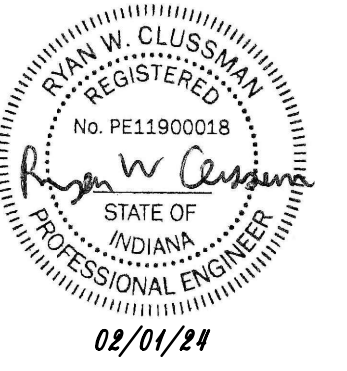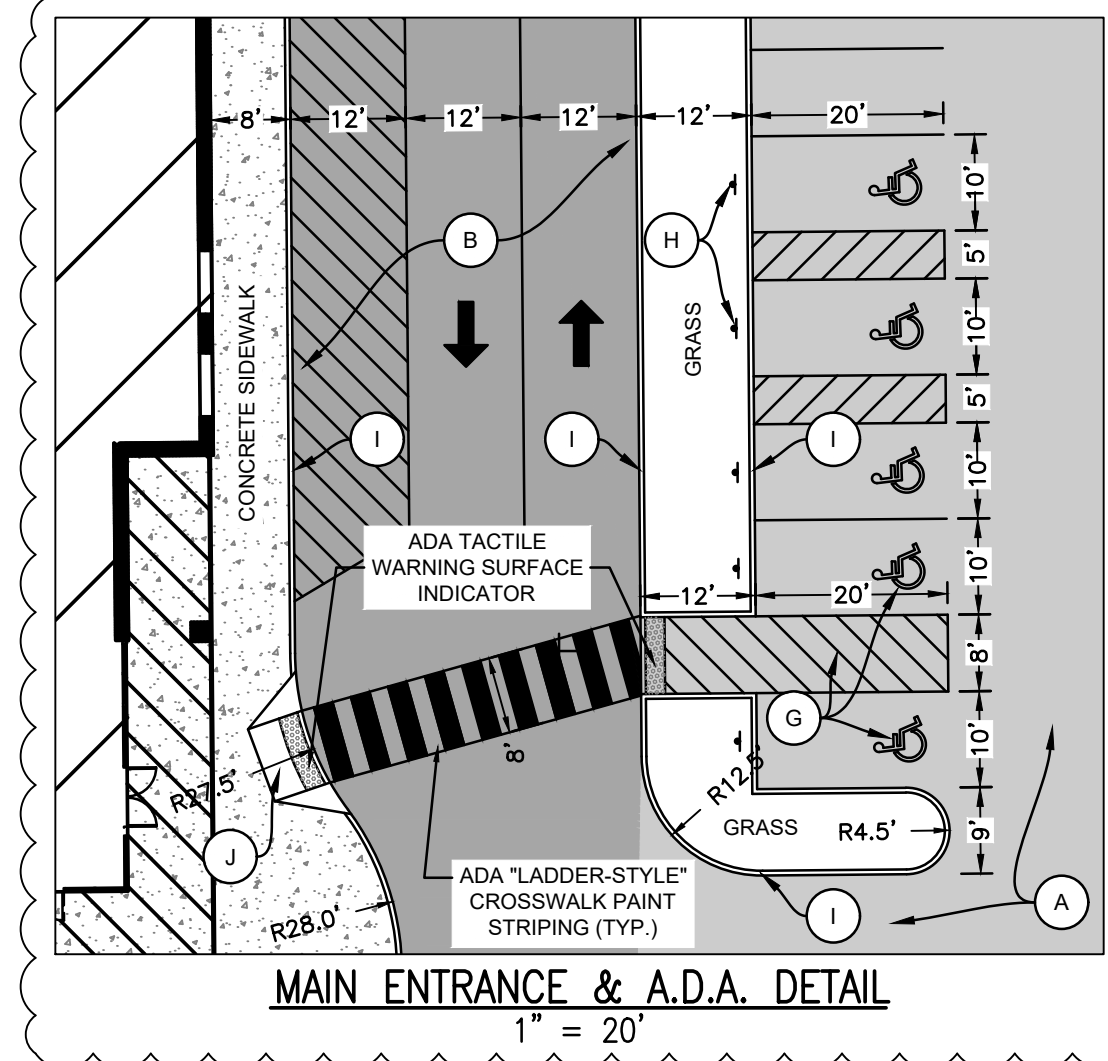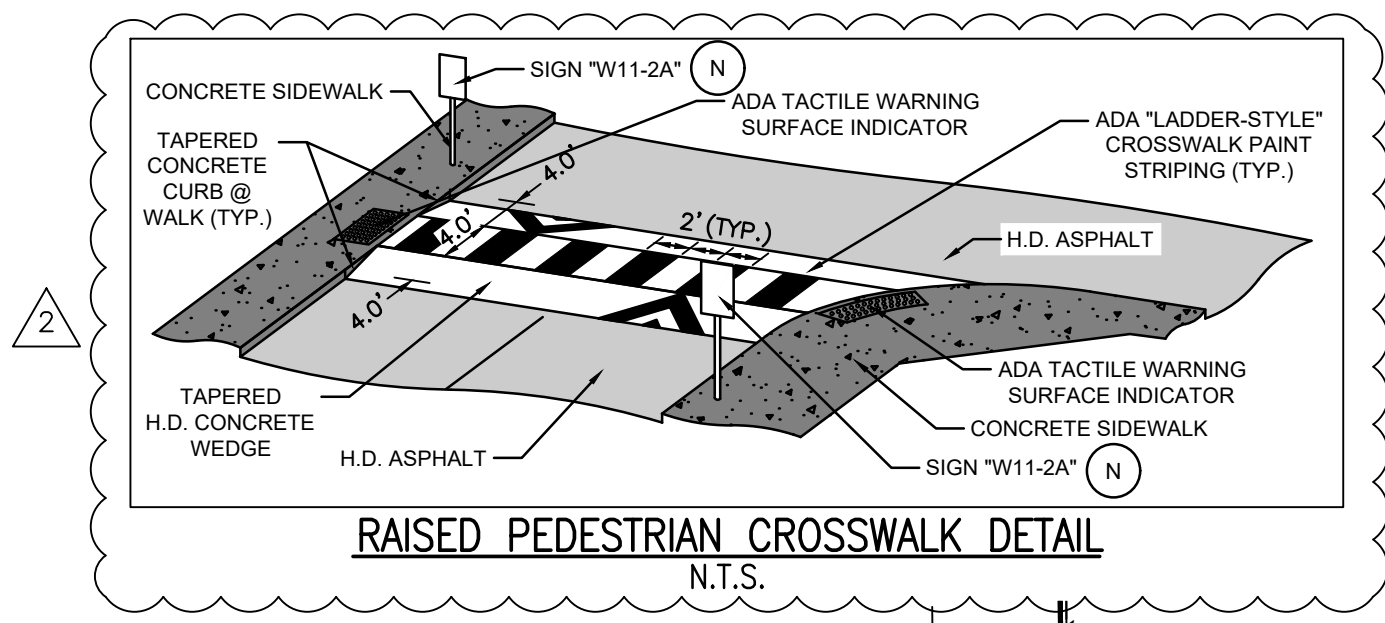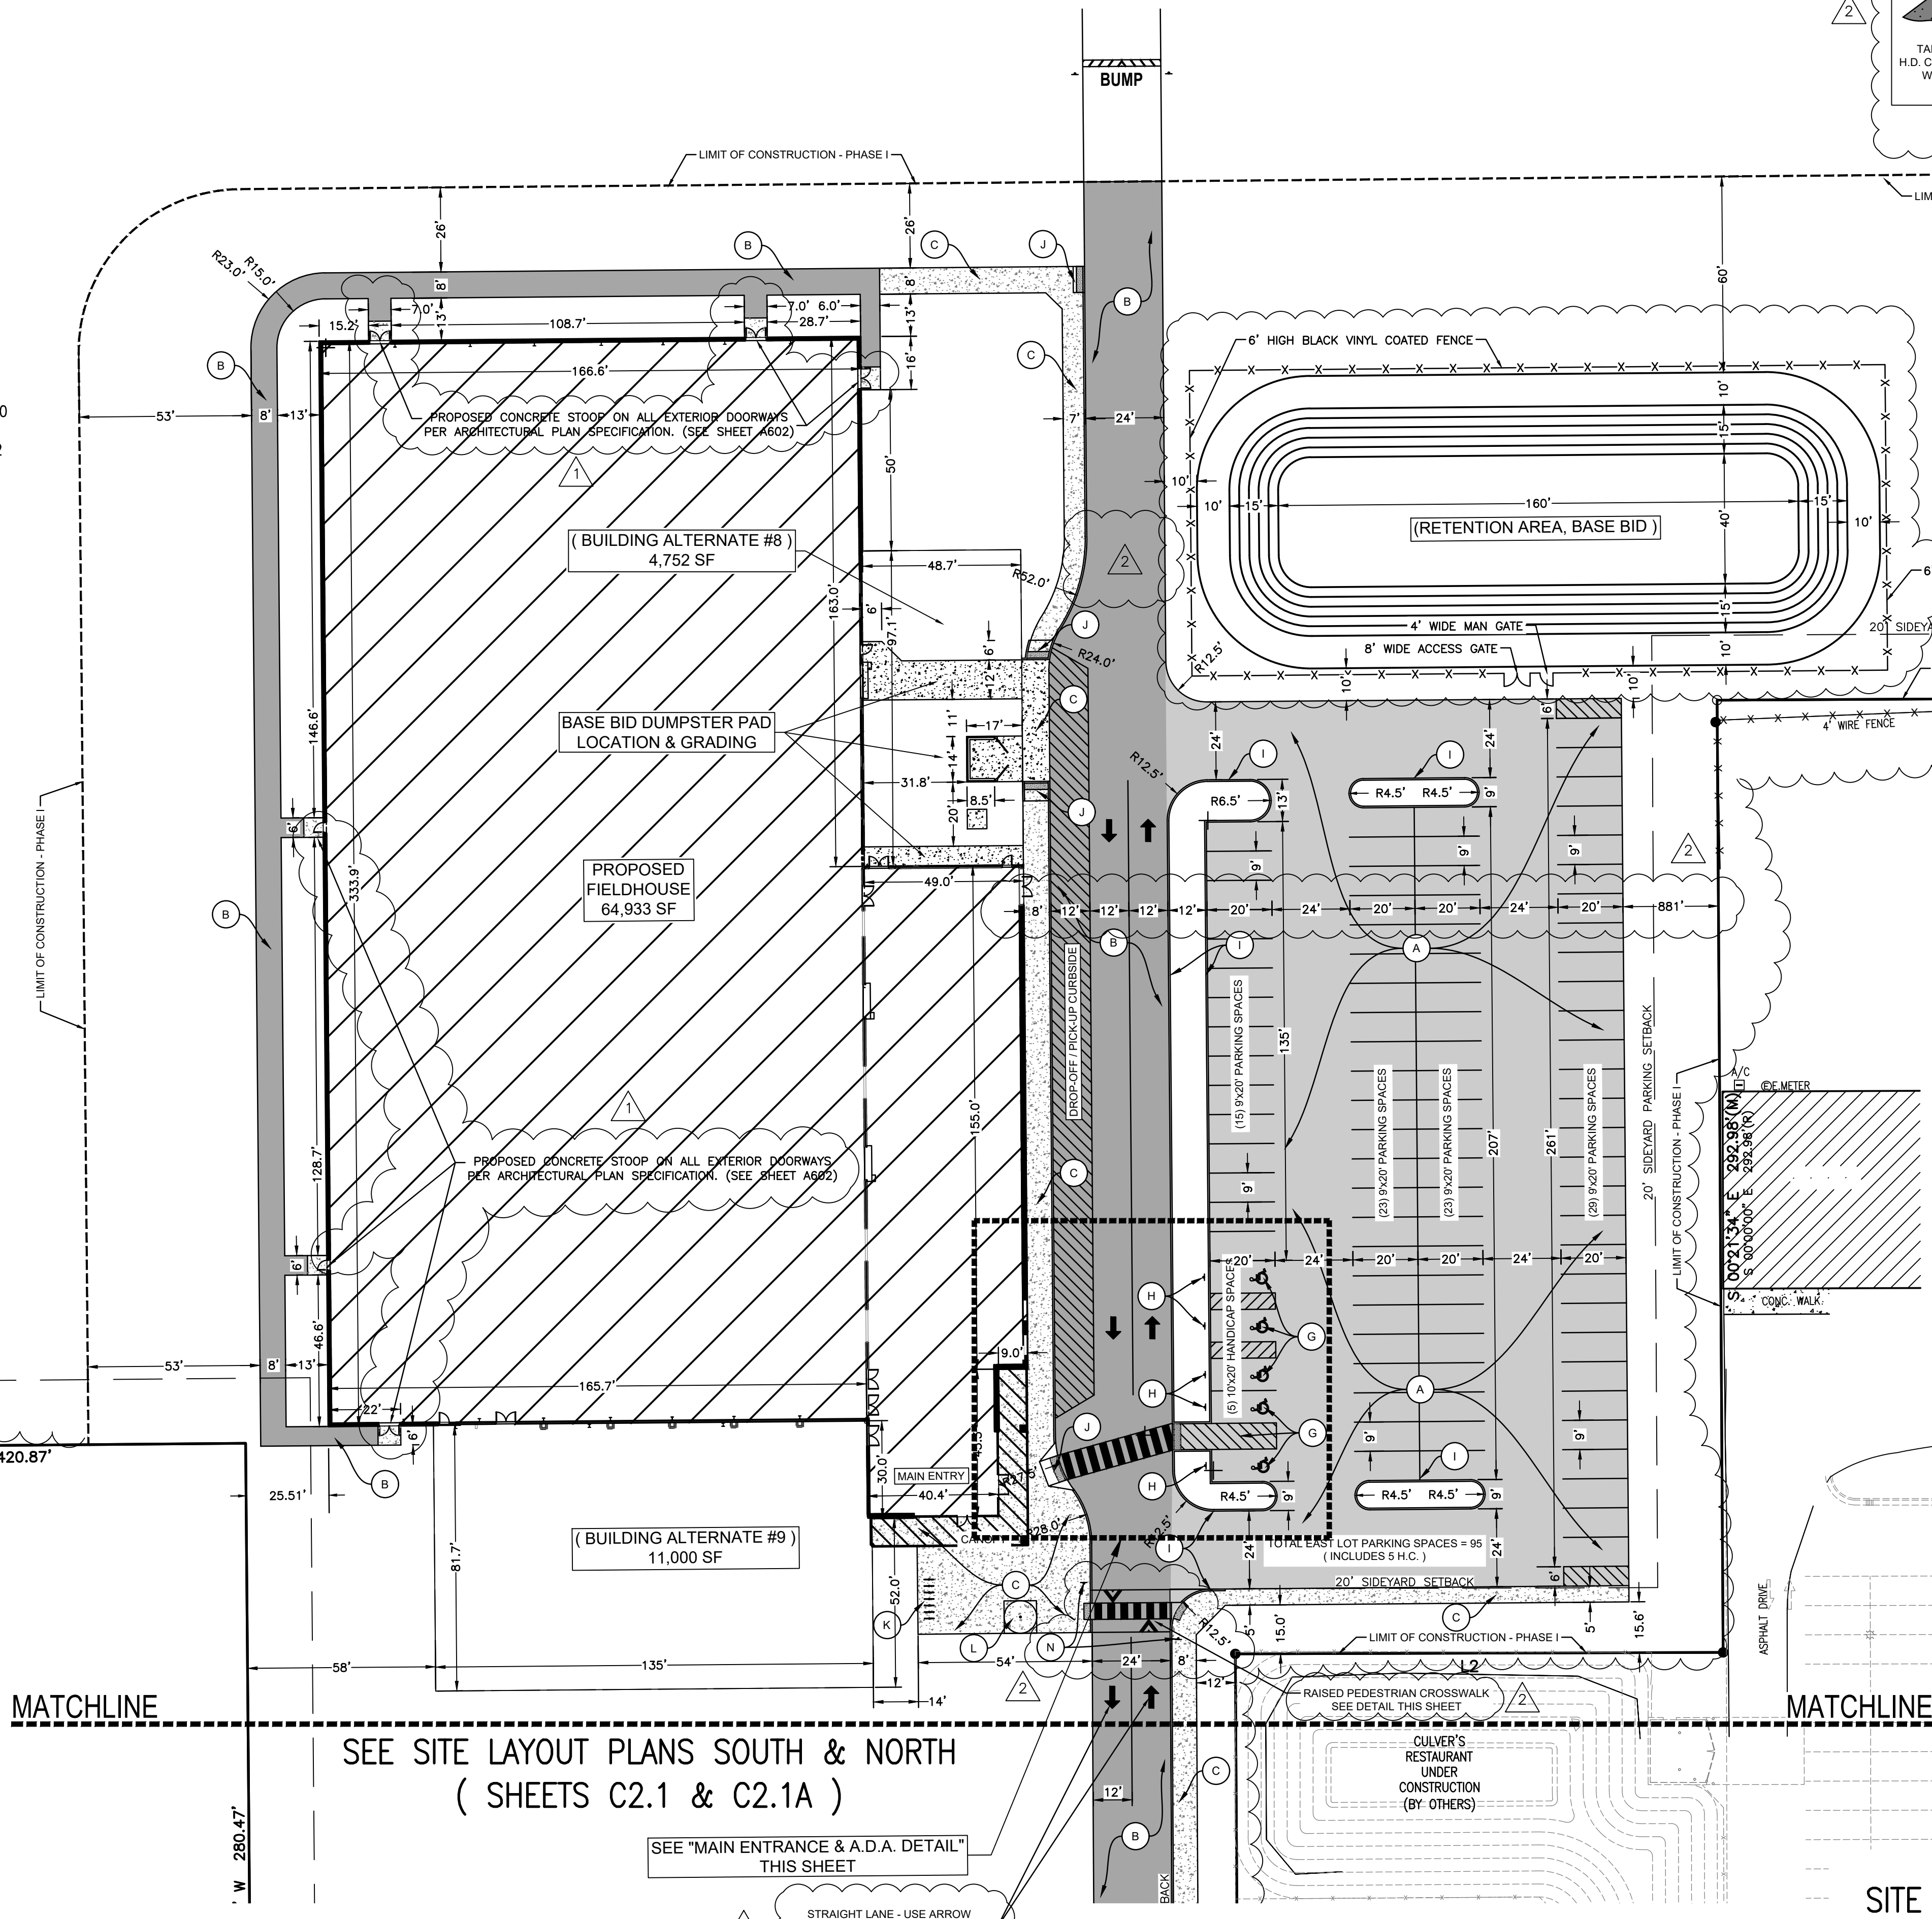

SITE LAYOUT PLAN – NORTH

SEE SITE LAYOUT PLANS SOUTH & NORTH
(SHEETS C2.1 & C2.1A)

SEE "MAIN ENTRANCE & A.D.A. DETAIL"
THIS SHEET

STRAIGHT LANE - USE ARROW
(PER MUTCD 2009 EDITION - FHWA)
(TYPICAL) SEE DETAIL THIS SHEET

PETITIONER:
PENN HARRIS MADISON
SCHOOL CORPORATION
55900 BITTERSWEET ROAD
MISHAWAKA, IN 46545
(574) 259-7941
ATTN: JOE WINTERS

SURVEYORS & ENGINEERS:
DANCH, HARNER & ASSOCIATES, INC.
1643 COMMERCE DRIVE
SOUTH BEND, IN. 46628
(574) 234-4003
ATTN: MICHAEL DANCH

DATE	BY	REVISIONS
01/10/24	ASM	
SCALE	CHECKED BY:	DATE
1" = 30'	MJD	1/28/24
FILE #	PROJ. MNGR:	BY
230228.5	MJD	ASM
		ADDENDUM #1
		ADDENDUM #2

Danch, Harner & Associates, Inc.
Land Surveyors • Professional Engineers
Landscape Architects • Land Planners

DHA

Office: (574) 234-4003 / (800) 944-4003 • Fax: (574) 234-4119
1643 Commerce Drive • South Bend, IN 46628

SHEET
C2.2

ANY INFORMATION ON THIS DRAWING IS NOT INTENDED TO BE SUITABLE FOR REUSE BY ANY PERSON, FIRM OR CORPORATION OR ANY OTHERS ON EXTENSION OF THIS PROJECT OR FOR ANY USE ON ANY OTHER PROJECT. ANY REUSE WITHOUT WRITTEN VERIFICATION AND ADOPTION BY THE ENGINEER, ARCHITECT OR SURVEYOR FOR THE SPECIFIC PURPOSE INTENDED WILL BE AT THE USER'S SOLE RISK AND WITHOUT LIABILITY OR LEGAL EXPOSURE TO THE ENGINEER, ARCHITECT OR SURVEYOR.

ALL UNDERGROUND UTILITIES MUST BE FIELD VERIFIED BY THE CONTRACTOR BEFORE ANY CONSTRUCTION MAY BEGIN.

© Copyright 2023 Danch, Harner & Associates, Inc.





PHMSC FIELDHOUSE – FINAL SITE PLAN (PHASE 1)
PART OF THE SOUTHWEST, AND NORTHWEST QUARTERS OF SECTION 6, TOWNSHIP 37 NORTH, RANGE 4 EAST,
PENN TOWNSHIP, ST. JOSEPH COUNTY, INDIANA.

PROPOSED LEGEND

- PROPOSED INLET
- PROPOSED CLEAN OUT
- PROPOSED HYDRANT
- PROPOSED LIGHT
- PROPOSED MANHOLE
- PROPOSED VALVE
- PROPOSED POLE
- PROPOSED CATCH BASIN
- PROPOSED END SECTION
- PROPOSED ELEVATION
- TOP OF WALK
- TS BOTTOM OF CURB
- TP TOP OF PAVEMENT
- TC TOP OF CURB
- BC BOTTOM OF CURB
- PROPOSED WATER
- PROPOSED ELECTRIC
- PROPOSED GAS LINE
- PROPOSED TELEPHONE
- PROPOSED CONTOUR

EXISTING LEGEND

- SET P.K. NAIL
- PINE TREE
- BUSH
- TREE
- FOUNTAIN/IRR.
- BOLLARD/POLE
- LIGHT POLE
- UTILITY POLE
- GUY ANCHOR
- SIGN
- WELL
- VALVE
- FIRE HYDRANT
- CURB INLET
- DRYWELL
- SANITARY MANHOLE
- STORM MANHOLE
- CLEAN-OUT
- FIBER OPTIC MANHOLE
- FOUND IRON
- MEASURED DISTANCE
- RECORD DISTANCE
- GAS METER
- WATER MANHOLE
- END SECTION
- ELEC. VAULT
- ELEC. TRANSFORMER
- PHONE VAULT
- SPOT ELEVATION
- EX. ELEVATION
- WIRE FENCE
- CHAIN LINK FENCE
- WOOD FENCE
- ONE-ELECTRIC
- USE-ELECTRIC
- UT-PHONE
- UG-GAS
- CTV-CABLE TV
- FO-WATER
- FO-FIBER OPTIC
- STORM LINE
- SANITARY LINE
- SET FLUSH, 5/8"
- CAPPED REBAR
- IN. REG. F-0044
- MI. REG. #22436
- SOIL BORING
- WATER METER
- CABLE PED.
- PHONE PED.
- ELEC. PED.
- MAILBOX
- A/C UNIT

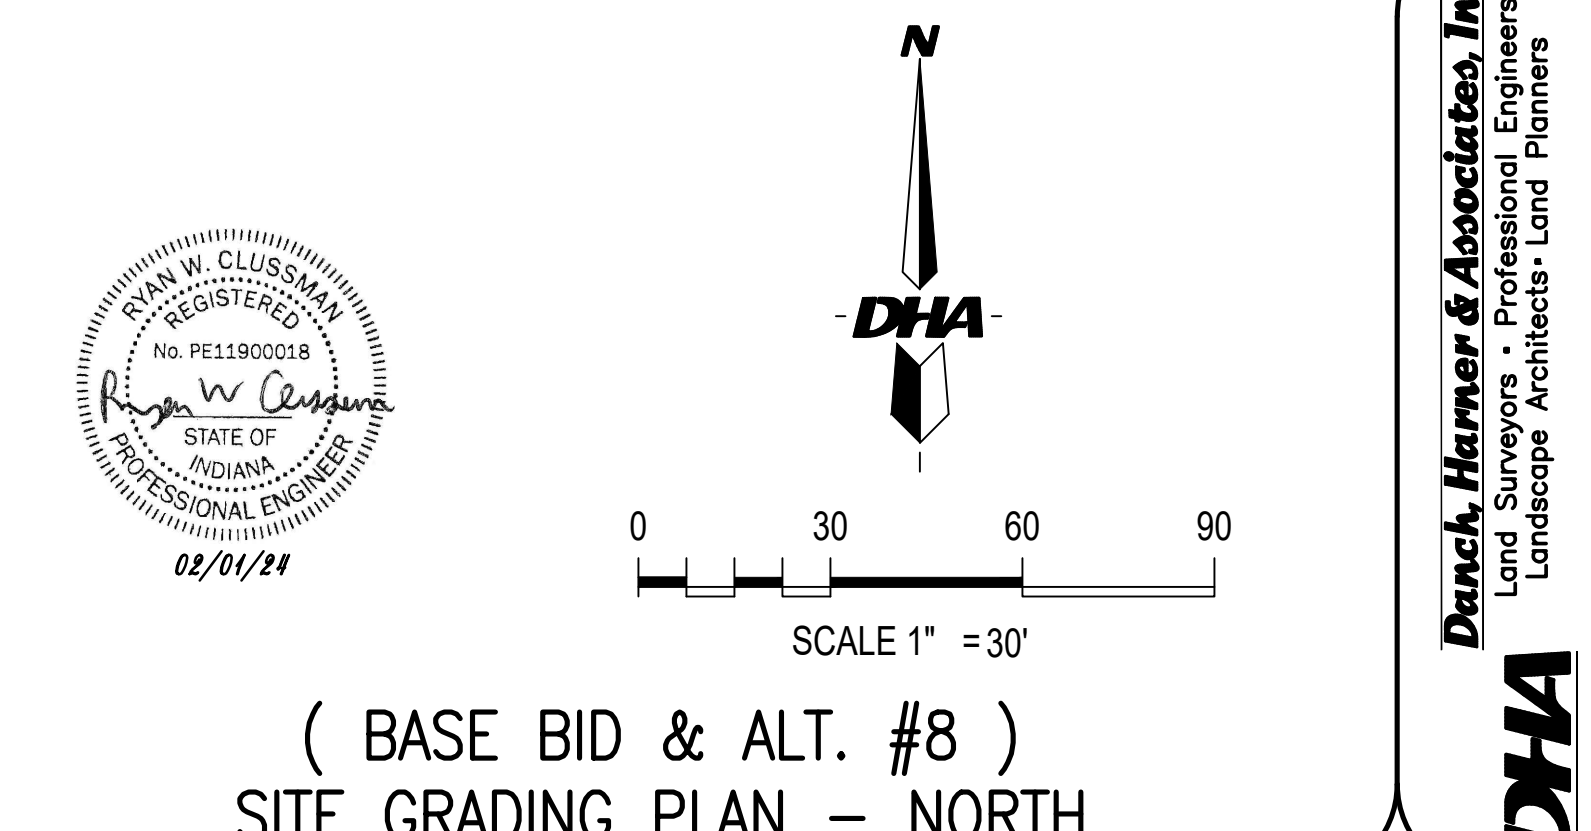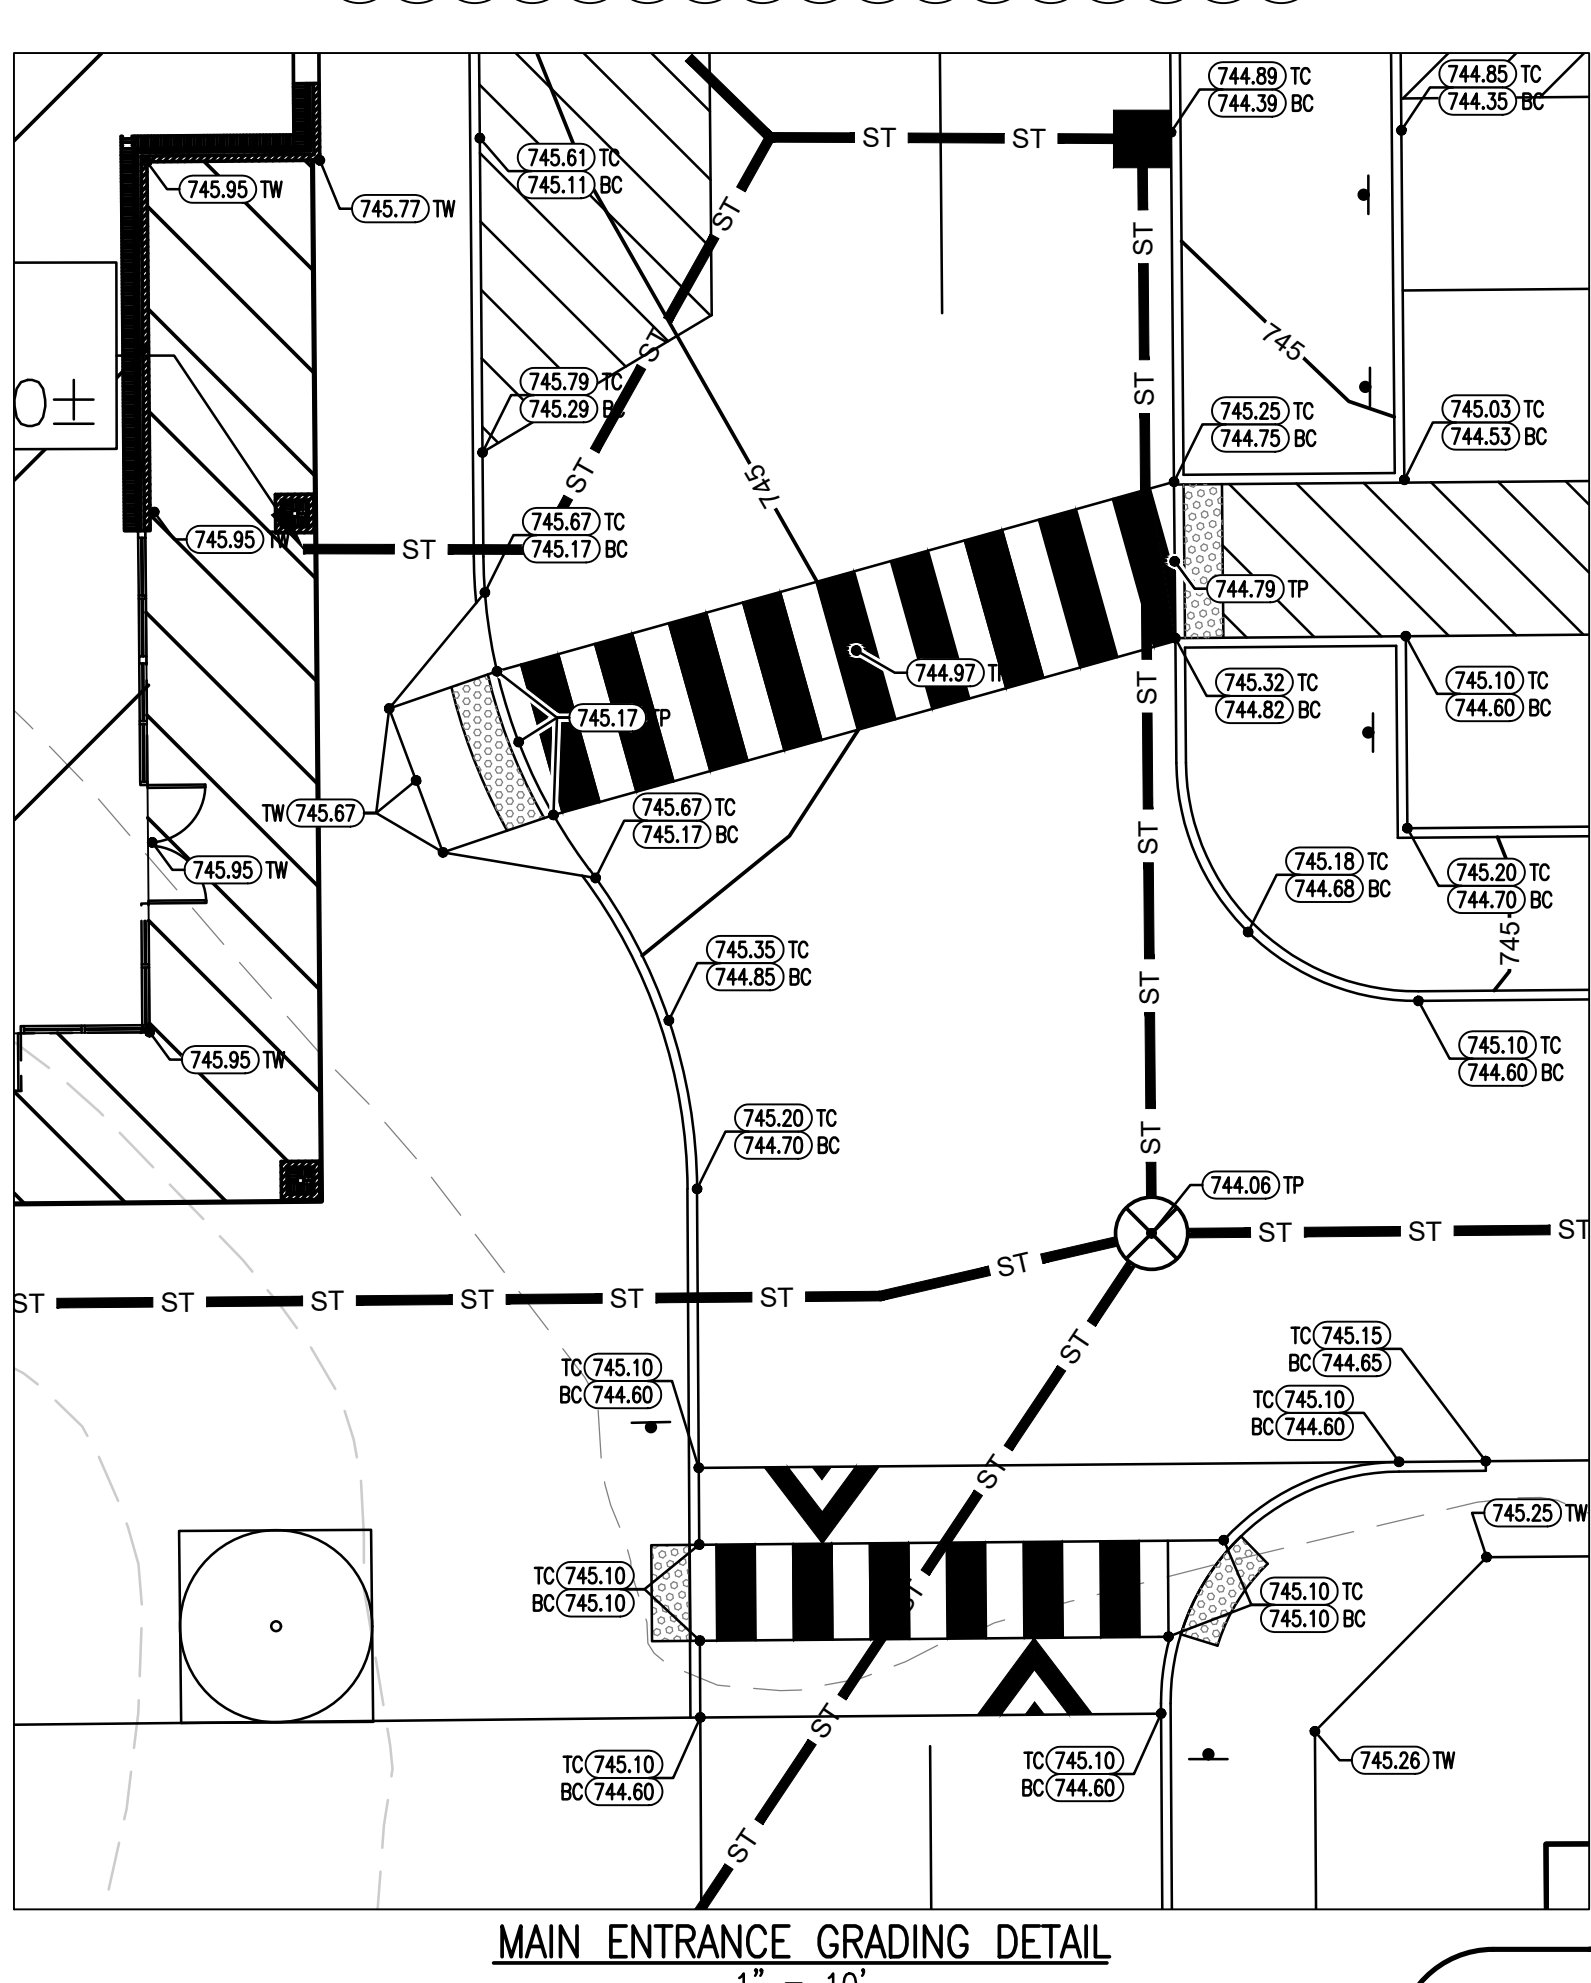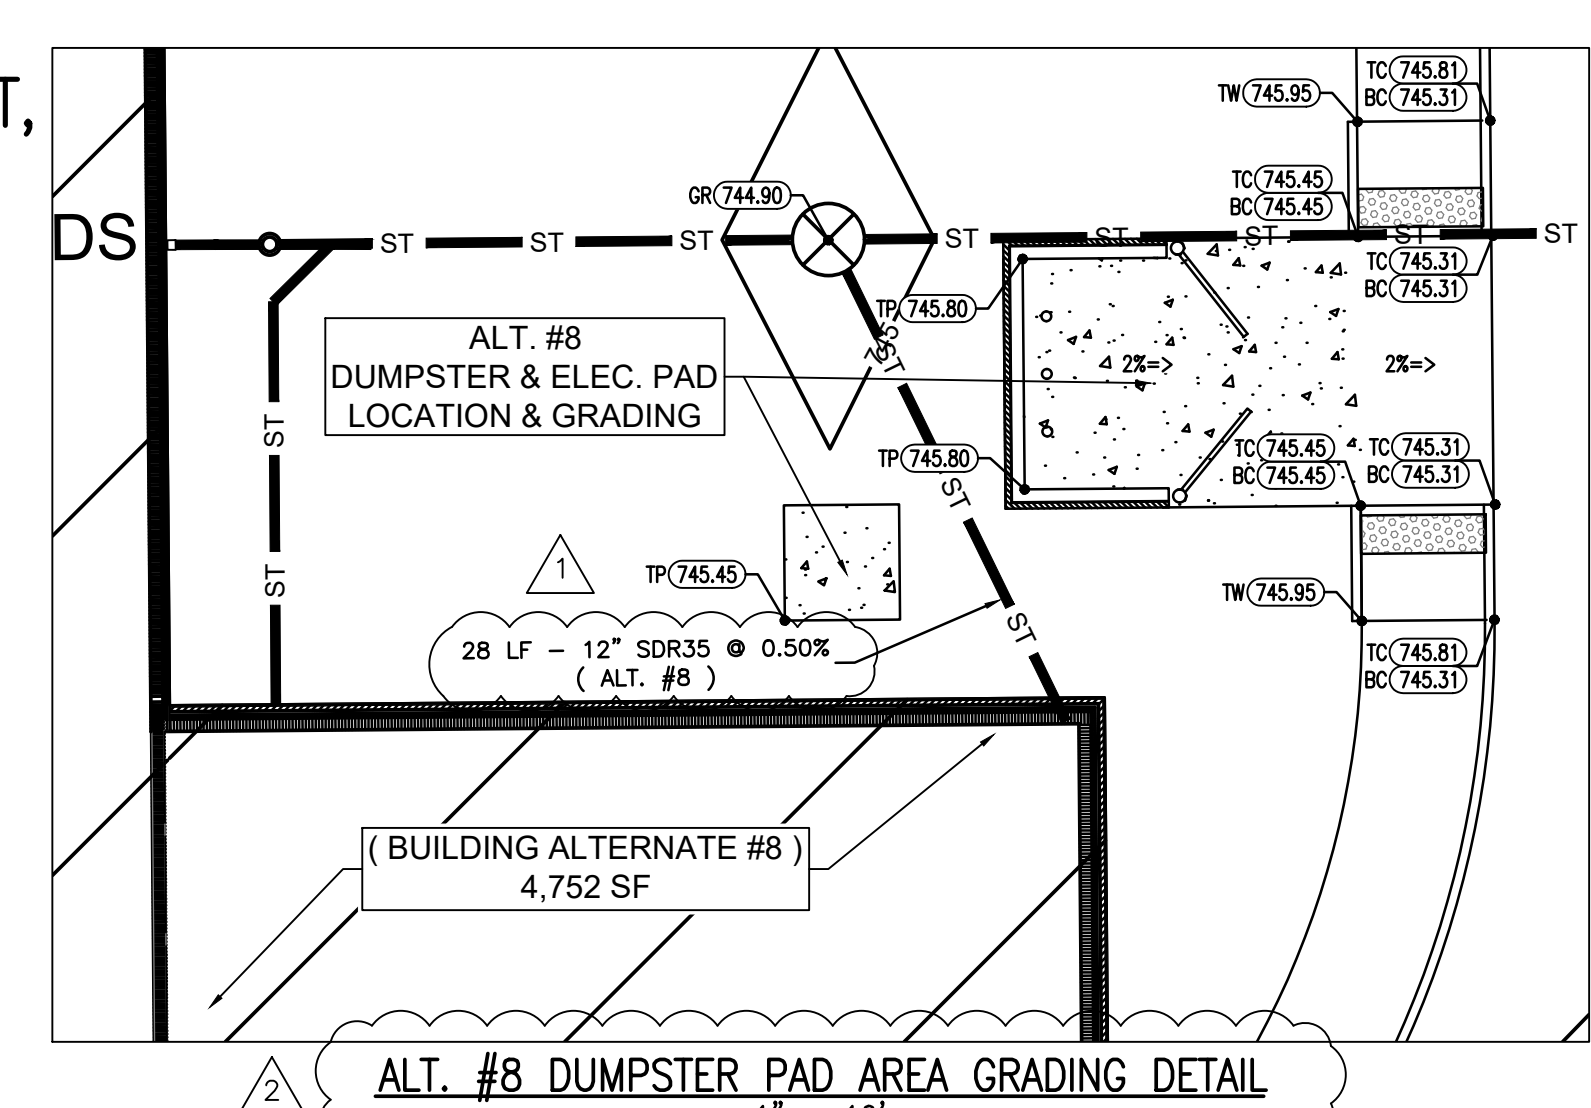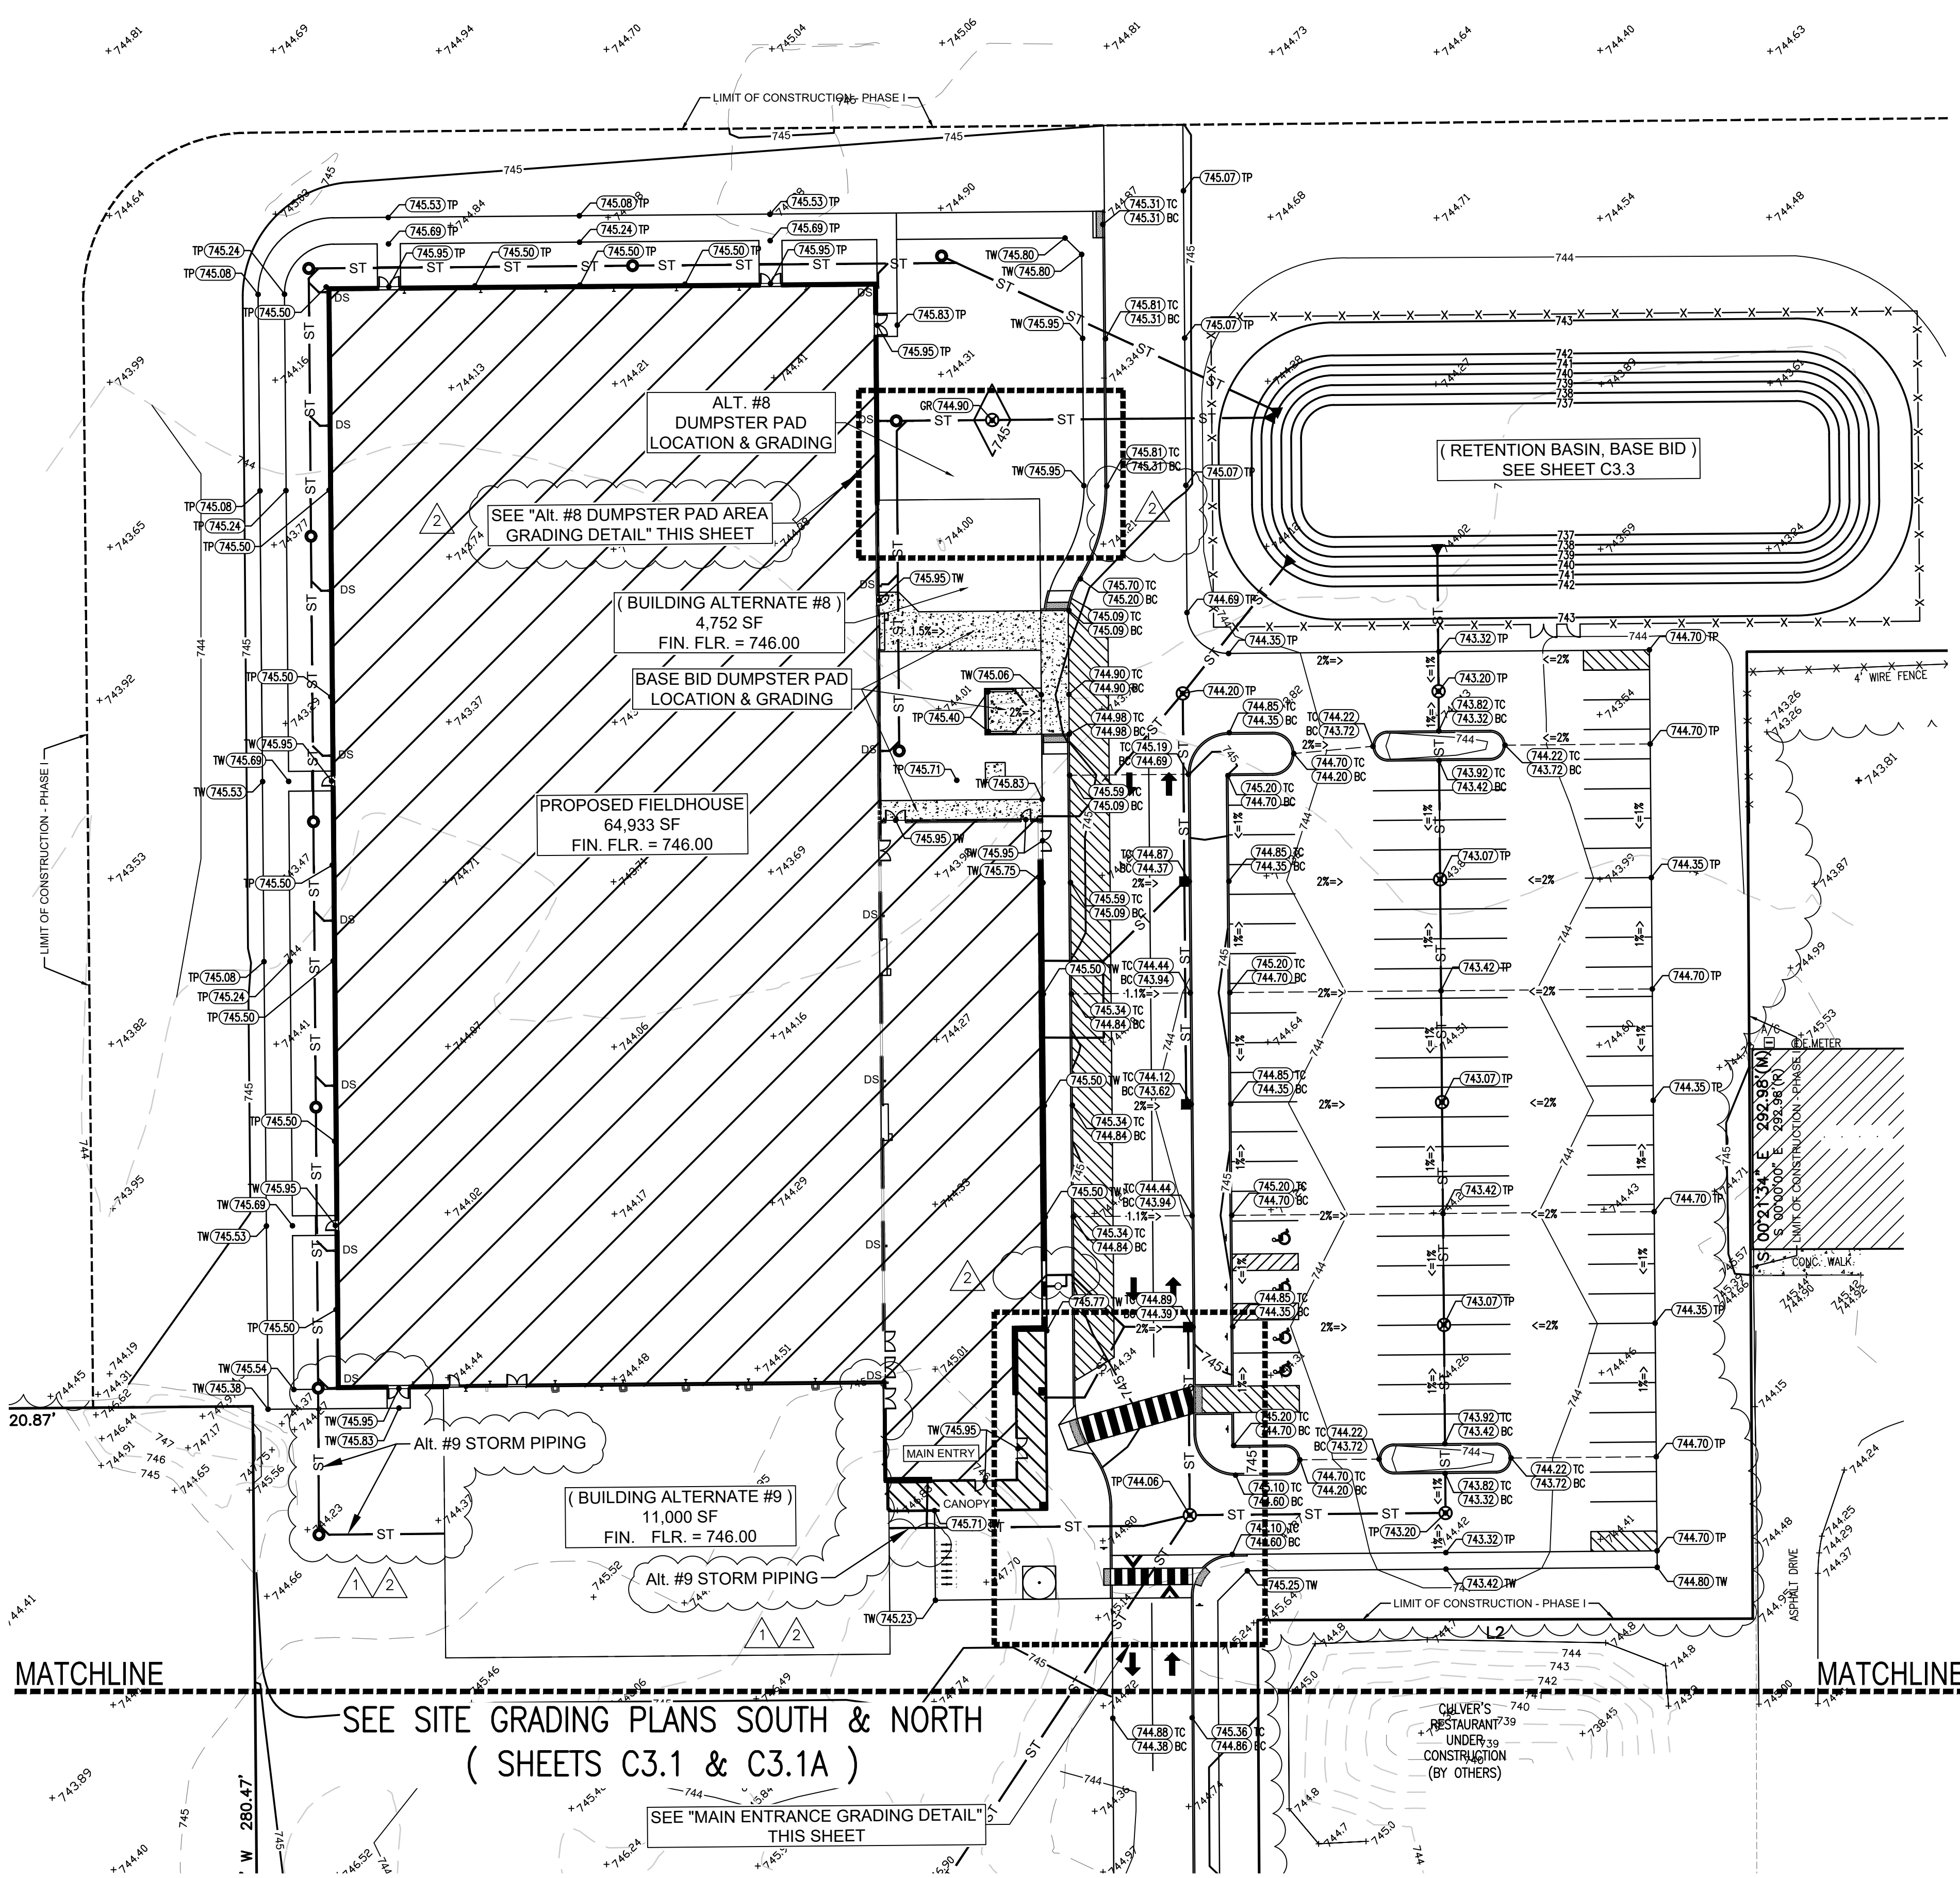

REVISIONS			
DATE	DRAWN BY:	CHECKED BY:	DATE
01/10/24	ASM	MJD	1/28/24
SCALE	1" = 30'	FILE #	230228.5
PROJ. MNGR:	MJD	BY:	ASM
ADDENDUM #1		ADDENDUM #2	

PETITIONER:

PENN HARRIS MADISON
SCHOOL CORPORATION
55900 BITTERSWEET ROAD
MISHAWAKA, IN 46628
(574) 234-4003
ATTN: JOE WINTERS

SURVEYORS & ENGINEERS:

DANCH, HARNER & ASSOCIATES, INC.
1643 COMMERCE DRIVE
SOUTH BEND, IN. 46628
(574) 234-4003
ATTN: MICHAEL DANCH

Danch, Harner & Associates, Inc.
Professional Engineers
Landscapers - Professional Engineers
Landscape Architects - Land Planners
Office: (574) 234-4003 / (800) 394-4003 • Fax: (574) 234-4119
1643 Commerce Drive • South Bend, IN 46628

SHEET


C3.2

ANY INFORMATION ON THIS DRAWING IS NOT INTENDED TO BE SUITABLE FOR REUSE BY ANY PERSON, FIRM OR CORPORATION OR ANY OTHERS ON EXTENSION OF THIS PROJECT OR FOR ANY USE ON ANY OTHER PROJECT. ANY REUSE WITHOUT WRITTEN VERIFICATION AND ADOPTION BY THE ENGINEER, ARCHITECT OR SURVEYOR FOR THE SPECIFIC PURPOSE INTENDED WILL BE AT THE USER'S SOLE RISK AND WITHOUT LIABILITY OR LEGAL EXPOSURE TO THE ENGINEER, ARCHITECT OR SURVEYOR.

ALL UNDERGROUND UTILITIES MUST BE FIELD VERIFIED BY THE CONTRACTOR BEFORE ANY CONSTRUCTION MAY BEGIN.

Copyright 2023 Danch, Harner & Associates, Inc.

PHMSC FIELDHOUSE – FINAL SITE PLAN (PHASE 1)
PART OF THE SOUTHWEST, AND NORTHWEST QUARTERS OF SECTION 6, TOWNSHIP 37 NORTH, RANGE 4 EAST,
PENN TOWNSHIP, ST. JOSEPH COUNTY, INDIANA.

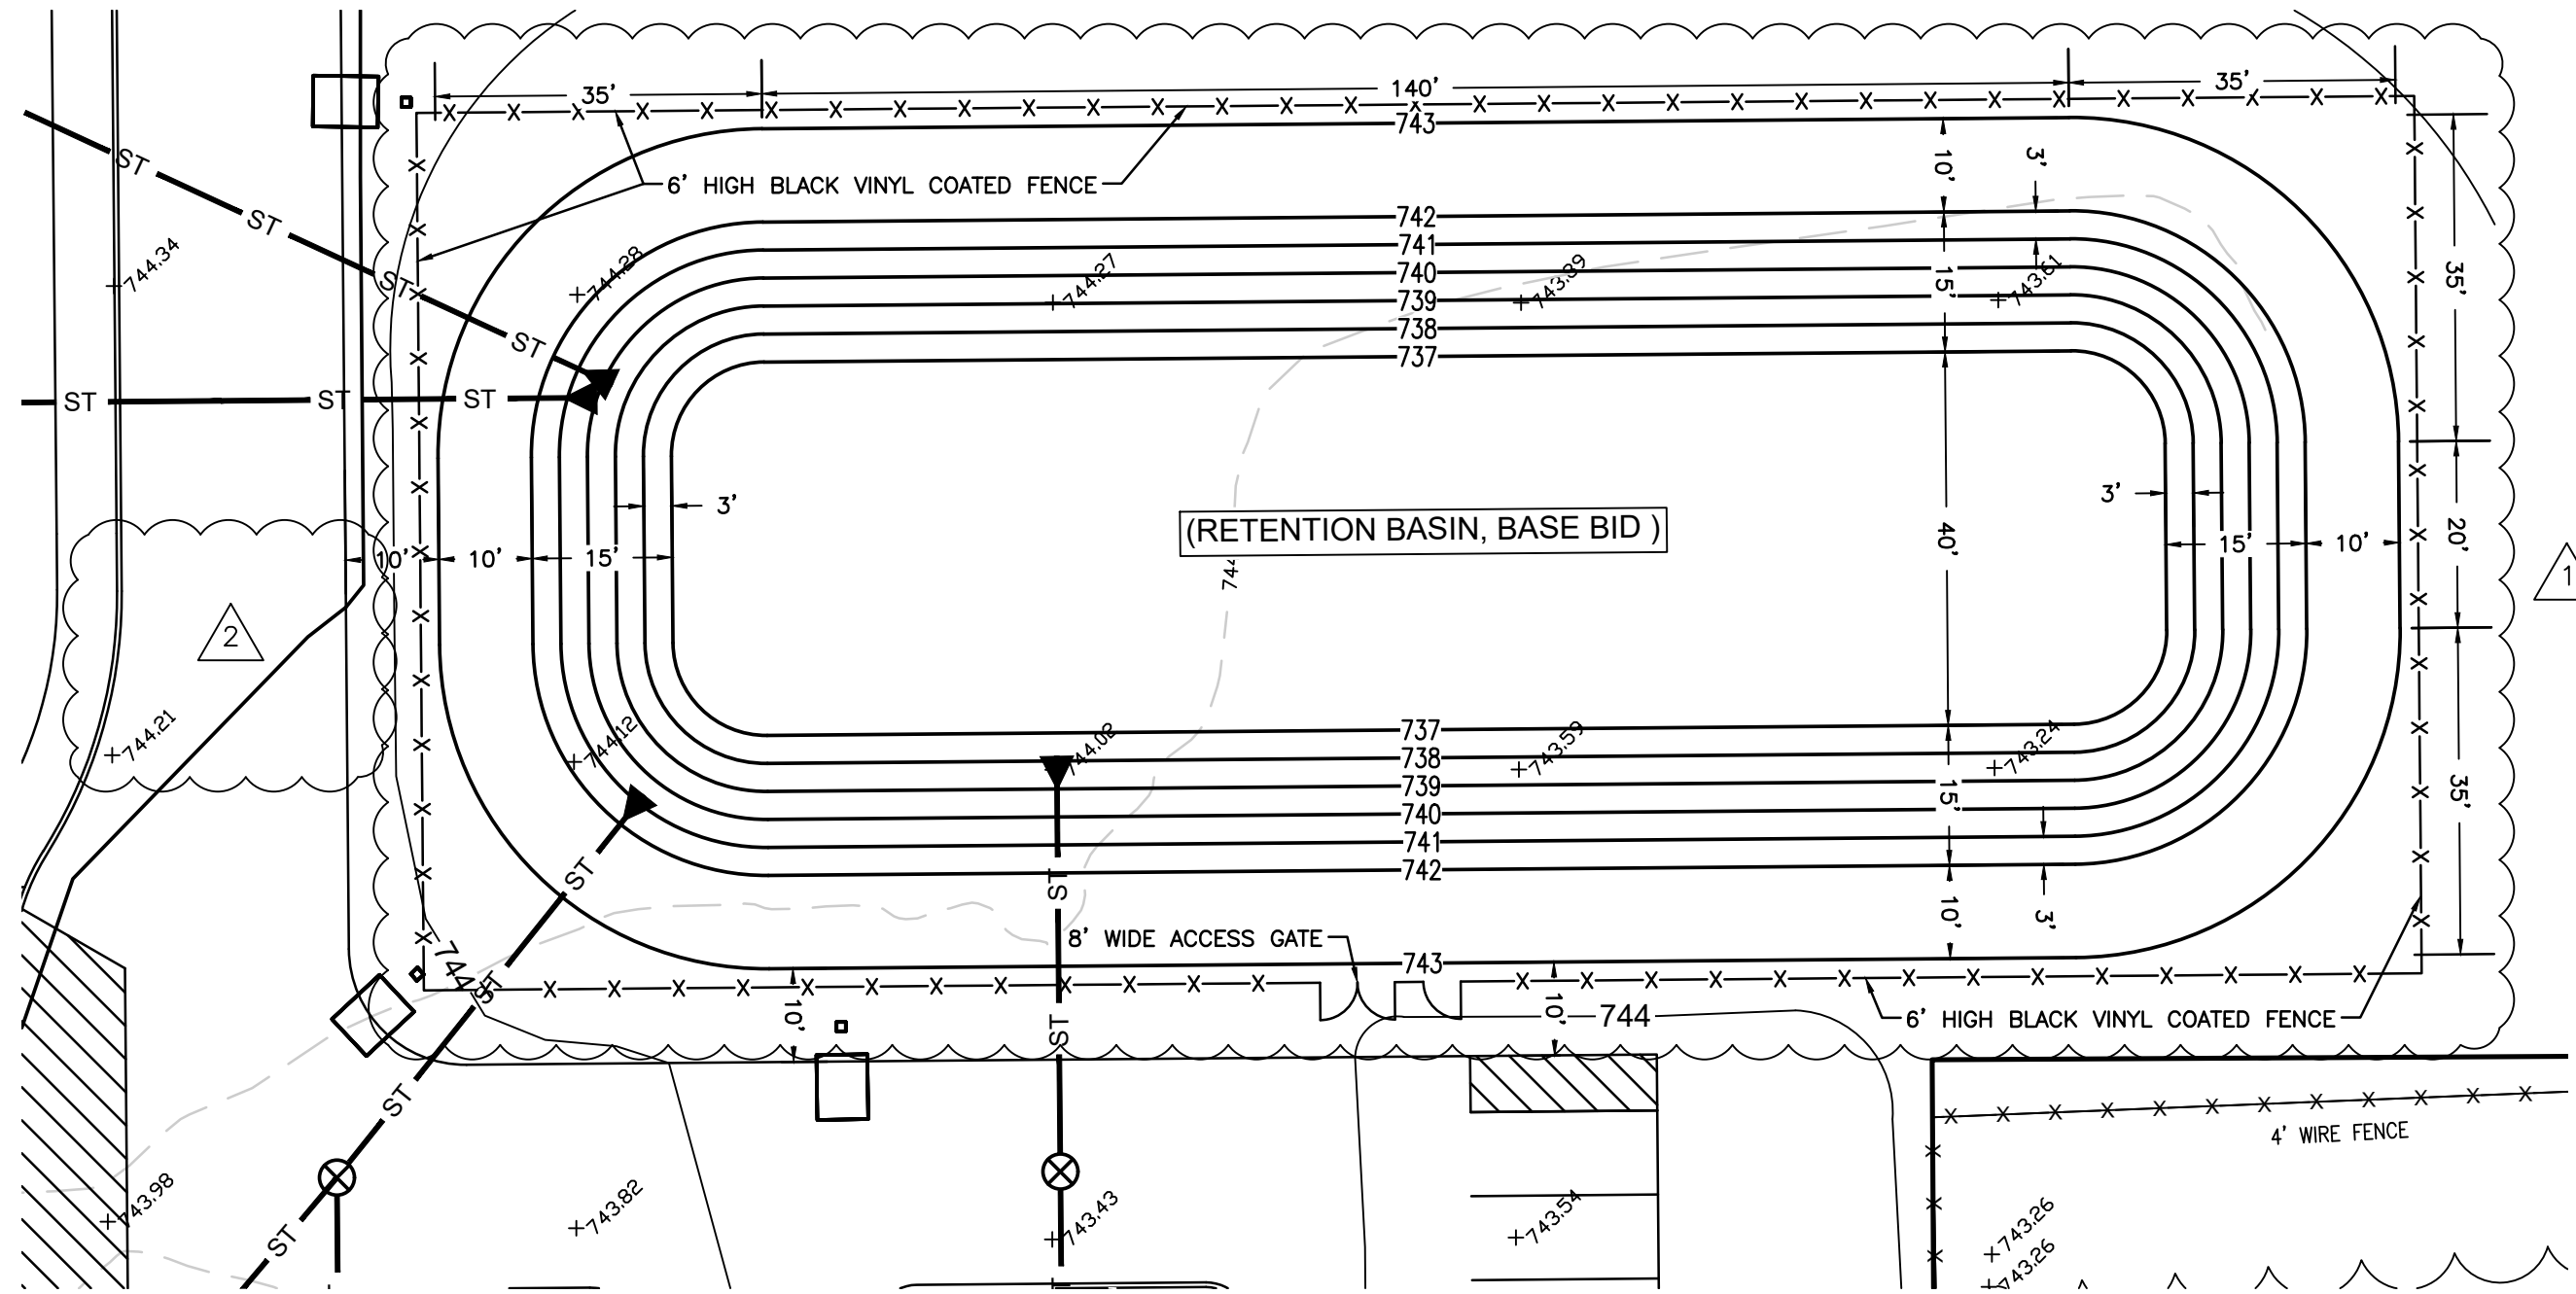

DRAINAGE CALCULATION: (RETENTION BASIN)

PHMSC FIELDHOUSE - FINAL SITE PLAN (PHASE 1)				
Post-Development	Area (ft ²)	Area (ac)	Coefficient	Total
Impervious Surface	92,781	2.130	0.99	91,853
Building	80,685	1.852	1.00	80,685
Open Space	134,781	3.094	0.23	31,000
Total	308,247	7.076		203,538
Weighted Runoff Coefficient (c) =			0.66	
Required Storage Calculation				
25 year, 24 Hour Rainfall Intensity (i) =			0.205	
Q (0.93 x 0.205 in/hr x 1.13 ac) =			0.891	ft ³ /s
Storage Required (0.215 ft ³ /s x 24 h x 3600 s + 6% siltration) =			46,260	ft ³
Proposed Storage Calculation				
Total Basin Inf. Surf. Area =			27,500	ft ²
Basin Depth =			5.0	ft
Proposed Basin			47,129	ft ³
Storage Required:			46,260	ft ³
Storage Provided:			47,129	ft ³
Surplus Storage:			869	ft ³

Project:	PHMSC FIELDHOUSE - FINAL SITE PLAN (PHASE 1)	Date:	12/7/2023
County:	ST. JOSEPH COUNTY, INDIANA.	Job No.:	230228.5
City/Town:	PENN TOWNSHIP		

Proposed Retention Basin Area				
Elevation	Area (Sq.Ft.)	Distance	Double Area	Volume (ft)
737	6314.16			
738	7490.93	1	13805.09	6902.545
739	8724.25	1	16215.18	8107.59
740	10014.11	1	18738.36	9369.18
741	11360.53	1	21374.64	10687.32
742	12763.5	1	24124.03	12062.015
743	17848.45	1	30611.95	15305.975
VOLUME RETENTION POND				47,129 CFT


BASE BID RETENTION BASIN

PROPOSED LEGEND

- PROPOSED INLET
- PROPOSED CLEAN OUT
- PROPOSED HYDRANT
- PROPOSED LIGHT
- PROPOSED MANHOLE
- PROPOSED VALVE
- PROPOSED POLE
- PROPOSED CATCH BASIN
- PROPOSED END SECTION
- PROPOSED ELEVATION
- TW TOP OF WALK
- TS BOTTOM OF CURB
- TP TOP OF PAVEMENT
- TC TOP OF CURB
- BC BOTTOM OF CURB
- PROPOSED WATER
- PROPOSED ELECTRIC
- PROPOSED GAS LINE
- PROPOSED TELEPHONE
- PROPOSED CONTOUR

EXISTING LEGEND


- SET P.K. NAIL
- FOUND IRON
- MEASURED DISTANCE
- RECORD DISTANCE
- PINE TREE
- BUSH
- TREE
- FOUNTAIN/IRR.
- BOLLARD/POLE
- LIGHT POLE
- UTILITY POLE
- GUY ANCHOR
- SIGN
- WELL
- VALVE
- FIRE HYDRANT
- CURB INLET
- DRYWELL
- SANITARY MANHOLE
- STORM MANHOLE
- CLEAN-OUT
- FIBER OPTIC MANHOLE
- EX. ELEVATION
- WIRE FENCE
- CHAIN LINK FENCE
- WOOD FENCE
- ONE-ELECTRIC
- USE-ELECTRIC
- UT-PHONE
- UG-GAS
- CTV-CABLE TV
- W-WATER
- FO-FIBER OPTIC
- FO-STORM LINE
- FO-SANITARY LINE
- SOIL BORING
- WATER METER
- CABLE PED.
- PHONE PED.
- ELEC. PED.
- MAILBOX
- A/C UNIT

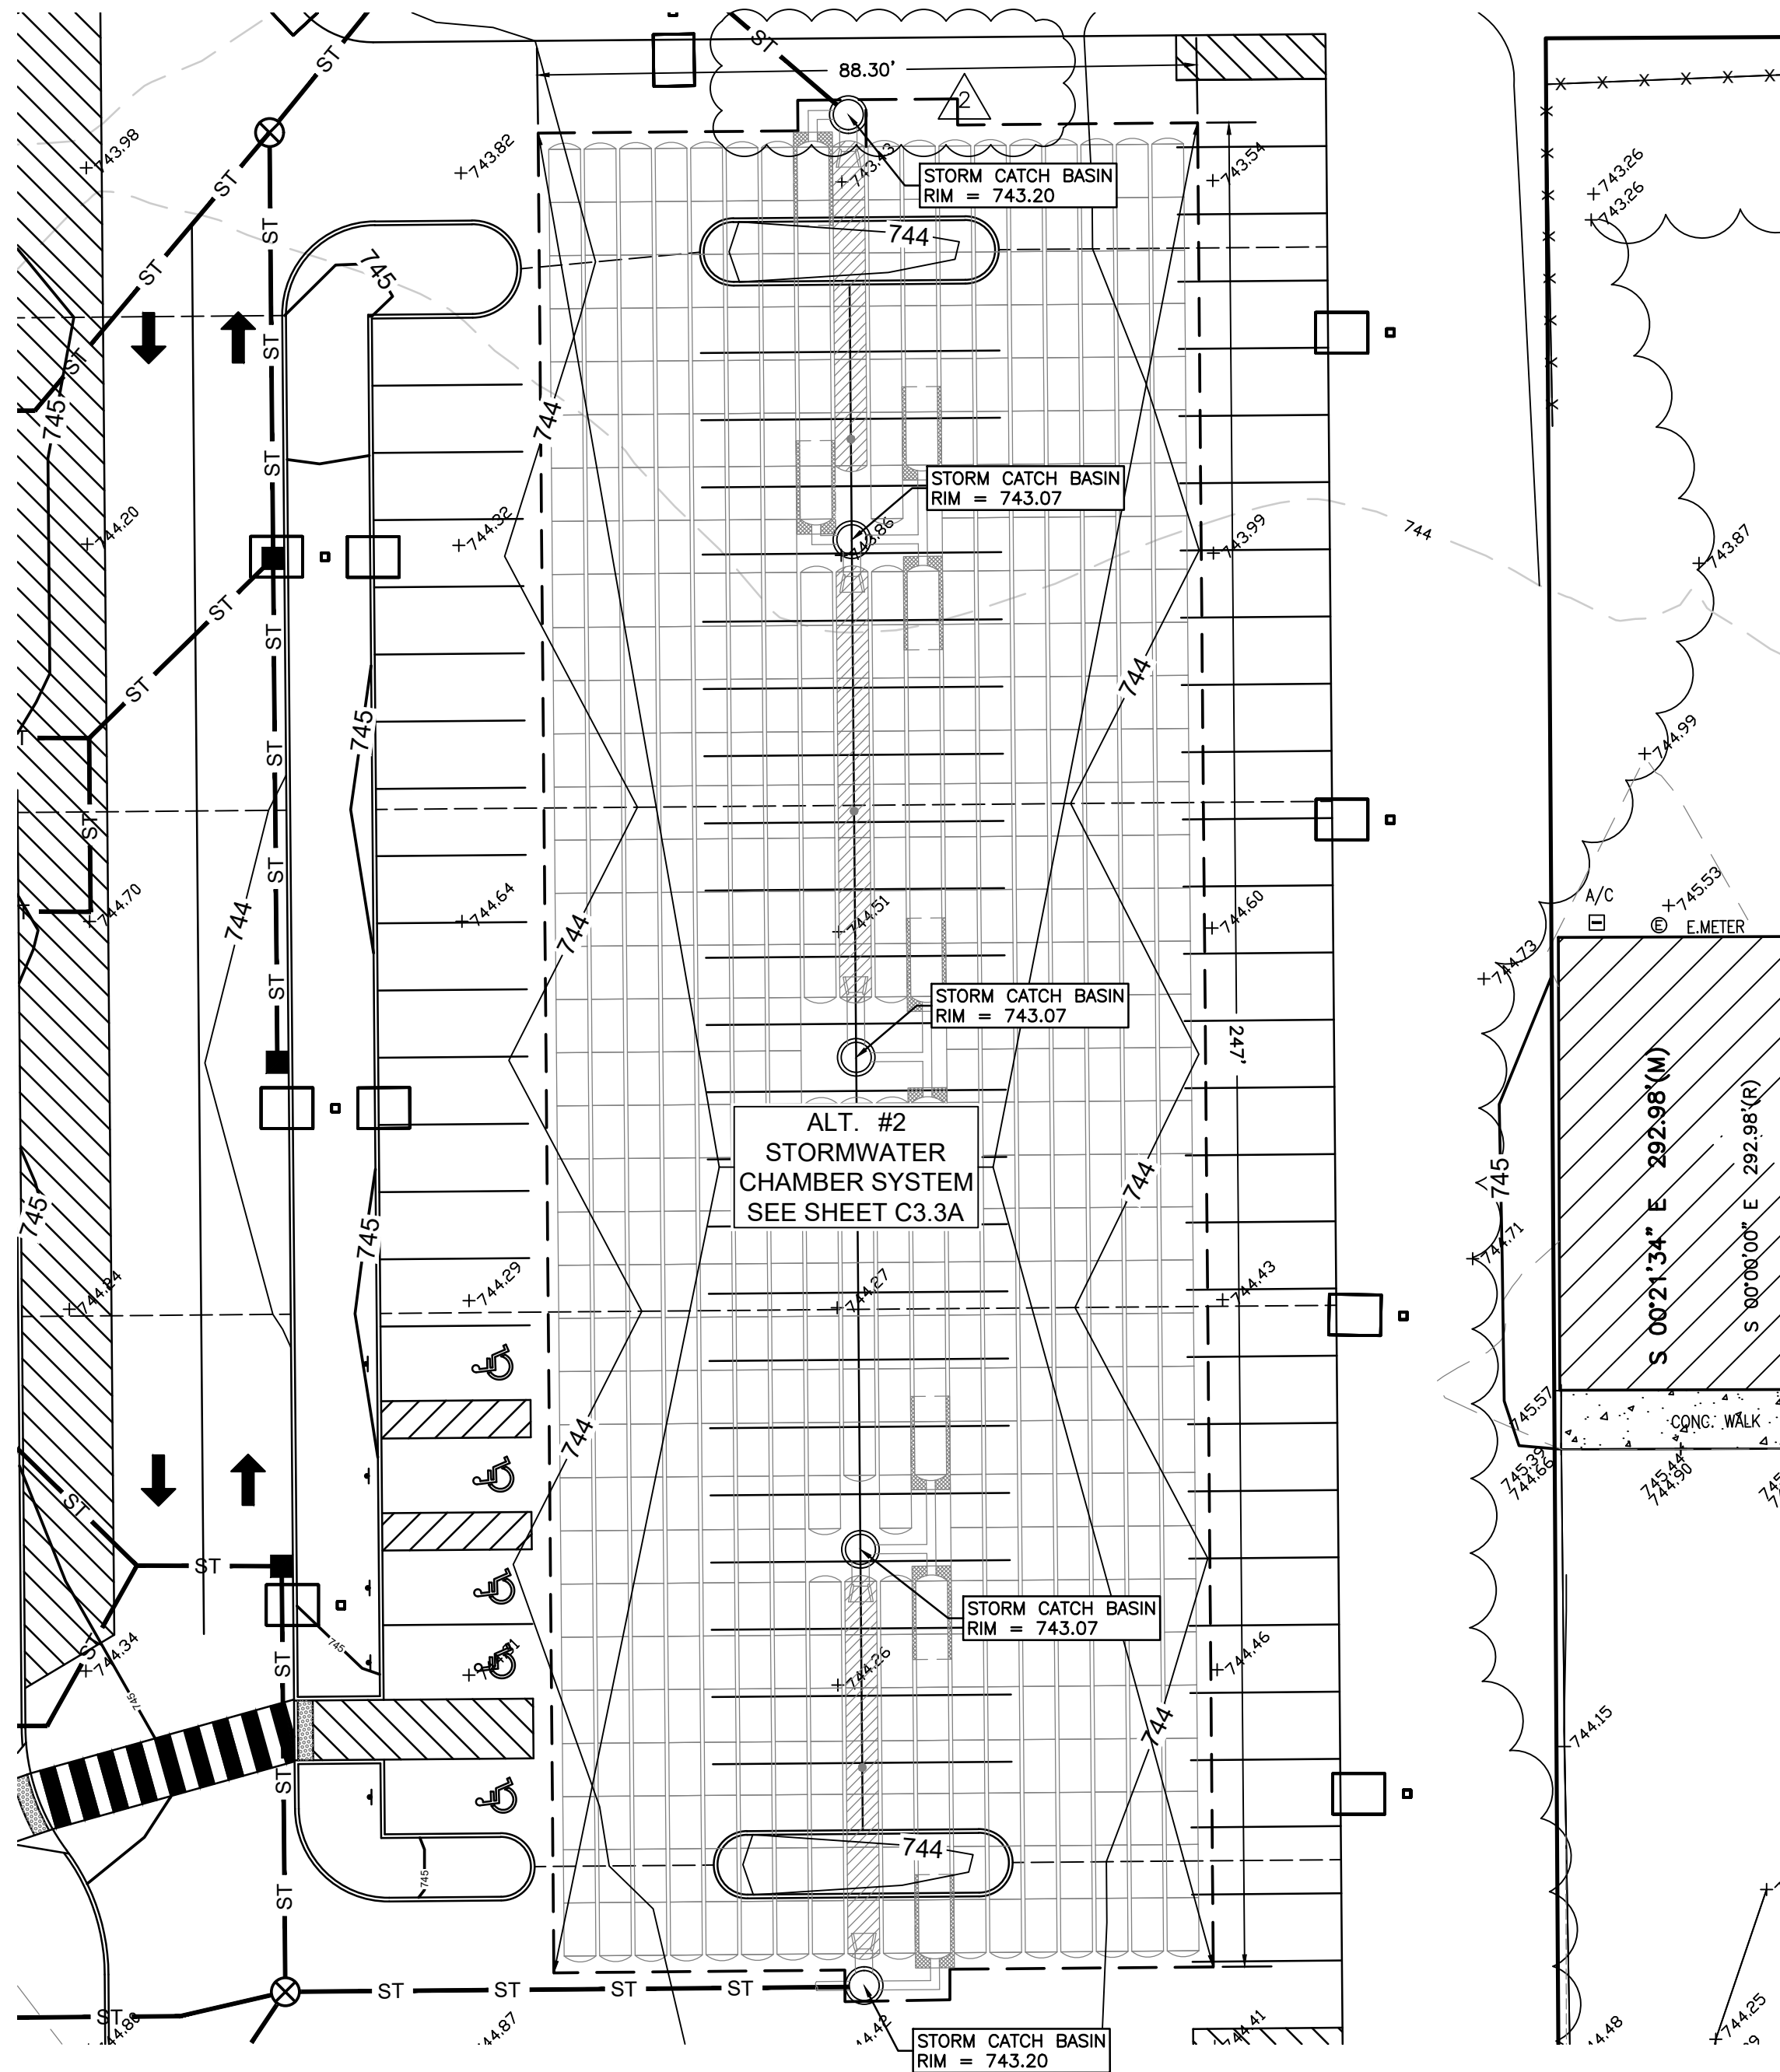

DRAINAGE CALCULATION: (ALT. #2 - CHAMBER SYSTEM)

PHMSC FIELDHOUSE - FINAL SITE PLAN (PHASE 1)				
Post-Development	Area (ft ²)	Area (ac)	Coefficient	Total
Impervious Surface	92,781	2.130	0.99	91,853
Building	80,685	1.852	1.00	80,685
Open Space	134,781	3.094	0.23	31,000
Total	308,247	7.076		203,538
Weighted Runoff Coefficient (c) =			0.66	
Required Storage Calculation				
25 year, 24 Hour Rainfall Intensity (i) =			0.205	
Q (0.93 x 0.205 in/hr x 1.13 ac) =			0.891	ft ³ /s
Storage Required (0.215 ft ³ /s x 24 h x 3600 s + 6% siltration) =			46,260	ft ³
Proposed Storage Calculation				
Total Basin Inf. Surf. Area =			27,500	ft ²
Basin Depth =			5.0	ft
Proposed Basin			47,129	ft ³
Storage Required:			46,260	ft ³
Storage Provided:			47,009	ft ³
Surplus Storage:			749	ft ³

ALT. #2 RETENTION CHAMBER SYSTEM

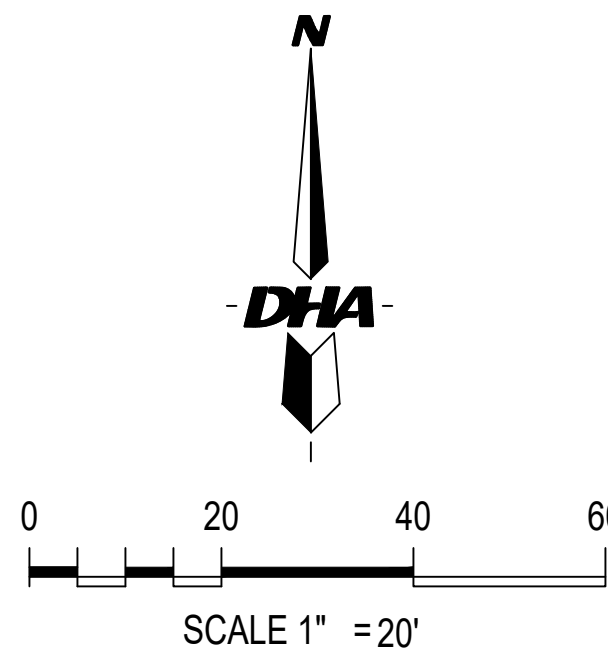

(BASE BID & ALT. #2 RETENTION)
SITE RETENTION PLAN

PETITIONER:

PENN HARRIS MADISON
SCHOOL CORPORATION
55900 BITTERSWEET ROAD
MISHAWAKA, IN 46545
(574) 259-7941
ATTN: JOE WINTERS

SURVEYORS & ENGINEERS:

DANCH, HARNER & ASSOCIATES, INC.
1643 COMMERCE DRIVE
SOUTH BEND, IN. 46628
(574) 234-4003
ATTN: MICHAEL DANCH

DATE	01/10/24
SCALE	1" = 20'
FILE #	230228.5

DRAWN BY:	ASM
CHECKED BY:	MJD
PROJ. MNGR:	MJD

REVISIONS

DATE	BY	ADDENDUM #1
1/28/24	ASM	
2/01/24	ASM	

Danch, Harner & Associates, Inc.
Land Surveyors • Professional Engineers
Landscape Architects • Land Planners
Office: (574) 234-4003 / (800) 344-4003 • Fax: (574) 234-4119
1643 Commerce Drive • South Bend, IN 46628

DHA

SHEET

C3.3

ANY INFORMATION ON THIS DRAWING IS NOT INTENDED TO BE SUITABLE FOR REUSE BY ANY PERSON, FIRM OR CORPORATION OR ANY OTHERS ON EXTENSION OF THIS PROJECT OR FOR ANY USE ON ANY OTHER PROJECT. ANY REUSE WITHOUT WRITTEN VERIFICATION AND ADOPTION BY THE ENGINEER, ARCHITECT OR SURVEYOR FOR THE SPECIFIC PURPOSE INTENDED WILL BE AT THE USER'S SOLE RISK AND WITHOUT LIABILITY OR LEGAL EXPOSURE TO THE ENGINEER, ARCHITECT OR SURVEYOR.

ALL UNDERGROUND UTILITIES MUST BE FIELD VERIFIED BY THE CONTRACTOR BEFORE ANY CONSTRUCTION MAY BEGIN.

PHMSC FIELDHOUSE – FINAL SITE PLAN (PHASE 1)
PART OF THE SOUTHWEST, AND NORTHWEST QUARTERS OF SECTION 6, TOWNSHIP 37 NORTH, RANGE 4 EAST,
PENN TOWNSHIP, ST. JOSEPH COUNTY, INDIANA.

PROJECT INFORMATION	
ENGINEERED PRODUCT MANAGER	AARON CHEEVER 978-302-0650 AARON.CHEEVER@ADSPIPE.COM
ADS SALES REP	SHAWN SMITH 574-276-5512 SHAWN.SMITH@ADS-PIPE.COM
PROJECT NO.	S387668



PENN HIGH SCHOOL FIELD HOUSE
MISHAWAKA, IN, USA

SC-740 STORMTECH CHAMBER SPECIFICATIONS

- CHAMBERS SHALL BE STORMTECH SC-740.
- CHAMBERS SHALL BE ARCH-SHAPED AND SHALL BE MANUFACTURED FROM VIRGIN, IMPACT-MODIFIED POLYPROPYLENE COPOLYMERS.
- CHAMBERS SHALL MEET THE REQUIREMENTS OF ASTM F2418, "STANDARD SPECIFICATION FOR POLYPROPYLENE (PP) CORRUGATED WALL STORMWATER COLLECTION CHAMBERS".
- CHAMBER ROWS SHALL PROVIDE CONTINUOUS, UNOBSTRUCTED INTERNAL SPACE WITH NO INTERNAL SUPPORTS THAT WOULD IMPEDE FLOW OR LIMIT ACCESS FOR INSPECTION.
- THE STRUCTURAL DESIGN OF THE CHAMBERS, THE STRUCTURAL BACKFILL, AND THE INSTALLATION REQUIREMENTS SHALL ENSURE THAT THE LOAD FACTORS SPECIFIED IN THE AASHTO LRFD BRIDGE DESIGN SPECIFICATIONS, SECTION 12.12, ARE MET FOR: 1) LONG-DURATION DEAD LOADS AND 2) SHORT-DURATION LIVE LOADS, BASED ON THE AASHTO DESIGN TRUCK WITH CONSIDERATION FOR IMPACT AND MULTIPLE VEHICLE PRESENCES.
- CHAMBERS SHALL BE DESIGNED, TESTED AND ALLOWABLE LOAD CONFIGURATIONS DETERMINED IN ACCORDANCE WITH ASTM F2787, "STANDARD PRACTICE FOR STRUCTURAL DESIGN OF THERMOPLASTIC CORRUGATED WALL STORMWATER COLLECTION CHAMBERS". LOAD CONFIGURATIONS SHALL INCLUDE: 1) INSTANTANEOUS (<1 MIN) AASHTO DESIGN TRUCK LIVE LOAD ON MINIMUM COVER 2) MAXIMUM PERMANENT (75-YR) COVER LOAD AND 3) ALLOWABLE COVER WITH PARKED (1-WEEK) AASHTO DESIGN TRUCK.
- REQUIREMENTS FOR HANDLING AND INSTALLATION:
 - TO MAINTAIN THE WIDTH OF CHAMBERS DURING SHIPPING AND HANDLING, CHAMBERS SHALL HAVE INTEGRAL, INTERLOCKING STACKING LUGS.
 - TO ENSURE A SECURE JOINT DURING INSTALLATION AND BACKFILL, THE HEIGHT OF THE CHAMBER JOINT SHALL NOT BE LESS THAN 2".
 - TO ENSURE THE INTEGRITY OF THE ARCH SHAPE DURING INSTALLATION, a) THE ARCH STIFFNESS CONSTANT SHALL BE GREATER THAN OR EQUAL TO 550 LBS/FT². THE ASC IS DEFINED IN SECTION 6.2.8 OF ASTM F2418. AND b) TO RESIST CHAMBER DEFORMATION DURING INSTALLATION AT ELEVATED TEMPERATURES (ABOVE 73° F / 23° C), CHAMBERS SHALL BE PRODUCED FROM REFLECTIVE GOLD OR YELLOW COLORS.
- ONLY CHAMBERS THAT ARE APPROVED BY THE SITE DESIGN ENGINEER WILL BE ALLOWED. UPON REQUEST BY THE SITE DESIGN ENGINEER OR OWNER, THE CHAMBER MANUFACTURER SHALL SUBMIT A STRUCTURAL EVALUATION FOR APPROVAL BEFORE DELIVERING CHAMBERS TO THE PROJECT SITE AS FOLLOWS:
 - THE STRUCTURAL EVALUATION SHALL BE SEALED BY A REGISTERED PROFESSIONAL ENGINEER.
 - THE STRUCTURAL EVALUATION SHALL DEMONSTRATE THAT THE SAFETY FACTORS ARE GREATER THAN OR EQUAL TO 1.95 FOR DEAD LOAD AND 1.75 FOR LIVE LOAD, THE MINIMUM REQUIRED BY ASTM F2787 AND BY SECTIONS 3 AND 12.12 OF THE AASHTO LRFD BRIDGE DESIGN SPECIFICATIONS FOR THERMOPLASTIC PIPE.
 - THE TEST DERIVED CREEP MODULUS AS SPECIFIED IN ASTM F2418 SHALL BE USED FOR PERMANENT DEAD LOAD DESIGN EXCEPT THAT IT SHALL BE THE 75-YEAR MODULUS USED FOR DESIGN.
- CHAMBERS AND END CAPS SHALL BE PRODUCED AT AN ISO 9001 CERTIFIED MANUFACTURING FACILITY.

IMPORTANT - NOTES FOR THE BIDDING AND INSTALLATION OF THE SC-740 SYSTEM

- STORMTECH SC-740 CHAMBERS SHALL NOT BE INSTALLED UNTIL THE MANUFACTURER'S REPRESENTATIVE HAS COMPLETED A PRE-CONSTRUCTION MEETING WITH THE INSTALLERS.
 - STORMTECH SC-740 CHAMBERS SHALL BE INSTALLED IN ACCORDANCE WITH THE "STORMTECH SC-310/SC-740/DC-780 CONSTRUCTION GUIDE".
 - CHAMBERS ARE NOT TO BE BACKFILLED WITH A DOZER OR AN EXCAVATOR SITUATED OVER THE CHAMBERS. STORMTECH RECOMMENDS 3 BACKFILL METHODS:
 - STONESHOOTER LOCATED OFF THE CHAMBER BED.
 - BACKFILL AS ROWS ARE BUILT USING AN EXCAVATOR ON THE FOUNDATION STONE OR SUBGRADE.
 - BACKFILL FROM OUTSIDE THE EXCAVATION USING A LONG BOOM HOE OR EXCAVATOR.
 - THE FOUNDATION STONE SHALL BE LEVELED AND COMPACTED PRIOR TO PLACING CHAMBERS.
 - JOINTS BETWEEN CHAMBERS SHALL BE PROPERLY SEATED PRIOR TO PLACING STONE.
 - MAINTAIN MINIMUM - 6" (150 mm) SPACING BETWEEN THE CHAMBER ROWS.
 - EMBEDMENT STONE SURROUNDING CHAMBERS MUST BE A CLEAN, CRUSHED, ANGULAR STONE 3/4"-2" (20-50 mm).
 - THE CONTRACTOR MUST REPORT ANY DISCREPANCIES WITH CHAMBER FOUNDATION MATERIALS BEARING CAPACITIES TO THE SITE DESIGN ENGINEER.
 - ADS RECOMMENDS THE USE OF "FLEXSTORM CATCH IT" INSERTS DURING CONSTRUCTION FOR ALL INLETS TO PROTECT THE SUBSURFACE STORMWATER MANAGEMENT SYSTEM FROM CONSTRUCTION SITE RUNOFF.
- NOTES FOR CONSTRUCTION EQUIPMENT**
- STORMTECH SC-740 CHAMBERS SHALL BE INSTALLED IN ACCORDANCE WITH THE "STORMTECH SC-310/SC-740/DC-780 CONSTRUCTION GUIDE".
 - THE USE OF CONSTRUCTION EQUIPMENT OVER SC-740 CHAMBERS IS LIMITED:
 - NO EQUIPMENT IS ALLOWED ON BARE CHAMBERS.
 - NO RUBBER Tired LOADERS, DUMP TRUCKS, OR EXCAVATORS ARE ALLOWED UNTIL PROPER FILL DEPTHS ARE REACHED IN ACCORDANCE WITH THE "STORMTECH SC-310/SC-740/DC-780 CONSTRUCTION GUIDE".
 - WEIGHT LIMITS FOR CONSTRUCTION EQUIPMENT CAN BE FOUND IN THE "STORMTECH SC-310/SC-740/DC-780 CONSTRUCTION GUIDE".
 - FULL 36" (900 mm) OF STABILIZED COVER MATERIALS OVER THE CHAMBERS IS REQUIRED FOR DUMP TRUCK TRAVEL OR DUMPING.

USE OF A DOZER TO PUSH EMBEDMENT STONE BETWEEN THE ROWS OF CHAMBERS MAY CAUSE DAMAGE TO THE CHAMBERS AND IS NOT AN ACCEPTABLE BACKFILL METHOD. ANY CHAMBERS DAMAGED BY THE "DUMP AND PUSH" METHOD ARE NOT COVERED UNDER THE STORMTECH STANDARD WARRANTY.

CONTACT STORMTECH AT 1-888-892-2694 WITH ANY QUESTIONS ON INSTALLATION REQUIREMENTS OR WEIGHT LIMITS FOR CONSTRUCTION EQUIPMENT.





PROPOSED LAYOUT	
592	STORMTECH SC-740 CHAMBERS
60	STORMTECH SC-740 END CAPS
6	STONE ABOVE (in)
6	STONE BELOW (in)
40	% STONE VOID
47,009	INSTALLED SYSTEM VOLUME (CF) (PERIMETER STONE INCLUDED)
21920	SYSTEM AREA (ft ²)
686	SYSTEM PERIMETER (ft)
PROPOSED ELEVATIONS	
748.99	MAXIMUM ALLOWABLE GRADE (TOP OF PAVEMENT/UNPAVED)
742.99	MINIMUM ALLOWABLE GRADE (UNPAVED WITH TRAFFIC)
742.49	MINIMUM ALLOWABLE GRADE (UNPAVED NO TRAFFIC)
742.49	MINIMUM ALLOWABLE GRADE (BASE OF FLEXIBLE PAVEMENT)
742.45	MINIMUM ALLOWABLE GRADE (TOP OF RIGID PAVEMENT)
741.49	TOP OF STONE
740.99	TOP OF SC-740 CHAMBER
739.53	12" TOP MANHOLE INVERT
738.59	12" BOTTOM CONNECTION INVERT
738.50	24" ISOLATOR ROW PLUS CONNECTION INVERT
738.49	BOTTOM OF SC-740 CHAMBER
737.99	UNDERDRAIN INVERT
737.99	BOTTOM OF STONE

NOTES

- MANHOLE SIZE TO BE DETERMINED BY SITE DESIGN ENGINEER. SEE TECHNICAL NOTE 6.32 FOR MANHOLE SIZING GUIDANCE.
- DUE TO THE ADAPTATION OF THIS CHAMBER SYSTEM TO SPECIFIC SITE AND DESIGN CONSTRAINTS, IT MAY BE NECESSARY TO CUT AND COUPLE ADDITIONAL PIPE TO STANDARD MANHOLE COMPONENTS IN THE FIELD.
- THIS CHAMBER SYSTEM WAS DESIGNED WITHOUT SITE-SPECIFIC INFORMATION ON SOIL CONDITIONS OR BEARING CAPACITY. THE SITE DESIGN ENGINEER IS RESPONSIBLE FOR DETERMINING THE SUITABILITY OF THE SOIL AND PROVIDING THE BEARING CAPACITY OF THE INSITU SOILS. THE BASE STONE DEPTH MAY BE INCREASED OR DECREASED ONCE THIS INFORMATION IS PROVIDED.
- THE SITE DESIGN ENGINEER MUST REVIEW ELEVATIONS AND IF NECESSARY ADJUST GRADING TO ENSURE THE CHAMBER COVER REQUIREMENTS ARE MET.

StormTech®
Chamber System

888-892-2694 | WWW.STORMTECH.COM

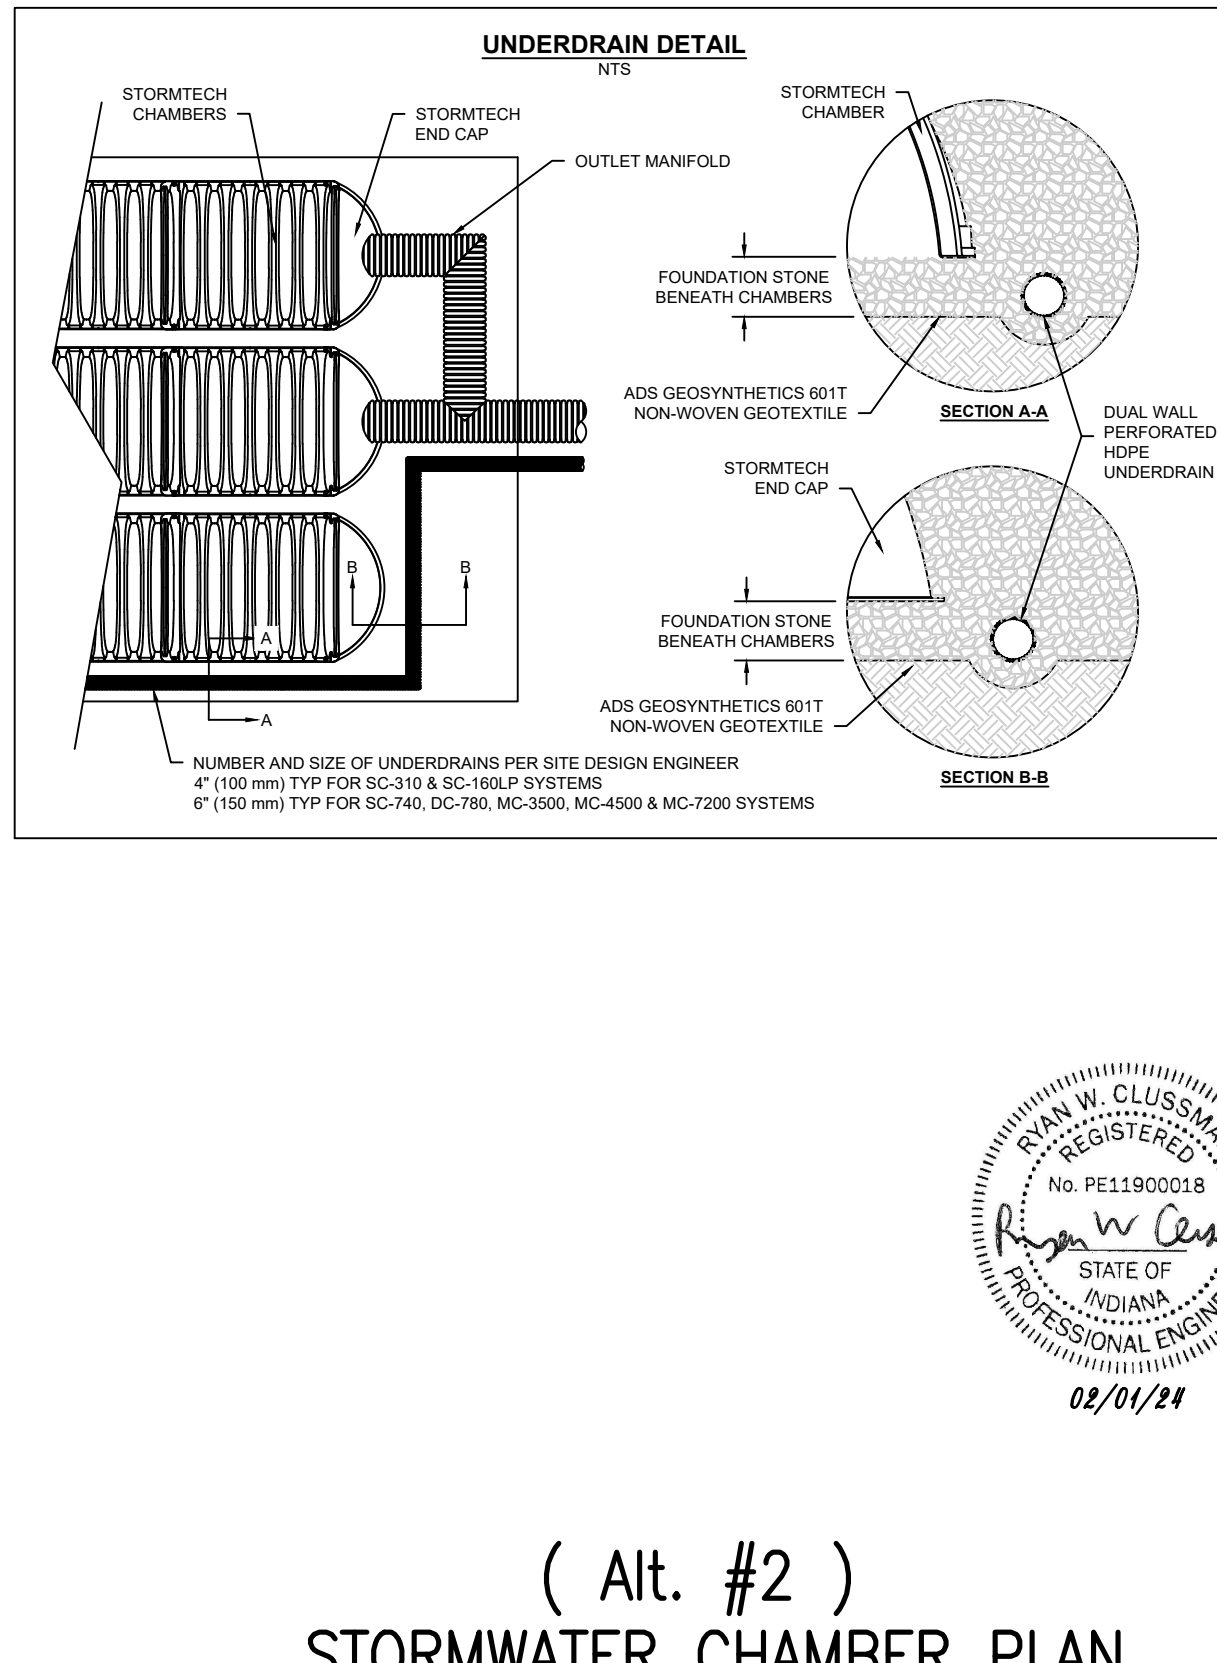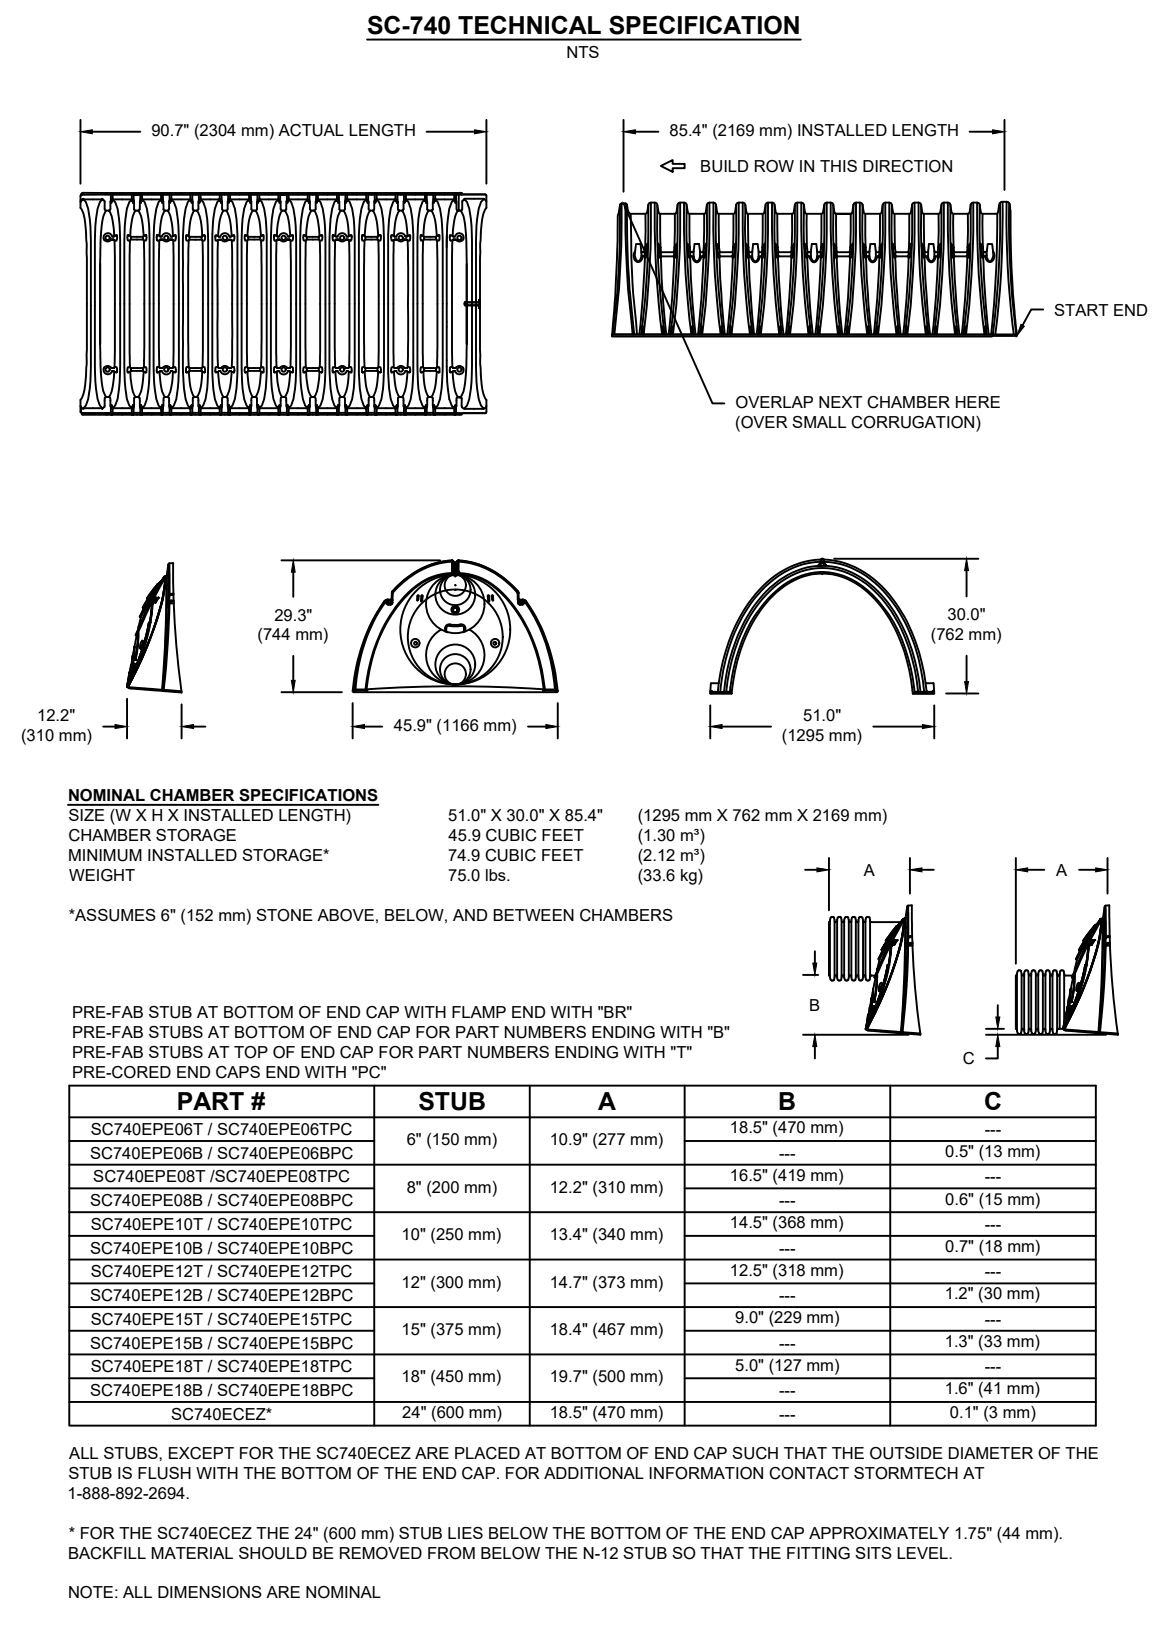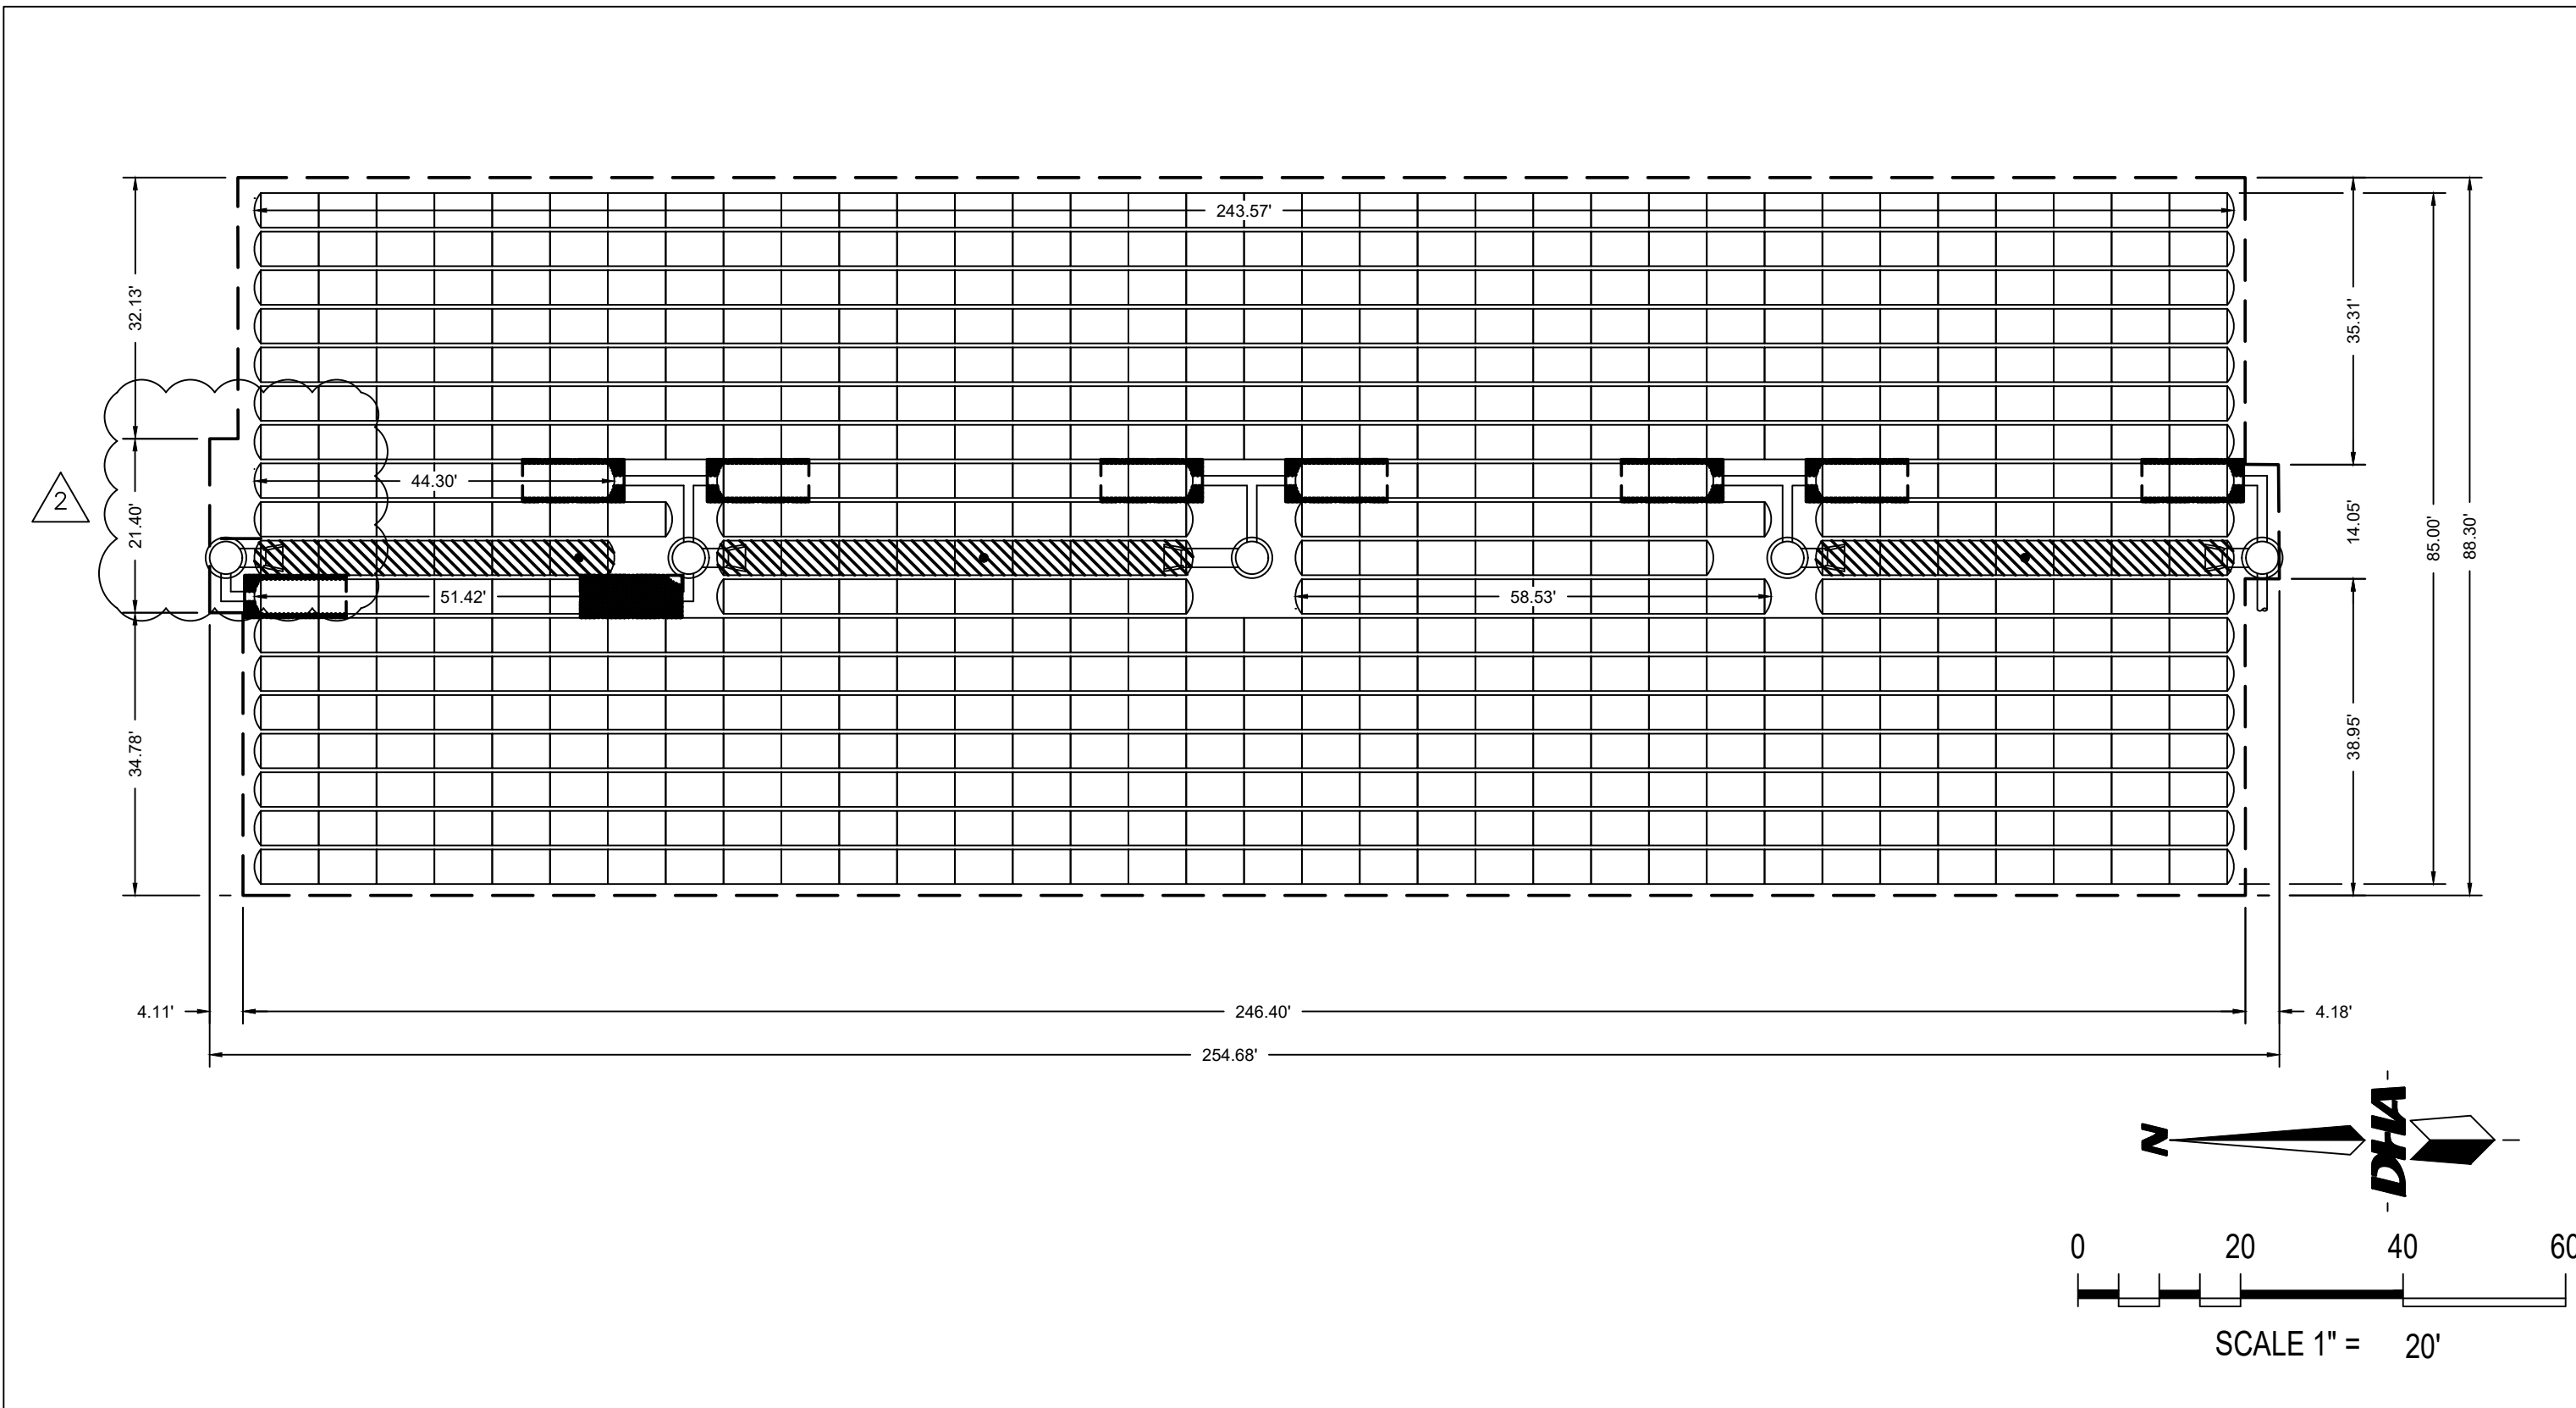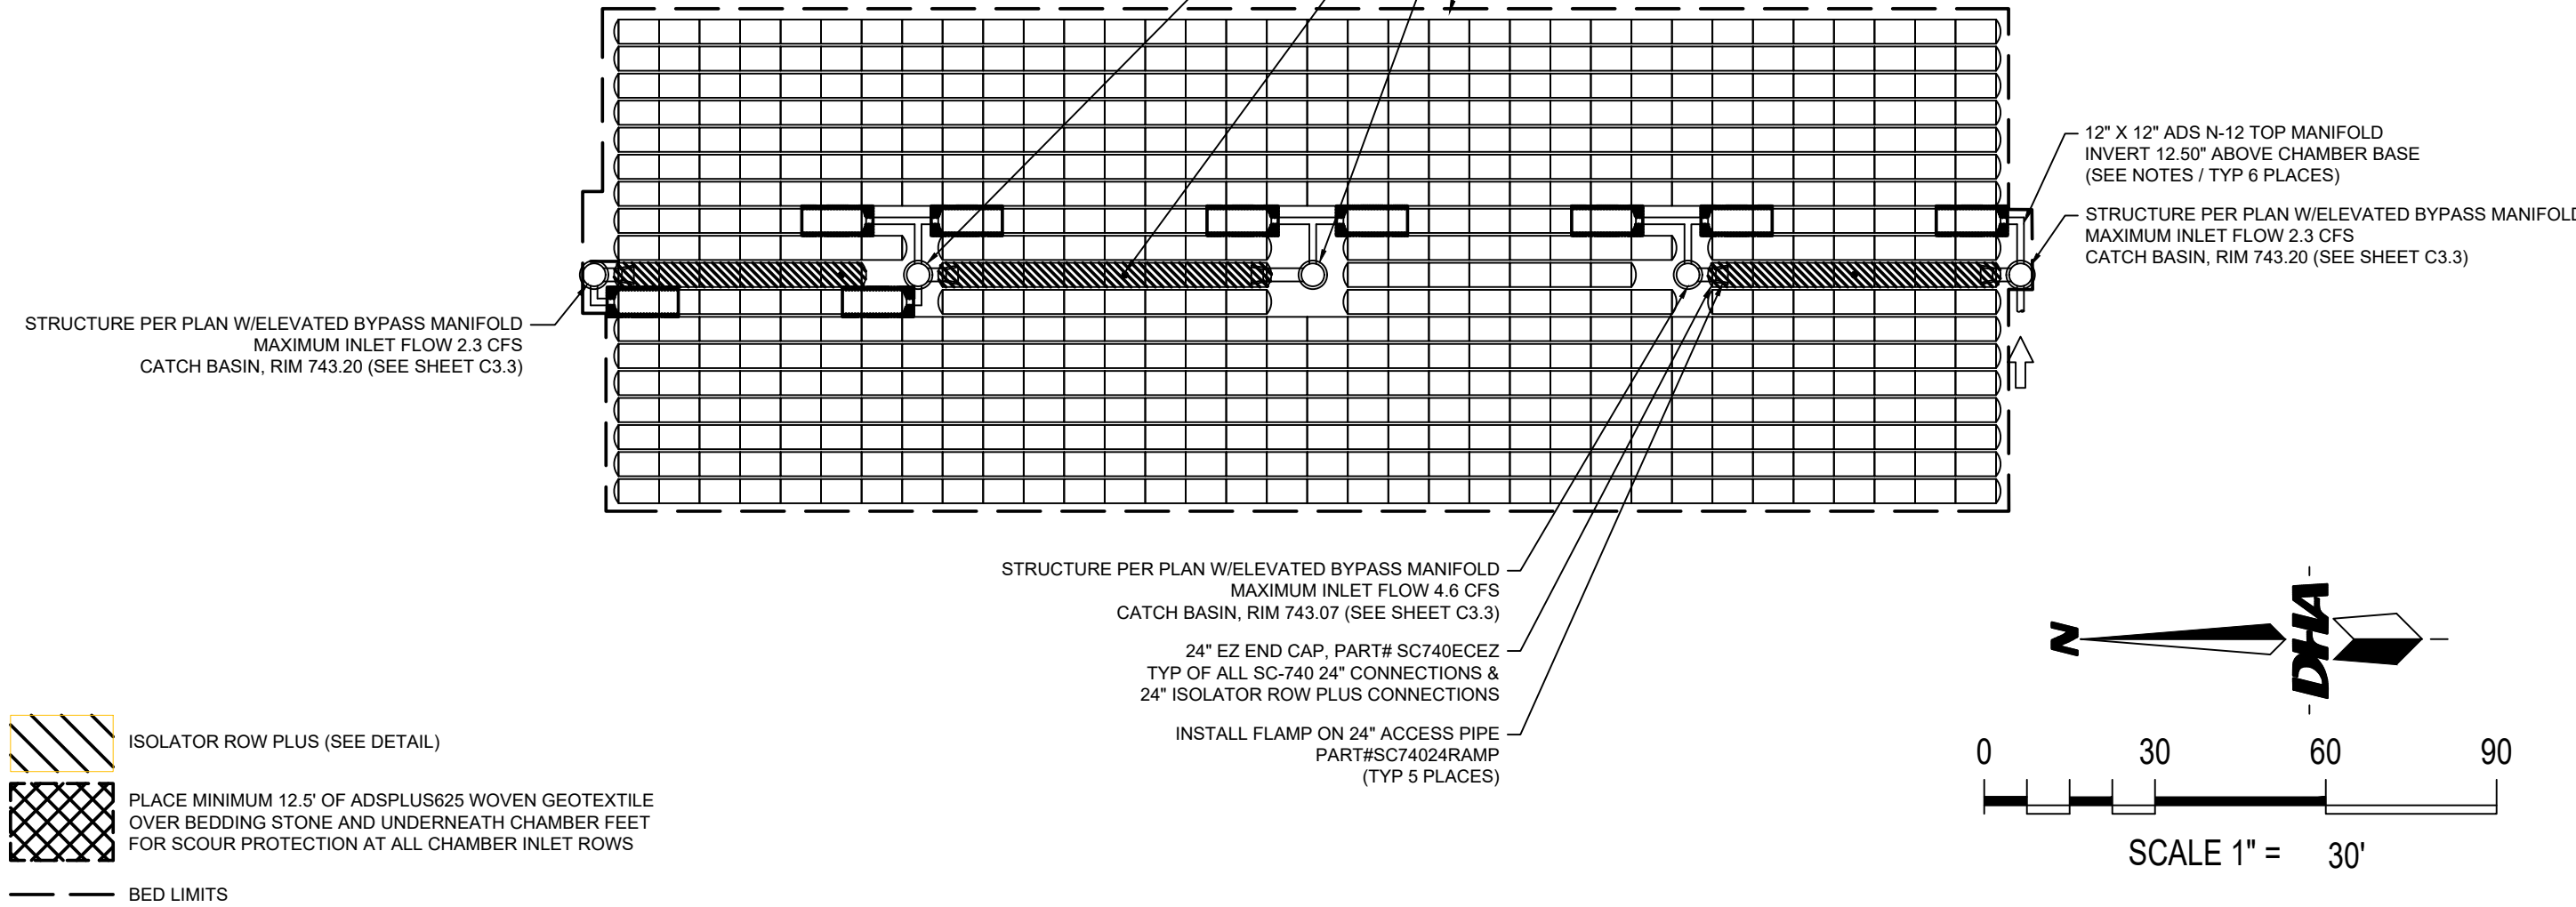

(Alt. #2)
STORMWATER CHAMBER PLAN

PETITIONER:

PENN HARRIS MADISON
SCHOOL CORPORATION
55900 BITTERSWEET ROAD
MISHAWAKA, IN 46545
(574) 259-7941
ATTN: JOE WINTERS

SURVEYORS & ENGINEERS:

DANCH, HARNER & ASSOCIATES, INC.
1643 COMMERCE DRIVE
SOUTH BEND, IN. 46628
(574) 234-4003
ATTN: MICHAEL DANCH

DATE	DRAWN BY:
01/10/24	ASM
SCALE	CHECKED BY:
NTS	MJD
FILE #	PROJ. MNGR:
230228.5	MJD

REVISIONS				
DATE	BY	ADDENDUM	REVISION	
2/01/24	ASM	#2		

Danch, Harner & Associates, Inc.
Land Surveyors • Professional Engineers
Landscape Architects • Land Planners
Office: (574) 234-4003 / (800) 944-4003 • Fax: (574) 234-4119
1643 Commerce Drive • South Bend, IN 46628

SHEET

C3.3A




ANY INFORMATION ON THIS DRAWING IS NOT INTENDED TO BE SUITABLE FOR REUSE BY ANY PERSON, FIRM OR CORPORATION OR ANY OTHERS ON EXTENSION OF THIS PROJECT OR FOR ANY USE ON ANY OTHER PROJECT. ANY REUSE WITHOUT WRITTEN VERIFICATION AND ADOPTION BY THE ENGINEER, ARCHITECT OR SURVEYOR FOR THE SPECIFIC PURPOSE INTENDED WILL BE AT THE USER'S SOLE RISK AND WITHOUT LIABILITY OR LEGAL EXPOSURE TO THE ENGINEER, ARCHITECT OR SURVEYOR.

ALL UNDERGROUND UTILITIES MUST BE FIELD VERIFIED BY THE CONTRACTOR BEFORE ANY CONSTRUCTION MAY BEGIN.

PHMSC FIELDHOUSE – FINAL SITE PLAN (PHASE 1)

PENN TOWNSHIP, ST. JOSEPH COUNTY, INDIANA.

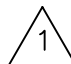UTILITY KEYNOTES:


- (2) 1-1/2" COPPER DOMESTIC WATER SERVICE:
INSTALL TAP & VALVE TAPPING METHODS AND MATERIALS PER MISHAWAKA STANDARD SPECIFICATIONS. STOP BOXES SHALL BE LOCATED BEHIND THE CURB IN LANDSCAPE ISLAND. ONE (1) MAIN METER AND SUB-METERS PER ARCHITECT'S INTERNAL PLUMBING PLAN. COORDINATE ALL ACTIVITIES WITH MISHAWAKA WATER DEPARTMENT.
- (2) 8" DUCTILE IRON WATER LINE FOR FIRE PROTECTION.
PROVIDE 12" x 8" TAP & VALVE FROM 12" WATER MAIN. FIRE LINE TO SERVICE THE ENTIRE BUILDING. SEE ARCHITECT'S PLUMBING PLAN FOR INTERNAL SPLIT. WATER UTILITIES SHALL BE INSTALLED AND TESTED PER THE "GENERAL CONSTRUCTION SPECIFICATIONS" FOR THE MISHAWAKA UTILITIES WATER DIVISION.
- (3) 6" SANITARY SEWER CONNECTION:
PROVIDE A SANITARY SEWER "DROP MANHOLE" AT END OF THE EXISTING 8" SEWER EXTENSION LEADING NORTH FROM THE EXISTING SANITARY STRUCTURE #1049 LOCATED IN MCKINLEY HWY. PAVEMENT.
PROVIDE 6" SDR 35 SANITARY SEWER MAIN FROM ROUTE LINE PER PLAN. INSTALL USING METHODS AND MATERIALS PER MISHAWAKA STANDARD SPECIFICATIONS. COORDINATE ALL ACTIVITIES WITH MISHAWAKA UTILITIES DEPARTMENT.
NOTIFY ENGINEER OF ANY CONFLICTS PRIOR TO INSTALLATION. JACK AND BORE SANITARY SEWER UNDER THE EXISTING ASPHALT PAVED FIRE DEPARTMENT DRIVEWAY PER CITY OF MISHAWAKA STANDARD SPECIFICATIONS.
- (4) ELECTRIC SERVICE: "POWER CO." TO PROVIDE UNDERGROUND SERVICE VIA TRANSFORMER. CONTRACTOR TO PROVIDE AND INSTALL 4" CONDUIT TO NEW CONNECTION LOCATION. SEE ARCHITECTURAL SHEETS FOR ELECTRICAL SCHEDULES
CONFIRM WITH ARCHITECT PRIOR TO WORK.
- (5) NATURAL GAS SERVICE: NATURAL GAS SERVICE. 
COORDINATE PIPING WITH NIPSCO.
- (6) TELEPHONE SERVICE: "TELEPHONE CO." TO PROVIDE UNDERGROUND SERVICE. CONTRACTOR TO PROVIDE AND INSTALL CONDUIT WIRE TO NEW CONNECTION LOCATION AS DETERMINED BY OWNER/ARCHITECT.
- (7) DOWNSPOUTS ARE TO BE CONNECTED TO 12" SDR 35 STORM SEWER SYSTEM AS SHOWN IN THE PLANS AT 0.5% SLOPE MINIMUM. INSTALL CLEAN-OUTS WERE NECESSARY FOR MAINTENANCE. 
- (8) PAVEMENT PATCH PER MISHAWAKA ENGINEERING STANDARDS. SEE PAVEMENT PATCH DETAIL IV-2 ON SHEET C7.1
- (9) PROPOSED FIRE HYDRANT LOCATED PER MISHAWAKA FIRE DEPT. & WATER DEPT. SEE DETAIL ON SHEET C7.2 

UTILITY NOTE:

CONTRACTOR TO FIELD VERIFY LOCATION, SIZE AND
INVERT OF "MAPPED" EXISTING SANITARY SEWER PRIOR
TO INSTALLATION. NOTIFY ENGINEER OF ANY CONFLICTS
PRIOR TO INSTALLATION. OPEN-CUT TRENCH ALL
UTILITY CONNECTIONS PER CITY OF MISHAWAKA
STANDARD SPECIFICATIONS.

***EXCEPTION:**

THE CONTRACTOR SHALL JACK AND BORE ANY UTILITY CROSSING UNDER THE EXISTING FIRE DEPARTMENT ACCESS DRIVE LOCATED WITHIN THE EXISTING ROADWAY EASEMENT LOCATED ON THE SOUTH SIDE OF THE SITE.

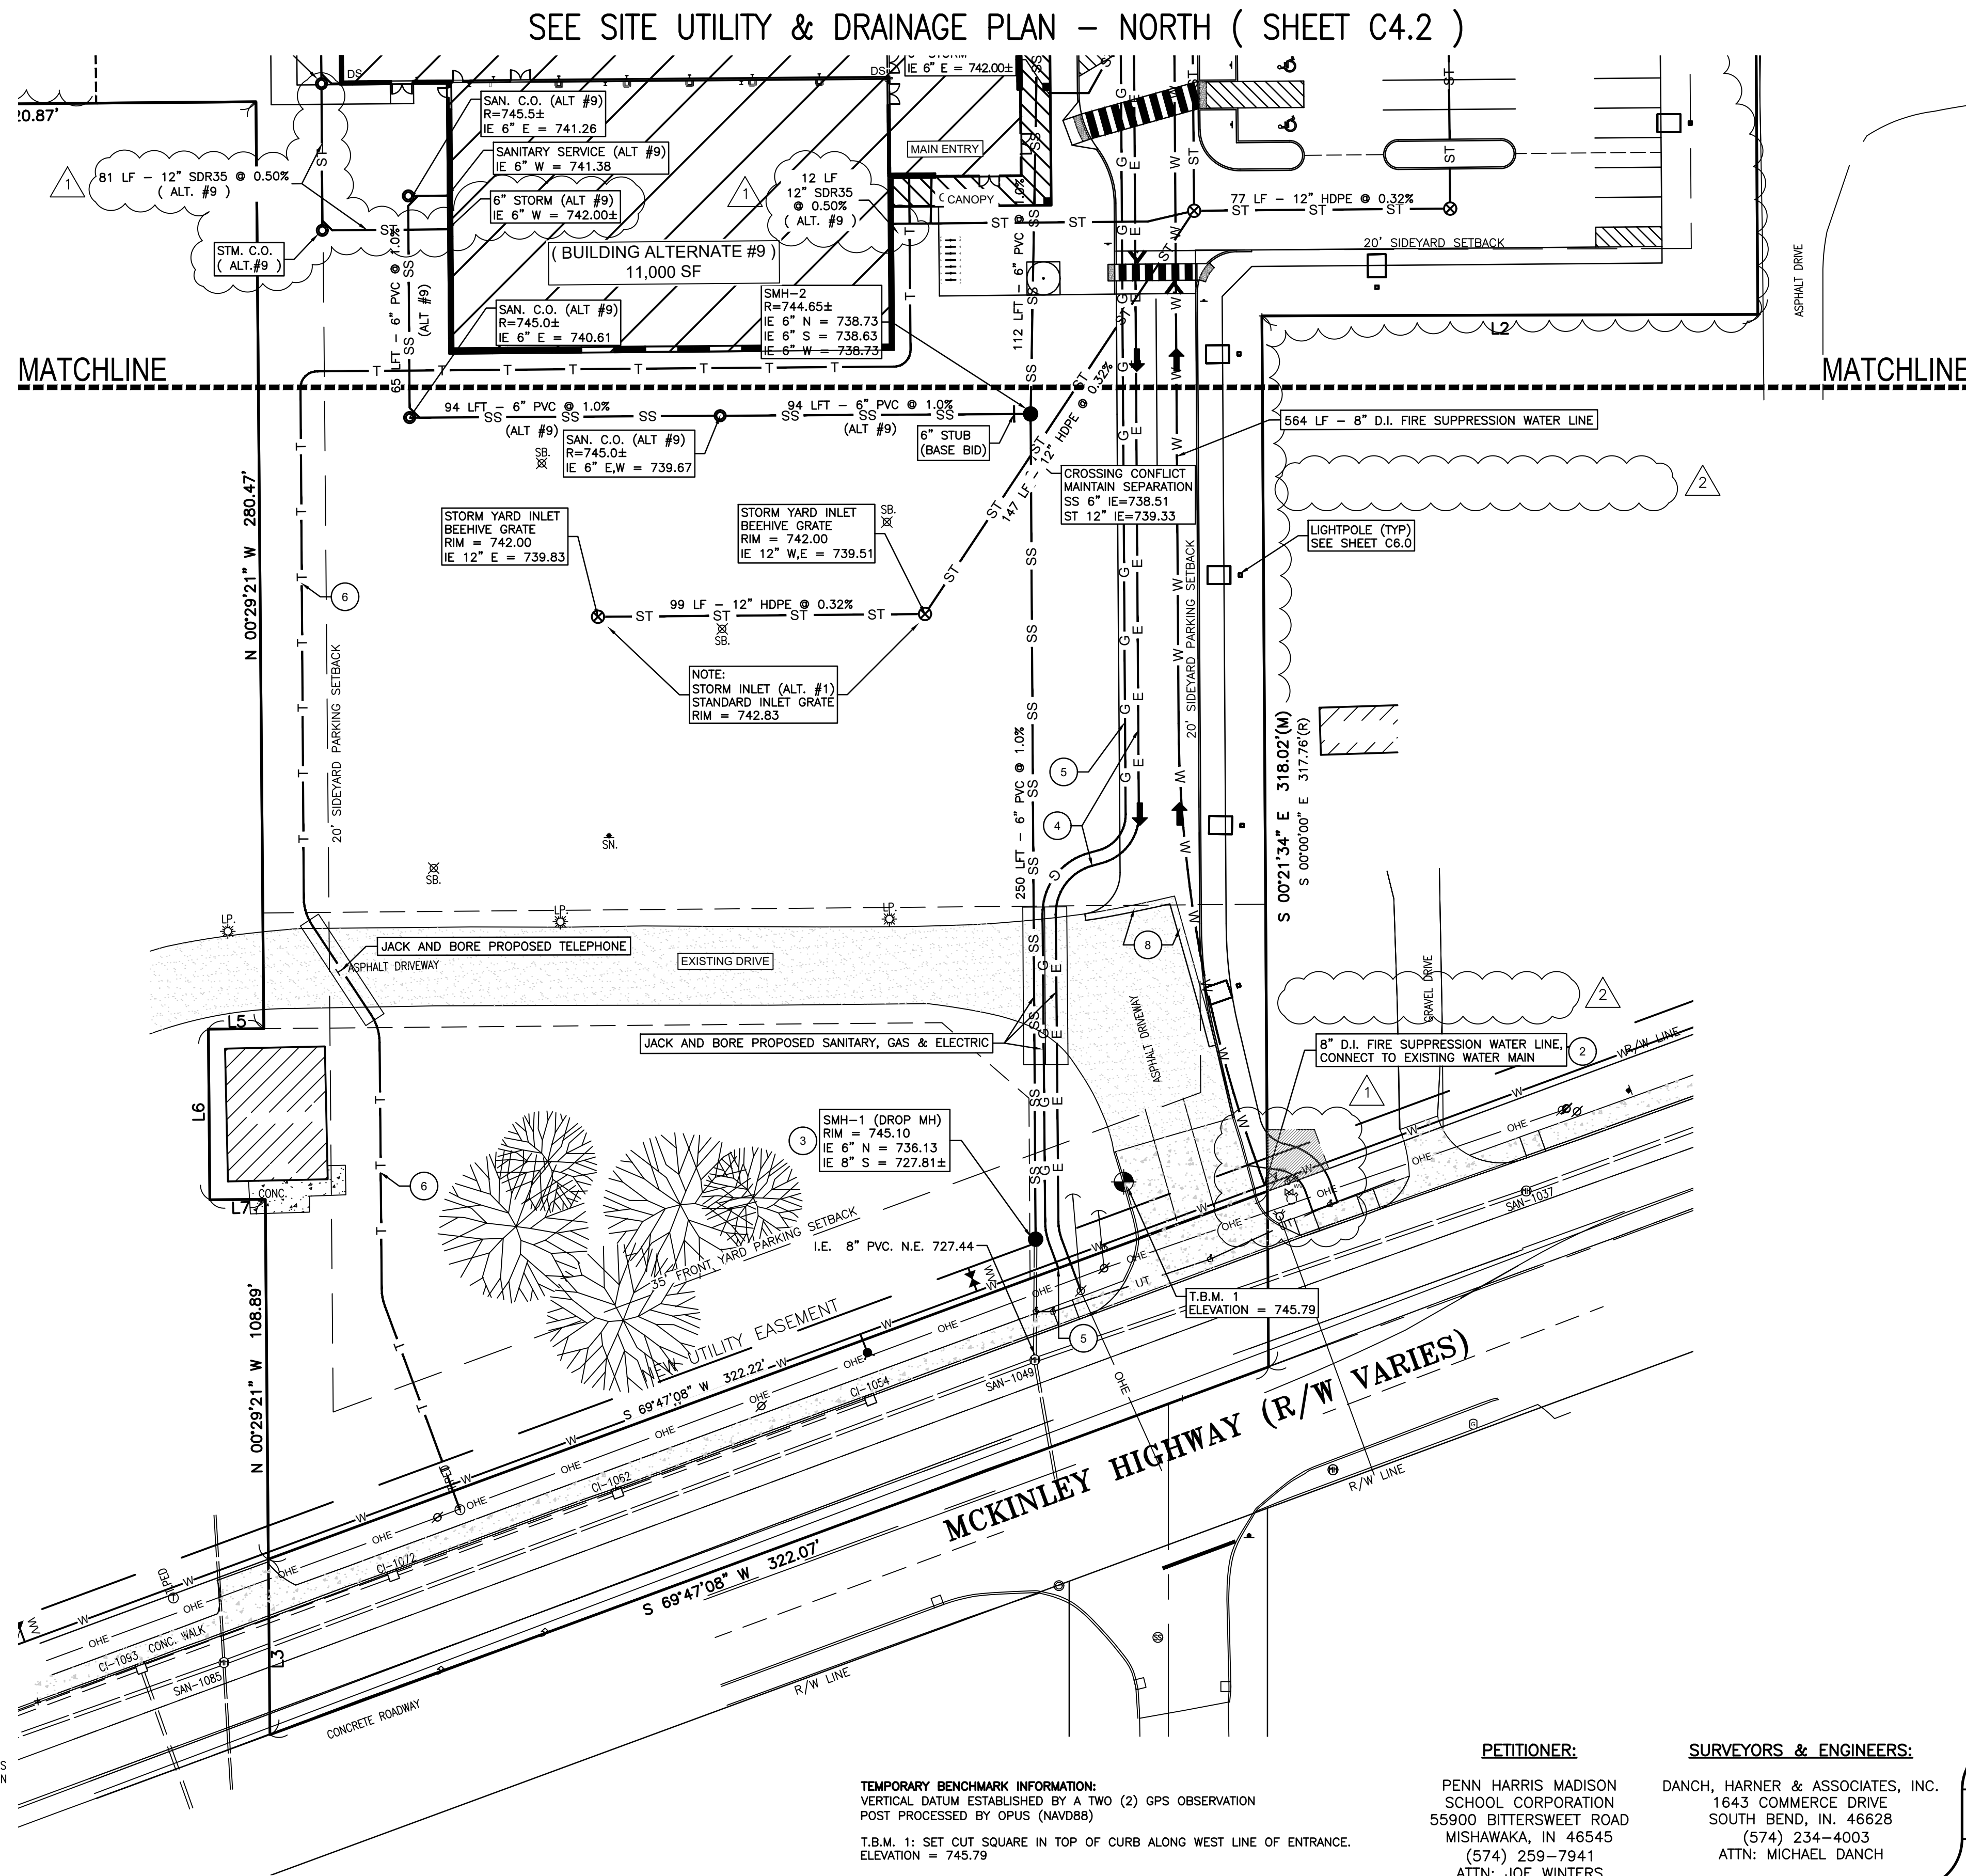

SITE UTILITY & DRAINAGE PLAN - SOUTH

DATE 01/10/24	DRAWN BY: ASM	R E V I S I O N S			
SCALE 1" = 30'	CHECKED BY: MJD	DATE 1/26/24	BY ASM	ADDENDUM #1	
FILE # 230228.5	PROJ. MANGR: MJD	2/01/24	ASM	ADDENDUM #2	

**Land Surveyors • Professional Engineers
Landscape Architects • Land Planners**

DHA

SHEET

C4.1

STRUCTURE CHART	
SAN-1037	CI-1054 (FLOW LINE)
RIM ELEV. = 746.07	RIM ELEV. = 745.92
UNABLE TO OPEN	I.E. 12" P.V.C. S.W. 741.41
(BROKEN UP)	CI-1062 (FLOW LINE)
SAN-1049	RIM ELEV. = 745.66
RIM ELEV. = 746.24	I.E. 12" P.V.C. N.E. 741.06
I.E. 8" P.V.C. N.E. 727.44	I.E. 12" P.V.C. S.W. 740.56
I.E. 18" P.V.C. N.E. 726.14	CI-1072 (FLOW LINE)
I.E. 8" P.V.C. S.W. 725.84	RIM ELEV. = 745.30
I.E. 18" P.V.C. S.W. 726.24	I.E. 12" P.V.C. N.E. 740.20
SAN-1085	I.E. 18" RCP. S.W. 742.15
RIM ELEV. = 746.24	CI-1093 (FLOW LINE)
I.E. 8" P.V.C. N.E. 735.88	RIM ELEV. = 745.03
I.E. 18" P.V.C. N.E. 725.98	I.E. 18" RCP. N.E. 740.03
I.E. 8" P.V.C. S.W. 736.03	I.E. 12" P.V.C. S.W. 740.13
I.E. 8" P.V.C. S.W. 737.38	I.E. 18" RCP. S.W. 739.83
I.E. 18" P.V.C. S.W. 725.78	CI-1094 (FLOW LINE)
	RIM ELEV. = 740.07
	I.E. 18" RCP. N.E. 739.67
	I.E. 18" RCP. S.W. 739.57

PROPOSED LEGEND

- | | |
|--------|----------------------|
| ■ | PROPOSED INLET |
| ■ | PROPOSED CLEAN OUT |
| ⦿ | PROPOSED HYDRANT |
| □ | PROPOSED LIGHT |
| ● | PROPOSED MANHOLE |
| ● | PROPOSED VALVE |
| ⚡ | PROPOSED POLE |
| ⊗ | PROPOSED CATCH BASIN |
| ▶ | PROPOSED END SECTION |
| 100.00 | PROPOSED ELEVATION |
| TW | TOP OF WALK |
| TS | BOTTOM OF CURB |
| TP | TOP OF PAVEMENT |
| TC | TOP OF CURB |
| BC | BOTTOM OF CURB |
| — W | PROPOSED WATER |
| — E | PROPOSED ELECTRIC |
| — G | PROPOSED GAS LINE |
| — T | PROPOSED TELEPHONE |
| — | PROPOSED CONTOUR |

EXISTING LEGEND

- | | | |
|---------------------|-----------------------|----------------|
| △ SET P.K. NAIL | ● FOUND IRN | SET CLASH 5/8" |
| | (M) MEASURED DISTANCE | ○ CAPPED REBAR |
| | (R) RECORD DISTANCE | W/ 1/4" DIA. |
| | | W. REG. #22436 |
| PINE TREE | ⊙ GAS METER | ⊗ SOIL BORING |
| BUSH | ⊙ WATER MANHOLE | ⊗ WATER METER |
| TREE | ▷ END SECTION | Ⓢ CABLE PBD. |
| FOUNTAIN/IRR. | Ⓢ ELEC. VAULT | ① PHONE PBD. |
| BOLLARD/POLE | Ⓢ ELEC. TRANSFORMER | Ⓢ ELEC. PBD. |
| LIGHT POLE | Ⓢ ELEC. VAULT | Ⓢ MAILBOX |
| UTILITY POLE | Ⓢ SPOT ELEVATION | A/C UNIT |
| GY ANCHOR | | |
| WELL | | |
| IGN | | |
| VALVE | | |
| FIRE HYDRANT | | |
| CURB INLET | | |
| DRYWELL | | |
| SE | | |
| SANITARY MANHOLE | | |
| STORM MANHOLE | | |
| CLEAN-OUT | | |
| FIBER OPTIC MANHOLE | | |

EX. ELEVATION

WIRE FENCE

CHAIN LINK FENCE

WOOD FENCE

ONE _____ ONE _____ ELECTRIC

UT _____ UT _____ PHONE

UD _____ UD _____ GAS

CTV _____ CTV _____ CABLE TV

W _____ W _____ WATER

FO _____ FO _____ FIBER OPTIC

STORM LINE

SANITARY LINE

ANY INFORMATION ON THIS DRAWING IS NOT INTENDED TO BE SUITABLE FOR REUSE BY ANY PERSON, FIRM OR CORPORATION OR ANY OTHERS ON EXTENSION OF THIS PROJECT OR FOR ANY USE ON ANY OTHER PROJECT. ANY REUSE WITHOUT WRITTEN VERIFICATION AND ADOPTION BY THE ENGINEER, ARCHITECT OR SURVEYOR FOR THE SPECIFIC PURPOSE INTENDED WILL BE AT THE USER'S SOLE RISK AND WITHOUT LIABILITY OR LEGAL EXPOSURE TO THE ENGINEER, ARCHITECT OR SURVEYOR.

ALL UNDERGROUND UTILITIES MUST BE FIELD VERIFIED BY THE CONTRACTOR BEFORE ANY CONSTRUCTION MAY BEGIN.

TEMPORARY BENCHMARK INFORMATION:
VERTICAL DATUM ESTABLISHED BY A TWO (2) GPS OBSERVATION
POST PROCESSED BY OPUS (NAVD88)

T.B.M. 1: SET CUT SQUARE IN TOP OF CURB ALONG WEST LINE OF ENTRANCE
ELEVATION = 745.79

PETITIONER:

PENN HARRIS MADISON
SCHOOL CORPORATION
55900 BITTERSWEET ROAD
MISHAWAKA, IN 46545
(574) 259-7941
ATTN: JOE WINTERS

SURVEYORS & ENGINEERS:

DANCH, HARNER & ASSOCIATES, INC.
1643 COMMERCE DRIVE
SOUTH BEND, IN. 46628
(574) 234-4003
ATTN: MICHAEL DANCH

PHMSC FIELDHOUSE – FINAL SITE PLAN (PHASE 1)
PART OF THE SOUTHWEST, AND NORTHWEST QUARTERS OF SECTION 6, TOWNSHIP 37 NORTH, RANGE 4 EAST,
PENN TOWNSHIP, ST. JOSEPH COUNTY, INDIANA.

- ## C4.2

DUNCAN, TURNER & ASSOCIATES, INC.
Land Surveyors • Professional Engineers
Landscape Architects • Land Planners

ATA

07000 111 4000 111 4000 111 4000 111 4000

—

**PENN-HARRIS-MADISON
SCHOOL CORPORATION**



63501 Beech Rd. Wakarusa, IN 46577
contactus@MagnusEng.com
www.MagnusEng.com

REV. NO.△	DESCRIPTION	DATE
2	Addendum #2	02/01/2024

S-004

Special Inspection is required in addition to all material tests and inspections defined elsewhere in the Construction Documents. Special Inspection is required for the following categories of work (by type of construction or by individual) to provide Special Inspection for items as indicated on the drawings.

2. The Special Inspector shall be a qualified person, who shall demonstrate competence, to the satisfaction of the Building Official and the Authority Having Jurisdiction, in the particular type of construction requiring Special Inspection.

3. "Periodic" Special Inspection is defined as the part-time or intermittent observation of work requiring Special Inspection by an approved Special Inspector who is present in the area where the work has been or is being performed and at the completion of the work.

4. Continuous Special Inspection is defined as the full-time observation of work requiring Special Inspection by an approved Special Inspector who is present in the area where the work is being performed.

5. The Special Inspector shall submit a written report of Special Inspection requirements "w/ the Owner's Special Inspector" shall submit to the SCOR for review, a minimum of 14 days prior to commencement of construction of elements requiring special inspection. The following:

- a. Name(s), address(es), telephone number(s), email address(es), and statement(s) of qualifications of all Special Inspectors to be engaged on the project.
- b. A listing of all items to receive Special Inspection, designation whether inspection will be continuous or periodic and the name of the individual that will be performing inspection for each item.

6. The Contractor shall coordinate with the Special Inspector sufficiently in advance of work requiring Special Inspection and shall provide access to the site and to the Construction Documents (current drawings and specifications) for the Special Inspector to perform the required inspection.

7. The Special Inspector shall observe the work requiring Special Inspection for conformance to the Construction Documents. All non-conforming work shall be brought to the immediate attention of the Contractor for correction, then if uncorrected, to the immediate attention of the Owner.

8. The Special Inspector shall submit periodic progress reports to the Owner, Architect, SEOR & Contractor identifying all Special Inspection operations performed. Reports shall be submitted no more than 7 days following each Special Inspection operation. Reports shall identify the inspected items and an indication of whether the inspected items were in conformance with the Construction Documents.

9. At the completion of all work requiring Special Inspection, the Special Inspector shall submit a final signed report to the Owner, Architect & Contractor. The Contractor shall be responsible for the Special Inspection work, to the best of the Special Inspector's knowledge, in conformance with the Construction Documents.

10. Failure to perform Special Inspection for the indicated construction or failure to correct non-conforming work shall constitute a basis for the removal of the work and removal and replacement by the General Contractor at no additional cost to the Owner, including, but not limited to:

- a. The cost of removal and replacement of all work for which Special Inspection was required but not performed, including the cost of testing and Special Inspection for the replacement work.
- b. The cost of all related work made necessary by the removal and replacement of the uninspected work per item a above.
- c. The cost of test design professional's services related to all work for which Special Inspection was required but not performed and services related to the replacement work.

11. Provide Special Inspection for the following construction:


- a. Concrete Construction
- b. Foundation Walls and Footings
- c. Soils and Earthwork
- d. Masonry Construction
- e. Steel Construction
- f. Steel Deck

Special Inspection Services Schedule - Foundation Walls and Pits				
Referenced Standards per IBC, Chapter 17				
Verification and Inspection Task	Test / Inspection	Description of Test / Inspection	Applicable to Project (Y/N)	Frequency
Concrete Placement	Inspection	The inspector must be present full-time during the entire placement of the first 2 shallow foundation concrete pours and then must be present at the start of 50% of the other concrete pours.	Y	Periodic
Formwork	Inspection	Verify that forms are plumb and straight, braced against movement, and lubricated for removal.	Y	Periodic
Dimensions	Inspection	Verify wall pit dimensions.	Y	Periodic
Embedded Items	Inspection	Verify anchor rods and/or dowels are installed with the embedment and projected lengths and in accordance with the Contract Documents.	Y	Periodic
Reinforcement	Inspection	Verify pit/wall reinforcement prior to placement of concrete.	Y	Periodic
Waterstops	Inspection	Verify water stops are properly installed and anchored into position prior to placement of concrete.	Y	Periodic
Backfill Operations	Inspection	Verify that foundation and pit walls with uneven backfill conditions are not backfilled until floor construction at top of wall is complete or temporary bracing is provided in accordance with the Contract Documents.	Y	Periodic
Concrete	Inspection	Verify concrete placement as outlined in this inspection plan.	Y	Periodic

Special Inspection Services Schedule - Masonry Construction				
Referenced Standards per IRC, Chapter 17				
Verification and Inspection Task	Test / Inspection	Description of Test / Inspection	Applicable to Project (Y/N)	Frequency
Material Testing	Test	Reference masonry specification for extent of testing required.	-	-
Quality Control	Inspection	Verify that quality control testing is provided in accordance with the project requirements.	Y	Periodic
Materials	Inspection	Verify the materials are stored properly before placement in the structure.	Y	Periodic
Wall Locations	Inspection	Verify the wall locations and thickness.	Y	Periodic
Control Joints	Inspection	Verify the proper installation of control joints, type and location.	Y	Periodic
Openings	Inspection	Verify the proper installation of structural elements around openings including lintels, sills, and door or window jambs including masonry unit type and reinforcement.	Y	Periodic
Connections	Inspection	Verify the masonry is properly connected to the supporting structure(s).	Y	Periodic
Reinforcing Steel	Inspection	Inspection of reinforcing steel and placement as follows:		
		Verify that reinforcement surfaces are free of excess rust or other coatings that may adversely affect bonding capacity.	Y	Periodic
		Verify reinforcing bars and horizontal joint reinforcement for compliance with Contract Documents and approved shop drawings as follows:		
		Material grade, size, quantity, spacing, and layering; bars are adequately tied and supported on chairs and centered as required; proper hook type and location; splice locations and required length of lap; proper clearance and cover requirements from masonry surfaces; sufficient spacing between reinforcement for grout placement; verify that unscheduled/additional reinforcing bars shown on plan, in details, or specified in notes are provided and are in compliance with Contract Documents and approved shop drawings.	Y	Periodic
Embedded Items	Inspection	Inspect embedded items to be cast in masonry prior to placement of grout for size, quantity, location, position and embedment. Inspect during placement for proper grout consolidation embedded items.	Y	Periodic
Mortar and Grout	Inspection	Inspect the mortar and grout used on the project as follows:		
		Verify that mortar and grout materials comply with the Contract Documents and approved submittals.	Y	Periodic
		Site-mixed mortar: Verify the mortar is mixed in accordance with specified proportions.	Y	Periodic
		Bag-mixed mortar: Verify the mortar is mixed in accordance to the manufacturer's instructions.	Y	Periodic
		Verify proper mortar placement.	Y	Periodic
		Grout bag mix: Verify that the grout is mixed according to the manufacturer's instructions.	Y	Periodic
		Ready-mix grout: Verify the mix number and grout strength.	Y	Periodic
Protection	Inspection	Prior to any grouting procedure, inspect the grout space to verify that it is clean and that cleanouts, if required, are in place and conform to requirements of the Contract Documents.	Y	Periodic
		Verify the proper grout placement and consolidation.	Y	Continuous
		Verify that grout testing is performed in accordance with the Contract Documents.	Y	Periodic
Protection	Inspection	Verify the proper construction techniques are followed for protection of masonry during dry-weather and/or cold-water construction.	Y	Periodic

Special Inspection Services Schedule - Steel Deck				
Referenced Standards per IRC, Chapter 17				
Verification and Inspection Task	Test / Inspection	Description of Test / Inspection	Applicable to Project (Y/N)	Frequency
Quality	Inspection	Visually inspect the deck prior to installation for damage.	Y	Periodic
Deck Material	Inspection	Verify that the deck depth, gauge, type, properties, and finish comply with the Contract Documents.	Y	Periodic
Deck Attachment	Inspection	Verify that the deck attachment to the supporting steel is as specified in the Contract Documents.	Y	Periodic
Deck Support	Inspection	Verify that the proper deck support is used around openings.	Y	Periodic
Deck Accessories	Inspection	Verify that deck accessories are being installed according to the Contract Documents and approved shop drawings.	Y	Periodic

C:\Users\madelm\Documents\2023_PHS Field House_Struct_RVT23_Central_TylenMadelm.rvt
2/1/2024 12:40:25 PM

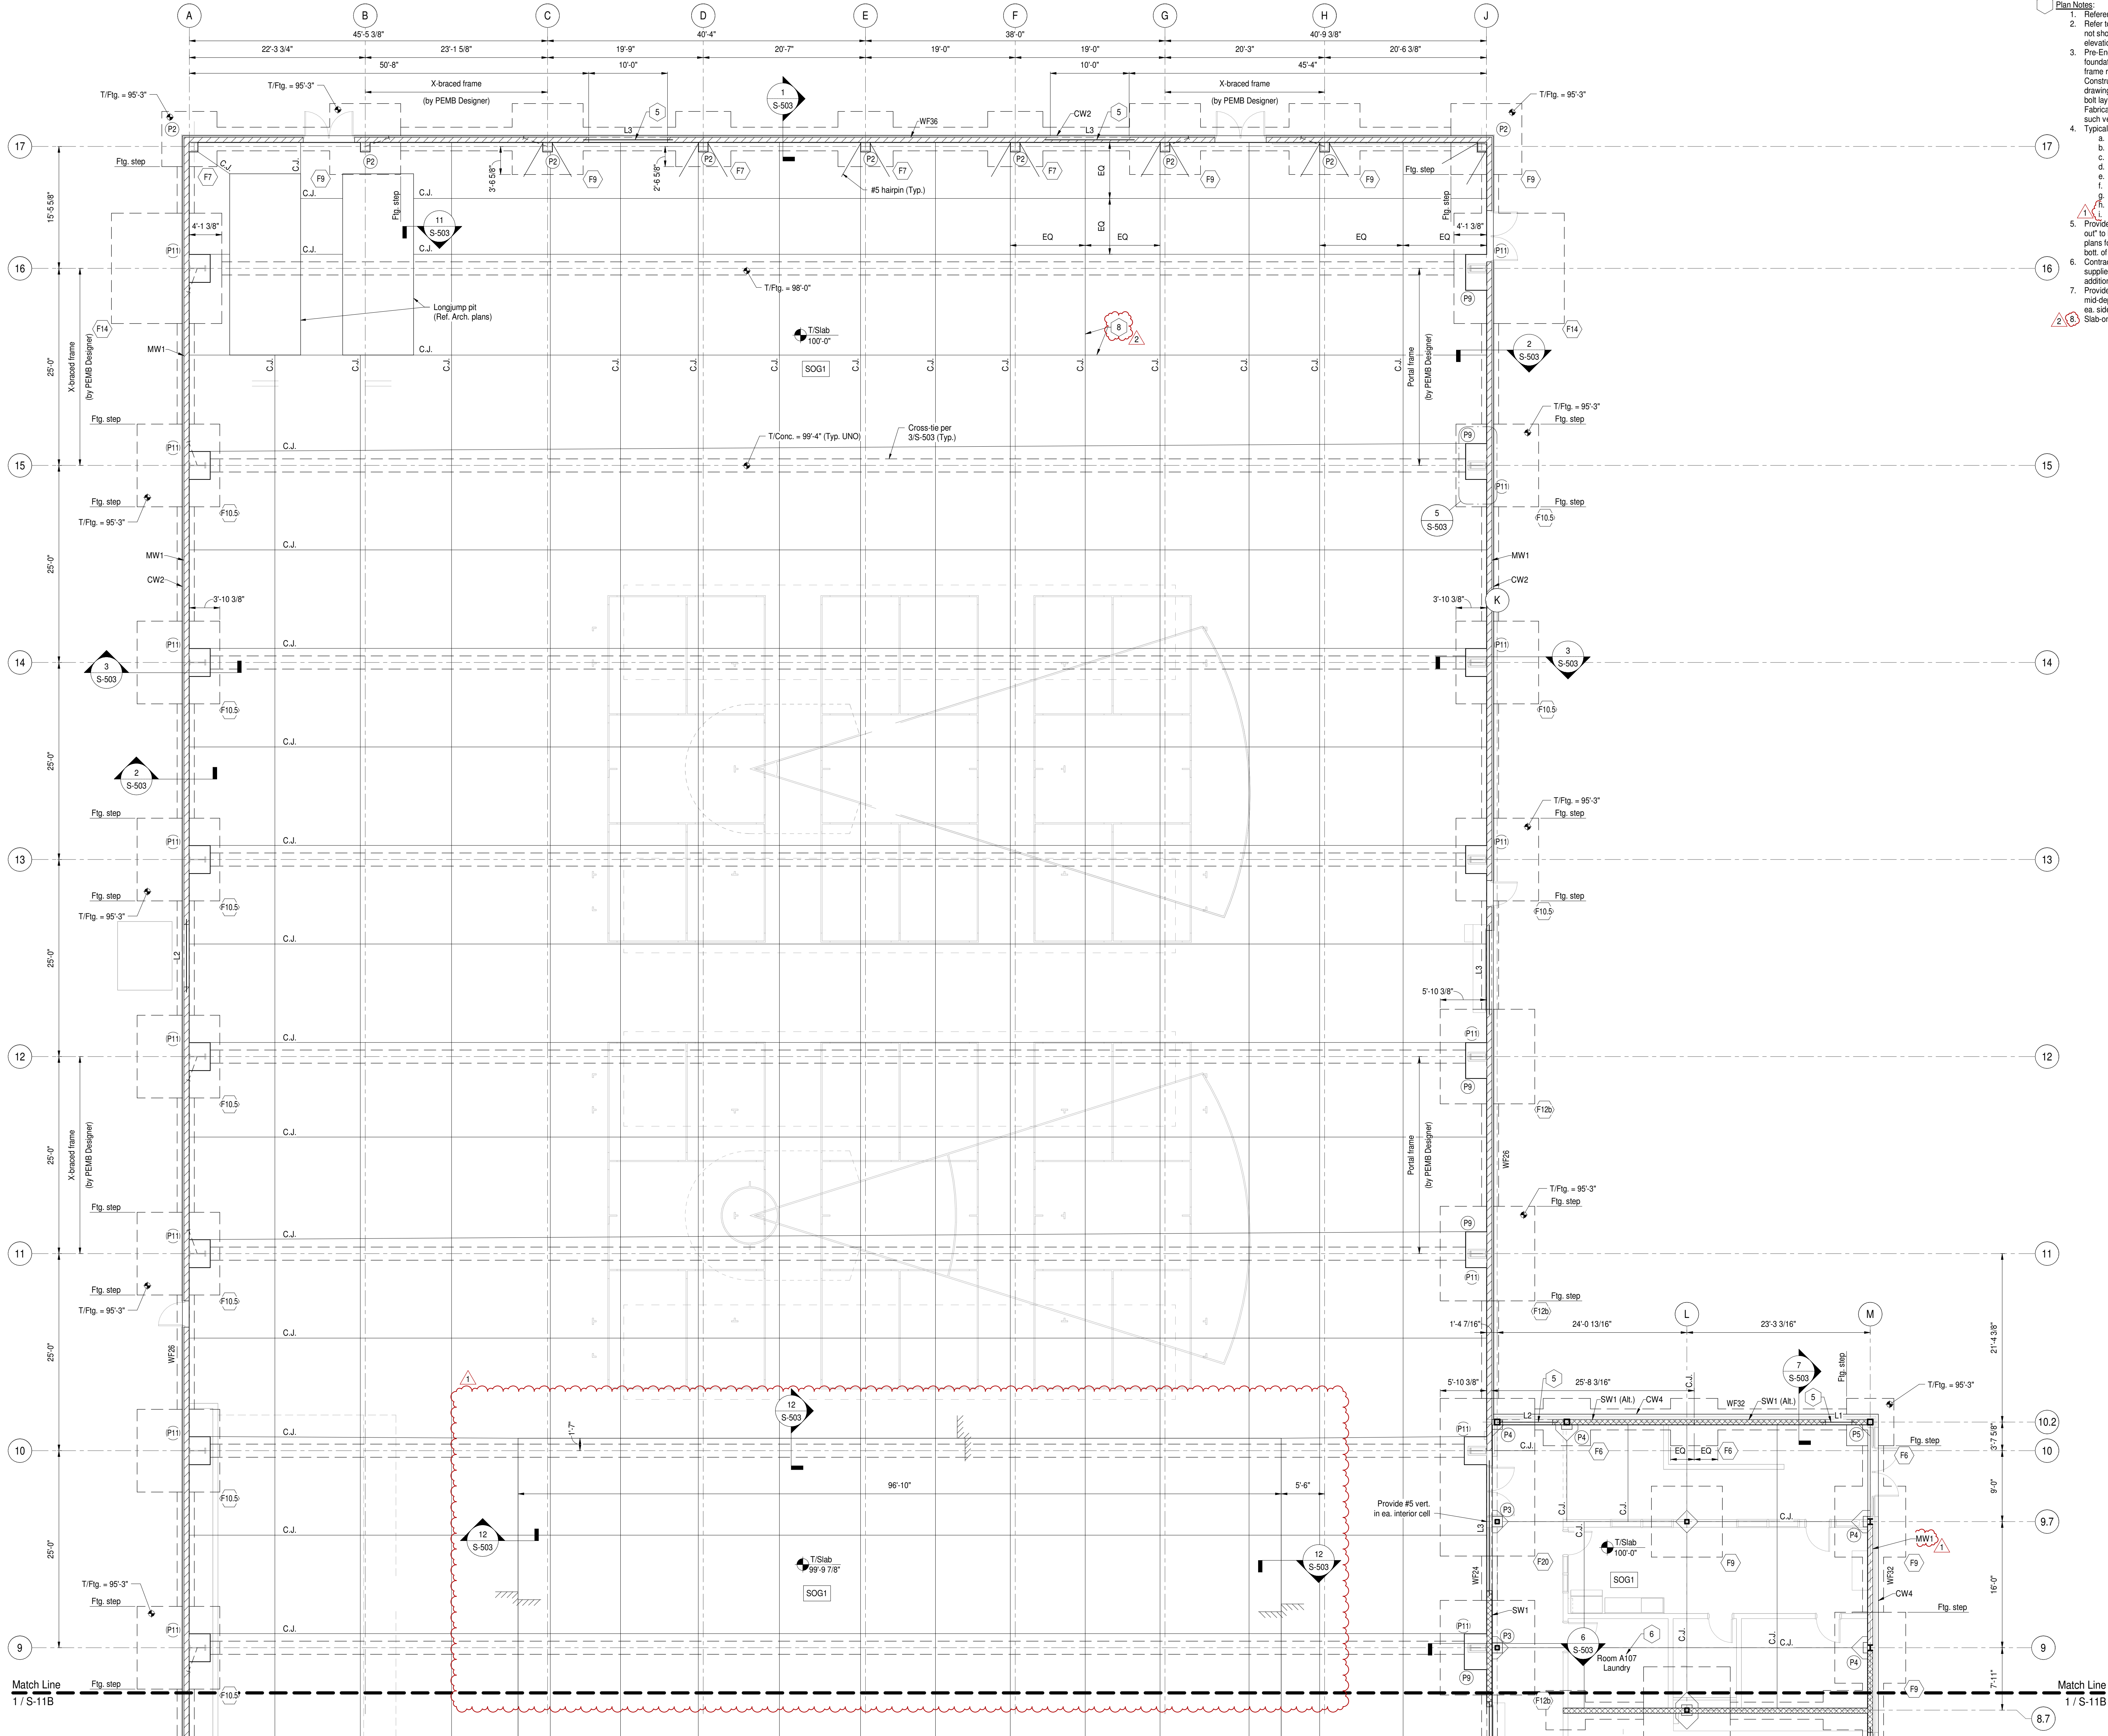

- Plan Notes:**
- Reference elevation = 100'-0" (746.00' NAVD88).
 - Refer to Architectural drawings for all dimensions not shown. Contractor shall verify all dimensions & elevations prior to construction.
 - Pre-Engineered Metal Building (PEMB) foundations depicted are based on preliminary frame reactions and require verification prior to construction. Contractor shall submit PEMB shop drawings depicting column reactions and anchor bolt layout to SEOR for verification of sizing. Fabrication shall not proceed prior to completion of such verification by SEOR.
 - Typical Elevations (UNO):
 - T/Flg @ ext. walls = 98'-0".
 - T/Flg @ int. shearwalls = 99'-4".
 - T/Flg @ ext. columns = 98'-0".
 - T/Flg @ int. columns = 98'-4".
 - T/Pedestal (WF & HSS) = 99'-4".
 - T/Pedestal (PEMB) = 100'-0".
 - T/Slab = 100'-0".
 - T/Conc. wall (Typ.) = 99'-4".
 - T/Conc. wall (PEMB) = 100'-0".
 - Provide opening as indicated w/ masonry "knock-out" to be removed for future opening. Ref. Arch. plans for opening height. Provide #4 dowels to both of jamb & top of foundation @ 4'-0" max. spa. Contractor to coord. housekeeping past w/ Owner-supplied laundry equipment. Ref. Arch. for additional requirements.
 - Provide #5 hairpins as noted on plan. Project into mid-depth of slab @ 1:1 slope. Minimum leg length ea. side shall be 4'-0".
 - Slab-on-grade control joints designated w/ "C.J."

COPYRIGHT 2024 BY FANNINGHOWEY ASSOCIATES, INC.

PENN HIGH SCHOOL FIELDHOUSE

12641 McKinley Highway, Mishawaka, Indiana 46545

PENN-HARRIS-MADISON SCHOOL CORPORATION




ARCHITECT

FANNING HOWEY


317.848.0966 WWW.FHAI.COM
350 E NEW YORK ST #300, INDIANAPOLIS, IN 46204

CONSULTANT

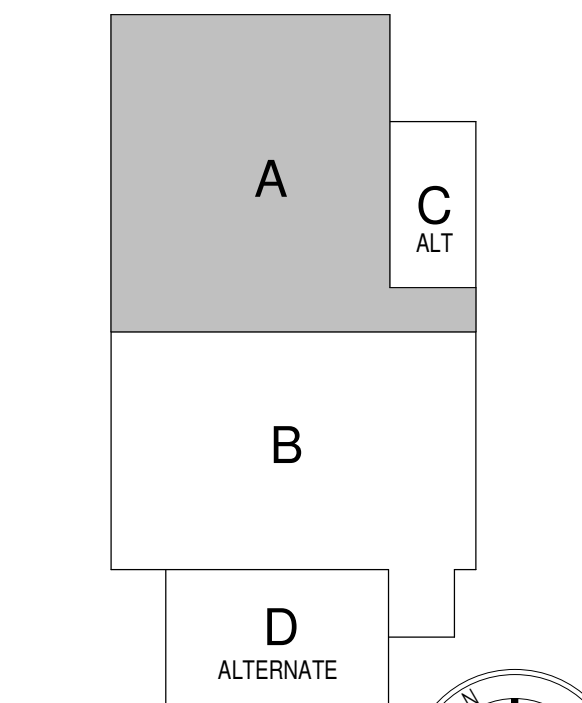

KEY PLAN

Construction Documents

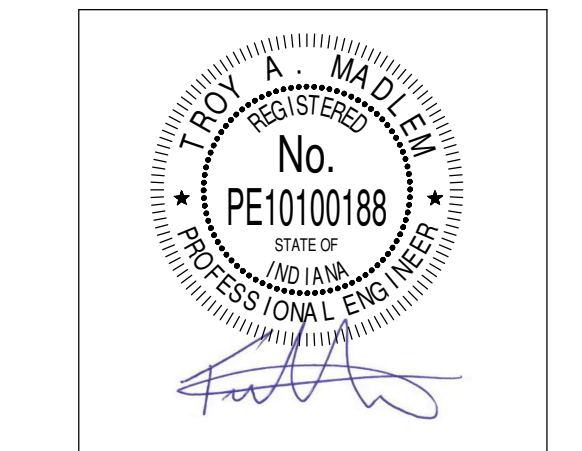

PROJECT MANAGER: JAA		
DRAWN BY: TCM		
PROJECT NUMBER: 222130.00		
PROJECT ISSUE DATE: January 10, 2024		
REV. NO.	DESCRIPTION	DATE
1	Addendum #1	01/26/2024
2	Addendum #2	02/01/2024


Foundation Plan - Unit A

S-11A




S-11B


C:\Users\madelm\Documents\2023_PHS Field House_Schd_RVT23_Central_TylenMadelm.rvt
2/1/2024 12:40:23 PM

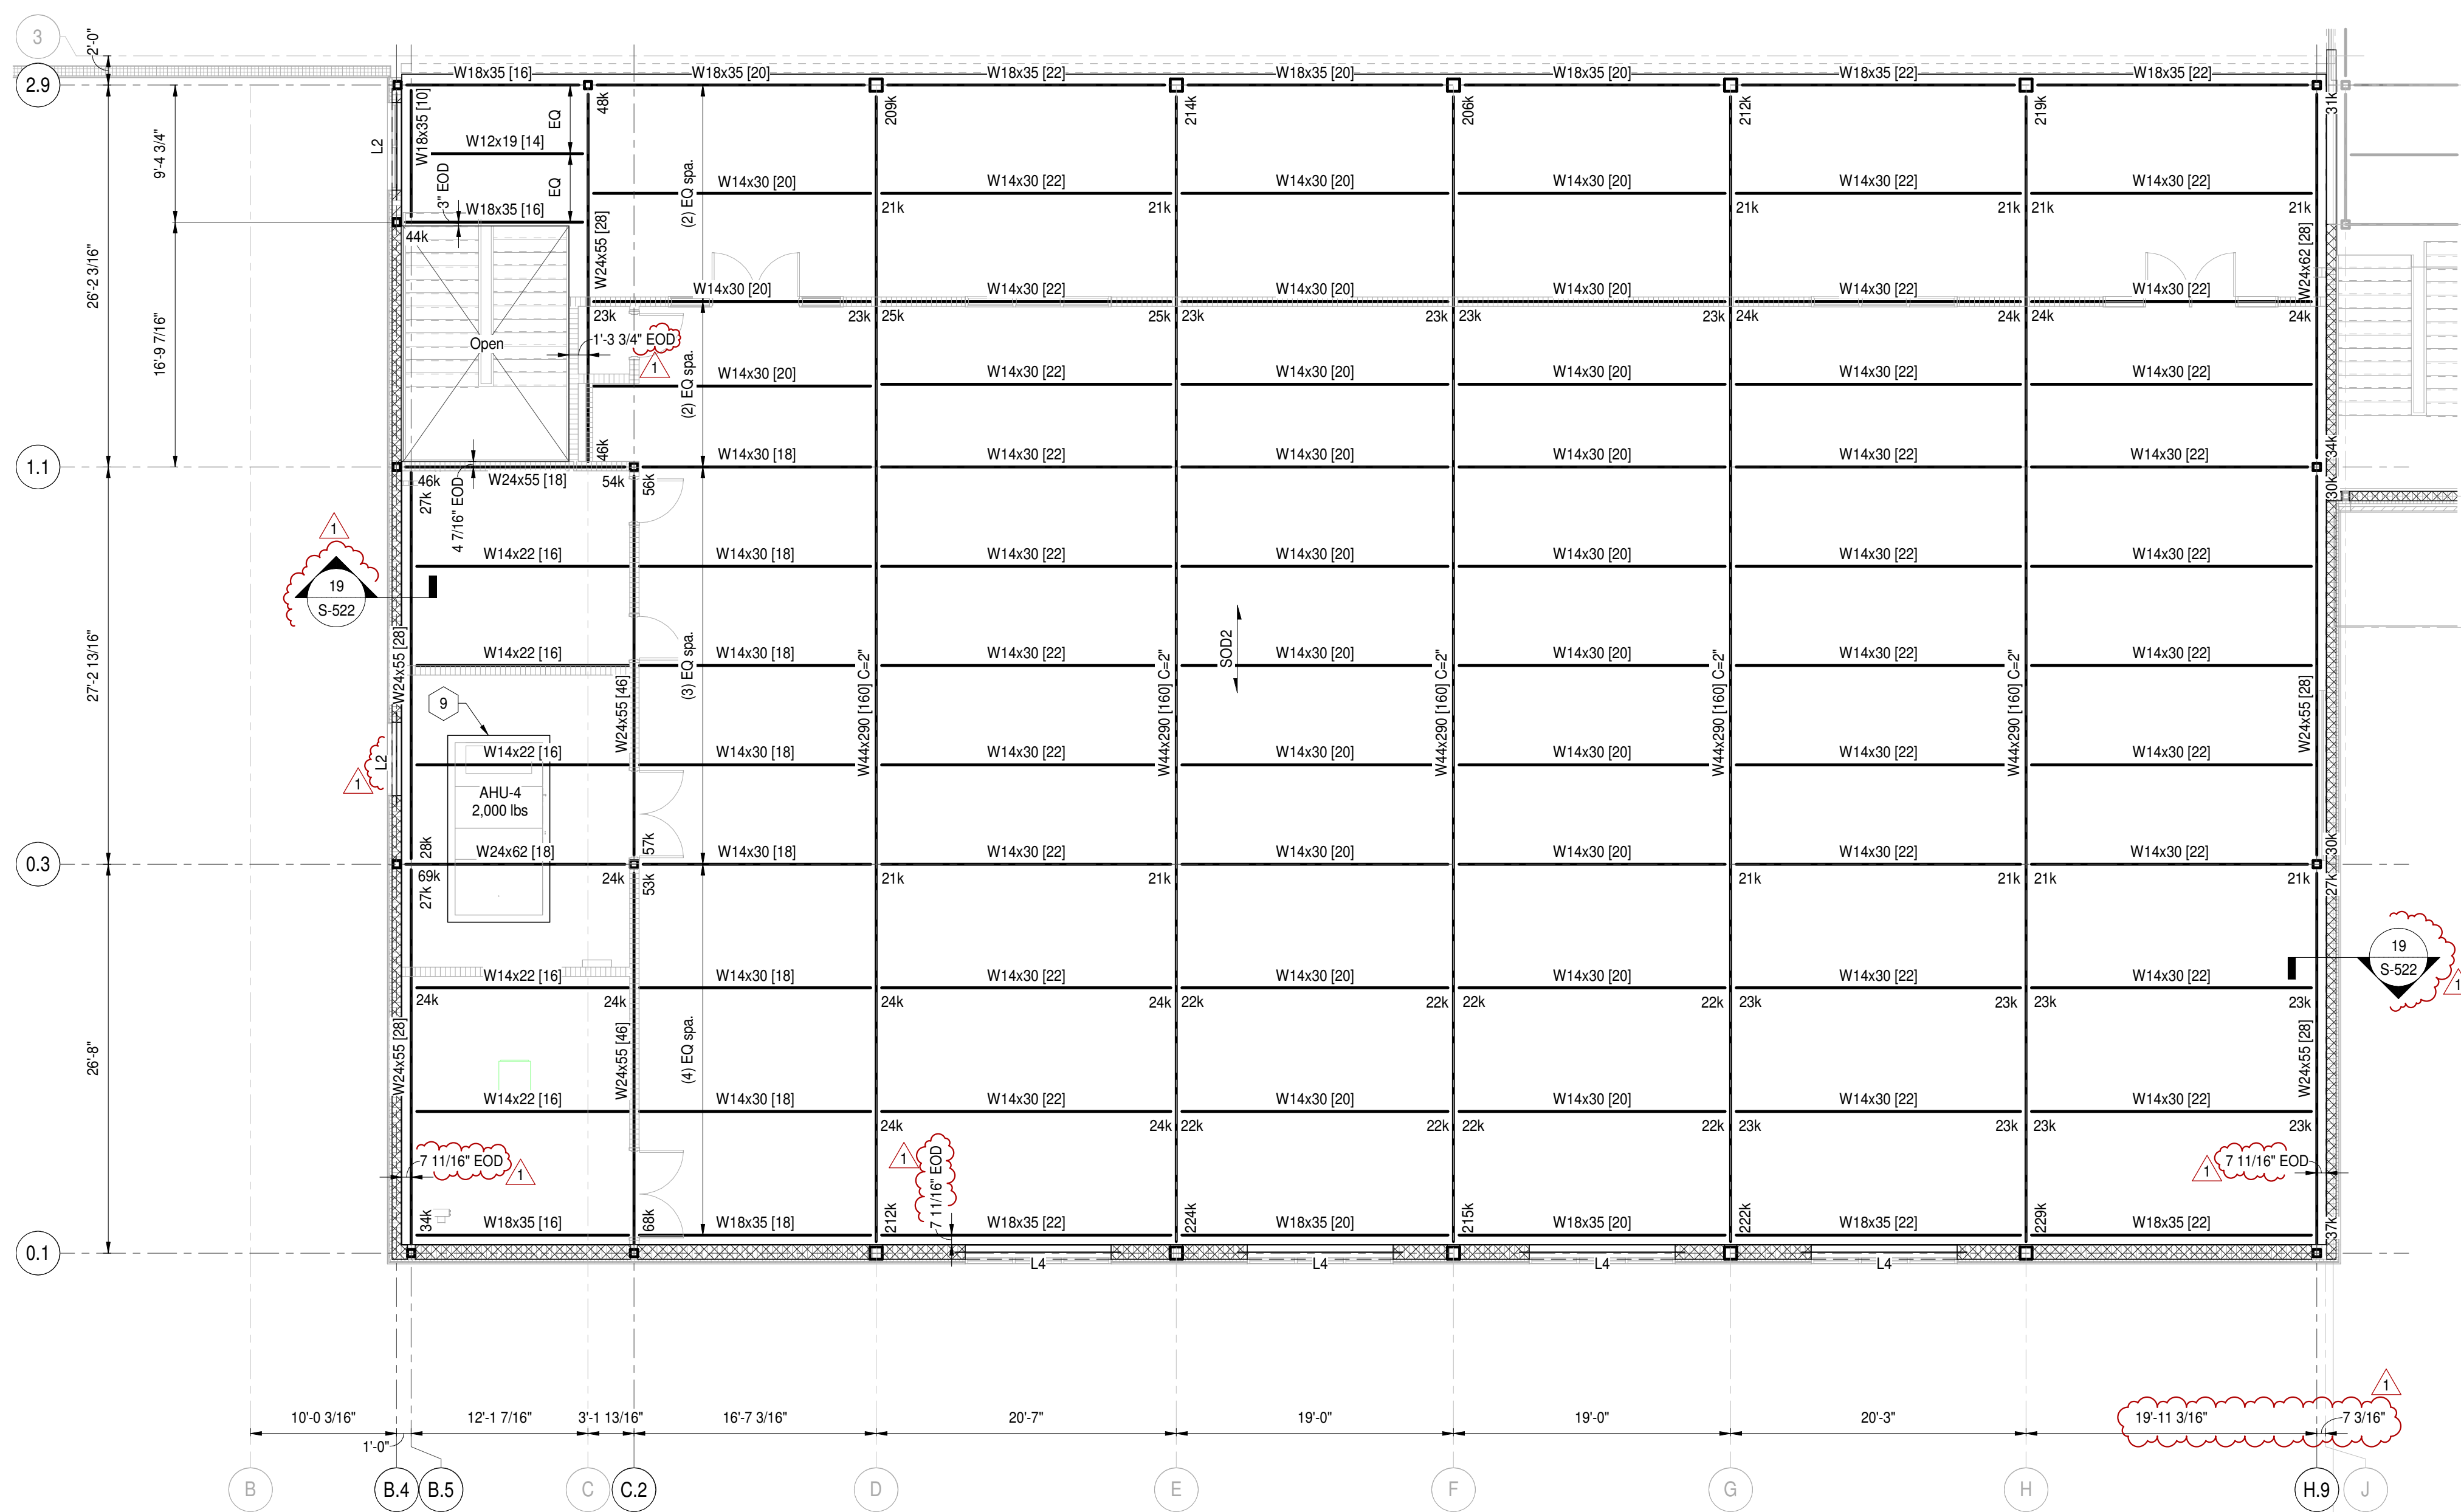

3 Second Floor Framing Plan Alternates - Unit D
Scale: 1/8" = 1'-0"

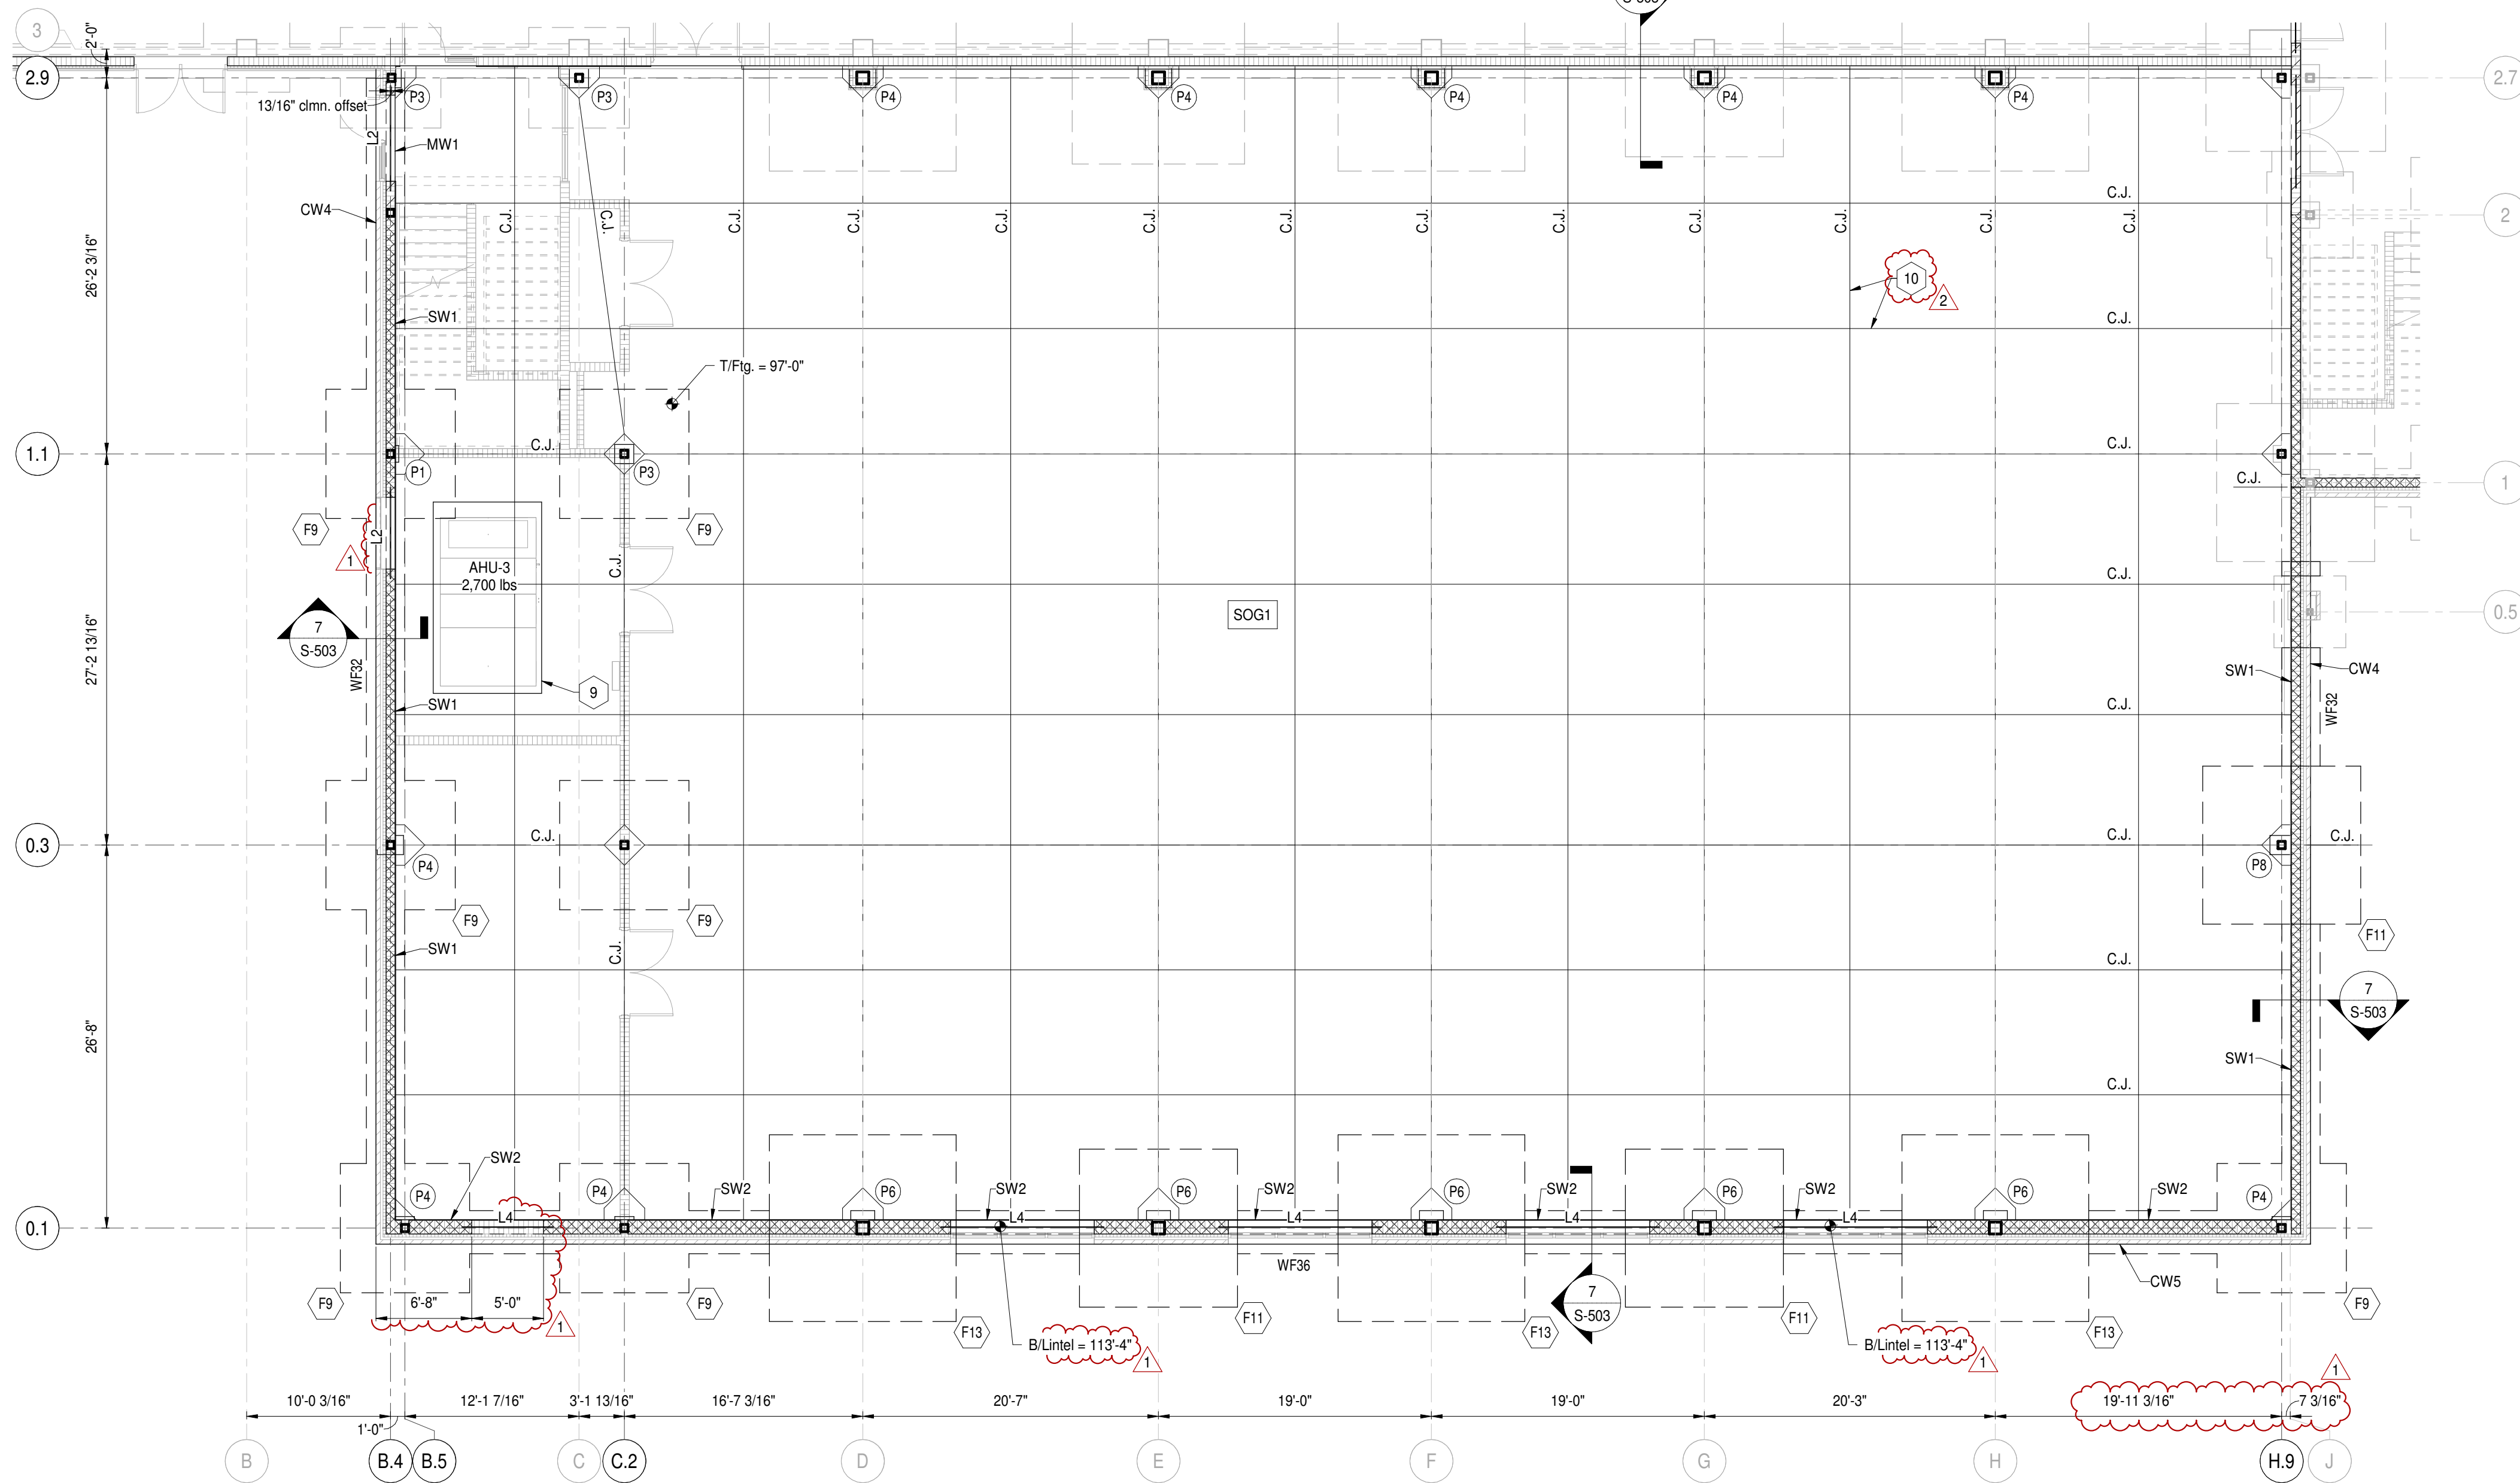

2 Foundation Plan Alternates - Unit D
Scale: 1/8" = 1'-0"

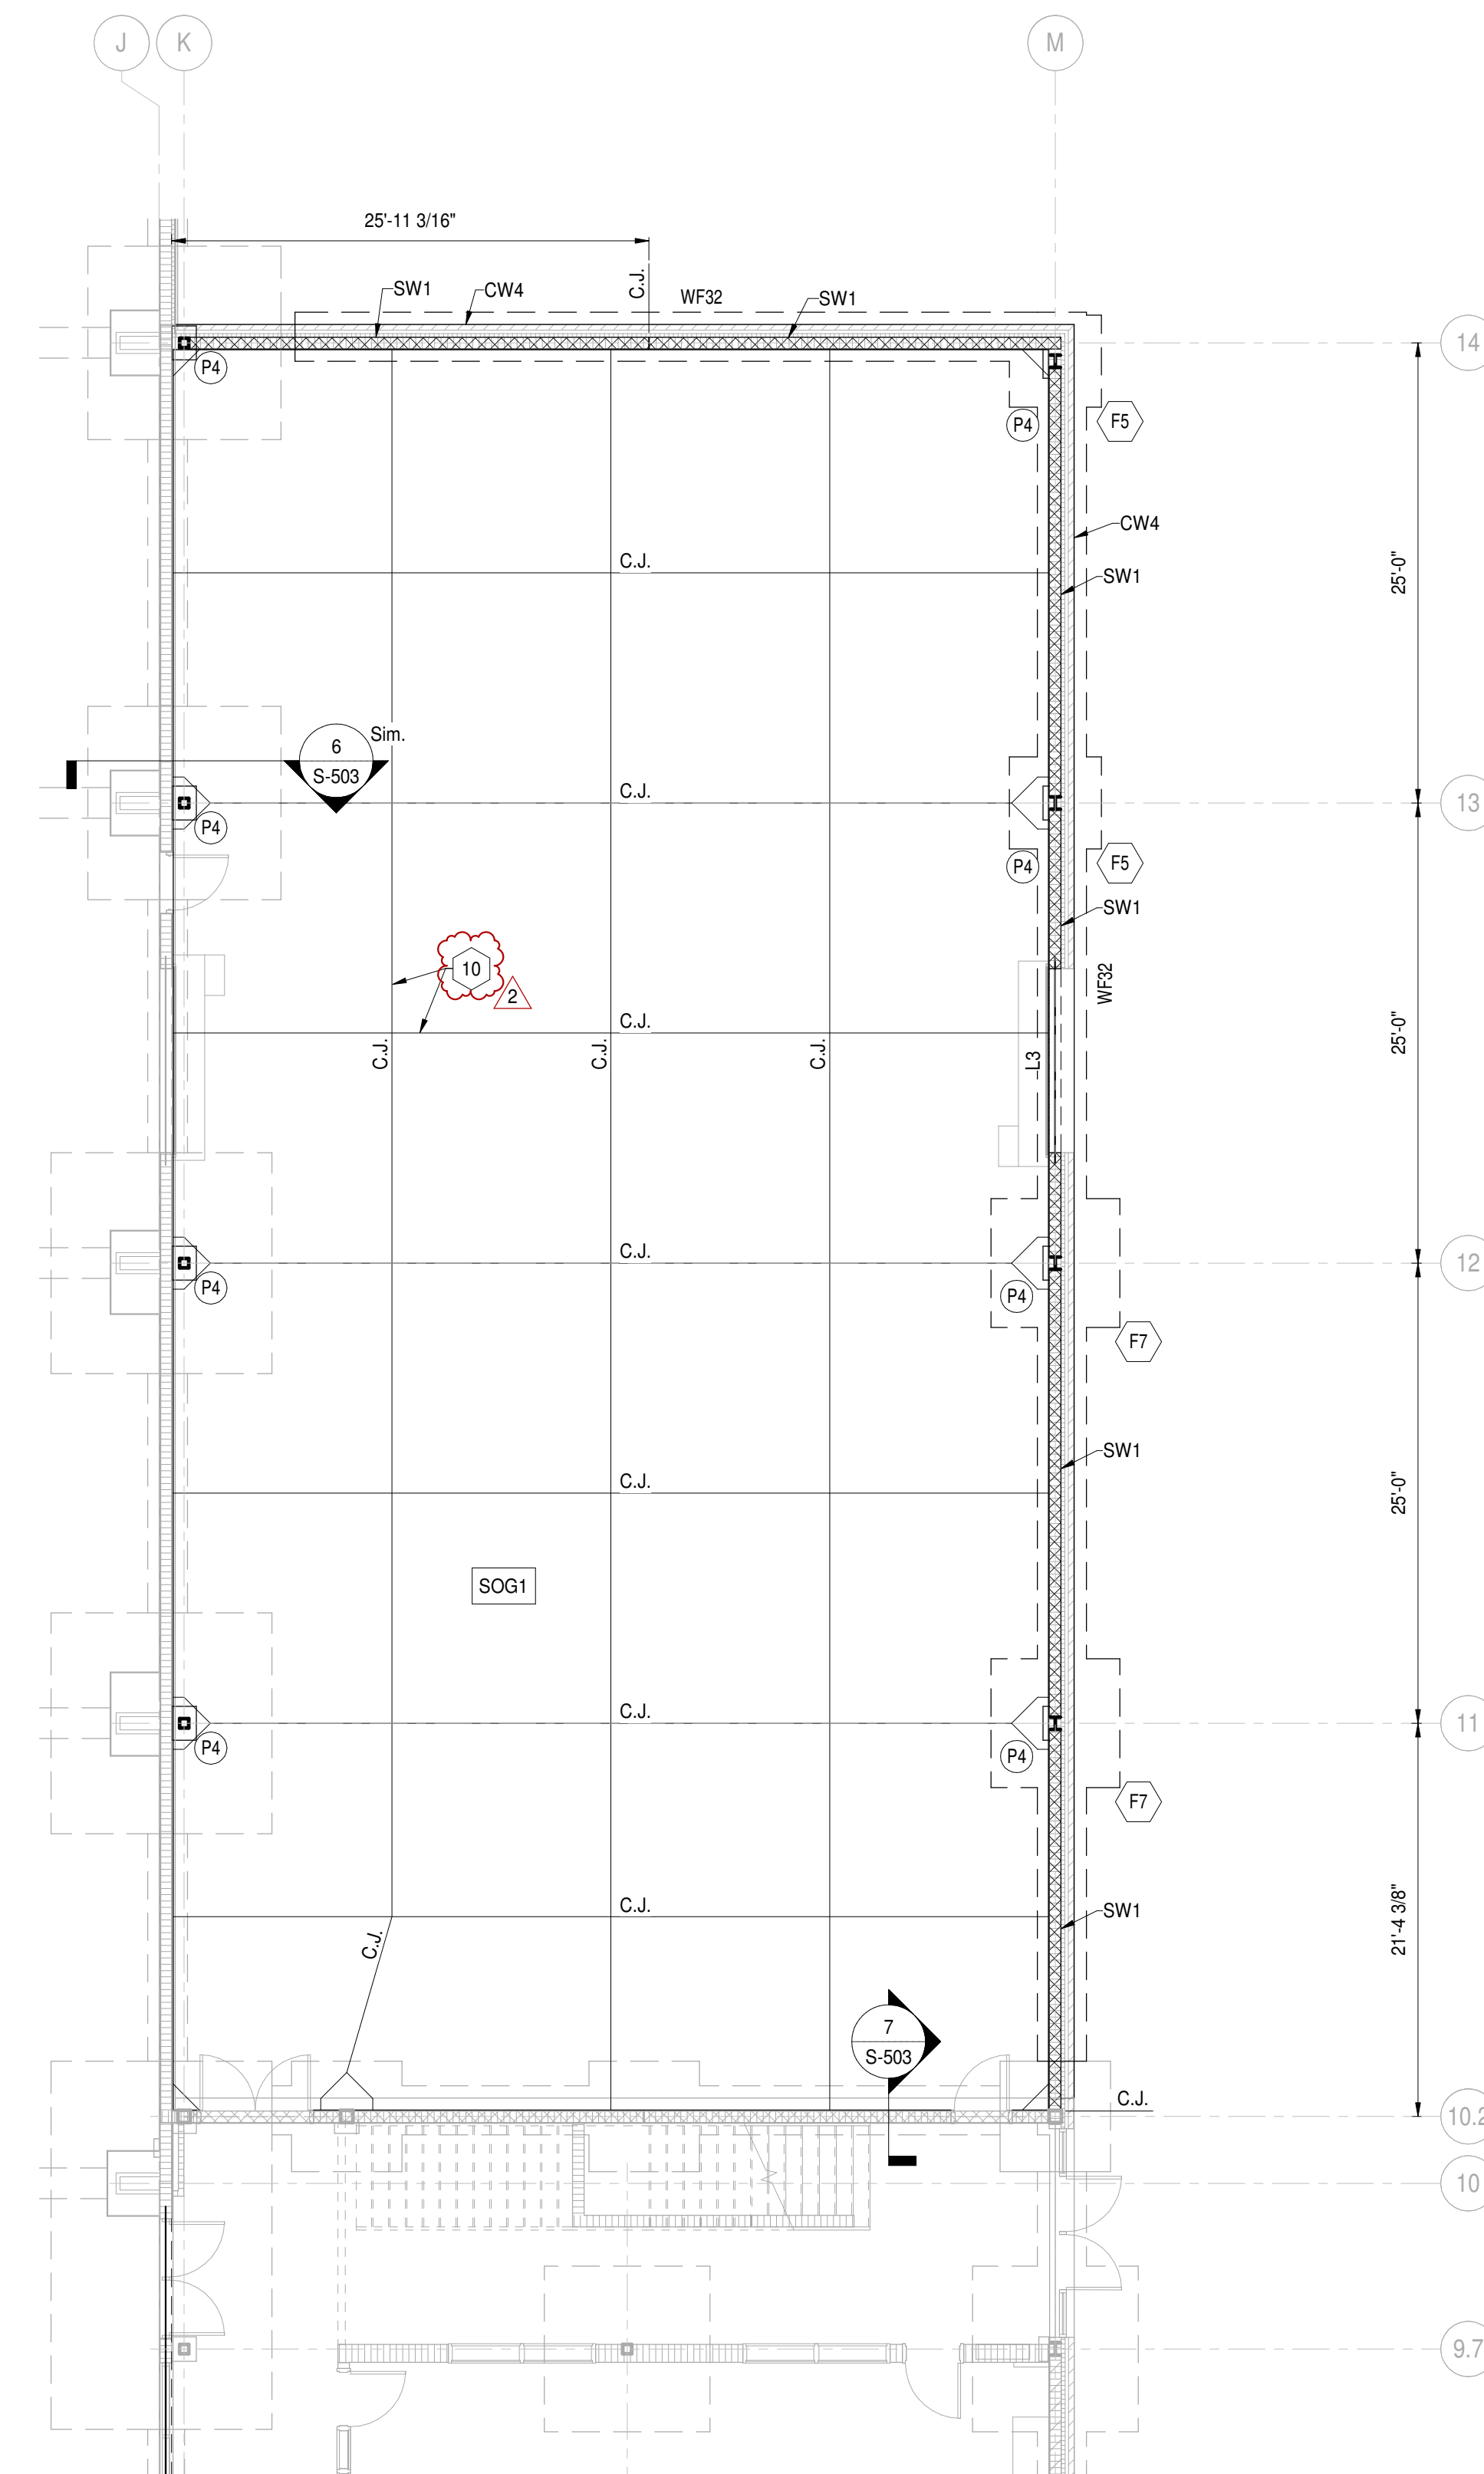

1 Foundation Plan Alternates - Unit C
Scale: 1/8" = 1'-0"

- Plan Notes:**
1. Reference elevation = 100'-0" (746.00' NAVD88).
 2. Refer to Architectural drawings for all dimensions not shown. Contractor shall verify all dimensions & elevations prior to construction and notify Architect & SEOR of any discrepancies.
 3. All walls shall be laid out from the arch. drawings.
 4. All contractor's shall coord. their work w/ all disciplines to avoid conflicts & identify all req'd materials and work.
 5. Coord. exact size & location of all mech. openings in floor slabs, roof decks & walls w/ the Mech. Contractor. Location & size of all duct openings, louvers, etc. shall be verified prior to construction.
 6. Provide channel frames at all supported slab openings and angle frames at all roof openings per typical details.
 7. Horiz. & diag. bridging for steel joists shall be designed, located & provided by joist supplier in accordance w/ SJI requirements. All diag. bridging shall be coordinated w/ mech. plans to avoid conflicts w/ duct runs.
 8. T/Steel Elev. = 114'-8 1/2" UNO.
 9. Contractor to coord. housekeeping pad w/ Owner-supplied laundry equipment. Ref. Arch. for additional requirements.
 10. Slab-on-grade control joints designated w/ 'C.J.'.

COPYRIGHT 2024 BY FANNINGHOWEY ASSOCIATES, INC.

PENN HIGH SCHOOL FIELDHOUSE

12641 McKinley Highway, Mishawaka, Indiana 46545

PENN-HARRIS-MADISON SCHOOL CORPORATION



FANNING HOWEY

317.848.0966 WWW.FHAI.COM
350 E NEW YORK ST #300, INDIANAPOLIS, IN 46204

MAGNUS ENGINEERING
STRENGTH | TRUST | COMMITMENT
63501 Beech Rd, Wakarusa, IN 46783
contactus@MagnusEng.com
www.MagnusEng.com

KEY PLAN

Construction Documents

PROJECT MANAGER: JAA
DRAWN BY: TCM
PROJECT NUMBER: 222130.00
PROJECT ISSUE DATE: January 10, 2024


REV. NO.	DESCRIPTION	DATE
1	Addendum #1	01/26/2024
2	Addendum #2	02/01/2024

Foundation & Framing Plan - Alternates

S-11C




1 Scale: 1/8" = 1'-0"

-  construction (omit from base bid)

S-12B

C:\Users\madelm\Documents\2023_PHS Field House_Struct_RVT23_Central_TywnMadelm.vnt
2/1/2024 12:40:29 PM

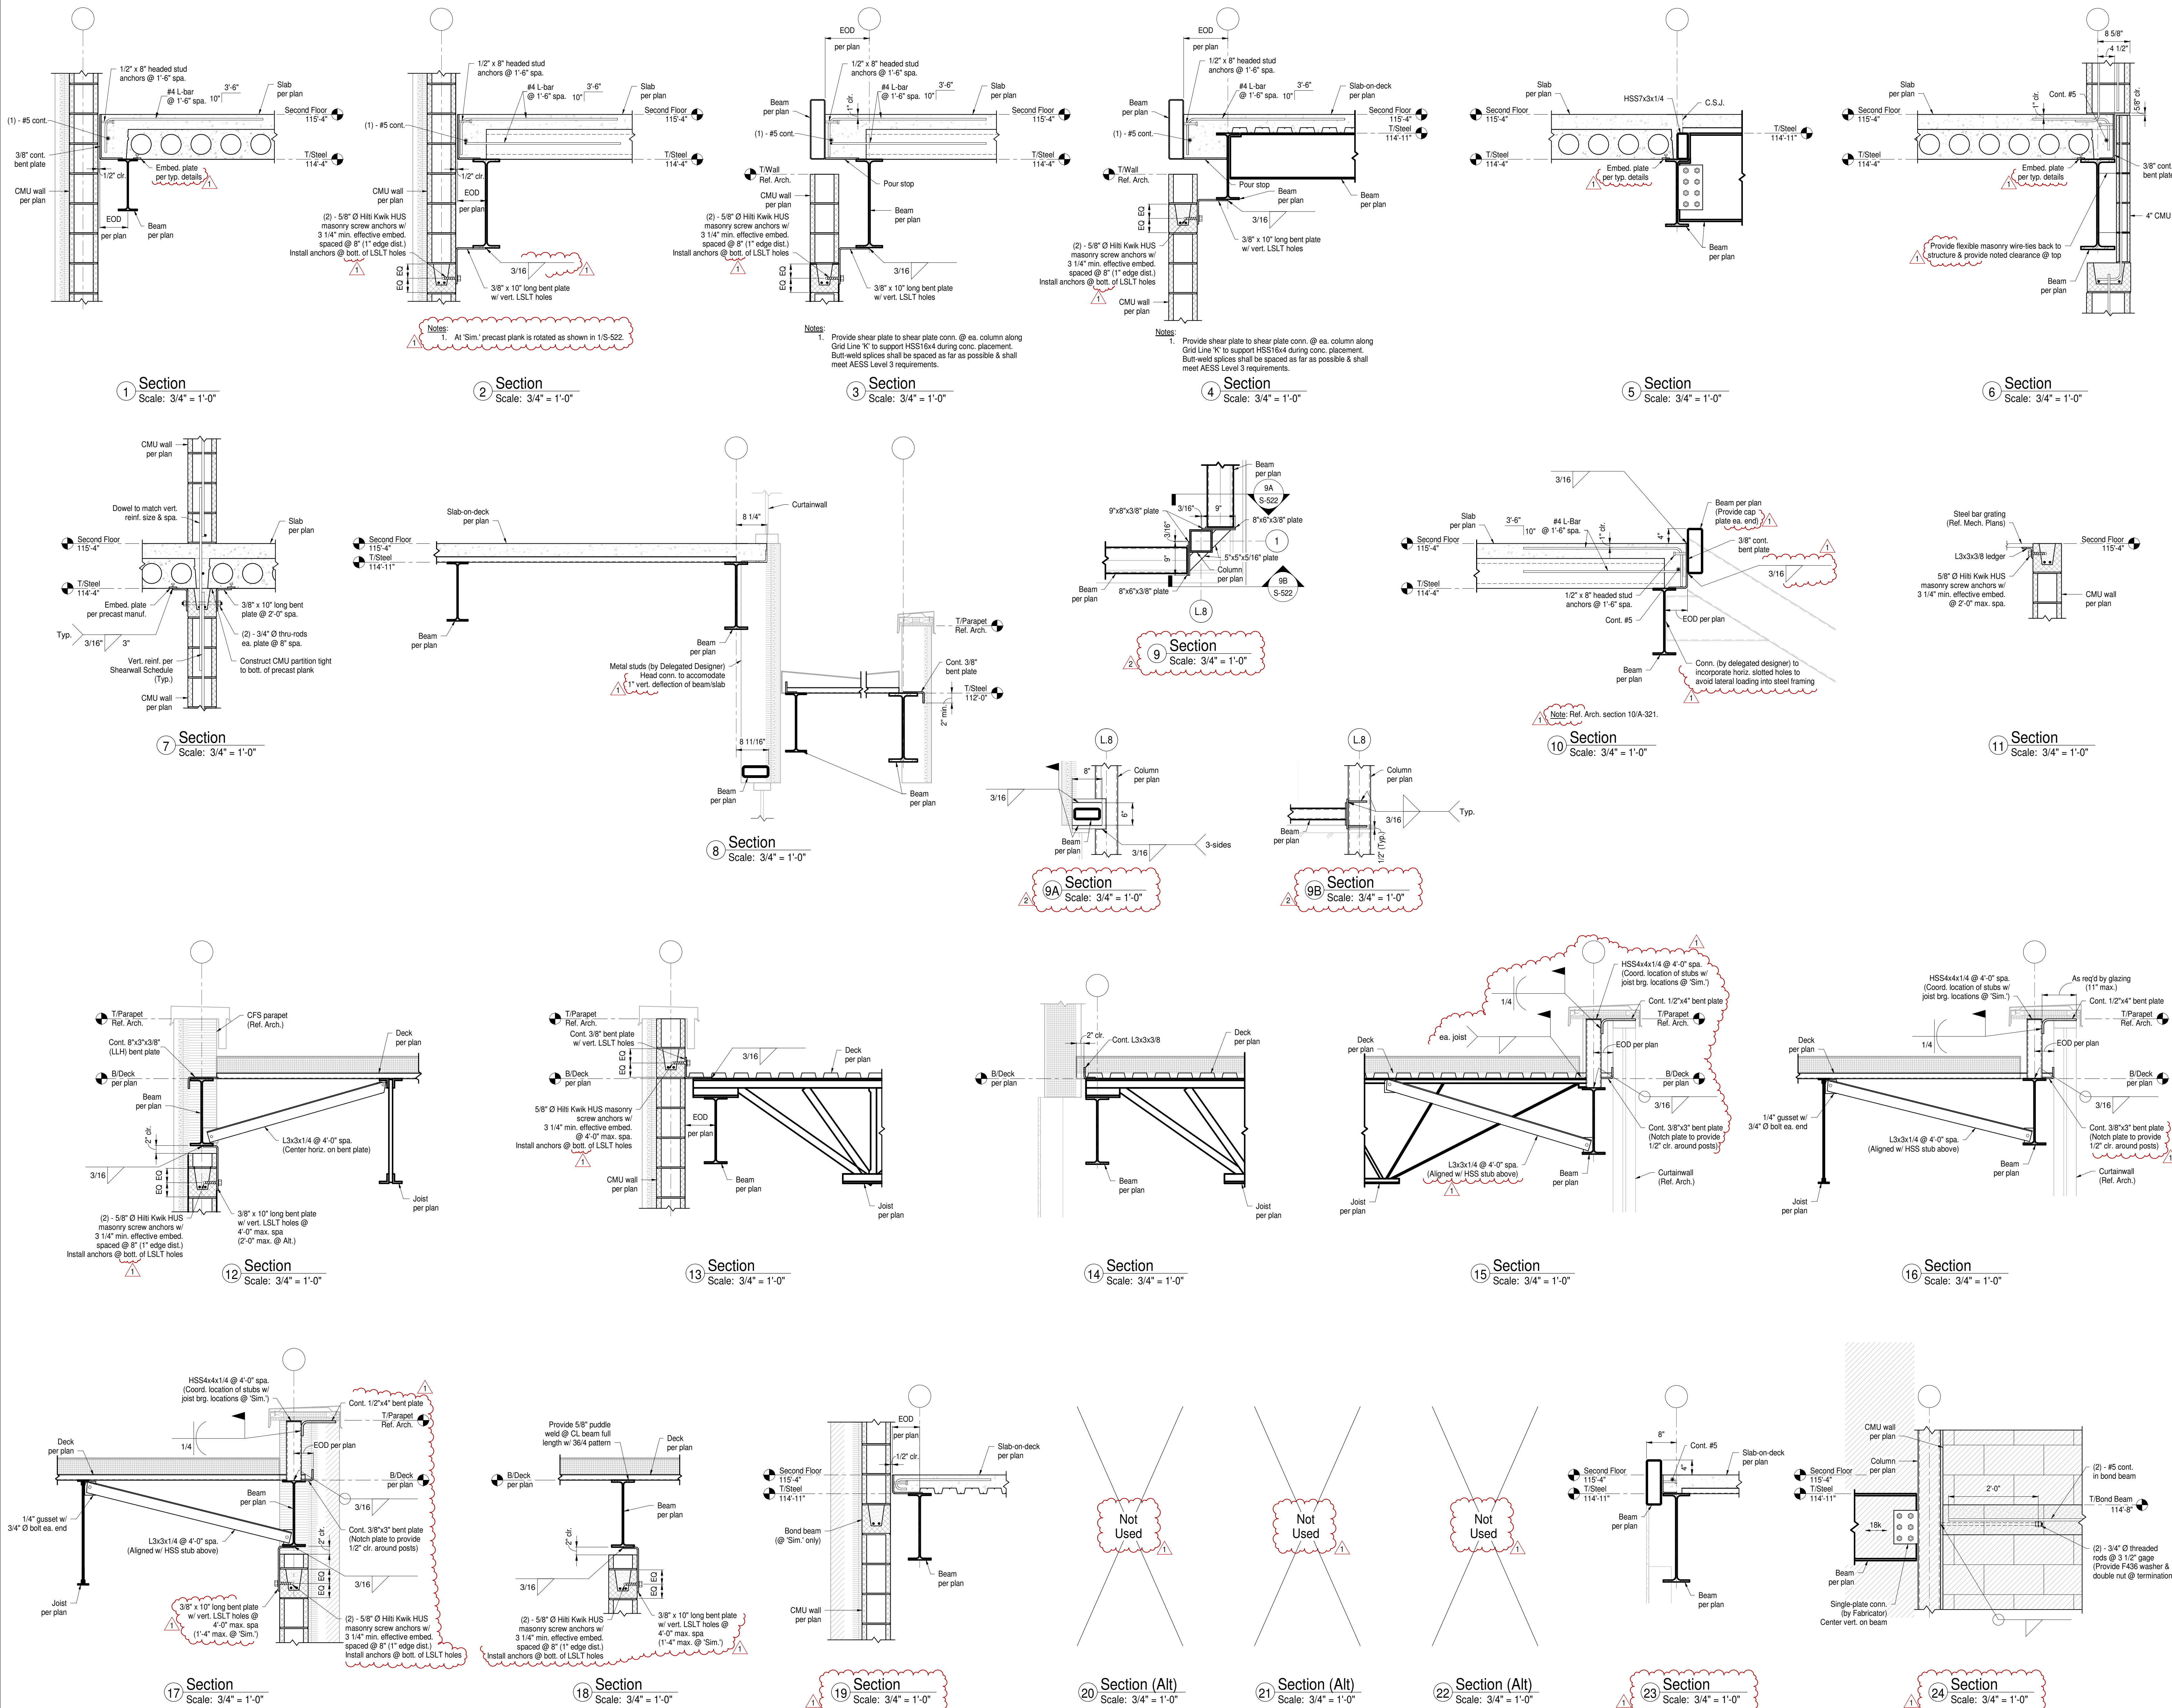

COPYRIGHT 2024 BY FANNINGHOWEY ASSOCIATES, INC.

PENN HIGH SCHOOL FIELDHOUSE

12641 McKinley Highway, Mishawaka, Indiana 46545

PENN-HARRIS-MADISON SCHOOL CORPORATION



ARCHITECT

FANNING HOWEY


317.848.0966 WWW.FHAI.COM
350 E NEW YORK ST #300, INDIANAPOLIS, IN 46204

CONSULTANT



63501 Beech Rd, Wakarusa, IN 46783
contactus@MagnusEng.com
www.MagnusEng.com

Construction Documents

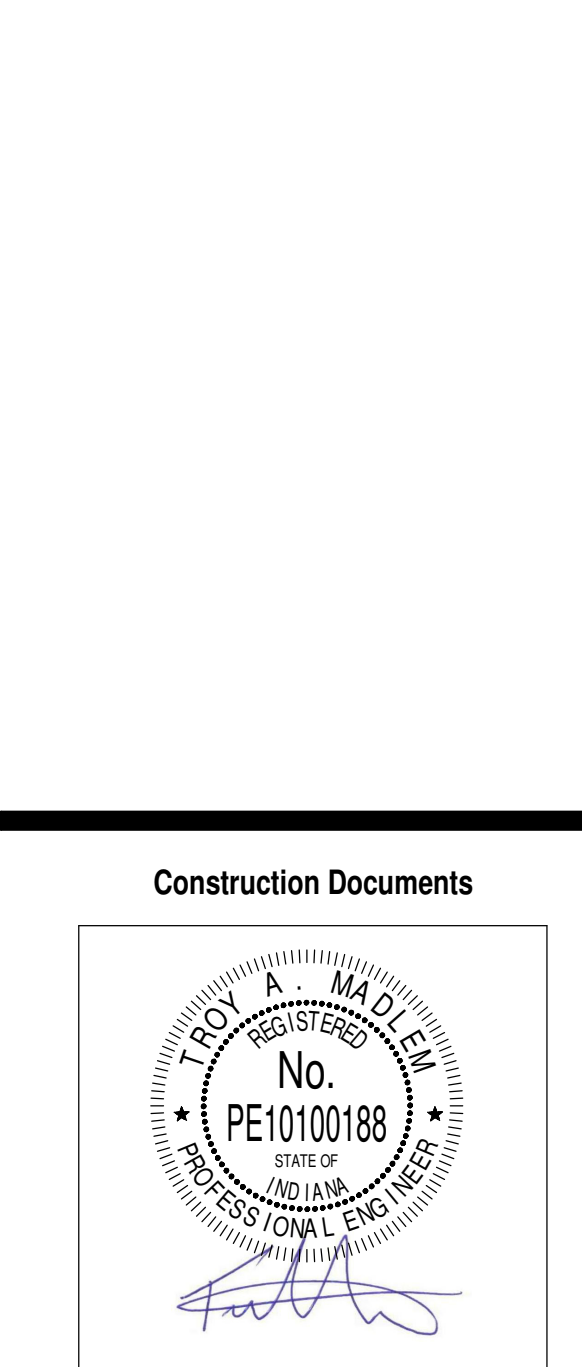


PROJECT MANAGER: JAA
DRAWN BY: TCM
PROJECT NUMBER: 22130.00
PROJECT ISSUE DATE: January 10, 2024

REV. NO.	DESCRIPTION	DATE
1	Addendum #1	01/26/2024
2	Addendum #2	02/01/2024

Steel Framing Details

S-522

C:\Users\lambert\Documents\2023_Arch_222130_10_alamphind_L215.rvt
2/1/2024 3:57:59 PM

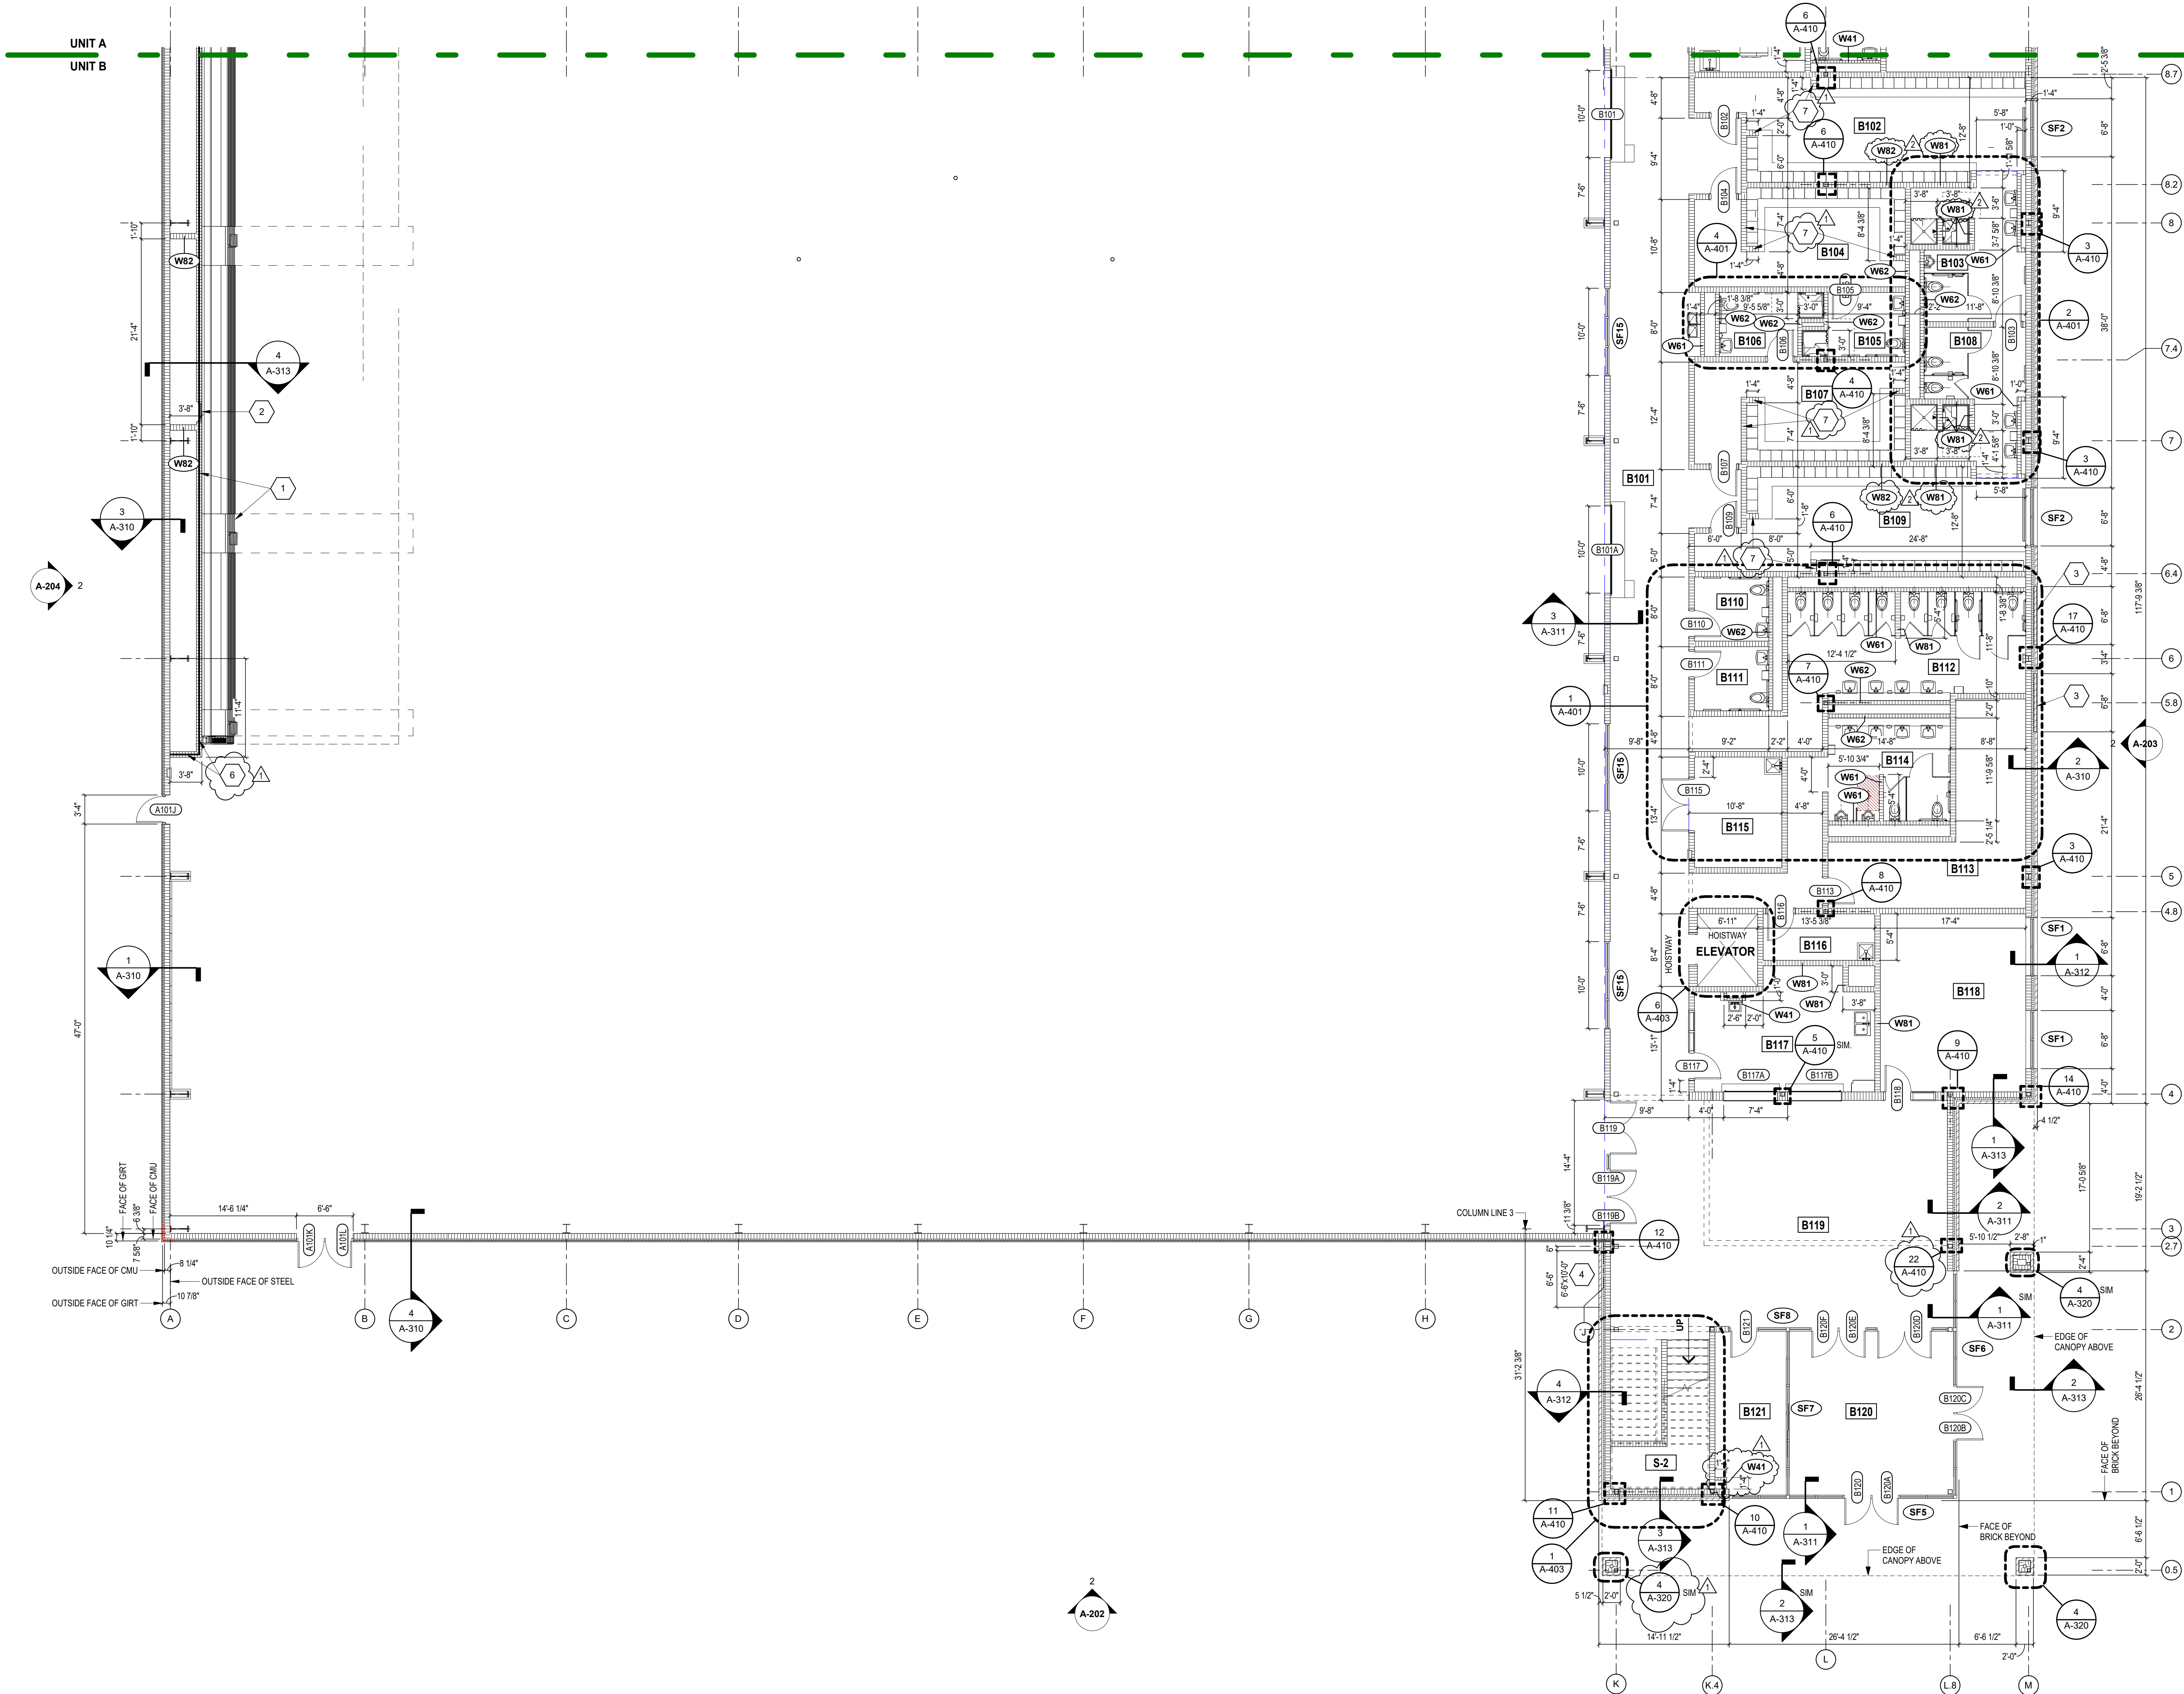

FIRST FLOOR ARCHITECTURAL PLAN - UNIT B

SCALE: 1/8" = 1'-0"

ARCHITECTURAL PLAN GENERAL NOTES

- ALL CMU WALLS THAT DO NOT LAY OUT IN FULL OR HALF LENGTHS SHOULD BE BALANCED SO AS NOT TO HAVE ANY PIECES LESS THAN 4" IN SIZE EXPOSED TO VIEW.
- WHERE DISSIMILAR FLOOR MATERIALS MEET, THEY SHALL DO SO UNDER THE CENTERLINE OF THE DOOR, UNLESS NOTED OTHERWISE.
- THE BASE FLOOR ELEVATION INDICATED FOR THE PROJECT IS 100'-0". REFER TO SITE PLAN FOR CORRELATION TO USGS DATUM.
- ALL INTERIOR MASONRY WALLS THAT RUN TO UNDERSIDE OF DECK ABOVE SHALL HAVE A 2" JOINT (U.N.O.) AT THE DECK TO BE FILLED WITH FIRE STOPPING AT RATED WALLS PER PROJECT MANUAL, AND MINERAL WOOL AT THE NON-RATED WALLS, TO ALLOW FOR DEFLECTION.
- FOR TYPICAL COMMON JOINT DETAILS AND CONSTRUCTION MOVEMENT JOINT DETAILS REFER TO DETAILS ON SHEET A-302.
- ALL DIMENSIONS ON FLOOR PLANS ARE TO FINISH FACE OF CMU, CONCRETE, BRICK OR FINISH FACE OF GIBB AT METAL STUD WALLS, UNLESS NOTED OTHERWISE.
- EXCEPTION: EXTERIOR METAL STUD WALLS ARE TO FACE OF METAL STUDS.
- HINGE SIDE DOOR JAMB AT WALLS WILL TYPICALLY BE LOCATED 4" MINIMUM FROM ADJACENT WALL, UNLESS NOTED OTHERWISE.
- ALL EXPOSED CONCRETE MASONRY UNITS (CMU) CORNERS ARE TO BE BULLNOSE, EXCEPT AT WINDOW JAMBS, BULKHEADS, WINDOW AND DOOR HEADS.
- SEE REFLECTED CEILING PLANS FOR BULKHEAD LOCATIONS AND DETAIL REFERENCES.
- REFER TO ROOM FINISH SCHEDULE OR PLAN AND EQUIPMENT PLANS FOR LOCATION AND EXTENT OF FINISH FLOOR MATERIALS.
- PROVIDE WOOD BLOCKING AS REQUIRED, WITHIN METAL STUD WALLS FOR WALL MOUNTED ITEMS.
- REFER TO MASTERCODE PLANS FOR CODE INFORMATION AND FIRE RATED WALL LOCATIONS.
- PROVIDE SPRAY FOAM INSULATION AND THERMAL BARRIER CONTINUOUS AT INTERSECTION OF EXTERIOR WALLS AND DECK.

ARCHITECTURAL PLAN NOTES

(ALL NOTES MAY NOT BE INDICATED ON THIS SHEET)

- INDICATES WALL TYPE. REFER TO DRAWING A301 FOR WALL THICKNESS, HEIGHT AND COMPOSITION.

NOTE: ALL INTERIOR WALLS ARE TO BE TYPE 82 (W82) UNLESS INDICATED OTHERWISE.

- CMU WALL AND TELESCOPING BLEACHERS (ALTERNATE)
- 2'-0" x 4'-0" ACCESS PANEL (ALTERNATE)
- RECESS BRICK 1" - SEE ELEVATIONS
- KNOCK-OUT PANEL. PROVIDE BACKER ROD / SEALANT JOINTS AT JAMBS SIMILAR TO 2-A502
- ROOF HATCH AND LADDER - SEE 1-AR101
- PROVIDE ALUMINUM GUARDRAIL AT THE TOP OF THE MASONRY CHASE - SEE 4/A-313 ALTERNATE
- 8'-0" HIGH WALL

ROOM LEGEND

ROOM NO.	ROOM NAME	AREA (SF)
A101	FIELDHOUSE	54,239 SF
B101	CORRIDOR	1,163 SF
B102	LOCKER ROOM #1	389 SF
B103	SHOWER	184 SF
B104	DRESSING ROOM #1	261 SF
B105	TOLLET	74 SF
B106	TOLLET	75 SF
B107	DRESSING ROOM #2	270 SF
B108	SHOWER	184 SF
B109	LOCKER ROOM #2	401 SF
B110	TOLLET	63 SF
B111	TOLLET	63 SF
B112	GIRLS RESTROOM	388 SF
B113	FIRE RISER	304 SF
B114	BOYS RESTROOM	270 SF
B115	STORAGE	127 SF
B116	CUSTODIAN	68 SF
B117	CONCESSION	263 SF
B118	OFFICE	341 SF
B119	LOBBY	1,039 SF
B120	VESTIBULE	369 SF
B121	SRO OFFICE	157 SF
S-2	STAIR	115 SF

COPYRIGHT 2024 BY FANNINGHOWE ASSOCIATES, INC.

PENN HIGH SCHOOL FIELDHOUSE

12641 McKinley Highway, Mishawaka, Indiana 46545

PENN-HARRIS-MADISON SCHOOL CORPORATION




ARCHITECT

FANNING HOWE

317.848.0966


WWW.FHAI.COM

350 E NEW YORK ST #500, INDIANAPOLIS, IN 46204

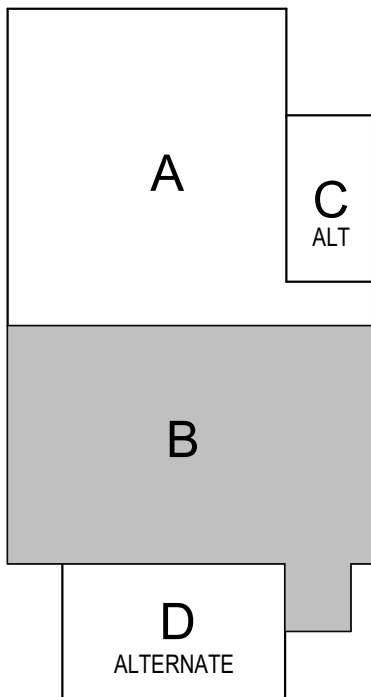

KEY PLAN

Construction Documents

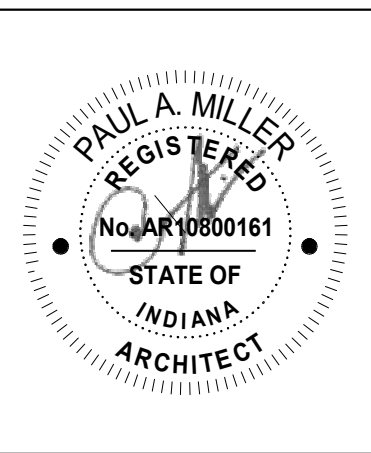

PROJECT MANAGER: MKS

DRAWN BY: KT

PROJECT NUMBER: 222130.00

PROJECT ISSUE DATE: January 10, 2024

REV. NO.	DESCRIPTION	DATE
1	Addendum #1	1-26-24
2	Addendum #2	2-1-24

FIRST FLOOR ARCHITECTURE PLAN - UNIT B


A-11B

**PENN-HARRIS-MADISON
SCHOOL CORPORATION**




**FANNING
HOWEY**

Diagram illustrating a four-way merge sort merge step. The input arrays are A, B, C, and D. A and B are merged into a gray array, and C and D are merged into a white array. These two intermediate arrays are then merged into a final white array, labeled 'ALTERNATE'.

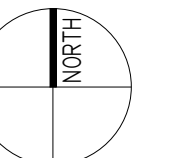

Construction Documents

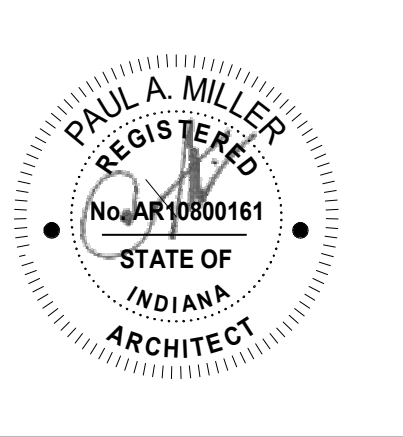[illegible]

A-12B

A. ALL CMU WALLS THAT DO NOT LAY OUT IN FULL OR FULL LENGTH SHOULD BE BALANCED SO AS NOT TO HAVE ANY PIER LESS THAN 4" FROM THE FACE OF THE WALL. WHERE DISMISAL FLOOR MATERIALS MEET, THEY SHALL DO SO UNDER THE CENTERLINE OF THE DOOR, UNLESS NOTED OTHERWISE.

B. THE BASE FLOOR ELEVATION INDICATED FOR THE PROJECT IS TO BE USED TO CORRELATE THE PLAN FOR CORRELATION TO USGS DATUM.

C. ALL INTERIOR MASONRY WALLS THAT RUN TO UNDESIRABLE PIER OR WALLS SHALL BE STOPPED AT THE FACE OF THE DECK BE FILLED WITH FIRE STOPPING AT RATED WALLS PER PROJECT MANUAL, AND MINERAL WOOL AT THE NON-DESIRABLE WALL TO ALLOW FOR FLOOR FINISHES.

D. FOR TYPICAL COMMON JOINT DETAILS AND CONSTRUCTION MOVEMENT JOINT DETAILS REFER TO DETAILS SECTION A-6.01.

E. ALL DIMENSIONS ON FLOOR PLANS ARE TO FINISH FACE OF CMU, CONCRETE, BRICK OR FINISH FACE OF GYPS AT INTERIOR WALLS, UNLESS OTHERWISE NOTED. AS AN EXCEPTION, EXTERIOR METAL STUD WALLS ARE TO FACE OF FINISH MATERIAL UNLESS OTHERWISE NOTED.

F. HINGE SIDE DOOR JAMBS AT WALLS WILL TYPICALLY BE LOCATED 4" MINIMUM FROM ADJACENT WALL UNLESS NOTED OTHERWISE.

G. ALL EXPOSED CONCRETE MASONRY UNITS (CMU) CORNERS ARE TO BE BULLNOSE. EXCEPT AT WINDOW JAMBS, BULLNOSE, WIND TO ROUNDOFF CORNERS TO 1/4" RADIUS.

H. SEE REFLECTED CEILING PLANS FOR BULKHEAD LOCATIONS AND DETAIL REFERENCES.

I. REFER TO INTERIOR FINISH PLANS FOR CODE INFORMATION AND EQUIPMENT PLANS FOR LOCATION AND EXTENT OF FINISH FLOOR MATERIALS.

J. PROVIDE FLOOR FLOORING AS REQUIRED, WITHIN METAL STUD WALLS FOR WALL MOUNTED ITEMS.

K. REFER TO INTERIOR FINISH PLANS FOR CODE INFORMATION AND FIRE RATED WALL LOCATIONS.

L. PROVIDE SPRAY FOAM INSULATION AND THERMAL BARRIER UNLESS AT INTERSECTION OF EXTERIOR WALLS AND DECK.

(ALL NOTES MAY NOT BE INDICATED ON THIS SHEET)

INDICATES WALL TYPE. REFER TO
DRAWING A301 FOR WALL THICKNESS,
HEIGHT AND COMPOSITION.

NOTE: ALL INTERIOR WALLS ARE TO BE TYPE 82 (W82) UNLESS
INDICATED OTHERWISE.

1. CMU WALL AND TELESCOPING BLEACHERS (ALTERNATE)
2. 2'-0" x 4'-0" ACCESS PANEL (ALTERNATE)
3. RECESS BRICK 1" - SEE ELEVATIONS
4. KNOCK-OUT PANEL. PROVIDE BACKER ROD / SEALANT JOINTS AT JAMBS SIMILAR TO 2-A502
5. ROOF HATCH AND LADDER - SEE 1-A1R01
6. PROVIDE ALUMINUM GUARDRAIL AT THE TOP OF THE MASONRY CHASE - SEE 4/A-313. ALTERNATE
7. 6'-8" HIGH WALL

ROOM NO.	ROOM NAME	AREA (SF)
A101	FIELDHOUSE	54,239 SF
A201	CORRIDOR	341 SF
A202	MECHANICAL	873 SF
B301	CORRIDOR	1,444 SF
B302	LOCKER ROOM #3	399 SF
B303	SHOWER	184 SF
B204	DRESSING ROOM #3	261 SF
B205	TOILET	74 SF
B306	TOILET	75 SF
B207	DRESSING ROOM #4	279 SF
B308	SHOWER	184 SF
B309	LOCKER ROOM #4	402 SF
B210	CLASSROOM	842 SF
B211	CUSTODIAN	67 SF
B212	TOILET	63 SF
B213	TOILET	63 SF
B214	ELECTRONIC / TECHNOLOGY	58 SF
B215	ELEVATOR EQUIPMENT	55 SF
B216	CLASSROOM	840 SF
B217	COMMONS	984 SF
S-2	STAIR	175 SF


VERIFICATION NOTE
CONTRACTOR SHALL VERIFY ALL DIMENSIONS AND CLEARANCES
AND ALL EXISTING FIELD CONDITIONS BEFORE STARTING
CONSTRUCTION. COMMENCEMENT OF WORK CONSTITUTES
ACCEPTANCE OF CONDITIONS.

SHOULD DIFFERENT CONDITIONS BE ENCOUNTERED, CONTACT THE ARCHITECT BEFORE PROCEEDING WITH WORK.




SCALE: 1/8" = 1'-0"

SHOULD DIFFERENT CONDITIONS BE ENCOUNTERED, CONTACT THE ARCHITECT BEFORE PROCEEDING WITH WORK.

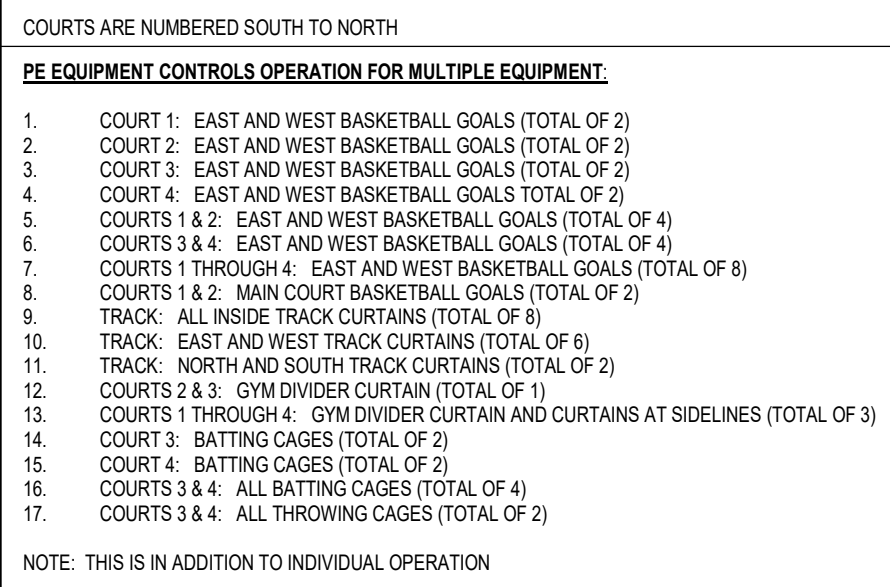

1 FIRST FLOOR EQUIPMENT PLAN - UNIT A
SCALE: 1/8" = 1'-0"

SHOULD DIFFERENT CONDITIONS BE ENCOUNTERED, CONTACT THE ARCHITECT BEFORE PROCEEDING WITH WORK.

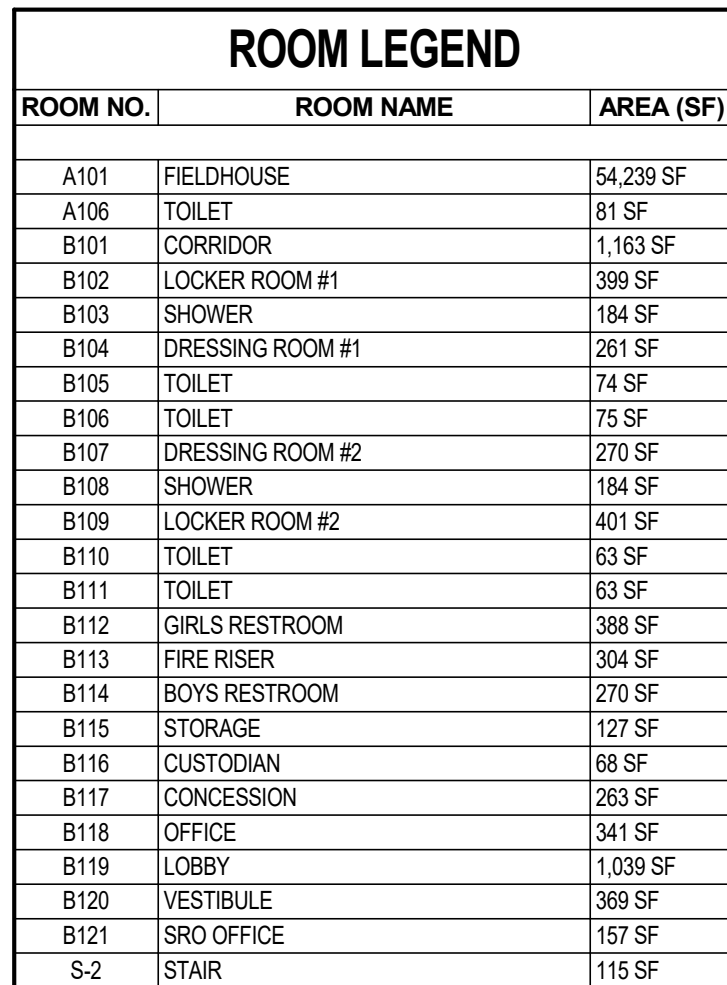

SCALE: 1/8" = 1'-0"

ROOM LEGEND		
ROOM NO.	ROOM NAME	AREA (SF)
B114	BOYS RESTROOM	270 SF
B115	STORAGE	127 SF
B116	CUSTODIAN	68 SF
B117	CONCESSION	283 SF
B118	OFFICE	341 SF
B119	LOBBY	1039 SF
B120	VESTIBULE	369 SF
B121	SRO OFFICE	157 SF
S-2	STAIR	115 SF

COPYRIGHT 2024 BY FANNING/HOWEY ASSOCIATES, INC.


12641 McKinley Highway, Mishawaka,
Indiana 46545

ARCHITECT



**FANNING
HOWEY**

317.848.0966 WWW.FHAI.COM
350 E NEW YORK ST #300, INDIANAPOLIS, IN 46204

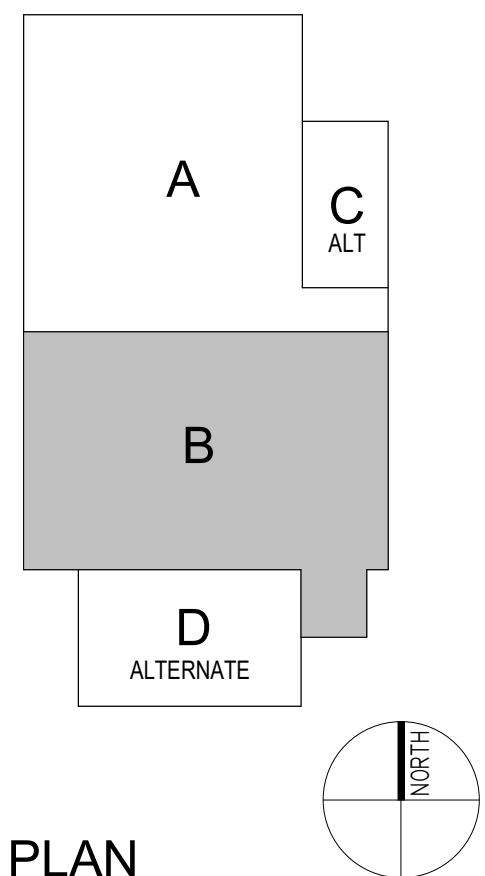

KEY PLAN

Construction Documents



PROJECT MANAGER: MKS
DRAWN BY: DJA
PROJECT NUMBER: 222130.00
PROJECT ISSUE DATE: January 10, 2024

[illegible]

**FIRST FLOOR VENTILATION PLAN -
UNIT B**

MV102

VENTILATION PLAN NOTES

(ALL NOTES MAY NOT BE INDICATED ON THIS SHEET)

- | | |
|-----|---|
| T4 | APPROXIMATE LOCATION OF DUCT STATIC PRESSURE SENSOR. SENSOR PROVIDED BY THE TEMPERATURE AND HUMIDITY CONTROL CONTRACTOR. COORDINATE MECHANICAL CONTRACTOR. COORDINATE ELECTRICAL CONTRACTOR WITH TRADES. |
| V4 | PROVIDE VOLUME DAMPER IN RETURN DUCTWORK TO AIR SUPPLY. AIR DIFFUSERS AND RETURN AIR GRILLE PROVIDED BY AIR ROTATION UNIT MANUFACTURER. CONTRACTOR TO PROVIDE INTERIOR DUCTWORK BETWEEN DIFFUSER/GRILLE AND AIR ROTATION UNIT. PAINT DIFFUSER/GRILLE PROVIDED BY MANUFACTURER. COORDINATE FINAL COLOR WITH ARCHITECT. |
| V4 | DUCT ROUTED UP TO FLOOR ABOVE. COORDINATE WITH STRUCTURAL. IN AREA. |
| V13 | DUCTWORK TO BE INSTALLED OPENING LOCATED ABOVE THE CEILING. COORDINATE ELECTRICAL LOCATION WITH TRADES. END OF DUCT OPEN TO SPACE. |
| V16 | DUCTWORK CONTRACTOR TO PROVIDE MANHOLE'S BAR GRATING STANDARD TO BE WEDED, GALVANIZED STEEL NOT THICKER THAN 1/8" RECTANGULAR BAR ABOVE. MANHOLE'S (OR EQUIVALENT) NOT HIGHER THAN 18" ABOVE. COORDINATE WITH ARCHITECTURAL & STRUCTURAL. |
| V16 | DUCTWORK PROVIDED WITH INTERNAL LINEN INSULATION. REFER TO SPECIFICATIONS. |
| V16 | PROVIDE AND INSTALL 3" EXHAUST VENT WITH A MINIMUM 14 INCH PER FOOT PITCH UPWARDS PER MANUFACTURER'S REQUIREMENTS FOR EACH VENT. COORDINATE WITH ARCHITECT. FINAL VENT DIAMETER WITH APPROVED SUBMITTALS. EXHAUST VENT MUST BE 3 FEET ABOVE THE COMBUSTION APPLIANCE. 10 FEET ABOVE ALL OTHER PORTS OF THE BUILDING WITHIN 10 FEET. ROUTE VENT UP THROUGH TRANSITION TO EXHAUST OUTSIDE. EXHAUST VENT REQUIRED. TERMINATE DUCT WITH SUPPORT COLLAR, ROOF FLASHING, AND VELOCITY CONE. |
| V16 | PROVIDE AND INSTALL 3" EXHAUST AIR INLET PER MANUFACTURER'S REQUIREMENTS. COORDINATE WITH ARCHITECT. FINAL VENT DIAMETER WITH APPROVED SUBMITTALS. ROUTE COMBUSTION AIR DUCT UP THROUGH TRANSITION TO EXHAUST OUTSIDE. EXHAUST CHASE IS REQUIRED. TERMINATE COMBUSTION AIR INLET WITH GOSNOREN, REFER TO DETAIL. PIPE SIZE AND SUPPORT MANHOLE MANUFACTURER'S REQUIREMENTS. |

VERIFICATION NOTE


CONTRACTOR SHALL VERIFY ALL DIMENSIONS AND CLEARANCES AND ALL EXISTING FIELD CONDITIONS BEFORE STARTING CONSTRUCTION. COMMENCEMENT OF WORK CONSTITUTES ACCEPTANCE OF CONDITIONS.

SHOULD DIFFERENT CONDITIONS BE ENCOUNTERED, CONTACT THE ARCHITECT BEFORE PROCEEDING WITH WORK.

UNIT B - FIRST FLOOR VENTILATION PLAN

SCALE: 1/8" = 1'-0"

C:\Users\larned\Documents\2023_MECH_222130.00_damod\VAZF.rvt
2/1/2024 11:39:42 AM

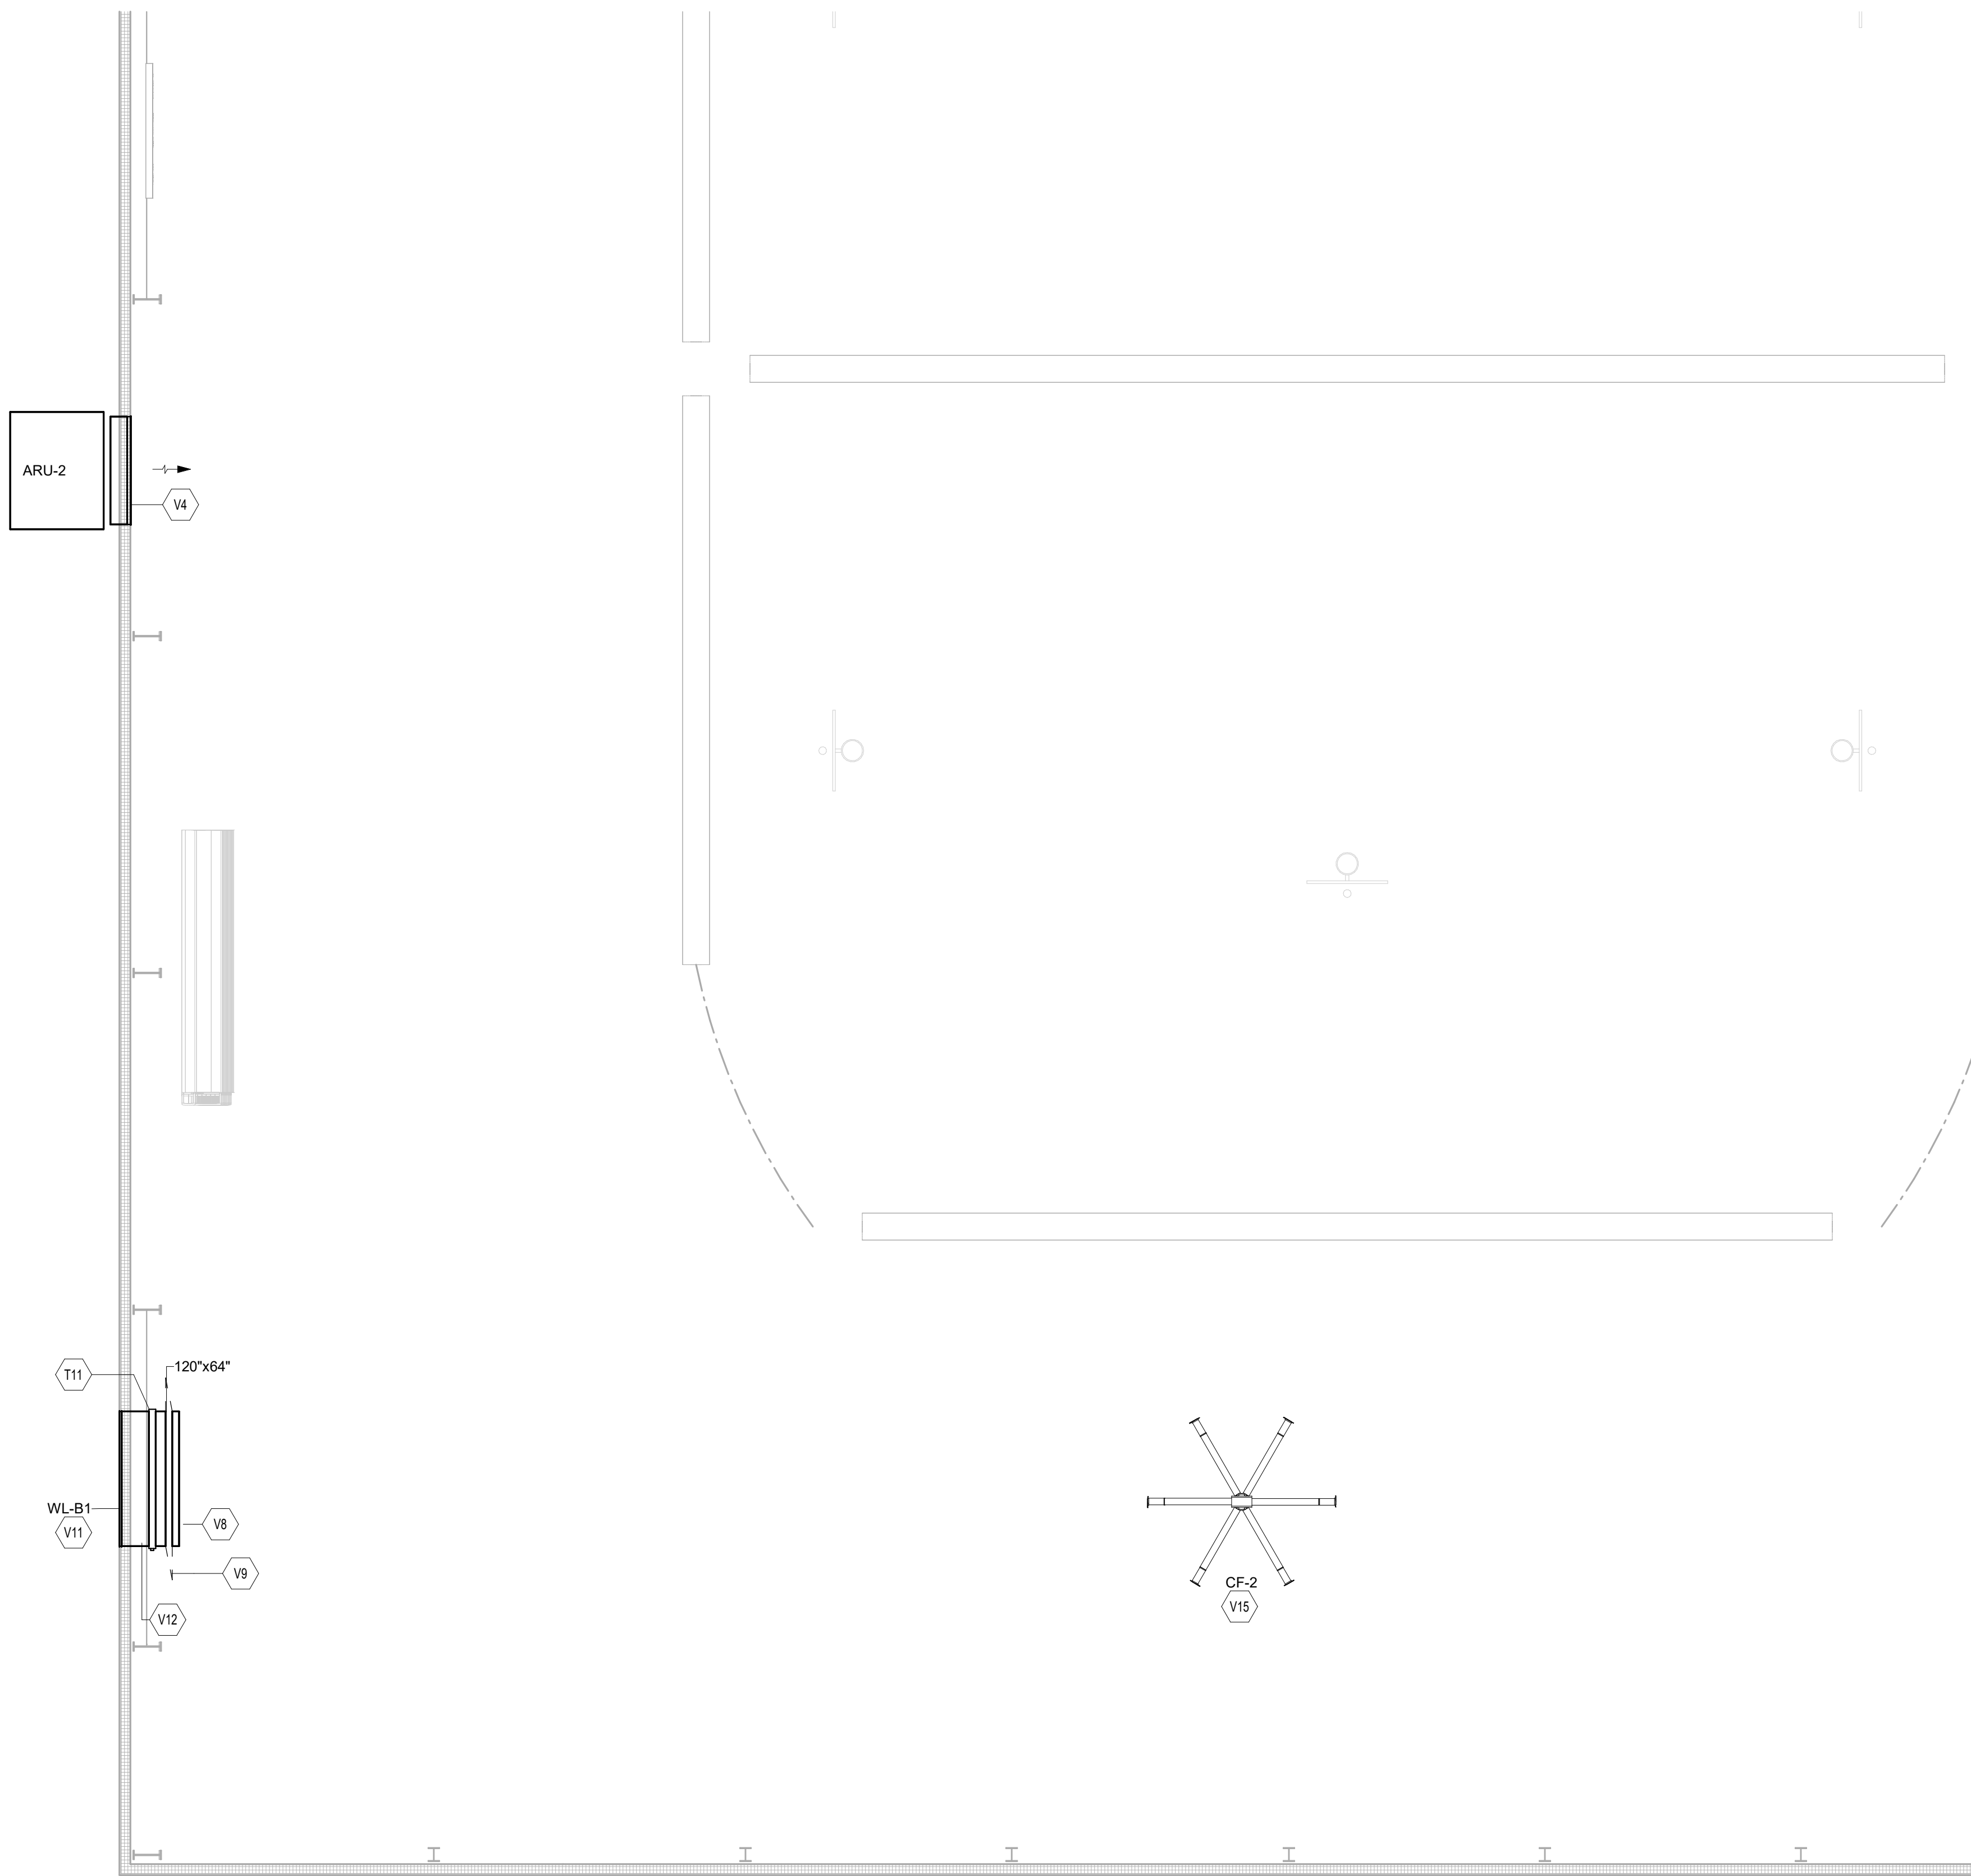

**PENN HIGH
SCHOOL
FIELDHOUSE**

12641 McKinley Highway, Mishawaka,
Indiana 46545

**PENN-HARRIS-MADISON
SCHOOL CORPORATION**



ARCHITECT




**FANNING
HOWEY**

317.848.0966

WWW.FHAI.COM

350 E NEW YORK ST #300, INDIANAPOLIS, IN 4620

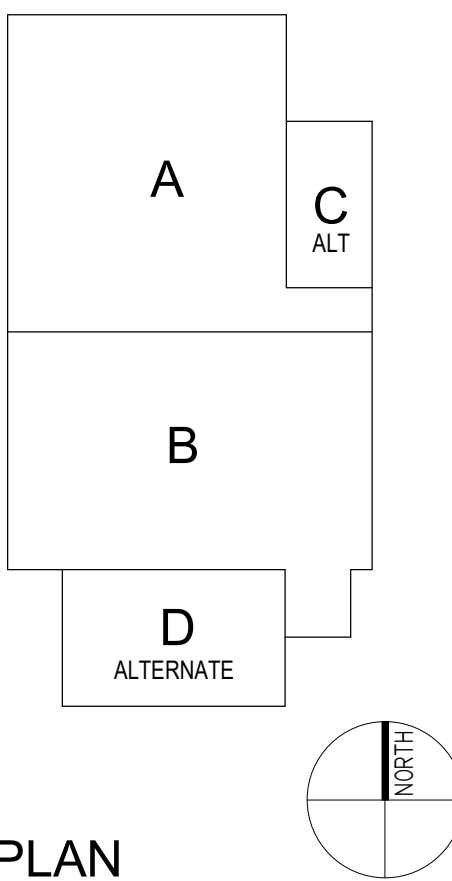

KEY PLAN

Construction Documents:



PROJECT MANAGER: MKS

DRAWN BY: DJ

PROJECT NUMBER: 222130.00

PROJECT ISSUE DATE: January 10, 2024

[illegible]

MECHANICAL SCHEDULES

M-602

DIFFUSER, REGISTER, AND GRILLE SCHEDULE									
MARK	TYPE	EXAMPLE MANUFACTURER MODEL NO.	NECK SIZE	OVERALL SIZE L"xW"	MAX CORE/ NECK VEL.(FPM)	MAX. CFM	MAX. NOISE CRITERIA	FRAME/ MOUNTING	REMARKS
A	SQUARE PLAQUE CEILING DIFFUSER	TITUS OMNI	6"	12"x12"	800	150	21	REFER TO REFLECTED CEILING PLAN	4-WAY BLOW DIFFUSERS, UNLESS INDICATED OTHERWISE ON DRAWINGS
B	SQUARE PLAQUE CEILING DIFFUSER	TITUS OMNI	6"	24"x24"	800	150	20	REFER TO REFLECTED CEILING PLAN	4-WAY BLOW DIFFUSERS, UNLESS INDICATED OTHERWISE ON DRAWINGS
C	SQUARE PLAQUE CEILING DIFFUSER	TITUS OMNI	8"	24"x24"	800	300	20	REFER TO REFLECTED CEILING PLAN	4-WAY BLOW DIFFUSERS, UNLESS INDICATED OTHERWISE ON DRAWINGS
D	SQUARE PLAQUE CEILING DIFFUSER	TITUS OMNI	10"	24"x24"	800	500	20	REFER TO REFLECTED CEILING PLAN	4-WAY BLOW DIFFUSERS, UNLESS INDICATED OTHERWISE ON DRAWINGS
E	SIDEWALL- SUPPLY GRILLE	TITUS 300RL	-	SEE FLOOR PLANS FOR SIZE	500	PER PLANS	20	DUCT OR SIDEWALL: REFER TO FLOOR PLAN	45 (DEGREE) DEFLECTION, UNLESS NOTED OTHERWISE ON FLOOR PLAN
F	SIDEWALL- RETURN GRILLE	TITUS 350FL	-	SEE FLOOR PLANS FOR SIZE	300	PER PLANS	20	DUCT OR SIDEWALL: REFER TO FLOOR PLAN	FIXED 35 (DEGREE) DEFLECTION BLADES
G	RETURN/AIR TRANSFER GRILLE	TITUS 355	-	12"x12"	500	450	20	REFER TO REFLECTED CEILING PLAN	PROVIDE ALUMINUM SURFACE MOUNT BORDER FOR DUCTED INSTALLATIONS.
H	RETURN/AIR TRANSFER GRILLE	TITUS 355	-	24"x12"	500	850	20	REFER TO REFLECTED CEILING PLAN	PROVIDE ALUMINUM SURFACE MOUNT BORDER FOR DUCTED INSTALLATIONS.
I	RETURN/AIR TRANSFER GRILLE	TITUS 355	-	24"x24"	500	1600	20	REFER TO REFLECTED CEILING PLAN	PROVIDE ALUMINUM SURFACE MOUNT BORDER FOR DUCTED INSTALLATIONS
J	LINEAR DIFFUSER SUPPLY	TITUS FL-10	6"	48" x 2-3/4"	-	175	20	DUCT - W/ SAFETY CHAIN REFER TO FLOOR PLAN	HIGHTHROW W/INSULATED PLENUM 1.0" SLOT WIDTH, TOTAL OF 1 SLOT
K	LINEAR DIFFUSER SUPPLY	TITUS FL-10	8"	48" x 2-3/4"	-	250	20	DUCT - W/ SAFETY CHAIN REFER TO FLOOR PLAN	JETHROW W/INSULATED PLENUM 1.0" SLOT WIDTH, TOTAL OF 1 SLOT
L	LINEAR DIFFUSER SUPPLY	TITUS FL-10	8"	48" x 6-1/16"	-	325	20	DUCT - W/ SAFETY CHAIN REFER TO FLOOR PLAN	HIGHTHROW W/INSULATED PLENUM 1.0" SLOT WIDTH, TOTAL OF 2 SLOT
M	SIDEWALL- SUPPLY GRILLE	TITUS 300RL	-	SEE FLOOR PLANS FOR SIZE	500	PER PLANS	20	DUCT OR SIDEWALL: REFER TO FLOOR PLAN	45 (DEGREE) DEFLECTION, UNLESS NOTED OTHERWISE ON FLOOR PLAN
N	SIDEWALL- RETURN GRILLE	TITUS 350FL	-	SEE FLOOR PLANS FOR SIZE	300	PER PLANS	20	DUCT OR SIDEWALL: REFER TO FLOOR PLAN	FIXED 35 (DEGREE) DEFLECTION BLADES

PUMP SCHEDULE																	
MARK	SYSTEM SERVED	TYPE	MIN FLOW GPM	GPM	HEAD FT.	MIN EFF. %	BHP@ DESIGN FLOW	SUCT. X DISCH.	IMPELLER DIAMETER	MOTOR				MANUF.	MODEL NUMBER	WEIGHT (LBS.)	NOTES
										RPM	HP	VOLT	PH				
HWP-1	PRIMARY HEATING HOT WATER	CLOSE COUPLED IN-LINE	0	75	22	52.9	0.77	NA	NA	2716	1	208	1	BELL & GOSSETT	ecocirc XL 40-200	37	1.2
HWP-2	PRIMARY HEATING HOT WATER	CLOSE COUPLED IN-LINE	0	75	22	52.9	0.77	NA	NA	2716	1	208	1	BELL & GOSSETT	ecocirc XL 40-200	37	1.2
HWP-3	SECONDARY HEATING HOT WATER	BASE MOUNTED END SUCTON	9	60	53	55.4	1.42	1.5x1.5	8.75	1800	3	208	3	BELL & GOSSETT	E-80 1.5x1.5x3.5B-182J,M	180	1.3,4.5
HWP-4	SECONDARY HEATING HOT WATER	BASE MOUNTED END SUCTON	9	60	53	55.4	1.42	1.5x1.5	8.75	1800	3	208	3	BELL & GOSSETT	E-80 1.5x1.5x3.5B-182J,M	180	1.3,4.5

NOTES:

1. REFER TO PROJECT MANUAL SECTION 232123.
2. PUMP CONTROLLED VIA ECM MOTOR.
3. PUMP CONTROLLED BY VARIABLE FREQUENCY CONTROLLER.
4. SECONDARY PUMPS WILL OPERATE IN PARALLEL. PUMP SHALL BE SIZED SUCH THAT IT DOES NOT RUN OFF ITS CURVE. WHEN OPERATING ALONE OUT AT THE SYSTEM CURVE.
5. SINGLE POINT POWER CONNECTION TO THE PUMP. PUMP DISCONNECT AND WIRING BETWEEN PUMP AND VFC BY DIVISION 26.

EXPANSION TANK/AIR SEPARATOR SYSTEM																
MARK NO.	SYSTEM	APPROX. SYSTEM VOLUME GAL.	SYSTEM TEMP. RANGE °F		PRESS. FILL. PRESURE AT TANK PSIG	MAX. OPERATING PRESSURE PSIG		MIN. TANK VOLUME GAL.	MIN. ACCEPT. VOLUME GAL.	100% OPER. WEIGHT LBS.	TANK MANUFACTURER & MODEL NO.	AIR SEPARATOR				AIR SEPARATOR MANUFACTURER & MODEL NO.
			MIN.	MAX.		RELIEF VALVE	AT EXP. TANK					SIZE	GPM	WPD	FLOODED WEIGHT	
ET-1 AS-1	HEATING HOT WATER	336	50	200	20	60	55	26	26	320	BELL & GOSSETT B110	3"	120	1.2	125 LBS	BELL & GOSSETT RL-34

NOTES:

1. AIR SEPARATOR WITH STRAINER SHALL HAVE TANGENTIAL INLET AND OUTLET
2. REFER TO SPECIFICATION 232113.
3. EXPANSION TANKS SHALL BE SELECTED WITH 100% WATER.

VARIABLE FREQUENCY CONTROLLER SCHEDULE							
MARK	EQUIPMENT SERVING	MARK SERVING	HP	SERVICE			NOTES
				(VOLT)	(HZ)	(PH)	
VFC-HWP-1	HEATING HOT WATER PUMP	HWP-1	3	208	60	3	1,2,3,4,5
VFC-HWP-2	HEATING HOT WATER PUMP	HWP-2	3	208	60	3	1,2,3,4,5
VFC-AHU-2S	AHU - SUPPLY FAN	AHU-2	7.5	480	60	3	1,2,3,4,5
VFC-AHU-2E	AHU - EXHAUST FAN	AHU-2	6	480	60	3	1,2,3,4,5

NOTES

1. DRIVE PROVIDED AND INSTALLED BY THE DIVISION 23 - HVAC CONTRACTOR.
2. DIVISION 26 - ELECTRICAL CONTRACTOR TO PROVIDE POWER WIRING TO VFC AND FROM VFC TO MOTOR.
3. TEMPERATURE CONTROL CONTRACTOR SHALL PROVIDE ALL TEMPERATURE CONTROL WIRING
4. REFER TO PROJECT MANUAL FOR ADDITIONAL REQUIREMENTS.
5. PROVIDED WITH A FACTORY MOUNTED DISCONNECT.

REFER TO MECHANICAL DRAWINGS FOR
EQUIPMENT THAT IS WITHIN ALTERNATES

HEATING PLANT EQUIPMENT SCHEDULE	
MARK	DESCRIPTION
BF-1	EATON FLOWLINE II - FBF211XSF-DP50304 SIDE LOOP BAG FILTER HOUSING FOR HEATING WATER SYSTEM.
CF-1	HEATING WATER CHEMICAL SHOT FEEDER, 5.0 GALLON CAPACITY.

PROVIDE REVERSED TYPE PANELOBOARD DIRECTORIES FOR EACH PANELOBOARD ADDED OR MODIFIED DURING THE PROJECT. FIELD VERIFY THE CORRECT INFORMATION WITH OWNER'S ASSISTANCE TO ENSURE THE CORRECT INFORMATION IS ACCURATE. PROVIDE BREAKERS SHALL BE IN THE OFF POSITION.

VIDEO PROJECTOR RECEPTACLE TO BE MOUNTED ABOVE THE PROJECTOR SCREEN. PROVIDE THE VIDEO PROJECTOR SHALL VERIFY ALL DIMENSIONS AND CLEARANCES AND ALL EXISTING FIELD CONDITIONS. PROVIDE THE VIDEO PROJECTOR SHALL VERIFY THE WORK CONSTITUTES ACCEPTANCE OF CONDITIONS. PROVIDE THE VIDEO PROJECTOR SHALL VERIFY THE CONTACT THE ARCHITECT BEFORE PROCEEDING WITH WORK.

4. LABEL EACH RECEPTACLE WITH THE PANEL NAME AND CIRCUIT NUMBER ON THE FACE OF EACH COVER PLATE WITH A TYPE I LABEL MOUNTED.

5. PROVIDE THE VIDEO PROJECTOR SHALL COVER PLATE FOR ANY GFCI PROTECTED DEVICE.

6. PROVIDE THE VIDEO PROJECTOR SHALL COVER CONDUCTOR SIZE TO COMPENSATE FOR VOLTAGE DROP DUE TO EXCESSIVE CIRCUIT LENGTHS. IN NO CASE SHALL VOLTAGE DROP EXCEED 3% OF THE CIRCUIT VOLTAGE.

7. REFER TO MECHANICAL PLANS FOR LOCATION OF MECHANICAL EQUIPMENT. LOCATE DISCONNECT SWITCHES.


8. REFER TO "CONTROL SCHEMATIC" MECHANICAL DRAWINGS FOR ADDITIONAL CONTROL WIRING AND CONTROL CONNECTIONS.

9. ALL DEVICES, EQUIPMENT, FIXTURES AND THE LIKE, SHALL BE IDENTIFIED AND PROPERLY IDENTIFIED BY THE GROUNDING CONDUCTOR. MAINTAIN MECHANICAL/ELECTRICAL BONDING OF MECHANICAL RACEWAY SYSTEMS.

(ALL NOTES MAY NOT BE INDICATED ON THIS SHEET)

SHOULD DIFFERENT CONDITIONS BE ENCOUNTERED, CONTACT THE ARCHITECT BEFORE PROCEEDING WITH WORK.


C:\Users\jackson\Documents\2023_ELEC_222130.00_1stfloorEVS27.rvt
2/1/2024 4:17:19 PM

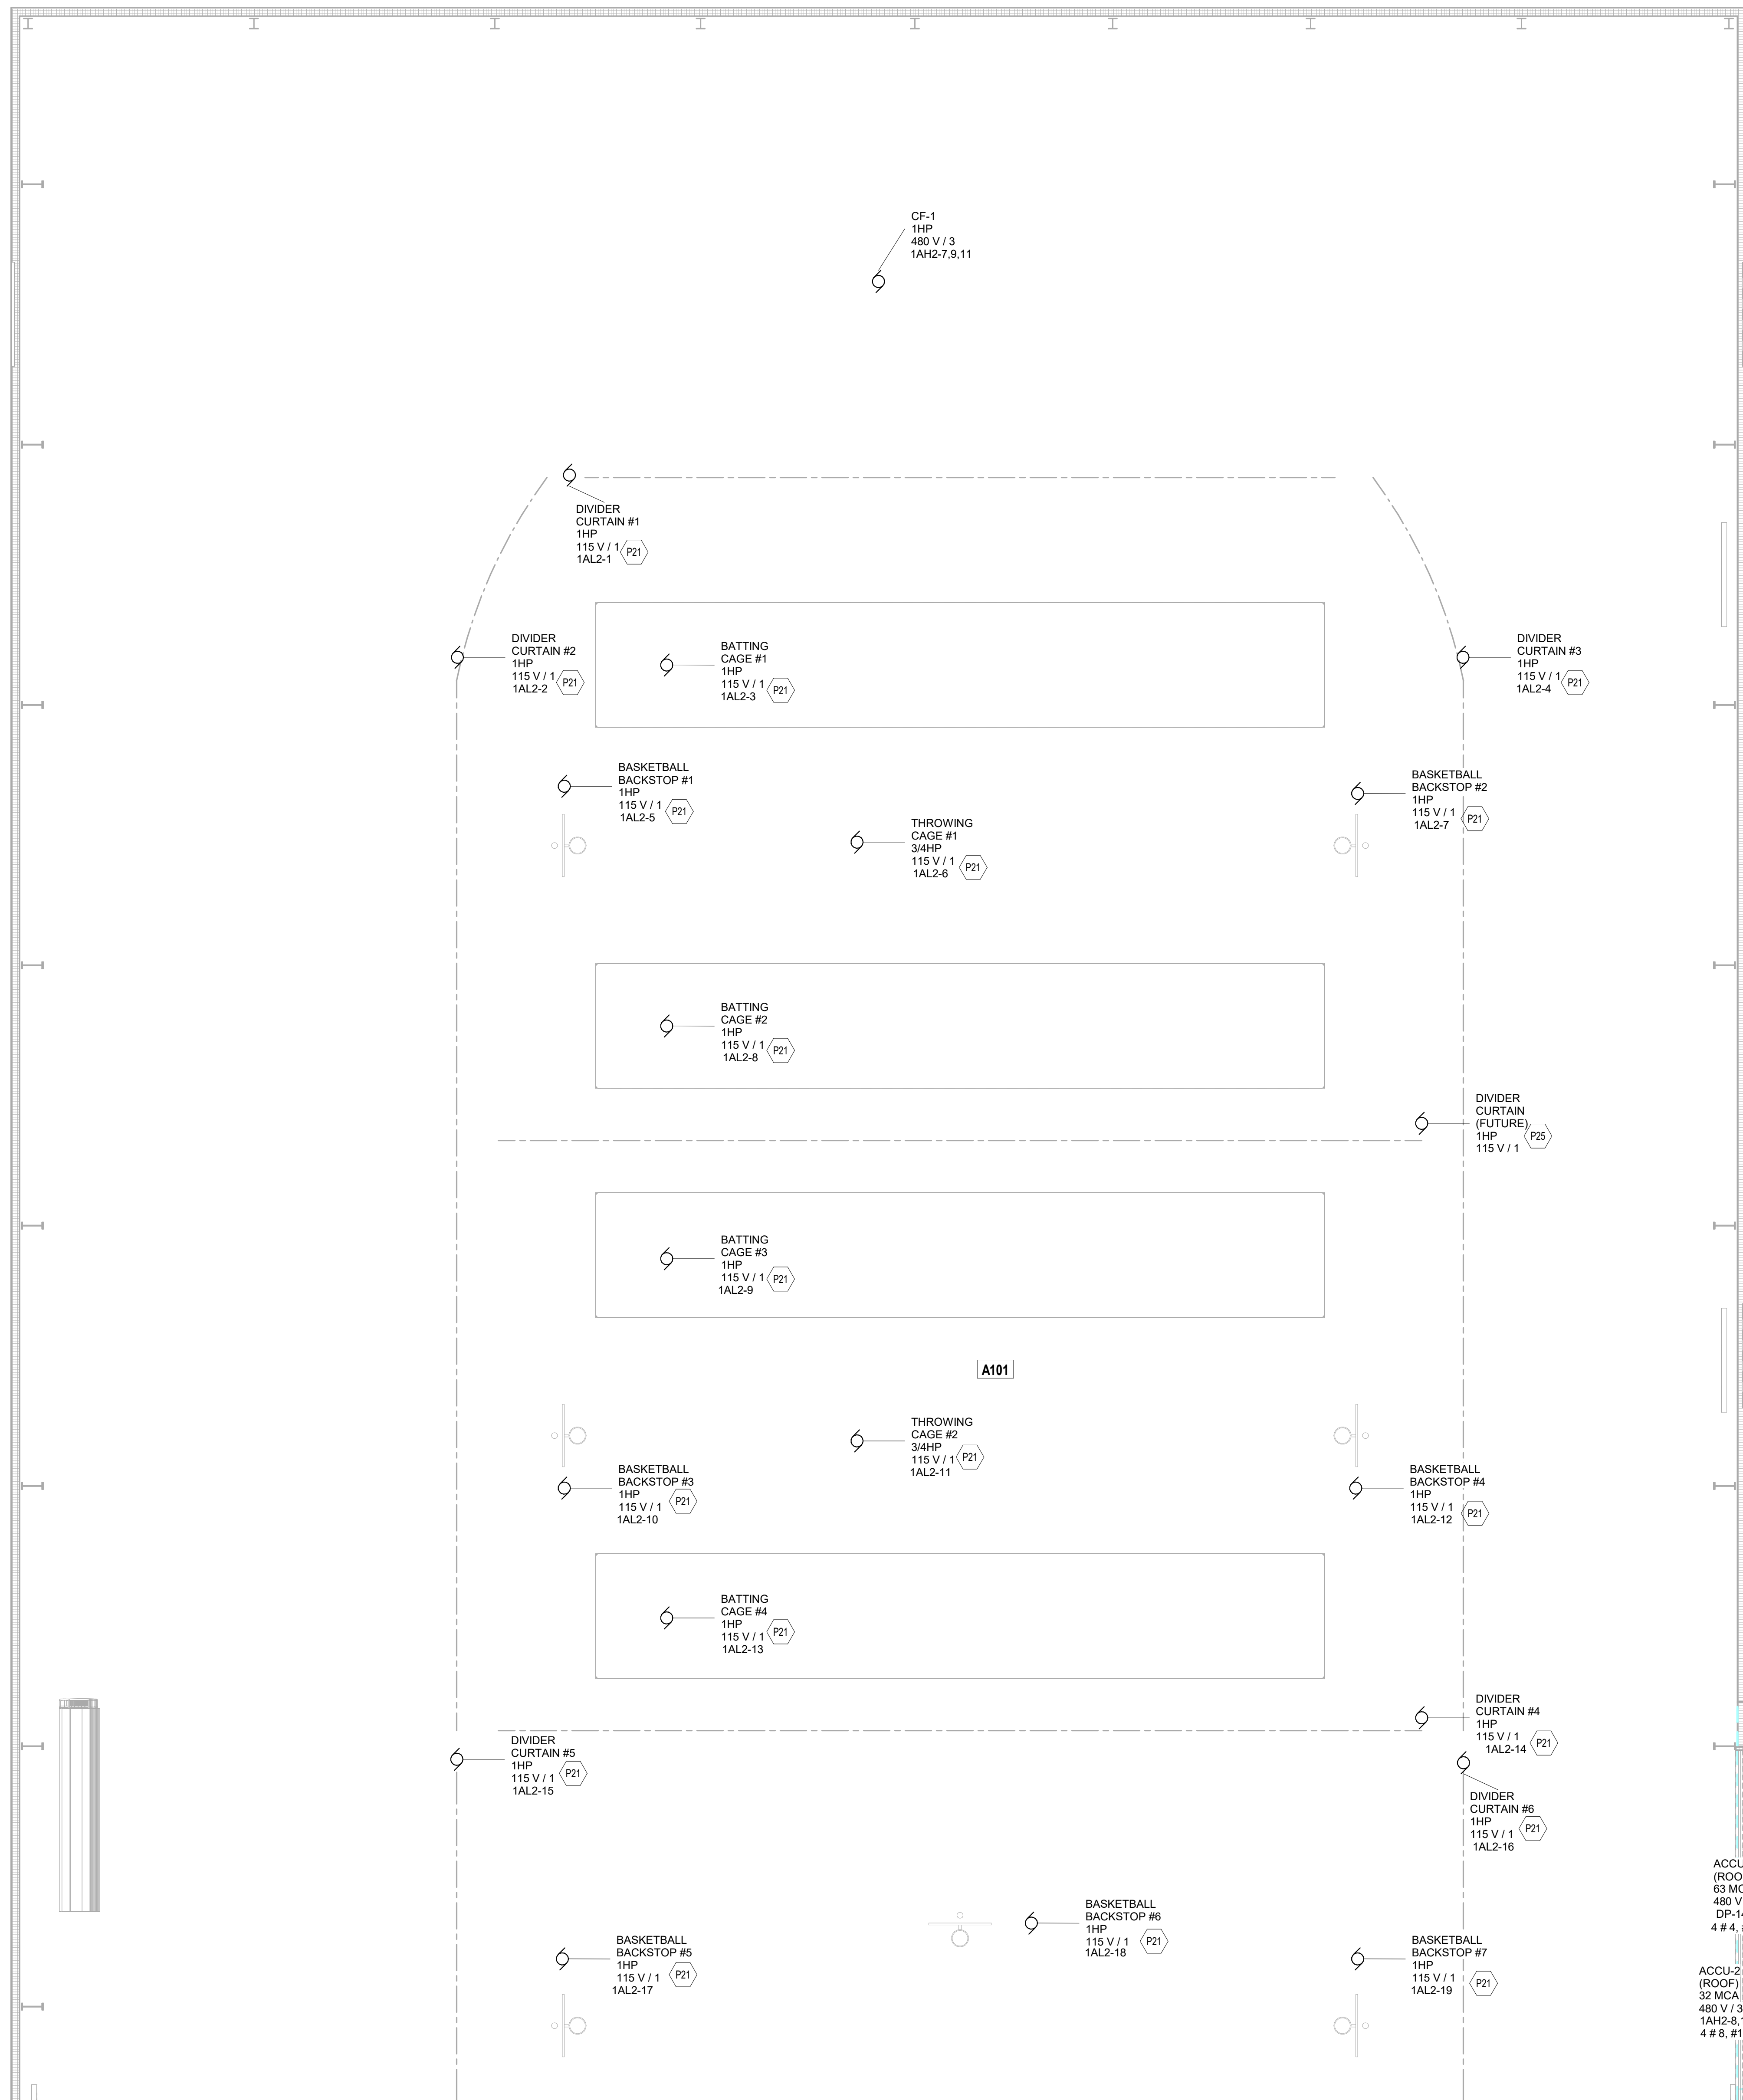

SECOND FLOOR POWER PLAN - UNIT A

SCALE: 1/8" = 1'-0"

ROOM LEGEND		
ROOM NO.	ROOM NAME	AREA (SF)
A101	FIELDHOUSE	5429 SF
A102	CORRIDOR	328 SF
A201	CORRIDOR	341 SF
A202	MECHANICAL	873 SF
B201	CORRIDOR	1444 SF
B202	LOCKER ROOM #3	399 SF
S-1	STAIR	81 SF

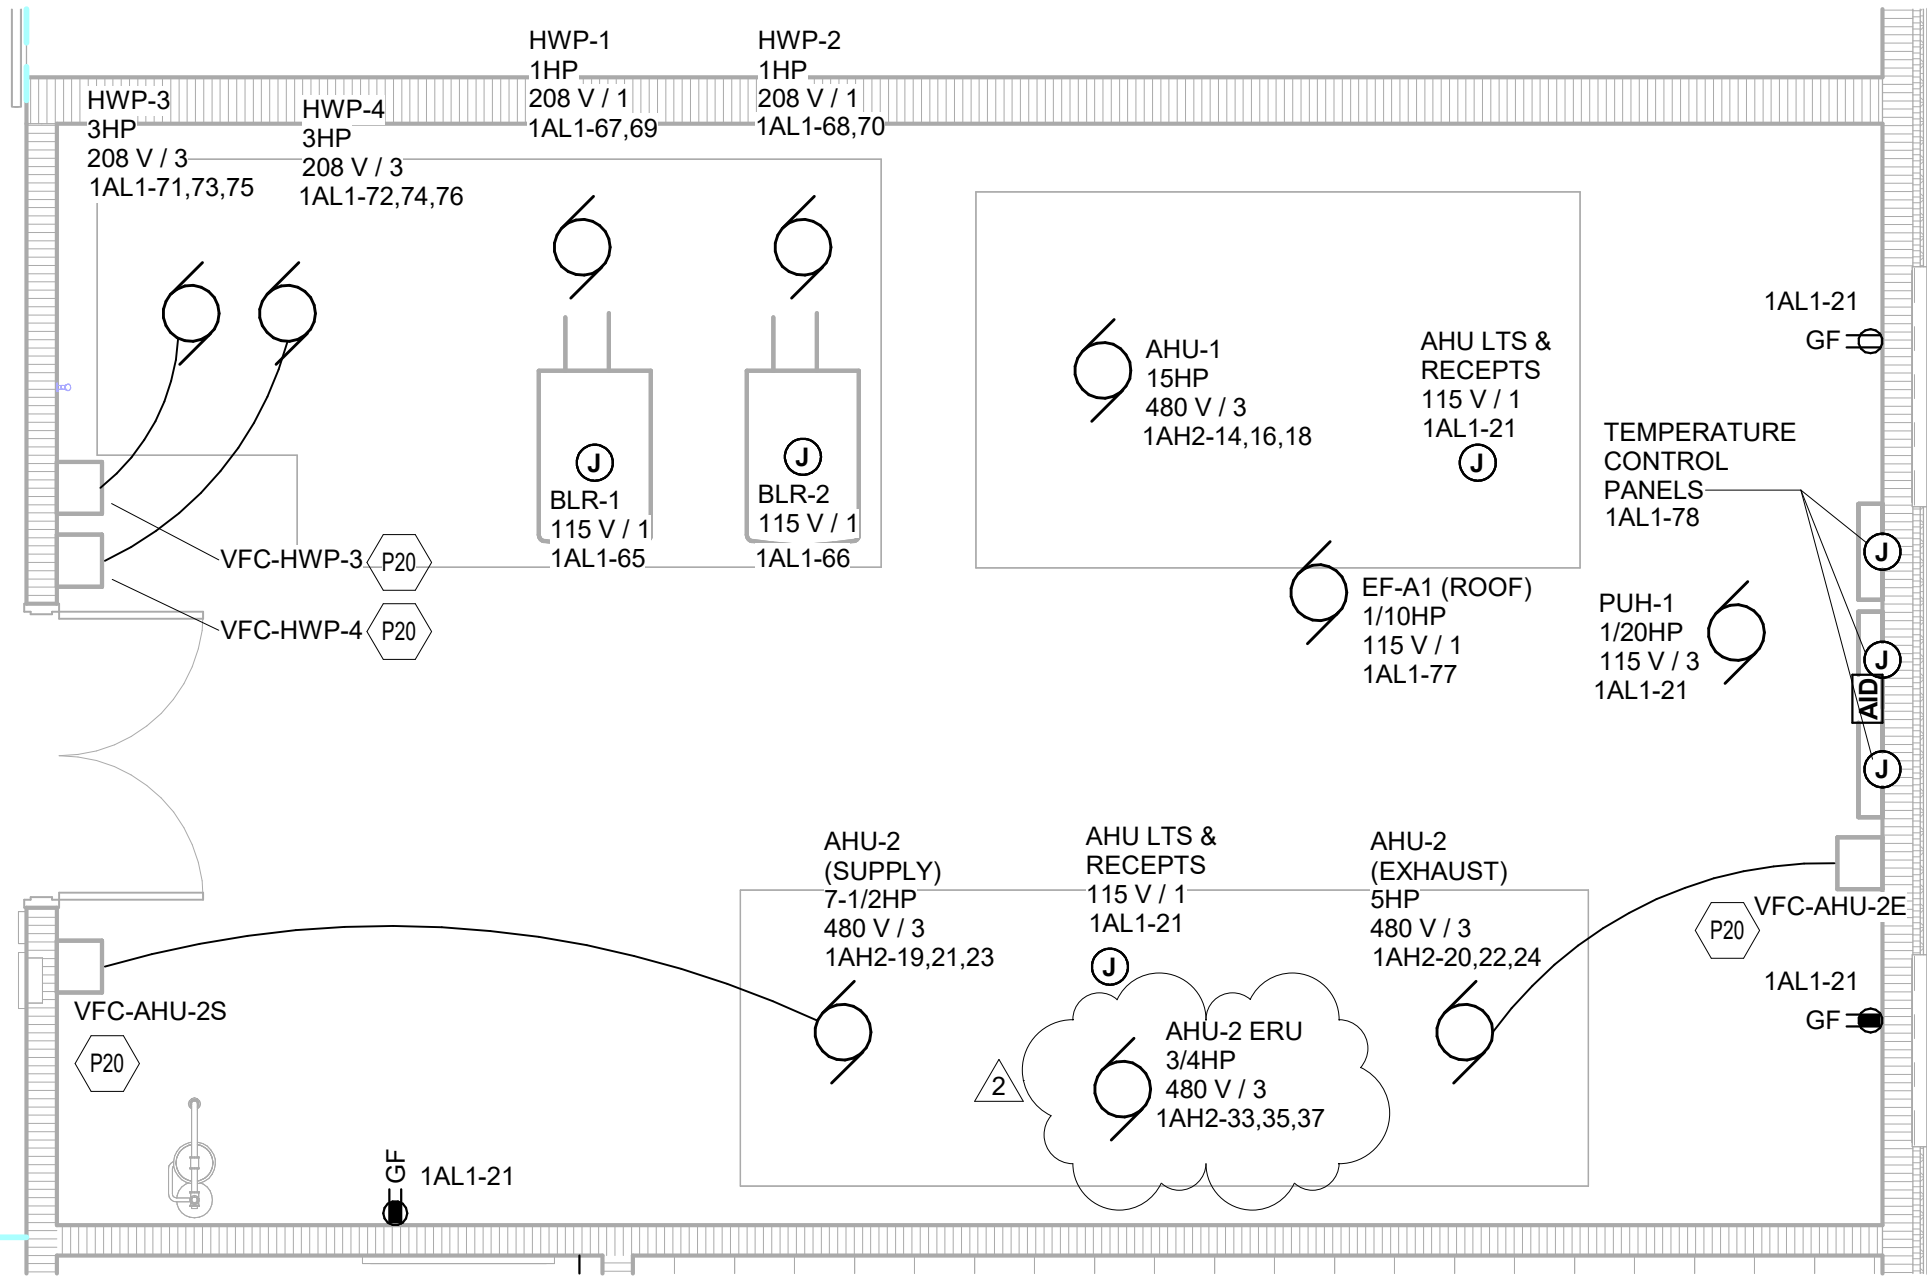

MECHANICAL ROOM POWER PLAN

SCALE: 1/4" = 1'-0"

POWER PLAN GENERAL NOTES

- PROVIDE REVISED TYPED PANELBOARD DIRECTORIES FOR EACH PANELBOARD ADDED OR MODIFIED DURING CONSTRUCTION. FIELD VERIFY EXISTING CIRCUIT INFORMATION WITH OWNER'S ASSISTANCE TO ENSURE FINAL DIRECTORY IS ACCURATE. UNUSED SPARE BREAKERS SHALL BE IN THE OFF POSITION.
- VIDEO PROJECTOR RECEPTACLE TO BE MOUNTED ABOVE WALL MOUNTED PROJECTOR BRACKET, 36" A.F.F. UNO. CONTRACTOR SHALL VERIFY ALL DIMENSIONS AND CLEARANCES AND ALL EXISTING FIELD CONDITIONS BEFORE STARTING CONSTRUCTION. COMMENCEMENT OF WORK CONSTITUTES ACCEPTANCE OF CONDITIONS. SHOULD DIFFERENT CONDITIONS BE ENCOUNTERED, CONTACT THE ARCHITECT BEFORE PROCEEDING WITH WORK.
- LABEL EACH RECEPTACLE WITH THE PANEL NAME AND CIRCUIT NUMBER ON THE FACE OF EACH COVER PLATE WITH A TYPED LAMINATED LABEL.
- PROVIDE "GFCI PROTECTED" LABEL ON COVER PLATE FOR ANY GFCI PROTECTED DEVICE.
- CONTRACTOR SHALL INCREASE CIRCUIT CONDUCTOR SIZE TO COMPENSATE FOR VOLTAGE DROP DUE TO EXCESSIVE CIRCUIT LENGTHS. IN NO CASE SHALL VOLTAGE DROP EXCEED NFPA 70 (NEC) REQUIREMENTS.
- REFER TO MECHANICAL PLANS FOR LOCATION OF MECHANICAL EQUIPMENT. LOCATE DISCONNECT SWITCHES PER NEC.
- REFER TO "CONTROL SCHEMATICS" MECHANICAL DRAWINGS FOR ADDITIONAL CONTROL WIRING AND CONTROL CONNECTIONS.
- ALL DEVICES, EQUIPMENT, FIXTURES, AND THE LIKE, SHALL BE BONDED WITH A PROPERLY SIZED EQUIPMENT GROUNDING CONDUCTOR. MAINTAIN MECHANICAL/ELECTRICAL BONDS OF METALLIC RACEWAY SYSTEM.

POWER PLAN NOTES

(ALL NOTES MAY NOT BE INDICATED ON THIS SHEET)

- P20 CONNECT MECHANICAL UNIT TO VFC AT THIS LOCATION. VFC TO BE PROVIDED BY DIVISION 23 CONTRACTOR.
- P21 CONNECT OVM EQUIPMENT CONTROLS MOTOR TO INDICATED CIRCUIT IN PANEL 1AL2. WIRE MOTOR THROUGH RELAY BOX LOCATED IN ELECTRICAL ROOM A105. PROVIDE WITH 2 # 10, # 10 IN 3/4" C. PROVIDE ADDITIONAL CONTROL SIGNALS FOR UP AND DOWN ADJUSTMENT PER MANUFACTURER REQUIREMENTS. MINIMUM # 10 CONDUCTORS. VERIFY INSTALLATION REQUIREMENTS WITH OVM EQUIPMENT CONTROLS MANUFACTURER.
- P25 PROVIDE 3/4" EMPTY CONDUIT FROM TSC1800XL RELAY NODE TO THIS LOCATION FOR FUTURE DIVIDER CURTAIN.
- P27 PROVIDE RECEPTACLE FOR AIR PURIFIER UNIT AT THIS LOCATION. COORDINATE EXACT LOCATION OF RECEPTACLE WITH ARCHITECTURAL FLOORPLANS AND DETAILS.

COPYRIGHT 2024 BY FANNINGHOWEY ASSOCIATES, INC.

PENN HIGH SCHOOL FIELDHOUSE

12641 McKinley Highway
Mishawaka, IN 46545


PENN-HARRIS-MADISON SCHOOL CORPORATION



ARCHITECT


FANNING HOWEY

317.848.0966 WWW.FHAI.COM
350 E NEW YORK ST #500, INDIANAPOLIS, IN 46204

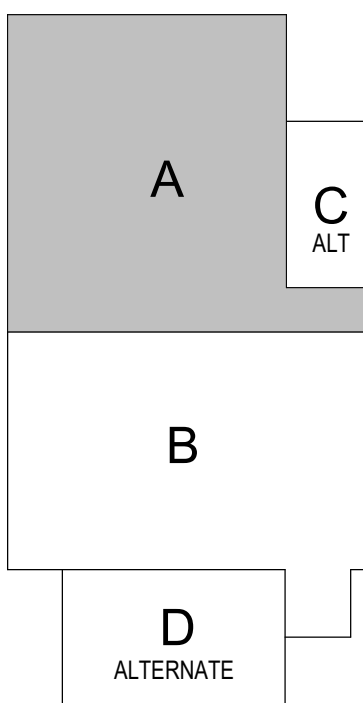

KEY PLAN

100% Construction Documents

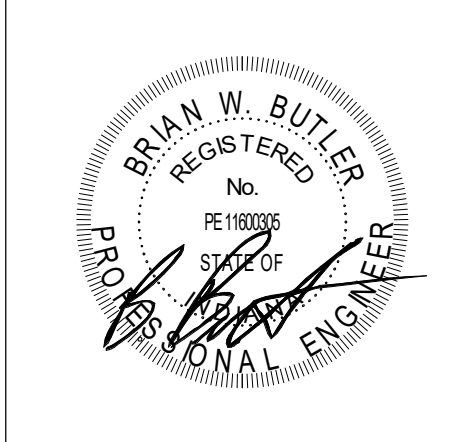

DRAWN BY: ISO

PROJECT NUMBER: 222130.00
PROJECT ISSUE DATE: 01.10.2024

REV. NO.	DESCRIPTION	DATE
2	Addendum #2	02.01.2024

VERIFICATION NOTE

CONTRACTOR SHALL VERIFY ALL DIMENSIONS AND CLEARANCES AND ALL EXISTING FIELD CONDITIONS BEFORE STARTING CONSTRUCTION. COMMENCEMENT OF WORK CONSTITUTES ACCEPTANCE OF CONDITIONS.

SHOULD DIFFERENT CONDITIONS BE ENCOUNTERED, CONTACT THE ARCHITECT BEFORE PROCEEDING WITH WORK.

SECOND FLOOR POWER PLAN - UNIT A


EP12A

**PENN-HARRIS-MADISON
SCHOOL CORPORATION**




**FANNING
HOWEY**

A diagram showing a 2x2 grid of cells. The top-left cell is labeled 'A' and is white. The top-right cell is labeled 'C' and is white, with the text 'ALT' below it. The bottom-left cell is labeled 'B' and is gray. The bottom-right cell is labeled 'D' and is white, with the text 'ALTERNATE' below it.

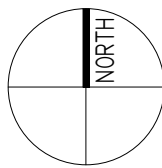

CONSTRUCTION DOCUMENTS

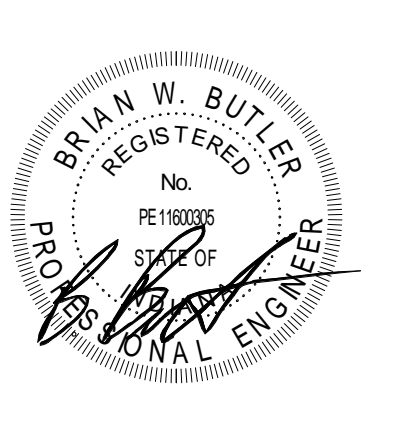[illegible]

ET12B

ROOM LEGEND			
ROOM NO.	OWNER ROOM NO.	ROOM NAME	AREA (SF)
A101	102	FIELDHOUSE	54239 SF
A201	-	CORRIDOR	341 SF
A202	212	MECHANICAL	873 SF
B201	-	CORRIDOR	1444 SF
B202	211	LOCKER ROOM #3	389 SF
B203	-	SHOWER	184 SF
B204	210	DRESSING ROOM #3	261 SF
B205	210A	TOILET	74 SF
B206	209A	TOILET	75 SF
B207	209	DRESSING ROOM #4	270 SF
B208	-	SHOWER	184 SF

ROOM LEGEND			
ROOM NO.	OWNER ROOM NO.	ROOM NAME	AREA (SF)
B209	208	LOCKER ROOM #4	402 SF
B210	207	CLASSROOM	842 SF
B211	206	CUSTODIAN	67 SF
B212	205	TOILET	63 SF
B213	204	TOILET	63 SF
B214	203	ELECTRICAL / TECHNOLOGY	58 SF
B215	202	ELEVATOR EQUIPMENT	55 SF
B216	201	CLASSROOM	844 SF
B217	-	COMMONS	984 SF
S-2	STAIR 1	STAIR	175 SF


- A. DEVICES SHALL BE INSTALLED AT LOCATIONS SHOWN ON DRAWINGS. LOCATIONS OF DEVICES SHALL BE COORDINATED WITH OTHER ELECTRICAL DEVICES/ CASEWORK/ ARCHITECTURAL FEATURES AND OTHER TRADES PRIOR TO ROUGH-IN. IF RELOCATION OF DEVICES IS REQUIRED DUE TO LACK OF COORDINATION BETWEEN ELECTRICAL DRAWINGS AND OTHER TRADES, ANY ASSOCIATED COSTS SHALL BE RESPONSIBILITY OF ELECTRICAL CONTRACTOR.
- B. DIVISION 26 CONTRACTOR IS RESPONSIBLE TO PROVIDE THE FOLLOWING ALL INFORMATION WITH PROPER BIDDINGS AS SHOWN ON THE E3 DRAWINGS AND ON E201 DETAILS.
- C. COORDINATE THE INSTALLATION OF ALL SPEAKER LOCATION ROUGH IN PLACEMENTS AND BACKSCENE CONDUIT INSTALLATION WITH THE DIVISION 27 CONTRACTOR PRIOR TO ROUGH-IN.
- D. COORDINATE ALL CLOSET OR CABINET POWER NEEDS AND PLACEMENTS WITH THE DIVISION 27 CONTRACTOR PRIOR TO INSTALLATION.

(ALL NOTES MAY NOT BE INDICATED ON THIS SHEET)

#	NOTE
R1	PROVIDE 2" CONDUIT PATHWAY FROM 2ND FLOOR ER TO WALL MOUNTED TR. CONDUIT TO BE SAME COLOR AS CEILING.
R2	SEE DETAIL 5/ E3.02 FOR FLOORHOUSE/ BASKETBALL COURTS SOUND SYSTEM AND RISER DIAGRAM.
R10	PROVIDE 3/4" CONDUIT TO ACCESSIBLE LAY-IN CEILING F. ELEVATOR EQUIPMENT. VERIFY EXACT LOCATIONS WITH ELEVATOR CONTRACTOR.
R11	COORDINATE POWER NEEDS WITH TECHNOLOGY AND SOUND SYSTEM COORDINATOR.
R12	PROVIDE 2 - 4" DATA STUBS FROM 2ND FLOOR TO FIRST
R13	COORDINATE SCOREBOARD ROUGH IN LOCATION WITH GENERAL CONTRACTOR
R14	TECH BOX FOR ELEVATOR ACCESS CONTROL. COORDINATE WITH TECH AND ELEVATOR CONTRACTORS



CONTRACTOR SHALL VERIFY ALL DIMENSIONS AND CLEARANCES AND ALL EXISTING FIELD CONDITIONS BEFORE STARTING CONSTRUCTION. COMMENCEMENT OF WORK CONSTITUTES ACCEPTANCE OF CONDITIONS.

SHOULD DIFFERENT CONDITIONS BE ENCOUNTERED, CONTACT THE ARCHITECT BEFORE PROCEEDING WITH WORK.

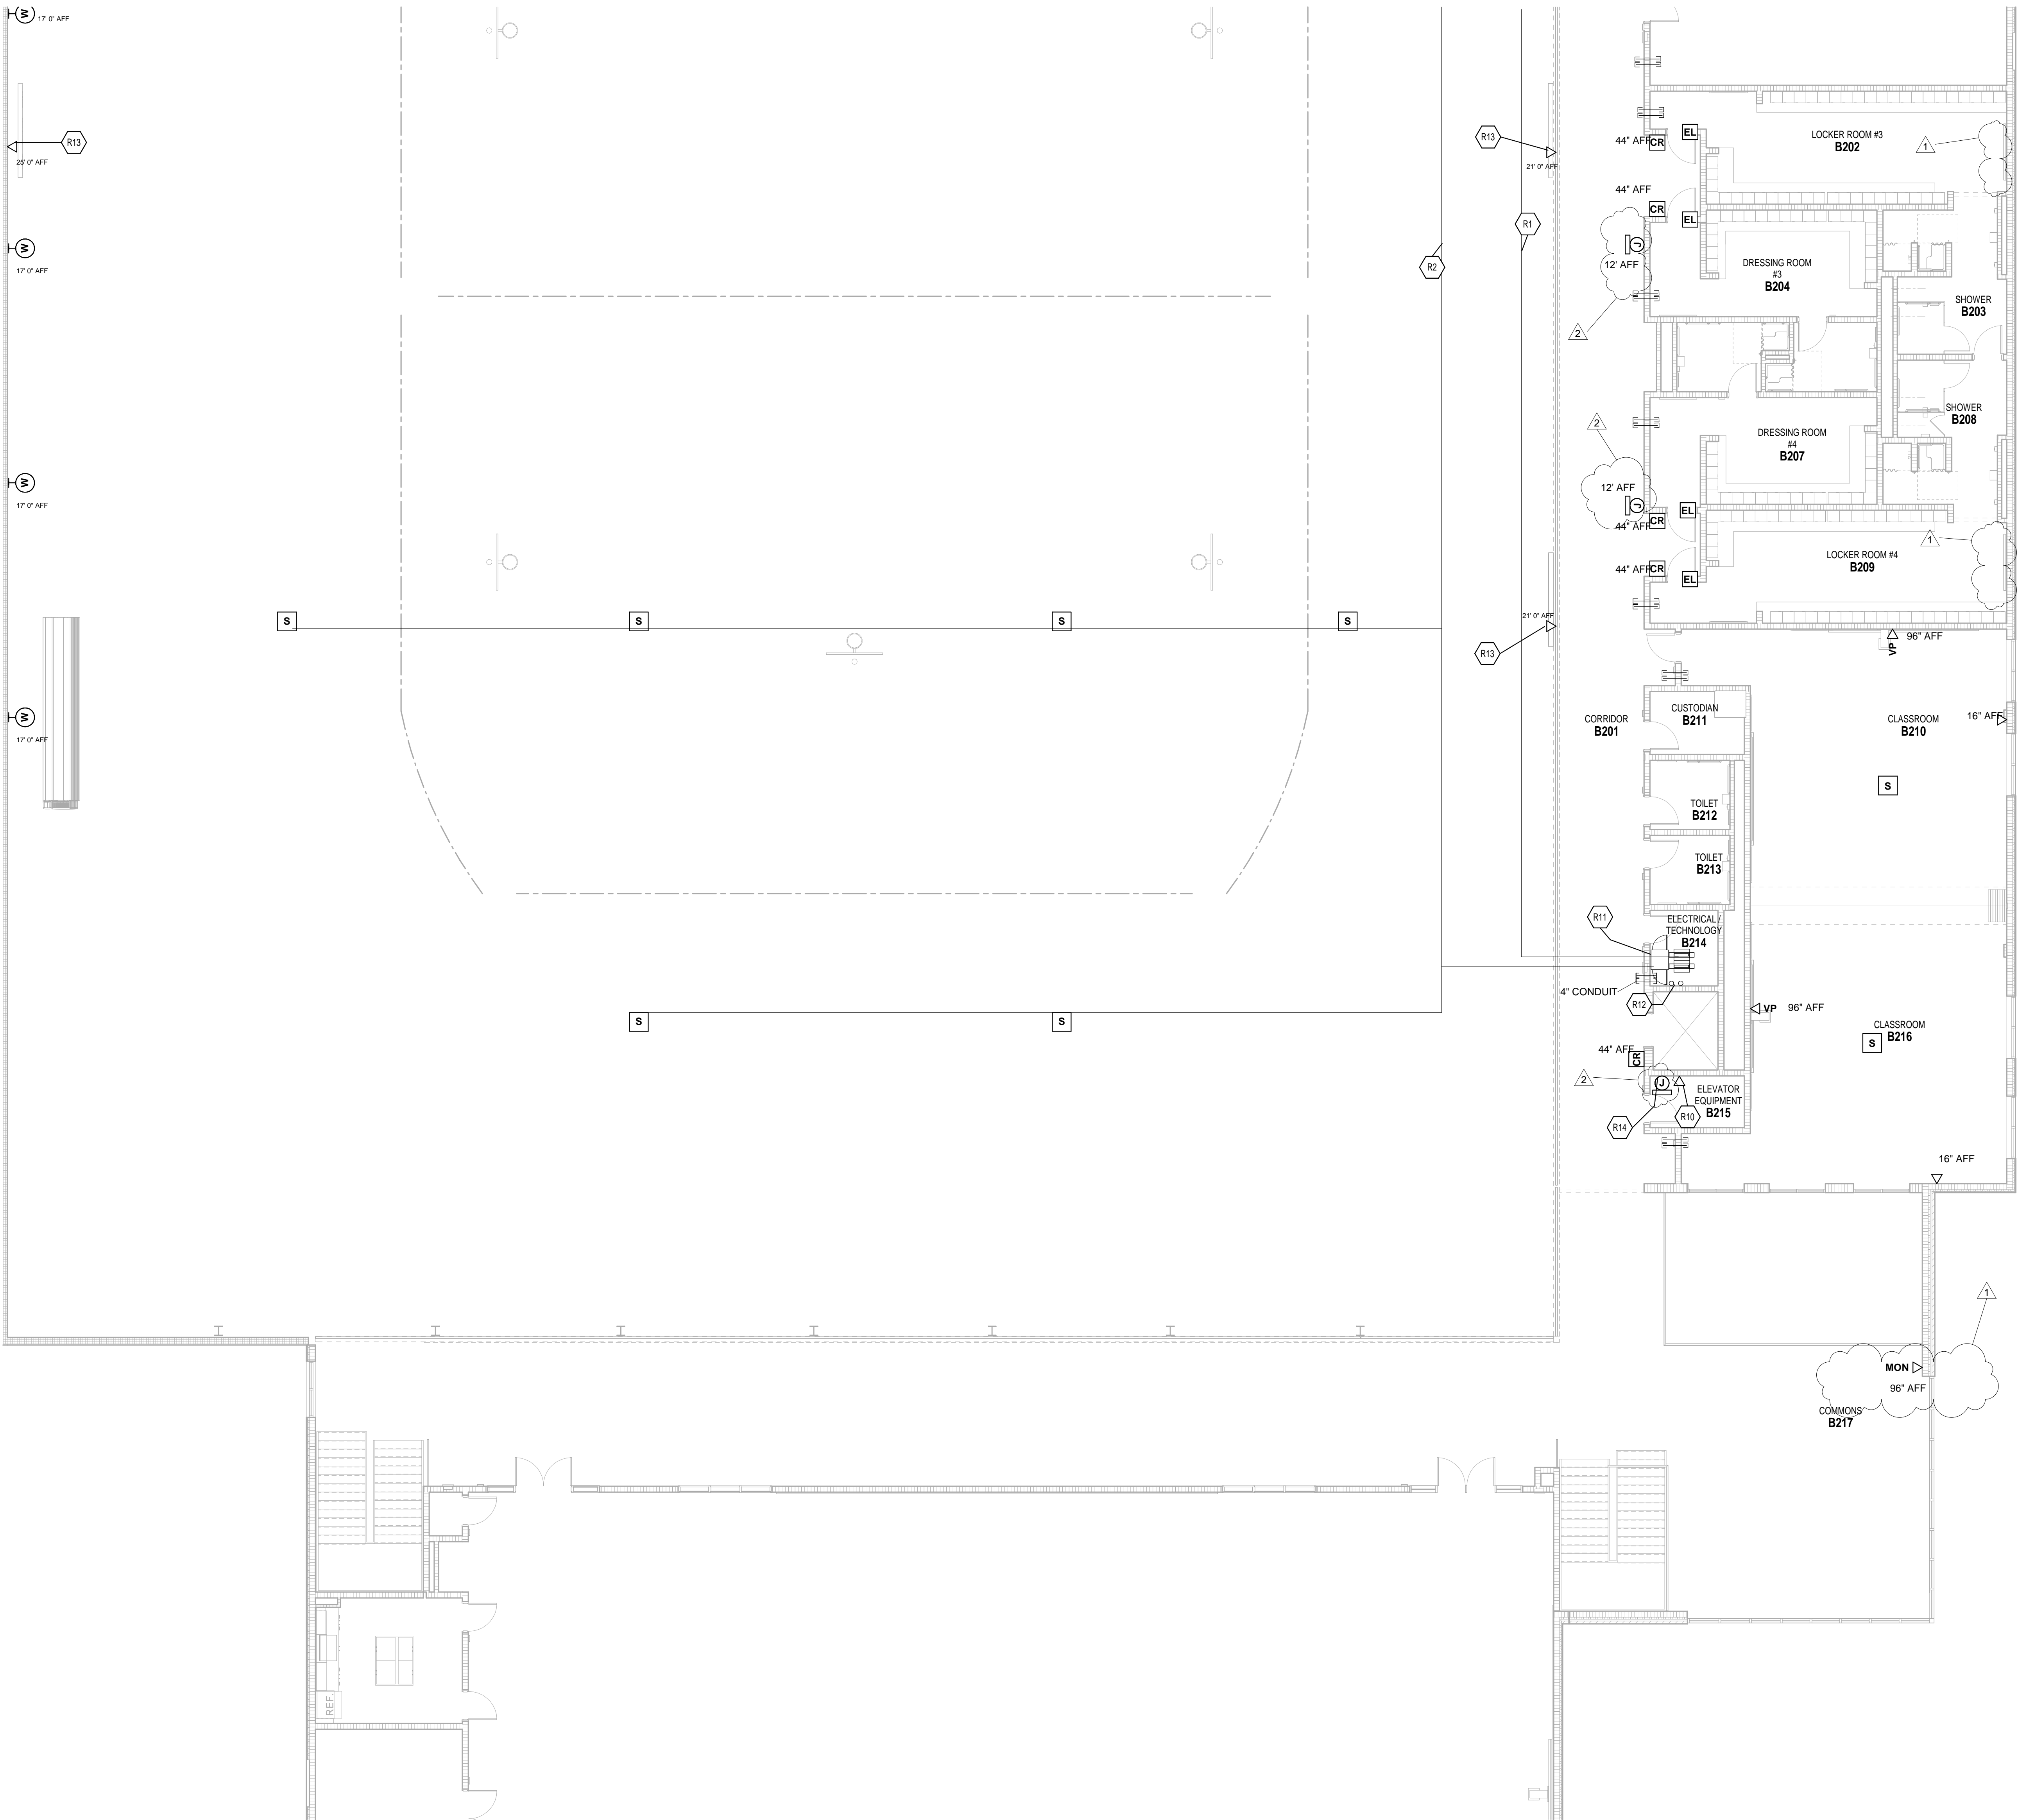

C:\Users\jackson\Documents\2023_ELEC_222130.00_1\sketchESV27.dwg
2/1/2024 1:17:28 PM

COPPER FEEDER SCHEDULE						
SOURCE 2014 NEC TABLE 15(B)(16), COPPER 75C, (THW, THWN, XHHW)						
FEEDER	QTY	PHASE	NEUTRAL	GROUND	SIZE	CONDUIT
LEGEND	SETS	QTY	(1)	(1)	Inches	
15	1	3 # 14		#14	3/4	
15N	1	3 # 14	#14	#14	3/4	
20	1	3 # 12	#12	#12	3/4	
20N	1	3 # 12	#12	#12	3/4	
30	1	3 # 10	#10	#10	3/4	
30N	1	3 # 10	#10	#10	3/4	
40	1	3 # 8	#8	#10	3/4	
40N	1	3 # 8	#8	#10	3/4	
60	1	3 # 6	#6	#10	1	
60N	1	3 # 6	#6	#10	1	
80	1	3 # 4	#4	#8	1 1/4	
80N	1	3 # 4	#4	#8	1 1/4	
100	1	3 # 3	#3	#8	1 1/2	
100N	1	3 # 3	#3	#8	1 1/2	
125	1	3 # 1	#1	#6	2	
125N	1	3 # 1	#1	#6	2	
150	1	3 # 1/0	#1/0	#6	2	
150N	1	3 # 1/0	#1/0	#6	2	
175	1	3 # 2/0	#2/0	#6	2	
175N	1	3 # 2/0	#2/0	#6	2	
200	1	3 # 3/0	#3/0	#6	2	
200N	1	3 # 3/0	#3/0	#6	2	
225	1	3 # 4/0	#4/0	#4	2 1/2	
225N	1	3 # 4/0	#4/0	#4	2 1/2	
250	1	3 # 250	#250	#4	2 1/2	
250N	1	3 # 250	#250	#4	2 1/2	
300	1	3 # 350	#350	#3	3	
300N	1	3 # 350	#350	#3	3	
350	1	3 # 500	#500	#3	4	
350N	1	3 # 500	#500	#3	4	
400	1	3 # 600	#600	#3	4	
400N	1	3 # 600	#600	#3	4	
500	2	3 # 250	#250	#2	2 1/2	
500N	2	3 # 250	#250	#2	2 1/2	
600	2	3 # 350	#350	#1	3	
600N	2	3 # 350	#350	#1	3	
800	2	3 # 600	#600	#1/0	4	
800N	2	3 # 600	#600	#1/0	4	
1000	3	3 # 400	#400	#2/0	3	
1000N	3	3 # 400	#400	#2/0	3	
1200	3	3 # 600	#600	#3/0	4	
1200N	3	3 # 600	#600	#3/0	4	
1600	4	3 # 600	#600	#4/0	4	
1600N	4	3 # 600	#600	#4/0	4	
2000	5	3 # 600	#600	#250	4	
2000N	5	3 # 600	#600	#250	4	
2500	6	3 # 600	#600	#350	4	
2500N	6	3 # 600	#600	#350	4	
3000	7	3 # 600	#600	#400	4	
3000N	7	3 # 600	#600	#400	4	
3300	8	3 # 600	#600	#400	4	
3300N	8	3 # 600	#600	#400	4	
3700	9	3 # 600	#600	#400	4	
3700N	9	3 # 600	#600	#400	4	

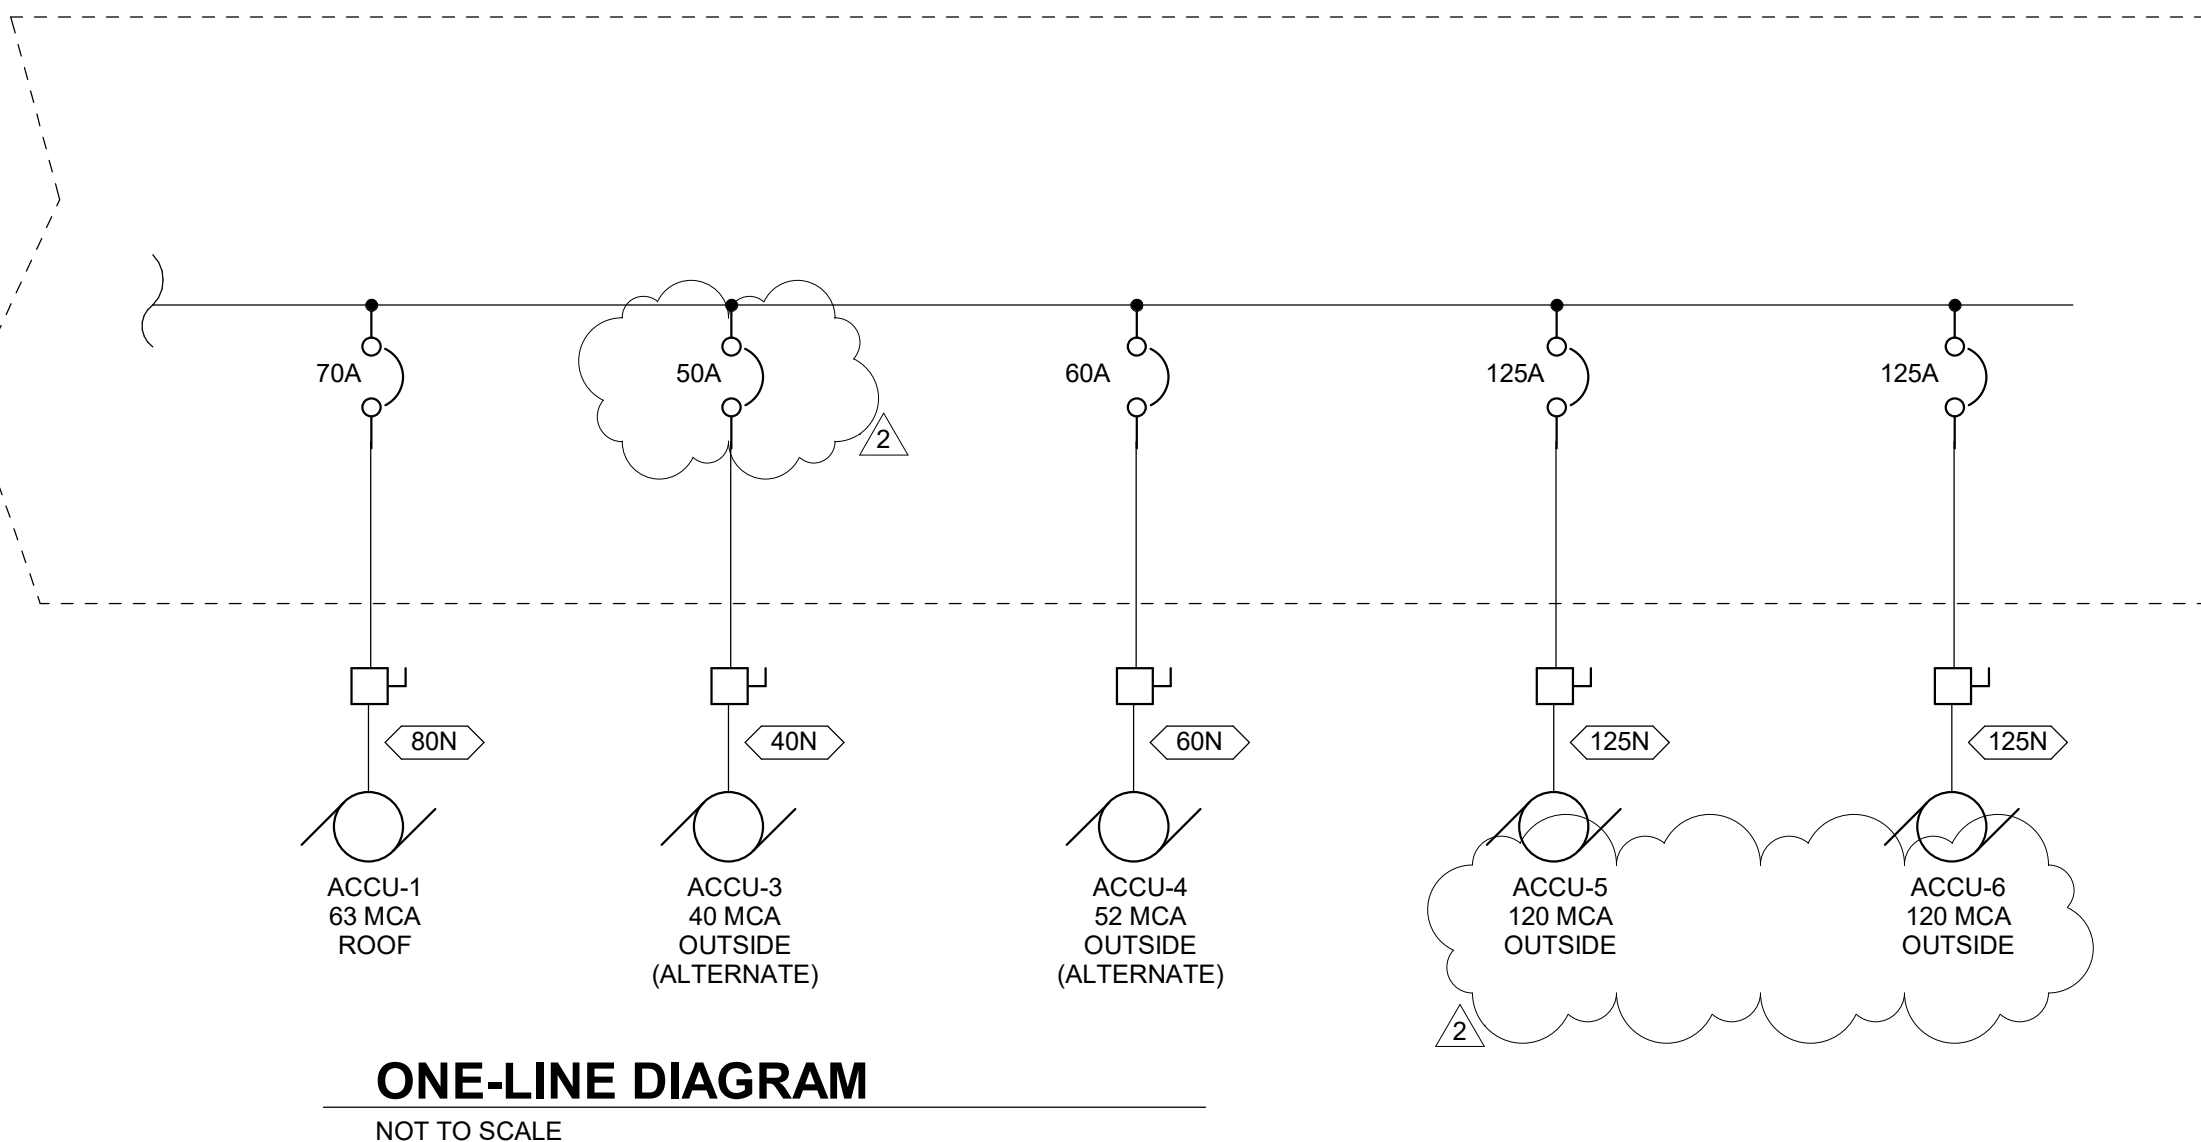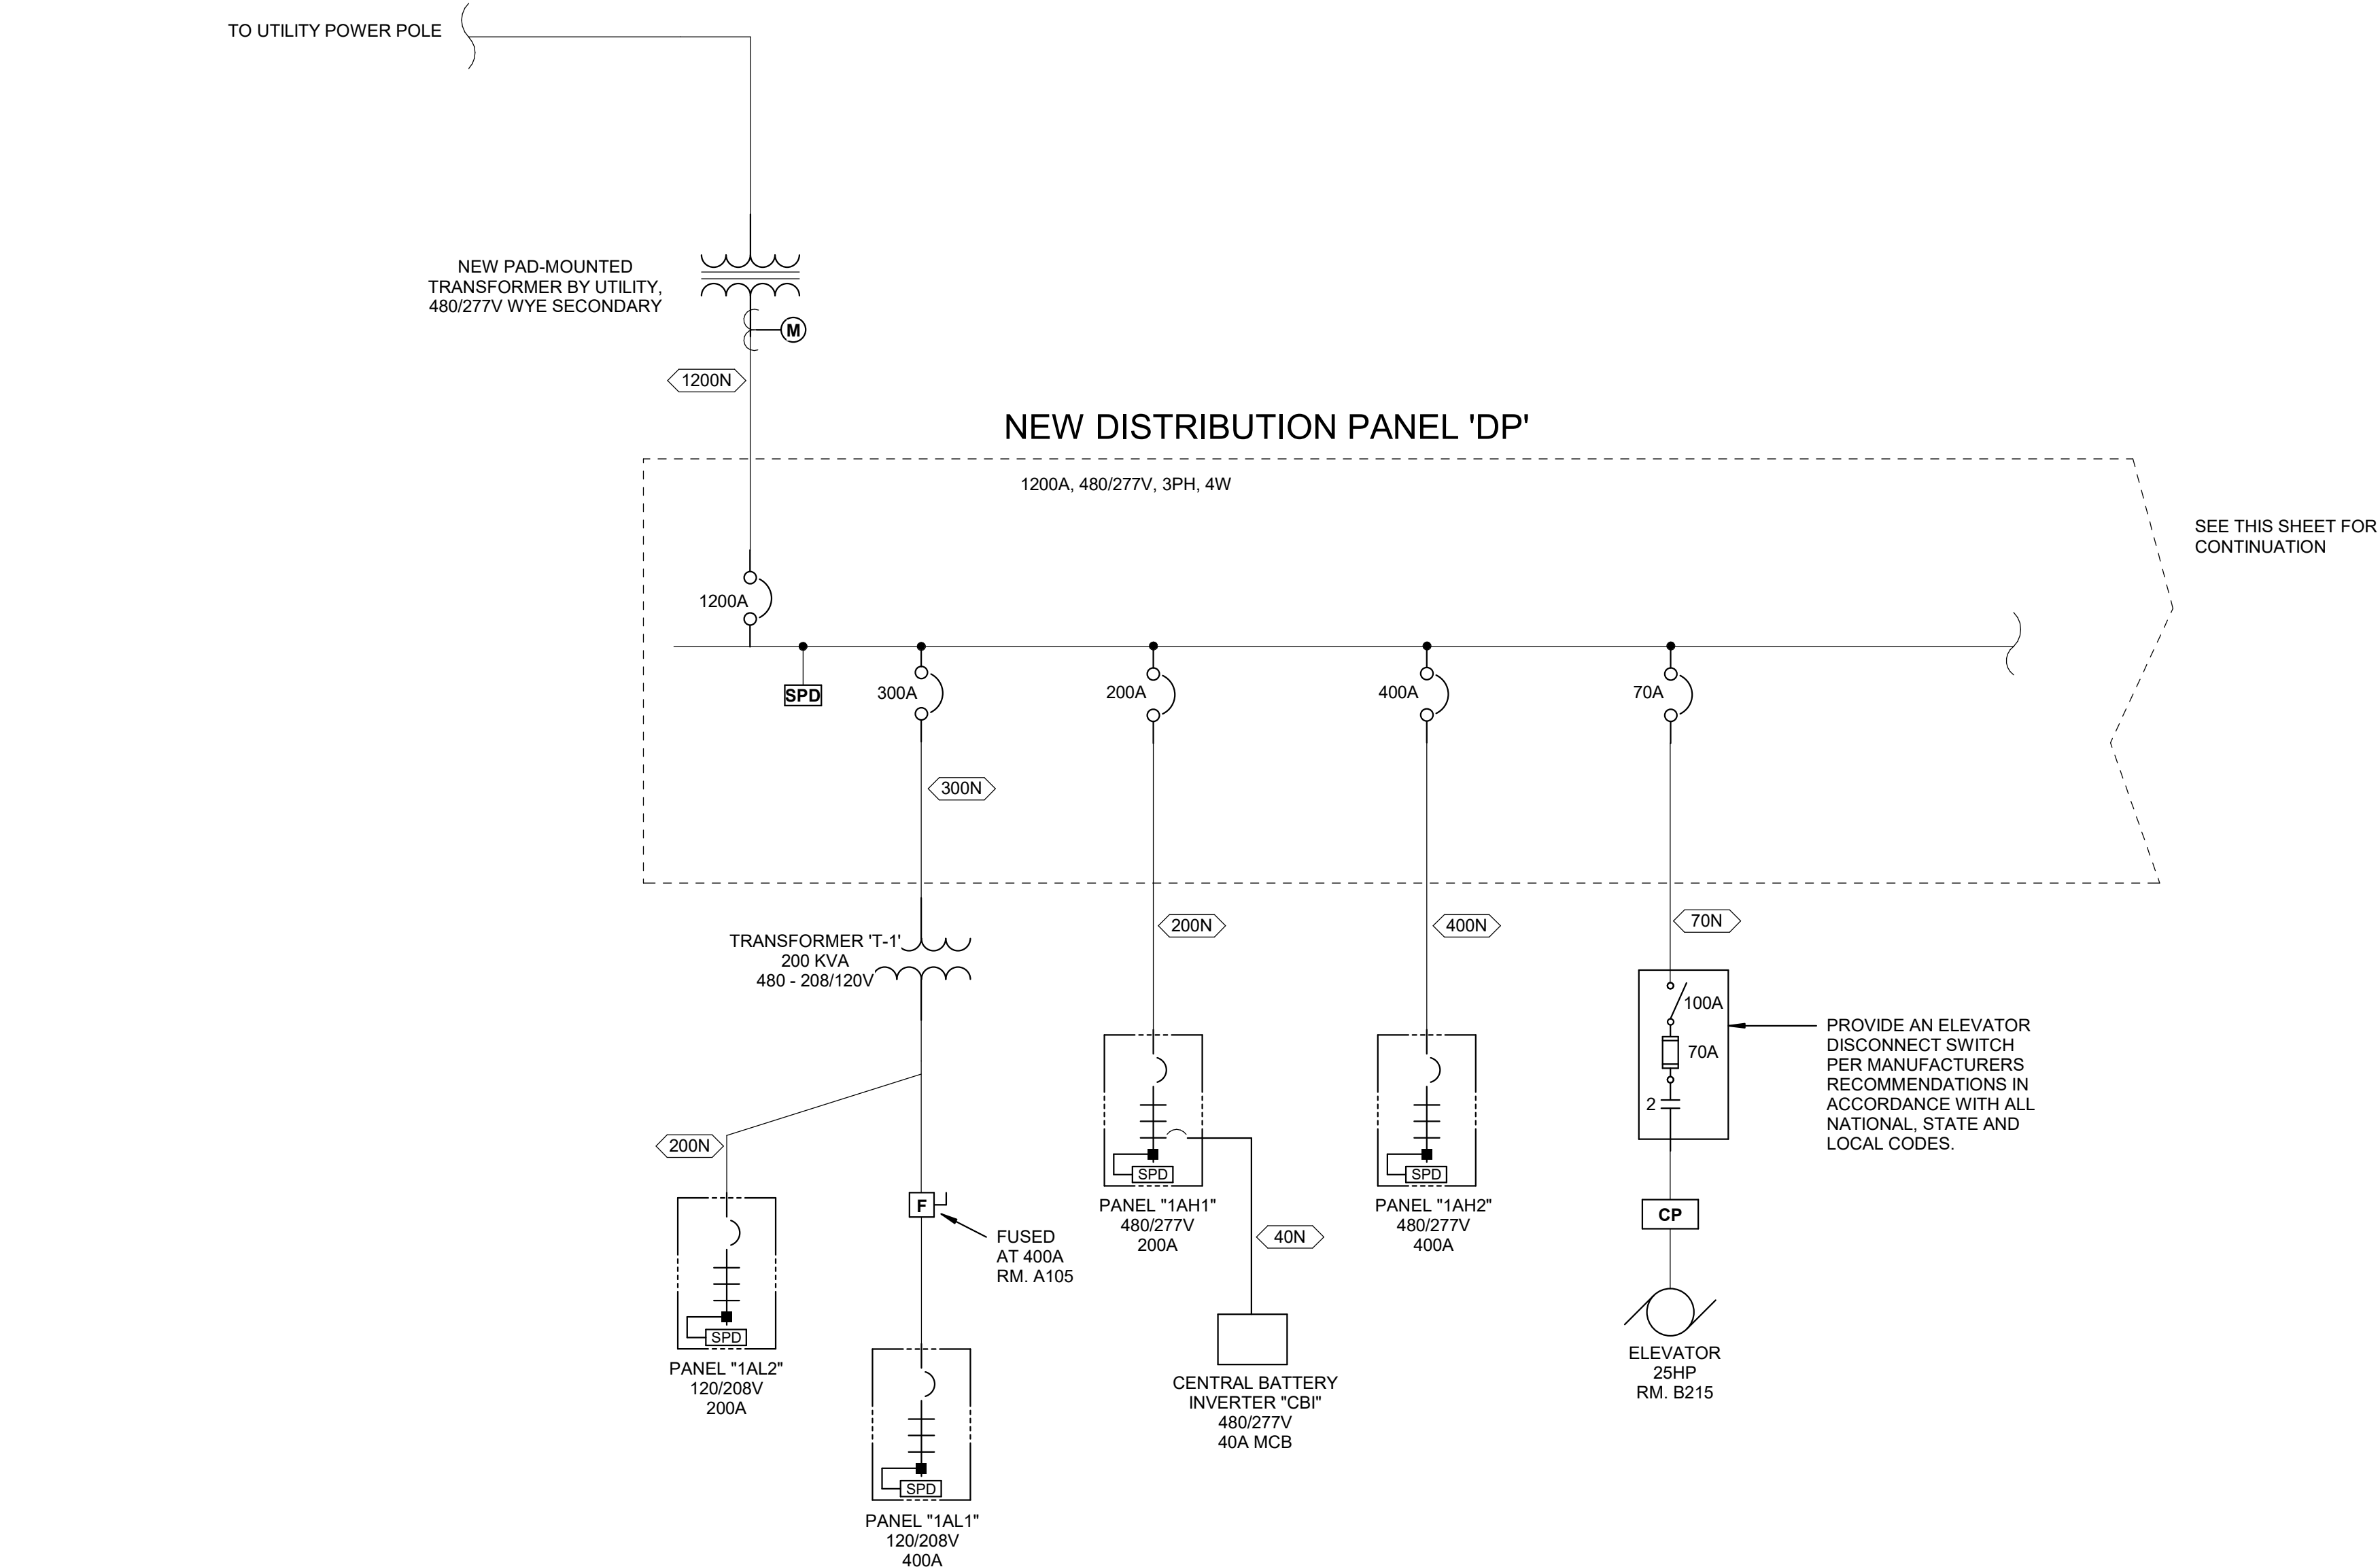

ONE LINE DIAGRAM SYMBOLS									
	MAIN LUG ONLY CIRCUIT BREAKER PANELBOARD, REFER TO E8 SERIES DRAWINGS FOR PANELBOARD SCHEDULES		DIGITAL ELECTRONIC POWER METER		COMBINATION MAGNETIC MOTOR STARTER WITH FUSED SWITCH		FUSED SWITCH IN SWITCHBOARD, 3P UNO		FUSED POTENTIAL TRANSFORMER
			KIRK KEY INTERLOCK				DISCONNECT SWITCH IN SWITCHBOARD, 3P UNO		
			UTILITY METER				FUSED BOLTED PRESSURE SWITCH WITH GROUND FAULT AND SINGLE PHASE PROTECTION, 3P UNO		
	MAIN BREAKER IN CIRCUIT BREAKER PANELBOARD, REFER TO E8 SERIES DRAWINGS FOR PANELBOARD SCHEDULES		MAIN BREAKER IN CIRCUIT BREAKER PANELBOARD WITH SUB-FEED BREAKER, REFER TO E8 SERIES DRAWINGS FOR PANELBOARD SCHEDULES		COMBINATION MAGNETIC MOTOR STARTER WITH MOTOR CIRCUIT PROTECTOR		TRANSFER SWITCH		EARTH GROUND
	THROUGH FEED LUGS CIRCUIT BREAKER PANELBOARD, REFER TO E8 SERIES DRAWINGS FOR PANELBOARD SCHEDULES		MAIN BREAKER IN CIRCUIT BREAKER PANELBOARD WITH INTEGRAL BUS CONNECTED SPD, REFER TO E8 SERIES DRAWINGS FOR PANELBOARD SCHEDULES				DISCONNECT, 3P UNO		
	MAIN DOUBLE LUG CIRCUIT BREAKER PANELBOARD, REFER TO E8 SERIES DRAWINGS FOR PANELBOARD SCHEDULES		MAIN BREAKER IN CIRCUIT BREAKER PANELBOARD WITH SPD MOUNTED ADJACENT WITH CLOSED NIPPLE, REFER TO E8 SERIES DRAWINGS FOR PANELBOARD SCHEDULES				MOLDED CASE CIRCUIT BREAKER, 3P UNO		
			CIRCUIT BREAKER IN SWITCHBOARD, 3P UNO		COMBINATION MAGNETIC MOTOR STARTER WITH VARIABLE SPEED CONTROLLER		INSULATED CASED POWER CIRCUIT BREAKER WITH L I S O PROTECTION FEATURES, 3P UNO		PLUG AND RECEPTACLE OR DRAWOUT DEVICE
							DRAWOUT CIRCUIT BREAKER, 3P UNO		
							SHUNT TRIP OPERATED CIRCUIT BREAKER		
			CONTROL PANEL FURNISHED UNDER DIVISION 25		GENERATOR		3 PHASE MOTOR, X INDICATES HORSEPOWER OR KILOWATTS		CONTROL PANEL FURNISHED UNDER DIVISION 25

LUMINAIRE SCHEDULE									
PLAN TYPE	MANUFACTURER/CATALOG	MOUNTING	NO.	WATTS	LAMPS TYPE	LUMENS	APPLIED VOLTAGE	DESCRIPTION	VA LOAD
A	LITHONIA DSX2 SERIES	30'-0" SQUARE STEEL POLE	1	219 W	LED	29085 lm	277 V	TYPE 2 MEDIUM DISTRIBUTION, 4000K CCT, WITH MULTI-VOLT DRIVER, MOUNT TO NEW 30-FOOT SQUARE STEEL POLE, DARK BRONZE FINISH.	219 VA
B	LITHONIA DSX2 SERIES	30'-0" SQUARE STEEL POLE	1	219 W	LED	29423 lm	277 V	TYPE 3 MEDIUM DISTRIBUTION, 4000K CCT, WITH MULTI-VOLT DRIVER, MOUNT TO NEW 30-FOOT SQUARE STEEL POLE, DARK BRONZE FINISH.	219 VA
C	LITHONIA DSX2 SERIES	30'-0" SQUARE STEEL POLE	1	219 W	LED	29861 lm	277 V	TYPE 4 MEDIUM DISTRIBUTION, 4000K CCT, WITH MULTI-VOLT DRIVER, MOUNT TO NEW 30-FOOT SQUARE STEEL POLE, DARK BRONZE FINISH.	219 VA
D	LITHONIA DSX2 SERIES	30'-0" SQUARE STEEL POLE	1	219 W	LED	21401 lm	277 V	TYPE 3 BACKLIGHT CONTROL DISTRIBUTION, 4000K CCT, WITH MULTI-VOLT DRIVER, MOUNT TO NEW 30-FOOT SQUARE STEEL POLE, DARK BRONZE FINISH.	219 VA
E	LITHONIA DSX2 SERIES	30'-0" SQUARE STEEL POLE	1	219 W	LED	22104 lm	277 V	TYPE 4 BACKLIGHT CONTROL DISTRIBUTION, 4000K CCT, WITH MULTI-VOLT DRIVER, MOUNT TO NEW 30-FOOT SQUARE STEEL POLE, DARK BRONZE FINISH.	219 VA
F	LITHONIA DSX2 SERIES	30'-0" SQUARE STEEL POLE	1	219 W	LED	21594 lm	277 V	LEFT CORNER CUTOFF DISTRIBUTION, 4000K CCT, WITH MULTI-VOLT DRIVER, MOUNT TO NEW 30-FOOT SQUARE STEEL POLE, DARK BRONZE FINISH.	219 VA
LDW61	FAIL-SAFE FLDO6A SERIES PHILIPS BRANDS A/E APPROVED EQUAL, GOTHAM EVO SHOWER SERIES PRESOLITE LF6LEDG4 SERIES	RECESSED	1	15 W	LED	1000 lm	277 V	6-INCH ROUND APERTURE LED SHOWER LIGHT WITH REGRESSED LENS REFLECTOR, WHITE REFLECTOR AND TRIM, SELF-FLANGED, IP65 WET LOCATION LISTED.	15 VA
LDW61X	FAIL-SAFE FLDO6A SERIES PHILIPS BRANDS A/E APPROVED EQUAL, GOTHAM EVO SHOWER SERIES PRESOLITE LF6LEDG4 SERIES	RECESSED	1	15 W	LED	1000 lm	277 V	6-INCH ROUND APERTURE LED SHOWER LIGHT WITH REGRESSED LENS REFLECTOR, WHITE REFLECTOR AND TRIM, SELF-FLANGED, IP65 WET LOCATION LISTED, WITH EMERGENCY BATTERY PACK.	15 VA
LE1	LITHONIA WDGE2 SERIES	SURFACE WALL	1	32 W	LED	3200 lm	277 V	LED WALL MOUNTED ARCHITECTURAL LUMINAIRE, TYPE 3 MEDIUM DISTRIBUTION, 4000K CCT, 70 CRI, DARK BRONZE FINISH, WITH MVOLT DRIVER, MOUNT ONTO JUNCTION BOX, VANDAL RESISTANT.	32 VA
LE1X	LITHONIA WDGE2 SERIES	SURFACE WALL	1	32 W	LED	3200 lm	277 V	LED WALL MOUNTED ARCHITECTURAL LUMINAIRE, TYPE 3 MEDIUM DISTRIBUTION, 4000K CCT, 70 CRI, DARK BRONZE FINISH, WITH MVOLT DRIVER, PROVIDE WITH INTEGRAL COLD WEATHER EMERGENCY BATTERY PACK, MOUNT ONTO JUNCTION BOX, VANDAL RESISTANT.	32 VA
LF2	LITHONIA CPX SERIES	RECESSED	1	45 W	LED	3900 lm	277 V	2 BY 4-FOOT LED FLAT PANEL FIXTURE WITH SATIN WHITE LENS, ALUMINUM FRAME, 4000K, 80CRI, ADJUSTABLE LUMEN OUTPUT, 0-10VDC DIMMING, MVOLT DRIVER.	45 VA
LF2X	LITHONIA CPX SERIES	RECESSED	1	45 W	LED	3900 lm	277 V	2 BY 4-FOOT LED FLAT PANEL FIXTURE WITH SATIN WHITE LENS, ALUMINUM FRAME, 4000K, 80CRI, ADJUSTABLE LUMEN OUTPUT, 0-10VDC DIMMING, MVOLT DRIVER WITH EMERGENCY BATTERY PACK.	45 VA
LH18	LITHONIA IBG SERIES	SUSPENDED	1	192 W	LED	18000 lm	277 V	2 BY 4-FOOT LED HIGH BAY, 95% REFLECTIVE SPECULAR ALUMINUM REFLECTOR, WIDE DISTRIBUTION, FROSTED ACRYLIC LENS AND WIREGUARD, 0-10VDC DIMMING, PROVIDE WITH ALL MOUNTING HARDWARE AND ACCESSORIES FOR AIRCRAFT CABLE SUSPENSION.	192 VA
LH18X	LITHONIA IBG SERIES	SUSPENDED	1	192 W	LED	18000 lm	277 V	2 BY 4-FOOT LED HIGH BAY, 95% REFLECTIVE SPECULAR ALUMINUM REFLECTOR, WIDE DISTRIBUTION, FROSTED ACRYLIC LENS AND WIREGUARD, 0-10VDC DIMMING, PROVIDE WITH ALL MOUNTING HARDWARE AND ACCESSORIES FOR AIRCRAFT CABLE SUSPENSION, WITH EMERGENCY TRANSFER DEVICE.	192 VA
LR2	METALUX WNLED SERIES DAY-BRITE OWL SERIES LITHONIA SBL SERIES COLUMBIA LAW SERIES OR A/E APPROVED EQUAL	SUSPENDED	1	48 W	LED	4000 lm	277 V	4-FOOT LED WRAP AROUND FIXTURE, ACRYLIC PRISMATIC DIFFUSER, 0-10VDC DIMMING, IF SUSPENDED, INSTALL AT 8-FOOT AFF WITH CONDUIT STEMS (UNO).	48 VA
LR2X	METALUX WNLED SERIES DAY-BRITE OWL SERIES LITHONIA SBL SERIES COLUMBIA LAW SERIES OR A/E APPROVED EQUAL	SUSPENDED	1	48 W	LED	4000 lm	277 V	4-FOOT LED WRAP AROUND FIXTURE, ACRYLIC PRISMATIC DIFFUSER, 0-10VDC DIMMING, WITH EMERGENCY BATTERY PACK. IF SUSPENDED, INSTALL AT 8-FOOT AFF WITH CONDUIT STEMS (UNO).	48 VA
LR4	METALUX WNLED SERIES DAY-BRITE OWL SERIES LITHONIA SBL SERIES HUBBELL BRANDS A/E APPROVED EQUAL	SURFACE	1	73 W	LED	7000 lm	277 V	4-FOOT WRAP LED AROUND FIXTURE, ACRYLIC PRISMATIC DIFFUSER, 0-10VDC DIMMING, IF SUSPENDED, INSTALL AT 8-FOOT AFF WITH CONDUIT STEMS (UNO).	73 VA
LR4X	METALUX WNLED SERIES DAY-BRITE OWL SERIES LITHONIA SBL SERIES HUBBELL BRANDS A/E APPROVED EQUAL	SURFACE	1	73 W	LED	7000 lm	277 V	4-FOOT WRAP LED AROUND FIXTURE, ACRYLIC PRISMATIC DIFFUSER, 0-10VDC DIMMING, WITH EMERGENCY TRANSFER DEVICE. IF SUSPENDED, INSTALL AT 8-FOOT AFF WITH CONDUIT STEMS (UNO).	73 VA
XC	SURE-LITES CX SERIES CHLORIDE 55 LINE SERIES LITHONIA SIGNATURE SERIES DUAL-LITE SEMBRA SERIES OR A/E APPROVED EQUAL	SURFACE CEILING	1	3 W	RED LED	0 lm	277 V	CAST ALUMINUM AC ONLY EXIT SIGN, SINGLE FACE, DIRECTIONAL ARROWS INDICATED, WHITE HOUSING. REFER TO PROJECT MANUAL FOR ADDITIONAL REQUIREMENTS.	3 VA
XVW	SURE-LITES UX SERIES CHLORIDE 60 LINE SERIES LITHONIA LV SERIES DUAL-LITE SEWL SERIES	SURFACE WALL	1	3 W	RED LED	0 lm	277 V	CAST ALUMINUM, VANDAL RESISTANT AC ONLY EXIT SIGN, SINGLE FACE, DIRECTIONAL ARROWS INDICATED, WHITE HOUSING, LISTED FOR WET LOCATIONS, REFER TO PROJECT MANUAL FOR ADDITIONAL REQUIREMENTS.	3 VA
XW	SURE-LITES CX SERIES CHLORIDE 55 LINE SERIES LITHONIA SIGNATURE SERIES DUAL-LITE SEMBRA SERIES	SURFACE WALL	1	3 W	RED LED	0 lm	277 V	CAST ALUMINUM AC ONLY EXIT SIGN, SINGLE FACE, DIRECTIONAL ARROWS INDICATED, WHITE HOUSING. REFER TO PROJECT MANUAL FOR ADDITIONAL REQUIREMENTS.	3 VA

- SEE SPECIFICATIONS FOR DRIVER REQUIREMENTS.
- FOR ALL DOWNLIGHTING FIXTURES, PROVIDE REQUIRED MOUNTING HARDWARE FOR MOUNTING IN LAY-IN TYPE CEILINGS.
- CONTRACTOR TO VERIFY TYPES AND QUANTITY OF LIGHT FIXTURES REQUIRING EMERGENCY TRANSFER DEVICES AND PROVIDE REQUIRED QUANTITY OF EMERGENCY TRANSFER DEVICES, LABOR, MATERIAL, ETC. IN THE PROJECT BID FOR FIELD INSTALLATION OF EMERGENCY TRANSFER DEVICES.
- LIGHT FIXTURE SUBMITTALS TO INCLUDE DATA SHEETS FOR ALL FIXTURE TYPES, INCLUDING ADDITIONAL DATA SHEETS FOR BALLAST COMBINATIONS REQUIRED TO MEET THE INSTALLATION REQUIREMENTS OF THE VARIOUS FIXTURE TYPES INDICATED IN THE REMARKS COLUMN OF THE FIXTURE SCHEDULES OR ON THE DRAWINGS. SUBMITTALS SHALL ALSO INDICATE COLOR FOR ANY CUSTOM COLOR LIGHT FIXTURES.

COPYRIGHT 2024 BY FANNINGHOWEY ASSOCIATES, INC.

PENN HIGH SCHOOL FIELDHOUSE

12641 McKinley Highway
Mishawaka, IN 46545

PENN-HARRIS MADISON SCHOOL CORPORATION




ARCHITECT

FANNING HOWEY


317.848.0966

WWW.FHAI.COM

350 E NEW YORK ST #500, INDIANAPOLIS, IN 46204

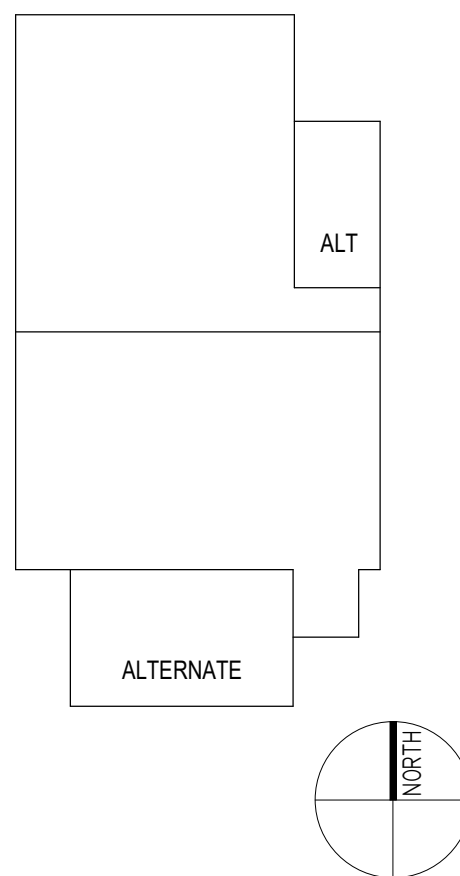

100% Construction Documents

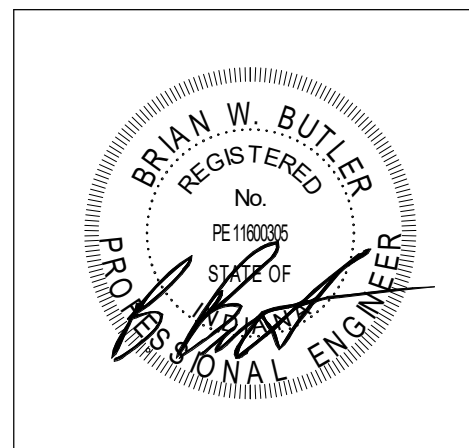

DRAWN BY: ISO

PROJECT NUMBER: 222130.00

PROJECT ISSUE DATE: 01.10.2024

REV. NO.	DESCRIPTION	DATE
1	Addendum #1	01.26.2024
2	Addendum #2	02.01.2024

LUMINAIRE SCHEDULE AND RISER DIAGRAM

E-601

Branch Panel: 1AH1											
Location: ELECTRICAL A105				Volts: 480/277 Wye				A.I.C. Rating:			
Supply From: DP				Phases: 3				Mains Type: M.C.B			
Mounting: Surface				Wires: 4				Mains Rating: 200 A			
Enclosure: Type 1								MCB Rating: 250 A			
Notes:											
CKT	Circuit Description	Trip	Poles	A	B	C	Poles	Trip	Circuit Description	CKT	
1	First floor lighting	20 A	1	3390... 3951...			1	20 A	Second floor lighting	2	
3	Fieldhouse lighting	20 A	1		3840... 3840...		1	20 A	Fieldhouse lighting	4	
5	Fieldhouse lighting	20 A	1			3840... 3840...	1	20 A	Fieldhouse lighting	6	
7	Fieldhouse lighting	20 A	1	3072... 3072...			1	20 A	Fieldhouse lighting	8	
9	Site lighting	20 A	1		0 VA	0 VA	1	20 A	Site lighting	10	
11	Exterior lighting	20 A	1			0 VA	429 VA	1	20 A	Exterior lighting	12
13	Unit C - First Floor Lighting (NOTE 1)	--	1	--	--		1	--	Unit D - First Floor Lighting (NOTE 1)	14	
15	D101 - Lighting #1 (NOTE 1)	--	1	--	--		1	--	Unit D - Second Floor Lighting (NOTE 1)	16	
17	D101 - Lighting #2 (NOTE 1)	--	1	--	--		1	--	D201 - Lighting #1 (NOTE 1)	18	
19	CB1	40 A	3	0 VA	--		1	--	D201 - Lighting #2 (NOTE 1)	20	
21	--	--	--	--	0 VA					22	
23	--	--	--	--		0 VA				24	
25										26	
27										28	
29										30	
31										32	
33										34	
35										36	
37										38	
39										40	
41										42	
Total Load:				13485 VA	7680 VA	8109 VA					
Total Amps:				49 A	28 A	30 A					
Legend:											
Load Classification		Connected Load		Demand Factor		Estimated Demand		Panel Totals			
Lighting		29274 VA		125.00%		36593 VA					
								Total Conn. Load: 29274 VA			
								Total Est. Demand: 36593 VA			
								Total Conn.: 35 A			
								Total Est. Demand: 44 A			
Notes:											
NOTE 1: PROVIDE CIRCUIT AS PART OF THE ALTERNATE BID.											

Branch Panel: 1AH2											
Location: ELECTRICAL A105				Volts: 480/277 Wye				A.I.C. Rating:			
Supply From: DP				Phases: 3				Mains Type:			
Mounting: Surface				Wires: 4				Mains Rating: 400 A			
Enclosure: Type 1								MCB Rating: 400 A			
Notes:											
CKT	Circuit Description		Trip	Poles	A	B	C	Poles	Trip	Circuit Description	CKT
1	ARU-1		40 A	3	7479... 7479...	7479... 7479...		3	40 A	ARU-2	2
3	--		--	--	--	--	--	--	--	--	4
5	--		--	--	--	--	7479... 7479...	--	--	--	6
7	Field House Fans CF-1, CF-2		20 A	3	1163... 5817...			3	40 A	ACCU-2 Roof	8
9	--		--	--	--	1163... 5817...	1163... 5817...	--	--	--	10
11	--		--	--	--	--	--	--	--	--	12
13	AHU-4 Rm. D204 (NOTE 1)		20 A	3	0 VA 5817...	0 VA 5817...		3	40 A	AHU-1 Rm. A202	14
15	--		--	--	--	--	0 VA 5817...	--	--	--	16
17	--		--	--	--	--	0 VA 5817...	--	--	--	18
19	AHU-2 Supply Rm. A202		20 A	3	3047... 2105...	3047... 2105...		3	20 A	AHU-2 Exhaust Rm. A202	20
21	--		--	--	--	--	--	--	--	--	22
23	--		--	--	--	--	3047... 2105...	--	--	--	24
25	Booster pump DWB1 Rm. B113		20 A	3	5817... 0 VA	5817... 0 VA		3	40 A	AHU-3 Rm. D103 (NOTE 1)	26
27	--		--	--	--	--	--	--	--	--	28
29	--		--	--	--	--	5817... 0 VA	--	--	--	30
31	CUH-2 Vest. B120		20 A	1	152 VA 152 VA			1	20 A	CUH-1 Corr. A103	32
33	AHU-2 Energy Recovery Unit - A202		20 A	3		443 VA					34
35	--		--	--	--	--	443 VA	--	--	--	36
37	--		--	--	443 VA			--	--	--	38
39	--		--	--	--	--	--	--	--	--	40
41	--		--	--	--	--	--	--	--	--	42
Total Load:					39472 VA	39168 VA	39168 VA				
Total Amps:					142 A	141 A	141 A				
Legend:											
Load Classification		Connected Load		Demand Factor		Estimated Demand		Panel Totals			
Motor		117808 VA		104.76%		123417 VA					
								Total Conn. Load: 117808 VA			
								Total Est. Demand: 123417 VA			
								Total Conn.: 142 A			
								Total Est. Demand: 148 A			
Notes:											
NOTE 1: PROVIDE CIRCUIT AS PART OF THE ALTERNATE BID.											

Branch Panel: 1AL1											
Location: ELECTRICAL A105				Volts: 120/208 Wye				A.I.C. Rating:			
Supply From: T-1				Phases: 3				Mains Type: M.C.B			
Mounting: Surface				Wires: 4				Mains Rating: 400 A			
Enclosure: Type 1								MCB Rating: 400 A			
Notes:											
CKT	Circuit Description	Trip	Poles	A	B	C	Poles	Trip	Circuit Description	CKT	
1	Convenience receptacles Corr. A103, Rm. A104	20 A	1	1080...	2000...		1	20 A	Microwave and GFCI receptacles Rm. A104	2	
3	Refrigerator receptacle Rm. A104	20 A	1		1000...	360 VA	1	20 A	Tub receptacles Rm. A104	4	
5	Convenience receptacles Corr. A102, Rms....	20 A	1			1080...	2160...	1	20 A	Fieldhouse floor boxes Rm. A101	6
7	Fieldhouse floor boxes Rm. A101	20 A	1	1080...	1080...		1	20 A	Fieldhouse floor boxes Rm. A101	8	
9	Fieldhouse receptacles Rm. A101, Exterior wall	20 A	1		1440...	540 VA	1	20 A	Fieldhouse receptacles Rm. A101, Exterior wall	10	
11	Receptacles Rm. A101, Corr. B101	20 A	1			1260...	900 VA	1	20 A	Fieldhouse receptacles Rm. A101, Exterior wall	12
13	Receptacles Rms. B102-B106	20 A	1	1440...	1620...		1	20 A	Convenience receptacles Rms. B106-B112	14	
15	Receptacles Rms. B113-B116, B118	20 A	1		1440...	720 VA	1	20 A	Convenience and monitor receptacles Rm. B117	16	
17	Receptacles Rm. B118	20 A	1			1260...	1260...	1	20 A	Receptacles Rm. B119, Exterior walls	18
19	Receptacles Rm. B121	20 A	1	1080...	360 VA		1	20 A	Water cooler receptacles Corr. B101 (NOTE 2)	20	
21	Convenience receptacles Corr. A201, Rm. A202	20 A	1		1412...	1440...	1	20 A	Receptacles Rms. B202-B206 (NOTE 1)	22	
23	Receptacles Corr. B201, Rms. B207-B209 (NOT...	20 A	1			1260...	1800...	1	20 A	Convenience receptacles Corr. B201, Rms....	24
25	Receptacles Rm. B210	20 A	1	1260...	1260...		1	20 A	Receptacles Rm. B216	26	
27	Overhead Door #1 - A101	20 A	1		1127...	828 VA	1	20 A	Overhead Door #2 - A101	28	
29	Overhead Door #3 - A101	20 A	1			828 VA	1127...	1	20 A	Bleacher Motor #1	30
31	Elevator Pump and Control Panel	20 A	1	1127...	1000...		2	20 A	EUH-1 Stair, S-2	32	
33	First Floor VAVs	20 A	1		350 VA	1000...	--	--	--	34	
35	Second Floor VAVs	20 A	1			250 VA	0 VA	1	20 A	Monitor receptacles - East Wall D101 (NOTE 1)	36
37	Overhead Door, Exhaust fan EF-C1 - C101 (NOT...	20 A	1	0 VA	0 VA		1	20 A	Receptacles - North Wall D101 (NOTE 1)	38	
39	Receptacles #1, PUH-5 - C101 (NOTE 1)	20 A	1		0 VA	0 VA	1	20 A	Receptacles - East Wall D101 (NOTE 1)	40	
41	Receptacles #2, PUH-6 - C101 (NOTE 1)	20 A	1			0 VA	0 VA	1	20 A	Receptacles - South Wall D101 (NOTE 1)	42
43	Sound Rack - D101 (NOTE 1)	20 A	1	0 VA	0 VA		1	20 A	Receptacles - West Wall D101, PUH-3 Rm. D102...	44	
45	Water Coolers - D101 (NOTE 1)	20 A	1		0 VA	0 VA	1	20 A	Receptacles- D102-104 & Exterior (NOTE 1)	46	
47	Receptacles - North Wall D202 (NOTE 1)	20 A	1			0 VA	0 VA	1	20 A	Sound Rack - D206 (NOTE 1)	48
49	Receptacles - East Wall D202 (NOTE 1)	20 A	1	0 VA	0 VA		1	20 A	Water Coolers - D202 (NOTE 1)	50	
51	Receptacles - South Wall D202 (NOTE 1)	20 A	1		0 VA	0 VA	1	20 A	Refrigerator - D205 (NOTE 1)	52	
53	Receptacles - West Wall D202, Island D205...	20 A	1			0 VA	0 VA	1	20 A	Receptacles - D101, D103-105 (NOTE 1)	54
55	Receptacles #1 - B117	20 A	1	180 VA	360 VA		1	20 A	Receptacles #2 - B117	56	
57	Receptacles #3 - B117	20 A	1		360 VA	360 VA	1	20 A	Receptacles - Island B117	58	
59	Receptacle - Floor Scrubber B115	20 A	1			180 VA	360 VA	1	20 A	Water cooler receptacles Corr. B101	60
61	Elevator lights, receptacle	20 A	1	288 VA	720 VA		1	20 A	IDF Backboard receptacles Rm. B214	62	
63	IDF Rack receptacle Rm. B214	20 A	1		180 VA	360 VA	1	20 A	IDF Rack receptacle Rm. B214	64	
65	BLR-1 Control Panel Rm. A202	20 A	1			1920...	1920...	1	20 A	BLR-2 Control Panel Rm. A202	66
67	HWP-1 Rm. A202	20 A	2	915 VA	915 VA		2	20 A	HWP-2 Rm. A202	68	
69	--	--	--	--	915 VA	915 VA	--	--	--	70	
71	HWP-3 Rm. A202	20 A	3	--	--	1272...	1272...	3	20 A	HWP-4 Rm. A202	72
73	--	--	--	--	1272...	1272...	--	--	--	74	
75	--	--	--	--	1272...	1272...	--	--	--	76	
77	EF-A1 Roof	20 A	1			345 VA	750 VA	1	20 A	Temperature Control Panels Rm. A202	78
79	Scoreboard receptacles	20 A	1	540 VA	1633...		1	20 A	Hot Water Return Pump HWP-C1, PUH-2 Rm....	80	
81	Water Softener receptacles Rm. B113	20 A	1			360 VA	360 VA	Y	20 A	Vending receptacle #1 Corr. A103 (NOTE 2)	82
83	EF-B1,B2,B3 - ROOF	20 A	1			805 VA	500 VA	1	20 A	Temperature control panels - D103, D204 (NOTE...	84
				Total Load:	22482 VA	18011 VA	22509 VA				
				Total Amps:	193 A	150 A	193 A				
Legend:											
Load Classification		Connected Load		Demand Factor		Estimated Demand		Panel Totals			
Motor		19864 VA		104.80%		20818 VA					
Other		6950 VA		100.00%		6950 VA		Total Conn. Load: 63002 VA			
Receptacle		3000 VA		100.00%		3000 VA		Total Est. Demand: 52720 VA			
Spare		500 VA		100.00%		500 VA		Total Conn.: 175 A			
Receptacle - Convenience		32328 VA		65.47%		21164 VA		Total Est. Demand: 146 A			
Receptacle - Special		360 VA		80.00%		288 VA					
Notes:											
NOTE 1: PROVIDE CIRCUIT UNDER THE ALTERNATE BID.											
NOTE 2: PROVIDE WITH 5mA GFCI BREAKER.											




ARCHITECT

FANNING HOWEY


17.848.0966

WWW.FHAI.COM

50 E NEW YORK ST #300, INDIANAPOLIS, IN 4620

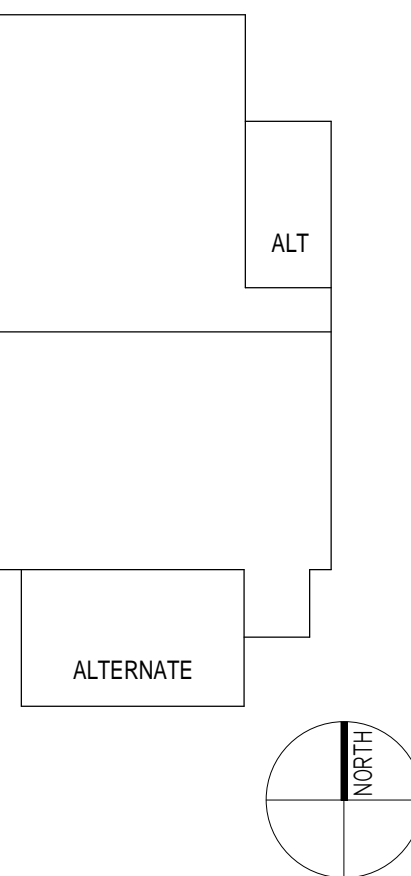

CONSTRUCTION DOCUMENTS

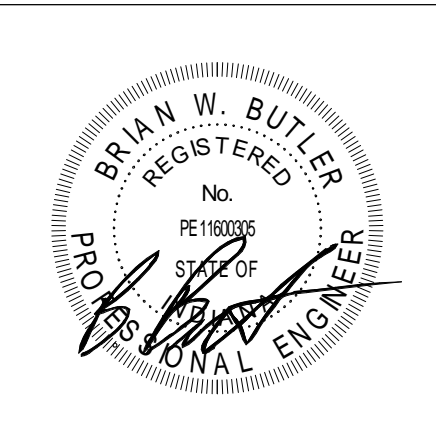
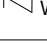
 





 










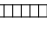


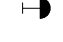





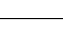
PROJECT MANAGER: MKS
DRAWN BY: CDT
PROJECT NUMBER: 222130.00
PROJECT ISSUE DATE: 1.13.2024

[illegible]

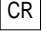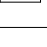

TECHNOLOGY SYMBOLS & ABBREVIATIONS


T-001

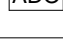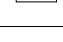COMMUNICATIONS SYMBOLS LEGEND		
SYMBOL	DESCRIPTION	WIRING DETAIL(S) UNLESS NOTED OTHERWISE
	COMMUNICATIONS OUTLET: WHEN INDICATED WITH C-x, x = THE QUANTITY OF COMMUNICATIONS COPPER HORIZONTAL CABLING, IN ADDITION TO OTHER CABLES NOTED.	2
	WALL MOUNTED COMMUNICATIONS OUTLET: WHEN INDICATED WITH C-x, x = THE QUANTITY OF COMMUNICATIONS COPPER HORIZONTAL CABLING, IN ADDITION TO OTHER CABLES NOTED.	1
	MULTI CAPACITY FLOOR BOX: WHEN INDICATED WITH C-x, x = THE QUANTITY OF COMMUNICATIONS COPPER HORIZONTAL CABLING, IN ADDITION TO OTHER CABLES NOTED.	-
	POKE-THRU FLOOR BOX: WHEN INDICATED WITH C-x, x = THE QUANTITY OF COMMUNICATIONS COPPER HORIZONTAL CABLING, IN ADDITION TO OTHER CABLES NOTED.	-
	CEILING MOUNTED PROJECTOR: WHEN INDICATED WITH C-x, x = THE QUANTITY OF COMMUNICATIONS COPPER HORIZONTAL CABLING, IN ADDITION TO OTHER CABLES NOTED.	-
	WALL MOUNTED PROJECTOR: WHEN INDICATED WITH C-x, x = THE QUANTITY OF COMMUNICATIONS COPPER HORIZONTAL CABLING, IN ADDITION TO OTHER CABLES NOTED.	8/T-501
	CEILING MOUNTED WIRELESS ACCESS POINT: WHEN INDICATED WITH C-x, x = THE QUANTITY OF COMMUNICATIONS COPPER HORIZONTAL CABLING, IN ADDITION TO OTHER CABLES NOTED.	2 CAT6A
	WALL MOUNTED WIRELESS ACCESS POINT: WHEN INDICATED WITH C-x, x = THE QUANTITY OF COMMUNICATIONS COPPER HORIZONTAL CABLING, IN ADDITION TO OTHER CABLES NOTED.	2 CAT6A
	CABLE TRAY	-
	LADDER TRAY	-
	CONDUIT SLEEVES BETWEEN WALLS	SHOWN ON E3 DRAWINGS
	2 (TWO) 4\" data-bbox="35 945 65 975"/>	-
	TELEPHONE TERMINATION BOARD	-
	TECHNOLOGY EQUIPMENT/SOUND RACK	7/T-501
	2-POST TECHNOLOGY EQUIPMENT RACK	-
	4-POST TECHNOLOGY EQUIPMENT RACK	7/T-501
	OVERHEAD DOCUMENT CAMERA: WHEN INDICATED WITH C-x, x = THE QUANTITY OF COMMUNICATIONS COPPER HORIZONTAL CABLING, IN ADDITION TO OTHER CABLES NOTED.	-

ACCESS CONTROL SYMBOLS LEGEND		
SYMBOL	DESCRIPTION	WIRING DETAIL(S) UNLESS NOTED OTHERWISE
	ACCESS CONTROL PANEL	2/T-502
	CARD READER	2/T-502
	ELECTRONIC LATCH SET WITH ELECTRONIC POWER TRANSFER	2/T-502
	AUTOMATIC DOOR PUSHBUTTON	-
	ABOVE CEILING WALL MOUNTED DOOR ACCESS CONTROLLER JUNCTION BOX. WHEN INDICATED WITH C-X X = THE QUANTITY OF COMMUNICATIONS COPPER HORIZONTAL CABLING, IN ADDITION TO OTHER CABLES NOTED.	2/T-502
	PUSH TO RELEASE BUTTON	-
	AUTOMATIC DOOR OPERATOR	2/T-502
	LOCKDOWN BUTTON	-
	AIPHONE DOOR INTERCOM/CAMERA	-
	AIPHONE MAIN INTERCOM/CAMERA CONSOLE DESKPHONE	-

PUBLIC ADDRESS AND MASS NOTIFICATION SYSTEMS		
SYMBOL	DESCRIPTION	WIRING DETAIL(S) UNLESS NOTED OTHERWISE
	ANTENNA	-
	CLASSROOM SOUND REINFORCEMENT SPEAKER - CEILING MOUNTED	3/T-502
	GYMNASIUM SOUND REINFORCEMENT SPEAKER - CEILING MOUNTED	-
	4" CEILING LOUDSPEAKER SPEAKER - CEILING MOUNTED	-
	CLASSROOM SOUND REINFORCEMENT SPEAKER - WALL MOUNTED	-
	WALL MOUNTED SPEAKER	-
	WALL MOUNTED SPEAKER-OUTLET	-
	CEILING MOUNTED PA SPEAKER	1/T-503
	LINE ARRAY COLUMN SPEAKERS - WALL MOUNTED	-
	FULL RANGE CEILING SPEAKER	-
	CEILING MOUNTED INTERCOM SPEAKER	-
	WALL MICROPHONE INPUT	-
	CEILING MICROPHONE	-
	AUX. INPUT	-
	MONITOR OUTPUT	-
	RECESSED JUNCTION BOX FOR SOUND SYSTEM	-
	SUBWOOFER	-
	WALL MOUNTED MICROPHONE/AUXILIARY INPUT	1/T-503

INTERIOR VIDEO SURVEILLANCE CAMERA SYMBOLS LEGEND		
SYMBOL	DESCRIPTION	WIRING DETAIL(S) UNLESS NOTED OTHERWISE
	CEILING MOUNTED VIDEO SURVEILLANCE CAMERA. WHEN INDICATED WITH C-x, x = THE QUANTITY OF COMMUNICATIONS COPPER HORIZONTAL CABLING, IN ADDITION TO OTHER CABLES NOTED.	1/7-502
	WALL MOUNTED VIDEO SURVEILLANCE CAMERA. WHEN INDICATED WITH C-x, x = THE QUANTITY OF COMMUNICATIONS COPPER HORIZONTAL CABLING, IN ADDITION TO OTHER CABLES NOTED.	1/7-502

EXTERIOR VIDEO SURVEILLANCE CAMERA SYMBOLS LEGEND		
SYMBOL	DESCRIPTION	WIRING DETAIL(S) UNLESS NOTED OTHERWISE
	WALL MOUNTED WEATHERPROOF VIDEO SURVEILLANCE CAMERA. WHEN INDICATED WITH C-x, x = THE QUANTITY OF COMMUNICATIONS COPPER HORIZONTAL CABLING, IN ADDITION TO OTHER CABLES NOTED.	1/T-502

TELECOMMUNICATIONS 6A CABLE COLOR LEGEND				
SYSTEM	TERMINATION (RJ45) PANDUIT	CABLE GENERAL	PATCH CABLE (PATCH PANEL)	PATCH CABLE (STATION)
DATA	WHITE	BLUE	BLUE	BLACK
WIRELESS	BLUE	BLUE	WHITE	WHITE
CAMERA	BLUE	BLUE	BLACK	BLACK
ACCESS	YELLOW	YELLOW	YELLOW	YELLOW
HVAC	RED	RED	RED	RED

	CONTRACTOR FURNISH	CONTRACTOR INSTALL	OWNER FURNISH	OWNER INSTALL
ACCESS CARD READERS, DOOR CONTACTS	NO	NO	YES	YES
ACCESS, SECURITY CABLING & ROUGH INS	YES	YES	NO	NO
AV PROJECTOR AND MOUNTS	YES	YES	NO	NO
AV PROJECTOR MISC. CABLING (IN WALL)	YES	YES	NO	NO
AV MONITOR PATCH CABLES	YES	YES	NO	NO
WIRELESS CLOCKS	NO	NO	YES	YES
FIBER BACKBONE	YES	YES	NO	NO
FIBER TERM AND TEST	YES	YES	NO	NO
FIBER ENCLOSURE WITH LC COUPLER PANEL	YES	YES	NO	NO
NETWORK EQUIPMENT	NO	NO	YES	YES
NETWORK SFP	NO	NO	YES	YES
IDF RACKS	YES	YES	NO	NO
SOUND REINFORCEMENT	YES	YES	NO	NO
SURVEILLANCE CAMERAS	NO	NO	YES	YES
SURVEILLANCE CAMERAS CAT6A CABLING	YES	YES	NO	NO
WIRELESS ACCESS POINTS	NO	YES	YES	NO
WIRELESS ACCESS POINTS CAT6A CABLING	YES	YES	NO	NO


TECHNOLOGY GENERAL NOTES

- A THE COMMUNICATIONS CABLING CONTRACTOR(S) IS/ARE RESPONSIBLE FOR ANY ADDITIONAL CONDUIT SLEEVES, OUTLET/JUNCTION BOX, SURFACE RACEWAY, CABLE TRAY, DOUBLE GANGE SQUEE PLASTER MUD RINGS, ETC. NOT SHOWN ON THE E3 ROOM IN DRAWINGS.
- B THE COMMUNICATIONS CABLING CONTRACTOR(S) IS/ARE RESPONSIBLE FOR COORDINATING WITH ELECTRICAL CONTRACTOR IN EXTENDING THE ELECTRICAL SERVICE FROM THE ELECTRICAL JUNCTION BOX IN THE SPACE TO ALL THE COMMUNICATIONS RACKS/CABINETS.
- C THE CONTRACTOR(S) SHALL BE RESPONSIBLE FOR REPLACING/REPAIRING DAMAGED CEILING GRID/TILE AS A RESULT OF THEIR INSTALLATION.
- D THE CONTRACTOR SHALL VERIFY THE SURFACE RACEWAY LOCATIONS, ROUTING, OPENINGS, ETC. WITH THE BUILDING ELECTRICAL CONTRACTOR, PROVIDE PROPER COVER PLATES FOR THE DEVICES AS REQUIRED.
- E THE COMMUNICATIONS CABLING CONTRACTOR SHALL COORDINATE THE EXACT LOCATION OF THE MONITORS AND VIDEO PROJECTOR WITH THE WHITEBOARD INSTALLATION CONTRACTOR AND ELECTRICAL CONTRACTOR TO ENSURE A FULL AND CLEAR PROJECTION IMAGE.

TECHNOLOGY ABBREVIATIONS

ABBREVIATIONS USED ON DRAWINGS IN GENERAL ARE LISTED BELOW.

AFF	ABOVE FINISH FLOOR
AFG	ABOVE FINISH GRADE
B	BLANK
C	CABLE
CATV	CABLE ANTENNA TELEVISION
J	JUNCTION BOX
MC/ER / MDF	MAIN CROSS CONNECT/EQUIPMENT ROOM / MAIN DISTRIBUTION FRAME
+N	INDICATES MOUNTING HEIGHT (IN) TO BOTTOM OF DEVICE FROM FINISH FLOOR UNLESS NOTED OTHERWISE
	NOT IN CONTRACT
NIC	NOT TO SCALE
NTS	TEMPORARY
TR / IDF	TELECOMMUNICATIONS ROOM / INTERMEDIATE DISTRIBUTION FRAME
T.T.B.	TELEPHONE TERMINATION BOARD
T.T.V.	TELEVISION
UNO	UNLESS NOTED OTHERWISE
VF	VERIFY IN FIELD
V	VOLUME CONTROL
W	WALL MOUNTED
	VIDEO INPUT LOCATION
	DEMO TABLE
WG	WIRE GUARD
R	RELEASE
DF	DUAL FACE
	WEATHER PROOF
VO	VIDEO OUTPUT
PTZ	PAN TILT ZOOM
ETR	EXISTING TO REMAIN
VP	VIDEO PROJECTOR
	SURFACE MOUNTED


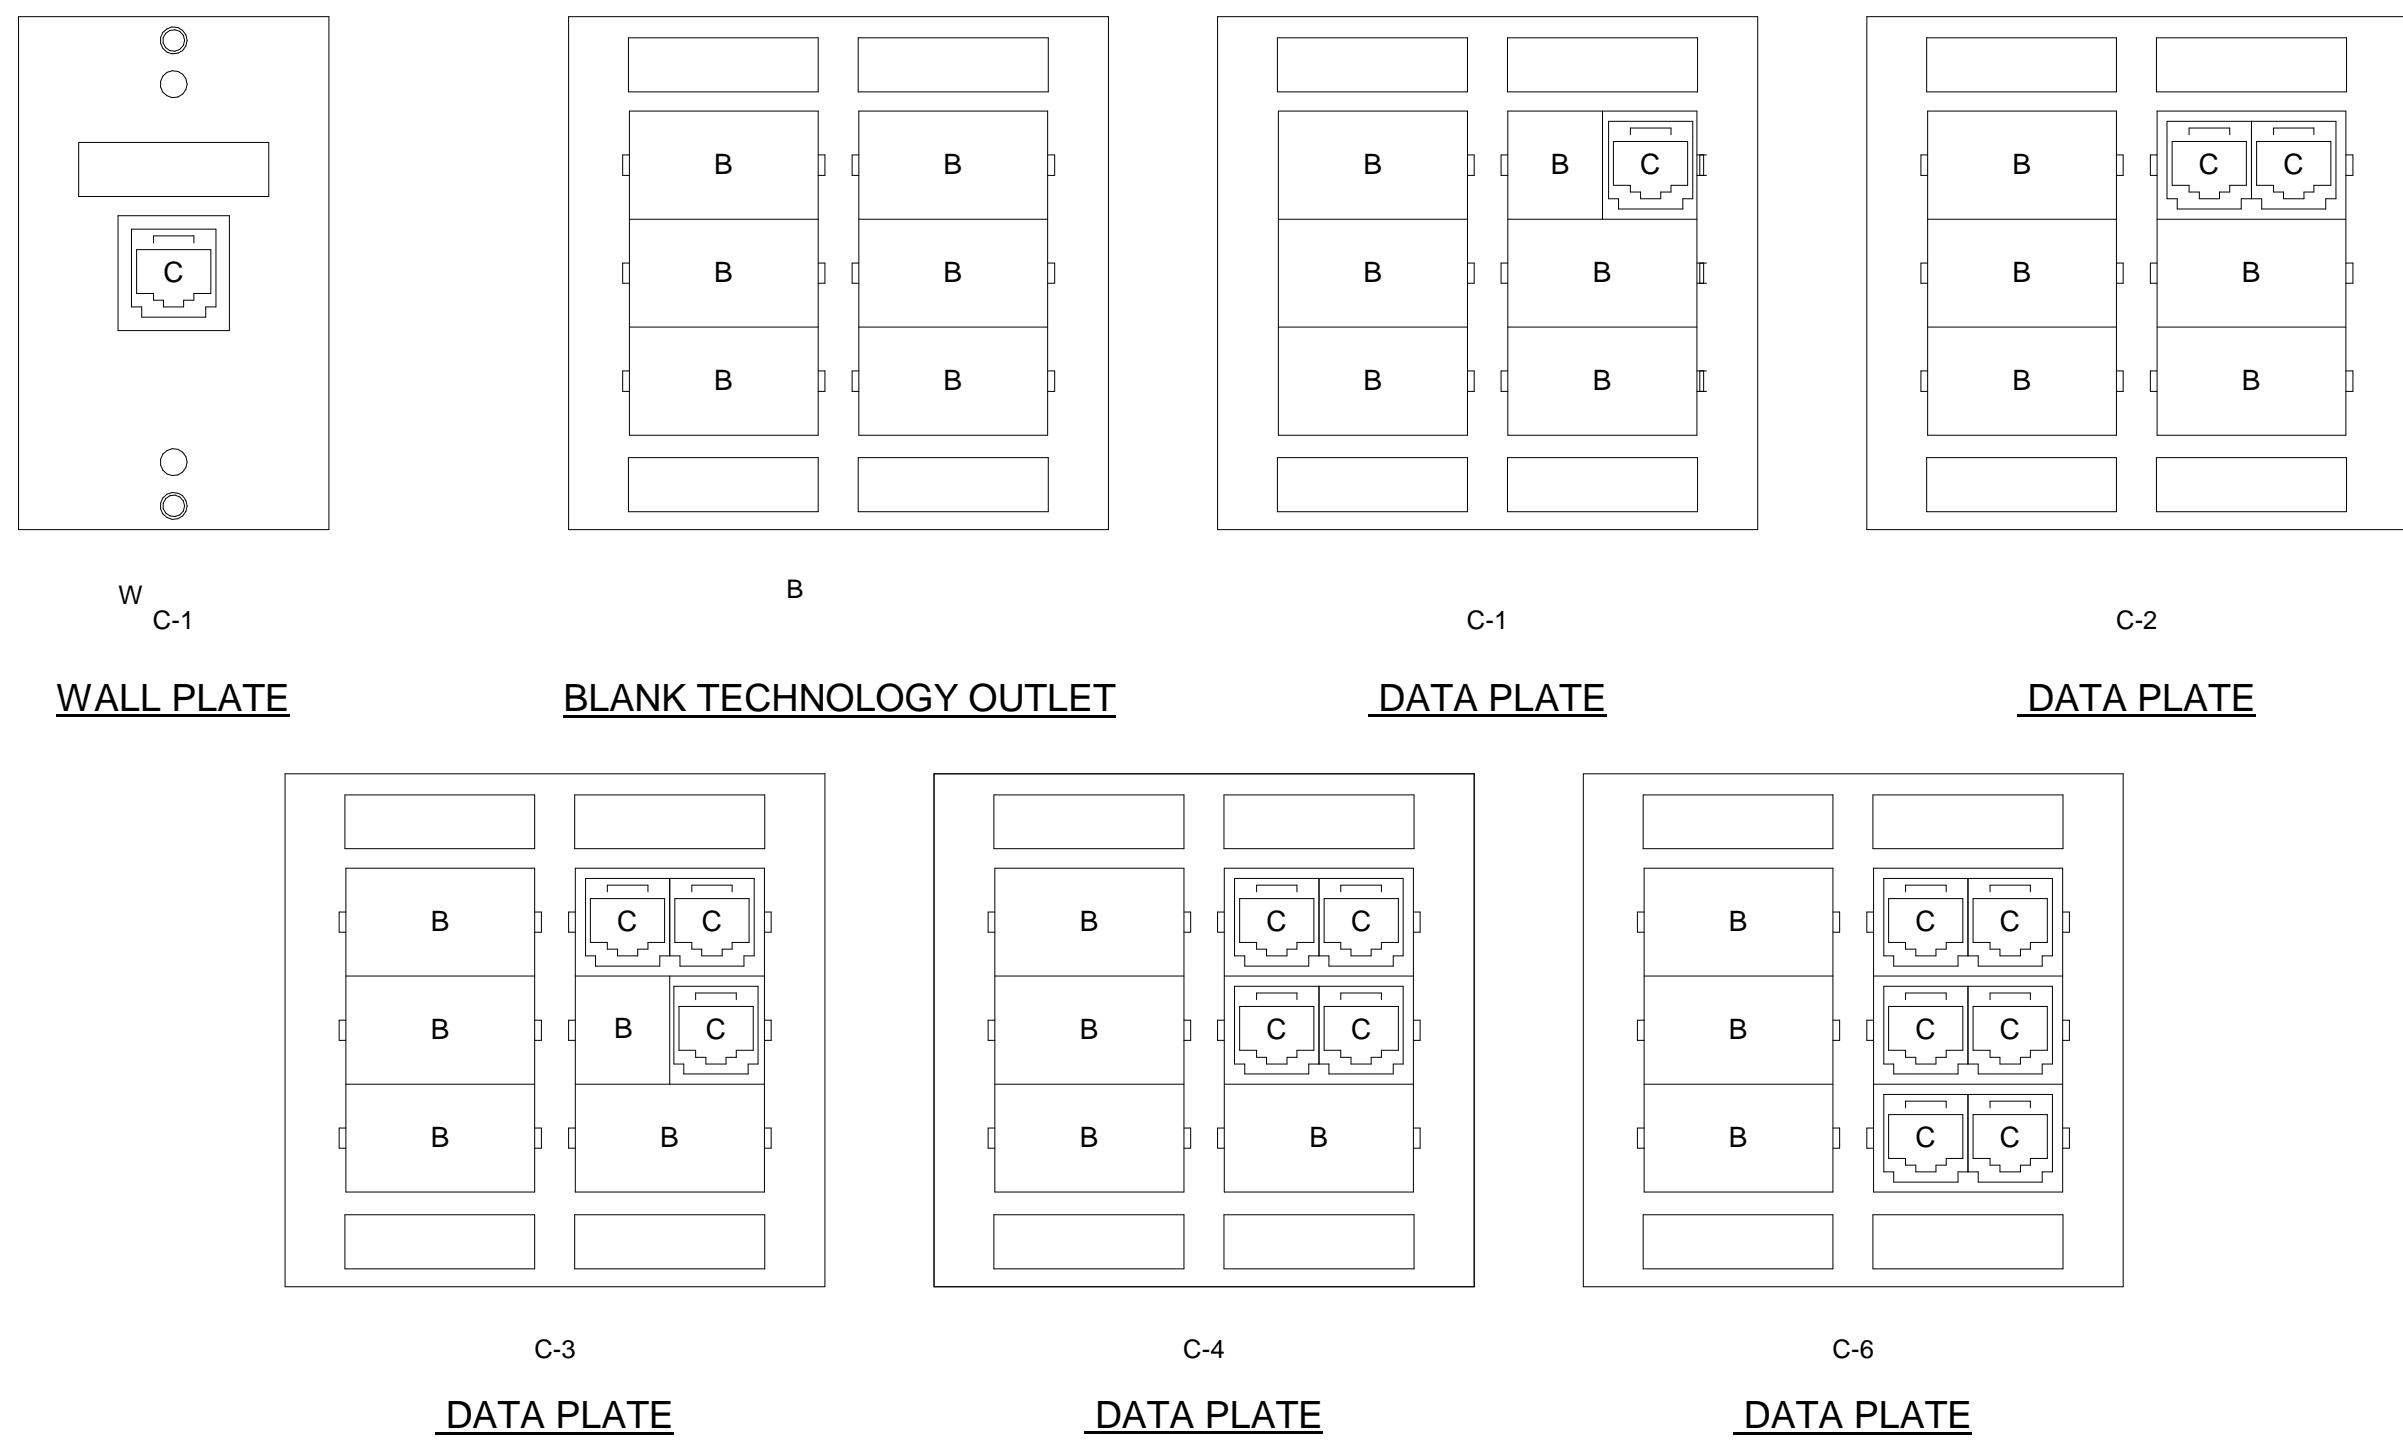


NOTE:
REFER TO AV WIRING DETAILS FOR
EXACT CONFIGURATIONS OF VIDEO
INPUT (V.I.), VIDEO OUTPUT (VO), AND
AV CABINET LOCATIONS..

WALL PLATE CONFIGURATIONS

TECHNOLOGY FACEPLATE ABBREVIATIONS

C - RJ45 DATA JACK
B - BLANK INSERT
WB - RJ-45 JACK FOR USB INTERACTIVITY
HD - RJ45 JACK FOR VIDEO
3.5mm - 3.5mm JACK
HDMI - HDMI CONNECTOR

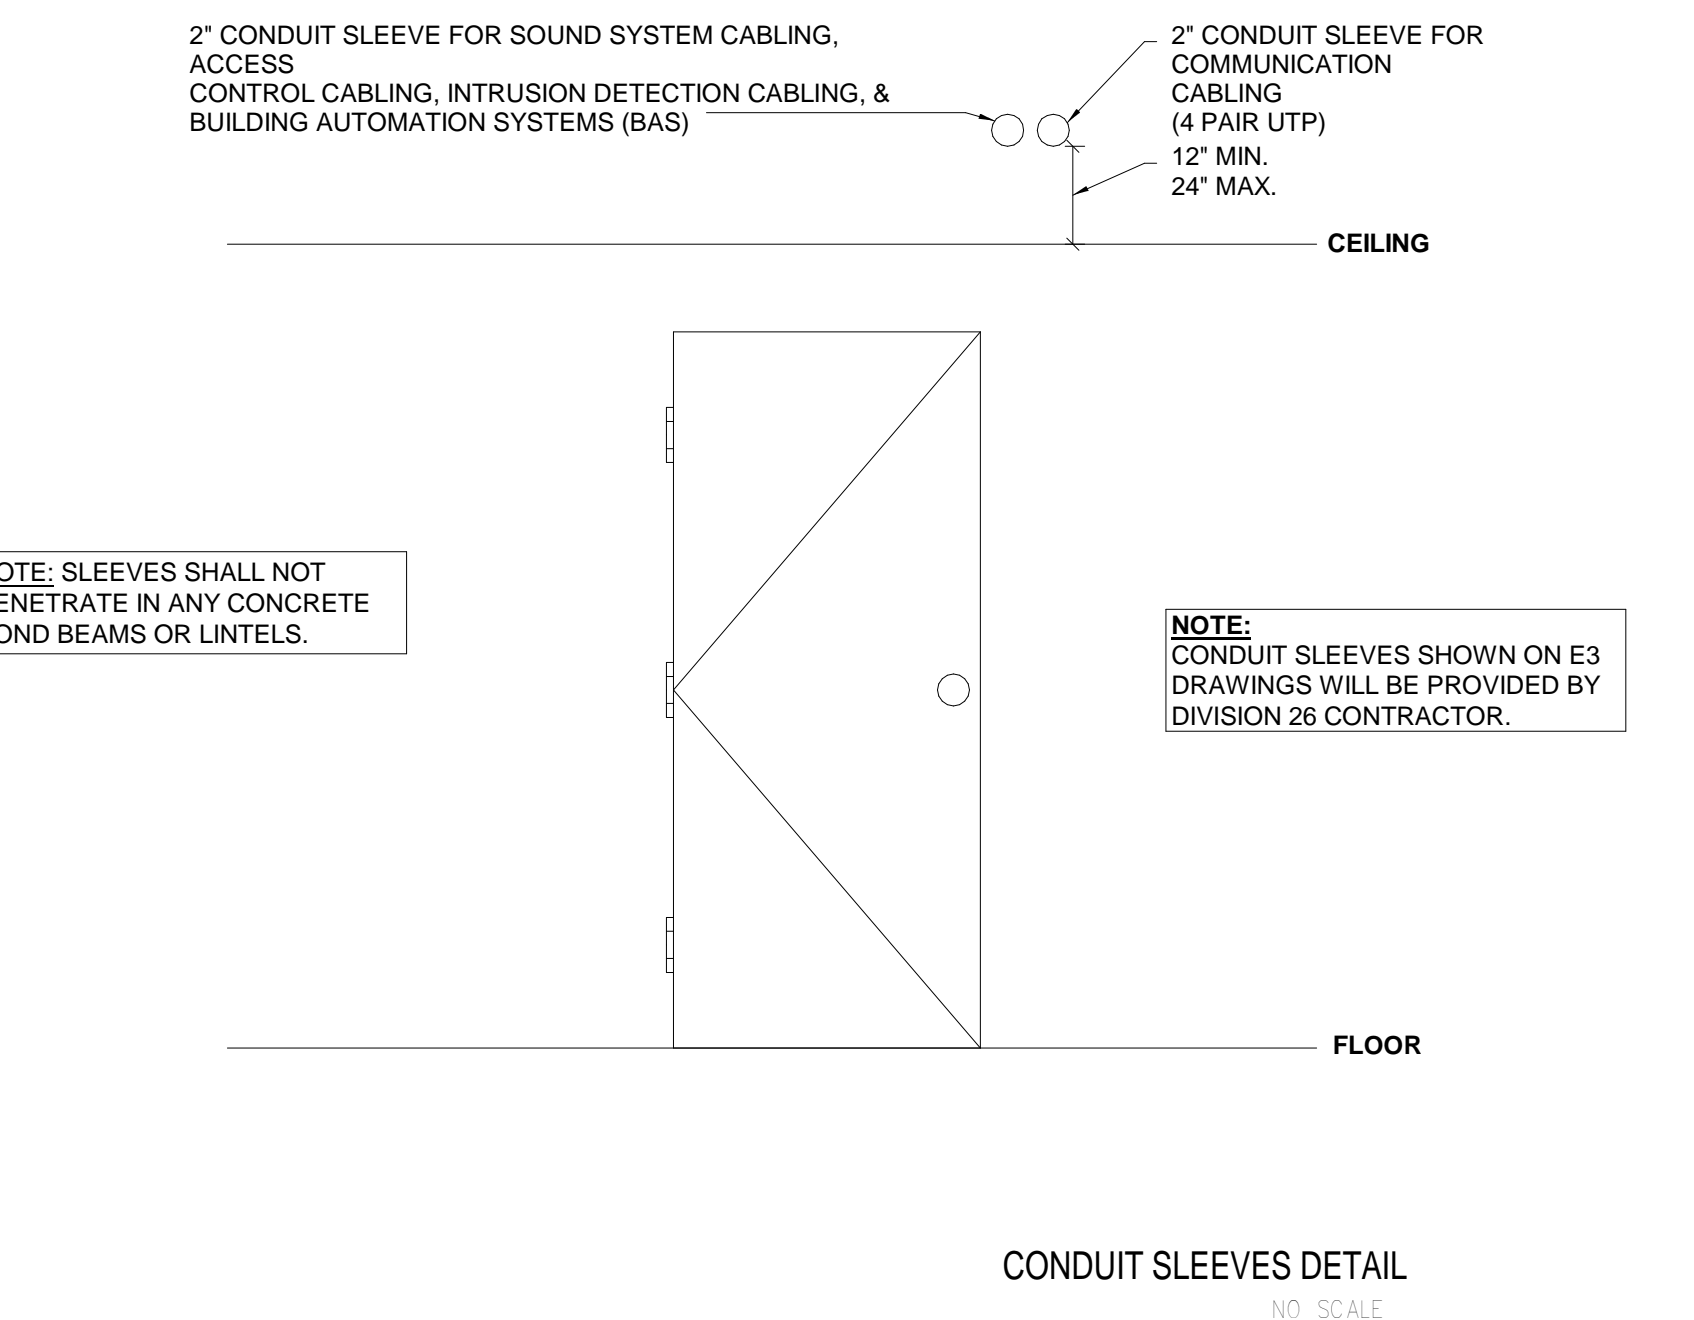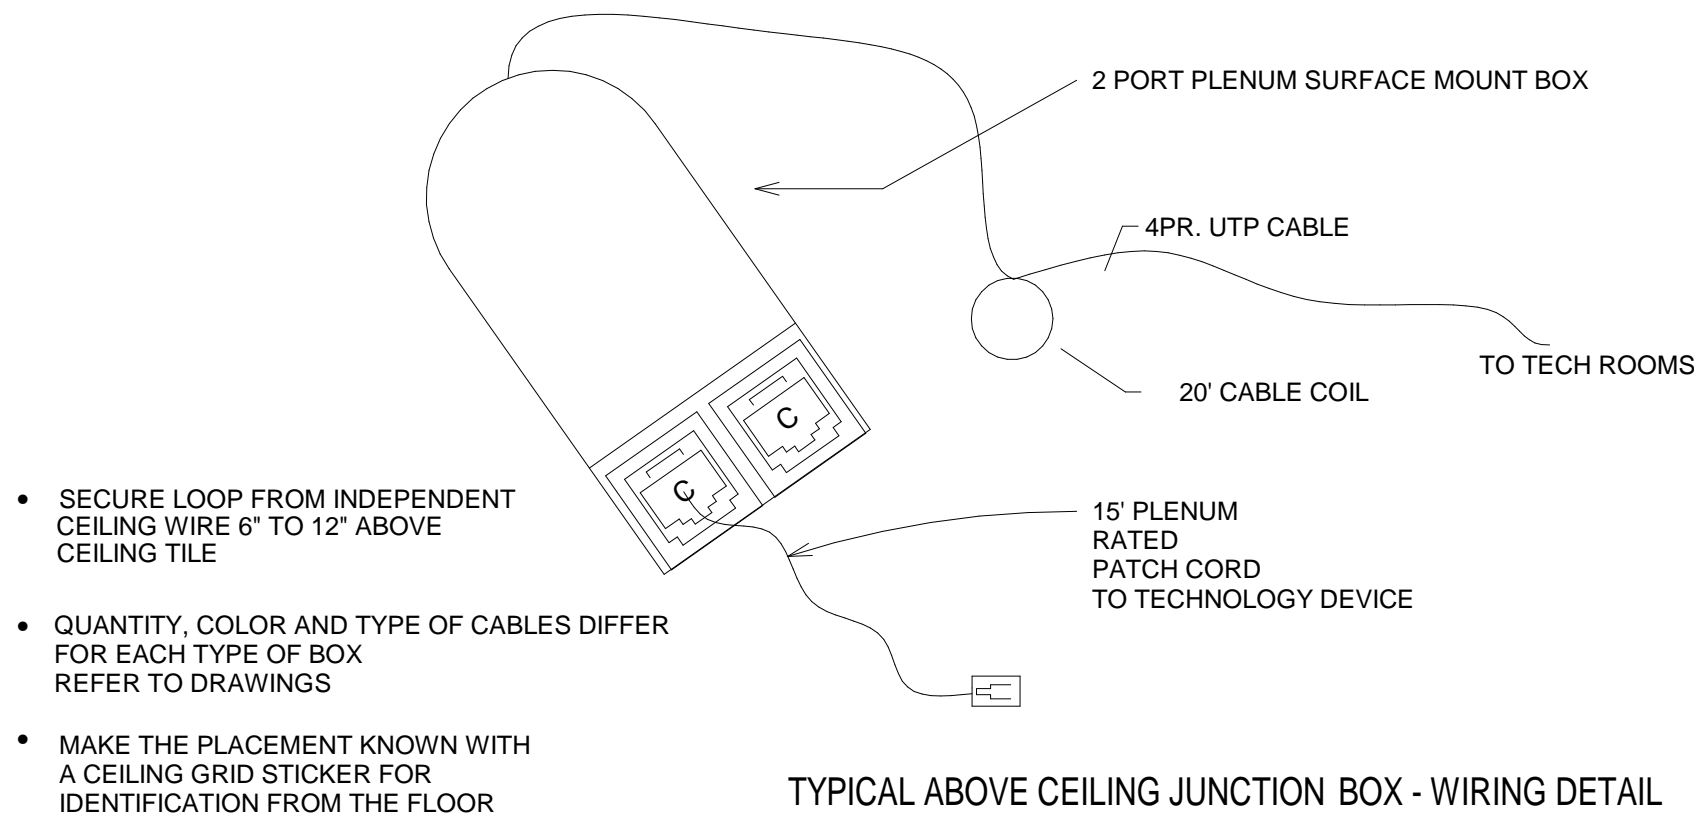

\\data\calmopolis\Schemas\My Documents\2023_TECH_2221\30_00_cdmna8\VKI.rvt
2/1/2024 8:45:41 AM

COPYRIGHT 2024 BY FANNINGHOWEY ASSOCIATES, INC.

PENN HIGH SCHOOL FIELDHOUSE

12641 McKinley Highway, Mishawaka, Indiana 46545



PENN-HARRIS-MADISON SCHOOL CORPORATION



ARCHITECT


FANNING
HOWEY

317.848.0966 WWW.FHAI.COM
350 E NEW YORK ST #500, INDIANAPOLIS, IN 46204

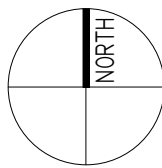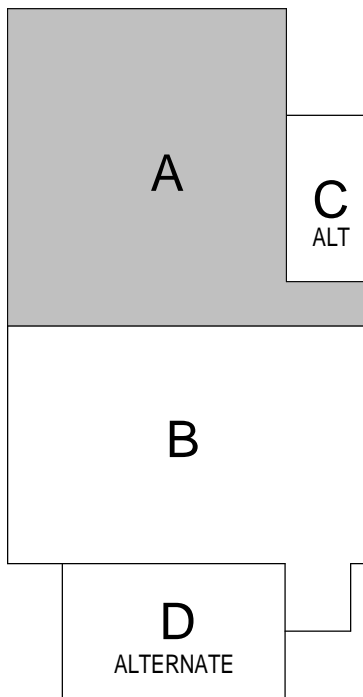

KEY PLAN

CONSTRUCTION DOCUMENTS

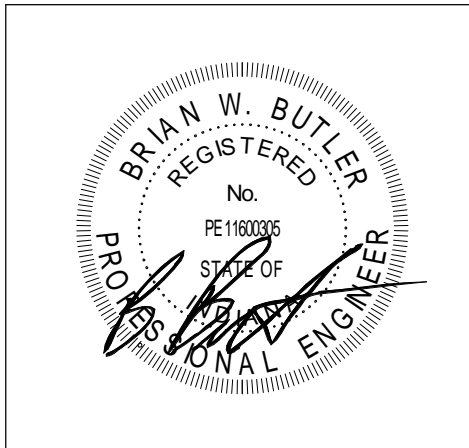

PROJECT MANAGER: MKS
DRAWN BY: CDT
PROJECT NUMBER: 222130.00
PROJECT ISSUE DATE: 1.13.2024

REV. NO.	DESCRIPTION	DATE
1	Addendum #1	1.26.2024
2	Addendum #2	2.2.2024

FIRST FLOOR TECHNOLOGY PLAN - UNIT A

T-11A

ROOM LEGEND			
ROOM NO.	OWNER	ROOM NAME	AREA (SF)
A101	102	FIELDHOUSE	5428 SF
A102	-	CORRIDOR	328 SF
A103	-	CORRIDOR	296 SF
A104	117	TRAINING	416 SF
A105	117B	ELECTRICAL	182 SF
A106	116	TOILET	81 SF
A107	117A	LAUNDRY	144 SF
S-1	STAIR 2	STAIR	81 SF

TECHNOLOGY PLAN GENERAL NOTES

- A. DEVICES SHALL BE INSTALLED AT LOCATIONS SHOWN ON DRAWINGS. LOCATIONS OF DEVICES SHALL BE COORDINATED WITH OTHER ELECTRICAL DEVICES/ CASEWORK/ ARCHITECTURAL FEATURES AND OTHER TRADES PRIOR TO ROUGH-IN. IF RELOCATION OF DEVICES IS REQUIRED DUE TO LACK OF COORDINATION BETWEEN ELECTRICAL DRAWINGS AND OTHER TRADES, ANY ASSOCIATED COSTS SHALL BE RESPONSIBILITY OF ELECTRICAL CONTRACTOR.
- B. CAT6A PATCH CORDS TO BE PROVIDED BY OTHERS. NETWORK EQUIPMENT AND WIRELESS ACCESS POINTS TO BE PROVIDED BY OWNER. INSTALLATION, TERMINATION, LABELING AND TESTING OF CABLING BY DIVISION 27 CONTRACTOR.
- C. CLASSROOM PROJECTORS AND SOUND REINFORCEMENT KITS TO BE PROVIDED TURNKEY BY THE DIVISION 27 CONTRACTOR. DIV 27 IS RESPONSIBLE FOR INSTALLATION AND TERMINATION OF ALL CONNECTIVITY WIRING NEEDED AS SHOWN ON DETAILS.
- D. ACCESS CONTROL IS ROUGH-IN WIRING ONLY AS SHOWN ON DETAILS. KANTECH SYSTEM EQUIPMENT AND PROGRAMMING TO BE PROVIDED BY OTHERS. (WIRELESS TECHNOLOGY SOLUTIONS)
- E. DOOR CONTACTS AND WIRING TO BE PROVIDED BY DOOR HARDWARE (087100) CONTRACTOR.
- F. VIDEO SURVEILLANCE EXAMVISION CAMERAS TO BE PROVIDED BY OTHERS. WIRELESS TECHNOLOGY SOLUTIONS) INSTALLATION, TERMINATION, LABELING AND TESTING OF CABLING BY DIVISION 27 CONTRACTOR. FIELDHOUSE FLOOR BOXES WILL HAVE ONE EMPTY CONDUIT TO EACH ONE FOR FUTURE TECH CABLES.
- H.

TECHNOLOGY PLAN NOTES

(ALL NOTES MAY NOT BE INDICATED ON THIS SHEET)

NOTE

- T10 PROVIDE CATEGORY 6A DATA FOR WIRELESS ACCESS POINTS. PROVIDE 20FT. SLACK LOOP COILED NEATLY AND SUPPORTED ABOVE THE CEILING. TERMINATE CABLES AND TEST PER SPECIFICATIONS. NOTE LOCATION ON RECORD DRAWINGS AND MARK LOCATION ON CEILING GRID WITH BLUE DOT. SLACK LOOP NOT NECESSARY FOR LOCATIONS WITH CONDUIT. SUCH AS GYMNASIUMS.
- T18 ALL FLOORBOXES IN FIELDHOUSE WILL HAVE ONE EMPTY CONDUIT TO EACH BOX FOR FUTURE DATA CABLING.

VERIFICATION NOTE

CONTRACTOR SHALL VERIFY ALL DIMENSIONS AND CLEARANCES AND ALL EXISTING FIELD CONDITIONS BEFORE STARTING CONSTRUCTION. COMMENCEMENT OF WORK CONSTITUTES ACCEPTANCE OF CONDITIONS.

SHOULD DIFFERENT CONDITIONS BE ENCOUNTERED, CONTACT THE ARCHITECT BEFORE PROCEEDING WITH WORK.

ROOM LEGEND			
ROOM NO.	OWNER ROOM NO.	ROOM NAME	AREA (SF)
B110	111	TOILET	63 SF
B111	110	TOILET	63 SF
B112	109	GIRLS RESTROOM	398 SF
B113	108	FIRE RISER	304 SF
B114	107	BOYS RESTROOM	270 SF
B115	108	STORAGE	127 SF
B116	105	CUSTOMER	68 SF
B117	104	CONCESSION	293 SF
B118	103	OFFICE	341 SF
B119	-	LOBBY	1039 SF
B120	-	VESTIBULE	1369 SF
B121	101	STAIR	157 SF
S-2	STAIR 1	STAIR	115 SF

DEVICES SHALL BE INSTALLED AT LOCATIONS SHOWN ON DRAWINGS. LOCATIONS OF DEVICES SHALL BE PROVIDED BY OTHERS. WIRING SHALL BE PROVIDED BY OTHERS. THE CONTRACTOR SHALL PROVIDE THE CASEWORK ARCHITECTURAL FEATURES AND OTHER TRADINGS PRIOR TO ROUGH-IN. IF RELOCATION OF DEVICES IS REQUIRED TO LAID OUT THE SYSTEM, THE CONTRACTOR SHALL BE RESPONSIBLE FOR THE RELOCATION OF ELECTRICAL DRAWINGS AND OTHER TRADES. ANY RELOCATION SHALL BE THE RESPONSIBILITY OF ELECTRICAL CONTRACTOR.

CATCH PADS COVERED TO BE PROVIDED BY OTHERS. THE CONTRACTOR SHALL BE RESPONSIBLE FOR THE POINTS TO BE PROVIDED BY OWNER. INSTALLATION, TERMINATION, LABELING AND TESTING OF CABLE BY DIVISION 27 CONTRACTOR.

CLASSROOM PROJECTORS AND SOUND REINFORCEMENT KITS TO BE PROVIDED TURNKEY BY THE DIVISION 27 CONTRACTOR. THE CONTRACTOR SHALL BE RESPONSIBLE FOR THE INSTALLATION AND TERMINATION OF ALL CONNECTIVITY WIRING NEEDED FOR ALL METALS.

ACCESS CONTROL IS ROUGH-IN WIRING ONLY AS SHOWN ON DETAILS. KATECH SYSTEM EQUIPMENT AND ACCESS CONTROL TO BE PROVIDED BY OTHERS. (WIRELESS TECHNOLOGY SOLUTIONS)

DOOR CONTACTS AND WIRING TO BE PROVIDED BY DOOR SCHEDULING CONTRACTOR.

VIDEO SURVEILLANCE EXAMINATION CAMERAS TO BE PROVIDED BY OTHERS. WIRING SHALL BE PROVIDED BY OTHERS. INSTALLATION, TERMINATION, LABELING AND TESTING OF CABLES BY DIVISION 27 CONTRACTOR. FIELD AND DOOR SCHEDULING CONTRACTOR SHALL BE REQUIRED TO CONDUCT EACH ONE FOR FUTURE TASKS.

12641 McKinley Highway, Mishawaka,
Indiana 46545



**FANNING
HOWEY**

A diagram showing a 2x2 grid of cells. The top-left cell is white and labeled 'A'. The top-right cell is white and labeled 'C' with 'ALT' written below it. The bottom-left cell is gray and labeled 'B'. The bottom-right cell is white and labeled 'D' with 'ALTERNATE' written below it.



A circular professional engineer seal for Brian W. Butler. The outer ring contains the text "BRIAN W. BUTLER" at the top and "REGISTERED PROFESSIONAL ENGINEER" at the bottom. Inside the ring, the word "No." is above the number "PE 11803035", which is above the words "STATE OF". A signature is written across the center of the seal.


REV. NO.△	DESCRIPTION	DATE
1	Addendum #1	1.26.2024
2	Addendum #2	2.2.2024

**FIRST FLOOR TECHNOLOGY PLAN -
UNIT B**

VERIFICATION NOTE

CONTRACTOR SHALL VERIFY ALL DIMENSIONS AND CLEARANCES AND ALL EXISTING FIELD CONDITIONS BEFORE STARTING CONSTRUCTION. COMMENCEMENT OF WORK CONSTITUTES ACCEPTANCE OF CONDITIONS.

SHOULD DIFFERENT CONDITIONS BE ENCOUNTERED, CONTACT THE ARCHITECT BEFORE PROCEEDING WITH WORK.

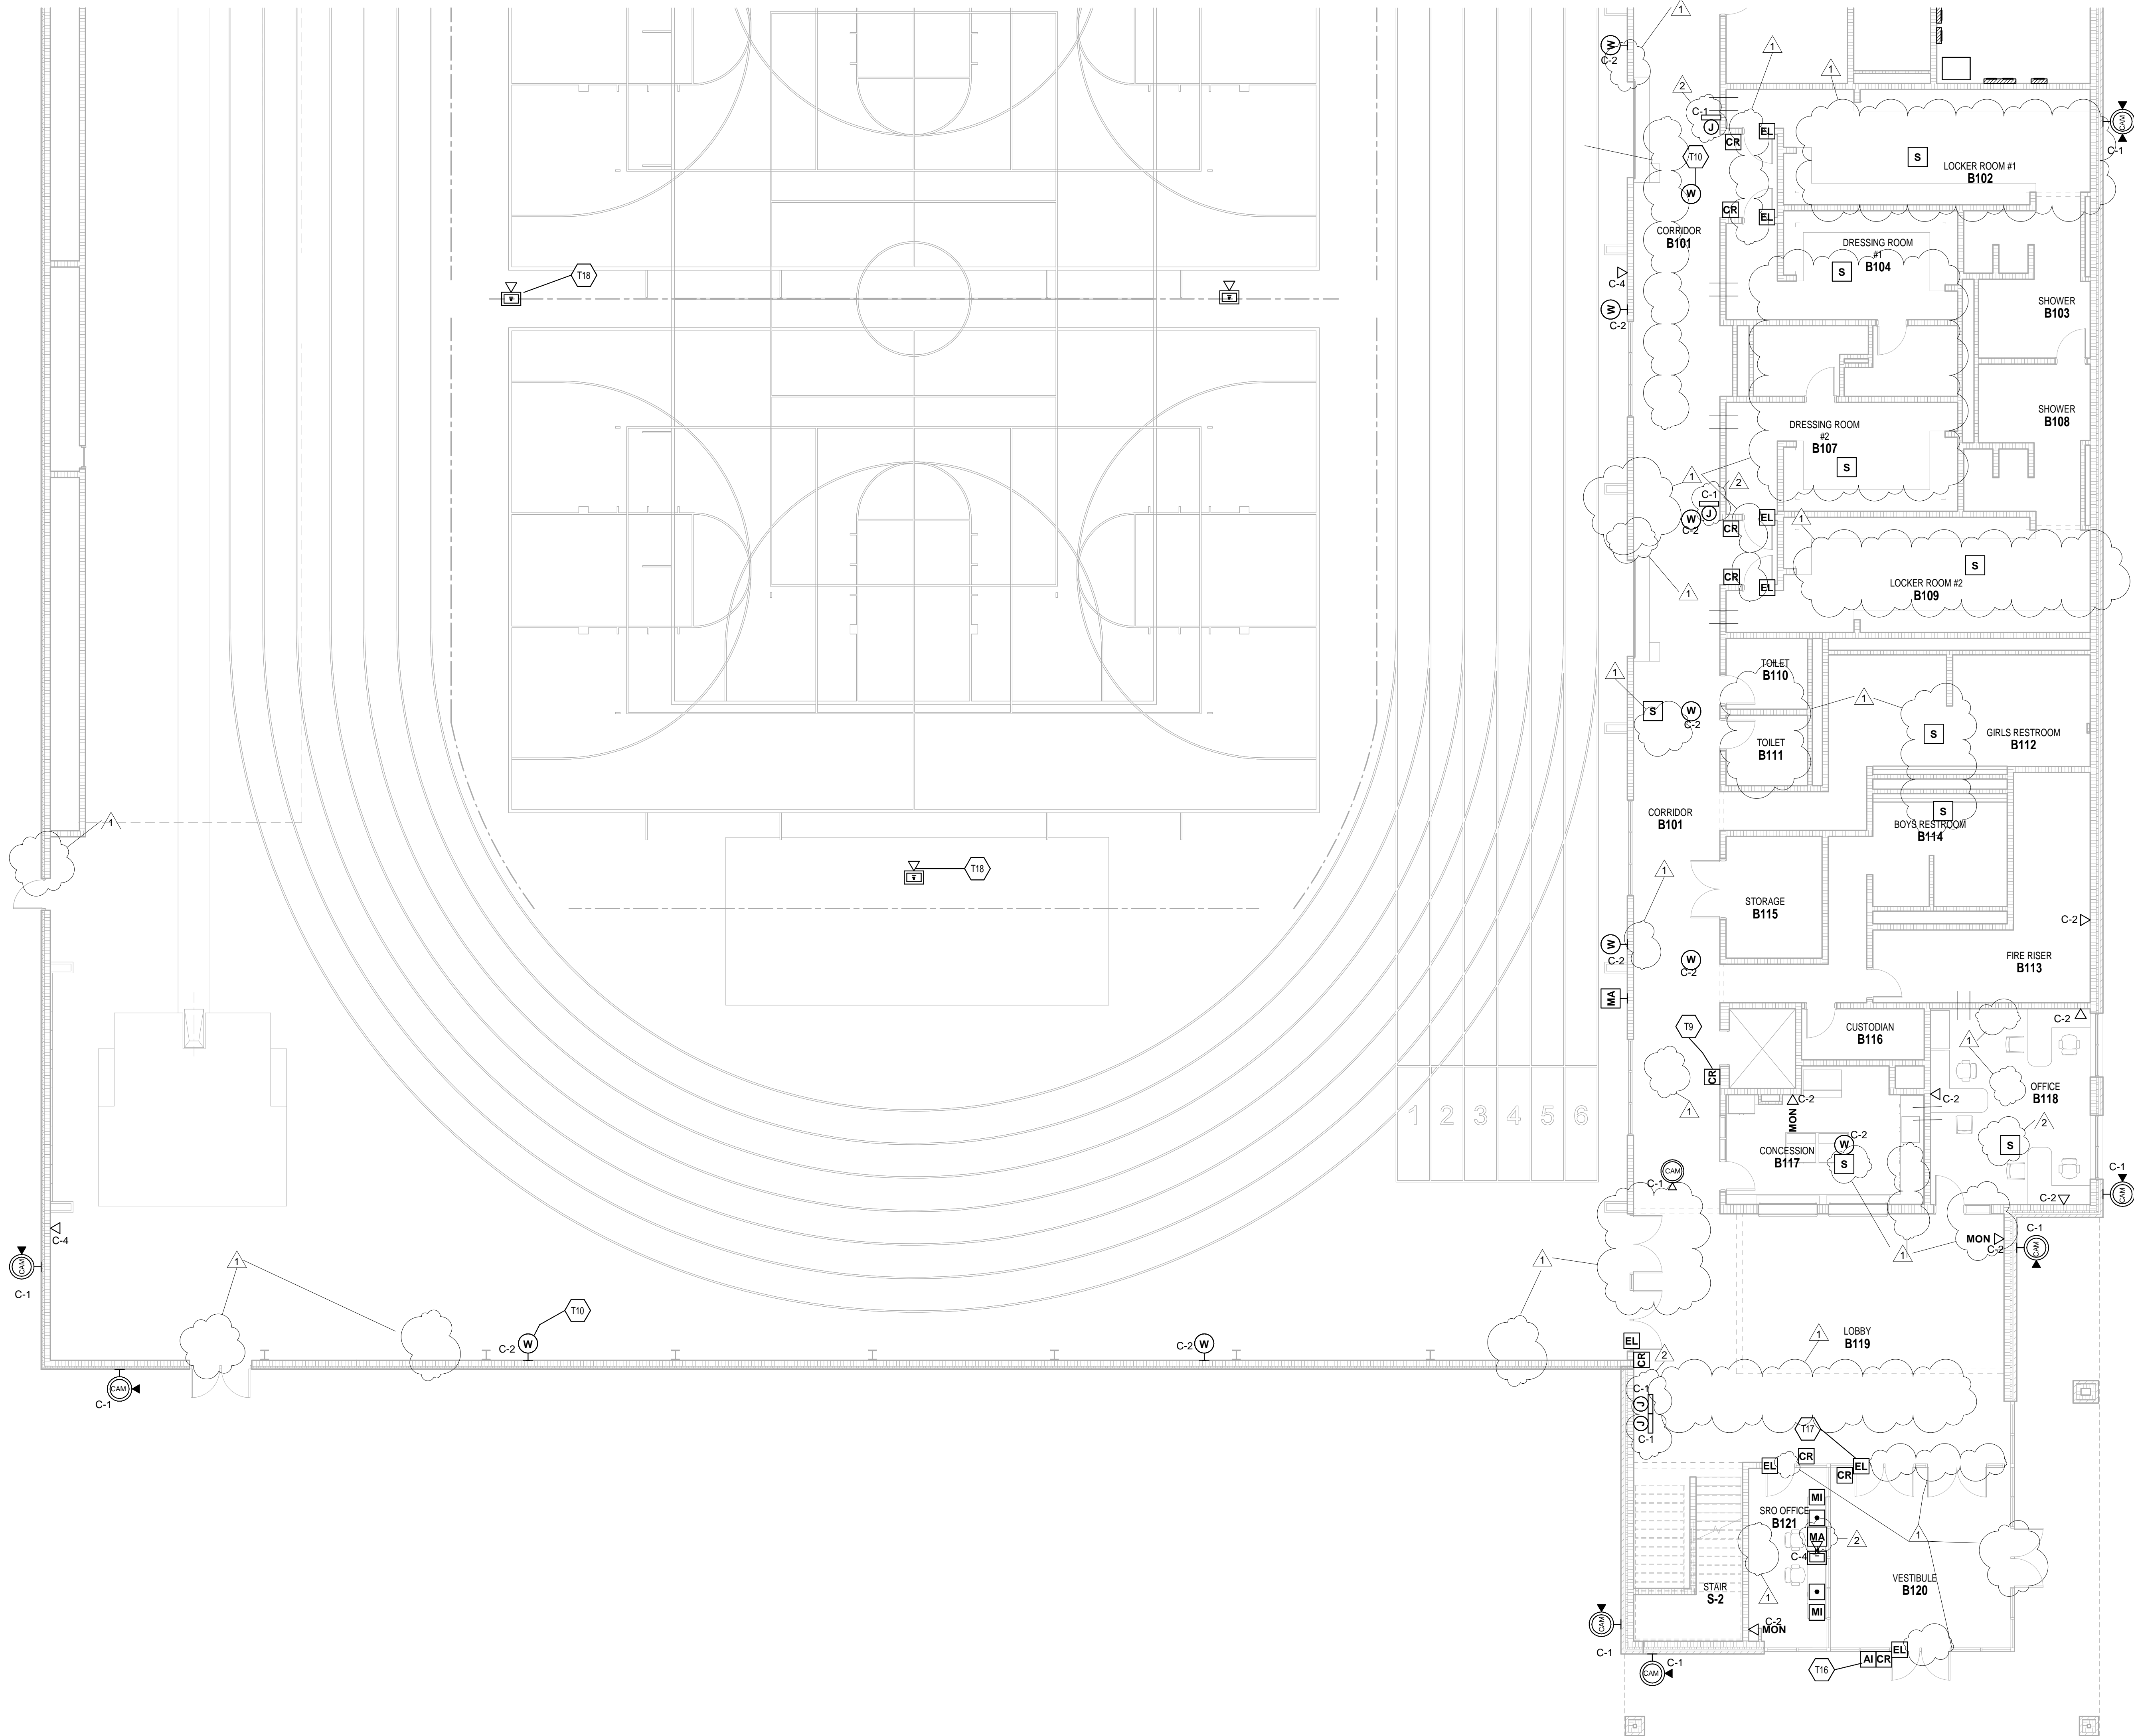

ROOM LEGEND			
ROOM NO.	OWNER ROOM NO.	ROOM NAME	AREA (SF)
A101	102	FIELDHOUSE	54239 SF
A102	-	CORRIDOR	328 SF
A103	-	CORRIDOR	286 SF
A104	117	TRAINING	416 SF
B119	-	LOBBY	1039 SF
S-1	STAIR 2	STAIR	81 SF
S-2	STAIR 1	STAIR	116 SF

ROOM LEGEND			
ROOM NO.	OWNER ROOM NO.	ROOM NAME	AREA (SF)

TECHNOLOGY PLAN GENERAL NOTES

- A. DEVICES SHALL BE INSTALLED AT LOCATIONS SHOWN ON DRAWINGS. LOCATIONS OF DEVICES SHALL BE COORDINATED WITH OTHER ELECTRICAL DEVICES/ CASEWORK ARCHITECTURE. RELOCATION OF DEVICES PRIOR TO ROUGH-IN. IF RELOCATION OF DEVICES IS REQUIRED DUE TO CLASHES WITH OTHER ELECTRICAL DRAWINGS AND OTHER TRADES, ANY ASSOCIATED COSTS SHALL BE RESPONSIBILITY OF ELECTRICAL CONTRACTOR.
- B. CAT6A PATCH CORDS TO BE PROVIDED BY OTHERS. EQUIPMENT CORDS TO BE PROVIDED BY OTHERS. PATCH CORDS ARE TO BE PROVIDED BY OWNER. INSTALLATION, TERMINATION, LABELING AND TESTING OF CABLEING BY DIVISION 27 CONTRACTOR.
- C. CLASSROOM PROJECTORS AND SOUND REINFORCEMENT KEYS TO BE PROVIDED TURNKEY BY THE DIVISION 27 CONTRACTOR. DIV 27 IS RESPONSIBLE FOR INSTALLATION AND TERMINATION OF ALL CONNECTIVITY WIRING NEEDED FOR ALL CABLES ON DETAILS.
- D. ACCESS CONTROL IS ROUGH-IN WIRING ONLY AS SHOWN ON DETAILS. KANTech SYSTEM EQUIPMENT AND HARDWARE TO BE PROVIDED BY OTHERS. (WIRELESS TECHNOLOGY SOLUTIONS)
- E. DOOR CONTACTS AND WIRING TO BE PROVIDED BY DOOR SUPPLIER. (80 TO CONTRACTOR)
- F. VIDEO SURVEILLANCE EXAMINATION CAMERAS TO BE PROVIDED BY OTHERS. (WIRELESS TECHNOLOGY SOLUTIONS) INSTALLATION, LABELING AND TESTING OF CABLEING BY DIVISION 27 CONTRACTOR.
- G. BUILDING FLOOR BOILING WATER/STEAM PIPING CONDUIT TO EACH ONE FOR FUTURE TECH CABLES.

COPYRIGHT 2024 BY FANNING/HOWEY ASSOCIATES, INC.

**PENN HIGH
SCHOOL
FIELDHOUSE**

12641 McKinley Highway, Mishawaka,
Indiana 46545

**PENN-HARRIS-MADISON
SCHOOL CORPORATION**




ARCHITECT



**FANNING
HOWEY**

317.848.0966 WWW.FHAI.COM
350 E NEW YORK ST #300, INDIANAPOLIS, IN 46204

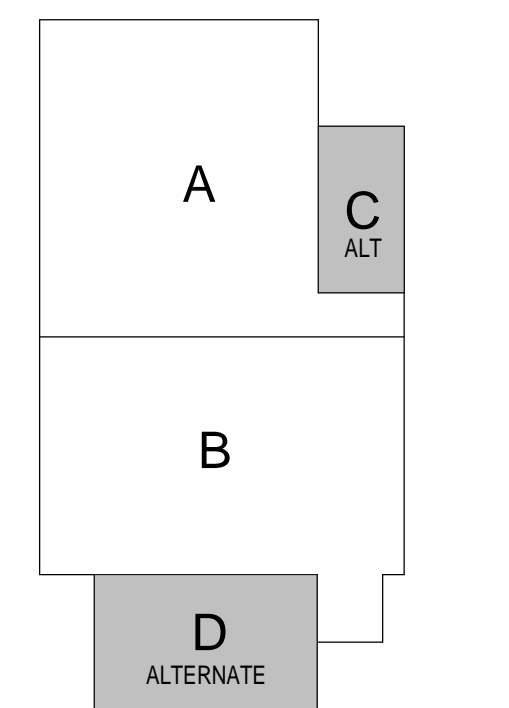

KEY PLAN

CONSTRUCTION DOCUMENTS



PROJECT MANAGER: MKS
DRAWN BY: CDT
PROJECT NUMBER: 222130.00
PROJECT ISSUE DATE: 1.13.2024

[illegible]


**FIRST FLOOR TECHNOLOGY PLAN -
UNIT C & D ALT**

T-11C

TECHNOLOGY PLAN NOTES


(ALL NOTES MAY NOT BE INDICATED ON THIS SHEET)

#	NOTE
T7	SEE DETAIL 2/T-503 FOR WRESTLING AND DANCE ROOM SOUND SYSTEMS.
T19	COORDINATE WITH ELECTRICAL AND GENERAL CONTRACTOR ON SCOREBOARD CABLE TERMINATIONS.
T21	PROVIDE OPEN 24X24X24 DATA RACKS FOR THE SOUND SYSTEM IN THIS CLOSET.

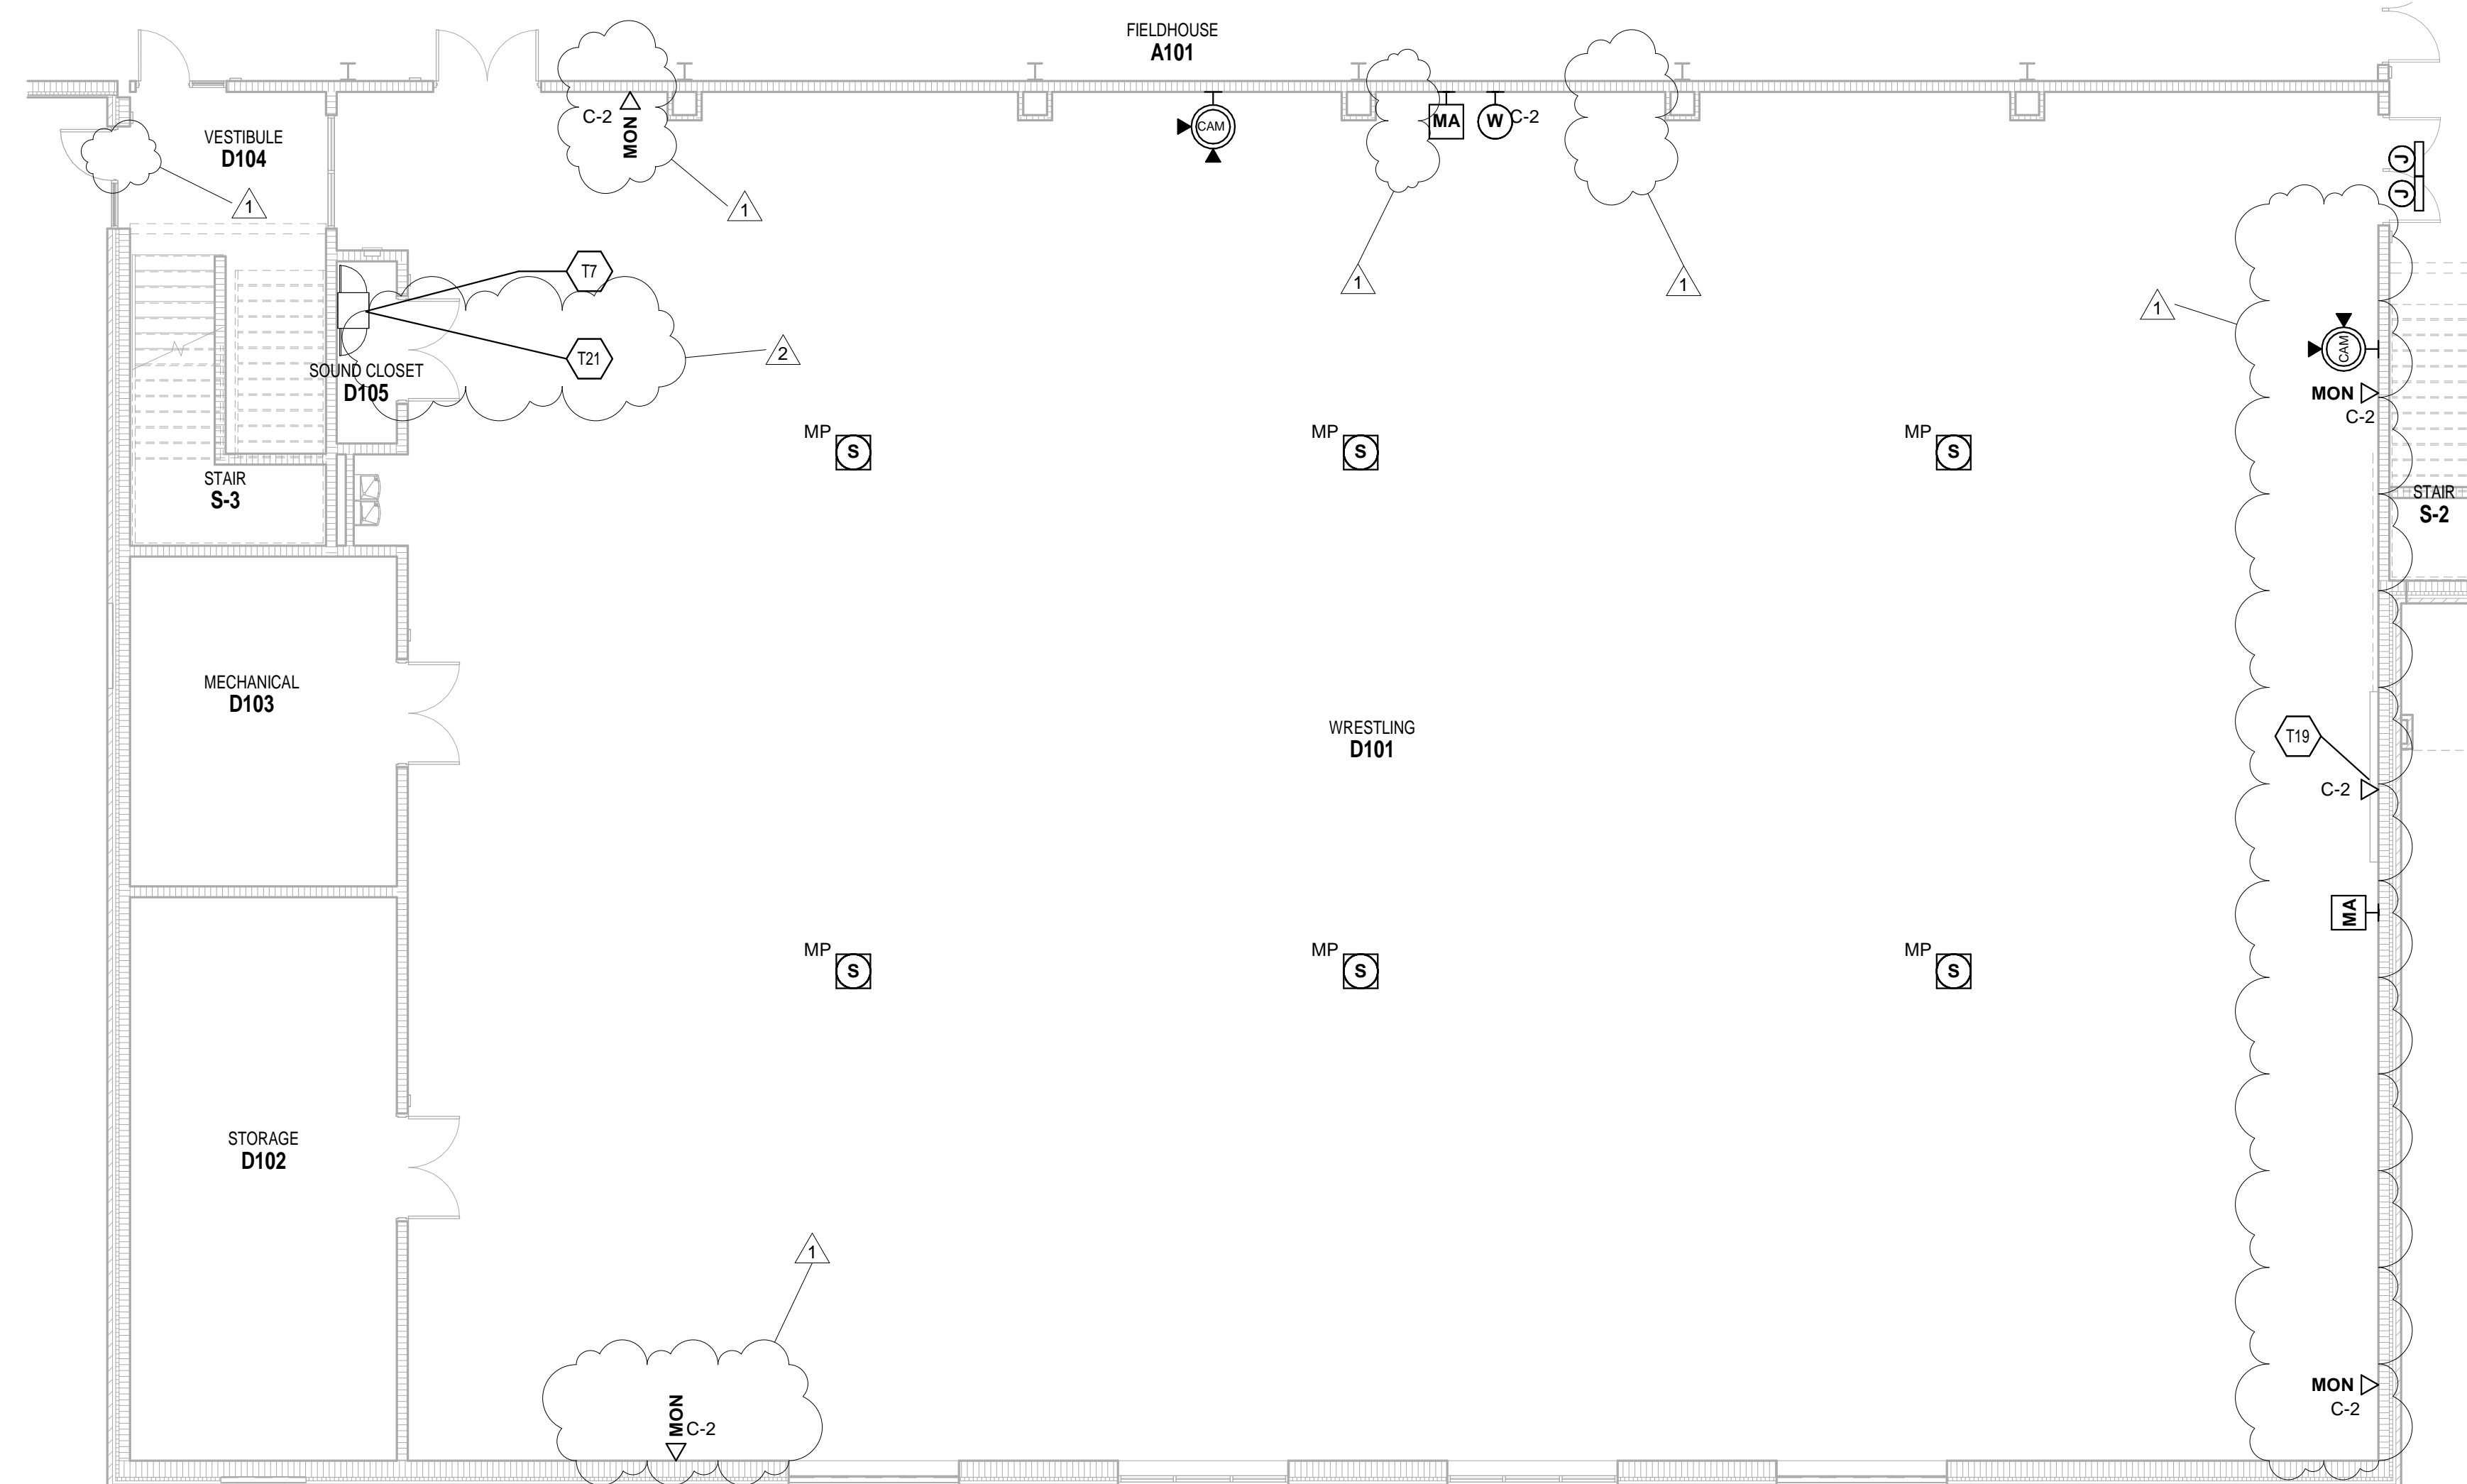

2 FIRST FLOOR TECHNOLOGY PLAN - UNIT D ALTERNATE
SCALE: 1/8" = 1'-0"

SCALE: 1/8" = 1'-0"

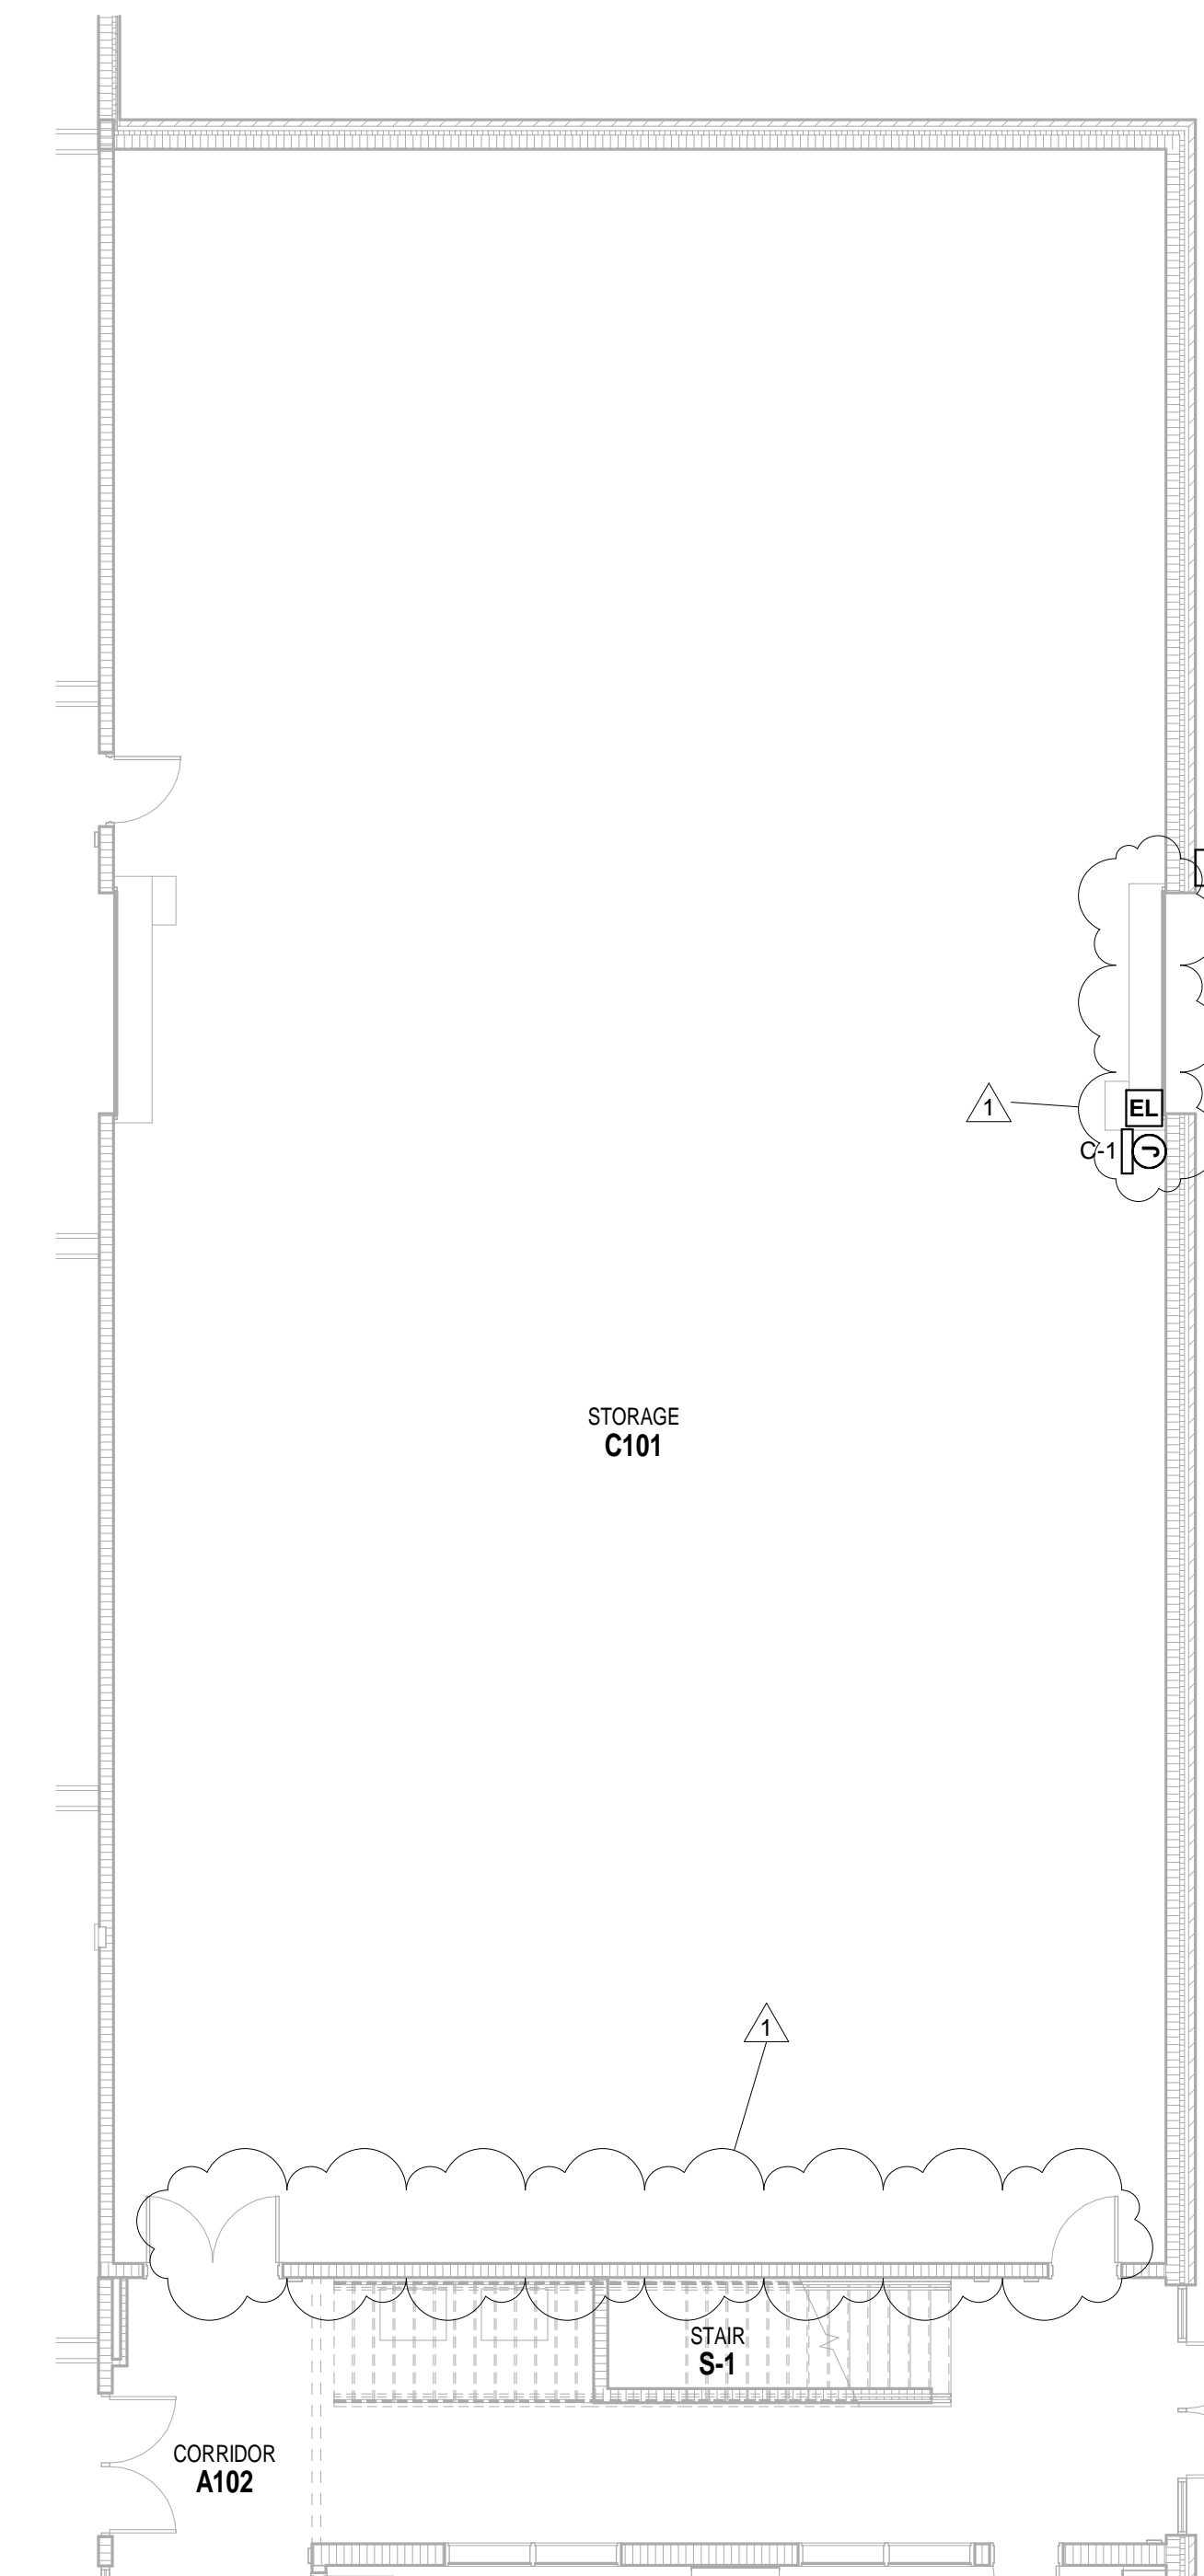

1 FIRST FLOOR TECHNOLOGY PLAN - UNIT C ALTERNATE
SCALE: 1/8" = 1'-0"

SCALE: 1/8" = 1'-0"

VERIFICATION NOTE

CONTRACTOR SHALL VERIFY ALL DIMENSIONS AND CLEARANCES AND ALL EXISTING FIELD CONDITIONS BEFORE STARTING CONSTRUCTION. COMMENCEMENT OF WORK CONSTITUTES ACCEPTANCE OF CONDITIONS.

SHOULD DIFFERENT CONDITIONS BE ENCOUNTERED, CONTACT THE ARCHITECT BEFORE PROCEEDING WITH WORK.

