

ADDENDUM NO. 2


LEBANON PUBLIC LIBRARY BUILDING RENOVATIONS & SITE IMPROVEMENTS 2024

104 E. Washington Street
Lebanon, Indiana, 46052

OMS PROJECT NO. 23031

DATE OF ADDENDUM

ODLE McGUIRE SHOOK
7222 N. SHADELAND AVE., SUITE 100
INDIANAPOLIS, INDIANA 46250

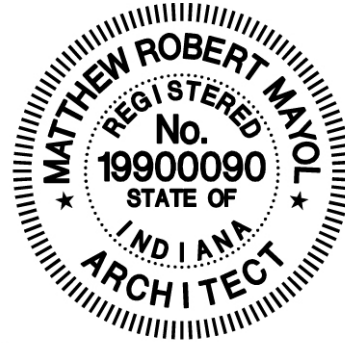

Matthew R. Mayol

Matthew R. Mayol, IN AR1900090

TO: BIDDERS OF RECORD

This Addendum changes and modifies the Bidding Documents dated February 29, 2024 and will become a part of the Contract Documents.

Acknowledge receipt of this Addendum in the space provided on the Bid Form. Failure to do so may subject the Bidder to disqualification.

This Addendum consists of: Page ADD.2-1

GENERAL

1. none


CHANGES TO SPECIFICATIONS:

1. none

CHANGES TO DRAWINGS:

1. Drawing G003:
 - A. Replace sheet in it's entirety.
2. Drawing L100: Irrigation Plan
 - A. Replace sheet in it's entirety.
3. Drawing L200: Landscape Plan
 - A. Remove four (4) plant beds along street.

END OF ADDENDUM NO. 2

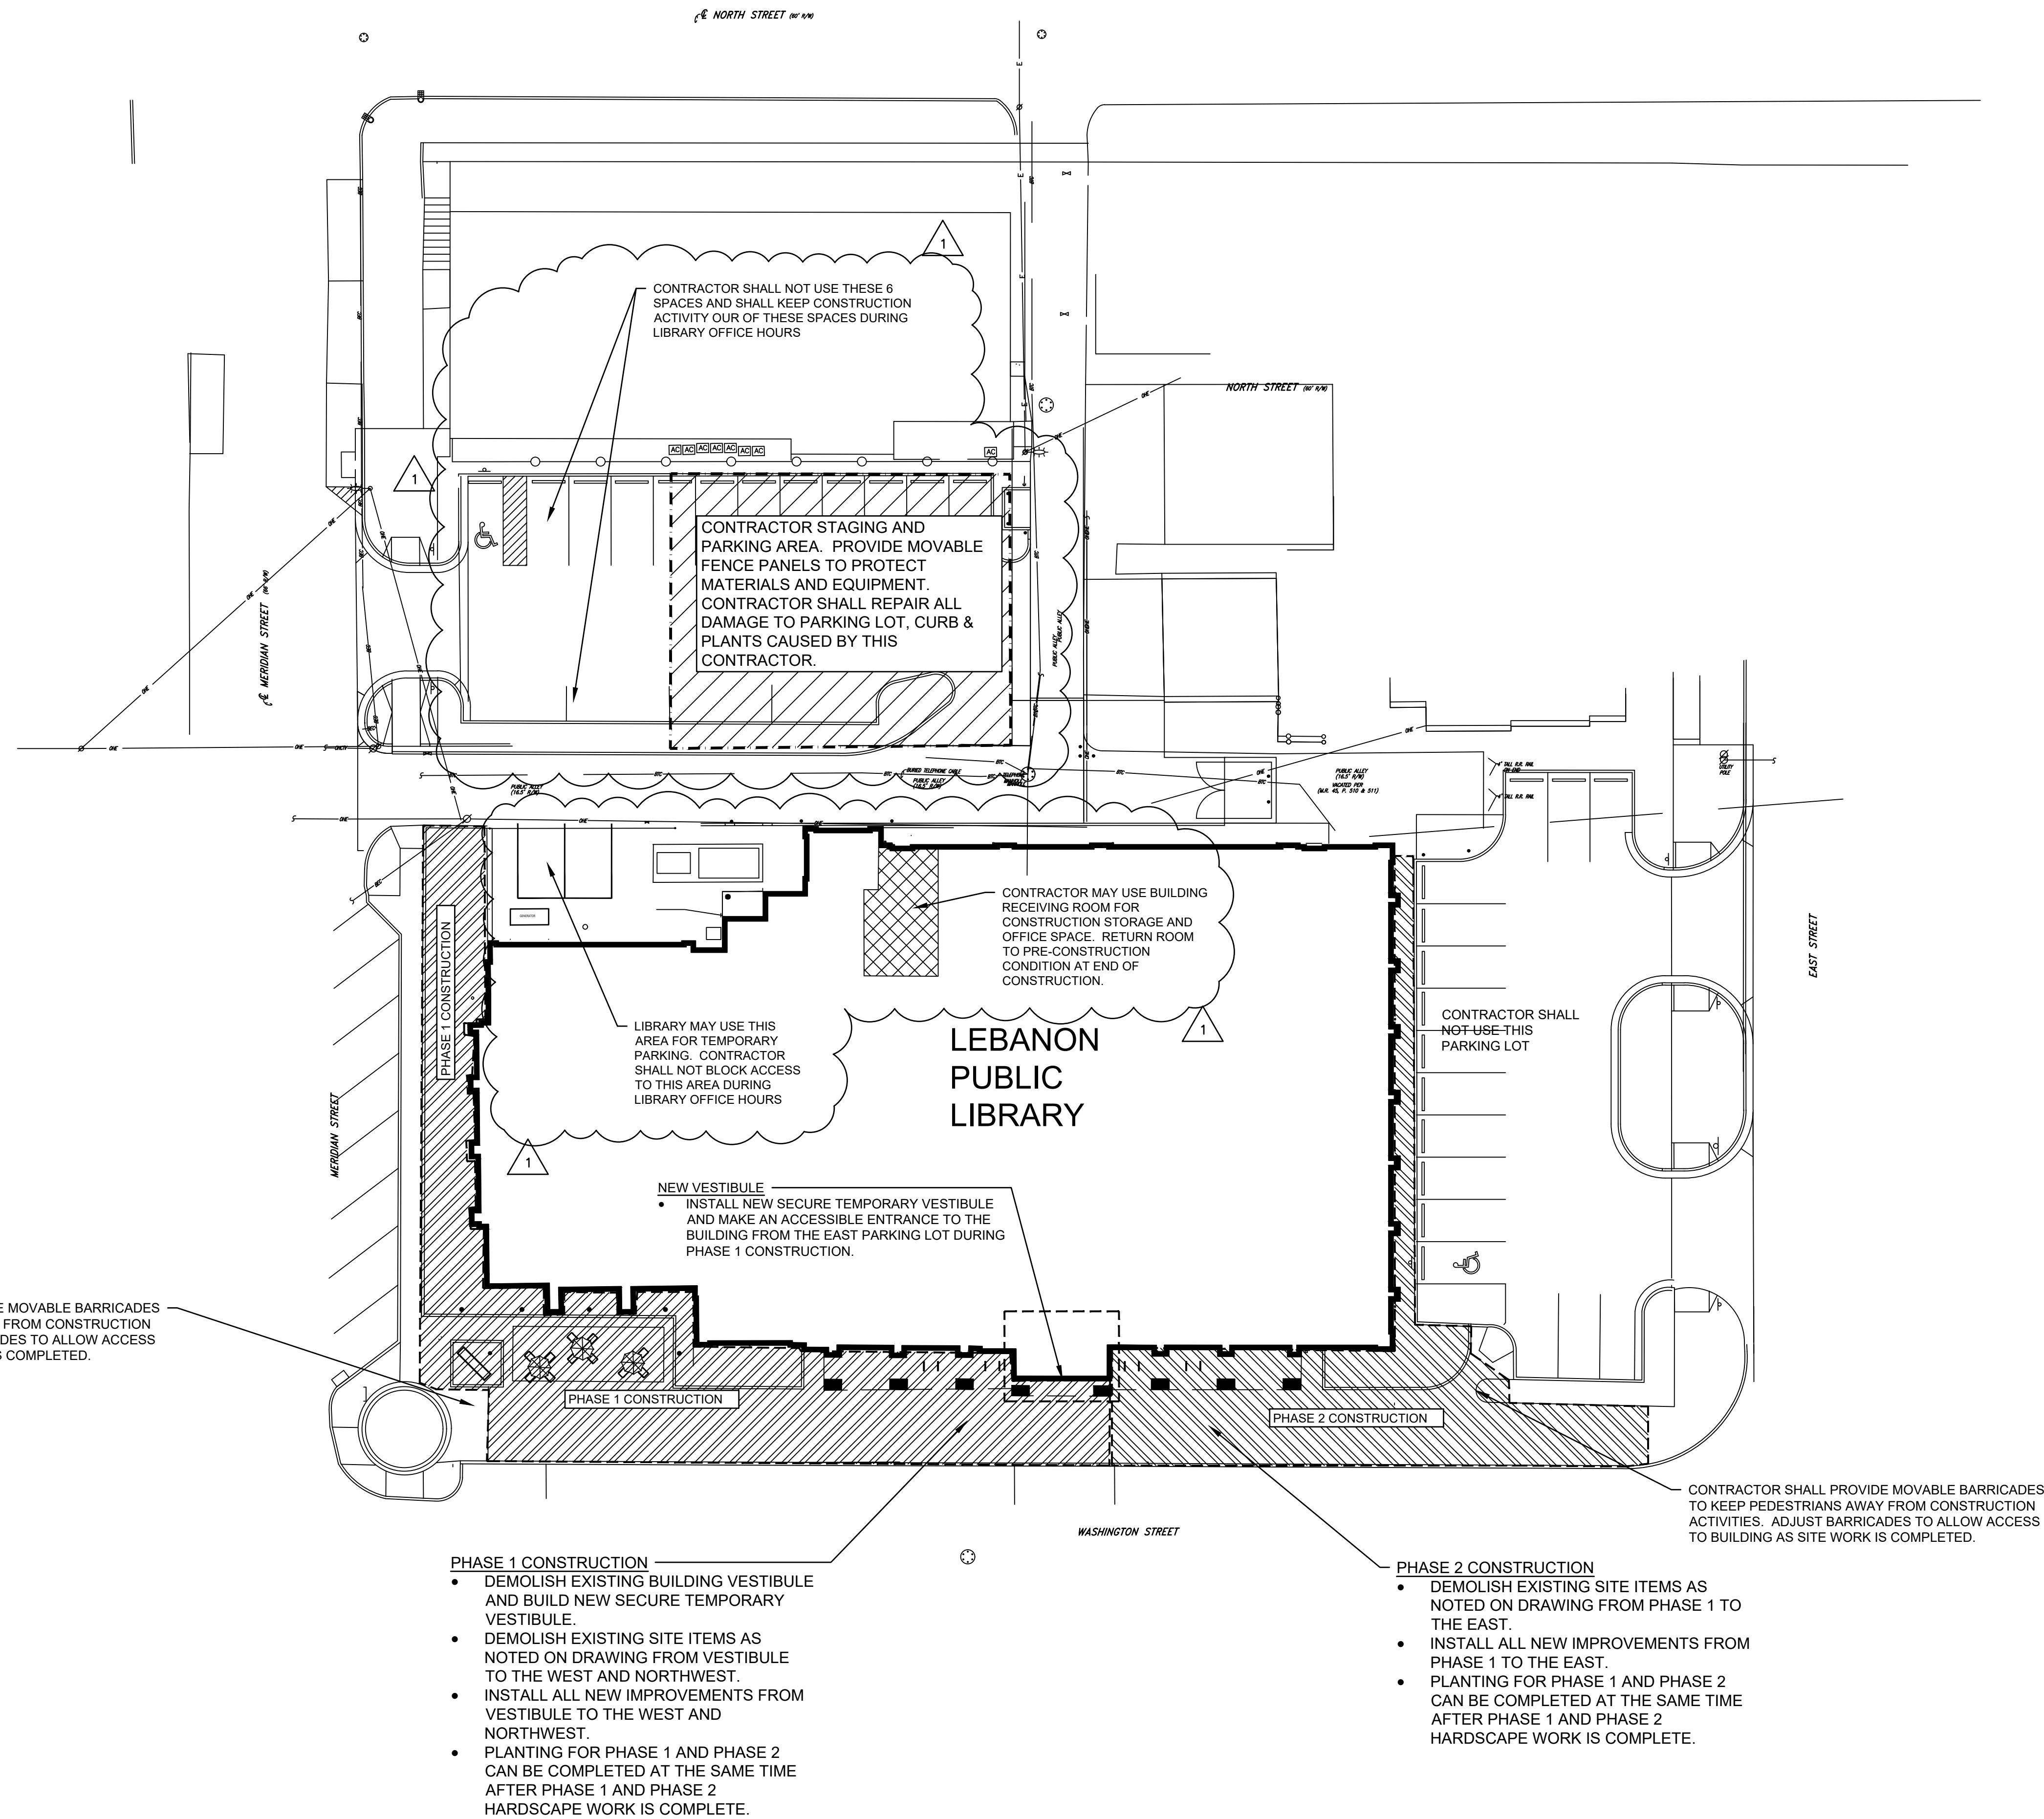

GENERAL NOTES:

1. CONTRACTOR SHALL VERIFY THE LOCATION OF ALL BURIED UTILITIES PRIOR TO EXCAVATION BY CALLING UTILITY LOCATING SERVICES.
2. ALL SURVEY, PROPERTY BOUNDARY, TOPOGRAPHIC AND EXISTING UTILITY INFORMATION PROVIDED BY VITREON GROUP, INDIANAPOLIS, INDIANA.



Odle McGuire Shook
ARCHITECTURE INTERIOR DESIGN
LANDSCAPE ARCHITECTURE ENGINEERING
"A history of forward thinking..."
www.omscorp.net

7222 N Shadeland Avenue
Suite 103
Indianapolis, Indiana 46250
317.842.0000
Fax 317.917.0616
oms@omscorp.net

100%
CONSTRUCTION
DOCUMENTS



Matthew R. Mayol
CERTIFIED

No.	Description	Date
1	ADDENDUM 1	3/15/24

REVISIONS

BUILDING RENOVATIONS AND SITE
IMPROVEMENTS 2024
LEBNON PUBLIC LIBRARY

LEBANON, INDIANA

© Copyright 2024

by OGLE MCGUIRE SHOOK
Copyright includes architectural work, building design,
plans or drawings, and specifications. Architectural
work is the overall form as well as the arrangement
and composition of spaces and elements in the design.
Reproduction without written permission is prohibited.

Project number: 23031
Date: FEB. 16, 2024


Drawn by: BWR
Checked by: MRM
Designed by: BWR

G003

CONTRACTOR STAGING &
CONSTRUCTION PHASING PLAN

CONTRACTOR STAGING & CONSTRUCTION PHASING PLAN

SCALE: 1" = 20'-0"

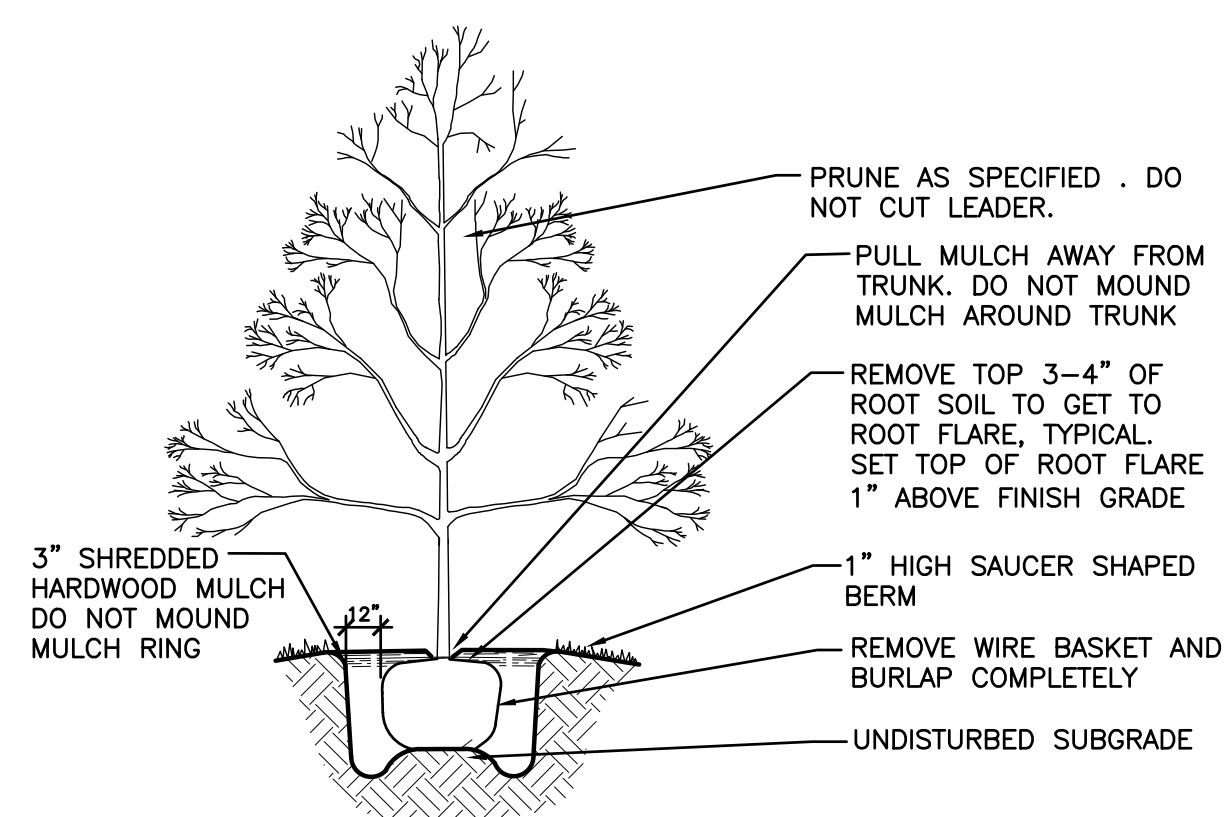

PLANT SCHEDULE						
QUANTITY:	SYMBOL:	BOTANICAL NAME:	COMMON NAME:	SIZE - CONDITION:	REMARKS:	
ORNAMENTAL TREES						
3	CFR	Cornus florida rubra	Pink Flowering Dogwood	2" cal.	B&B	Single trunk
EVERGREEN SHRUBS						
29 44	BK IGC	Buxus k. 'Green Velvet' Ilex glabra 'Chamzin'	Green Velvet Boxwood Nordic Inkberry Holly	24" hgt. 24" hgt.	Pot Pot	Full and matched
DECIDUOUS SHRUBS						
9 16	HA HM VS	Hydrangea A. 'Annabelle' Hydrangea m. 'Big Daddy' Viburnum p.t. Snowflake	Annabelle Hydrangea Big Daddy Hydrangea Summer Snowflake Viburnum	30" hgt. 30" hgt. 30" hgt.	Pot Pot Pot/B&B	Full, 24" spread Full, 24" spread Full, 24" spread
PERENNIALS, ORNAMENTAL GRASSES, GROUNDCOVER						
31 30 6 27 27 33 11	AA AD EM MD NW RF SM	Achillea x. 'Appleblossom' Aster d. 'Woods Purple' Echinacea p. 'Magnus' Monarda d. 'Pardon My Pink' Nepeta f. 'Walker's Low' Rudbeckia f. 'Goldsturm' Salvia 'Mainacht'	Appleblossom Yarrow Woods Purple Aster Magnus Purple Coneflower Pardon My Pink Monarda Walker's Low Catmint Goldsturm Black-eyed Susan May Night Salvia	1 gal. 1 gal. 1 gal. 1 gal. 1 gal. 1 gal. 1 gal.	Pot Pot Pot Pot Pot Pot Pot	

4

3

2

NOT TO SCALE




1. CONTRACTOR SHALL VERIFY THE LOCATION OF ALL BURIED UTILITIES PRIOR TO EXCAVATION BY CALLING UTILITY LOCATING SERVICES.
2. ALL SURVEY, PROPERTY BOUNDARY, TOPOGRAPHIC AND EXISTING UTILITY INFORMATION PROVIDED BY VITREON GROUP INDIANAPOLIS, INDIANA.

LANDSCAPE NOTES:

1. ALL PLANT MATERIAL SHALL CONFORM TO ANSI Z 60-2004. TREE CALIPER SIZE SHALL BE MEASURED 12" ABOVE GRADE. MINIMUM BRANCH HEIGHT FOR TREES SHALL BE 6' ABOVE FINISH GRADE. ALL TREES, SHRUBS, PERENNIALS AND GROUNDCOVERS SHALL BE SPECIMEN OR QUALITY GRADE.
2. REMOVE EXISTING SHRUBS IN 3' X 3' AREA WHERE NEW HYDRANGEAS ARE PLANTED. PLANT NEW HYDRANGEAS. AFTER PLANTING, REMOVE WEEDS FROM THIS BED AND ADD 3" SHREDDED HARDWOOD MULCH, TYPICAL.

LANDSCAPE LEGEND:

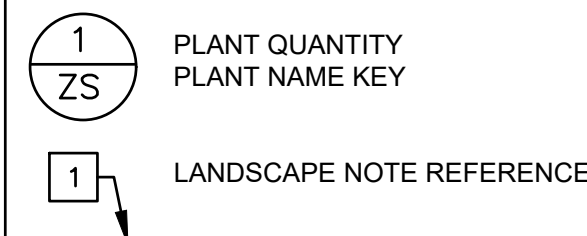


1

SCALE: 1" = 10'-0"



7222 N Shadeland Avenue
Suite 103
Indianapolis, Indiana 46250
317.842.0000
Fax 317.917.0616
oms@omscorp.net

**100%
CONSTRUCTION
DOCUMENTS**

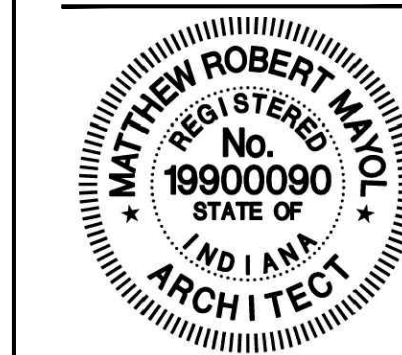

Matthew R. Mayo
CERTIFIED

[illegible]

REVISIONS

**BUILDING RENOVATIONS AND SITE
IMPROVEMENTS 2024**
LEBNON PUBLIC LIBRARY

LEBANON, INDIANA

© Copyright 202.

by ODLE McGUIRE SHOOK
Copyright includes architectural work, building design
plans or drawings, and specifications. Architectural
work is the overall form as well as the arrangement
and composition of spaces and elements in the design.
Reproduction without written permission is prohibited.

Project number: 23031
Date: **FEB. 16, 2024**

Drawn by: **BWF**
Checked by: **MRM**
Designed by: **BWF**

L200

LANDSCAPE PLAN