




**Sunman-Dearborn Community Schools
BP#1 - Early Mechanical**

ADDENDUM 1

Additional SES Updated Drawings

Date: 8/5/24

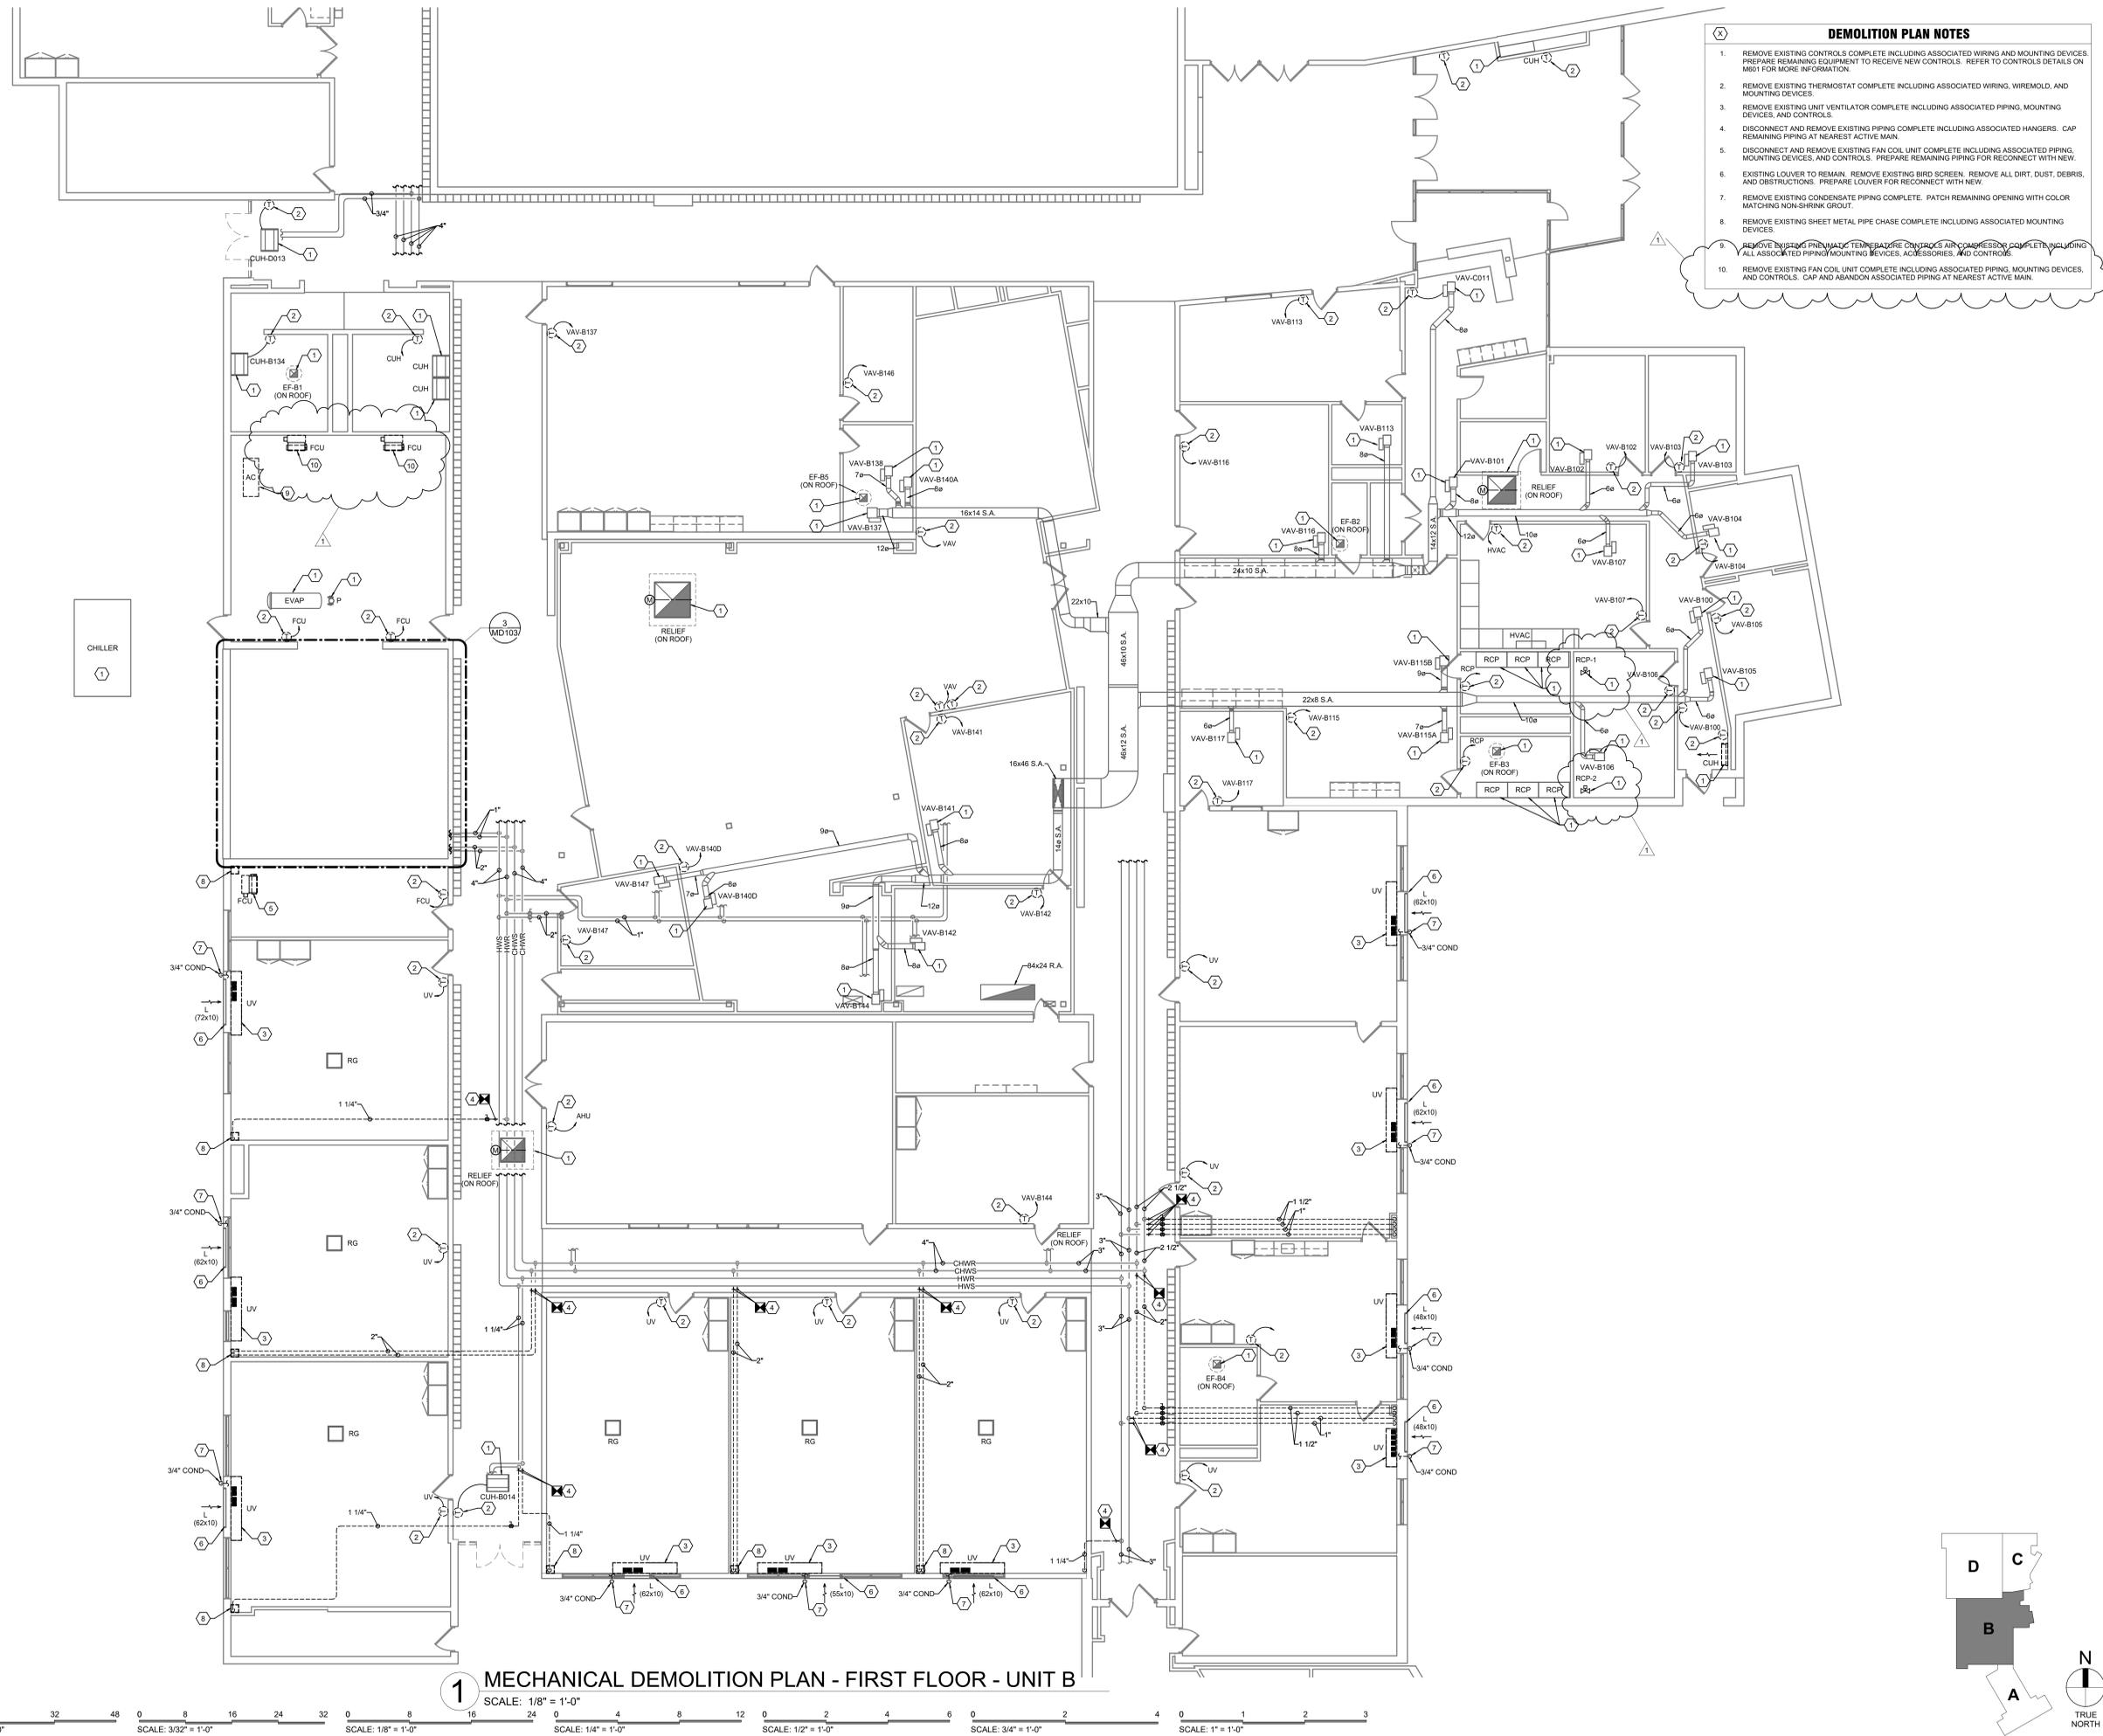

- DEMOLITION PLAN NOTES**
1. REMOVE EXISTING CONTROLS COMPLETE INCLUDING ASSOCIATED WIRING AND MOUNTING DEVICES. PREPARE REMAINING EQUIPMENT TO RECEIVE NEW CONTROLS. REFER TO CONTROLS DETAILS ON MD101 FOR MORE INFORMATION.
 2. REMOVE EXISTING THERMOSTAT COMPLETE INCLUDING ASSOCIATED WIRING, WIREMOLD, AND MOUNTING DEVICES.
 3. REMOVE EXISTING UNIT VENTILATOR COMPLETE INCLUDING ASSOCIATED PIPING, MOUNTING DEVICES, AND CONTROLS.
 4. DISCONNECT AND REMOVE EXISTING PIPING COMPLETE INCLUDING ASSOCIATED HANGERS. CAP REMAINING PIPING AT NEAREST ACTIVE MAIN.
 5. DISCONNECT AND REMOVE EXISTING FAN COIL UNIT COMPLETE INCLUDING ASSOCIATED PIPING, MOUNTING DEVICES, AND CONTROLS. PREPARE REMAINING PIPING FOR RECONNECT WITH NEW.
 6. EXISTING LOUVER TO REMAIN. REMOVE EXISTING BIRD SCREEN. REMOVE ALL DIRT, DUST, DEBRIS, AND OBSTRUCTIONS. PREPARE LOUVER FOR RECONNECT WITH NEW.
 7. REMOVE EXISTING CONDENSATE PIPING COMPLETE. PATCH REMAINING OPENING WITH COLOR MATCHING NON-SHRINK GROUT.
 8. REMOVE EXISTING SHEET METAL PIPE CHASE COMPLETE INCLUDING ASSOCIATED MOUNTING DEVICES.
 9. REMOVE EXISTING PNEUMATIC TEMPERATURE CONTROLS AIR COMPRESSOR COMPLETE INCLUDING ALL ASSOCIATED PIPING, MOUNTING DEVICES, ACCESSORIES, AND CONTROLS.
 10. REMOVE EXISTING FAN COIL UNIT COMPLETE INCLUDING ASSOCIATED PIPING, MOUNTING DEVICES, AND CONTROLS. CAP AND ABANDON ASSOCIATED PIPING AT NEAREST ACTIVE MAIN.

LANCER ASSOCIATES ARCHITECTURE
 145 NORTH EAST STREET
 INDIANAPOLIS, IN 46204

PRIMARY ENGINEERING INC.
 Fort Wayne Indianapolis
 2028 Law Ave. 9786 Cornerport Blvd., Suite 103
 Fort Wayne, Indiana 46802 Indianapolis, Indiana 46202
 316-224-0444 317-224-1221
 www.primaryeng.com www.primaryeng.com

All concepts, ideas, plans, and details as shown on this document are the sole property of Primary Engineering, Inc. and shall not be used for any other purpose without their expressed written consent. The project owner shall be permitted to retain copies for information and reference purposes.
 2024 © Primary Engineering, Inc.

**SUNMAN-DEARBORN COMM. SCHOOL CORP.
 RENOVATIONS TO SUNMAN ELEMENTARY SCHOOL**
 925 N Meridian St, Sunman, IN 47041




ASL

REVISIONS:	DATE	BY	DESCRIPTION
1	05/20/24	ADDENDUM #1	

100% CONSTRUCTION DOCUMENTS
 PROJECT: #23138
 DATE: 07/24/2024
 DRAWN BY: ASL


MECHANICAL DEMO PLAN - FIRST FLOOR - UNIT B

MD101B
 TRUE NORTH
 PRIMARY JOB # 24588

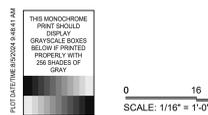

1 MECHANICAL DEMOLITION PLAN - FIRST FLOOR - UNIT B

- DEMOLITION PLAN NOTES**
- REMOVE EXISTING CONTROLS COMPLETE INCLUDING ASSOCIATED WIRING AND MOUNTING DEVICES. PREPARE REMAINING EQUIPMENT TO RECEIVE NEW CONTROLS. REFER TO CONTROLS DETAILS ON MD101 FOR MORE INFORMATION.
 - REMOVE EXISTING THERMOSTAT COMPLETE INCLUDING ASSOCIATED WIRING, WIREMOLD, AND MOUNTING DEVICES.
 - REMOVE EXISTING UNIT VENTILATOR COMPLETE INCLUDING ASSOCIATED PIPING, MOUNTING DEVICES, AND CONTROLS.
 - DISCONNECT AND REMOVE EXISTING PIPING COMPLETE INCLUDING ASSOCIATED HANGERS. CAP REMAINING PIPING AT NEAREST ACTIVE MAN.
 - REMOVE EXISTING FAN COIL UNIT COMPLETE INCLUDING ASSOCIATED PIPING, DUCTWORK, GRILLES, MOUNTING DEVICES, AND CONTROLS.
 - EXISTING LOUVER TO REMAIN. REMOVE EXISTING BIRD SCREEN. REMOVE ALL DIRT, DUST, DEBRIS, AND OBSTRUCTIONS. PREPARE LOUVER FOR RECONNECT WITH NEW.
 - REMOVE EXISTING CONDENSATE PIPING COMPLETE. PATCH REMAINING OPENING WITH COLOR MATCHING NON-SHRINK GROUT.
 - REMOVE EXISTING SHEET METAL PIPE CHASE COMPLETE INCLUDING ASSOCIATED MOUNTING DEVICES.
 - REMOVE EXISTING FINNED TUBE RADIATION COMPLETE INCLUDING ASSOCIATED PIPING, MOUNTING DEVICES, AND CONTROLS. CAP AND ABANDON REMAINING PIPING AT FLOOR PENETRATION.

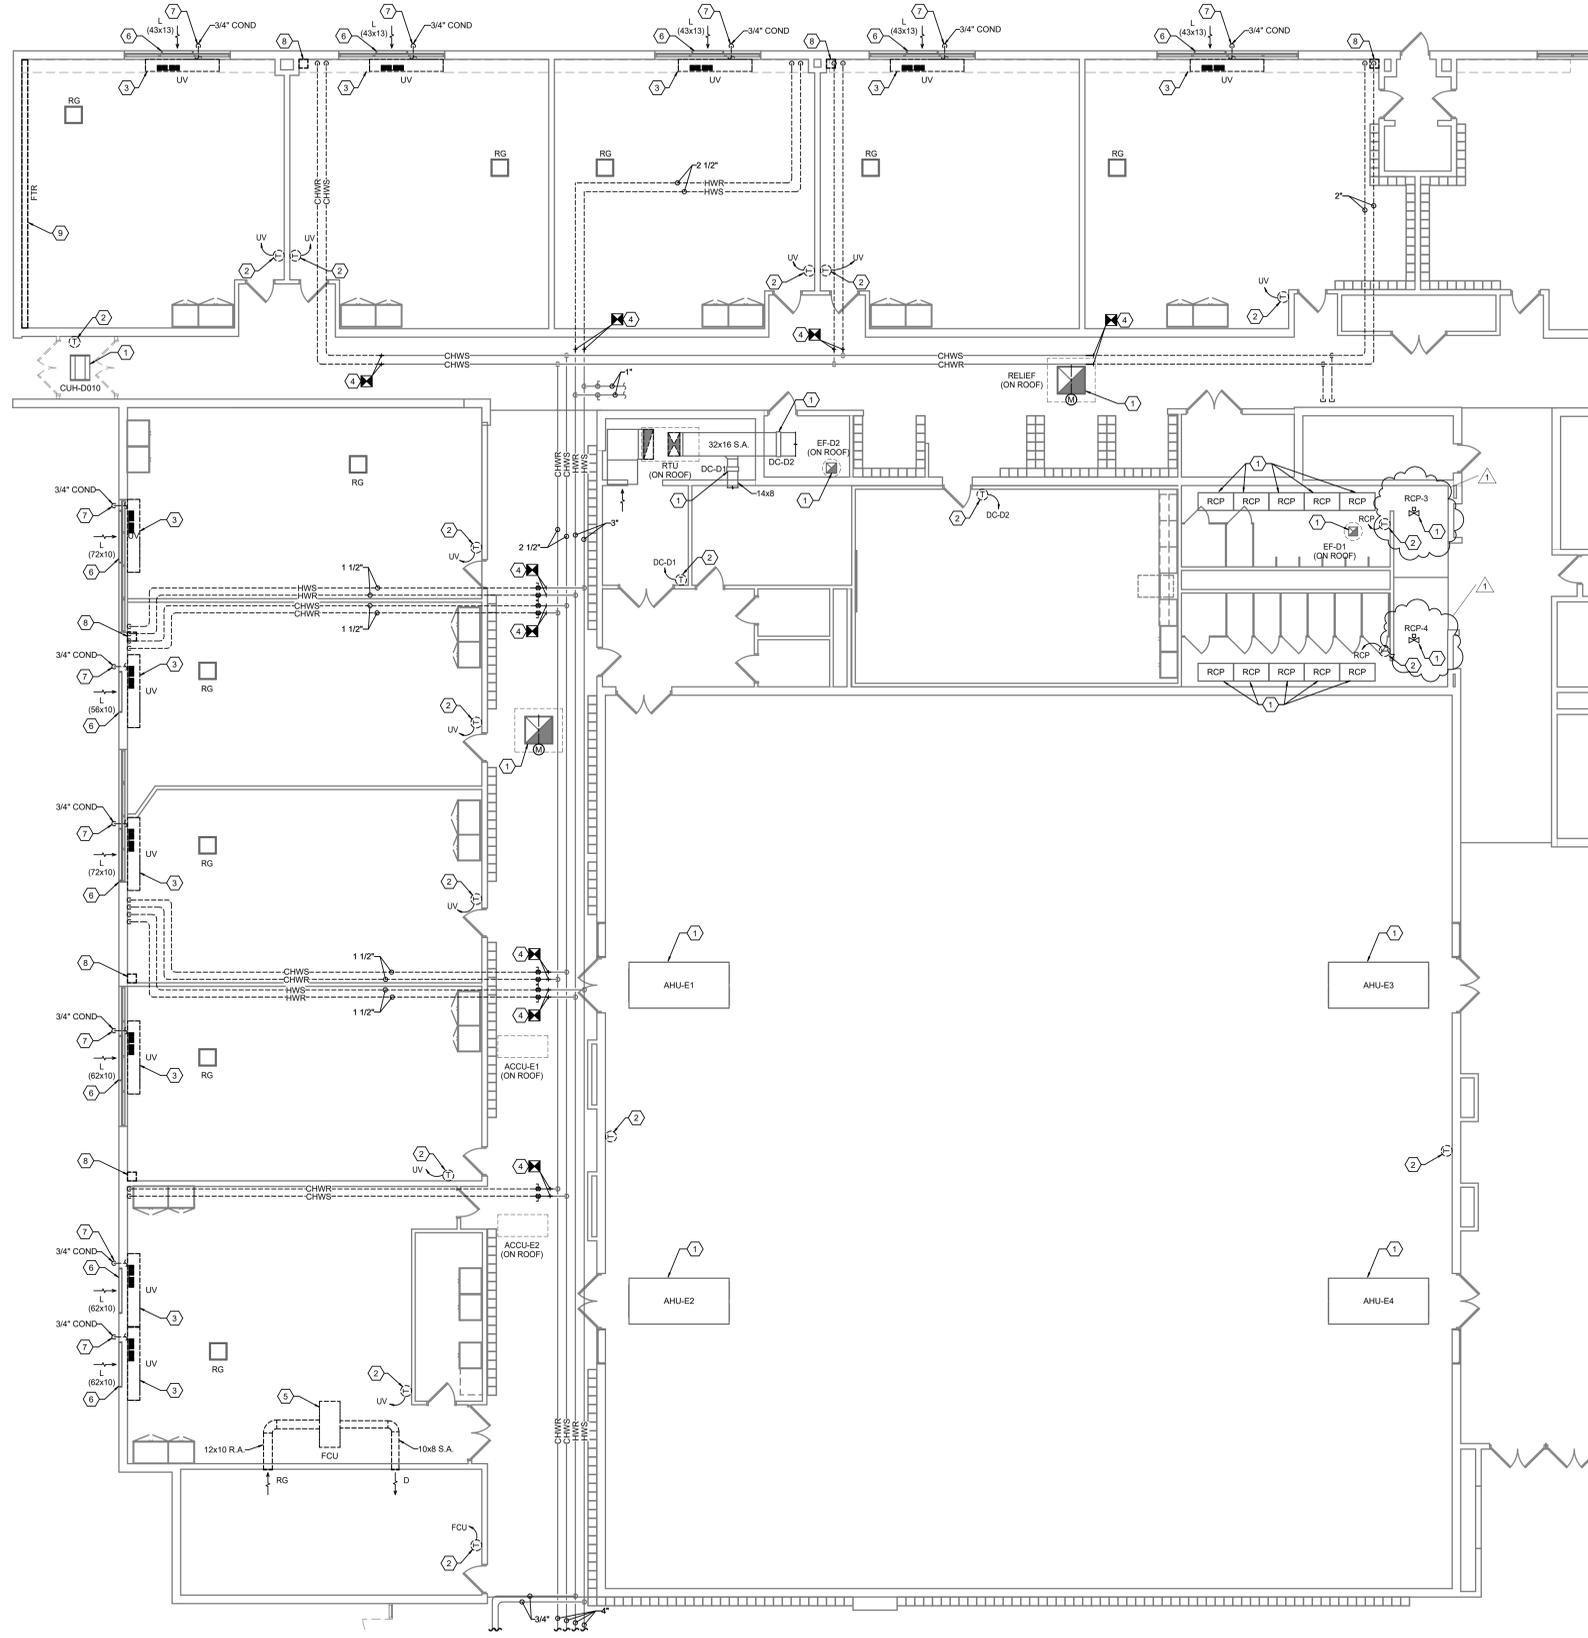

1 MECHANICAL DEMOLITION PLAN - FIRST FLOOR - UNIT D

SCALE: 1/16" = 1'-0" SCALE: 3/32" = 1'-0" SCALE: 1/8" = 1'-0" SCALE: 1/4" = 1'-0" SCALE: 1/2" = 1'-0" SCALE: 3/4" = 1'-0" SCALE: 1" = 1'-0"

THIS MONOCHROME PRINT SHOULD DISPLAY GRAPHICAL LINES BELOW IF PRINTED PROPERLY WITH 25% SHADES OF GRAY

All concepts, ideas, plans, and details as shown on this document are the sole property of Primary Engineering, Inc. and shall not be used for any other purpose without their expressed written consent. The project owner shall be permitted to retain copies for information and reference purposes.
©2024 © Primary Engineering, Inc.




ASL

REVISIONS:	DATE:	BY:	APPROVED BY:
1	18/05/2024	ASL	ADDENDUM #1

100% CONSTRUCTION DOCUMENTS
PROJECT: #23138
DATE: 07/24/2024
DRAWN BY: ASL

MECHANICAL DEMO PLAN - FIRST FLOOR - UNIT D

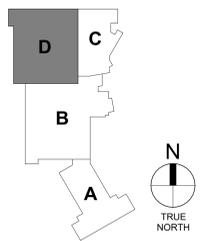

MD101D