

# ECHS ADDENDUM #1 DRAWINGS 10/11/24

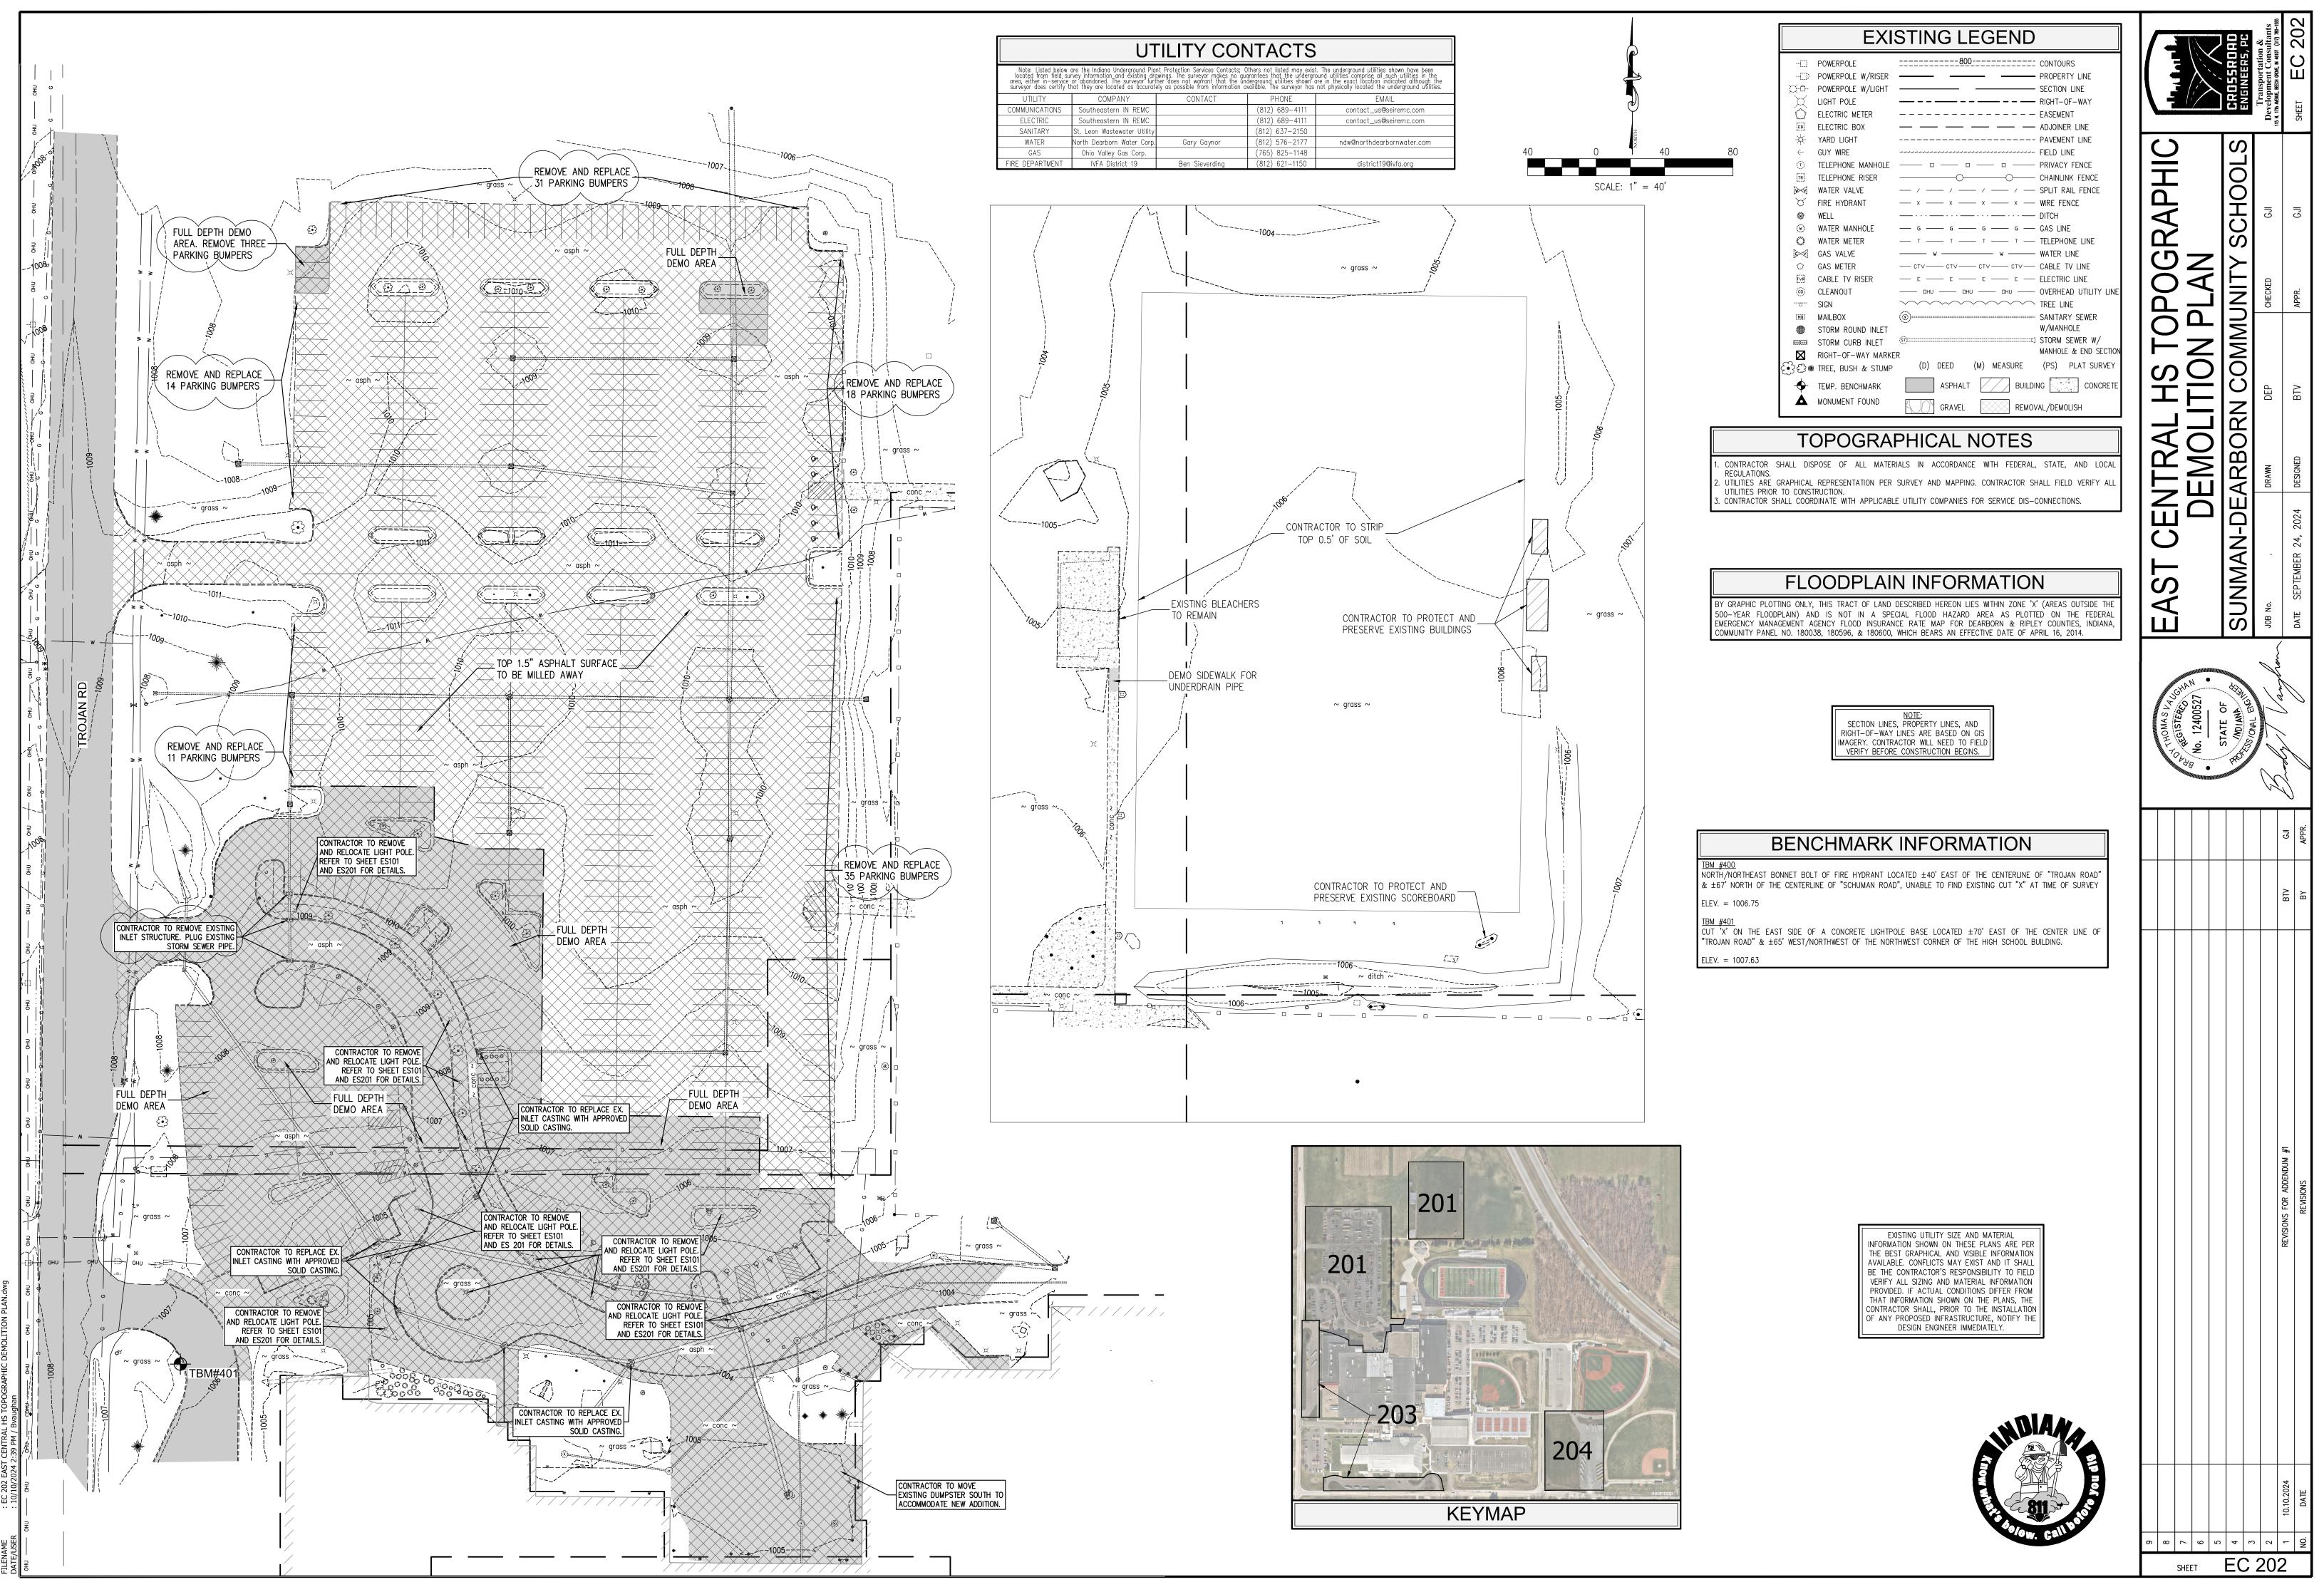


CTORY PATH : R:\Active\Lancer+Beebe\Sunman-Dearborn\Design\CAD\Plan AME : EC 202 EAST CENTRAL HS TOPOGRAPHIC DEMOLITION PLA

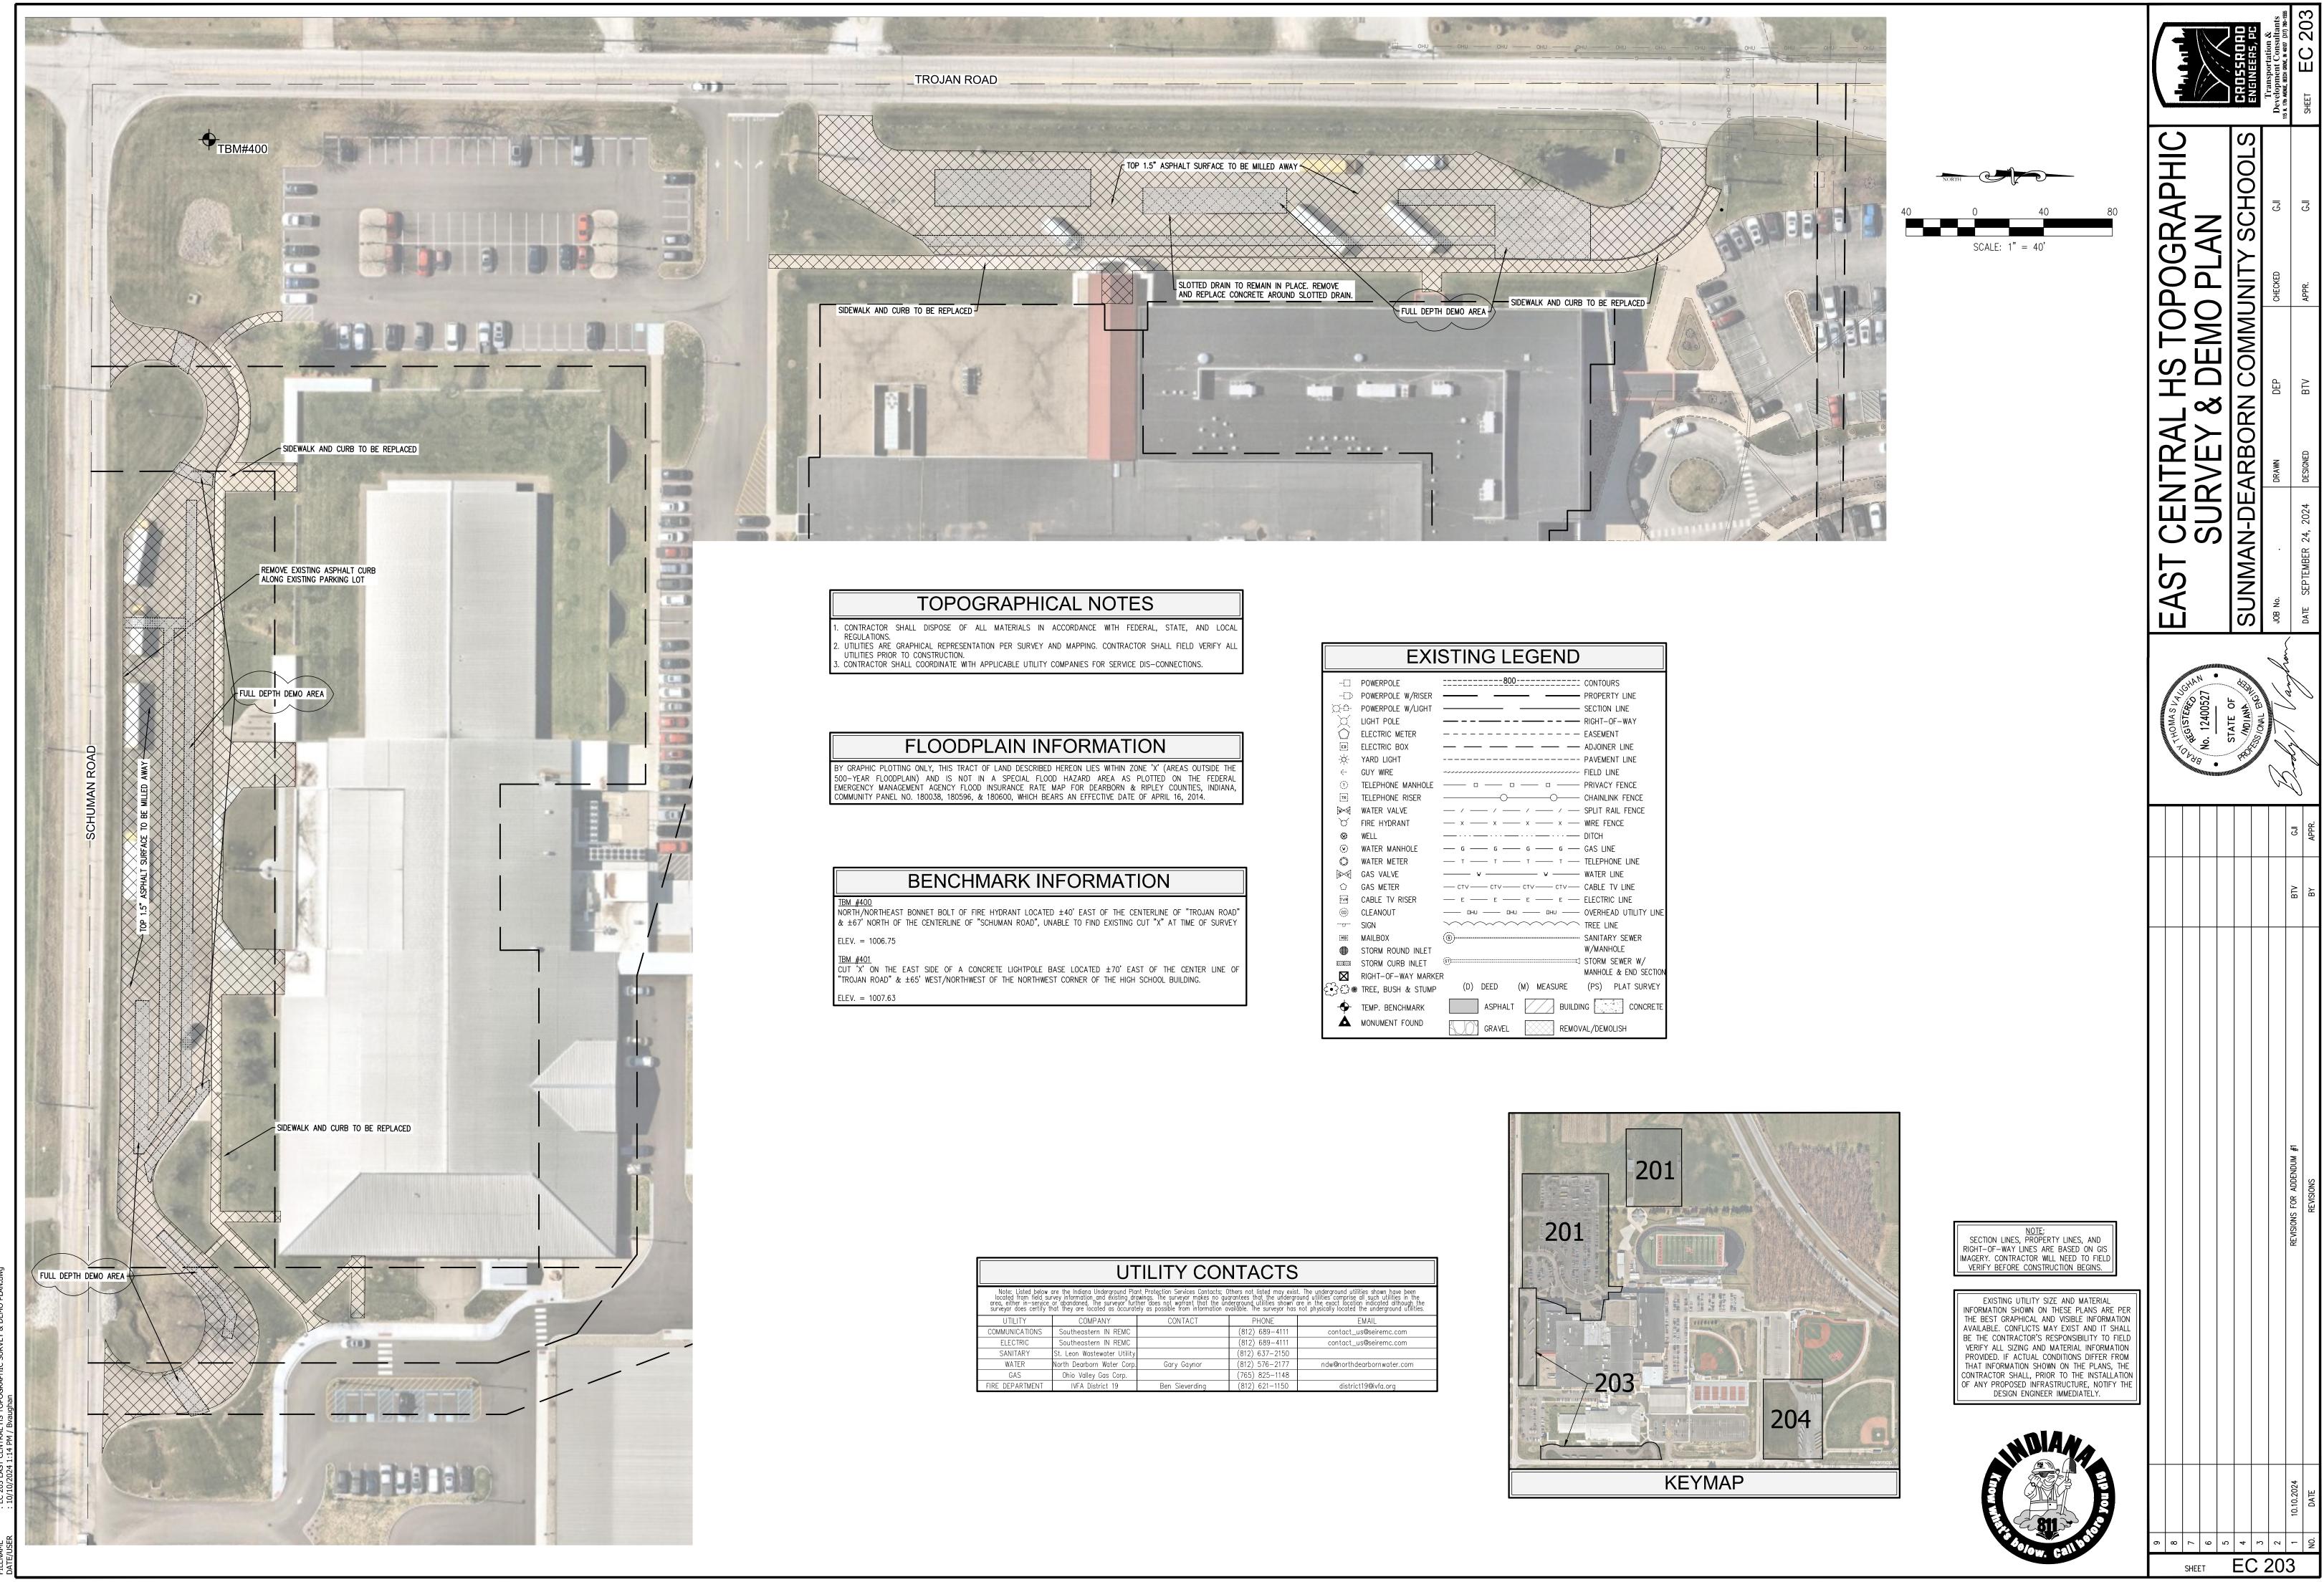

	EXR	STING LEGEND	
[]]	POWERPOLE	800	CONTOURS
-	POWERPOLE W/RISER		PROPERTY
) <u>(</u> -6-	POWERPOLE W/LIGHT		SECTION I
X	LIGHT POLE		RIGHT-OF
Ô	ELECTRIC METER		EASEMENT
EB	ELECTRIC BOX		ADJOINER
*	YARD LIGHT		PAVEMEN
€	GUY WIRE		FIELD LIN
Ð	TELEPHONE MANHOLE	0 0 0	PRIVACY
TR	TELEPHONE RISER	OO	CHAINLINK
	WATER VALVE	/ / / /	SPLIT RAI
ď	FIRE HYDRANT	— x — x — x — x —	WIRE FEN
$\otimes$	WELL		DITCH
$\odot$	WATER MANHOLE	— G — G — G — G —	
0	WATER METER	— T — T — T — T —	TELEPHON
\$~~\$	GAS VALVE	w w	WATER LI
Ó	GAS METER	CTV CTV CTV	CABLE TV
	CABLE TV RISER	— E — E — E — E —	
(III)	CLEANOUT	DHU DHU DHU	
0	SIGN	~~~~~~~~~~~~~~~~~~~~~~~~~~~~~~~~~~~~~~	TREE LINE
[ <u>MB</u> ]	MAILBOX	(0)	
$\blacksquare$	STORM ROUND INLET	<u></u>	W/MANHO
	STORM CURB INLET	<u>(</u> )	MANHOLE
	RIGHT-OF-WAY MARKE		
£•}₽₽®	TREE, BUSH & STUMP	(D) DEED (M) MEASURE	(PS) F
•	TEMP. BENCHMARK	ASPHALT BUILDI	NG
Δ	MONUMENT FOUND	GRAVEL REMOV	AL/DEMOL

UTILITY CONTACTS													
Note: Listed below are the Indiana Underground Plant Protection Services Contacts; Others not listed may exist. The underground utilities shown have been located from field survey information and existing drawings. The surveyor makes no guarantees that the underground utilities comprise all such utilities in the area, either in-service or abandoned. The surveyor further does not worrant that the underground utilities the exist in the exact location indicated although the surveyor does certify that they are located as accurately as possible from information available. The surveyor has not physically located the underground utilities.													
UTILITY	COMPANY	COMPANY CONTACT PHONE EMAIL											
COMMUNICATIONS	Southeastern IN REMC		(812) 689-4111	contact_us@seiremc.com									
ELECTRIC	Southeastern IN REMC		(812) 689-4111	contact_us@seiremc.com									
SANITARY	St. Leon Wastewater Utility		(812) 637-2150										
WATER	North Dearborn Water Corp.	Gary Gaynor	(812) 576-2177	ndw@northdearbornwater.com									
GAS	Ohio Valley Gas Corp.		(765) 825-1148										
			(										

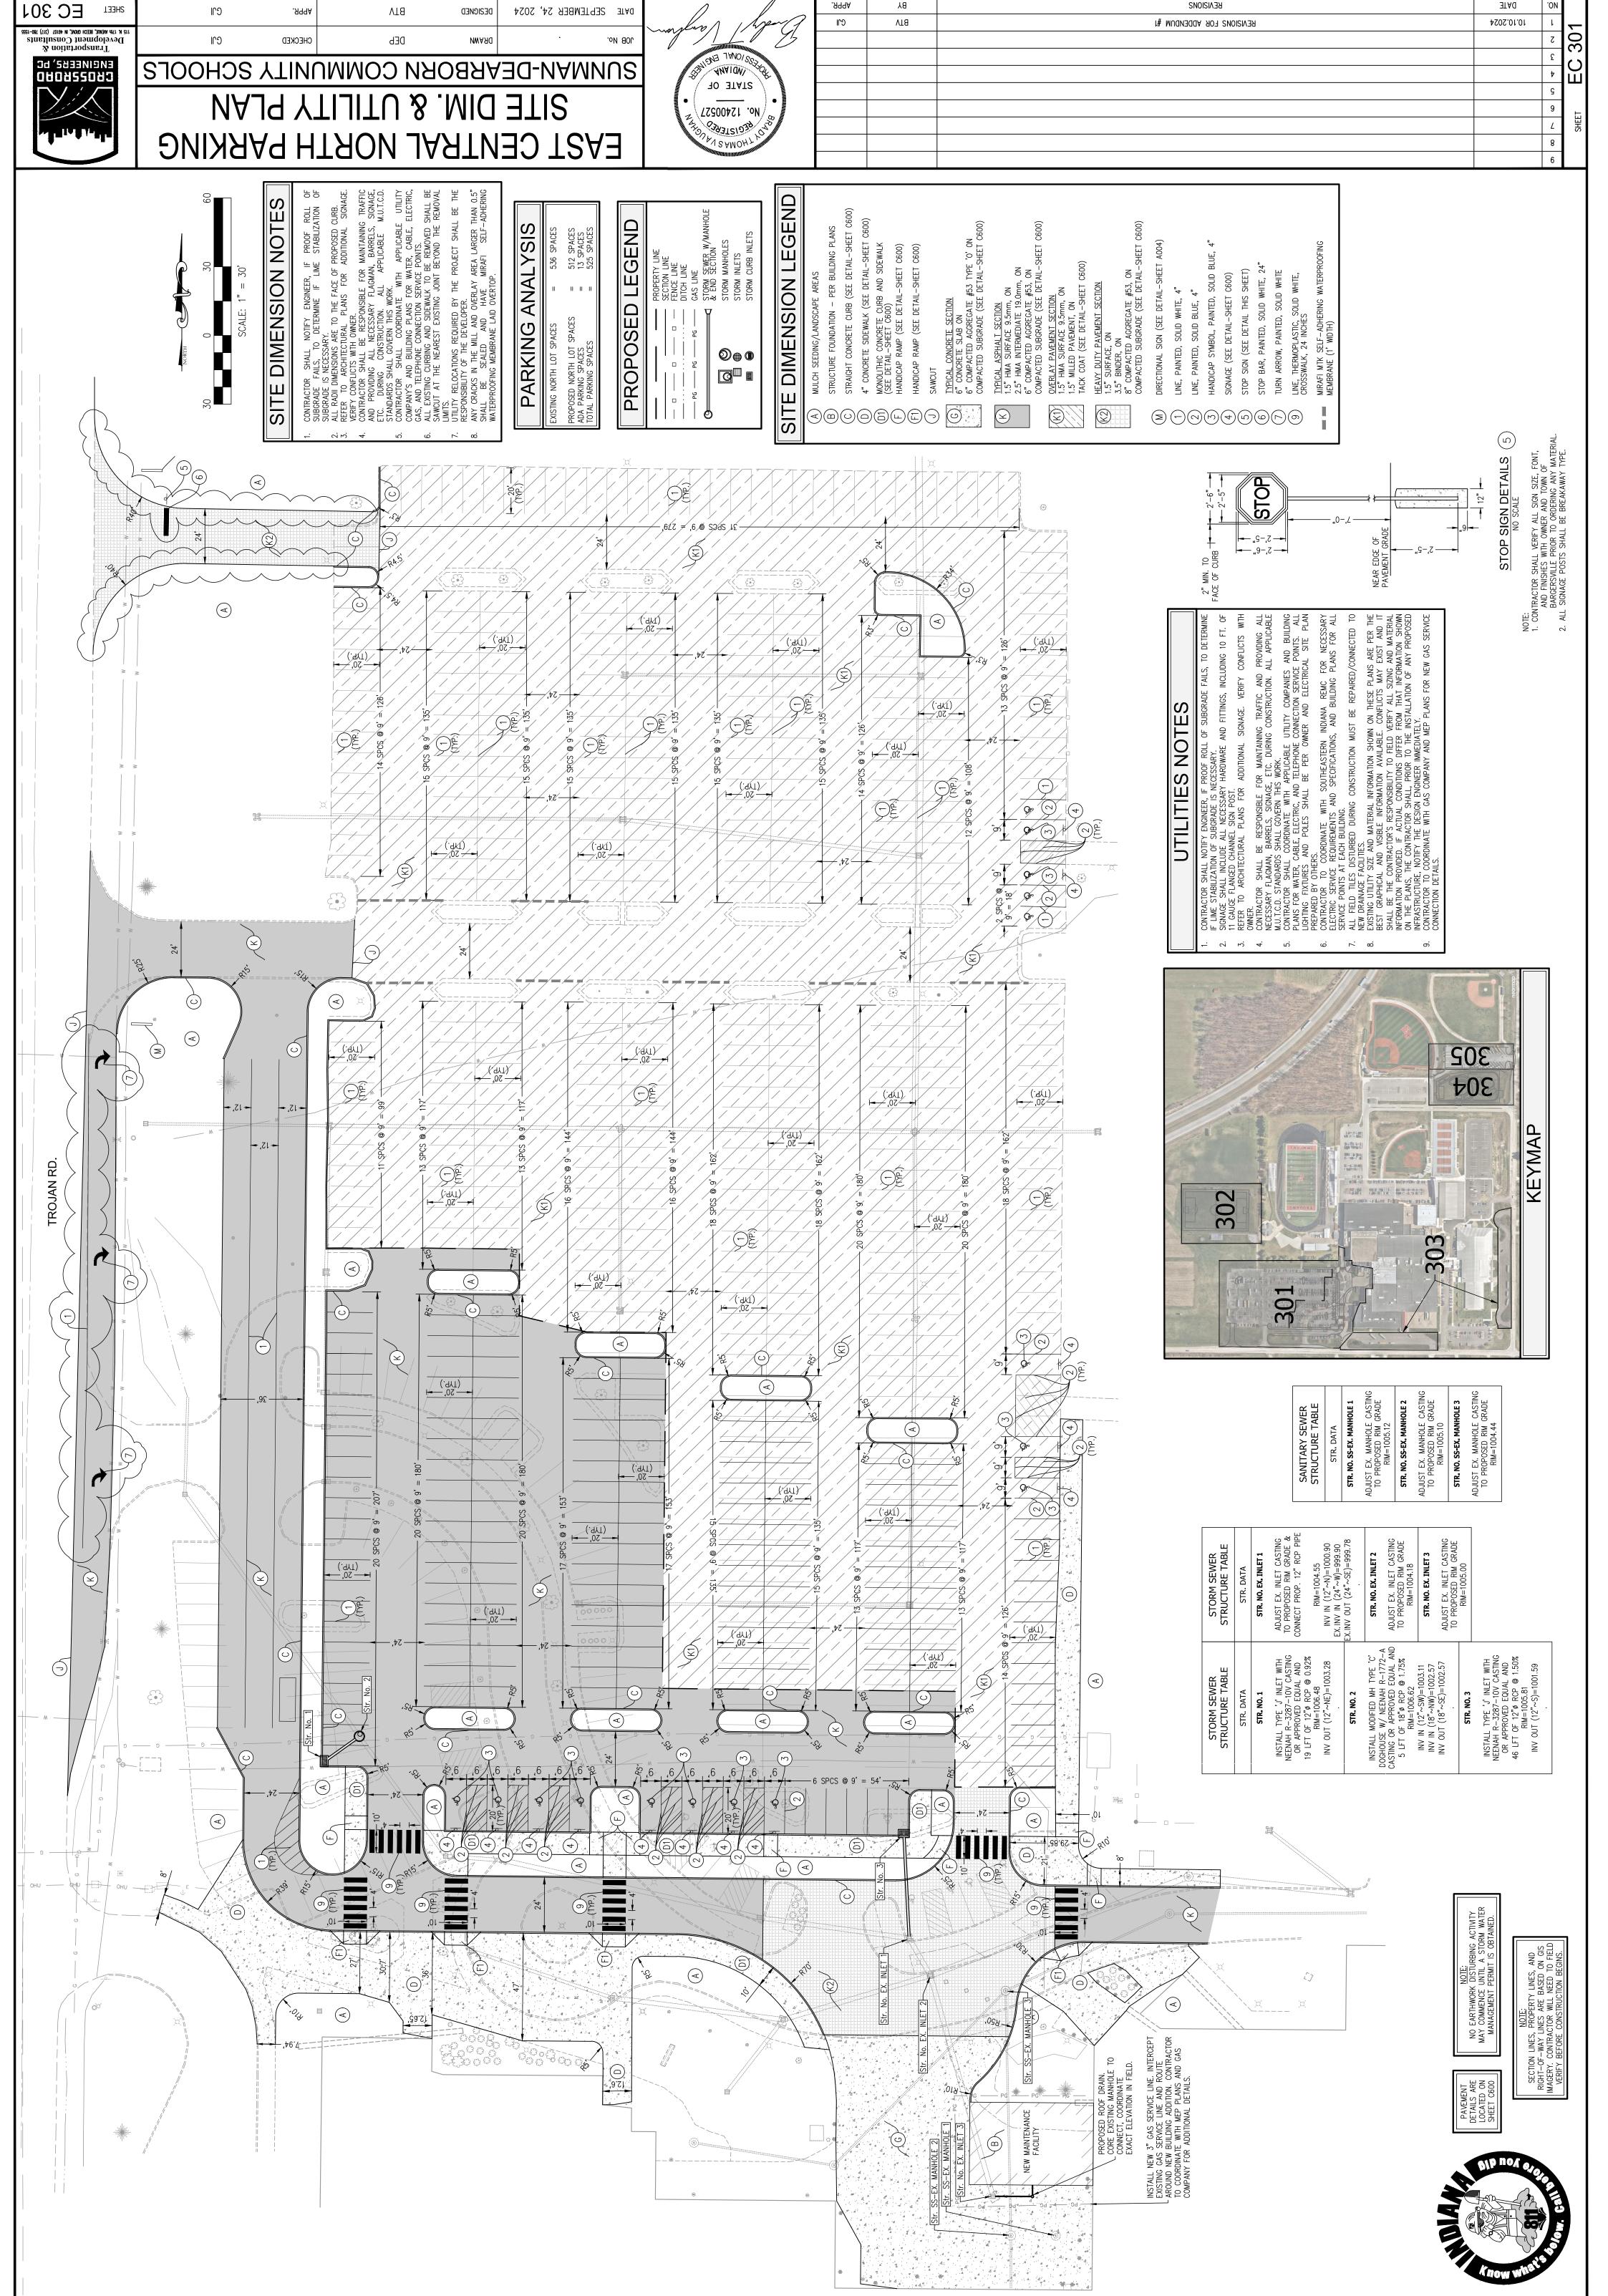



SANITARY SEWER STRUCTURE TABLE STR. DATA STR. NO. SS-EX. MANHOLE 1 AD.ILIST FX MANHOLE CASTING	KIM=1005.12 STR. NO. SS-EX. MANHOLE 2 ADJUST EX. MANHOLE CASTING TO PROPOSED RIM GRADE RIM=1005.10	SIR. NO. SS-EX. MANHOLE 3 Adjust ex. Manhole Casting To Proposed RIM Grade RIM=1004.44
--	--	---

: 10/10/2024 2:03 PM / Bvaughan Filename Pate/User 

 FILENAME
 : EC 301 EAST CENTRAL NORTH PARKING SITE DIM. & UTILITY PLAN.dwg

 FILENAME
 : EC 301 EAST CENTRAL NORTH PARKING SITE DIM. & UTILITY PLAN.dwg

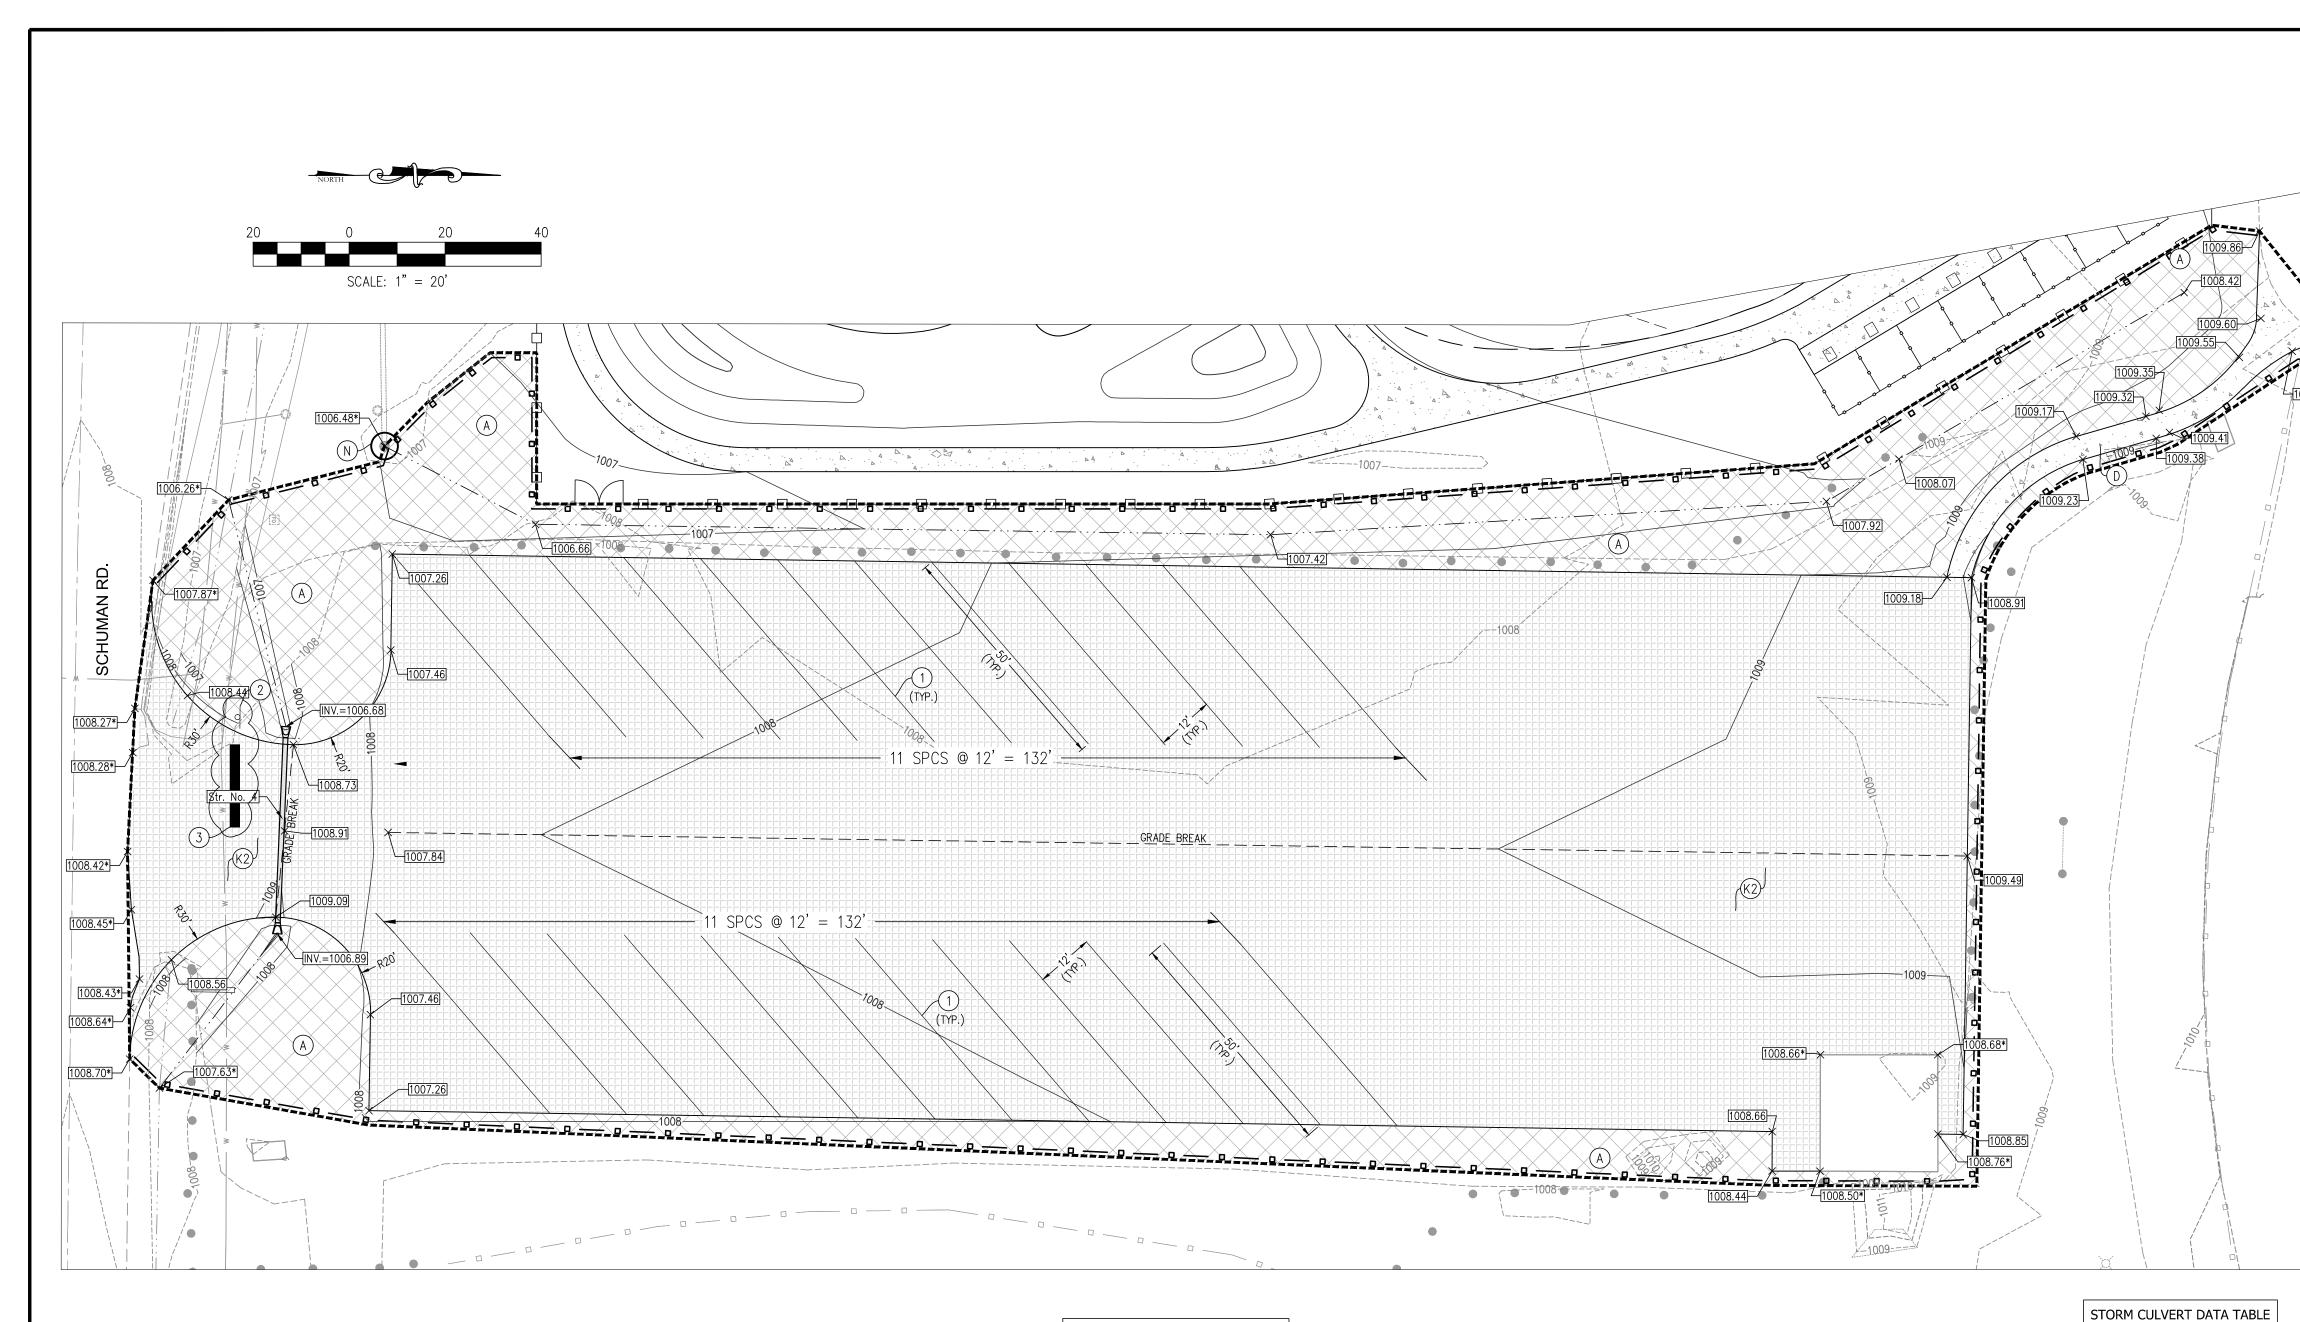

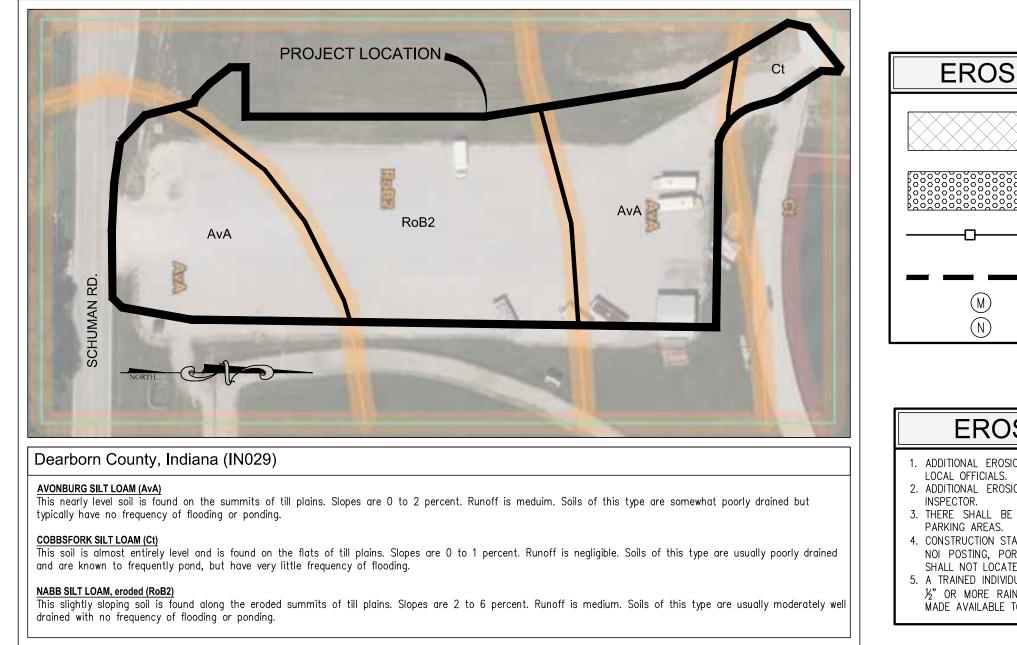

### SOIL MAP AND DESCRIPTION NOT TO SCALE

ADDITIONAL EROSION CONTROL MEASURES MAY BE REQUIRED BY STATE OR COUNTY OFFICIALS


### **EROSION CONTROL LEGEND**

MULCHED SEEDING
REVETMENT RIPRAP
 SILT FENCE SLOPE CHECK (NUTEC 3 NWS–6 OR APPROVED EQUAL)
CONSTRUCTION LIMITS
CONCRETE WASHOUT AREA (SEE DETAIL-SHEET _)
FABRIC DROP INLET PROTECTION (SEE DETAIL-SHEET _

(M)

### **EROSION CONTROL NOTES**


ADDITIONAL EROSION CONTROL MEASURES MAY BE REQUIRED BY STATE, COUNTY, OR ADDITIONAL EROSION CONTROL MEASURES MAY BE REQUIRED IN THE FIELD BY THE . THERE SHALL BE NO DIRT, DEBRIS, OR STORAGE OF MATERIALS WITHIN PROPOSED 4. CONSTRUCTION STAGING AREA (TO BE DETERMINED BY CONTRACTOR) SHALL INCLUDE THE NOI POSTING, PORT-O-LETS, TRASH CONTAINERS, AND FUELING TANKS. CONTRACTOR SHALL NOT LOCATE STAGING AREA WITHIN PROPOSED PARKING LOT. 5. A TRAINED INDIVIDUAL MUST PERFORM AN INSPECTION ONCE A WEEK AND AFTER EVERY MADE AVAILABLE TO THE TOWN INSPECTOR UPON REQUEST.

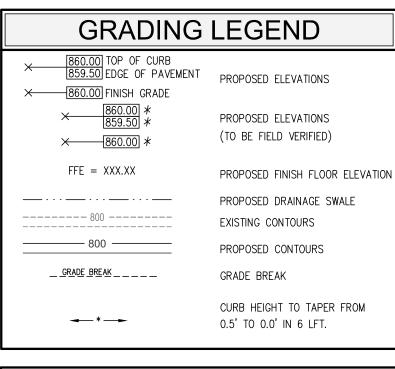


### **GRADING NOTES**

CONTRACTOR SHALL PROVIDE POSITIVE DRAINAGE AWAY FROM ALL BUILDINGS IN FINAL GRADING OF SITE. CONTRACTOR SHALL COORDINATE WITH THE ARCHITECT TO DETERMINE PROPER FOUNDATION EXPOSURE FOR EACH BUILDING TYPE, HOWEVER, IN NO INSTANCE SHALL DRAINAGE TOWARDS THE BUILDING FOUNDATION BE ALLOWED. CONTRACTOR SHALL NOT ALLOW DRAINAGE FROM PROJECT SITE TO DISCHARGE ONTO ADJACENT PROPERTIES IN FINAL GRADING OF SITE. CONTRACTOR SHALL PLACE A BERM WHERE NECESSARY. SEE REAR DITCH DETAIL.

STORM CURB INLETS

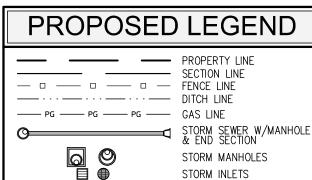

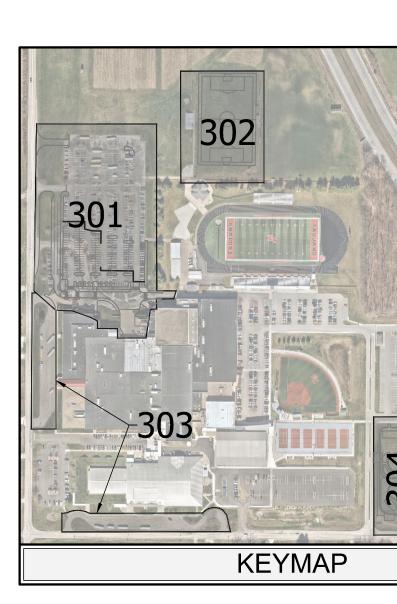


STR. DATA CULVERT

STR. NO. 4 INSTALL TWO (2) CONCRETE END SECTIONS AND

43 LFT OF 12"ø RCP @ 0.49%


U.S. EL=1006.89 D.S. EL.=1006.68

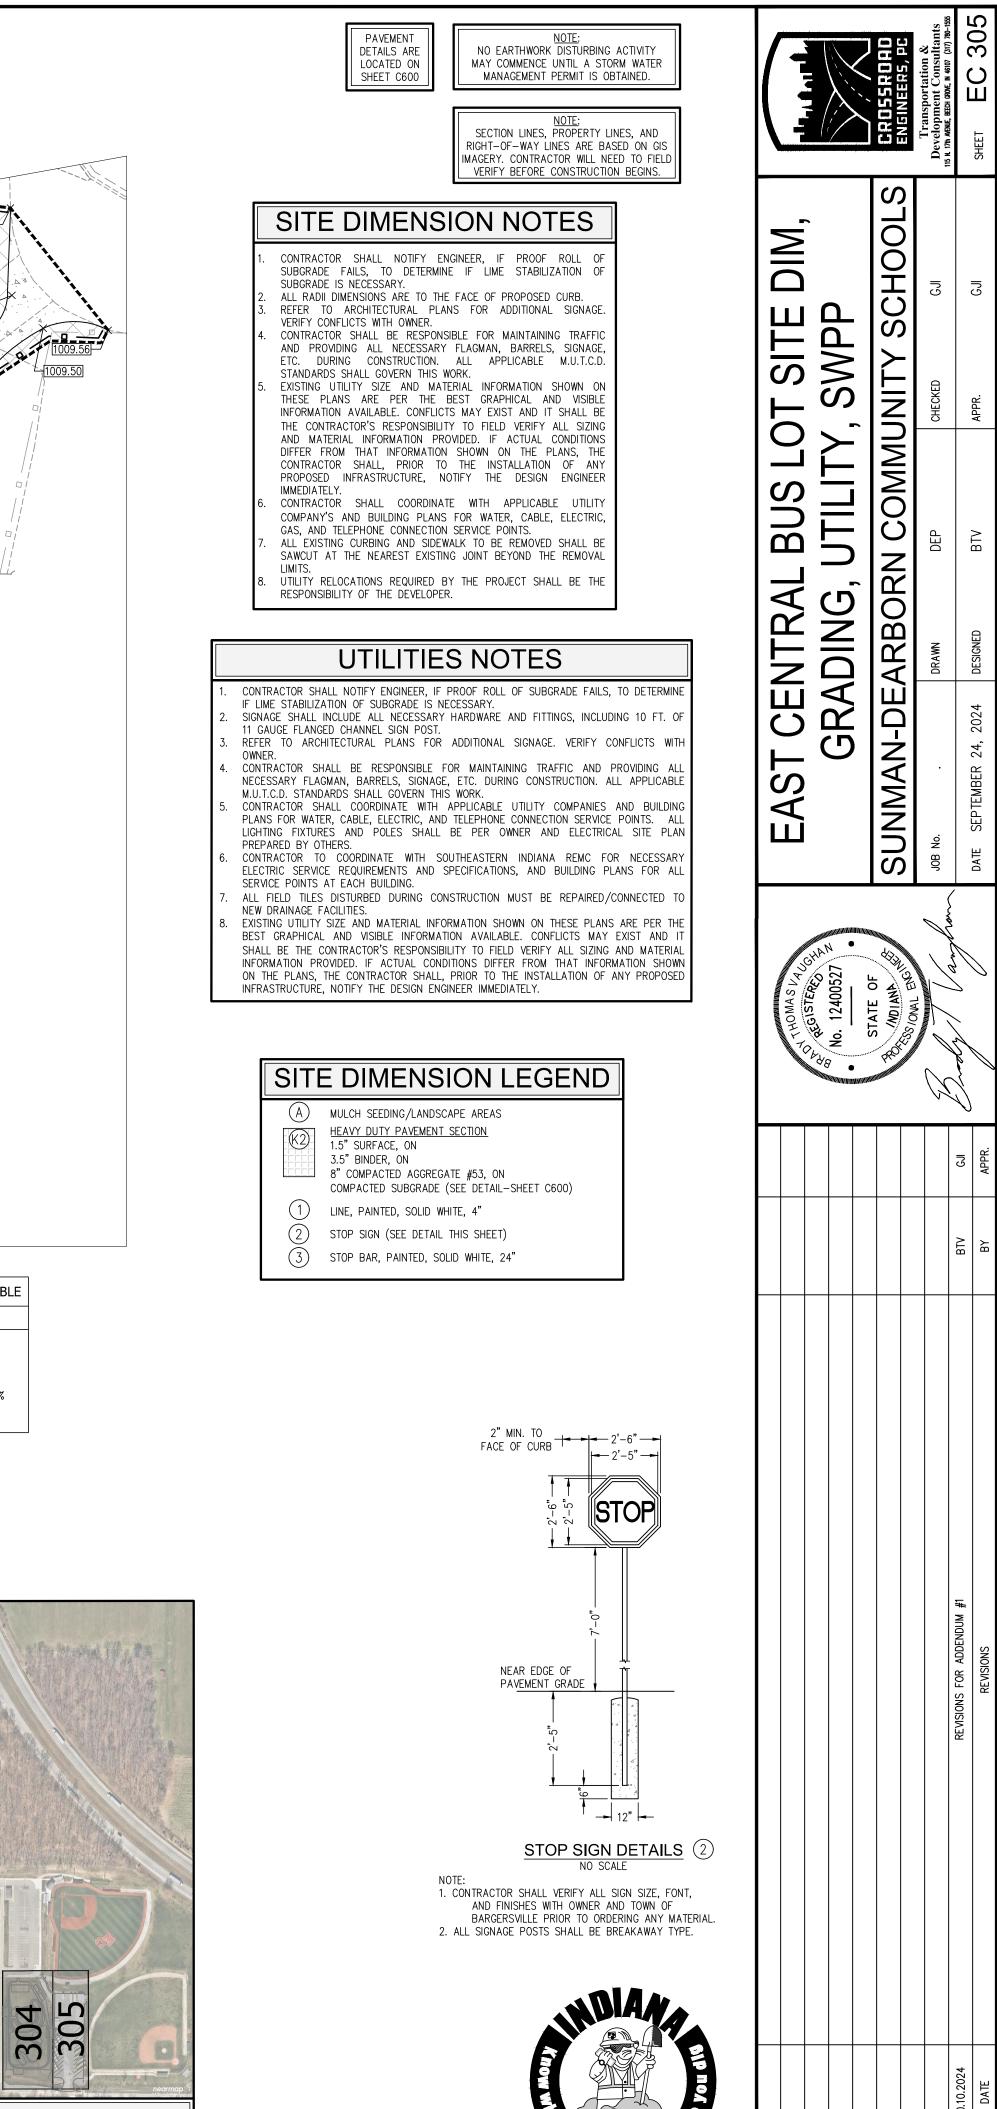


- | 2 | 0 | 2 | 2 | 0 | 4 | 0 | 2


SHEET

EC 305

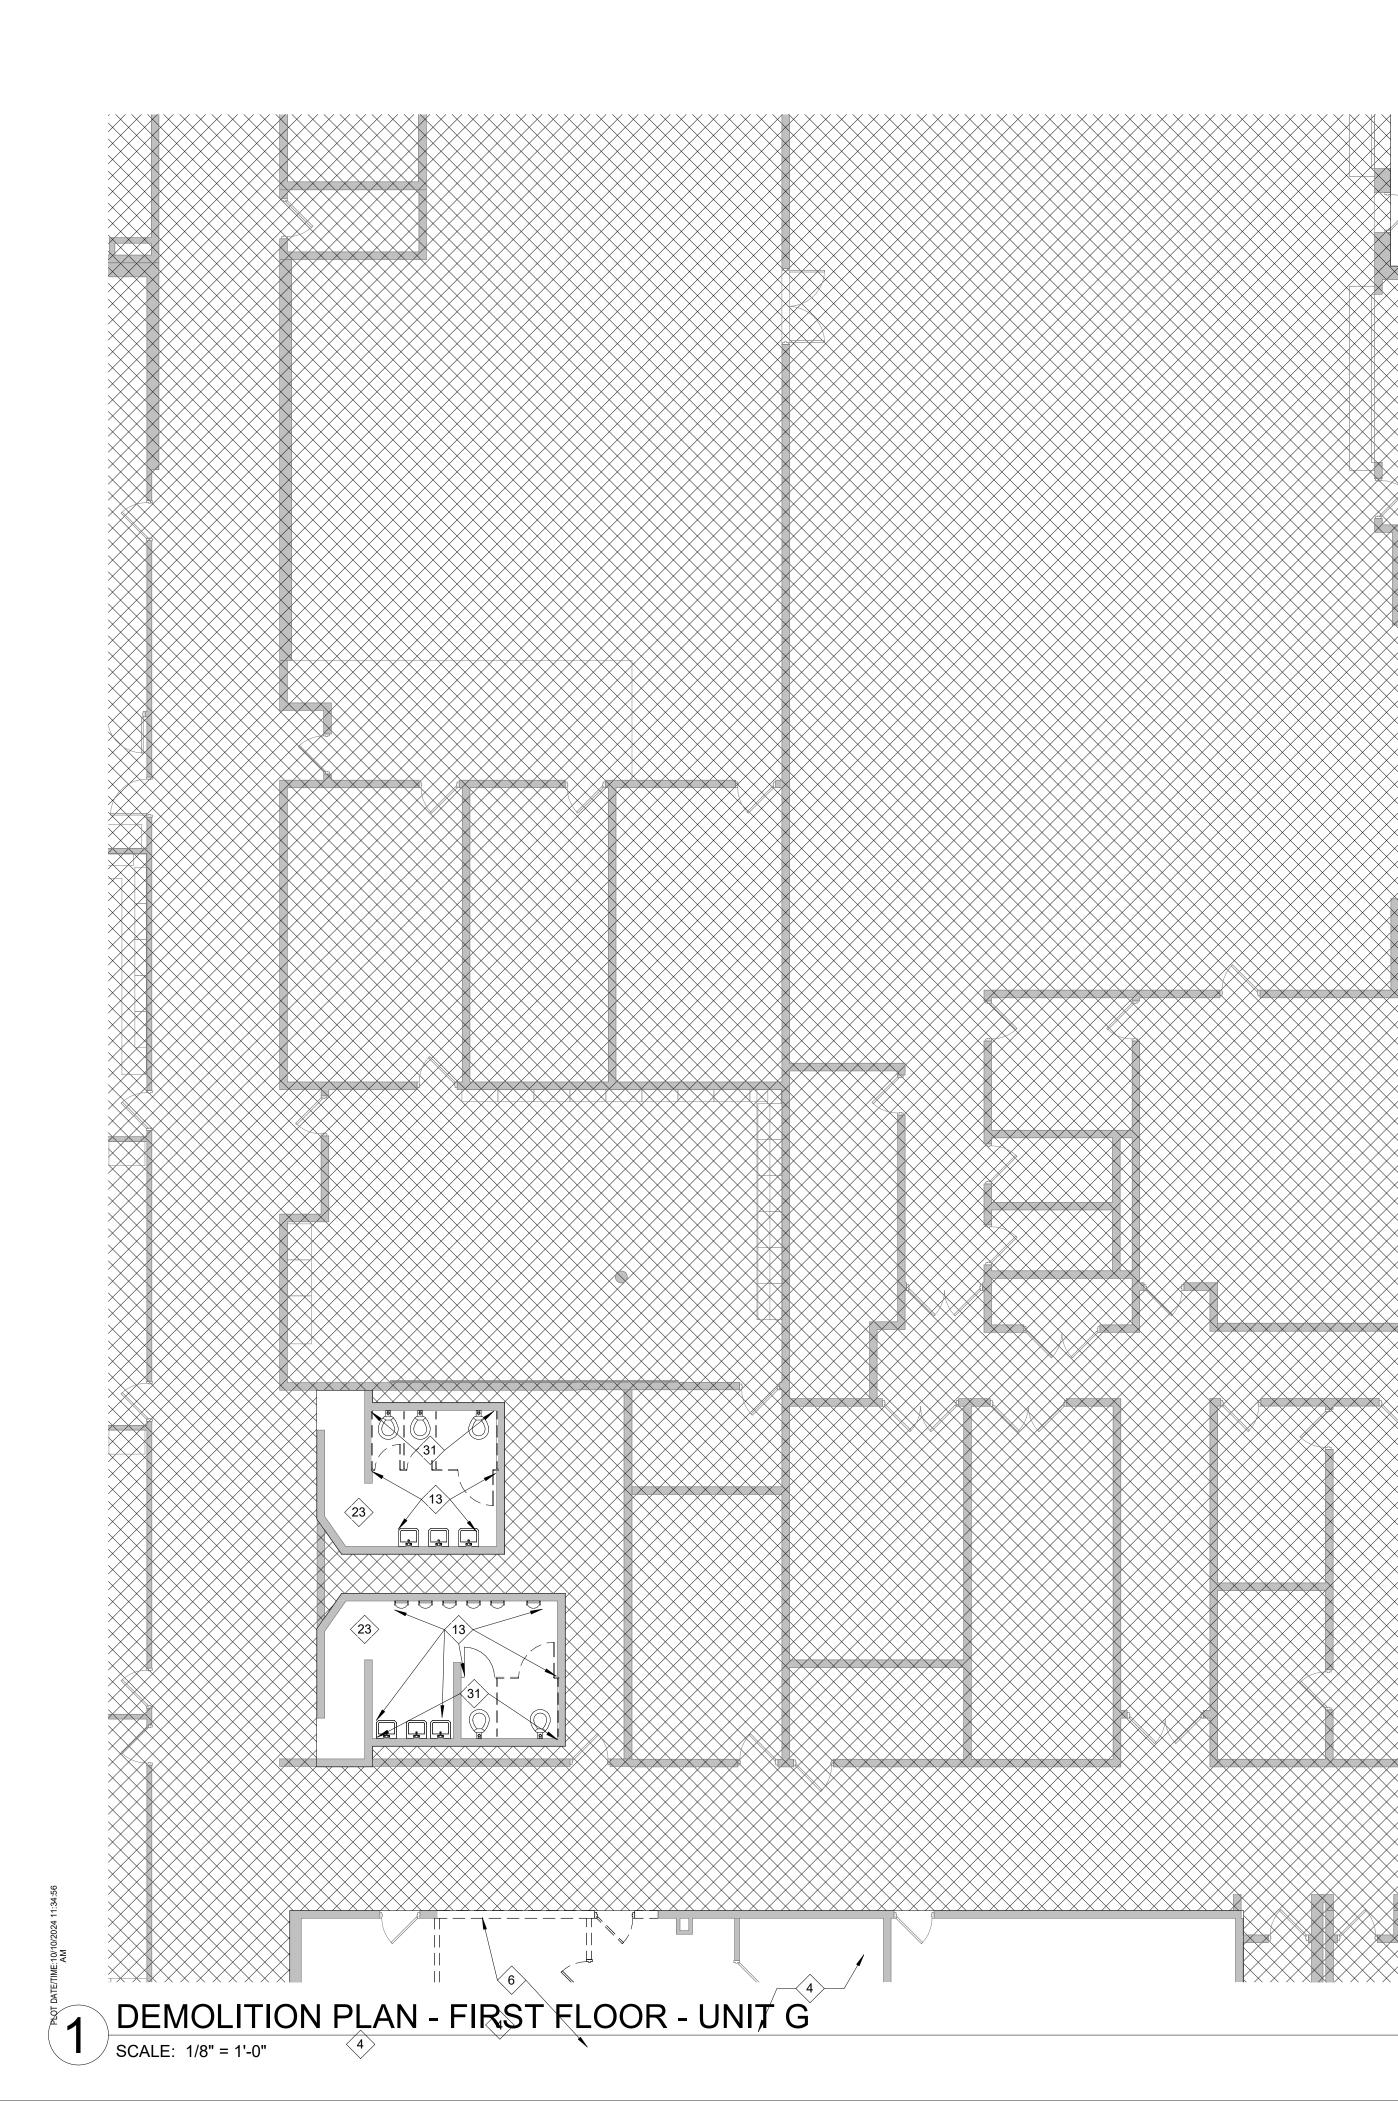

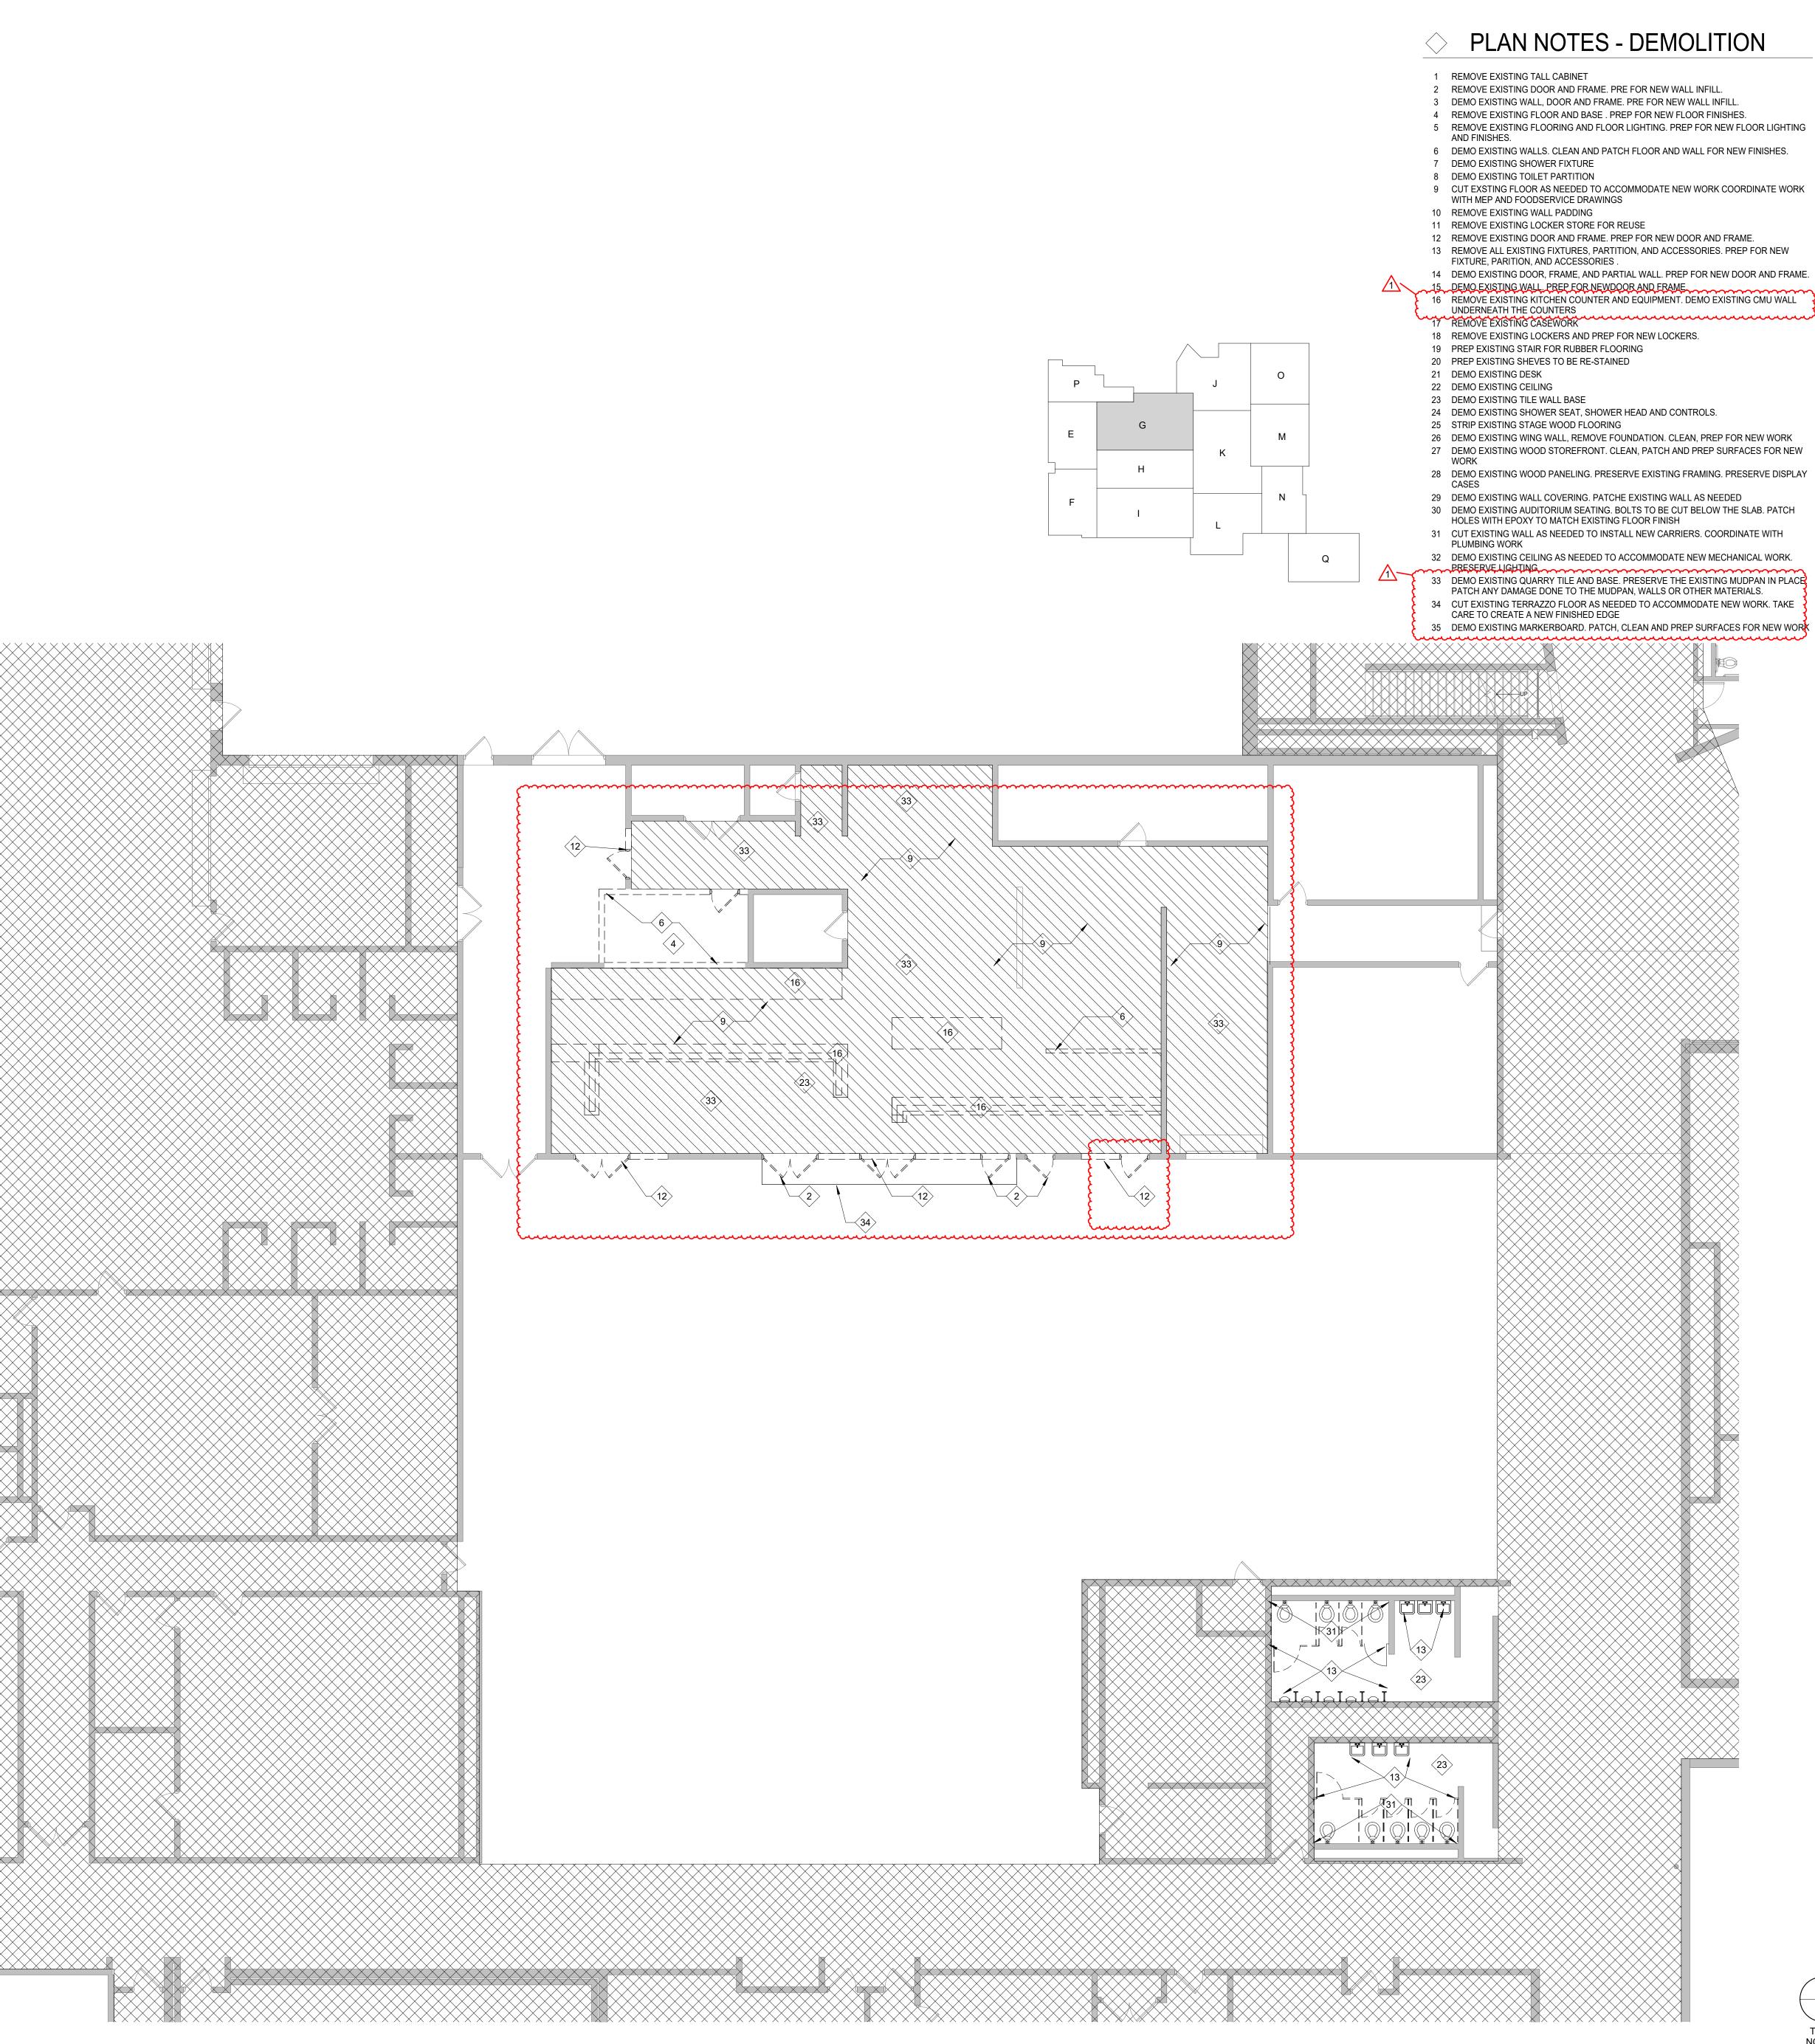




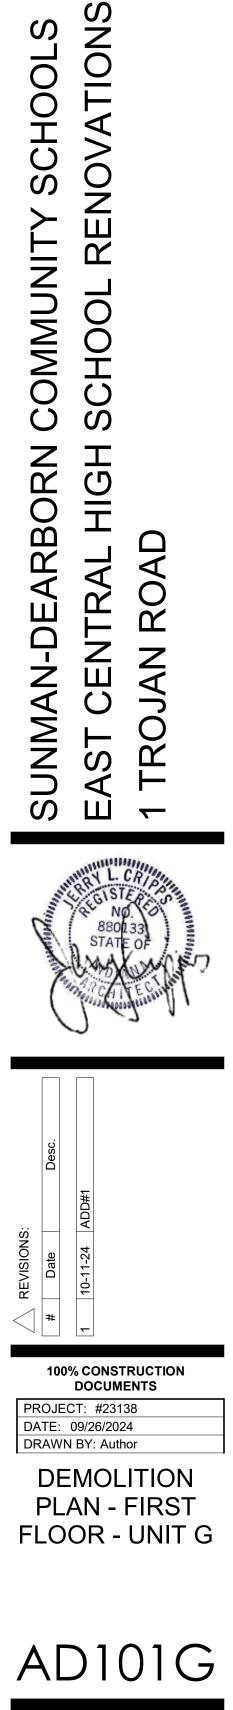






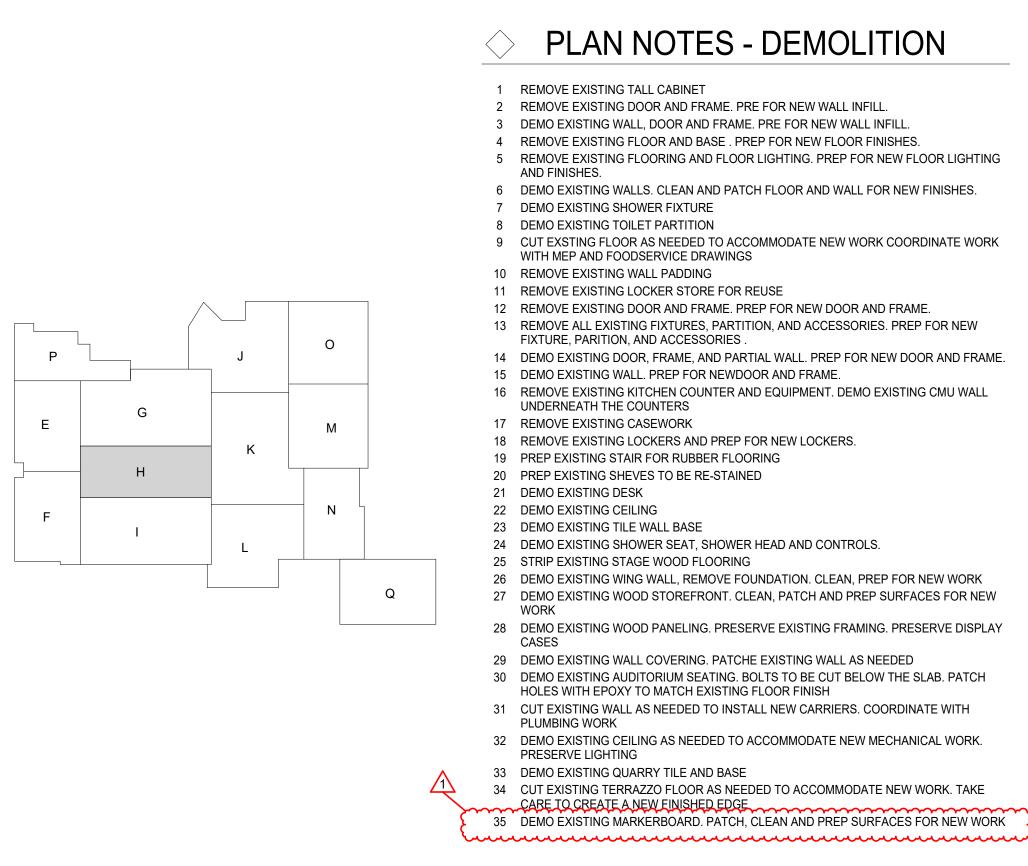




S



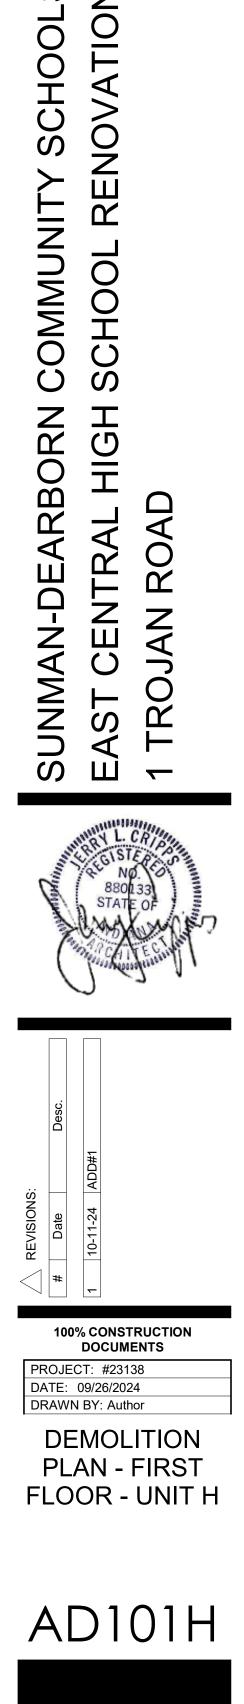

\_\_\_\_\_\_




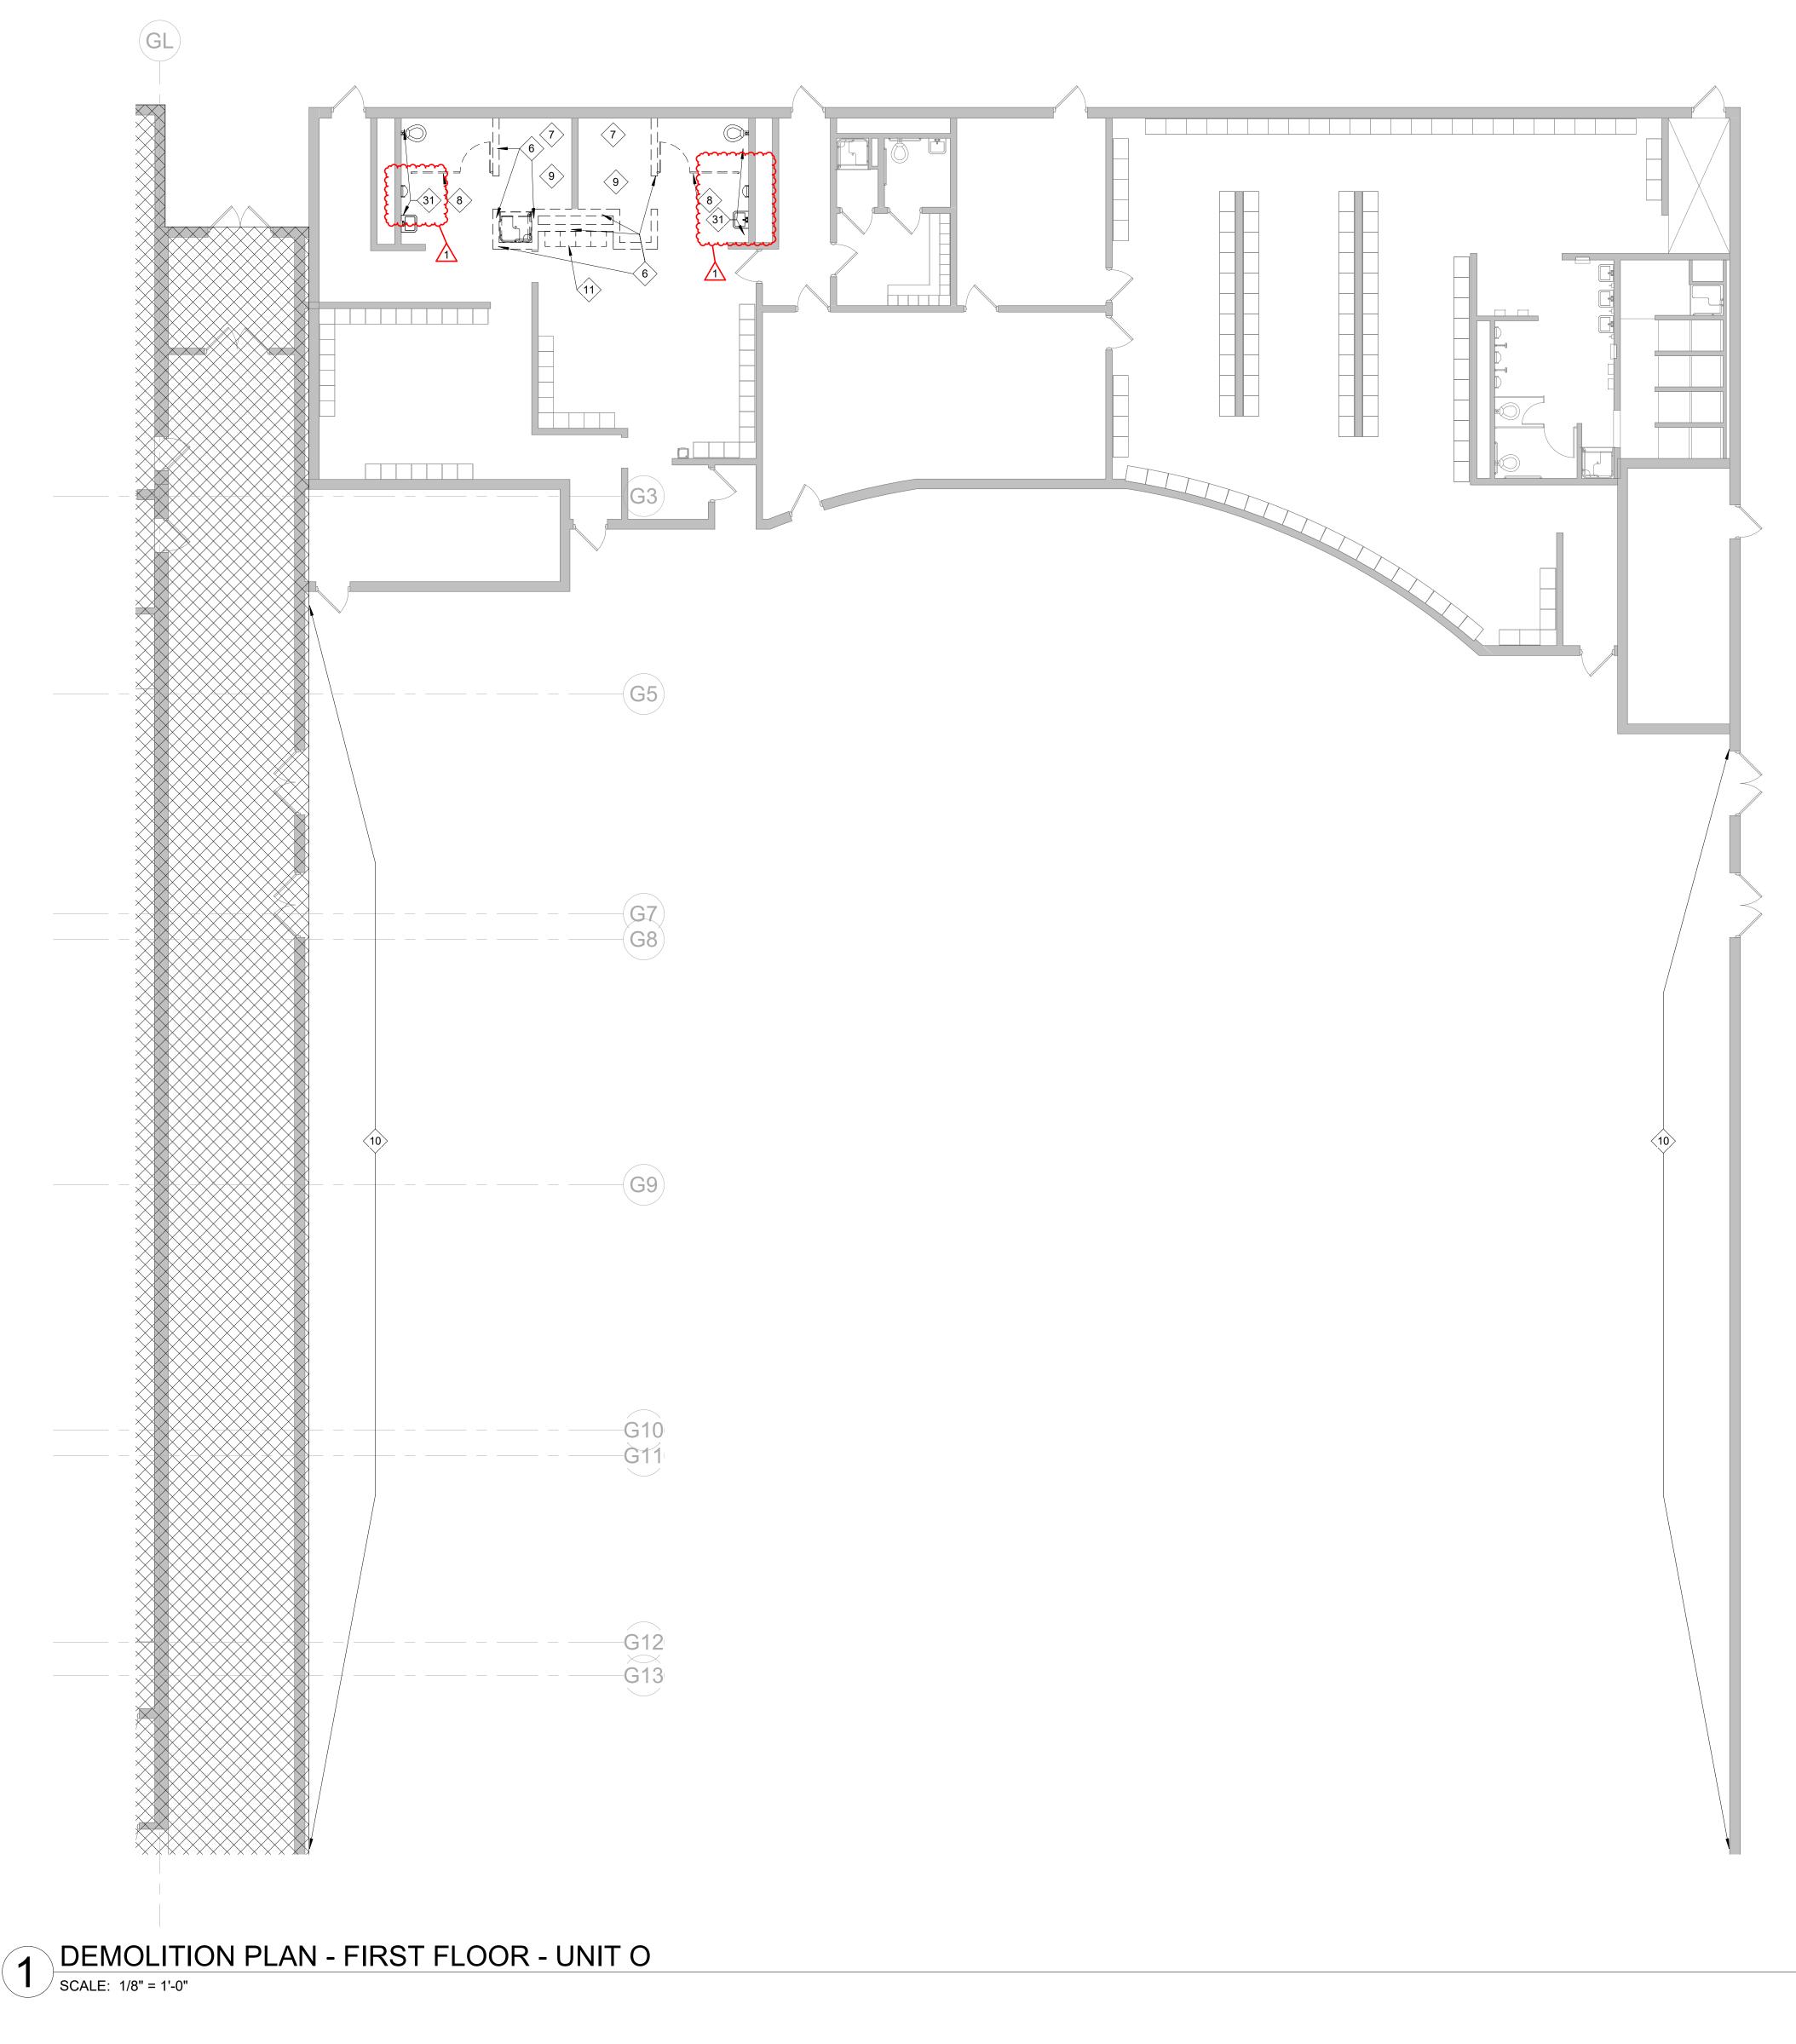

### PLAN NOTES - DEMOLITION $\langle \rangle$


1 REMOVE EXISTING TALL CABINET

- 2 REMOVE EXISTING DOOR AND FRAME. PRE FOR NEW WALL INFILL. 3 DEMO EXISTING WALL, DOOR AND FRAME. PRE FOR NEW WALL INFILL.
- 4 REMOVE EXISTING FLOOR AND BASE . PREP FOR NEW FLOOR FINISHES.
- 5 REMOVE EXISTING FLOORING AND FLOOR LIGHTING. PREP FOR NEW FLOOR LIGHTING AND FINISHES.
- 6 DEMO EXISTING WALLS. CLEAN AND PATCH FLOOR AND WALL FOR NEW FINISHES.
- 7 DEMO EXISTING SHOWER FIXTURE 8 DEMO EXISTING TOILET PARTITION
- 9 CUT EXSTING FLOOR AS NEEDED TO ACCOMMODATE NEW WORK COORDINATE WORK WITH MEP AND FOODSERVICE DRAWINGS
- 10 REMOVE EXISTING WALL PADDING
- 11 REMOVE EXISTING LOCKER STORE FOR REUSE 12 REMOVE EXISTING DOOR AND FRAME. PREP FOR NEW DOOR AND FRAME.
- 13 REMOVE ALL EXISTING FIXTURES, PARTITION, AND ACCESSORIES. PREP FOR NEW
- FIXTURE, PARITION, AND ACCESSORIES . 14 DEMO EXISTING DOOR, FRAME, AND PARTIAL WALL. PREP FOR NEW DOOR AND FRAME. 15 DEMO EXISTING WALL. PREP FOR NEWDOOR AND FRAME.
- 16 REMOVE EXISTING KITCHEN COUNTER AND EQUIPMENT. DEMO EXISTING CMU WALL UNDERNEATH THE COUNTERS
- 17 REMOVE EXISTING CASEWORK
- 18 REMOVE EXISTING LOCKERS AND PREP FOR NEW LOCKERS. 19 PREP EXISTING STAIR FOR RUBBER FLOORING
- 20 PREP EXISTING SHEVES TO BE RE-STAINED
- 21 DEMO EXISTING DESK
- 22 DEMO EXISTING CEILING 23 DEMO EXISTING TILE WALL BASE
- 24 DEMO EXISTING SHOWER SEAT, SHOWER HEAD AND CONTROLS.
- 25 STRIP EXISTING STAGE WOOD FLOORING
- 26 DEMO EXISTING WING WALL, REMOVE FOUNDATION. CLEAN, PREP FOR NEW WORK 27 DEMO EXISTING WOOD STOREFRONT. CLEAN, PATCH AND PREP SURFACES FOR NEW WORK
- 28 DEMO EXISTING WOOD PANELING. PRESERVE EXISTING FRAMING. PRESERVE DISPLAY
- CASES 29 DEMO EXISTING WALL COVERING. PATCHE EXISTING WALL AS NEEDED
- 30 DEMO EXISTING AUDITORIUM SEATING. BOLTS TO BE CUT BELOW THE SLAB. PATCH HOLES WITH EPOXY TO MATCH EXISTING FLOOR FINISH
- 31 CUT EXISTING WALL AS NEEDED TO INSTALL NEW CARRIERS. COORDINATE WITH
- PLUMBING WORK 32 DEMO EXISTING CEILING AS NEEDED TO ACCOMMODATE NEW MECHANICAL WORK. PRESERVE LIGHTING
- 33 DEMO EXISTING QUARRY TILE AND BASE. PRESERVE THE EXISTING MUDPAN IN PLACE.
- PATCH ANY DAMAGE DONE TO THE MUDPAN, WALLS OR OTHER MATERIALS. 34 CUT EXISTING TERRAZZO FLOOR AS NEEDED TO ACCOMMODATE NEW WORK. TAKE
- CARE TO CREATE A NEW FINISHED EDGE 35 DEMO EXISTING MARKERBOARD. PATCH, CLEAN AND PREP SURFACES FOR NEW WORK

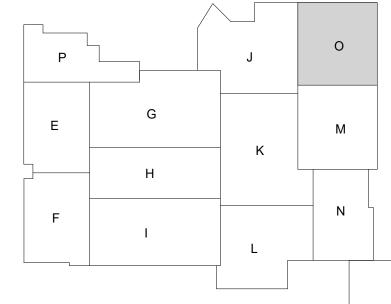






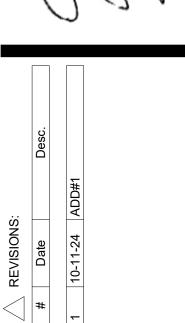


100% CONSTRUCTION<br/>DOCUMENTSPROJECT: #23138DATE: 09/26/2024DRAWN BY: Author

DEMOLITION PLAN - FIRST FLOOR - UNIT O

AD1010

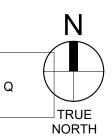

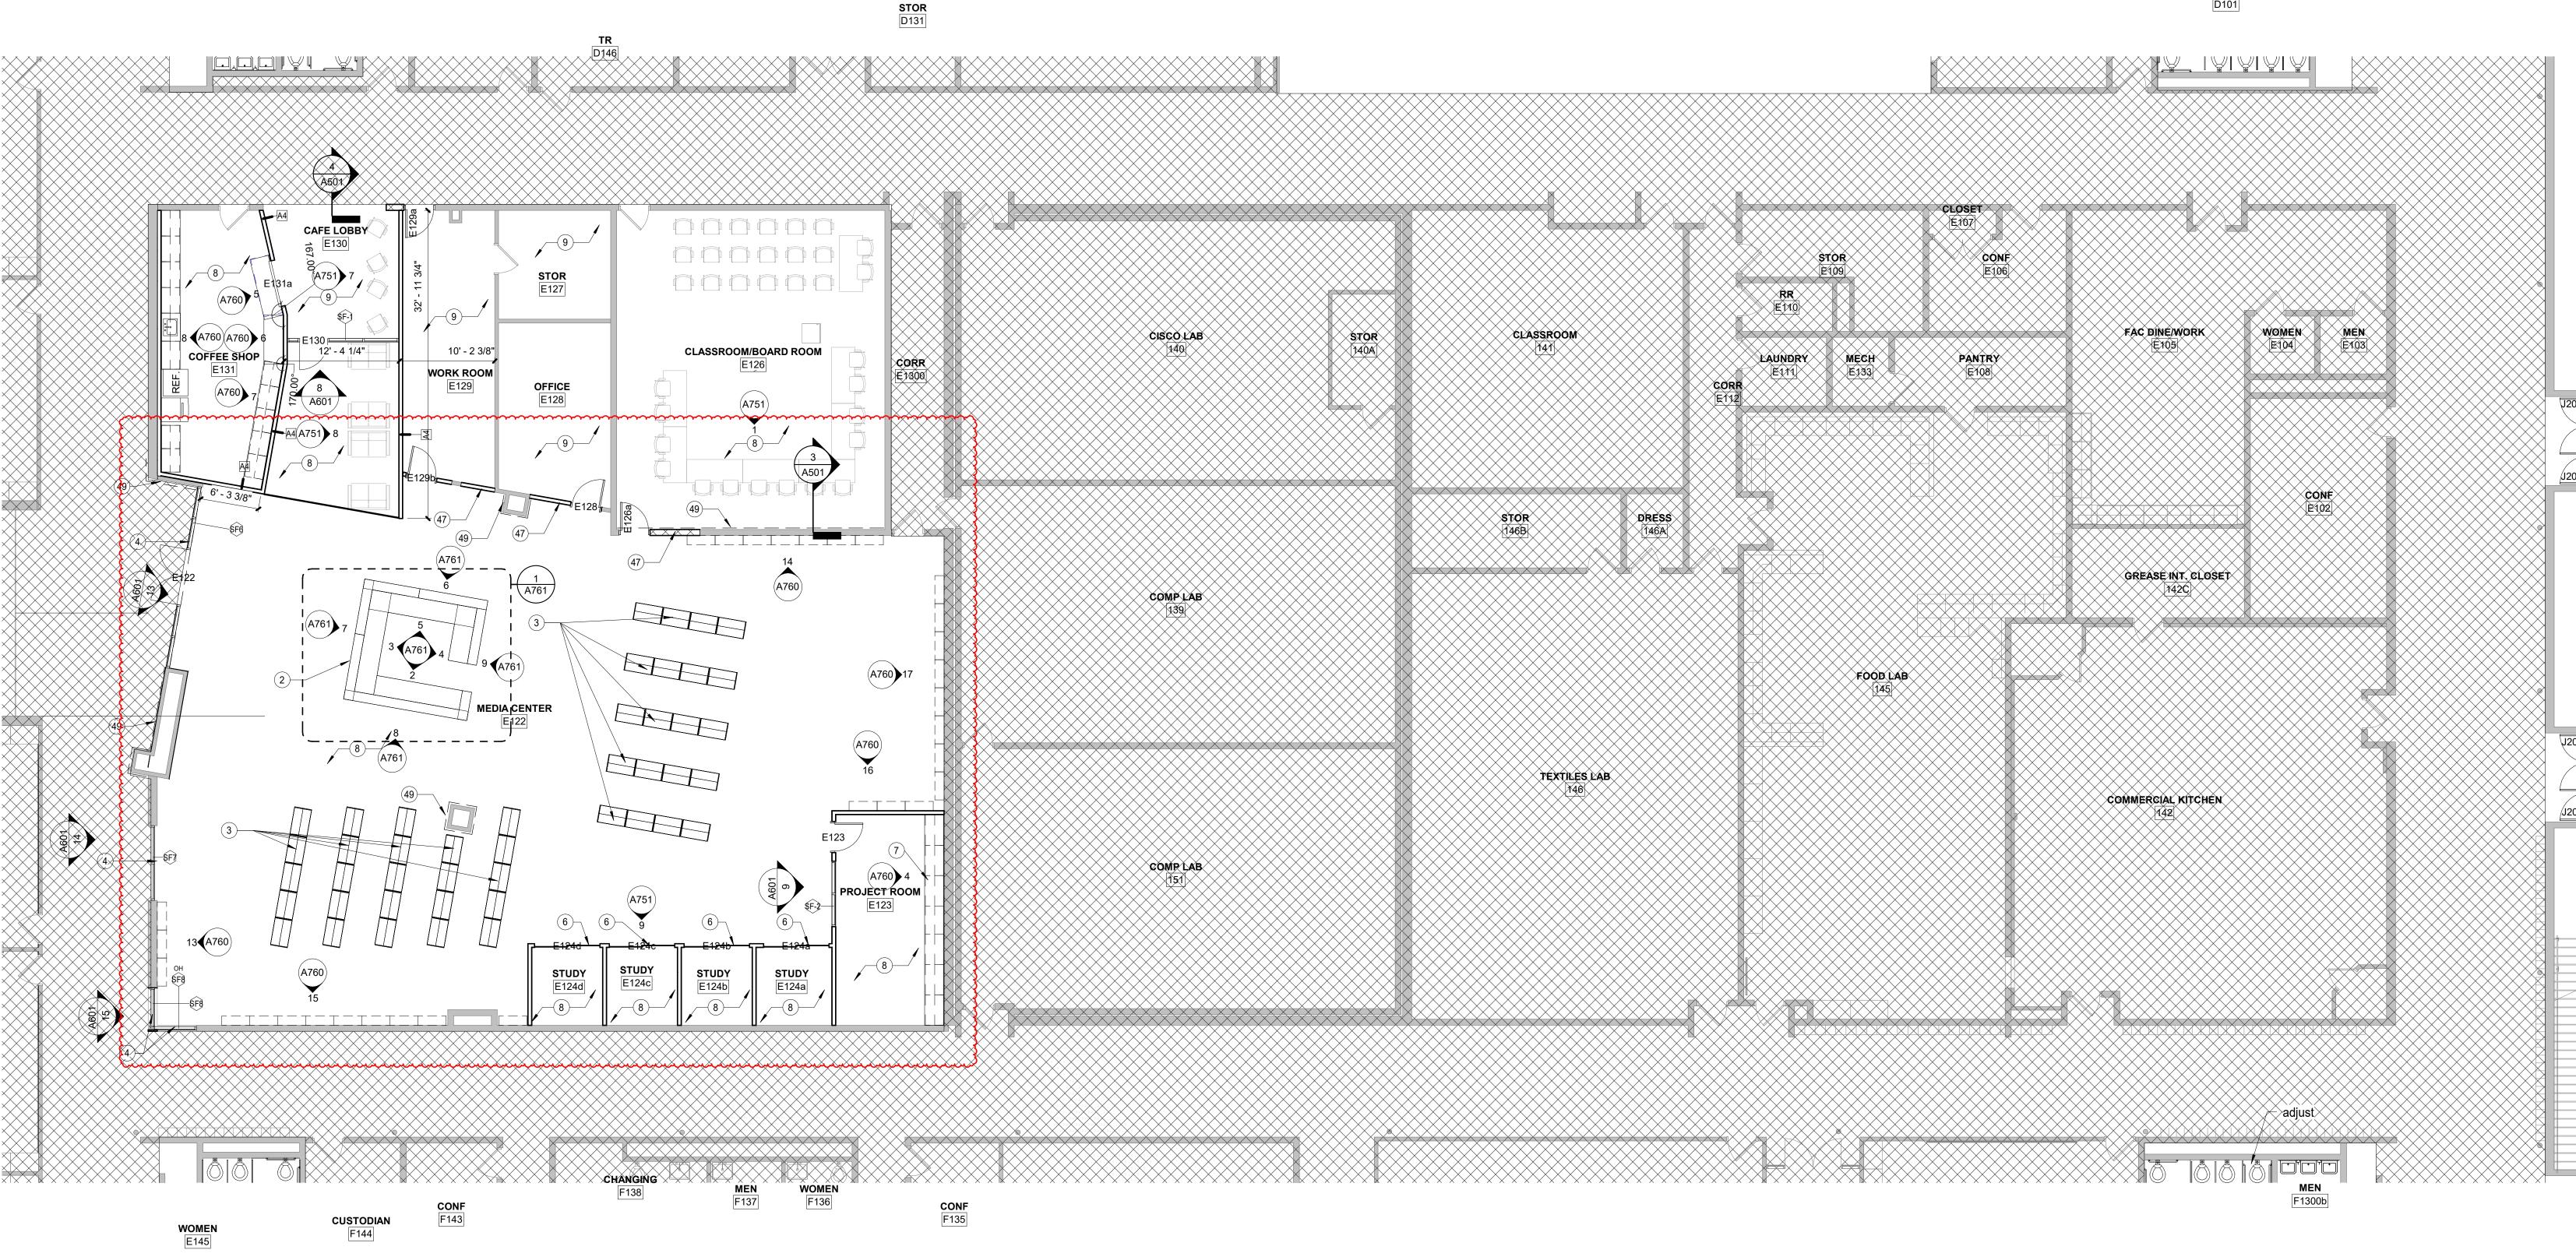

# **FIRST FLOOR UNIT PLAN - UNIT H** SCALE: 1/8" = 1'-0"

# O PLAN NOTES - FLOOR PLAN

### NEW MOTORIZED WINDOW SHADES, 11'-4" TALL VIF NEW MEDIA CENTER DESK. RUN UNDERSLAB POWER AND DATA

- 3 SAND AND STAIN EXISTING WOOD SHELVING. REPOSITION TO NEW LOCATIONS4 NEW ALUMINUM STOREFRONT
- 5 SAND AND STAIN EXISTING WOODWORK
- 6 SAND AND STAIN EXISTING WOODWORK7 NEW CASEWORK
- 8 NEW FLOORING (LVT/CPT), NEW WALL PAINT, NEW CEILING, NEW LIGHTING
  9 NEW FLOORING (LVT/CPT), NEW WALL PAINT
- 11 NEW OVERHEAD GRILLE. PROVIDE STEEL LINTEL AS NEEDED
- 12 NEW KITCHEN EQUIPMENT
   13 KITCHEN RENOVATION: NEW EPX FLOORING, NEW WALL PAINT, NEW CEILING GRID AND TILES
- IILES 14 ENLARGE DOOR OPENING
- 15 ENLARGE DOOR OPENING

25 PAINT RAW CONCRETE WALL


- 16 RELOCATE/ADJUST EXISTING WATER SERVICE (4" DOMESTIC SERVICE, 4" DOMESTIC, 6" FIRE PROTECTION SERVICE)
- 17 NEW SECTIONAL OVERHEAD DOOR
- 18 RELOCATE TRASH COMPACTOR HERE
- 19 NEW WALL COMPOSITION: 8" BLOCK, 2" RIGID INSULATION, FACE MASONRY TO MATCH EXISTING 8"X8" DARK BROWN MASONRY. WALLS TO GO UP TO 18'-0" AFF.
- 20 DEMO EXISTING SHOWER TO MAKE ROOM FOR 2 NEW CHANGING ROOMS
- 21 REPLACE EXISTING COUNTERTOP WITH NEW SOLID SURFACE
  22 DEMO EXISTING SHOWER AND COUNTERTOP TO MAKE ROOM FOR 2 NEW CHANGING
- ROOMS 24 REPLACE CARPET, SEE T-SERIES DRAWINGS FOR FLOOR MOLDS FOR ISLE LIGHTING


## ○ PLAN NOTES - FLOOR PLAN

- 26 LOCKER ROOM RENOVATION: NEW EPX FLOORING, NEW, NEW PAINT, NEW PLUMBING FIXTURES, RECONFIGUREATION OF LOCKER LAYOUT, RECONFIGUARION OF SHOWER LAYOUT
- 27 FIELDHOUSE RENOVATION: REPLACEMENT OF WALL PADDING
- 28 REPLACE EXISTING VINYL SIGNAGE WITH CUSTOM NEW GRAPHIC. 34'-0" X4'-4"
  29 CLEAN, PATCH EXISTING CONCRETE STAIRS. PROVIDE NEW RUBBER TREAD AND RISER
- 30 NEW DOOR IN EXISTING FRAME31 NEW 2 TIER METAL LOCKER MATCH EXISTING LOCKER COLOR SELECTED BY
- 32 NEW BACKLIT LETTERS. ALUMINUM. 18" TALL. "EAST CENTRAL HIGH SCHOOL"33 NEW RESTROOM
- 36 TEAM ROOM RENOVATION: NEW FLOORING, NEW PAINT, NEW DIGITAL DISPLAY ON SOUTH WALL
- 37 NEW BACKLIT LETTERS. ALUMINUM. 12" TALL. "SUNMAN-DEARBORN COMMUNITY SCHOOL CORPORATION"
- 38 NEW KITCHEN EQUIPMENT
- 39 INFILL WALL TO MATCH ADJACENT WALLS CONTRUCTION AND FINISHES
- 40 REPLACE THEATER SEATING WITH NEW SEATS. SEE T-SERIES DRAWINGS
- 41 SLIDING SECURITY GATE SIMILAR TO DYNAMIC CLOSUES EZ GRILLE. 8'-0" HIGH. PROVIDE UNISTRUT AS NEEDED TO SUPPORT THE GRILLE. PAINT BLACK
- 42 NEW FLOORING AND WALL BASE
- 43 NEW ADA DOOR OPERATOR
  44 CUSTOM VINYL GRAPHIC INSTALL OVER EXISTING STOREFRONT. UP TO 9'-0" AFF MULLION
- 45 RELOCATE EXISTING LOCKER TO NEW LOCATION
- 46 PROVIDE NEW FLOOR THRESHOLD AT DOOR
- 47 INFILL EXISTING WALL AFTER WALL OPENING WAS REMOVED48 NEW DOOR FRAME, NEW DOOR
- 49 INSTALL NEW SHEET OF 5/8" GYPSUM BOARD OVER EXISTING SURFACES


**WOMEN**D101




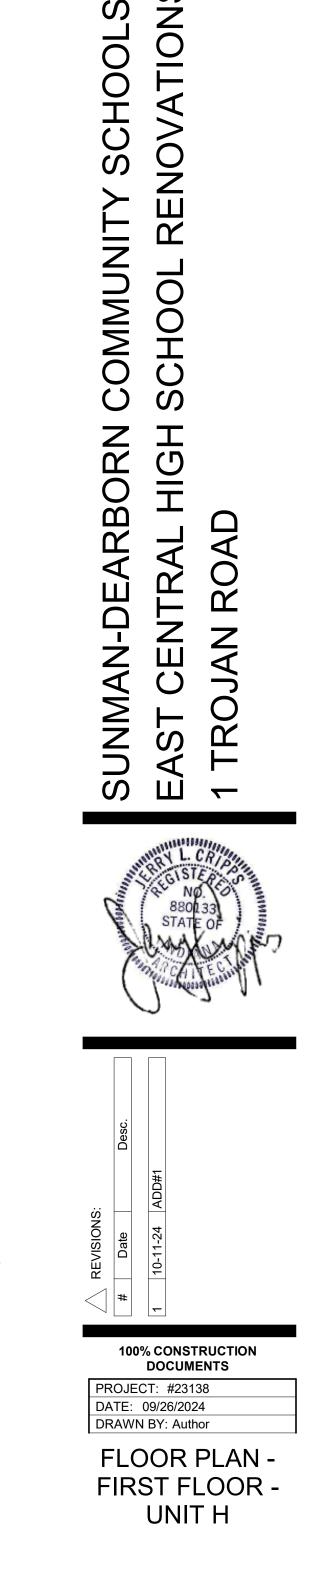

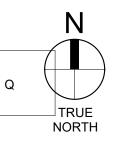



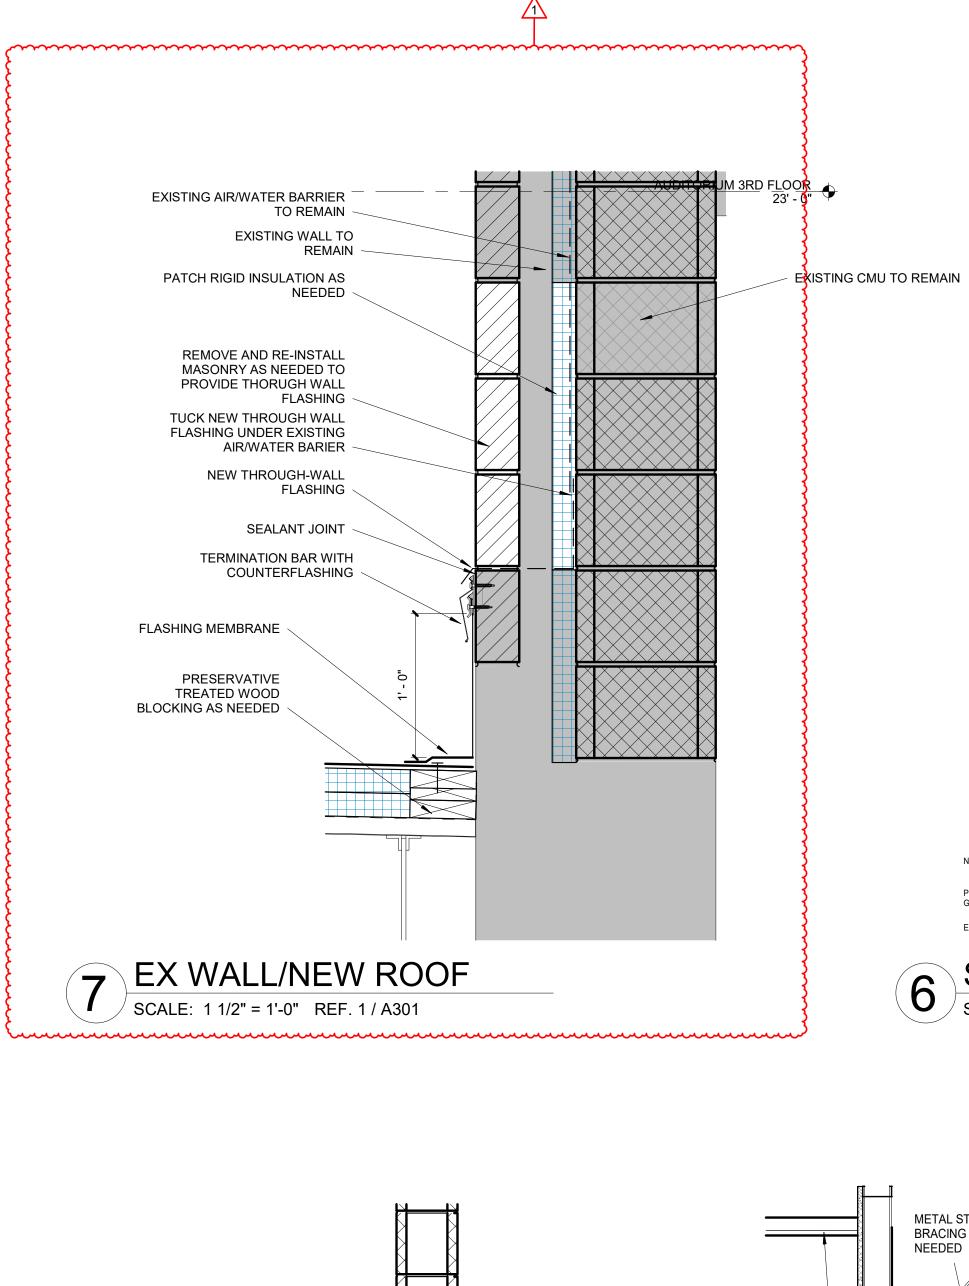

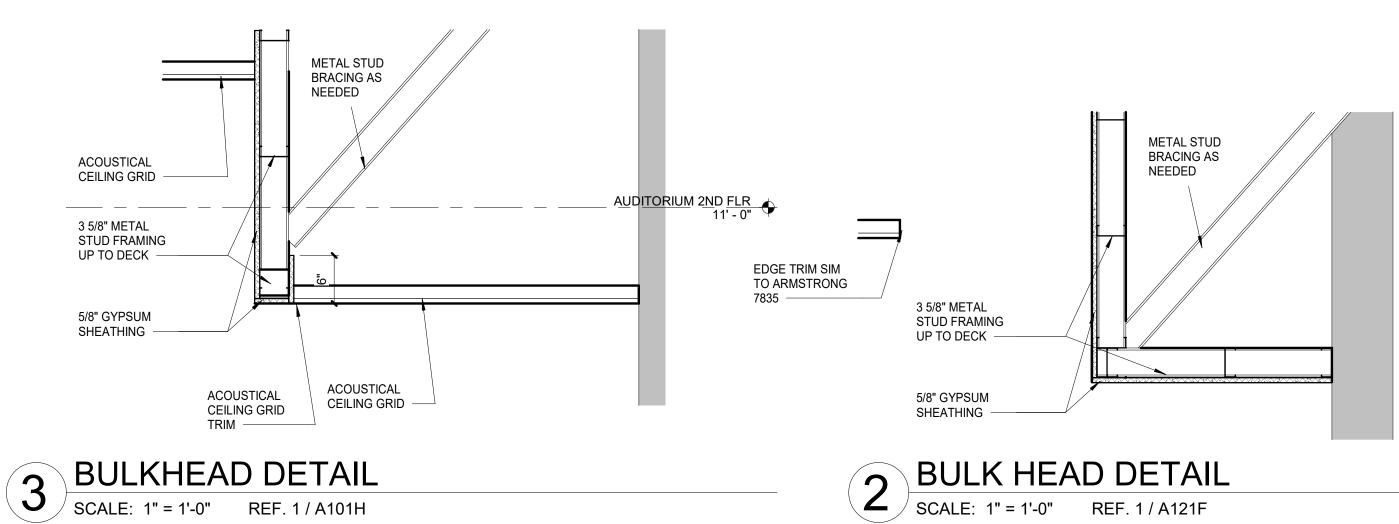

DEMO EXISTING WALL TO DECK -----

NEW ACOUSTICAL PANEL CEILING


EXISTING CEILING, PROVIDE NEW TRIM

5 SERVING CENTER OPENING SCALE: 1" = 1'-0" REF. 1 / A101G

PROVIDE AND OPEING FOR THE GRILLE TO COME DOWN

NEW MOTORIZED OVERHEAD COILING GRILLE

NEW TUBE STEEL —

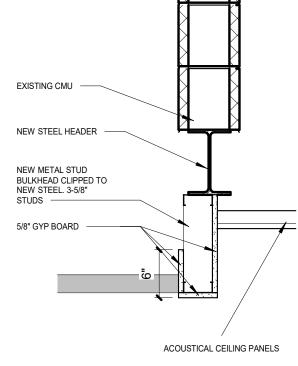



EX WALL TO REMAIN -

NEW CMU LINTEL PER STRUCTURAL


\_\_\_\_\_ NEW ACOUSTICAL PANEL CEILING

PROVIDE AND OPEING FOR THE GRILLE TO COME DOWN -

EXISTING CEILING, PROVIDE NEW TRIM


SCALE: 1" = 1'-0" REF. 1/A121G

NEW MOTORIZED OVERHEAD COILING GRILLE ABOVE THE CEILING

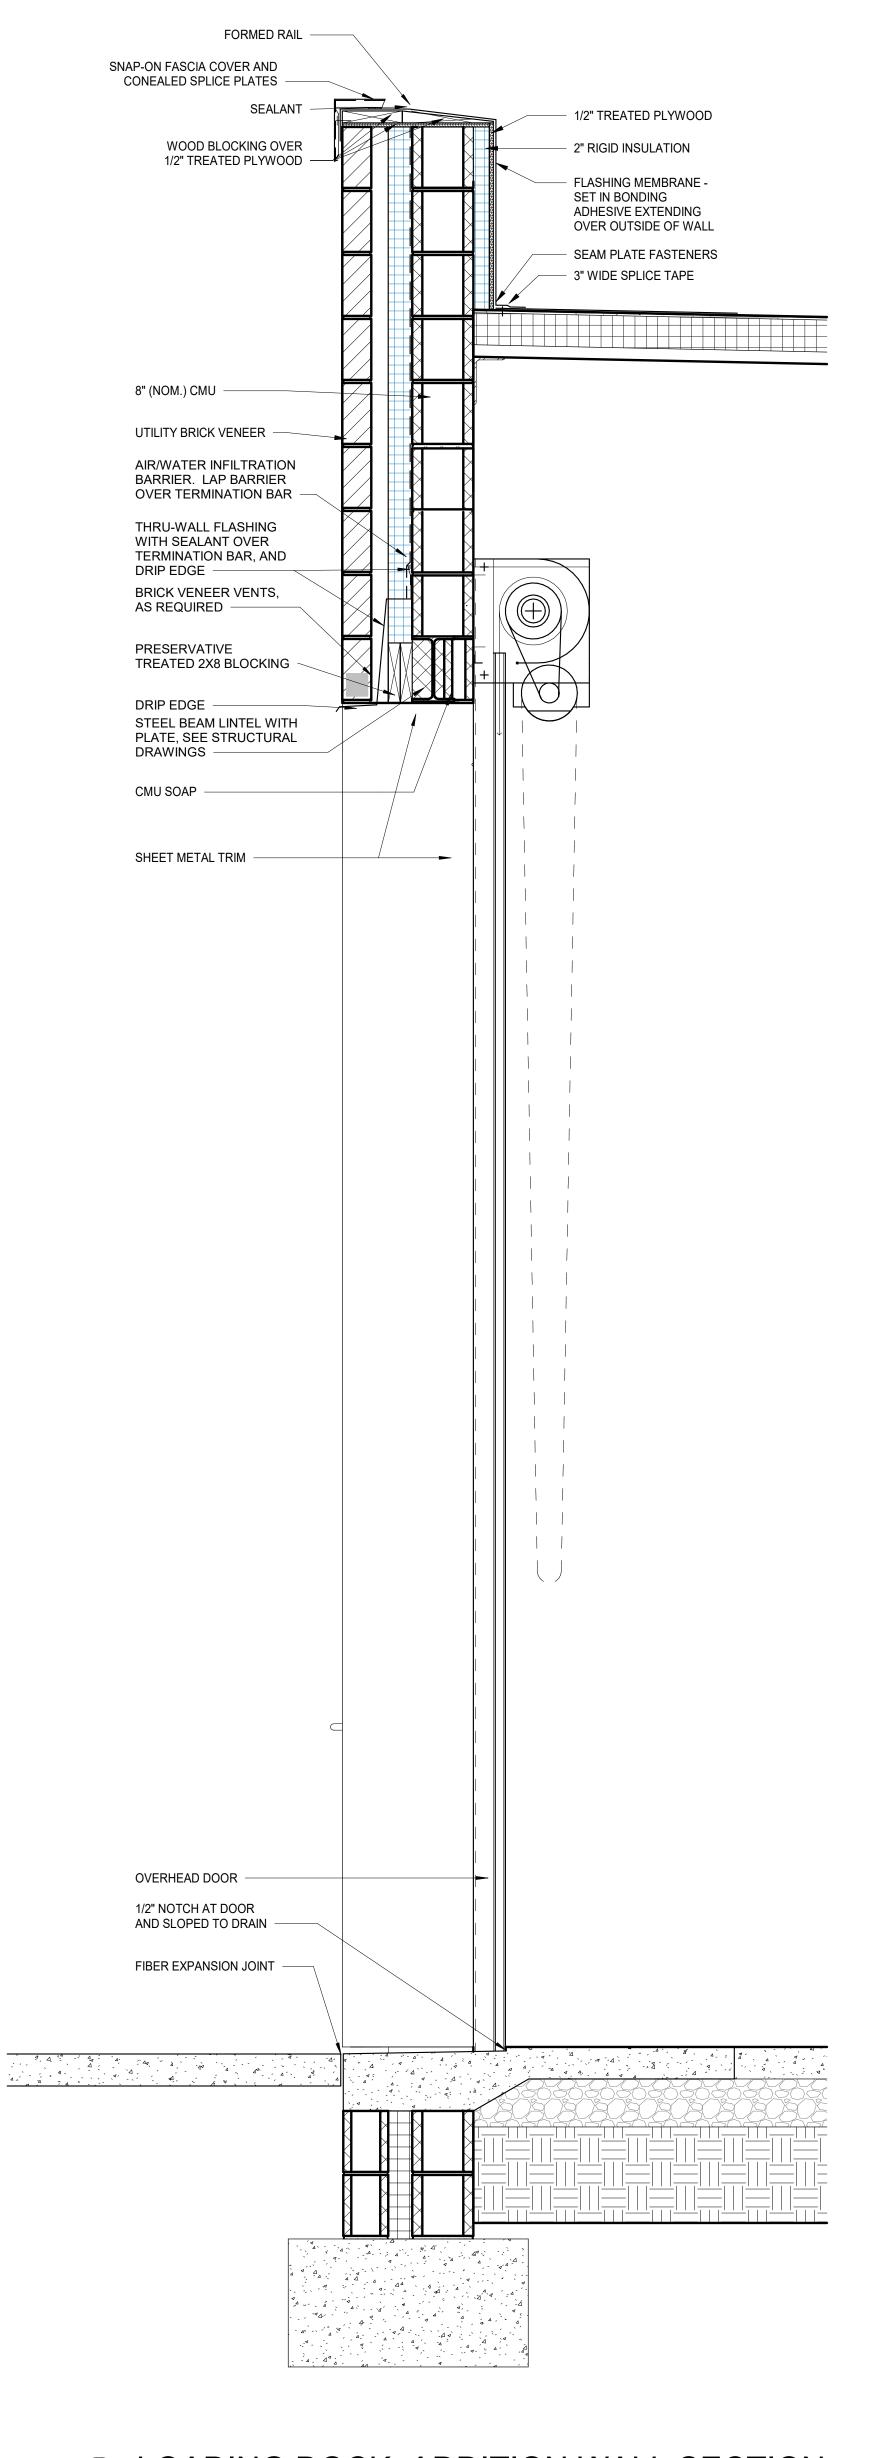

LOADING DOCK ADDITION WALL SECTION SCALE: 1" = 1'-0" REF. 1 / A101J



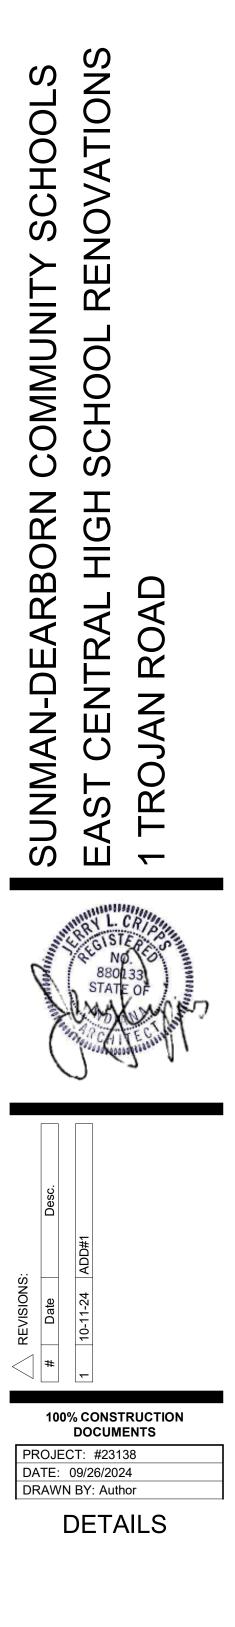



### GENERAL NOTES A. CONTRACTOR TO VERIFY EXISITING CONDITIONS AND REPAIR ALL EXISTING WALLS, SLAB, AND CEILINGS TO A CONDITION SUITABLE FOR ACCEPTING NEW FINISHES AS PER MANUFACTURER'S RECOMMENDED INSTALLATION METHODS. MINIMUM LEVEL 4 FINISH ON EXISTING AND NEW WALLS, UNLESS NOTED OTHERWISE. B. ALL FLOORING TRANSITIONS TO COMPLY WITH ADA GUIDELINES AND TO OCCUR UNDER CENTER OF DOORWAYS AND OR AT CENTERLINE OF WALL, UNLESS INDICATED DIFFERENTLY ON FINISH PLANS. PROVIDE REDUCER STRIPS WHEREVER CARPET OR LVT MEET CONCRETE. C. CONTRACTOR TO PROVIDE PROTECTION AS NEEDED DURING CONSTRUCTION. IF, ANY, TO PERSERVE NEW FINISHES WHILE COMPLETING CONSTRUCTION. D. CONTRACTOR SHALL BE RESPONSIBLE FOR VERIFICATION OF DIMENSIONS AND JOB CONDITIONS. ANY DEVIATION FROM WHAT IS INDICATED ON THE FINISH PLANS SHALL BE BROUGHT TO THE ATTENTION OF THE ARCHITECTS AND DESIGNERS. ALL DIMENSIONS SHOWN ARE TO FACE OF FINISH MATERIAL, UNLESS NOTED OTHERWISE. E. WHERE WALLS ARE INDICATED TO RECEIVE PAINT FINISH, PRIME AND PAINT GRILLES, FIRE EXTINGUISHER CABINETS, AND OTHER ITEMS EMBEDDED IN WALL CONSTRUCTION TO MATCH SURFACE ON WHICH THEY OCCUR. F. CONTRACTOR TO PROVIDE DRYWALL REVEAL JOINT WHERE DRYWALL MEETS DISSIMILAR MATERIALS. G. CONTRACTOR TO PROVIDE SCHLUTER EDGE WHERE TILE MEETS DISSIMILAR MATERIALS. REFER TO INTERIOR DETAILS FOR FURTHER DETAILS. H. DO NOT INSTALL GYPSUM BOARD BEHIND TILE BACKER BOARD LOCATIONS. I. IF ONLY PAINT IS INDICATED AS THE FINISH, REFER TO ARCHITECTURAL FLOOR PLANS FOR SUBSTRATE INFORMATION. J. ALL WALLS, COLUMNS, AND CEILINGS TO BE PAINTED PT-1, UNLESS NOTED OTHERWISE. K. PAINT ALL NEW HM DOOR FRAMES WITHIN SCOPE IN THEIR ENTIRETY, PT-5.

NOTES

# FINISH LEGEND

		•			
		EXISTING TO		<b>RESILIE</b> EPX-1:	
	FLOO	R COVERI	NG		TYPE
	CARPE CPT-1:	MFG:	INTERFACE		COLO INST
		TYPE: PATTERN: COLOR:	25CM X 1M CARPET PLANK AE311 104672 GREIGE		LOC/ CON
		INSTALL:	ASHLAR, REF. PLAN FOR DIRECTION	EPX-2:	MFG:
~		LOCATION: CONTACT:	TYPICAL, UNLESS NOTED OTHERWISE JAE PARK 317-459-8762		TYPE COLO
•	CPT-2:	MFG: TYPE: PATTERN: COLOR:	INTERFACE 25CM X 1M CARPET PLANK AE317 105825 POPPY		LOCA REM CON
			ASHLAR, REF. PLAN FOR DIRECTION MEDIA CENTER ACCENT	RUB-1:	MFG: TYPE
			WHEN CPT-1 AND CPT-2 ARE COMBINED, CPT-1 IS TO BE 90% AND CPT-2 IS TO BE 10%		PATT
~	CPT-3:	TYPE:	MANNINGTON BROADLOOM - INTEGRA HP BACKING		INST, LOCA REM,
		PATTERN: COLOR:	33642 REPELETRON		CON
			DIRECTIONAL AUDITORIUM NEIL MACK 317-800-0680	RUB-2:	MFG: TYPE
	RESILIE	NT FLOOR			PATT
	LVT-1:	MFG: TYPE: PATTERN: COLOR: INSTALL:	INTERFACE 25CM X 1M RESILIENT PLANK A007 STUDIO SET A00702 PEWTER ASHLAR, REF. PLAN FOR DIRECTION		COLO INST/ LOC/ REM/
		LOCATION: CONTACT:	TYPICAL, UNLESS NOTED OTHERWISE JAE PARK 317-459-8762		CON

LVT-2: MFG: INTERFACE TYPE: 25CM X 1M RESILIENT PLANK PATTERN: A007 STUDIO SET COLOR: A00710 POPPY INSTALL: ASHLAR, REF. PLAN FOR DIRECTION LOCATION: MEDIA CENTER ACCENT CONTACT: JAE PARK 317-459-8762

FLOOR CO

)	R COVERING (CONT.)MFG:SHERWIN WILLIAMS HIGH PERFORMANCE FLOORINGTYPE:RESUFLOR DECO QUARTZ BC23 EPOXY SYSTEMCOLOR:STORMY EVENINGINSTALL:MONOLITHIC, 6" INTEGRAL COVE BASE, REF. SPECSLOCATION:RESTROOMS CONTACT:KAREN E. MCILWAIN 317-714-5610MFG:SHERWIN WILLIAMS HIGH PERFORMANCE FLOORING TYPE:TYPE:FASTOP MULTI TOPFLOOR SL45 COLOR:MID GRAYINSTALL:MONOLITHIC, 6" INTEGRAL COVE BASE, REF. SPECSLOCATION:KITCHEN REMARKS:REMARKS:INCLUDE GRIT, REF. SPECS CONTACT:KAREN E. MCILWAIN 317-714-5610MFG:NORA TYPE:INTEGRAL RUBBER STAIR TREAD AND RISERPATTERN:NORAMENT HAMMERED STAIRTREADCOLOR:DUST GREY 0884 INSTALL:DIRECTIONAL LOCATION:STAIRS REMARKS:REMARKS:INCLUDE NOSING WHERE TOP STEP MEETS LANDING, REF. DETAILCONTACT:ROB GROM 317-764-9025MFG:NORA INTEGRAL RUBBER STAIR TREAD	
E		SHERWIN WILLIAMS HIGH
	TYPE:	RESUFLOR DECO QUARTZ
		STORMY EVENING MONOLITHIC, 6" INTEGRAL COVE
		RESTROOMS
	MFG:	-
	COLOR:	FASTOP MULTI TOPFLOOR SL45 MID GRAY MONOLITHIC, 6" INTEGRAL COVE
	REMARKS:	KITCHEN INCLUDE GRIT, REF. SPECS
	-	INTEGRAL RUBBER STAIR TREAD
	PATTERN:	NORAMENT HAMMERED
	INSTALL:	DUST GREY 0884 DIRECTIONAL
		INCLUDE NOSING WHERE TOP STEP MEETS LANDING, REF.
	CONTACT:	
	-	NORA INTEGRAL RUBBER STAIR TREAD AND RISER
	PATTERN:	NORAMENT HAMMERED STAIRTREAD
	Color: INSTALL: LOCATION: REMARKS:	SLATE GREY 0716 DIRECTIONAL AUDITORIUM STAIRS PROVIDE VISUALLY IMPAIRED

REMARKS: PROVIDE VISUALLY IMPAIRED SMOOTH STRIP AT EACH TREAD. COLOR TO BE LIGHT GREY 0122 CONTACT: ROB GROM 317-764-9025

WALL	BASE		PAIN	PAINT/WALL FINISH											
<b>RESILIE</b> RB-1:	ent base MFG: Type: Color: Location:	TARKETT JOHNSONITE 6" RESILIENT WALL BASE 48 GREY TYPICAL, UNLESS NOTED	<b>PAINT</b> PT-1:	MFG: Type: Color: Location:	SHERWIN WILLIAMS REF. SPECS FOR TYPE SW7570 EGRET WHITE TYPICAL										
		OTHERWISE COLOR TO BE USED WITH ALL VINYL TRANSITION STRIPS JEN MAYNARD 765-480-3266	PT-2:	MFG: TYPE: COLOR: LOCATION:											
EPOXY	BASE														
EB-1:	MFG: TYPE:	SHERWIN WILLIAMS HIGH PERFORMANCE FLOORING RESUFLOR DECO FLAKE BC23 EPOXY SYSTEM	PT-3:	MFG: TYPE: COLOR: LOCATION:											
I		STORMY EVENING MONOLITHIC, 6" INTEGRAL COVE BASE, REF. SPECS RESTROOMS KAREN E. MCILWAIN 317-714-5610	PT-4:	MFG: TYPE: COLOR: LOCATION:											
EB-2:	MFG: TYPE: COLOR:	SHERWIN WILLIAMS HIGH PERFORMANCE FLOORING FASTOP MULTI TOPFLOOR SL45 MID GRAY	PT-5:	TYPE: COLOR:	SHERWIN WILLIAMS REF. SPECS FOR TYPE SW7068 GRIZZLE GRAY ALL NEW HM DOOR FRAMES										
		MONOLITHIC, 6" INTEGRAL COVE BASE, REF. SPECS KITCHEN INCLUDE GRIT, REF. SPECS KAREN E. MCILWAIN 317-714-5610	WALL 1 WT-1:	MFG: TYPE: PATTERN: COLOR: GROUT: INSTALL: LOCATION:	STEREO GREY VL73 MAPEI 93 WARM GRAY										

### N WILLIAMS ECS FOR TYPE EGRET WHITE

### N WILLIAMS CS FOR TYPE

### N WILLIAMS ECS FOR TYPE

MANAMANA MANAMANA MANAMANA

PLASTIC LAMINATE/SOLID SURFACE	•
--------------------------------	---

PLASTIC LAMINATE PL-1: MFG: FORMICA TYPE: PLASTIC LAMINATE COLOR: DANISH MAPLE 8906-58 INSTALL: MONOLITHIC, VERTICAL GRAIN LOCATION: TYPICAL, UNLESS NOTED OTHERWISE CONTACT: KYLIE LEYBA 317-869-8717

SOLID SURFACE SS-1: MFG: CORIAN TYPE: 1/2" SOLID SURFA COLOR: SILVER BIRCH 1/2" SOLID SURFACE INSTALL: MONOLITHIC, HORIZONTAL GRAIN LOCATION: CIRCULATION DESK

SS-2: MFG: CORIAN TYPE: 1/2" SOLID SURFAC COLOR: ASH CONCRETE 1/2" SOLID SURFACE INSTALL: MONOLITHIC, HORIZONTAL GRAIN LOCATION: TYPICAL COUNTERTOP

MISC.

WINDO	W TREATMEN	ITS
TEX-1:	MFG:	MECHO
	TYPE:	MOTORI
		OPENNE
		ELECTR
		MOUNTE
	PATTERN:	SOHO 16
	COLOR:	DOVE GI
	LOCATION:	NATATO
WALL P	ROTECTION	
WP-1:		FORMIC
	TYPE:	HARDST
	COLOR:	DANISH
	INSTALL:	MONOLI
		MANF. IN
	LOCATION:	MEDIA C
	REMARKS:	USE MAI
		DESIGNE

O SYSTEMS RIZED ROLLER SHADE - 3% IESS, WHISPER IQ+ MOTOR, RO 2 BRACKET FOR SURFACE TED SHADE 1600 GREY ORIUM

CA STOP PANELS H MAPLE 8906-58 LITHIC, VERTICAL GRAIN, REF. INSTALL GUIDE CENTER ANUFACTURER PROVIDED TRIM. NER TO SELECT COLOR.


### AUDITORIUM

SEATING CH-1: MFG: TYPE: SEAT: BACK: LIGHT: BASE: FABRIC: LOCATION: AUDITORIUM

SERIES SEATING VERA CLASSIC 24"W BER SC 20.5, 3/4 SEAT FOLD UPHOLSTERED BER BC H35X20.5 UPHOLSTERED WITH PLEAT END PANEL: BER WOOD MEDIUM 20 L/R VENEER INSERT - PECAN OPEN PORE STAIN ARM REST: BER WOOD (RIGHT), BER POLYURETHANE (LEFT) CONCEALED LED MOUNTED IN END PANELS STEEL PLATFORM, BLACK POWDERCOAT STANDARD GRADE 5 - AVANA - 191557 REMARKS: REF. AUDITORIUM DRAWINGS FOR END PANEL AND AISLE LIGHT

LOCATIONS




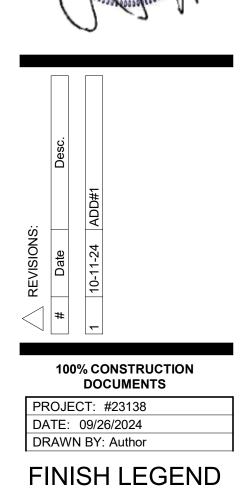







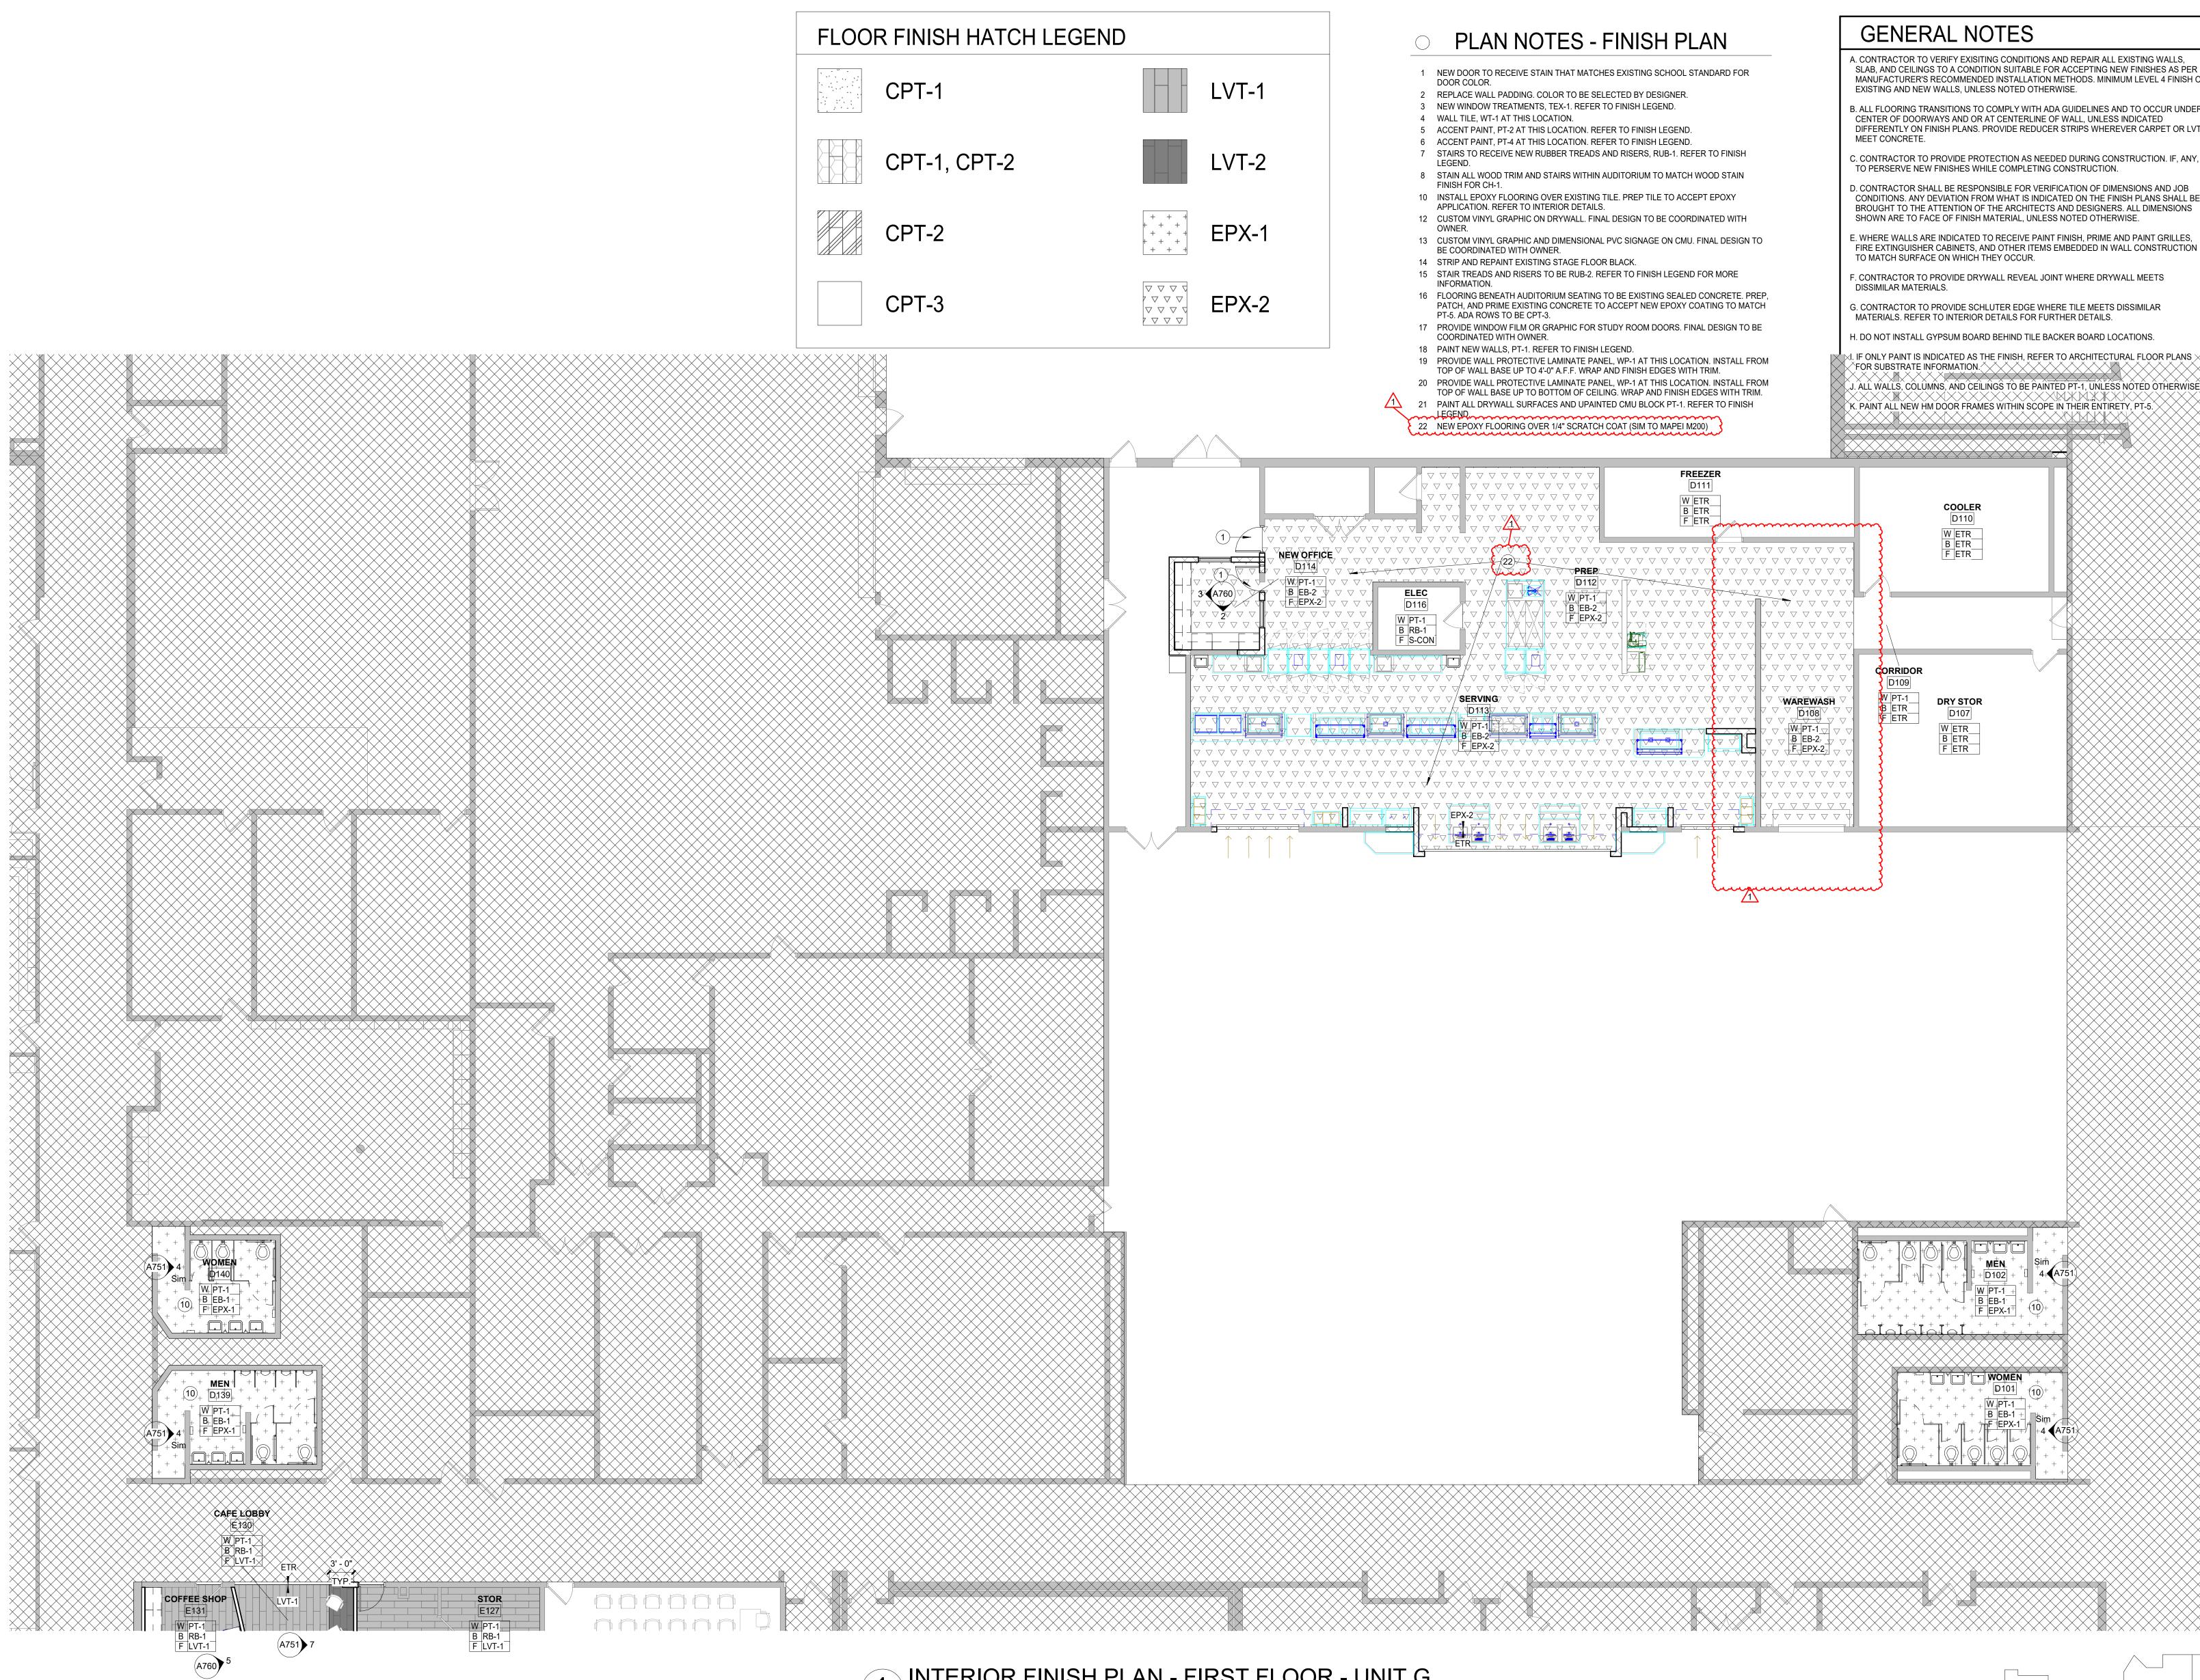

INTERIOR FINISH PLAN - FIRST FLOOR - UNIT G SCALE: 1/8" = 1'-0"

A. CONTRACTOR TO VERIFY EXISITING CONDITIONS AND REPAIR ALL EXISTING WALLS. SLAB, AND CEILINGS TO A CONDITION SUITABLE FOR ACCEPTING NEW FINISHES AS PER MANUFACTURER'S RECOMMENDED INSTALLATION METHODS. MINIMUM LEVEL 4 FINISH ON EXISTING AND NEW WALLS, UNLESS NOTED OTHERWISE.

B. ALL FLOORING TRANSITIONS TO COMPLY WITH ADA GUIDELINES AND TO OCCUR UNDER CENTER OF DOORWAYS AND OR AT CENTERLINE OF WALL, UNLESS INDICATED DIFFERENTLY ON FINISH PLANS. PROVIDE REDUCER STRIPS WHEREVER CARPET OR LVT

C. CONTRACTOR TO PROVIDE PROTECTION AS NEEDED DURING CONSTRUCTION. IF, ANY, TO PERSERVE NEW FINISHES WHILE COMPLETING CONSTRUCTION.


D. CONTRACTOR SHALL BE RESPONSIBLE FOR VERIFICATION OF DIMENSIONS AND JOB CONDITIONS. ANY DEVIATION FROM WHAT IS INDICATED ON THE FINISH PLANS SHALL BE BROUGHT TO THE ATTENTION OF THE ARCHITECTS AND DESIGNERS. ALL DIMENSIONS SHOWN ARE TO FACE OF FINISH MATERIAL, UNLESS NOTED OTHERWISE.

E. WHERE WALLS ARE INDICATED TO RECEIVE PAINT FINISH, PRIME AND PAINT GRILLES, FIRE EXTINGUISHER CABINETS, AND OTHER ITEMS EMBEDDED IN WALL CONSTRUCTION

F. CONTRACTOR TO PROVIDE DRYWALL REVEAL JOINT WHERE DRYWALL MEETS G. CONTRACTOR TO PROVIDE SCHLUTER EDGE WHERE TILE MEETS DISSIMILAR

H. DO NOT INSTALL GYPSUM BOARD BEHIND TILE BACKER BOARD LOCATIONS.


(J. ALL WALLS, COLUMNS, AND CEILINGS TO BE PAINTED PT-1, UNLESS NOTED OTHERWISE." K. PAINT ALL NEW HM DOOR FRAMES WITHIN SCOPE IN THEIR ENTIRETY, PT-5.

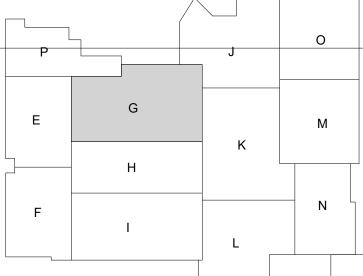


Ν


 $\mathbf{T}$ 


TRUE NORTH

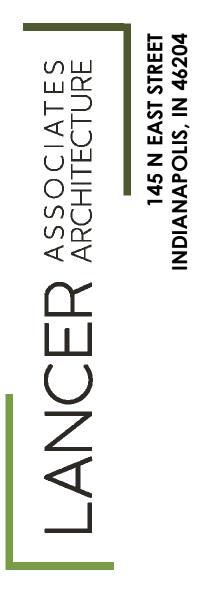

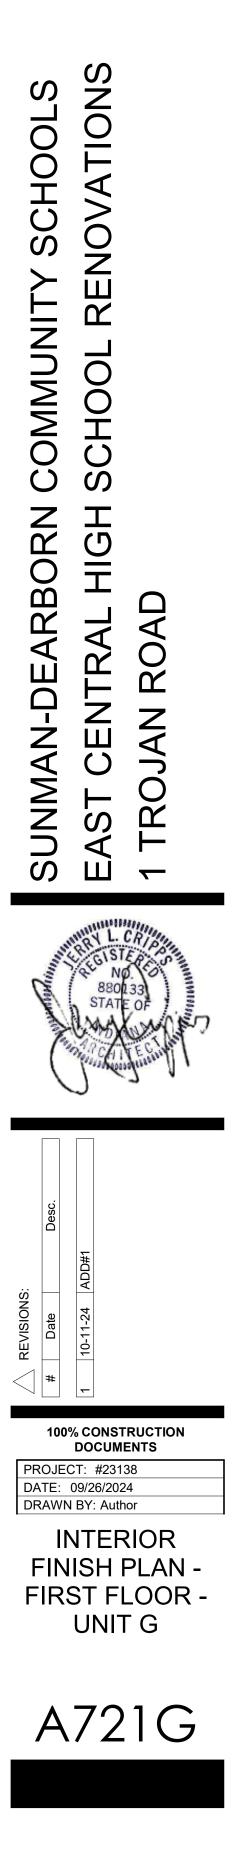



HEC.

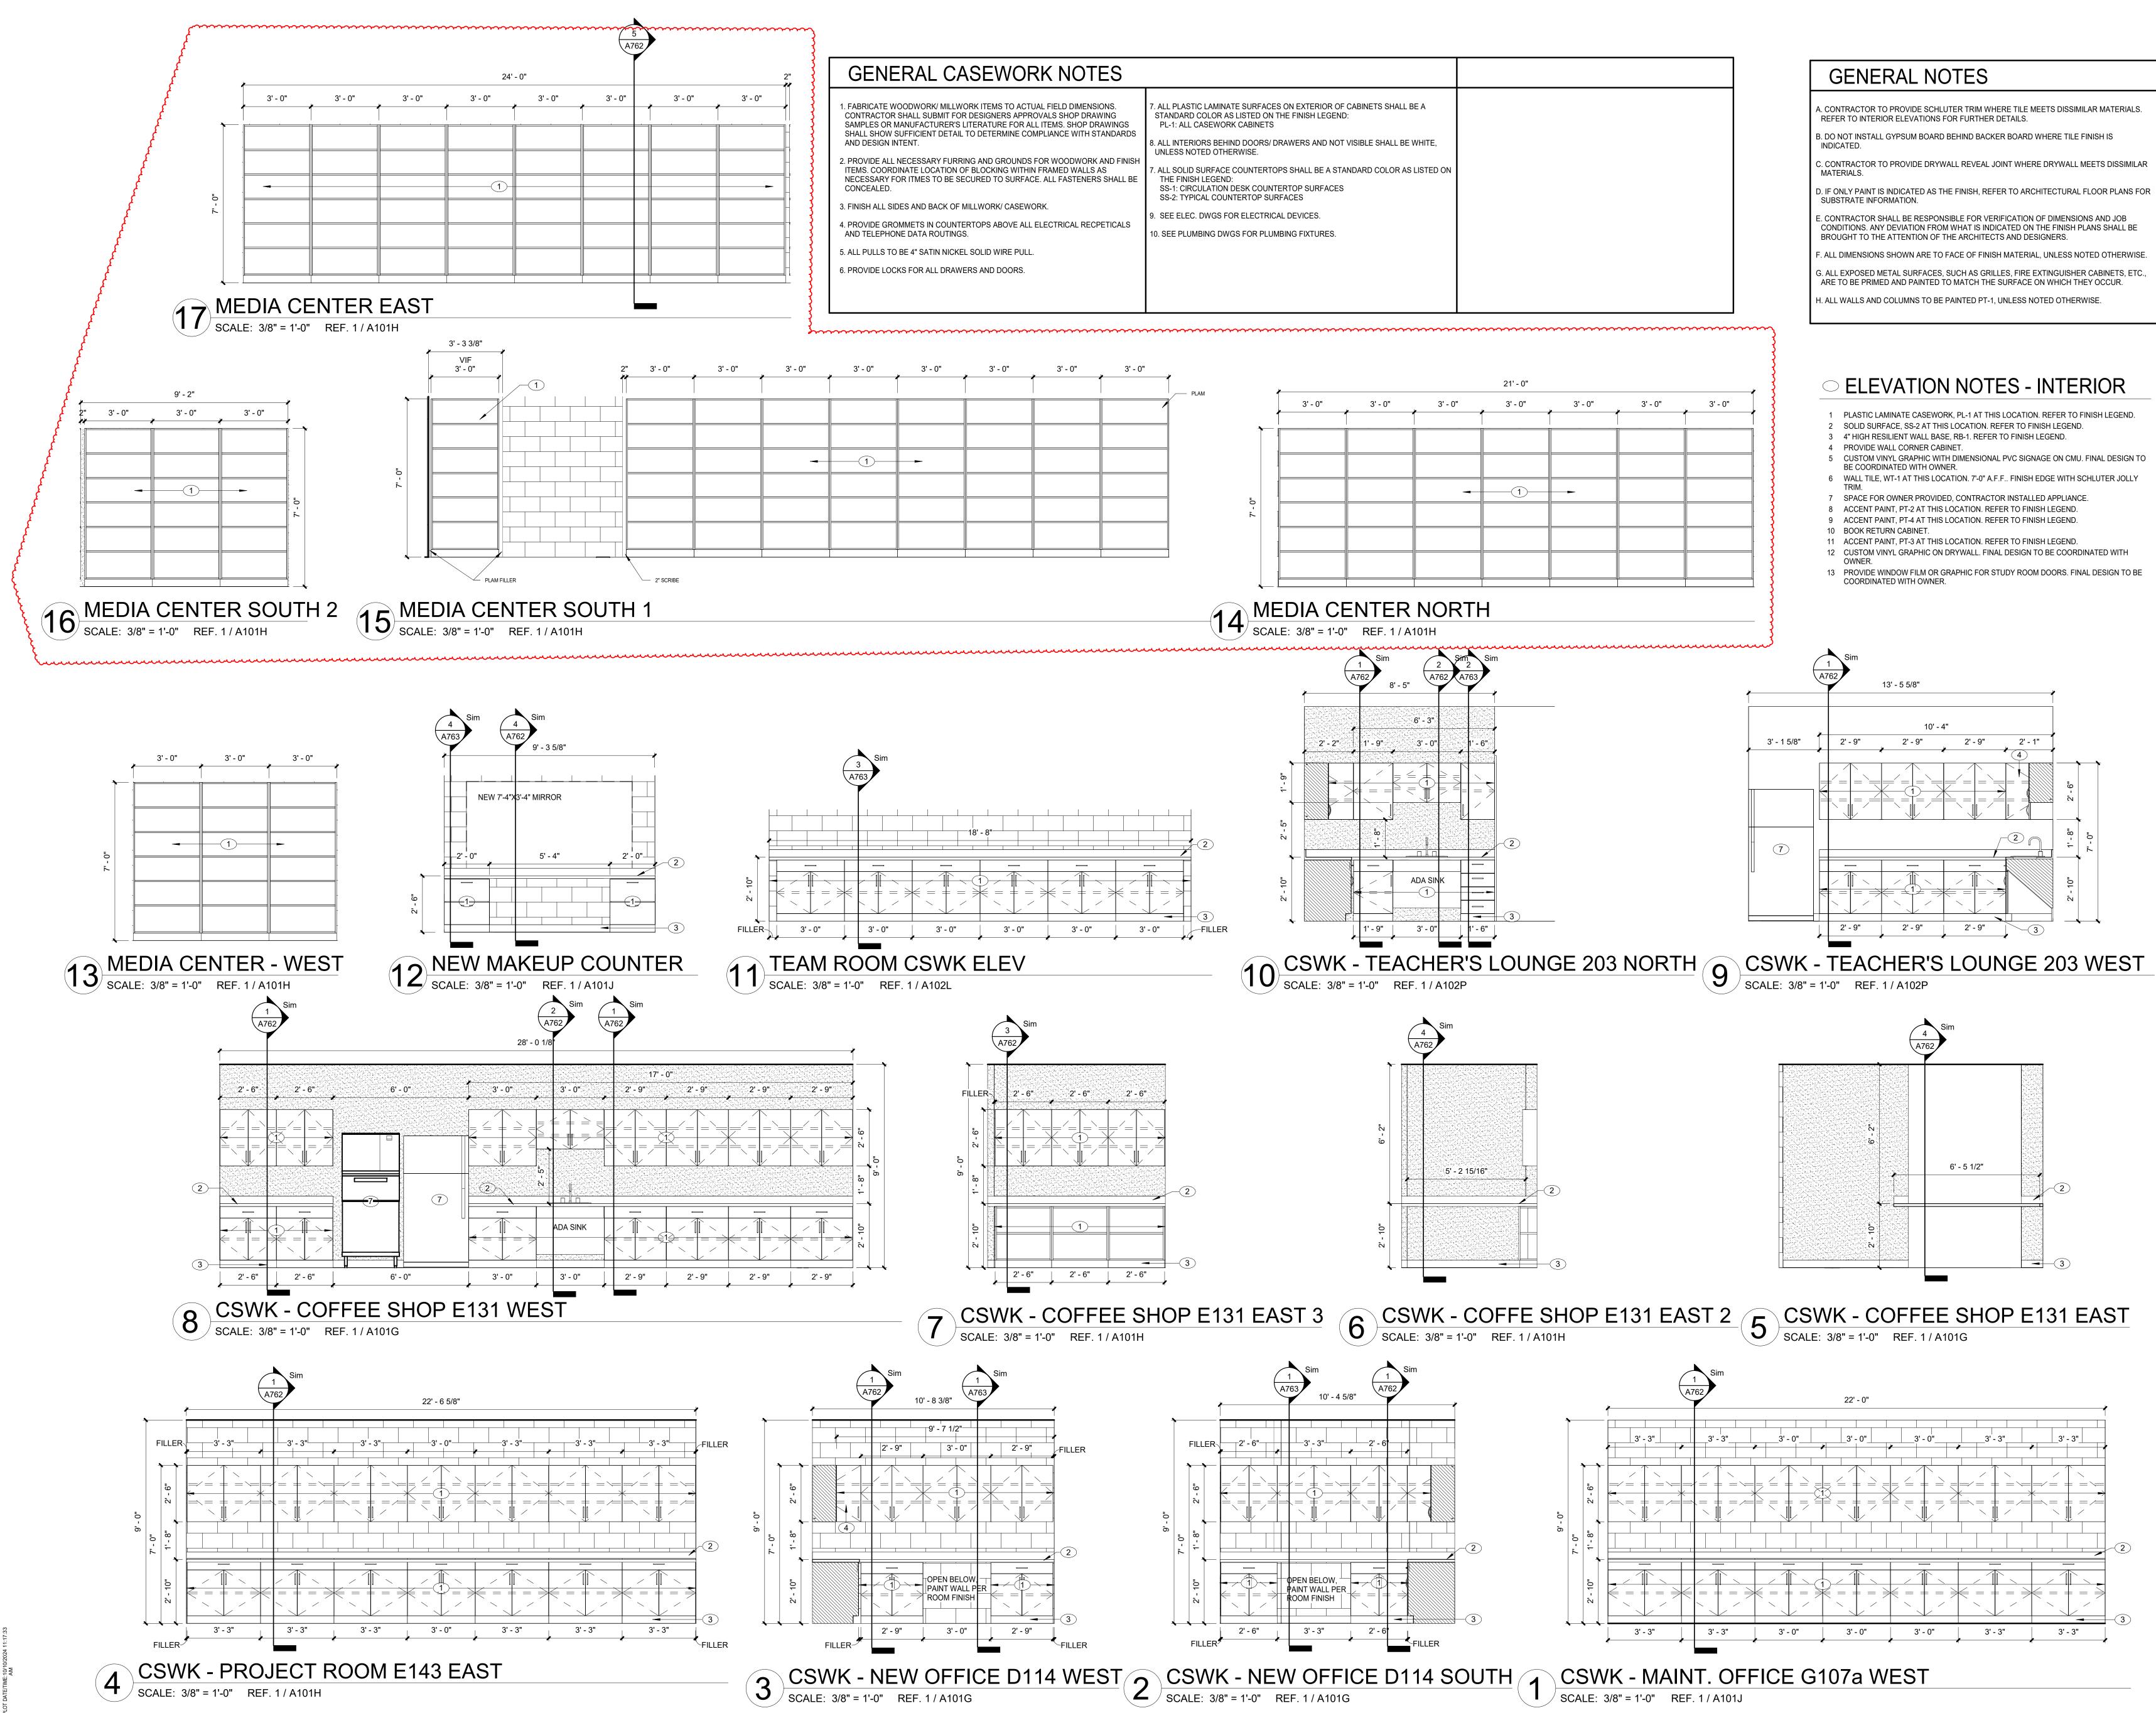

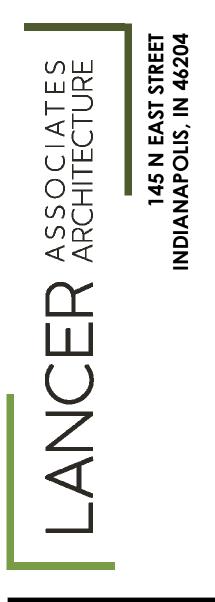




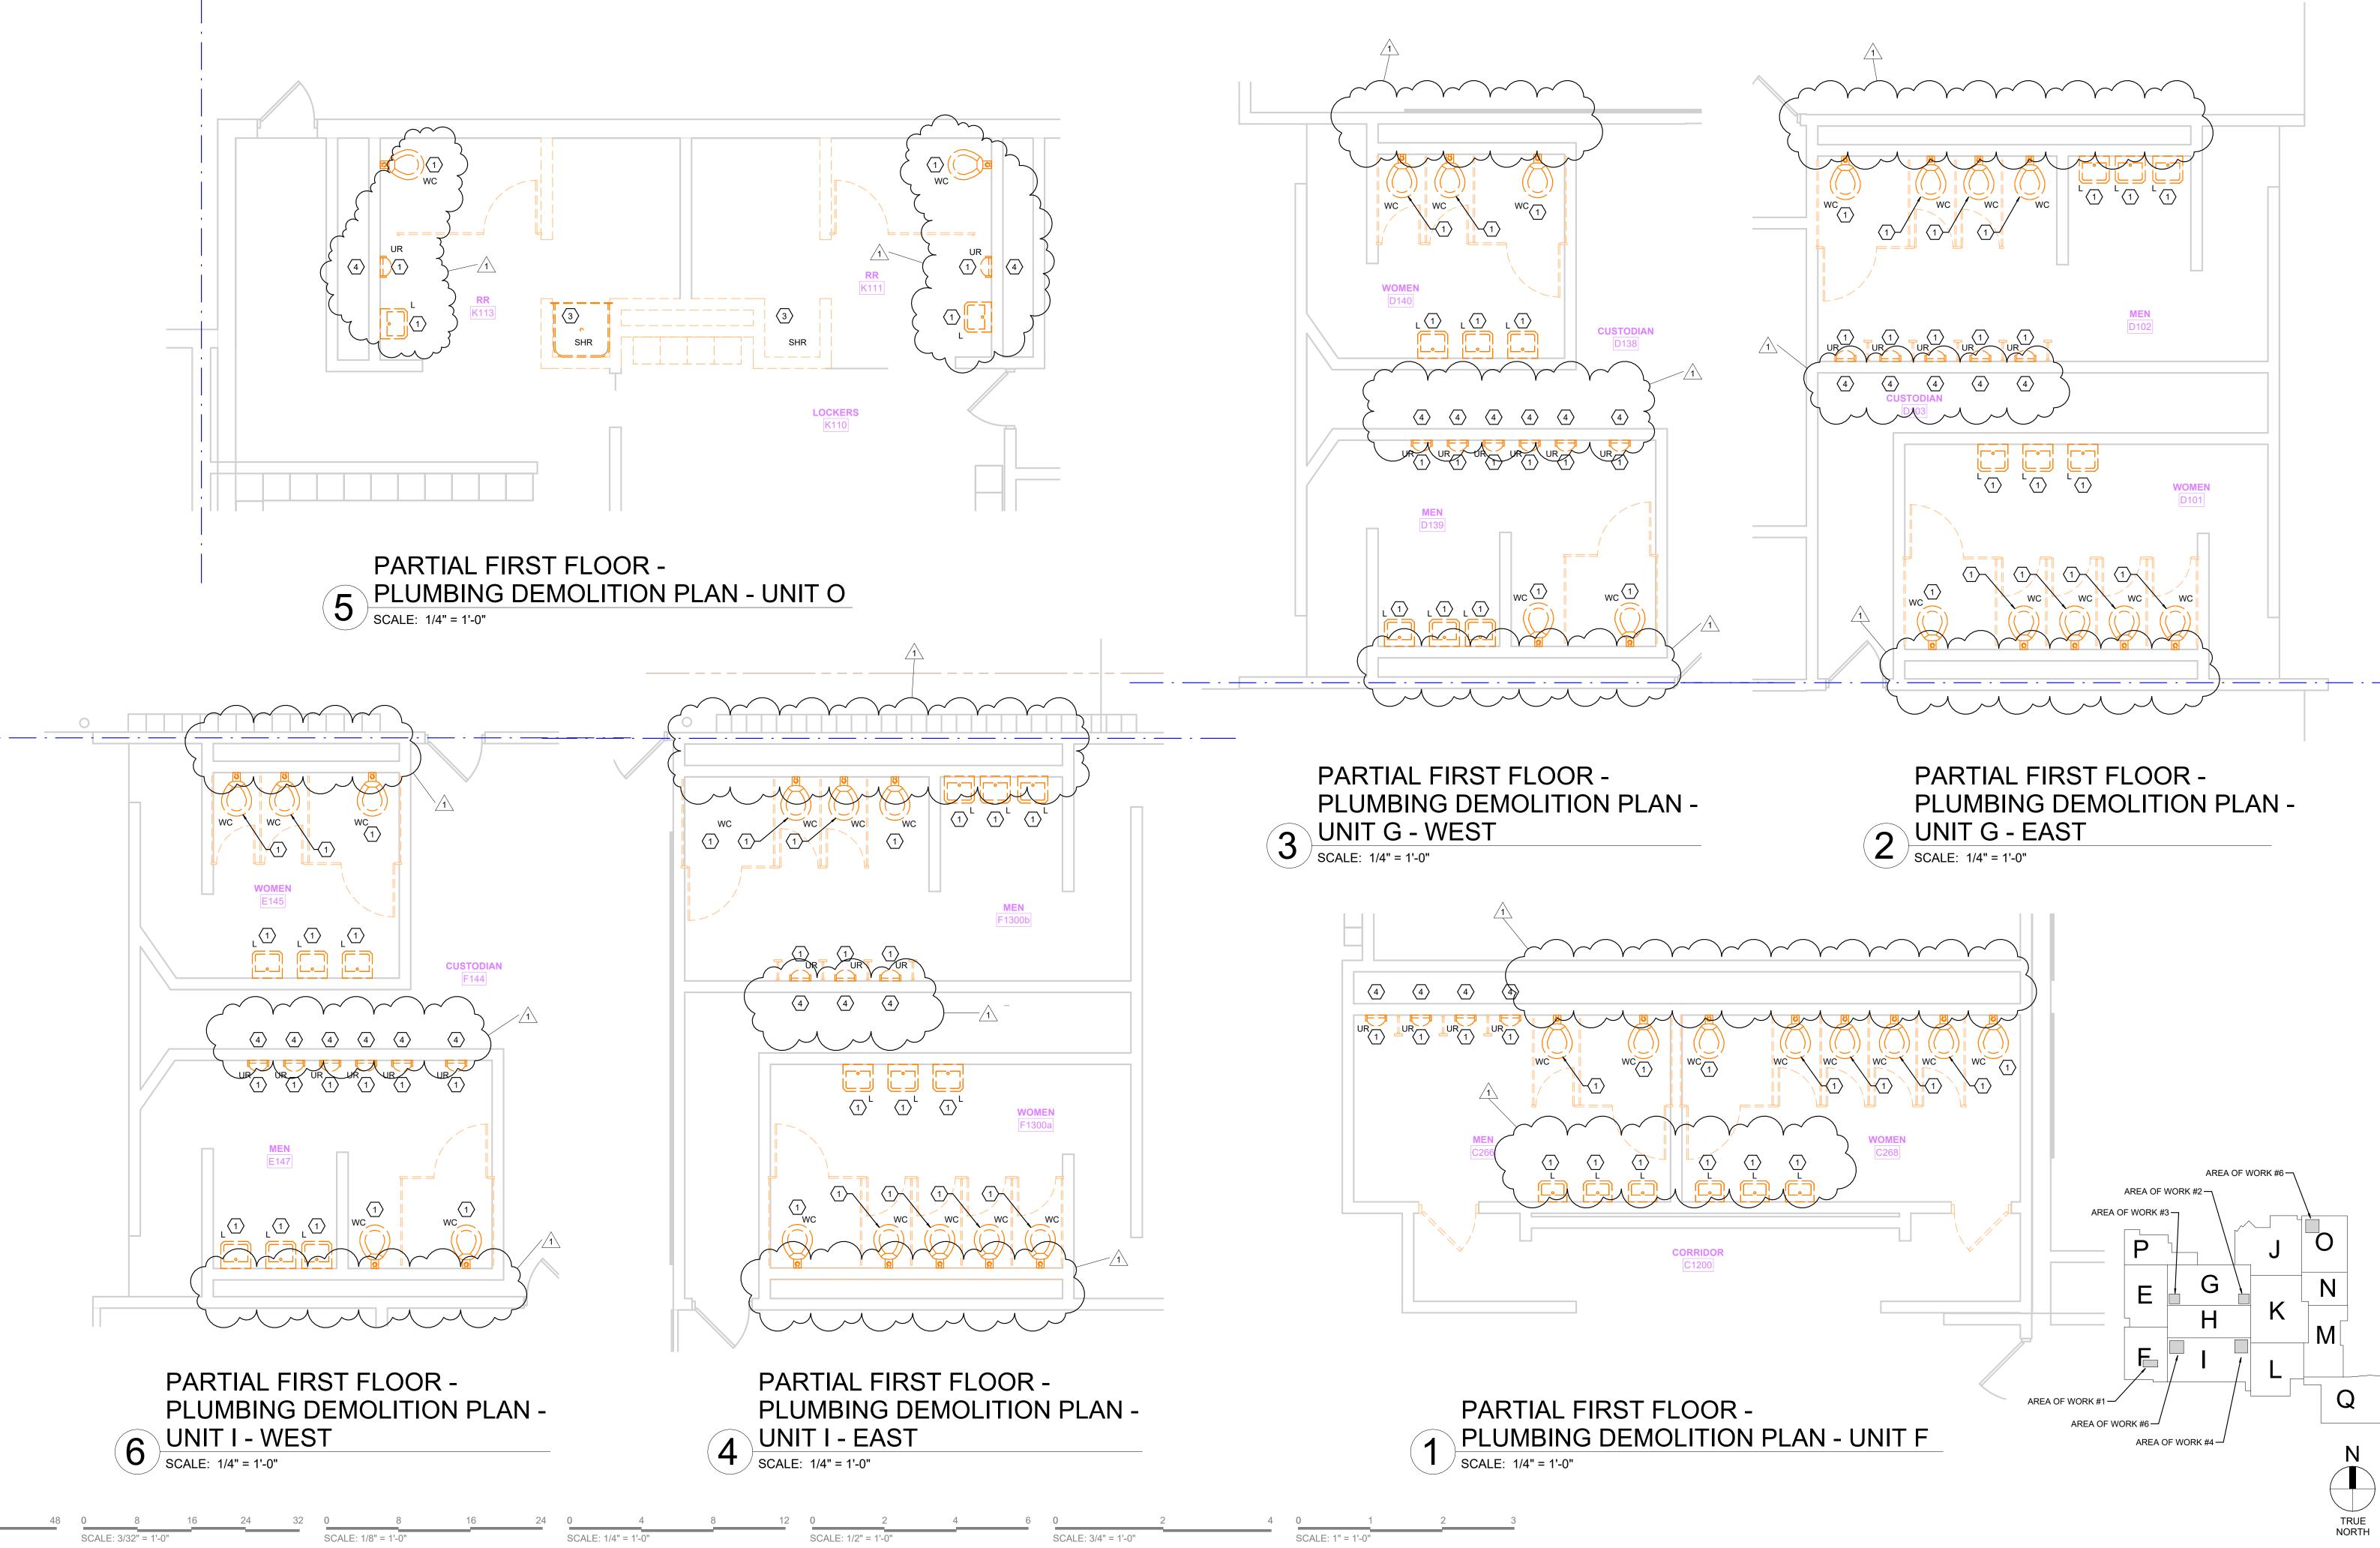

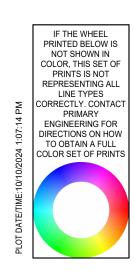

SCALE: 1/16" = 1'-0"

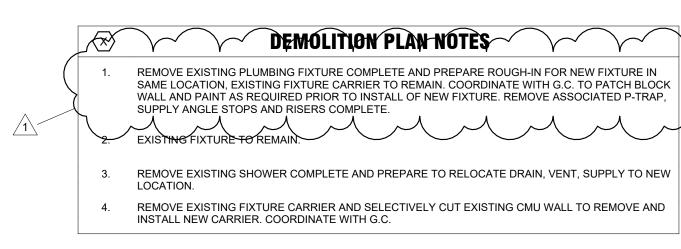







PRIMARY ENGINEERING INC Fort Wayne Indianapoli 2828 Lake Ave. 9785 Crosspoint Blvd., Suite 103 
 Fort Wayne, Indiana 46805
 Indianapolis, Indiana 46256

 260.424.0444 ph
 317.324.1221 ph
 info@primarv-eng.com www.primary-eng.com All concepts, ideas, plans, and details as


shown on this document are the sole property of Primary Engineering, Inc., and shall not be used for any other purpose without their expressed written consent. The project owner shall be permitted to retain copies for information and reference purposes. 2024 © Primary Engineering, Inc.



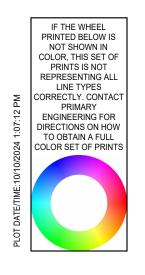

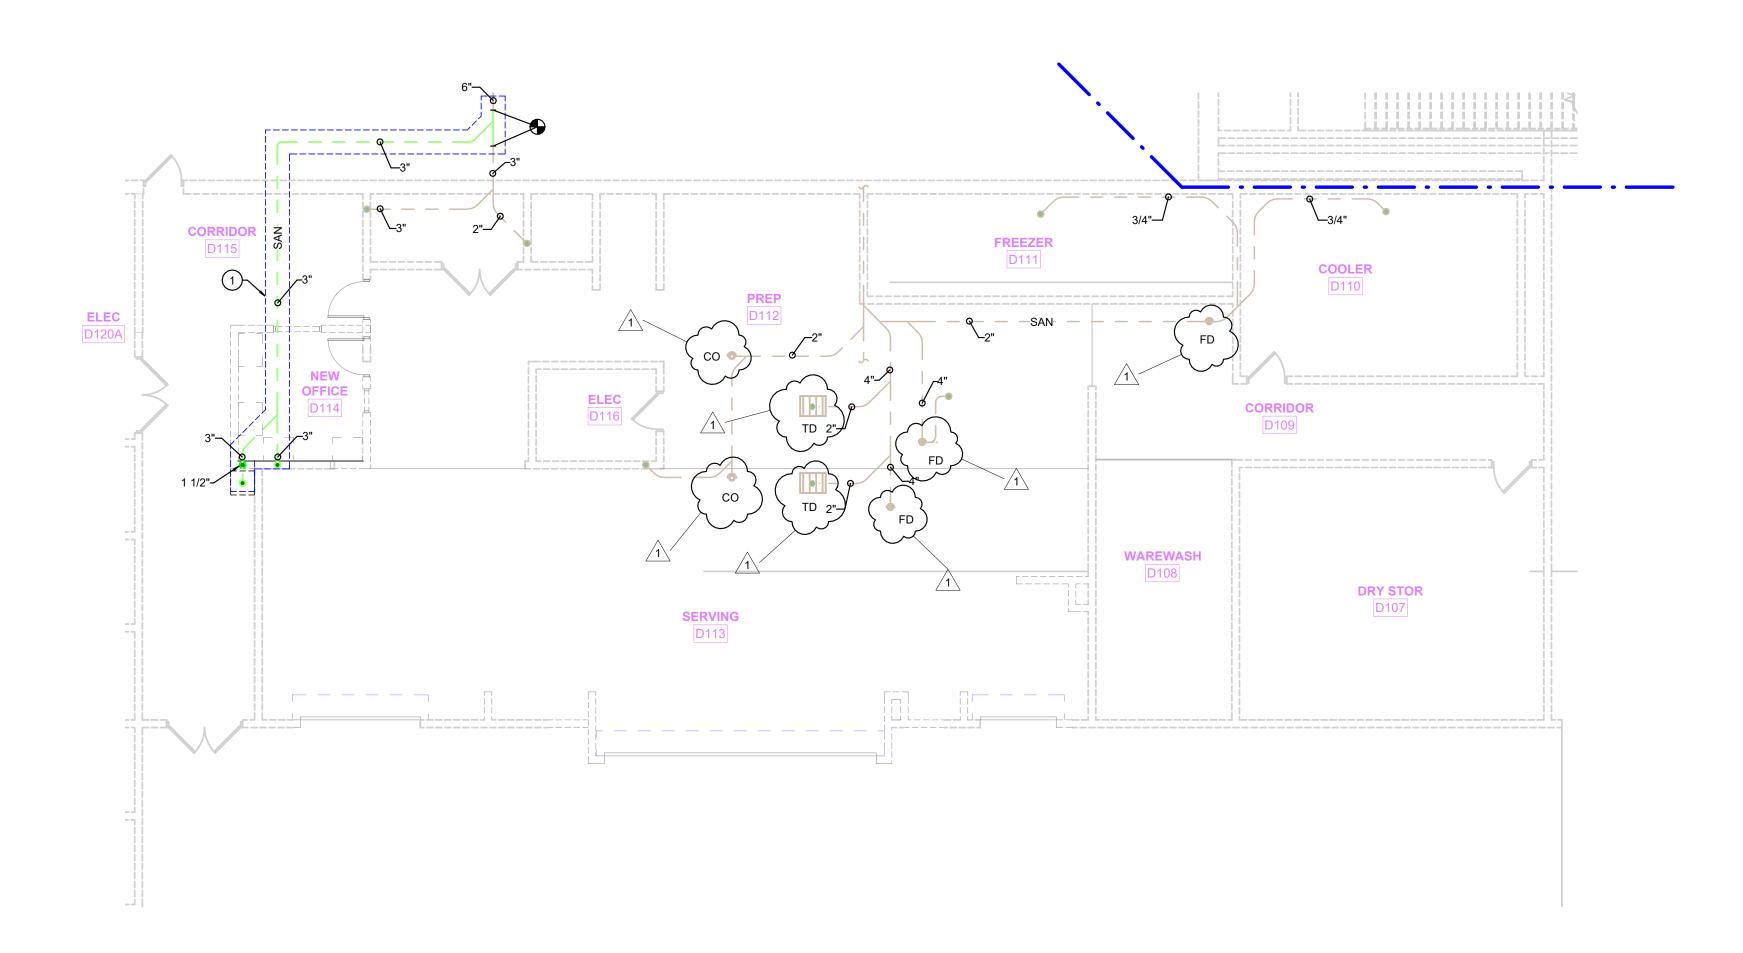



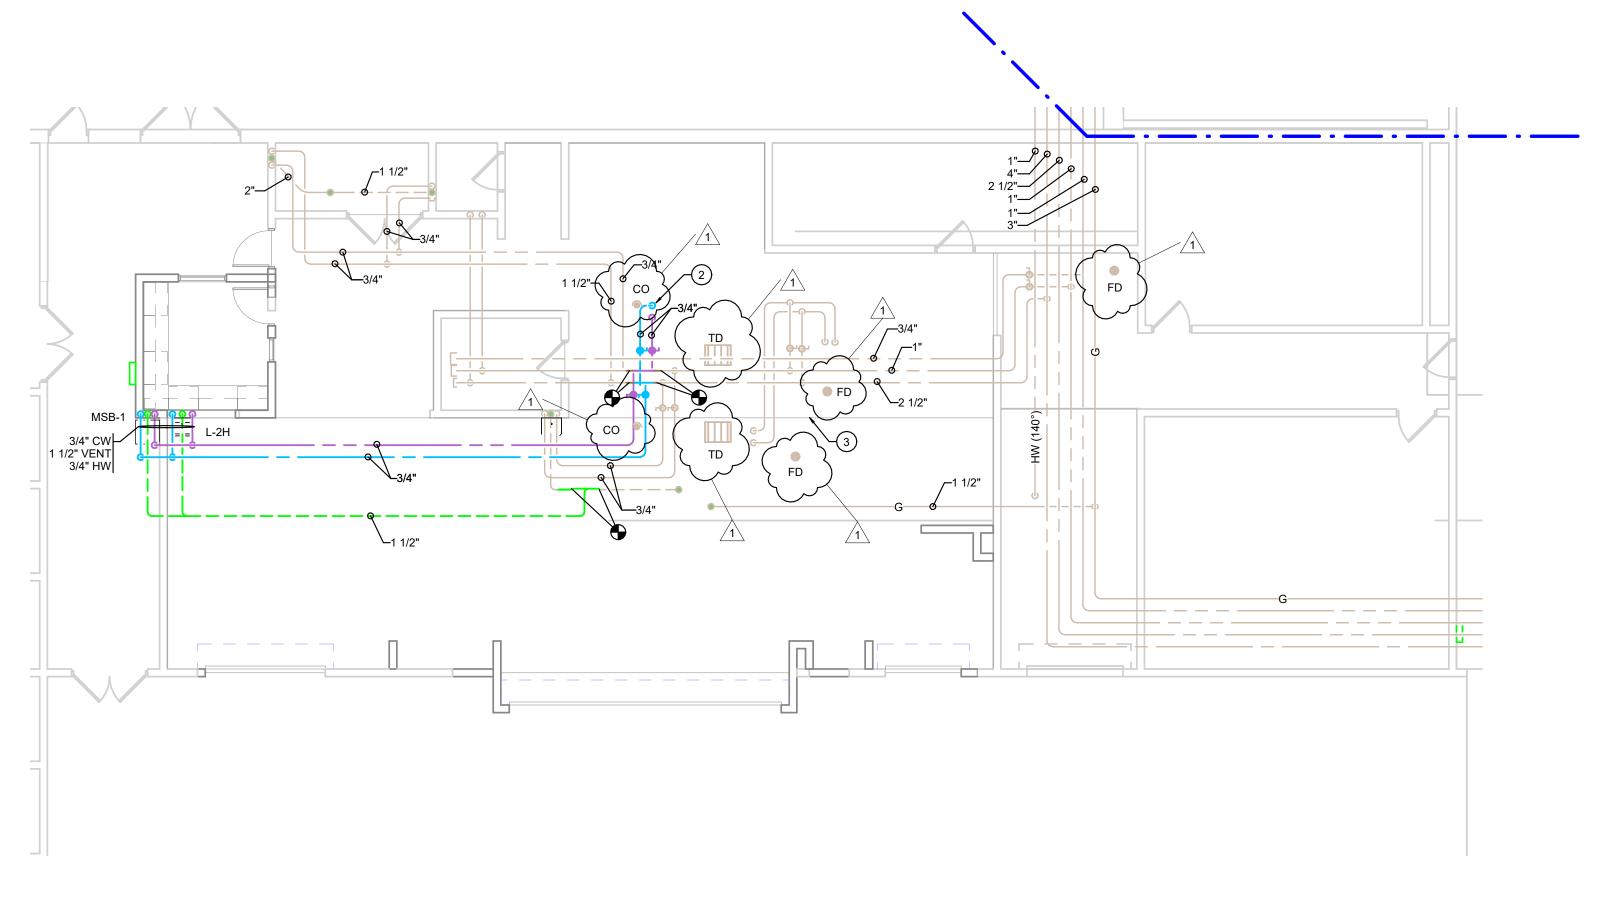


1 PARTIAL FIRST FLOOR - PLUMBING PLAN - UNIT G SCALE: 1/8" = 1'-0"

(X)

### **PLAN NOTES**

- SAWCUT AND REMOVE EXISTING FLOOR AS REQUIRED TO ROUTE NEW UNDERGROUND PIPING AND TIE-IN TO EXISTING. BACKFILL WITH COMPACTIBLE FILL, DOWEL INTO EXISTING SLAB, AND POUR NEW OF SAME THICKNESS. 1
- 2. ROUTE NEW PIPING DOWN CHASE TO NEW KITCHEN EQUIPMENT.
- 3. CONNECT NEW/RELOCATED KITCHEN EQUIPMENT TO EXISTING PIPING.

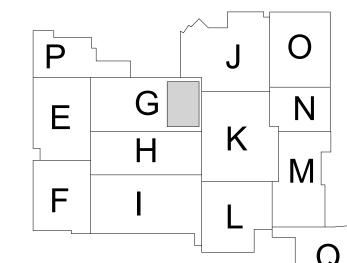

Ν

Μ

Q

Ν


TRUE NORTH




All concepts, ideas, plans, and details as shown on this document are the sole property of Primary Engineering, Inc., and shall not be used for any other purpose without their expressed written consent. The project owner shall be permitted to retain copies for information and reference purposes. 2024 © Primary Engineering, Inc.





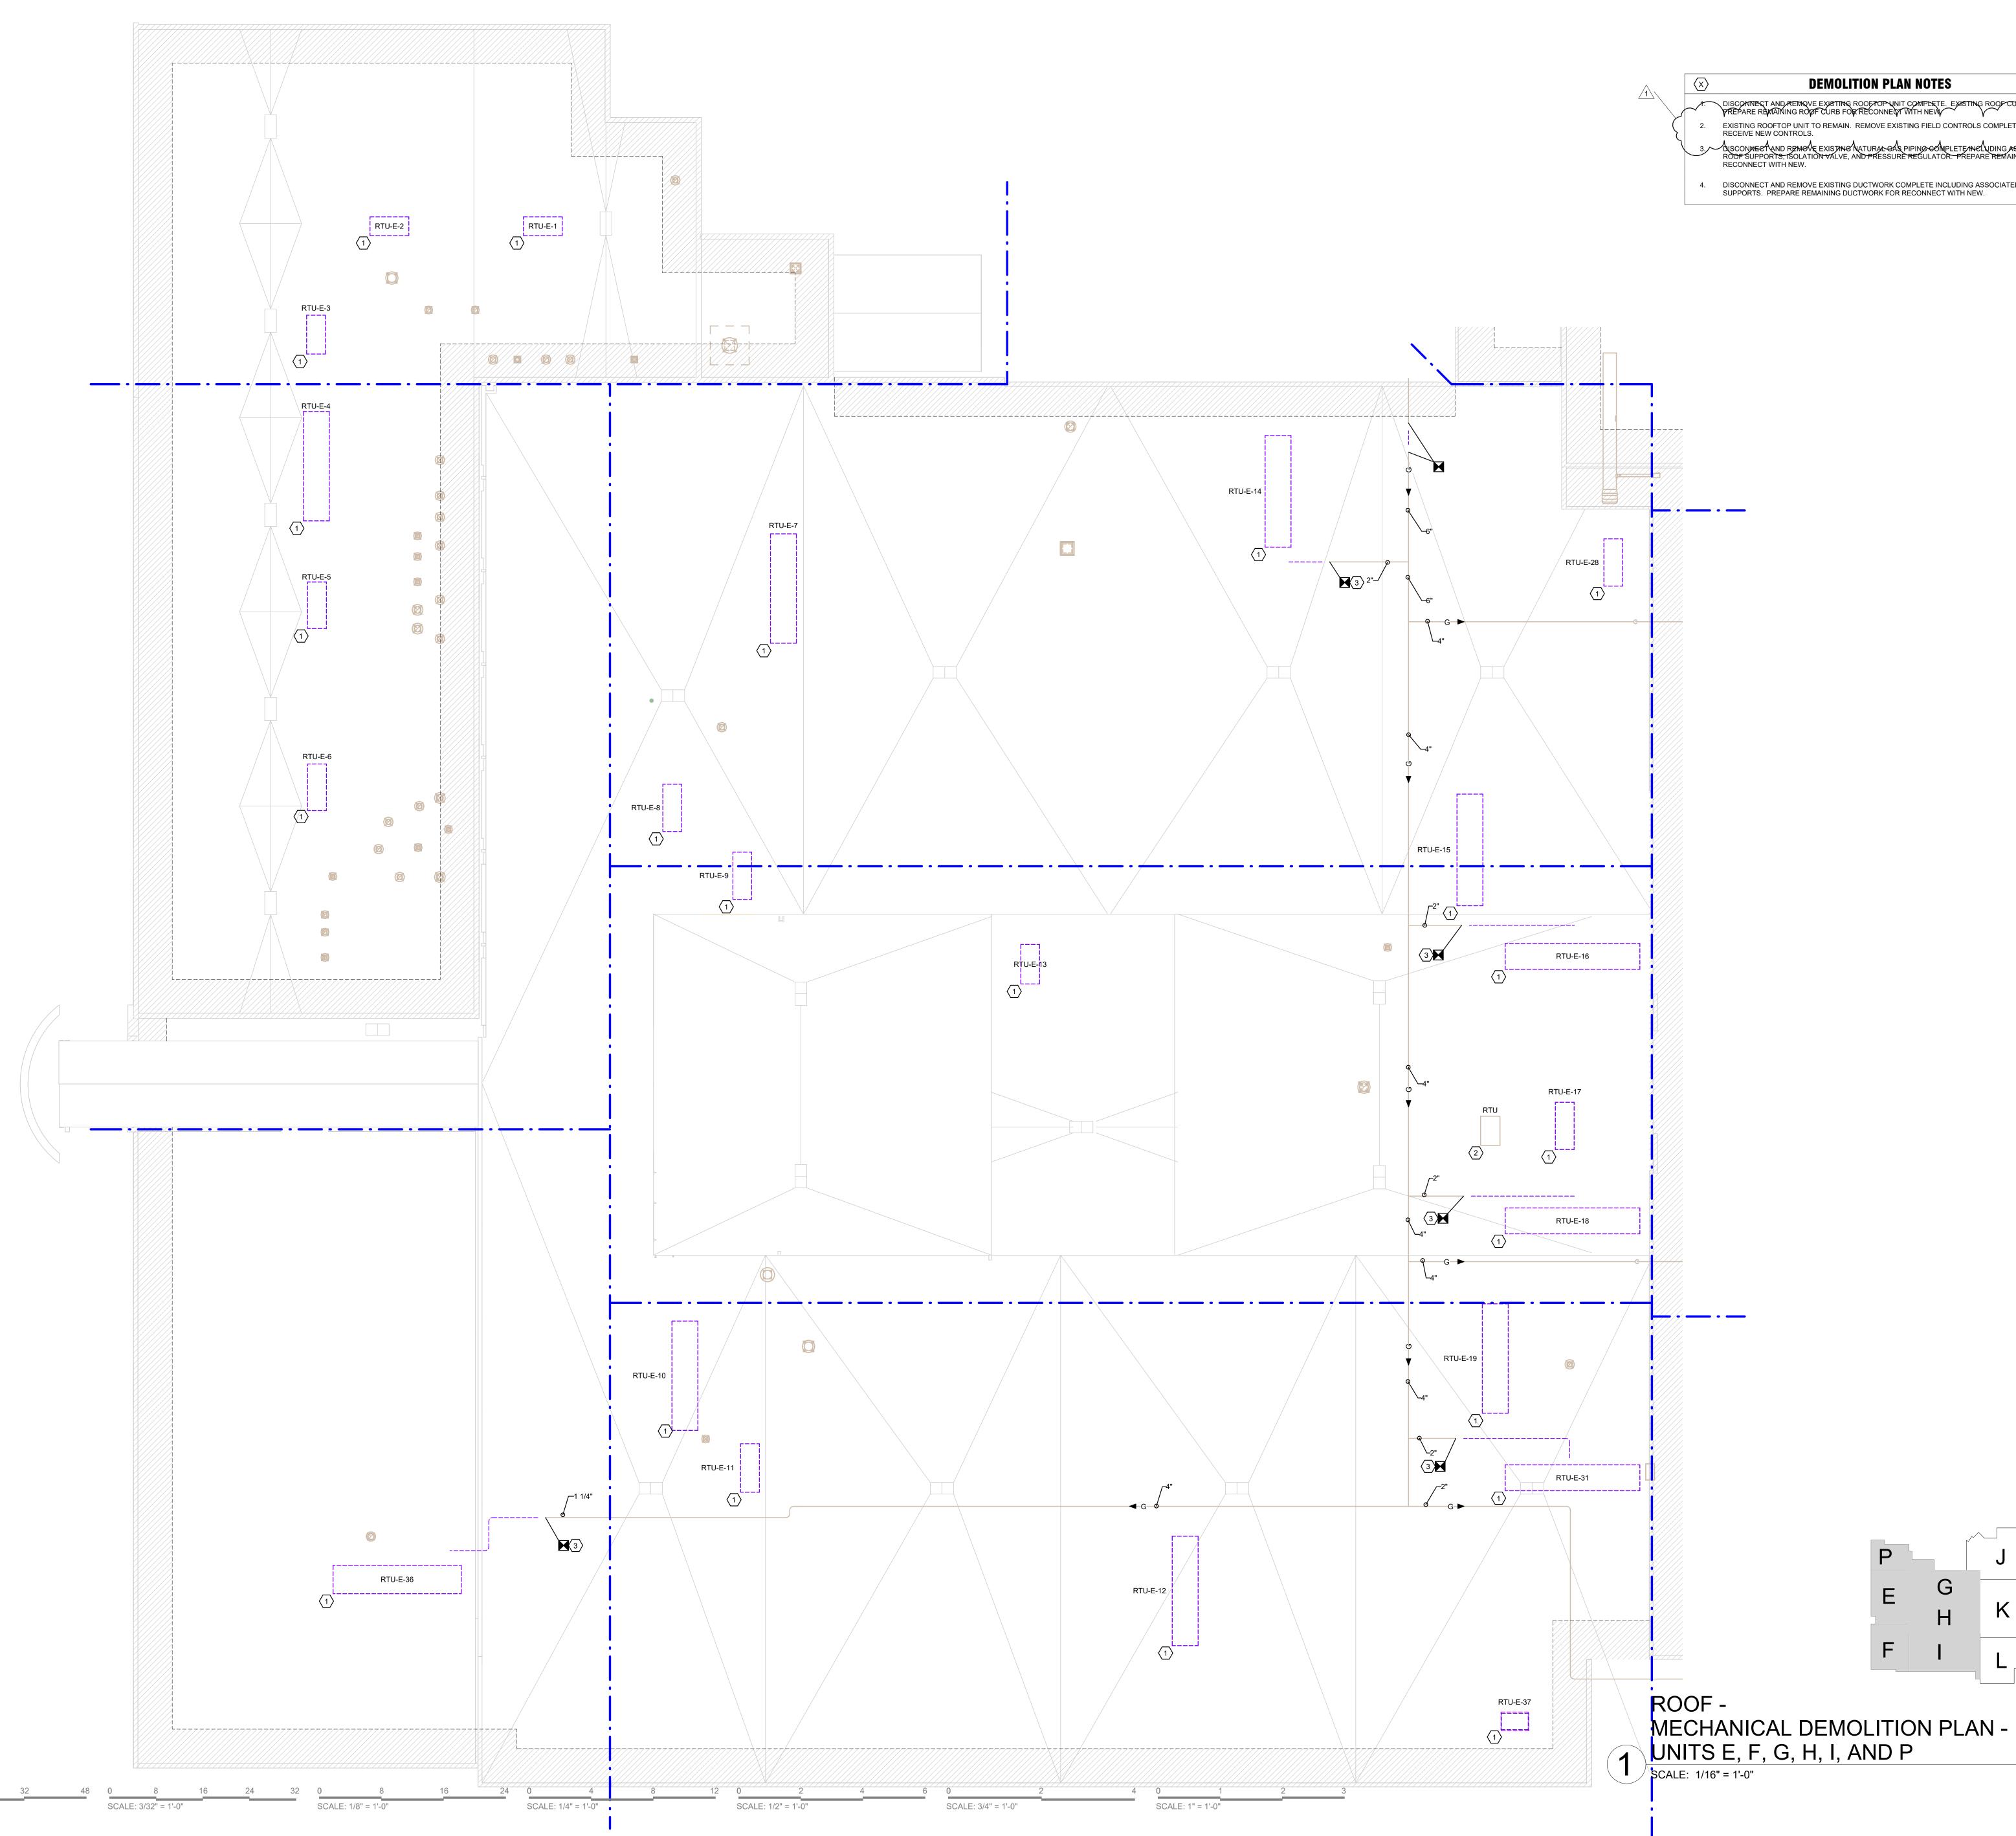

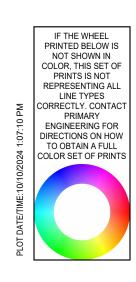



SCALE: 1/16" = 1'-0"

۸.	$\langle X \rangle$	DEMOLITION PL
	<del>1.</del>	DISCOMMENT AND REMOVE EXISTING ROOFFOP UN PREPARE REMAINING ROOF CURB FOR RECONNER
ξ	2.	EXISTING ROOFTOP UNIT TO REMAIN. REMOVE EXIS RECEIVE NEW CONTROLS.

XISTING FIELD CONTROLS COMPLETE. UNIT TO 3. DISCONMENTAND REMOVE EXISTING NATURAL CAS PIPING COMPLETE/INCLUDING ASSOCIATED ROOF SUPPORTS, ISOLATION VALVE, AND PRESSURE REGULATOR. PREPARE REMAINING PIPING FOR RECONNECT WITH NEW.

4. DISCONNECT AND REMOVE EXISTING DUCTWORK COMPLETE INCLUDING ASSOCIATED ROOF SUPPORTS. PREPARE REMAINING DUCTWORK FOR RECONNECT WITH NEW.

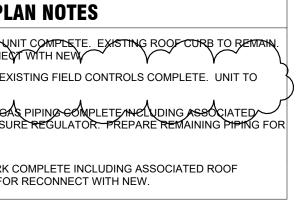

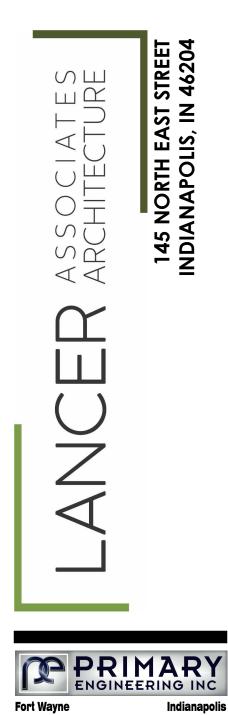



 
 2828 Lake Ave.
 9785 Crosspoint Blvd., Suite 103

 Fort Wayne, Indiana 46805
 Indianapolis, Indiana 46256

 260.424.0444 ph
 317.324.1221 ph


 info@primary-eng.com
 www.primary-eng.com
 All concepts, ideas, plans, and details as shown on this document are the sole property of Primary Engineering, Inc., and shall not be used for any other purpose without their expressed written consent. The project owner shall be permitted to retain copies for information and reference purposes. 2024 © Primary Engineering, Inc.

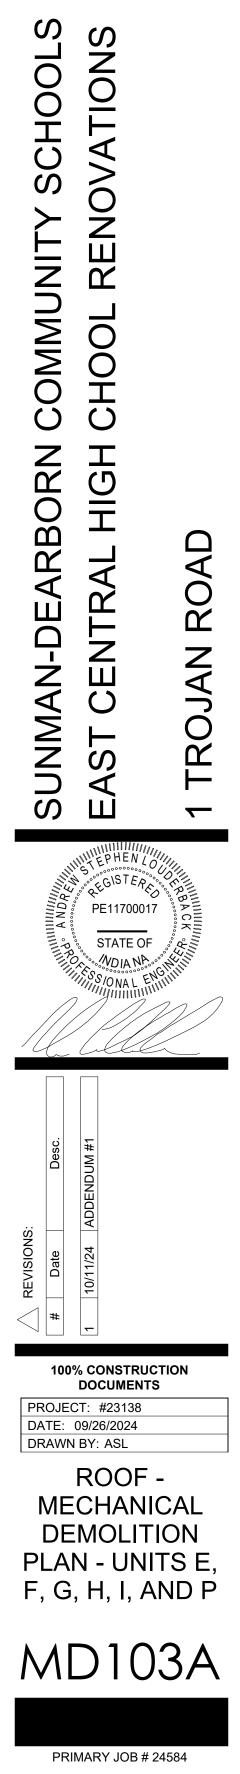


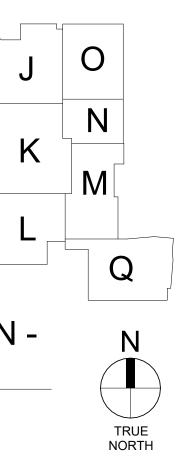

G

Η

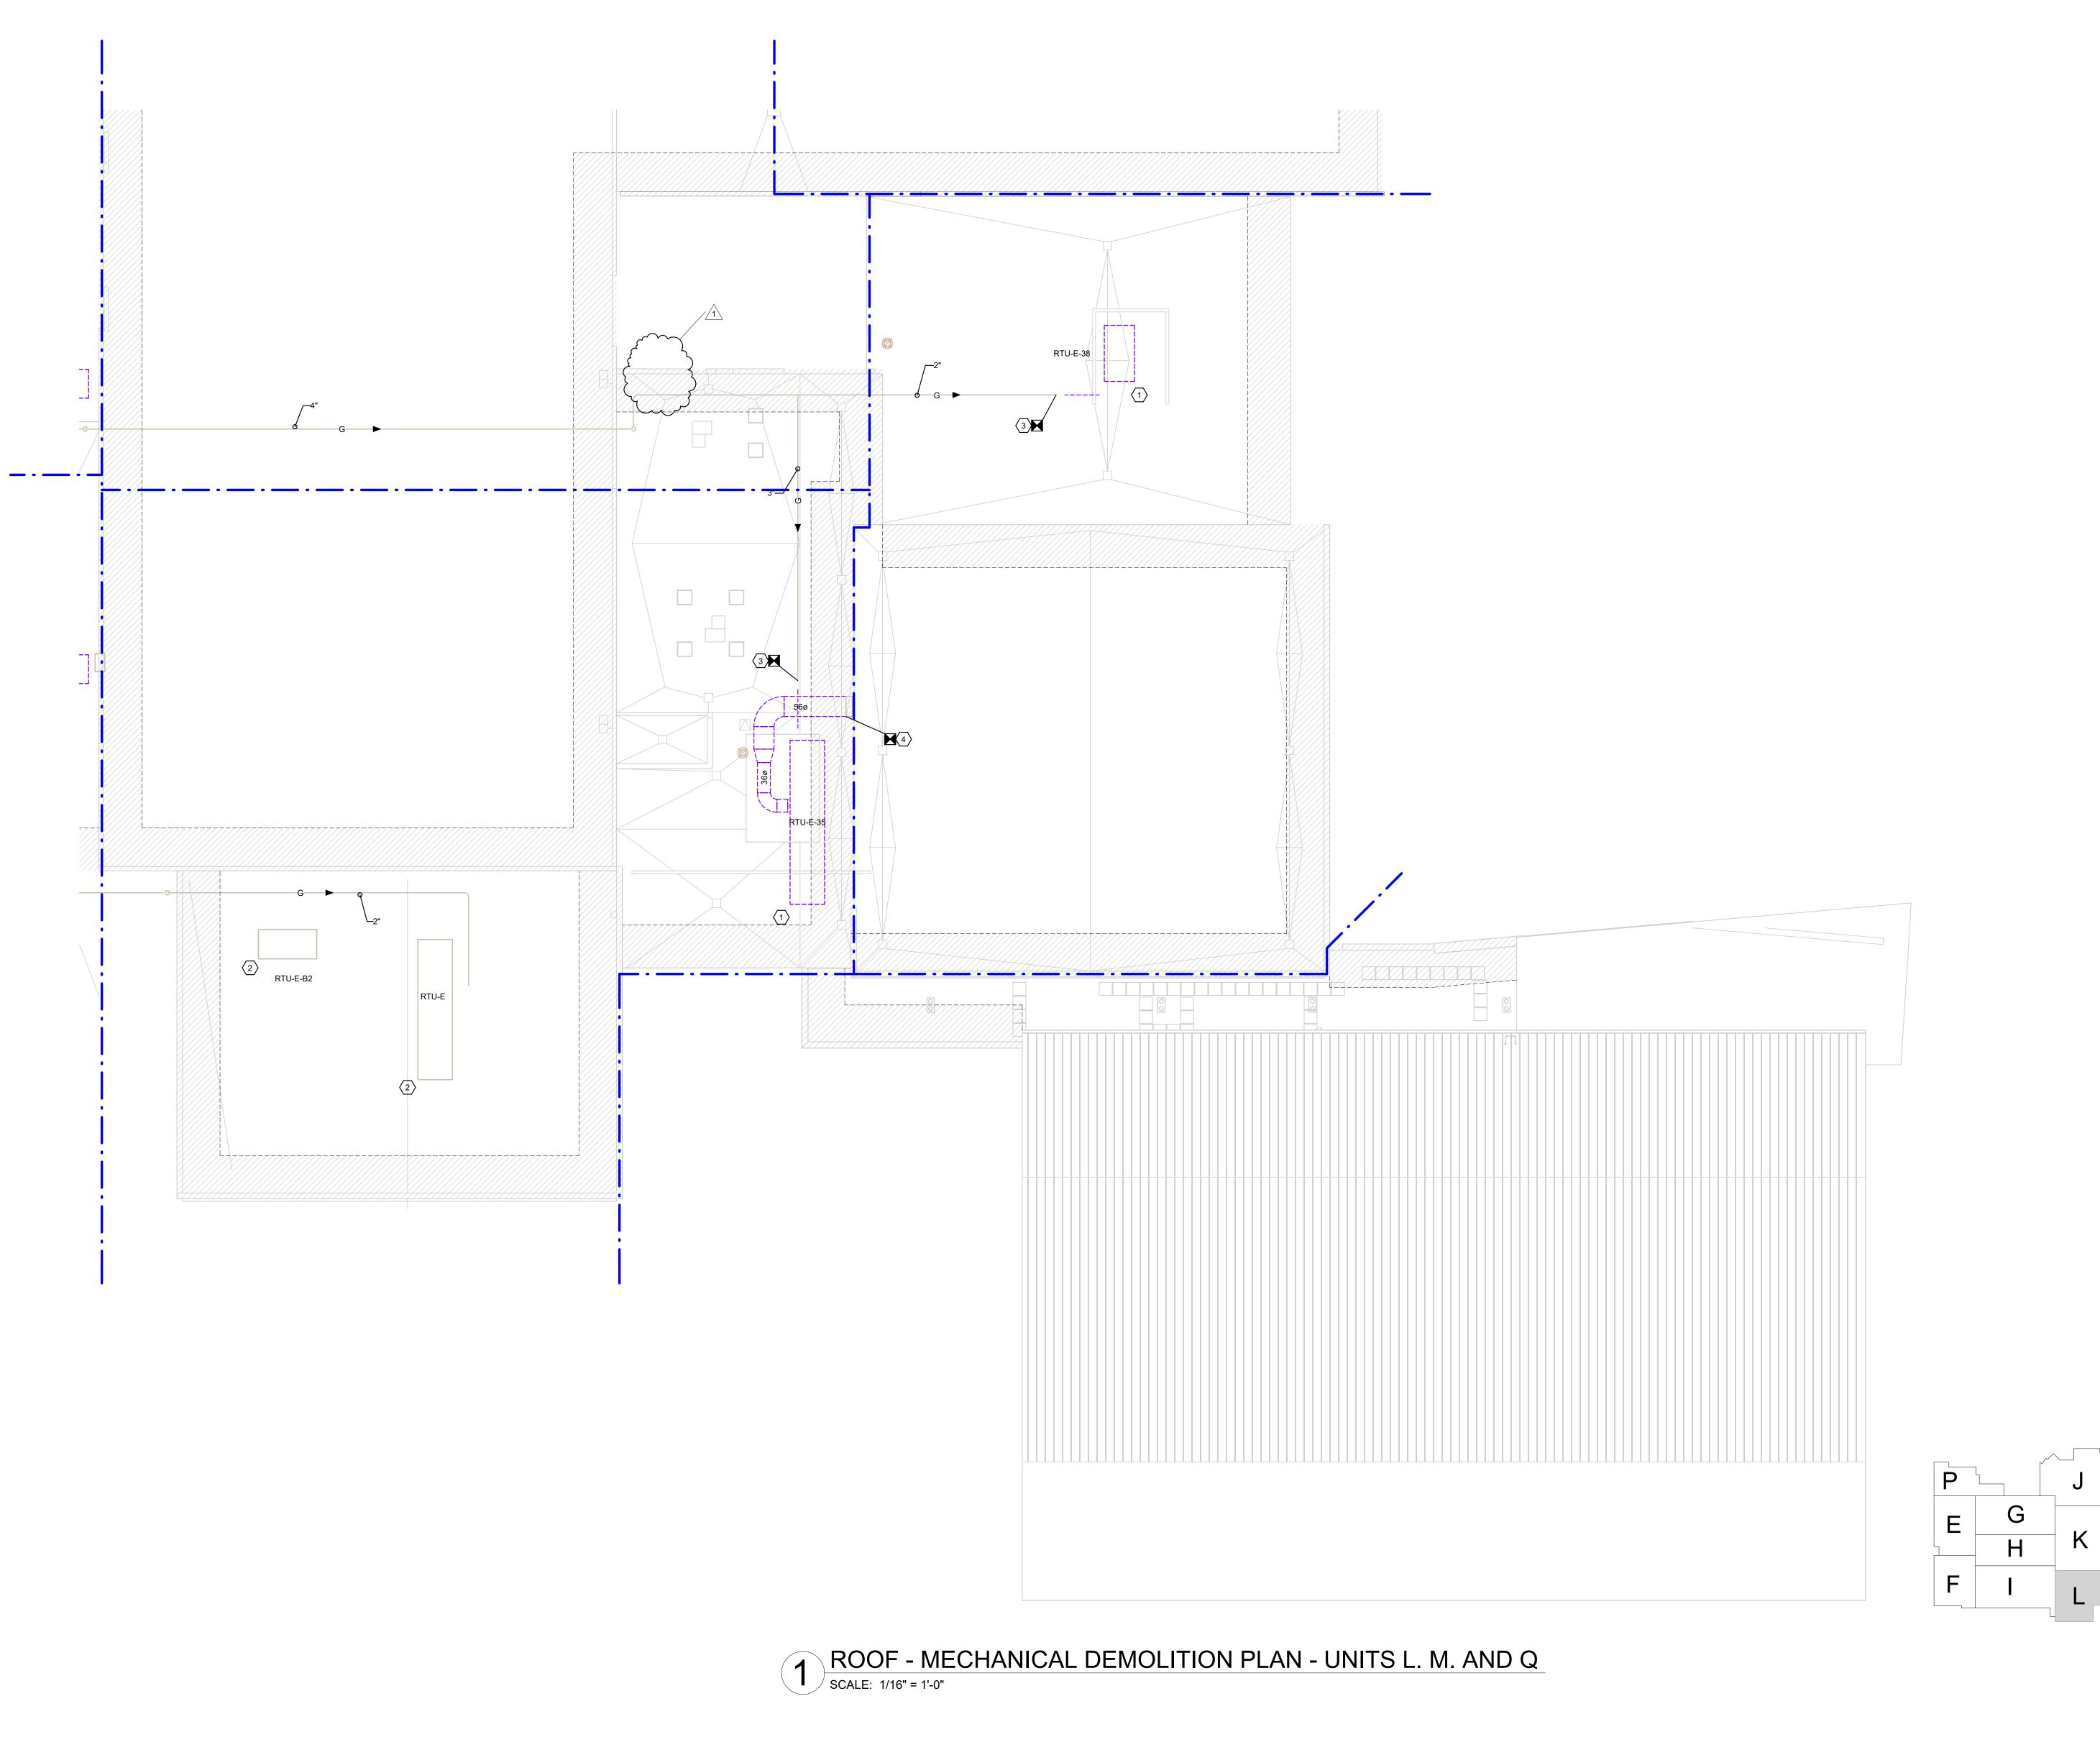

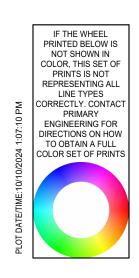

SCALE: 1/8" = 1'-0"


SCALE: 1/4" = 1'-0"

12 SCALE: 1/2" = 1'-0"


4 6

SCALE: 3/4" = 1'-0"

4 0

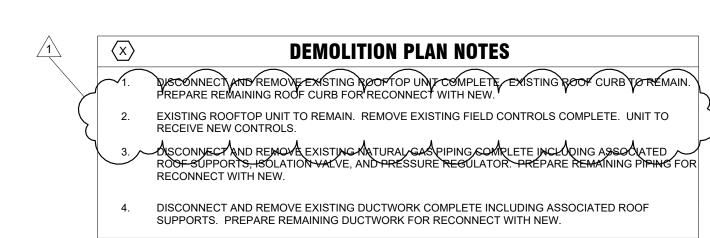


0 1 2 3 SCALE: 1" = 1'-0"

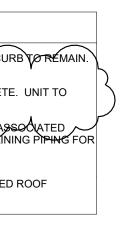





Fort Wayne Indianapolis 2828 Lake Ave.9785 Crosspoint Blvd., Suite 103Fort Wayne, Indiana 46805Indianapolis, Indiana 46256260.424.0444 ph317.324.1221 phinfo@primary-eng.comwww.primary-eng.com All concepts, ideas, plans, and details as

shown on this document are the sole property of Primary Engineering, Inc., and shall not be used for any other purpose without their expressed written consent. The project owner shall be permitted to retain copies for information and reference purposes. 2024 © Primary Engineering, Inc.

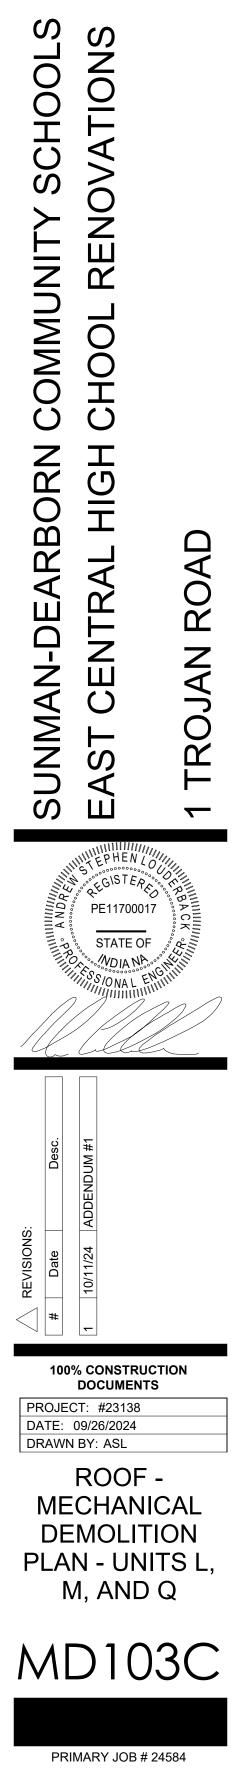

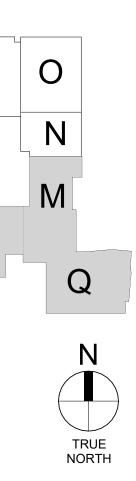




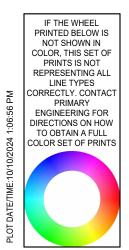



24


SCALE: 1/8" = 1'-0"

0

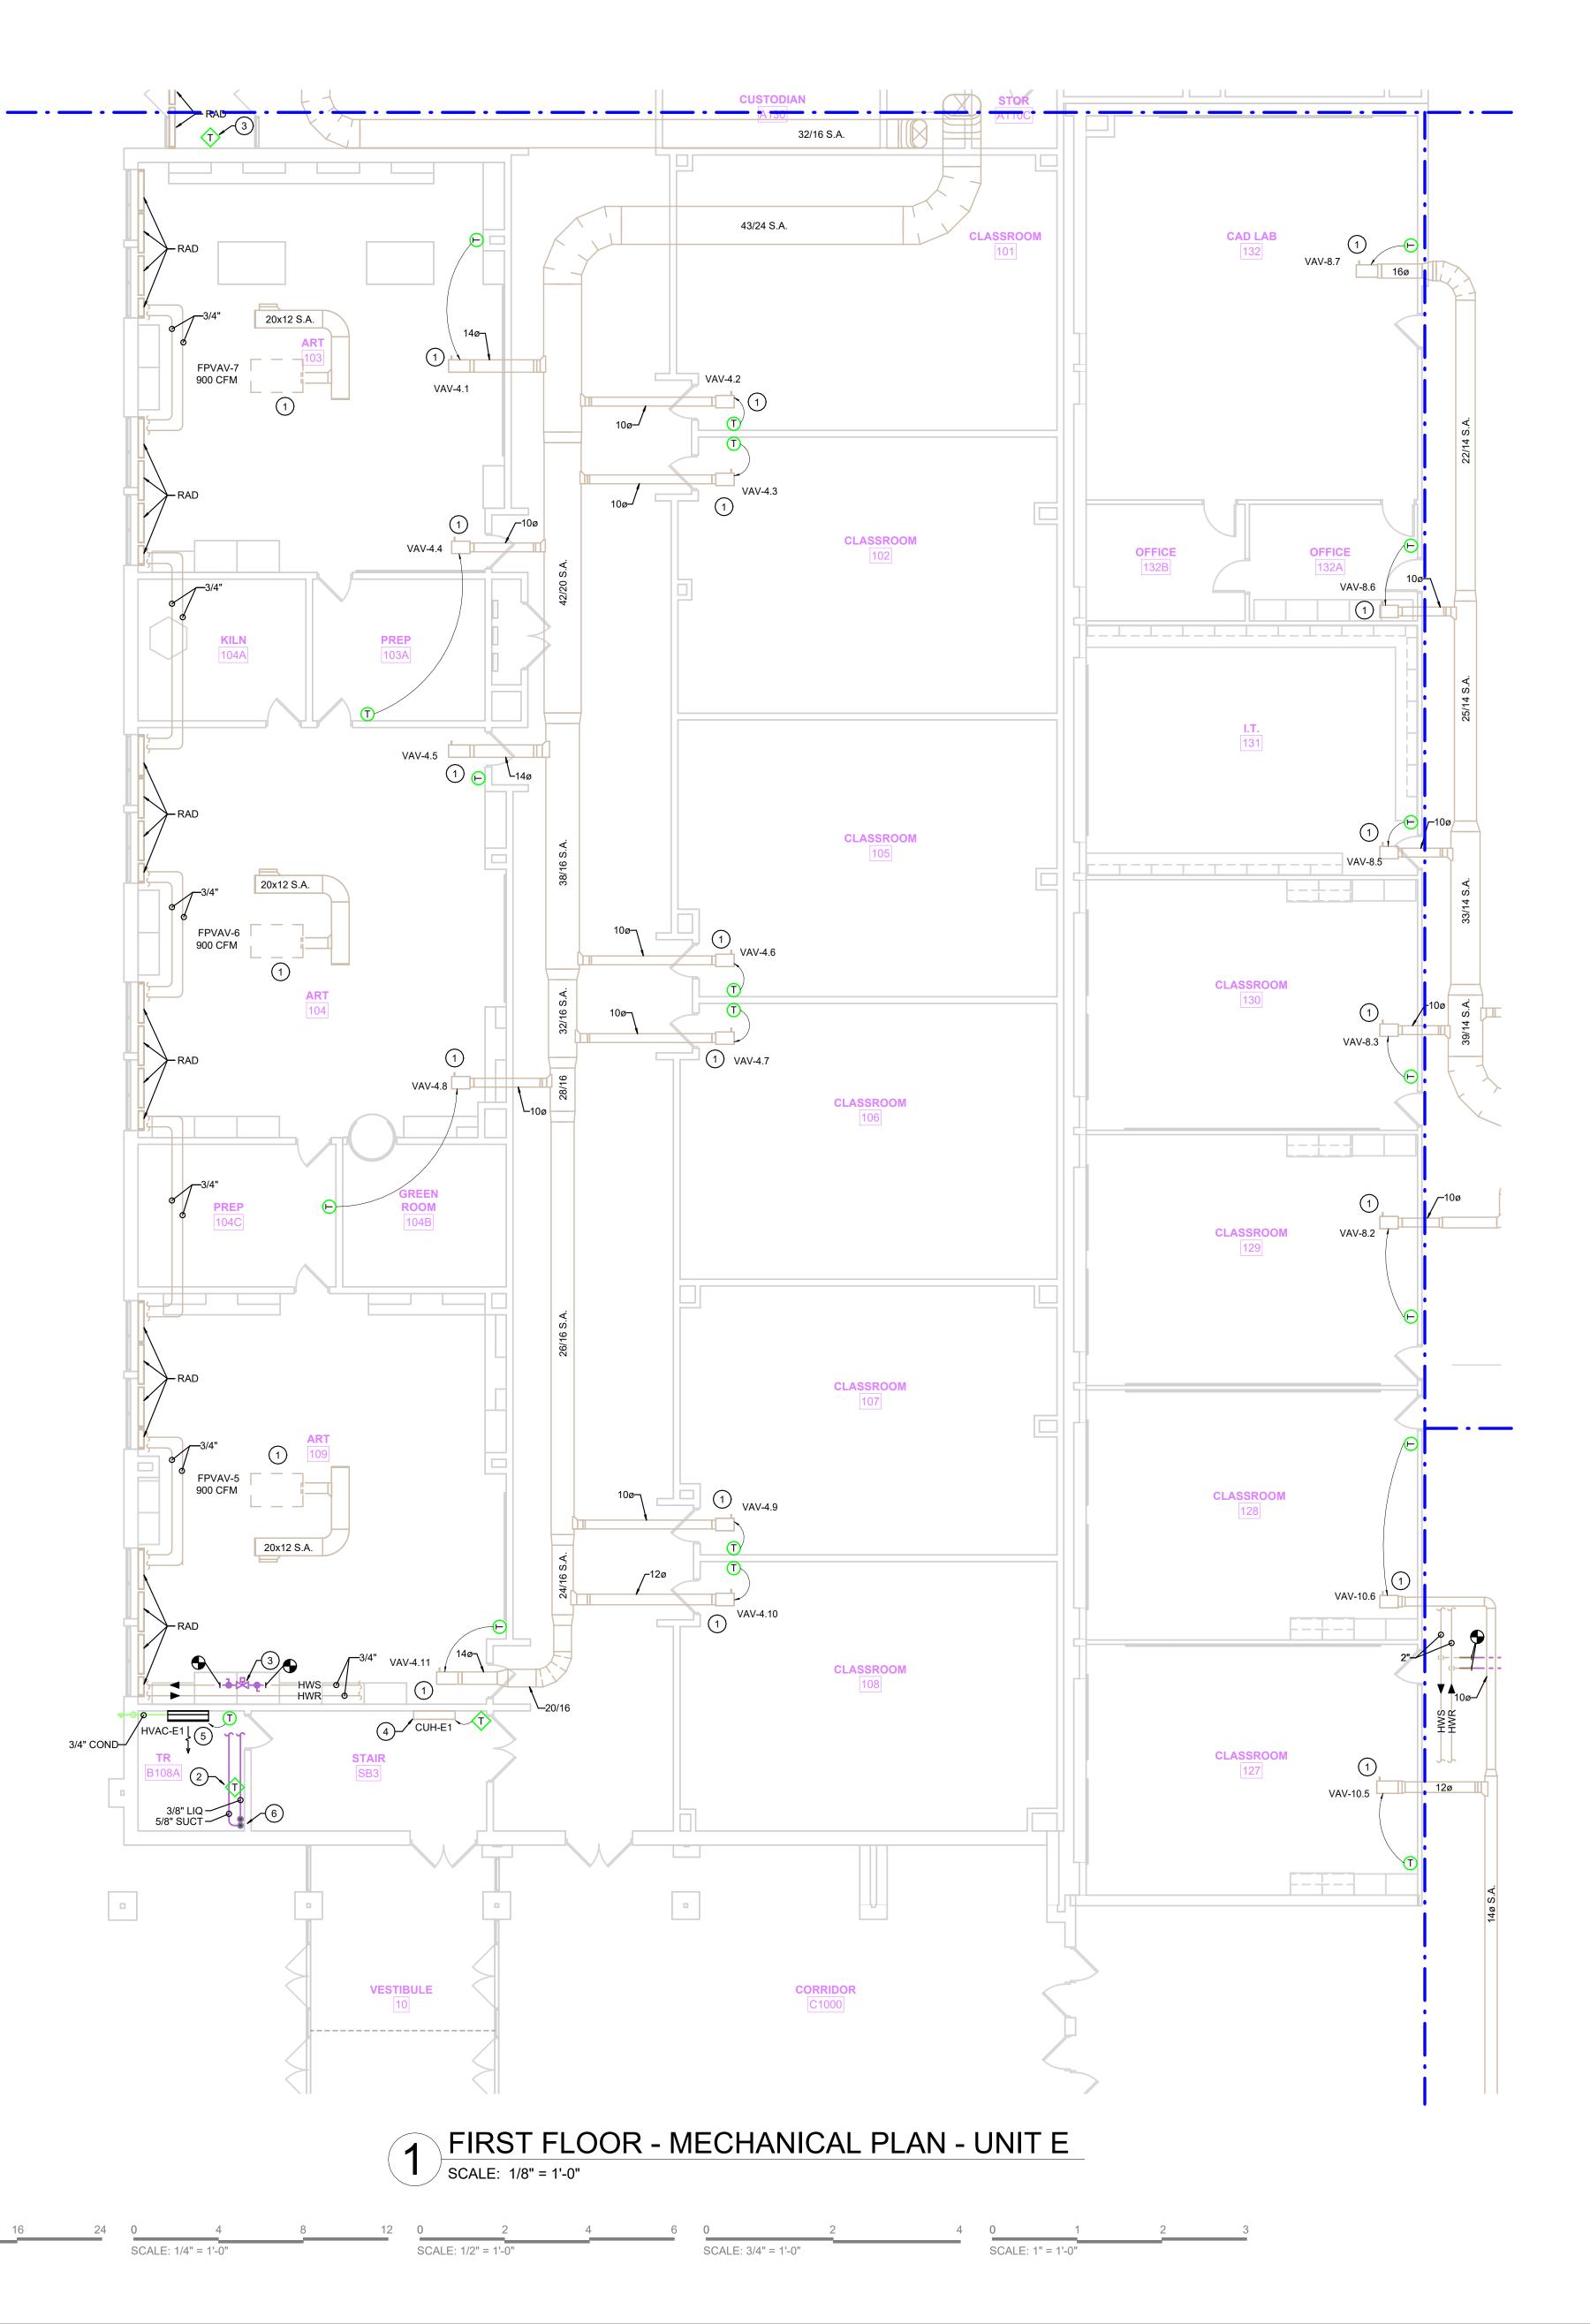

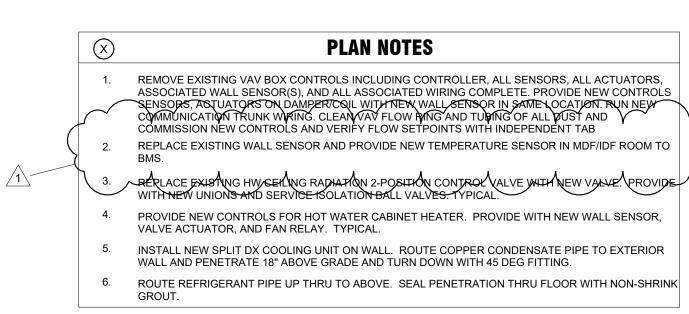

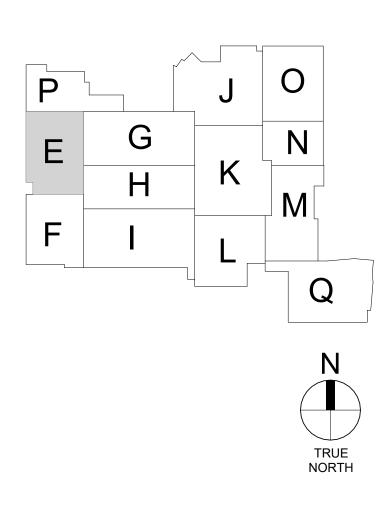

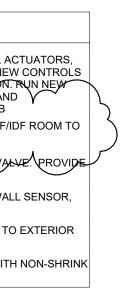




Fort Wayne Indianapoli 
 2828 Lake Ave.
 9785 Crosspoint Blvd., Suite 103


 Fort Wayne, Indiana 46805
 Indianapolis, Indiana 46256

 260.424.0444 ph
 317.324.1221 ph

 info@primary-eng.com
 www.primary-eng.com
 All concepts, ideas, plans, and details as

shown on this document are the sole property of Primary Engineering, Inc., and shall not be used for any other purpose without their expressed written consent. The project owner shall be permitted to retain copies for information and reference purposes. 2024 © Primary Engineering, Inc.

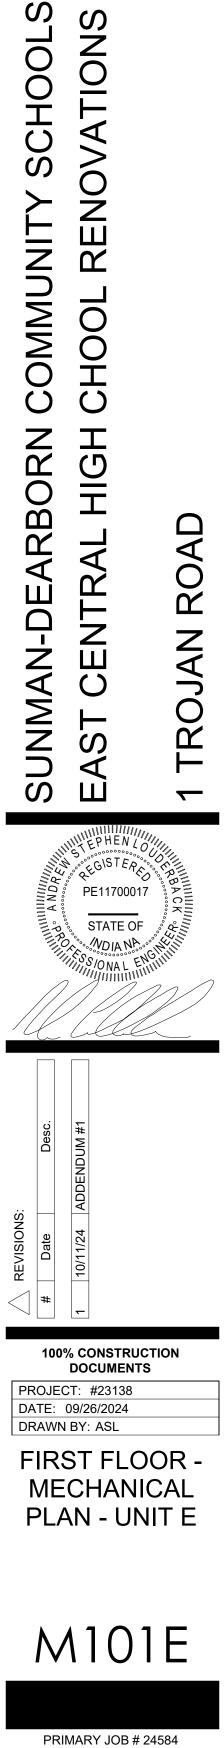

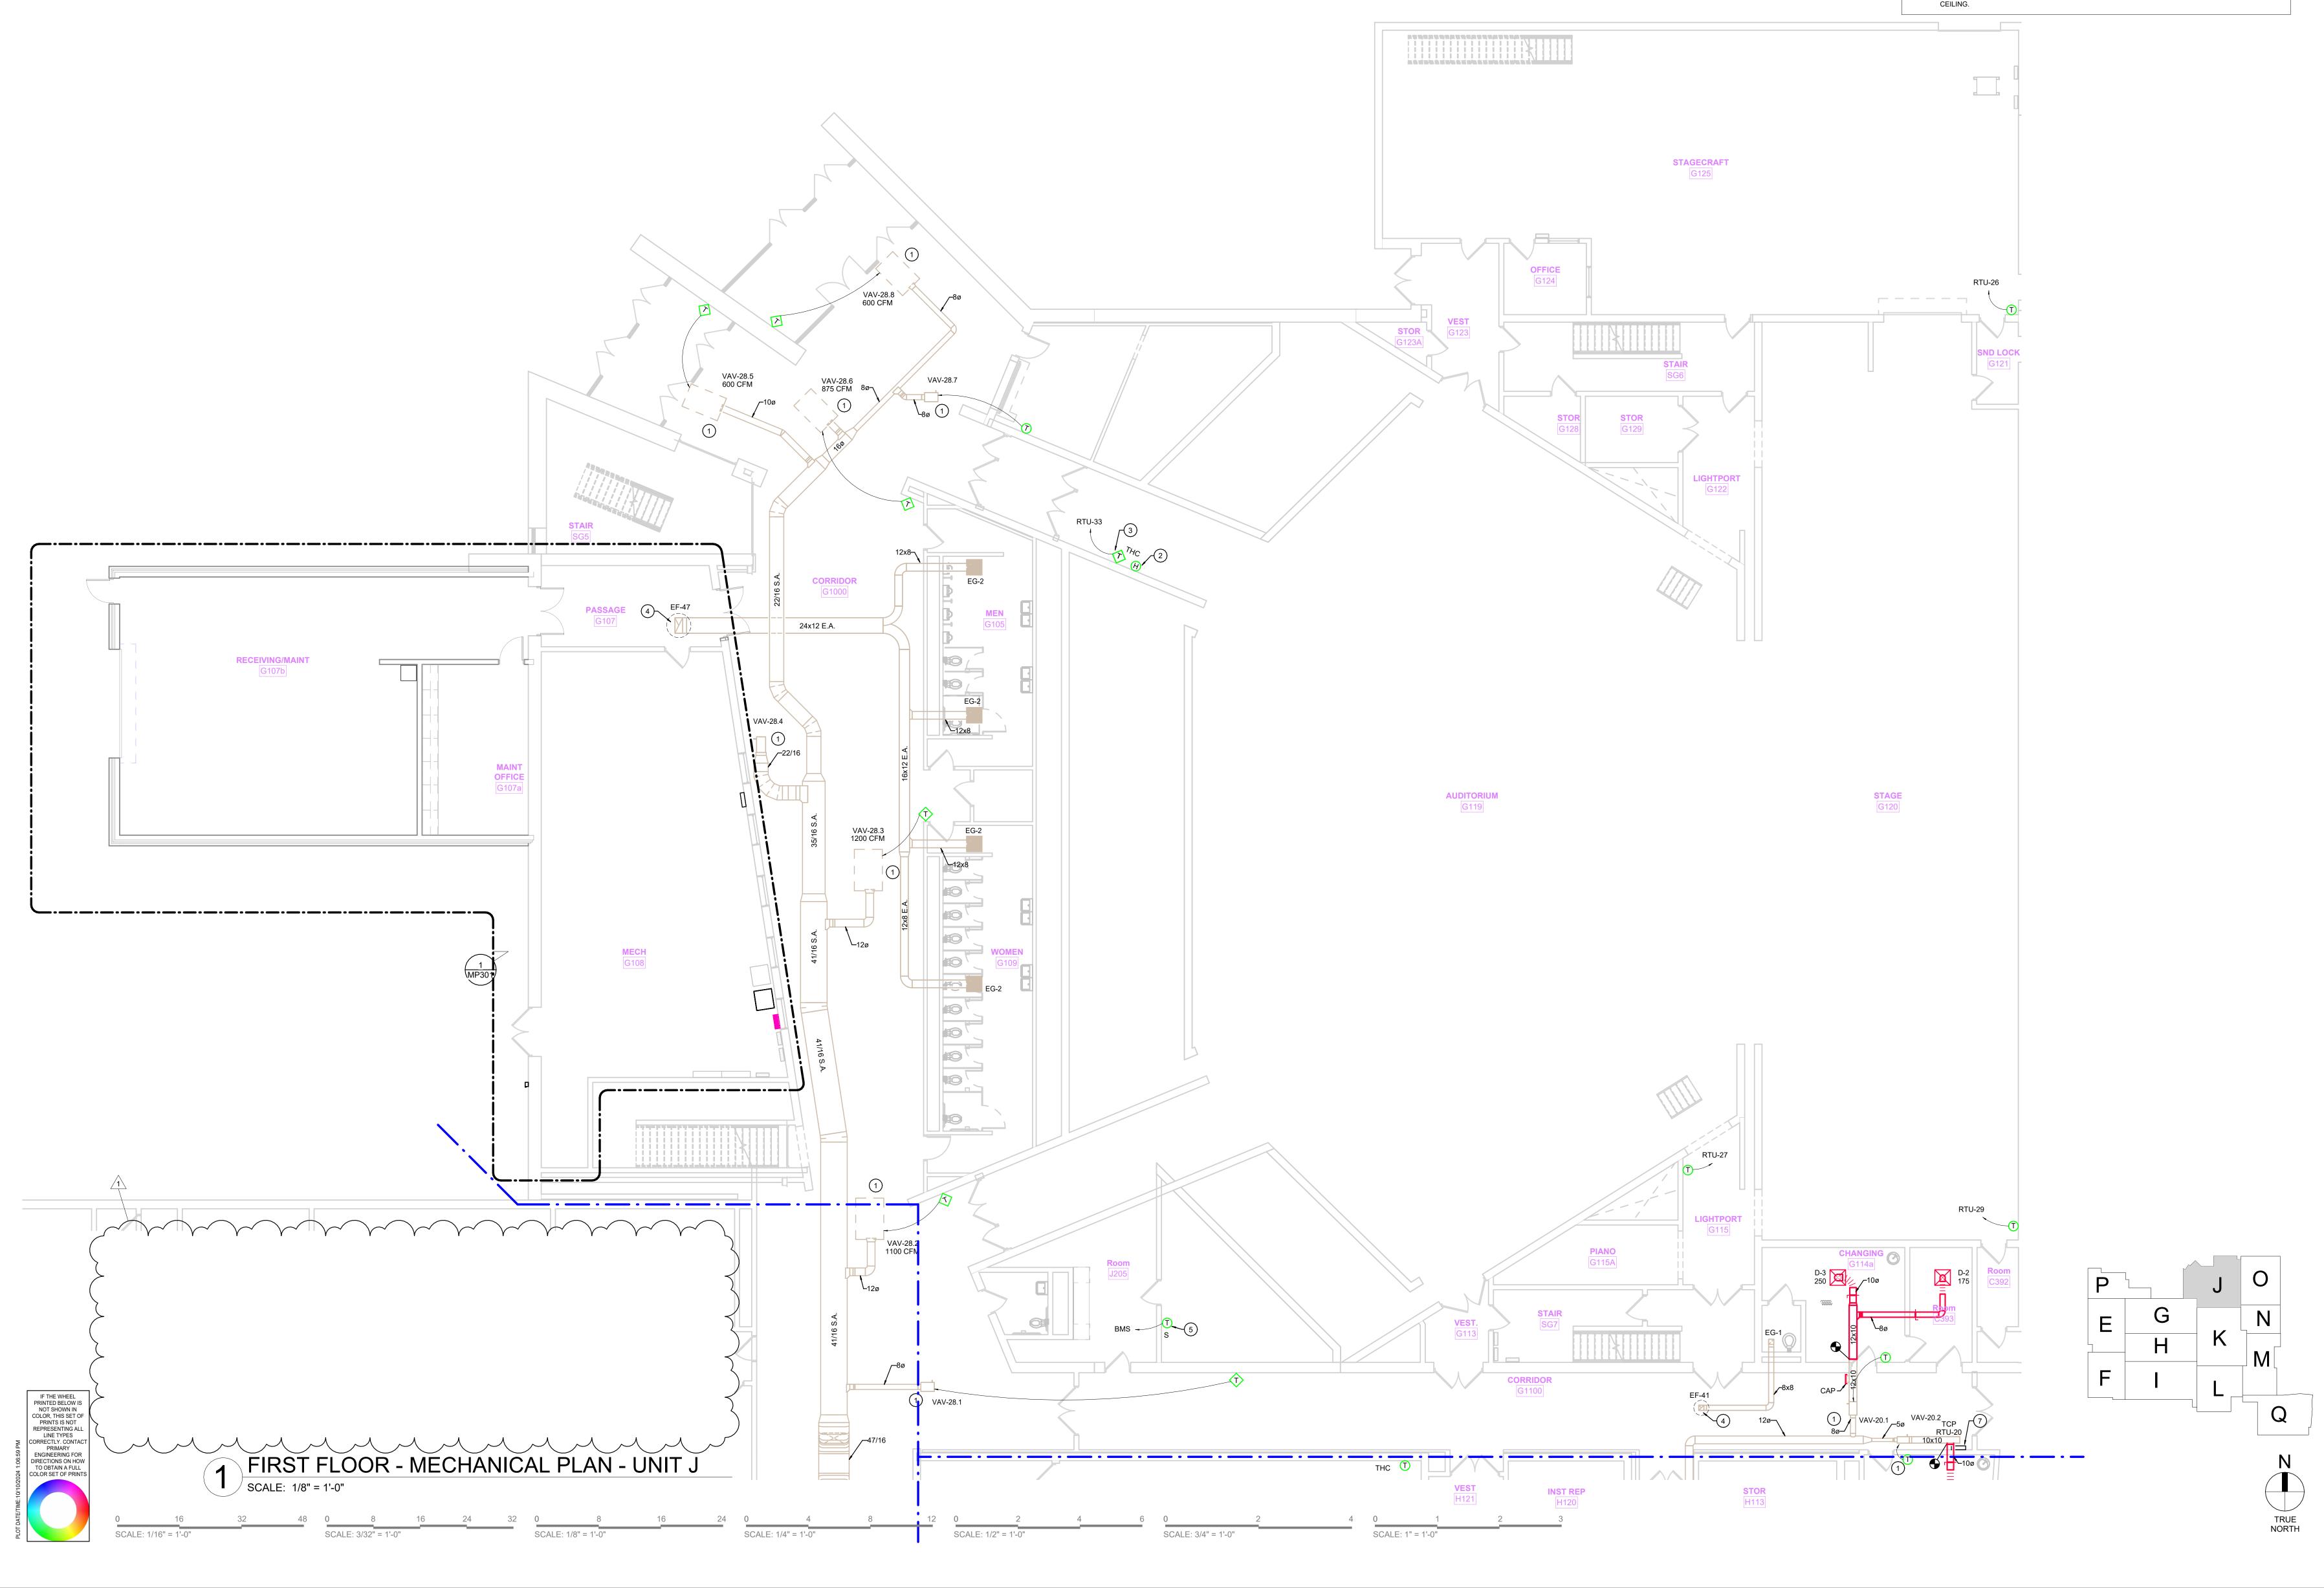

### REMOVE EXISTING VAV BOX CONTROLS INCLUDING CONTROLLER, ALL SENSORS, ALL ACTUATORS, ASSOCIATED WALL SENSOR(S), AND ALL ASSOCIATED WIRING COMPLETE. PROVIDE NEW CONTROLS SENSORS, ACTUATORS ON DAMPER/COIL WITH NEW WALL SENSOR IN SAME LOCATION. RUN NEW COMMUNICATION TRUNK WIRING. CLEAN VAV FLOW RING AND TUBING OF ALL DUST AND COMMISSION NEW CONTROLS AND VERIFY FLOW SETPOINTS WITH INDEPENDENT TAB. 2. REMOVE EXISTING HUMIDITY SENSOR AND COVER WITH BLANK COVER PLATE. PROVIDE NEW COMBINATION SENSOR WITH TEMPERATURE, HUMIDITY, CARBON DIOXIDE. NO SET POINT CONTROL OR DISPLAY. 4. REMOVE EXISTING AND PROVIDE NEW CONTROLS FOR EXHAUST FAN WITH FAN RELAY AND DAMPER ACTUATOR. 5. REPLACE EXISTING WALL SENSOR AND PROVIDE NEW TEMPERATURE SENSOR IN MDF/IDF ROOM. 6. REPLACE EXISTING WALL SENSOR AND PROVIDE NEW TEMPERATURE SENSOR FOR RTU. 7. PROVIDE AND INSTALL NEW ROOFTOP UNIT TEMPERATURE CONTROL PANEL ABOVE EXISTING

**PLAN NOTES** 





 
 2828 Lake Ave.
 9785 Crosspoint Blvd., Suite 103

 Fort Wayne, Indiana 46805
 Indianapolis, Indiana 46256


 260.424.0444 ph
 317.324.1221 ph


 info@primary-eng.com
 www.primary-eng.com
 All concepts, ideas, plans, and details as shown on this document are the sole property of Primary Engineering, Inc., and shall not be used for any other purpose without their expressed written consent. The project owner shall be permitted to retain copies for information and reference purposes. 2024 © Primary Engineering, Inc.

Indianapolis


Fort Wayne



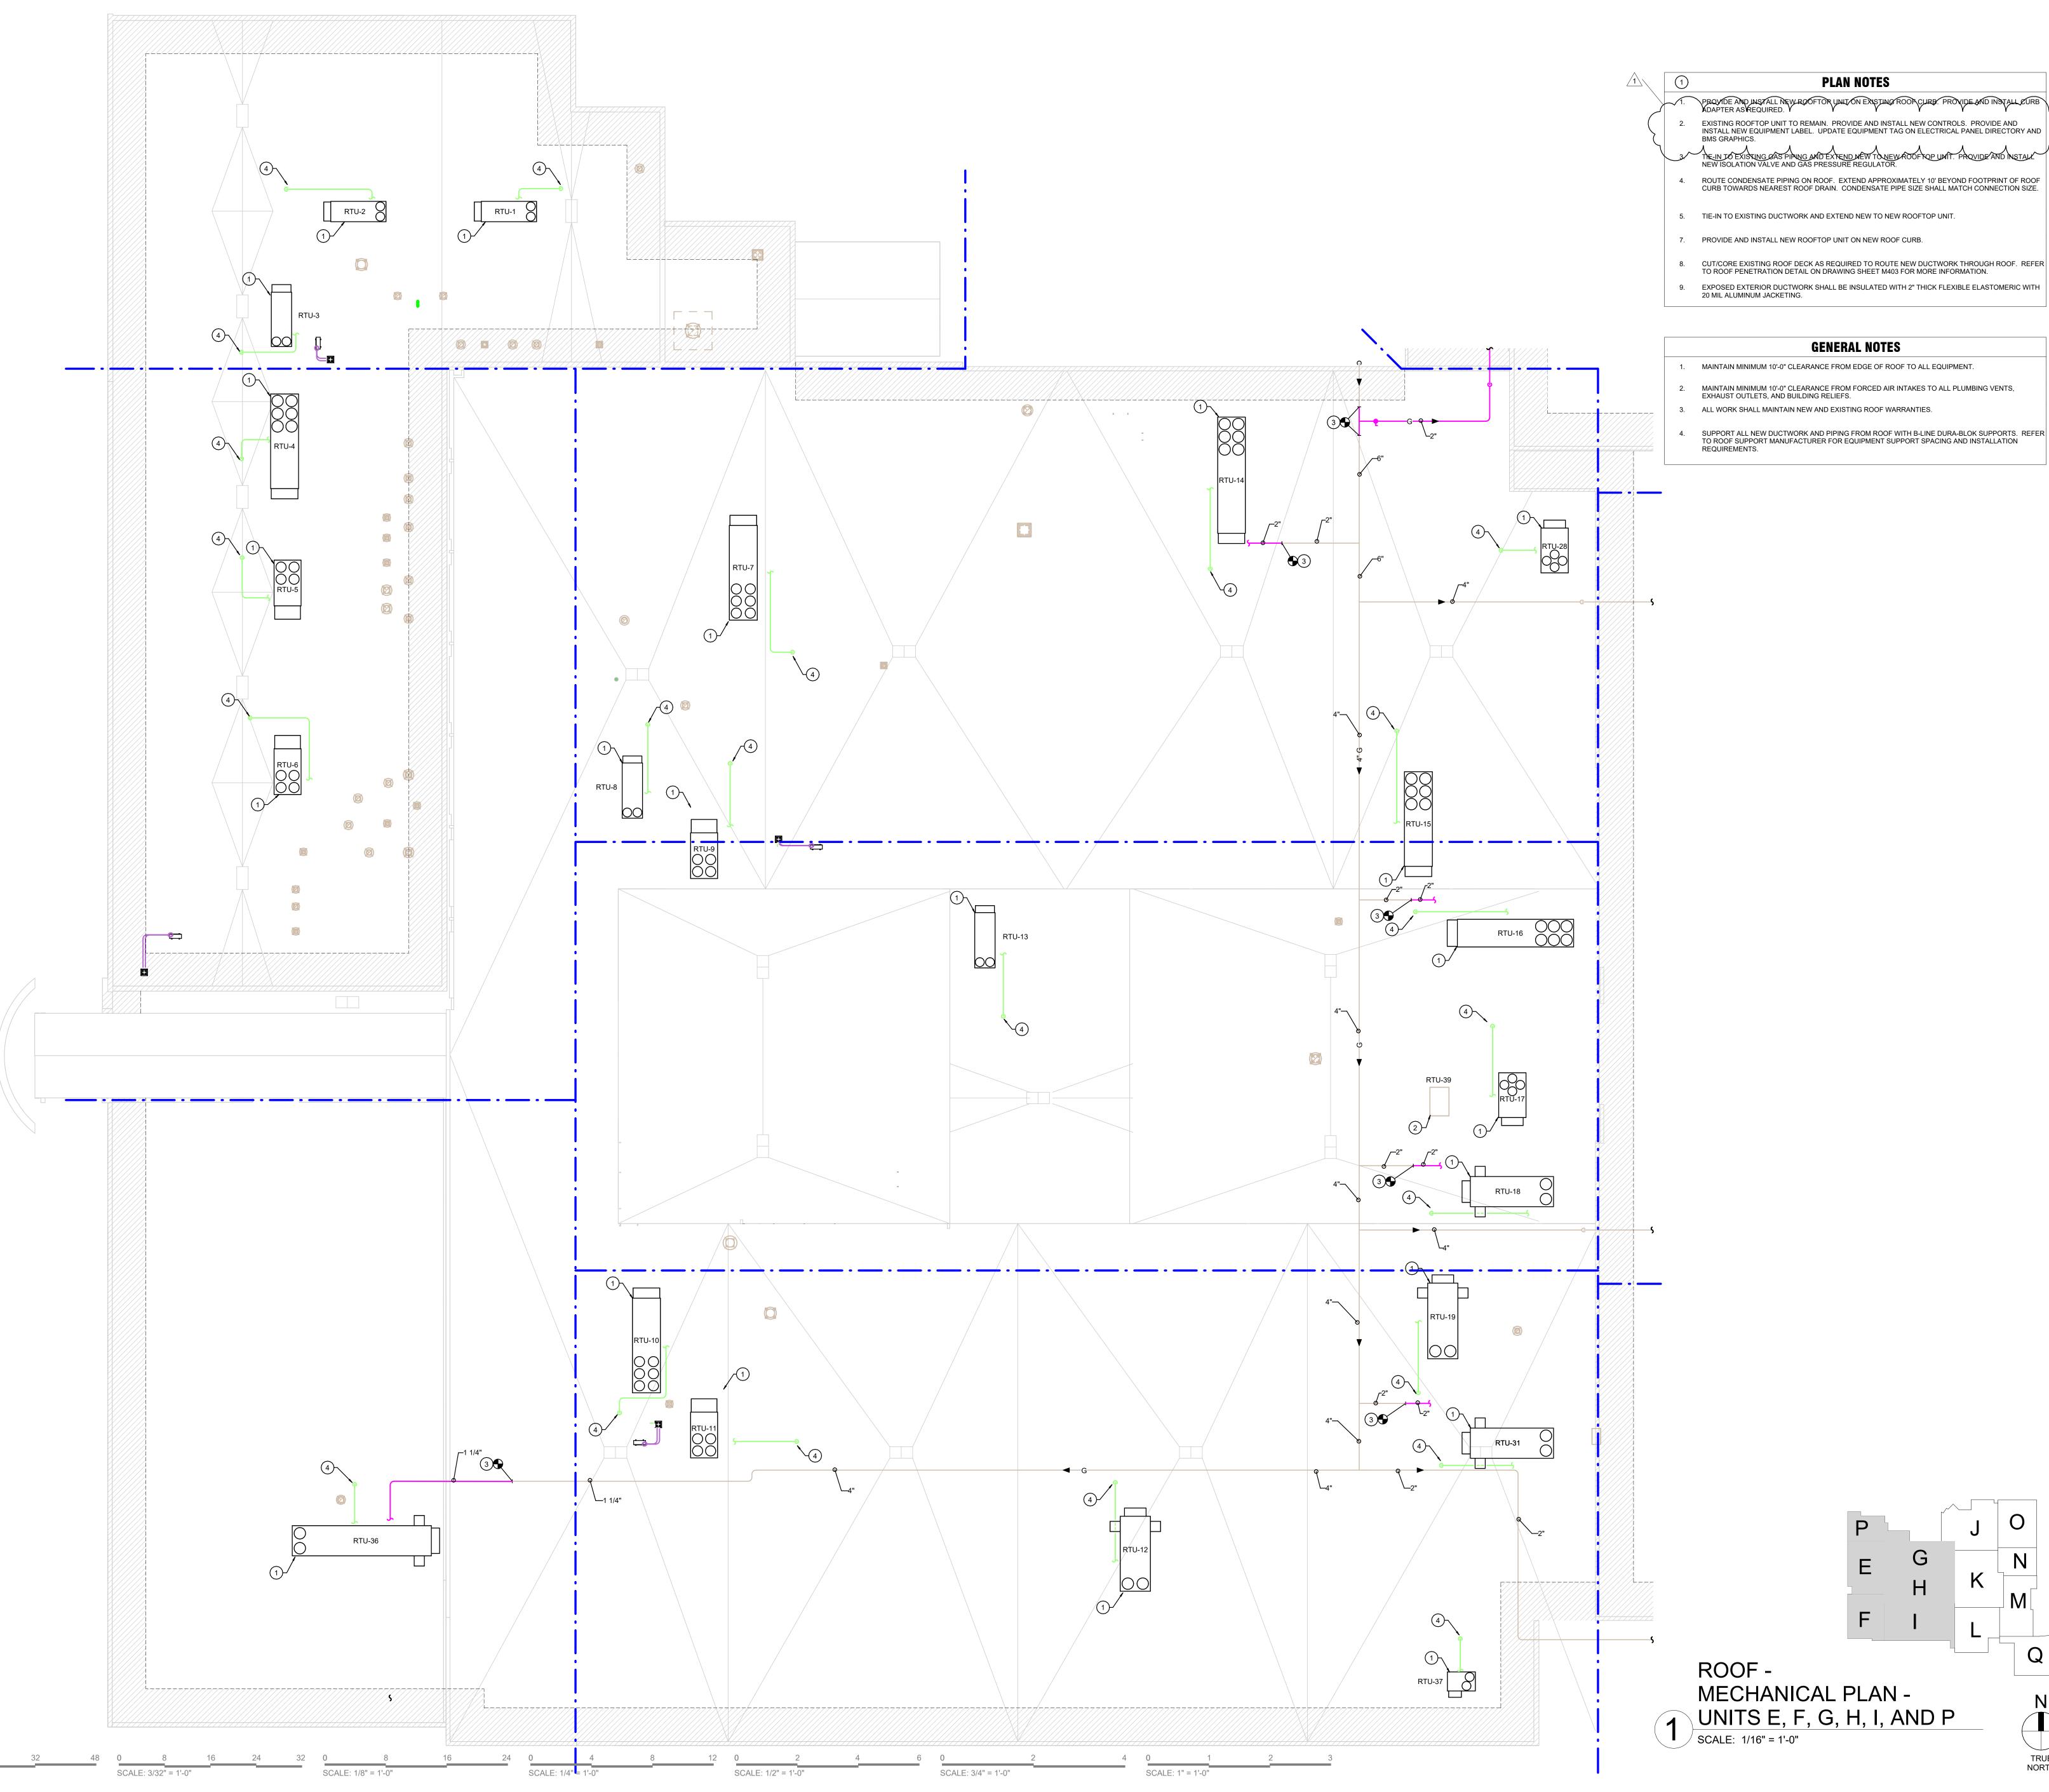


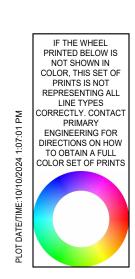

SCALE: 1/16" = 1'-0"

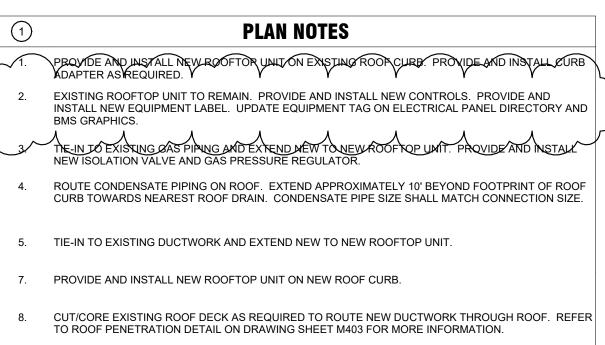

- MAINTAIN MINIMUM 10'-0" CLEARANCE FROM EDGE OF ROOF TO ALL EQUIPMENT.
- SUPPORT ALL NEW DUCTWORK AND PIPING FROM ROOF WITH B-LINE DURA-BLOK SUPPORTS. REFER TO ROOF SUPPORT MANUFACTURER FOR EQUIPMENT SUPPORT SPACING AND INSTALLATION

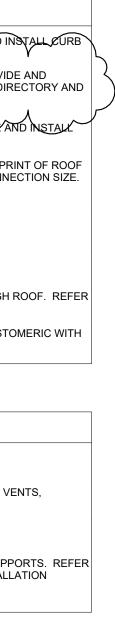





 
 Fort Wayne, Indiana 46805
 Indianapolis, Indiana 46256


 260.424.0444 ph
 317.324.1221 ph
 info@primary-eng.com www.primary-eng.com All concepts, ideas, plans, and details as

shown on this document are the sole property of Primary Engineering, Inc., and shall not be used for any other purpose without their expressed written consent. The project owner shall be permitted to retain copies for information and reference purposes. 2024 © Primary Engineering, Inc.



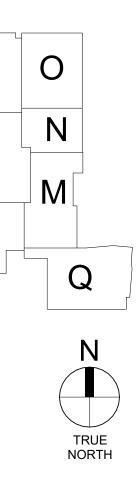


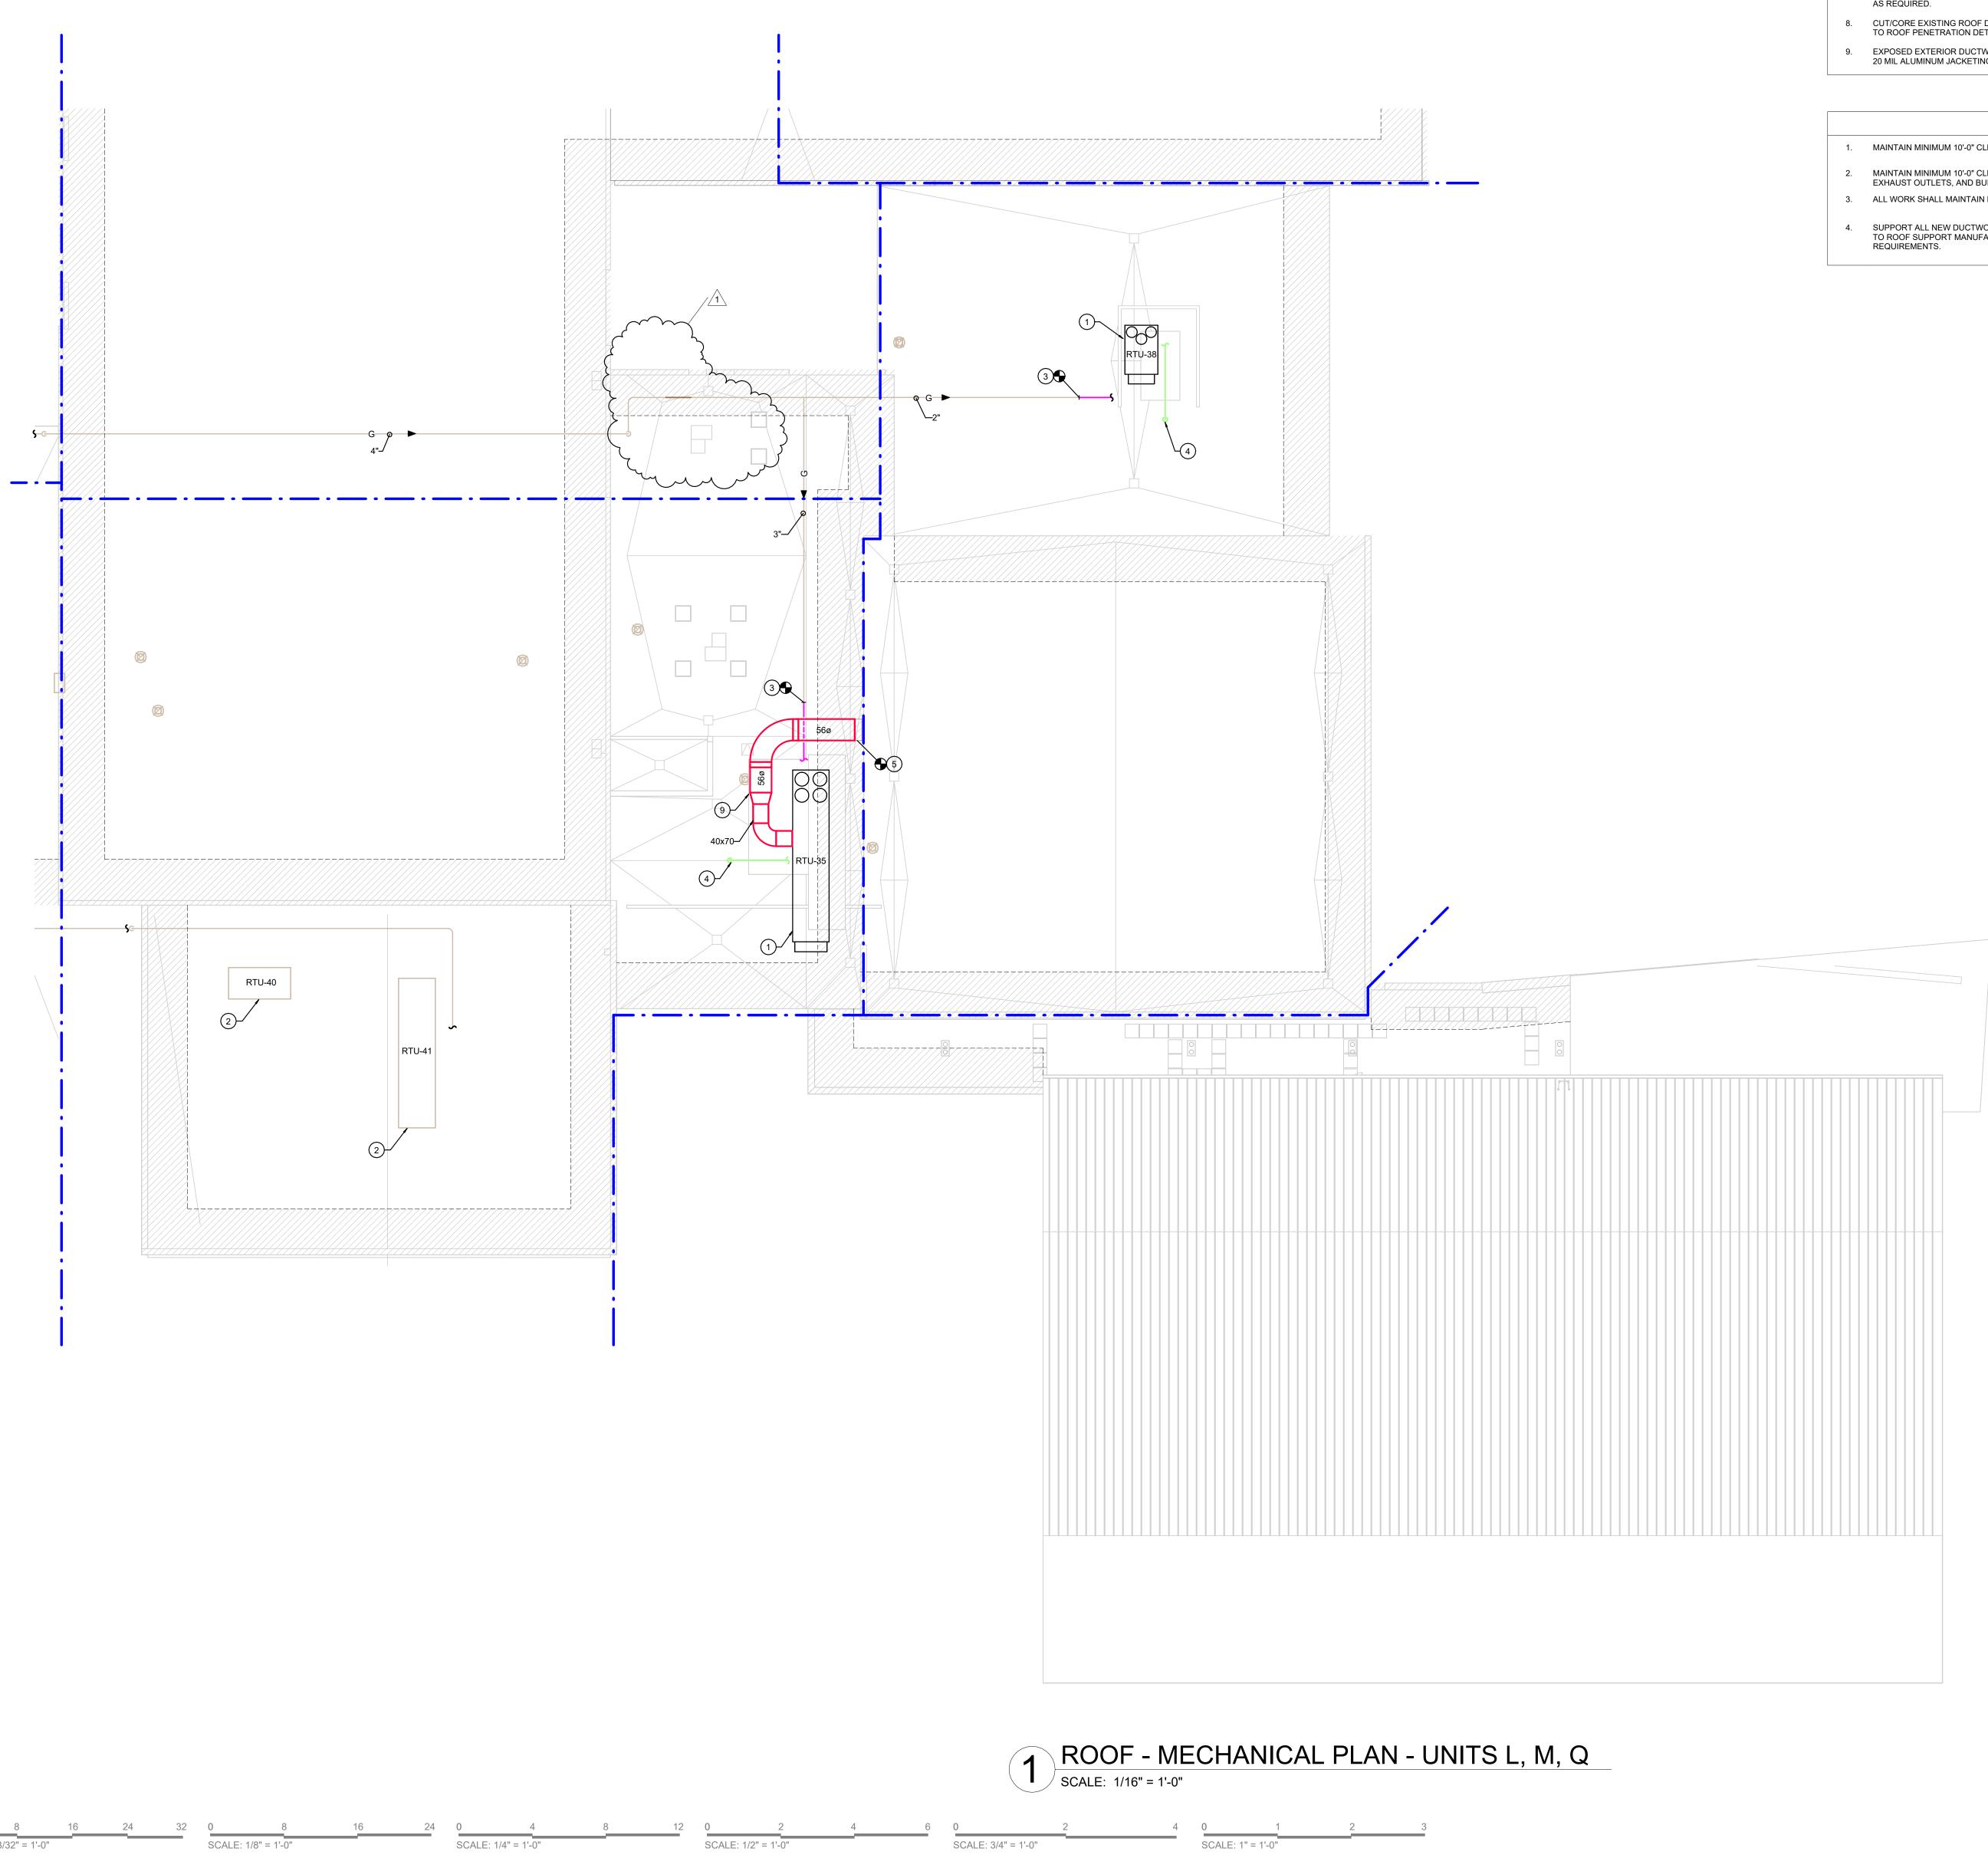


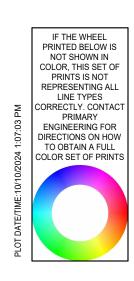

(X)	PLAN NOTES
	PROVIDE AND INSTALL NEW ROOF TOP UNIT ON EXISTING ROOF CURB PROVIDE AND IN ADAPTER AS REQUIRED.
2.	EXISTING ROOFTOP UNIT TO REMAIN. PROVIDE AND INSTALL NEW CONTROLS. PROVIDE INSTALL NEW EQUIPMENT LABEL. UPDATE EQUIPMENT TAG ON ELECTRICAL PANEL DIRE BMS GRAPHICS.
3.	THEN TO EXISTING GAS PLIPING AND EXTEND NEW TO NEW ROOF OP UNIT PROVIDE AN NEW ISOLATION VALVE AND GAS PRESSURE REGULATOR.
4.	ROUTE CONDENSATE PIPING ON ROOF. EXTEND APPROXIMATELY 10' BEYOND FOOTPRI CURB TOWARDS NEAREST ROOF DRAIN. CONDENSATE PIPE SIZE SHALL MATCH CONNE
5.	TIE-IN TO EXISTING DUCTWORK AND EXTEND NEW TO NEW ROOFTOP UNIT.
7.	PROVIDE AND INSTALL NEW ROOFTOP UNIT ON NEW ROOF CURB. CUT/CORE EXISTING FAS REQUIRED.
8.	CUT/CORE EXISTING ROOF DECK AS REQUIRED TO ROUTE NEW DUCTWORK THROUGH F TO ROOF PENETRATION DETAIL ON DRAWING SHEET M403 FOR MORE INFORMATION.
9.	EXPOSED EXTERIOR DUCTWORK SHALL BE INSULATED WITH 2" THICK FLEXIBLE ELASTO 20 MIL ALUMINUM JACKETING.

- 1. MAINTAIN MINIMUM 10'-0" CLEARANCE FROM EDGE OF ROOF TO ALL EQUIPMENT. 2. MAINTAIN MINIMUM 10'-0" CLEARANCE FROM FORCED AIR INTAKES TO ALL PLUMBING VENTS, EXHAUST OUTLETS, AND BUILDING RELIEFS.
- 3. ALL WORK SHALL MAINTAIN NEW AND EXISTING ROOF WARRANTIES.
- 4. SUPPORT ALL NEW DUCTWORK AND PIPING FROM ROOF WITH B-LINE DURA-BLOK SUPPORTS. REFER TO ROOF SUPPORT MANUFACTURER FOR EQUIPMENT SUPPORT SPACING AND INSTALLATION REQUIREMENTS.

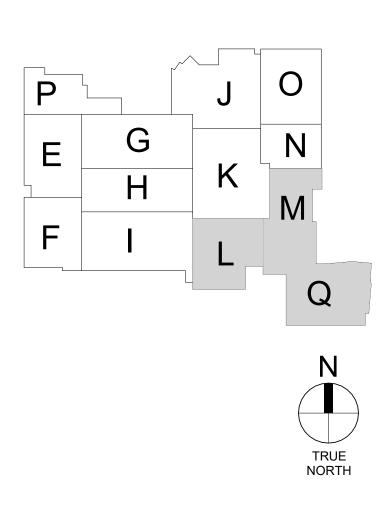


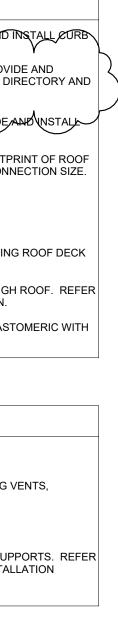




All concepts, ideas, plans, and details as shown on this document are the sole property of Primary Engineering, Inc., and shall not be used for any other purpose without their expressed written consent. The project owner shall be permitted to retain copies for information and reference purposes. 2024 © Primary Engineering, Inc.



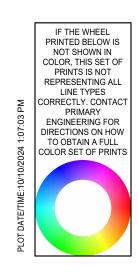

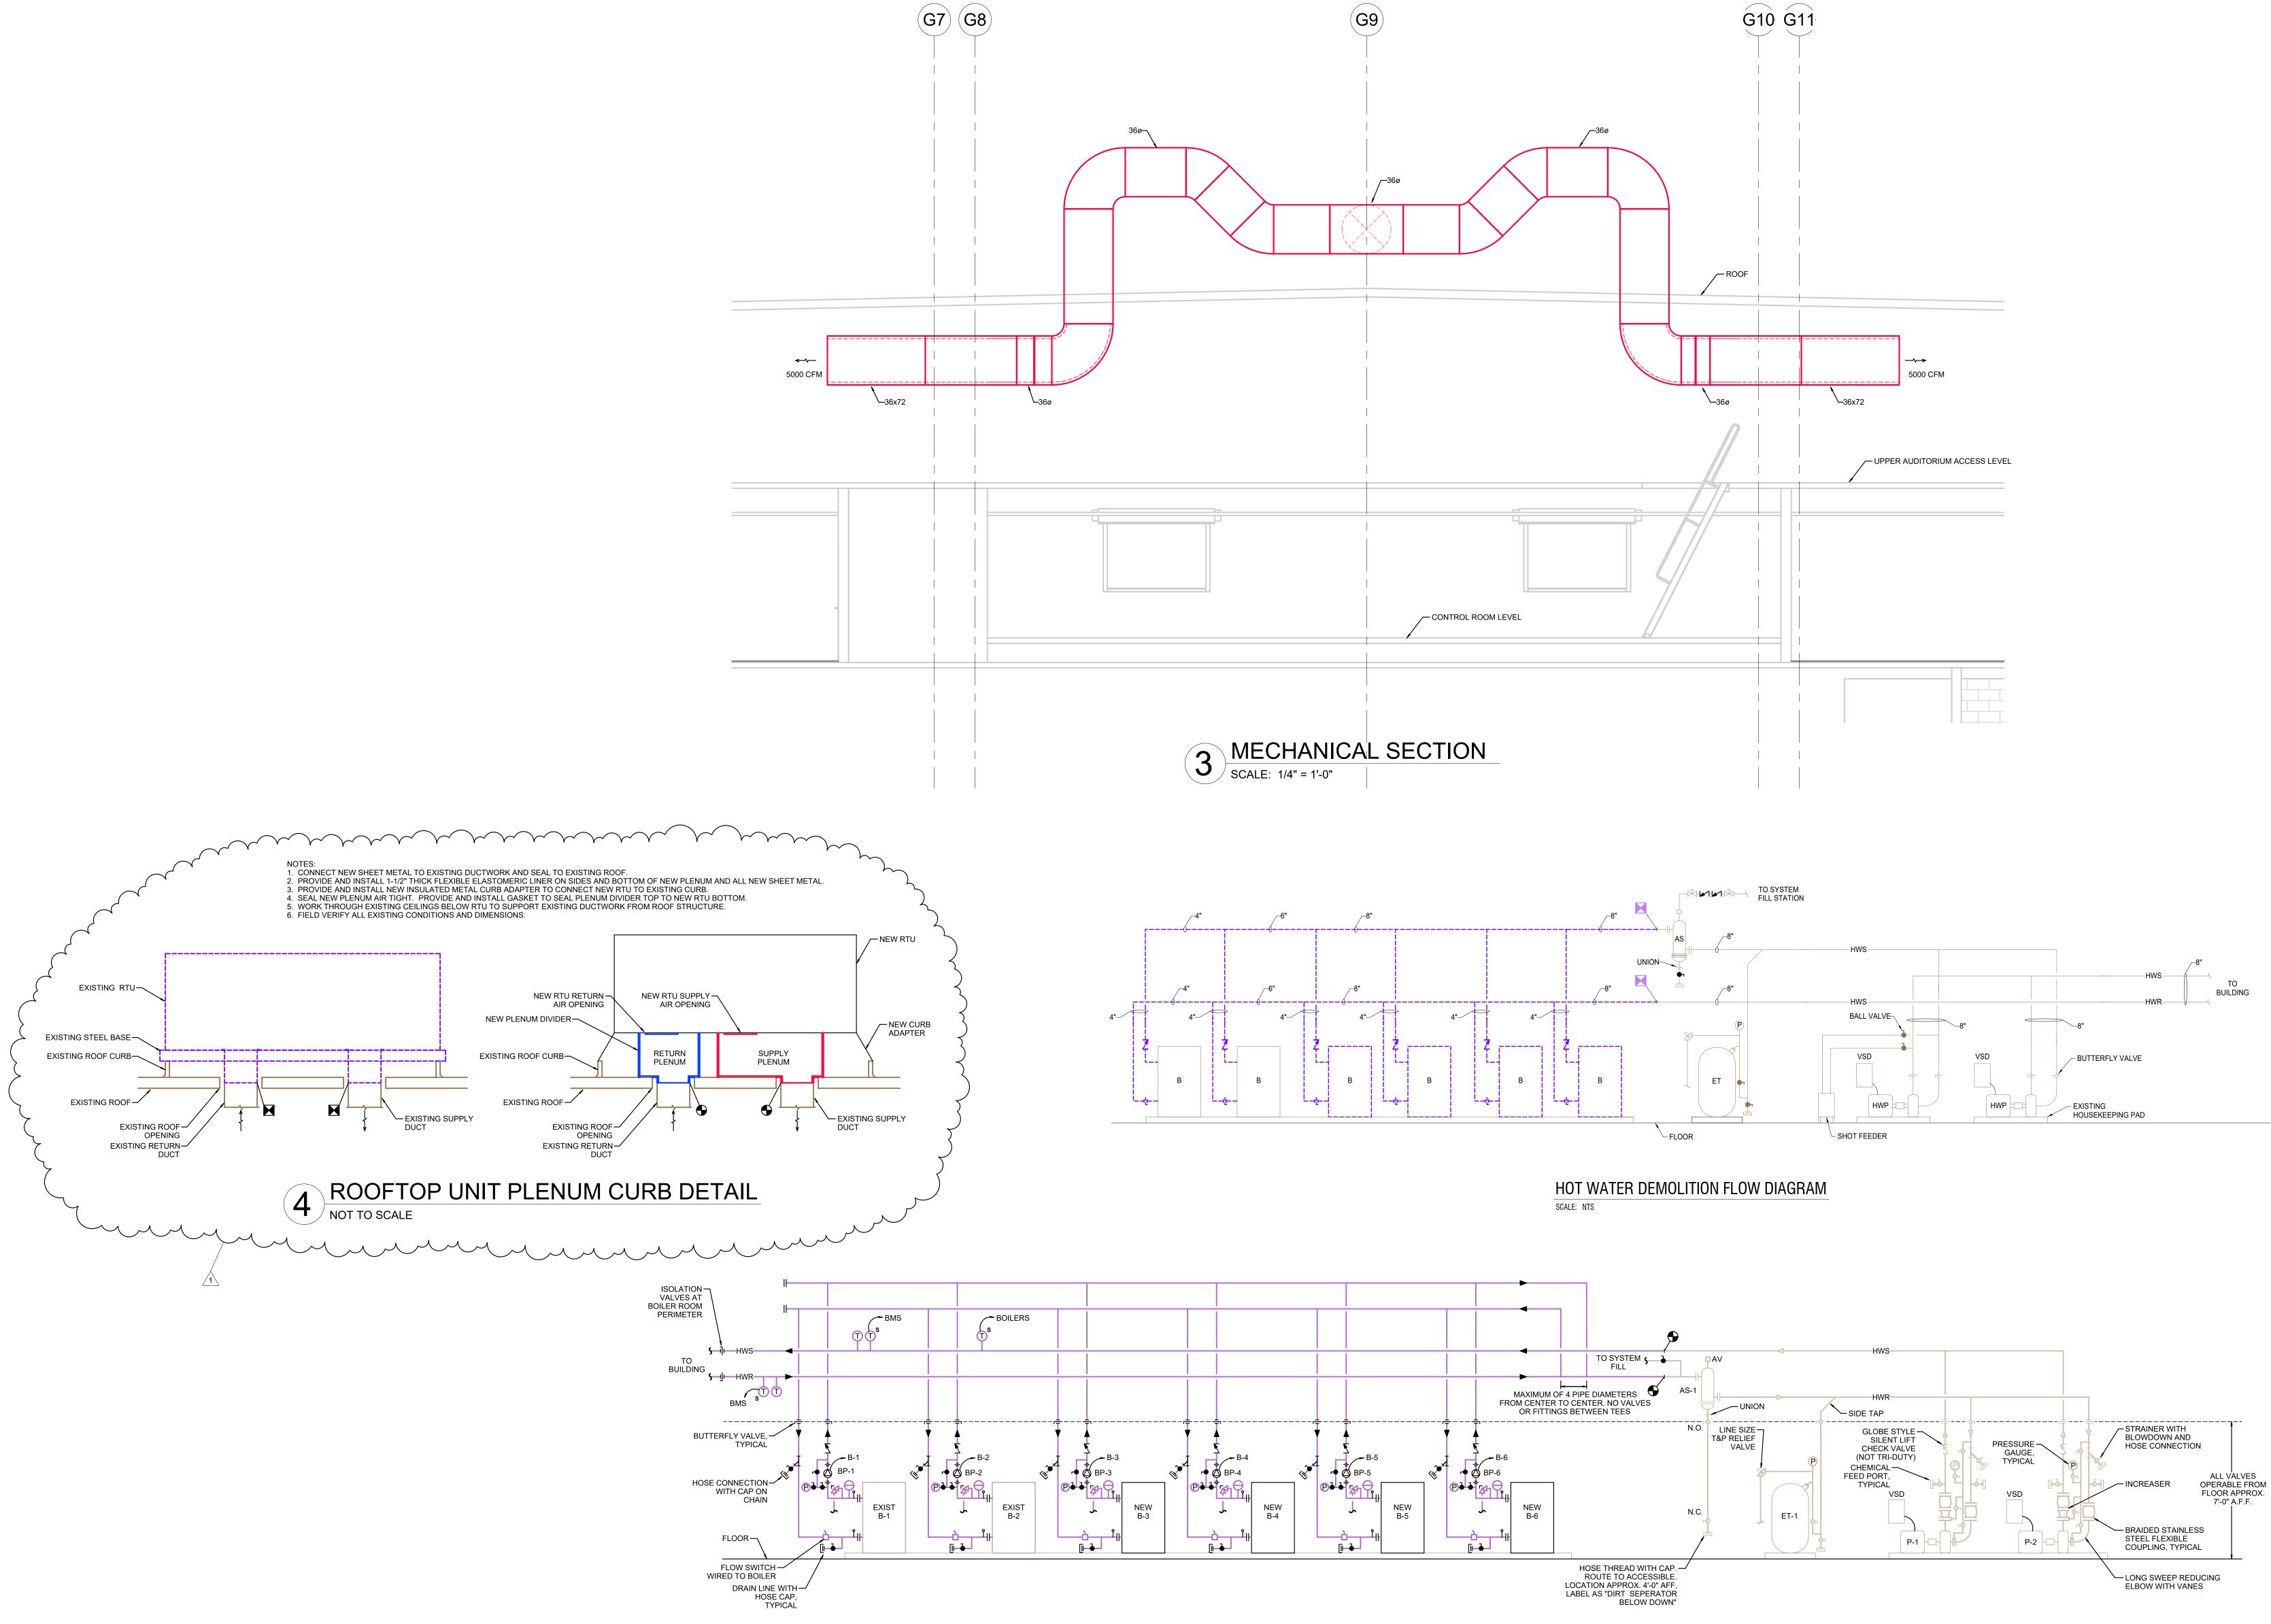

# 1 HOT WATER FLOW DIAGRAM NOT TO SCALE



 
 2828 Lake Ave.
 9785 Crosspoint Blvd., Suite 103

 Fort Wayne, Indiana 46805
 Indianapolis, Indiana 46256

 260.424.0444 ph
 317.324.1221 ph


 info@primary-eng.com
 www.primary-eng.com
 All concepts, ideas, plans, and details as shown on this document are the sole property of Primary Engineering, Inc., and shall not be used for any other purpose without their expressed written consent. The project owner shall be permitted to retain copies for information and reference purposes.

and reference purposes. 2024 © Primary Engineering, Inc.



PRIMARY JOB # 24584

																		ROOF	TOP UN	IT SCH	EDULE																		
TAG MANUFACTURER	RTU-1 ADDISON	RTU-2 ADDISON	RTU-3 ADDISON	RTU-4 ADDISON	RTU-5 ADDISON	RTU-6 ADDISON	RTU-7 ADDISON	RTU-8 ADDISON	RTU-9 ADDISON	RTU-10 ADDISON	RTU-11 ADDISON	RTU-12 CARRIER	RTU-13 ADDISON	RTU-14 ADDISON	RTU-15 ADDISON	RTU-16 ADDISON	RTU-17 CARRIER	RTU-18 CARRIER	RTU-19 CARRIER	RTU-20 CARRIER	RTU-21 CARRIER	RTU-22 CARRIER	RTU-23 CARRIER	RTU-24 CARRIER	RTU-25 CARRIER	RTU-26 CARRIER	RTU-27 CARRIER	RTU-28 CARRIER	RTU-29 CARRIER	RTU-30 CARRIER	RTU-31 CARRIER	RTU-32 CARRIER	RTU-33 CARRIER	RTU-34 CARRIER	RTU-35 CARRIER	RTU-36 CARRIER	RTU-37 CARRIER	RTU-38 CARRIER	CARRIER
MODEL PF SERVICE 2	RMA 150 C2 2ND FLR P	PRMA 150 C2 1ST FLR P	PRRA 120 C2 1ST FLR P	PRMA 360 D6 1ST FLR E	PRMK 241 S5 2ND FLR E/P	PRMK 241 S5 2ND FLR E	PRMA 300 D6 1ST FLR G	PRMA 210 C2 1ST FLR E/G	PRMK 241 S5 MEDIA CENTE	PRMA 300 D6 R 1ST FLR E/F/I	PRMK 241 S5	50V2AX28 1ST FLR I	PRMA 150 C2 I 1ST FLR H	PRMA 420 D6XL KITCHEN	PRMA 360 D6 CAFETERIA	PRMA 480 E6 MAIN GYM	50GC-M24 1ST FLR H	48V2DY34 MAIN GYM	50V2AX28 1ST FLR I	50V2AX28 1ST FLR K	50V2AX28 1ST/2ND O	48V2DY30 FIELD HOUSE	48V2DY30 FIELD HOUSE	48V2DY30 FIELD HOUSE	48V2DX34 1ST/2ND N	48GCRN09 1ST FLR J	48V2DY28 AUDITORIUM	50GC-M24 1ST FLR J	48V3DY70 STAGE	50GC-M20 1ST FLR K	48V2DY34 MAIN GYM	48V2DY34 MAIN GYM	48V2DY28 AUDITORIUM	50GC-N09 3RD FLR J	48V3DY74 AUX GYM	48V2DT54 1ST FLR F	50GC-N07 1ST FLR I	40001117 4	48GORK06 MAINT ADDN.
	VAV VERTICAL	VAV VERTICAL	VAV VERTICAL	VAV VERTICAL	VAV VERTICAL	VAV VERTICAL	VAV VERTICAL	VAV VERTICAL	VAV VERTICAL	VAV VERTICAL	VAV VERTICAL	VAV VERTICAL	VAV VERTICAL	SZ, IGH, HGRH VERTICAL	VAV VERTICAL	SZ, IGH, HGRH VERTICAL	VAV VERTICAL	SZ, IGH, HGRH VERTICAL	I VAV VERTICAL	VAV VERTICAL	VAV VERTICAL	SZ, IGH, HGRH	I SZ, IGH, HGRH VERTICAL	H SZ, IGH, HGRH VERTICAL	I VAV, IGH VERTICAL	SZ, IGH, HGRH VERTICAL	SZ, IGH, HGRH VERTICAL	VAV VERTICAL	SZ, IGH, HGRH VERTICAL	VAV VERTICAL	SZ, IGH, HGRH VERTICAL	SZ, IGH, HGRH VERTICAL	SZ, IGH, HGRH VERTICAL	SZ, HGRH VERTICAL	SZ, IGH, HGRH HORIZONTAL	VAV, IGH VERTICAL	SZ, HGRH VERTICAL	SZ, IGH, HGRH SZ, VERTICAL	
UNIT WIEGHT (LBS) FILTER AREA (S.F.)	3260 40	3260 40	3218 40	7091 108.3	3948 83.3	3948 8.3	6779 108.3	3428 40	3948 83.3	6776 108.3	3948 83.3	5200 -	3260 40	7826 108.3	7003 108.3	9782 126.1	2790 31.3	6055 -	5200	5200 -	5200	6305 -	6305	6305	6215	1118 11.1	6055 -	2790 31.3	9671 50	2466 20.8	6305 -	6305 -	6055	1043 11.1	9738 50	9359 50	918 4.4	2403 6.9	
FILTER APD (IN W.C.) FILTER TYPE 2	0.46 2" PLEATED	0.46 2" PLEATED	0.36 2" PLEATED	0.52 2" PLEATED	1.02 2" PLEATED	1.02 2" PLEATED	0.29 2" PLEATED	0.29 2" PLEATED	0.99 2" PLEATED	0.31 2" PLEATED	1.01 2" PLEATED	- 2" PLEATED	0.46 2" PLEATED	0.29 2" PLEATED	0.54 2" PLEATED	0.34 2" PLEATED	- 2" PLEATED	- 2" PLEATED	- 2" PLEATED	- 2" PLEATED	- 2" PLEATED	- 2" PLEATED	- 2" PLEATED	- 2" PLEATED	- 2" PLEATED	- 2" PLEATED	- 2" PLEATED	- 2" PLEATED	0.15 2" PLEATED	- 2" PLEATED	- 2" PLEATED	- 2" PLEATED	- 2" PLEATED	- 2" PLEATED	0.18 2" PLEATED	0.14 2" PLEATED	- 2" PLEATED	- 2" PLEATED 2'	2" PLEATED
FILTER EFF. SUPPLY FAN	MERV 8 RTU-1	MERV 8 RTU-2	MERV 8 RTU-3	MERV 8 RTU-38	MERV 8 RTU-42
AIRFLOW (CFM) OUTSIDE AIR (CFM)	4950 1770	4950 930	4400 660	12775 4470	7950 2910	7950 2975	9505 2025	5000 2445	7840 2535	9775 3765	7925 3825	11300 3955	4950 1755	9500 2000	12910 4355	15000 7000	8665 3945	15000 7000	10875 3465	9150 4120	10700 6955	12000 3000	12000 3000	12000 3000	15000 8250	3000 450	10000 4000	7500 2600	26000 1300	6325 2215	15000 7000	15000 7000	10000 4000	3200 0	32000 3000	17420 4980	2700 270	4920 2450	440
TSP (IN W.C.) ESP (IN W.C.) BPM	3.01 1.63 2110	3.01 1.63 2110	2.47 1.39 1894	3.52 2.02 1609	4.63 1.58 2246	4.63 1.58 2246	2.53 1.44 1816	2.49 1.63 2029	4.66 1.68 2245	2.86 1.70 1884	4.40 1.36 2202	- 1.80 1942	3.01 1.63 2110	3.54 1.50 1909	3.72 2.33 1638	3.89 1.20 2236	- 1.66 2153	- 1.20 2323	- 1.70 1875	- 1.50 1661	- 1.80 1883	- 1.20 1900	- 1.20 1900	- 1.20 1900	- 1.20 2150	- 1.75 1956	- 1.00 1680	- 1.60 1991	2.3 1.00 2630	- 1.60 1812	- 1.20 2251	- 1.20 2251	- 1.00 1680	- 0.75 1601	2.5 0.90 2540	2.2 1.60 2047	- 1.00 1627	- 1.00 1501	2394
FAN QUANTITY DRIVE TYPE	1 DIRECT	1 DIRECT	1 DIRECT	1 DIRECT	2 DIRECT	2 DIRECT	1 DIRECT	1 DIRECT	2 DIRECT	1 DIRECT	2 DIRECT	- DIRECT	1 DIRECT	1 DIRECT	1 DIRECT	2 DIRECT	1 DIRECT	- DIRECT	- DIRECT	- DIRECT	- DIRECT	- DIRECT	- DIRECT	- DIRECT	- DIRECT	- DIRECT	- DIRECT	- DIRECT	4 DIRECT	- DIRECT	- DIRECT	- DIRECT	- DIRECT	- DIRECT	6 DIRECT	4 DIRECT	- DIRECT	- DIRECT	
MOTOR (HP, EA) MOTOR (BHP, EA)	5 3.84	5 3.84	5 2.79	15 10.92	6.97 4.35	6.97 4.35	10 6.9	5 3.32	6.97 4.31	10 7.76	6.97 4.12	- 8.38	5 3.84	10 8.35	15 11.55	10 7.27	- 7.39	- 14.31	- 7.56	- 5.26	- 7.66	- 7.88	- 7.88	- 7.88	- 11.2	- 2.77	- 5.46	- 5.9	9.4 6.83	- 4.47	- 12.94	- 12.94	- 5.46	- 1.46	9.4 6.4	4.8 3.14	- 1.61	- 2.54	1.45
MOTOR TYPE 4 EXHAUST FAN	I-POLE VFD RTU-1	4-POLE VFD RTU-2	4-POLE VFD RTU-3	4-POLE VFD RTU-4	ECM RTU-5	ECM RTU-6	4-POLE VFD RTU-7	4-POLE VFD RTU-8	ECM RTU-9	4-POLE VFD RTU-10	ECM RTU-11	- RTU-12	4-POLE VFD RTU-13	4-POLE VFD RTU-14	4-POLE VFD RTU-15	4-POLE VFD RTU-16	- RTU-17	- RTU-18	- RTU-19	- RTU-20	- RTU-21	- RTU-22	- RTU-23	- RTU-24	- RTU-25	- RTU-26	- RTU-27	- RTU-28	ECM RTU-29	- RTU-30	- RTU-31	- RTU-32	- RTU-33	- RTU-34	ECM RTU-35	ECM RTU-36	- RTU-37	- RTU-38	{ RTU-42
AIRFLOW (CFM) ESP (IN W.C.)	4950 0.25	4950 0.25	4400 0.25	12775 0.25	7950 0.25	7950 0.25	9505 0.25	5000 0.25	7840 0.25	9775 0.25	7925 0.25	11300 0.25	4950 0.25	9500 0.25	12910 0.25	15000 0.25	4590 0.25	15000 0.25	10875 0.25	9150 0.25	10700 0.25	12000 0.25	12000 0.25	12000 0.25	15000 0.25	3000 0.25	10000 0.25	4590 0.25	26000 0.25	4590 0.25	15000 0.25	15000 0.25	10000 0.25	3200 0.25	32000 0.25	17420 0.25	2700 0.25	4590 0.25	0.25
RPM FAN QUANTITY	1716	1716	1544	1570	1522 2	1522 2	1276 2	1731	1504 2	1306 2	1518 2	-	1716	1276 2	1585	2250 2	-	-	-	633	- 741	-	- 1523	1520	- 1874	-	-	-	2161 3	-	- 1874	-	-	-	2238 3	2206 2	-	-	
DRIVE TYPE MOTOR (HP, EA)	DIRECT 2	DIRECT 2	DIRECT 1 1/2	DIRECT 10	DIRECT 3.88	DIRECT 3.88	DIRECT 7 1/2	DIRECT 2	DIRECT 3.88	DIRECT 7 1/2	DIRECT 3.88	DIRECT	DIRECT 2	DIRECT 7 1/2	DIRECT 10	DIRECT 2	DIRECT	DIRECT	DIRECT	DIRECT	DIRECT	DIRECT	DIRECT	DIRECT	DIRECT	DIRECT -	DIRECT	DIRECT -	DIRECT 9.7	DIRECT	DIRECT	DIRECT	DIRECT	DIRECT	DIRECT 9.7	DIRECT 9.7	DIRECT -	DIRECT -	
MOTOR (BHP, EA) MOTOR TYPE 4	1.69 I-POLE VFD	1.69 4-POLE VFD	1.24 4-POLE VFD	8.2 4-POLE VFD	1.14 ECM	1.14 ECM	2.56 ECM	1.73 4-POLE VFD	1.1 ECM	3.73 ECM	1.13 ECM	3.31	1.69 4-POLE VFD	2.56 ECM	8.42 4-POLE VFD	1.8 4-POLE VFD	-	2.1	0.8	0.48	0.76	2.78	2.78	2.78	5.06	-	2.78	-	4.2 ECM	-	5.06	5.06	2.78	-	4.6 ECM	4.2 ECM	-	-	
DX COOLING COIL AIRFLOW (CFM)	RTU-1 4950	RTU-2 4950	RTU-3 4400	RTU-4 12775	RTU-5 7950	RTU-6 7950	RTU-7 9505	RTU-8 5000	RTU-9 7840	RTU-10 9775	RTU-11 7925	RTU-12 11300	RTU-13 4950	RTU-14 9500	RTU-15 12910	RTU-16 15000	RTU-17 8665	RTU-18 15000	RTU-19 10875	RTU-20 9150	RTU-21 10700	RTU-22 12000	RTU-23 12000	RTU-24 12000	RTU-25	RTU-26 3000	RTU-27 10000	RTU-28 7500	RTU-29 26000	RTU-30 6325	RTU-31 15000	RTU-32 15000	RTU-33 10000	RTU-34 3200	RTU-35 35000	RTU-36 17420	RTU-37 2700	RTU-38 4920	RTU-42 2200
TOTAL CAP (MBH) SENS CAP (MBH)	152 128	152 128	123 111	434 339	282 221	282 221	323 254	209 150	281 212	335 266	290 218	346 271	152 128	415 293	378 335	424 385	253 203	401 360	337 264	339 250	363 283	346 278	346 278	346 278	409 361	92 72	338 263	241 178	720 556	207 157	401 360	401 360	338 263	90 71	842 704	614 454	69 56	183 137	47
EAT DB/WB (DEG F)	80 / 66 56 / 56	80 / 66 56 / 56	78 / 64	81 / 67 56 / 56	81 / 66	81 / 66 54 / 54	78 / 65	81 / 67 53 / 53	81 / 66	81 / 67 56 / 56	83 / 68 56 / 56	81 / 67 59 / 57	80 / 66 56 / 56	81 / 67 53 / 53	81 / 66 57 / 56	76 / 64	83 / 68 61 / 59	83 / 68 55 / 55	80 / 66 58 / 56	83 / 68 58 / 56	86 / 70 61 / 60	79 / 65 58 / 56	79 / 65 58 / 56	79 / 65 58 / 56	84 / 69 62 / 61	78 / 64 56 / 54	82 / 67 58 / 56	81 / 67 59 / 57	76 / 63	81 / 67 58 / 57	83 / 68 55 / 55	83 / 68 55 / 55	82 / 67 58 / 56	75 / 62 55 / 55	77 / 63	80 / 66 58 / 54	77 / 63 58 / 54	83 / 68 57 / 56	80 / 67
FPI	6 12	6 12	6 12	6 12	6 12	6 12	6 12	6 12	6 12	6 12	6 12	-	6 12	6 12	6 12	6 12	-	-	-	-	-	-	· ·	-	-	-	-	-	6 12	-	-	-	-	-	6 12	4 12	-	-	
APD (IN W.C.) AIR VELOCITY (FPM) REFRIGERANT	412 R454B	0.5 412 R454B	0.38 366 R454B	0.56 442 R454B	0.72 496 R454B	0.72 496 R454B	0.34 329 R454B	0.36 312 R454B	0.72 490 R454B	0.36 338 R454B	0.73 495 R454B	- - R454B	0.5 412 R454B	0.32 328 R454B	0.49 446 R454B	0.39 359 R454B	- - R454B	- - R454B	R45 <b>9B</b>
CIRCUITS AMBIENT (DEG F)	2 95	2 95	2 95	2 95	2 95	2 95	2 95	2 95	2 95	2 95	2 95	1 95	2 95	2 95	2 95	2 95	1 95	1 95	1 95	1 95	1 95	1 95	1 95	1 95	1 95	1 95	1 95	1 95	2 95	1 95	1 95	1 95	1 95	95	2 95	2 95	1 95	1 95	95
STAGES EER	VFD 9.6	VFD 9.6	VFD 10.1	VFD 10.5	VFD 9.6	VFD 9.6	VFD 10.3	VFD 10.5	VFD 9.6	VFD 10.3	VFD 10	VFD 10.5	VFD 9.6	VFD 10.8	VFD 8.9	VFD 13.7	2 11.6	VFD 9.8	VFD 10.5	VFD 10.5	VFD 10.5	VFD 10.3	VFD 10.3	VFD 10.3	VFD 9.8	2 11.8	VFD 10.4	2 11.6	VFD 9.8	2 12	VFD 9.8	VFD 9.8	VFD 10.4		VFD 9.5	VFD 10.4	2 12.4	2 11.8	12.8
INDIRECT GAS-FIRED HEAT AIRFLOW (CFM)	RTU-1	RTU-2 -	RTU-3	RTU-4 -	RTU-5	RTU-6	RTU-7	RTU-8 -	RTU-9	RTU-10 -	RTU-11	RTU-12 -	RTU-13	RTU-14 9500	RTU-15 -	RTU-16 15000	RTU-17	RTU-18 15000	RTU-19	RTU-20	RTU-21	RTU-22 12000	RTU-23 12000	RTU-24 12000	RTU-25	RTU-26 3000	RTU-27 10000	RTU-28 -	RTU-29 26000	RTU-30 -	RTU-31 15000	RTU-32 15000	RTU-33 10000	RTU-34 -	RTU-35 32000	RTU-36 17420	RTU-37 -	RTU-38 4920	RTU-42 2200
INPUT CAP (MBH, EA) OUTPUT CAP (MBH, EA)	-	-	-	-	-	-		-	-	-	· ·	-		800 648	-	600 486		650 527	-	-	-	650 527	650 527	650 527	650 527	180 148	650 527	-	1068 865	-	650 527	650 527	650 527	-	1068 865	1068 865	-	400 324	110 88
EAT DB (DEG F) LAT DB (DEG F)	-	-		-	-	-		-		-	· ·	-	-	58 121	-	56 86	-	38 70	-	-	-	52 93	52 93	52 93	32 65	60 106	42 90	-	67 96	-	38 70	38 70	42 90	-	63 94	50 96	-	35 96	60 97
FUEL MODULATION	-	-	-	-	-	-	-		-	-	-	-		NAT GAS 10 TO 1	-	NAT GAS 10 TO 1	- -	NAT GAS 2-STAGE	-	-	-	NAT GAS 2-STAGE	NAT GAS 2-STAGE	NAT GAS 2-STAGE	NAT GAS 2-STAGE	NAT GAS 2-STAGE	NAT GAS 2-STAGE	-	NAT GAS 2-STAGE	-	NAT GAS 2-STAGE	NAT GAS 2-STAGE	NAT GAS 2-STAGE	-	NAT GAS 2-STAGE	NAT GAS 2-STAGE	-	NAT GAS	NAT. GAS 2-STAGE
EFFICIENCY APD (IN W.C.)	-	-	-	-	-	-	-	-	-	-	-	-	-	81 1.09	-	81 0.87	-	-	-	-	-	-	-	-	-	-	-	-	-	-	-	-	-	-	-	-	-	-	89
	RTU-1 460/3	RTU-2 460/3	RTU-3 460/3	RTU-4 460/3	RTU-5 460/3	RTU-6 460/3	RTU-7 460/3	RTU-8 460/3	RTU-9 460/3	RTU-10 460/3	RTU-11 460/3	RTU-12 460/3	RTU-13 460/3	RTU-14 460/3	RTU-15 460/3	RTU-16 460/3	RTU-17 460/3	RTU-18 460/3	RTU-19 460/3	RTU-20 460/3	RTU-21 460/3	RTU-22 460/3	RTU-23 460/3	RTU-24 460/3	RTU-25 460/3	RTU-26 460/3	RTU-27 460/3	RTU-28 460/3	RTU-29 460/3	RTU-30 460/3	RTU-31 460/3	RTU-32 460/3	RTU-33 460/3	RTU-34 460/3	RTU-35 460/3	RTU-36 460/3	RTU-37 208/3	RTU-38 460/3	460/3
MCA MES	34.4 50.2	34.4 50.2	30.5 48.8 50	100.8 130.5 150	81.6 90	81.6	87.6 104.4 110	43.1 59.8	81.6	87.6 104.4 110	61 81.6 90	- 80 100	34.4 50.2 80	99.5 120.4	100.8 130.5 150	102.68 109.7 125	- 54 60	- 95 125	80 100	- 80 100	80 100	- 87 110	- 87 110	- 87 110	- 101 125	- 22	- 80 100	- 54 60	183.3 190 200	- 45 60	- 101 125	- 101 125	- 80 100	- 22	211.7 219 225	139.5 150 175	- 39 50	- 39 50	14
EXISTING INFORMATION EXISTING TAG	U-1 (NORTH)	RTU-2	RTU-3	RTU-4	RTU-35 (EAST)	RTU-1 (SOUTH)	RTU	RTU	
EXISTING MFR EXISTING MODEL A	ADDISON RC150L24A	ADDISON ARC150L24A	ADDISON ARC120J24A	ADDISON DC360P24B	ADDISON ARC240M24A	ADDISON ARC240M24A	ADDISON DC300N24B	ADDISON ARC200L24A	ADDISON ARC240M24A	ADDISON DC300N24B	ADDISON ARC240M24A	ADDISON DC300N24B	ADDISON ARC150L24A	ADDISON DC420N24B	ADDISON DC360P24B	ADDISON DC420P24B	ADDISON ARC240M24A	ADDISON DC420P24B	ADDISON DC300N24B	ADDISON DC300M24B	ADDISON DC300N24B	ADDISON DC360N24B	ADDISON DC360N24B	ADDISON DC360N24B	ADDISON DC420P24B	ADDISON ARC084J24A	ADDISON DC300M24B	ADDISON ARC240L24A	YORK YPAL070MVC	ADDISON ARC200L24A	ADDISON DC420P24B	ADDISON DC420P24B	ADDISON DC300M24B	ADDISON ARC096G24A	YORK YPAL075MCC	TRANE SFHFC554HD	CARRIER 50HCA07A2A5	CARRIER 48HCED20A2	
EXISTING SN 50 EXISTING CURB DIM WxL (IN)	0105701001 58"x120"	50105701002 58"x120"	50105702001 58"x120"	50105710001 74"x318"	50105703001 58"x144"	50105703002 58"x144"	50105711001 74"x318"	50105704001 58"x144"	50105722001 58"x144"	50105712001 74"x318"	50105705001 58"x150"	50105723001 74"x318"	50105701003 58"x120"	0501R5713001 74"x318"	50105714001 74"x318"	50105721001 74"x396"	50105705002 58"x144"	50105721002 74"x396"	50105716001 74"x318"	50105717001 74"x318"	50105718001 74"x318"	50105719001 74"x354"	50105719002 74"x354"	50105719003 74"x354"	50105721003 74"x354"	50105706001 40"x120"	50105720001 74"x354"	50105707001 58"x146"	RHPM012287 88"x450"	50105708001 58"x146"	50105721004 74"x396"	50105715001 99"x396"	50105720002 74"x354"	50105709001 58"x98"	RGPM011942 92"x454"	J94G72106 -	1210G10462 54"x84"	4133P20809 69"x130"	
EXISTING VOLTAGE/PHASE EXISTING MCA	460/3 47.6	460/3		460/3 97	460/3		460/3 82.8	460/3 65.5		460/3 83.1				460/3 102.8	460/3 96.8	460/3 129	460/3 75.3	460/3 129	460/3 82.8		460/3 83.5					460/3	460/3 76.8	460/3 69.3	460/3 180		460/3 129	460/3 76.8			460/3 151	460/3 154	208-230/3 34.3	460/3 38.2	
EXISTING MFS	50 RTU-1	RTU-2	RTU-3	110 RTU-4	90 RTU-5	RTU-6	100 RTU-7	80 RTU-8	RTU-9	100 RTU-10	RTU-11	RTU-12	RTU-13	110 RTU-14	110 RTU-15	150 RTU-16	90 RTU-17	150 RTU-18	100 RTU-19	RTU-20	100 RTU-21	RTU-22	RTU-23	RTU-24	RTU-25	30 RTU-26	90 RTU-27	80 RTU-28	200 RTU-29	RTU-30	150 RTU-31	90 RTU-32	RTU-33	RTU-34	175 RTU-35	175 RTU-36	50 RTU-37	50 RTU-38	
	2, 3, 4, 5, 6, 7, 1 9, 10, 11, 12, 13		7, 1, 2, 3, 4, 5, 6, 7 2, 8, 9, 10, 11, 12 13		7, 1, 2, 3, 4, 5, 6, 7 8, 9, 10, 11, 12 13	7, 1, 2, 3, 4, 5, 6, 7 , 8, 9, 10, 11, 12, 13		7, 1, 2, 3, 4, 5, 6, 7 , 8, 9, 10, 11, 12 13		7, 1, 2, 3, 4, 5, 6, 7 2, 8, 9, 10, 11, 12, 13		7, 1, 2, 3, 4, 5, 6, 7 , 8, 9, 10, 11, 12, 13	, 1, 2, 3, 4, 5, 6, 7, <sup>-</sup> 8, 9, 10, 11, 12, 13	1, 2, 3, 4, 5, 6, 7, 8, 9, 10, 11, 12, 13, 15, 16		1, 2, 3, 4, 5, 6, 7 8, 9, 10, 11, 12, 13, 15, 16		1, 2, 3, 4, 5, 6, 7 8, 9, 10, 11, 12 13, 15, 16	7, 1, 2, 3, 4, 5, 6, 7 8, 9, 10, 11, 12, 13		, 1, 2, 3, 4, 5, 6, 7 8, 9, 10, 11, 12, 13		, 8, 9, 10, 11, 12		, , , , , , ,	7, 1, 2, 3, 4, 5, 6, 7, , 8, 9, 10, 11, 12, 13, 15, 16				1, 2, 3, 4, 5, 6, 7, 8, 9, 10, 11, 12, 13		1, 2, 3, 4, 5, 6, 7 8, 9, 10, 11, 12, 13, 15, 16	8, 9, 10, 11, 12,					1, 2, 3, 4, 5, 6, 7, 1, 2 8, 9, 10, 11, 12, 9, 1 13, 15, 16	
REMARKS: 1. PROVIDE AND INSTALL WITH MOTO 2. PROVIDE AND INSTALL WITH PHAS 3. PROVIDE AND INSTALL WITH PHAS 4. PROVIDE AND INSTALL WITH OUTS 5. PROVIDE AND INSTALL WITH FACT 6. PROVIDE AND INSTALL WITH FACT 7. PROVIDE AND INSTALL WITH INSU 9. PROVIDE AND INSTALL WITH INSU 9. PROVIDE AND INSTALL WITH POWE 10. PROVIDE WITH TERMINAL STRIP F 11. PROVIDE WITH BACNET CONTROI 12. PROVIDE AND INSTALL WITH FACT 13. PROVIDE AND INSTALL WITH FACT 14. PROVIDE AND INSTALL WITH 24" T 15. PROVIDE AND INSTALL WITH STAI 16. PROVIDE AND INSTALL WITH STAI	SE LOSS PROT GLE POINT ELE SIDE INTAKE H TORY INSTALLE GED ACCESS D VERED HAIL GI JLATED METAL ERED EXHAUS FOR CONTROL DLLER FOR INTE TORY MOUNTE ULATED STAINI TALL INSULATE DULATING HO	ECTION. CTRICAL POW OOD WITH INI ED ELECTRICA OORS. JARDS ON ALL CURB ADAPT T. BY TCC. EGRATION OF ED CONVENIE LESS STEEL D ED METAL ROO T GAS REHEA	VER CONNECTION LET SCREEN. AL DISCONNECT L CONDENSER C ER. DATA INTO BMS. NCE RECEPTACL DRAIN PAN. DF CURB. T.	I. SWITCH. DILS. SHIP WITH		ON PANELS TO P	PREVENT DAMAG	e During Shipf	Ping, Rigging, I	INSTALLATION.																												Ĺ	
1. EXISTING EQUIPMENT INFORMATIN	ION SHOWN FO	OR REFERENC	E ONLY. CONTR	ACTOR SHALL VE	ERIFY ALL EXISTI	ING INFORMATIO	N AND CONDITIC	DNS.																															

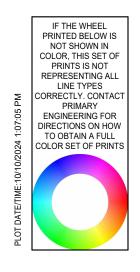

							BOI	LER \$	SCHE	EDU	LE								
TAG	MFR.	MODEL	HEATING INPUT (MBH)	HEATING OUTPUT (MBH)	THERMAL EFF (%)	FUEL	BURNER TURNDOWN	T&P RELIEF PRESS	FUEL PRESS. (IN W.C.)	GAS CONN (IN)	WATER CONN (IN)	FLUE OUTLET (IN)	FLUE MATL.	DESIGN FLOW (GPM)	MIN FLOW (GPM)	WATER PD (FT)	TEMP RISE (DEG F)	ELEC (V/PH)	FL
B-1	WEIL-MCLAIN	SVF 2000 - EXISTING	1999	1923	96.2%	NAT. GAS	10:1	50	3.5 - 14	2	3.0	8	PP/CPVC	190	49	4.4	20	120/1	23.
B-2	WEIL-MCLAIN	SVF 2000 - EXISTING	1999	1923	96.2%	NAT. GAS	10:1	50	3.5 - 14	2	3.0	8	PP/CPVC	190	49	4.4	20	120/1	23.
B-3	WEIL-MCLAIN	SVF 2000	1999	1923	96.2%	NAT. GAS	10:1	50	3.5 - 14	2	3.0	8	PP/CPVC	190	49	4.4	20	120/1	23.
B-4	WEIL-MCLAIN	SVF 2000	1999	1923	96.2%	NAT. GAS	10:1	50	3.5 - 14	2	3.0	8	PP/CPVC	190	49	4.4	20	120/1	23.
B-5	WEIL-MCLAIN	SVF 2000	1999	1923	96.2%	NAT. GAS	10:1	50	3.5 - 14	2	3.0	8	PP/CPVC	190	49	4.4	20	120/1	23.
B-6	WEIL-MCLAIN	SVF 2000	1999	1923	96.2%	NAT. GAS	10:1	50	3.5 - 14	2	3.0	8	PP/CPVC	190	49	4.4	20	120/1	23.

PROVIDE AND INSTALL WITH LOW WATER CUT-OFF.
 PROVIDE WITH CONDENSATE NEUTRALIZATION TANK WITH LIMESTONE.
 POLICES SHALL BE PROVIDED WITH INTEGRAL SEQUENCES TO CONNECT.


 BOILERS SHALL BE PROVIDED WITH INTEGRAL SEQUENCER TO CONNECT ALL BOILERS INTO A COMMON TEAM. PROVIDE ALL ASSOCIATED CONTROLLERS, WIRING, PROGRAMMING, SETUP, ETC. FOR A FULLY FUNCITONAL SYSTEM IN EVERY RESPECT.
 BOILER MFR SHALL VERIFY ALL FLUE/INTAKE SIZING AND ROUTING.

5. EXISTING EQUIPMENT SHOWN FOR REFERENCE ONLY. INCLUDE FACTORY RE-STARTUP OF THESE BOILERS WITH NEW BOILERS. UPDATE FIRMWARE AS REQURIED FOR ENTIRE TEAM. 6. BOILER MFR SHALL PROVIDE WITH VARIABLE SPEED PRIMARY PUMP AND CONTROL PUMP FROM BOILER. REFER TO PUMP SCHEDULE FOR ADDITIONAL INFORMATION.


				HUIV	VATER	CABIN					ULE				
TAG	MFR.	MODEL	LOCATION	TYPE	CAPACITY (MBH)	AIRFLOW (CFM)	MOTOR (HP)	AMPS	RPM	EWT/LWT (DEG F)	FLOW (GPM)	ROWS	FINS/FT	CONTROL VALVE	ELEC (V/PH)
CUH-F1	STERLING	Fl-1110-04	UNIT F 1ST FLOOR	FI	27.8	355	1/10	1.4	875	135 / 99	2	2	144	3-WAY	120/1
CUH-F2	STERLING	FI-1110-04	UNIT F 1ST FLOOR	FI	27.8	355	1/10	1.4	875	135 / 99	2	2	144	3-WAY	120/1
CUH-F3	STERLING	FI-1110-04	UNIT F 1ST FLOOR	FI	27.8	355	1/10	1.4	875	135 / 99	2	2	144	3-WAY	120/1
CUH-F4	STERLING	FI-1110-04	UNIT F 1ST FLOOR	FI	27.8	355	1/10	1.4	875	135 / 99	2	2	144	3-WAY	120/1
1 PROVIDE		ITH FACTORY WIRE	D ELECTRICAL DISCONNE	ст											
			ERS. AND 16 GA CONTSTR		VIDE 1 KEY FOR	EACH UNIT.									
		DIL AND 1" MERV 11	,												





PRIMARY JOB # 24584

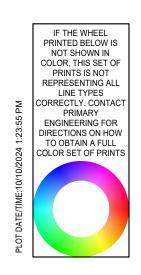


Sunman Dearborn Schools East Central High School		OU		JT (	(0)							TAL			<b>IS</b> н/ рит	٩R	DW	ARE	E C)		ALC										S ALC		E	ЗN
	or	Floating Point Control		er			Pressure Switch	Flow Switch	Space Occupancy Sensor			Contact Closure		Auxiliary Contact	KW Meter Contact	Temperature	lative Humidity	Set Point Adjustment	(maa)		lles)		Flow Measurement (apm/cfm)	Electrical Current Flow (amps)	Position Feedback	Trending	nt Alarm		ification		ierature)		Scheduled Un/Un	Optimum start/stop
Point Description Outside Air	ပိ	Flo	Sol	Ľ	Ше	4-2	Pre	Ê	Š	10	ð	ပိ	Å	Ā	ž	Ter		Sel S	Ca	Ö	Lio	Pre	Ê	Ше	В Б С	. L	σ Ш	Le .	Ma	Ξ	ĹŎ		<u>5</u> 6	3
Rooftop Unit VAV w/ relief (RTU-1 to 41) Supply fan(s) Supply air duct main static pressure OA damper																																		
Cooling stages/modulation (2) Heating stages/modulation (2) Dehum mode / hot gas reheat																																		-
Return air Mixed air Supply air Relief fan(s)																																		-
Zone differential pressure Space temperature (SZ units only)																																		_ _ _
Boiler Plant Boiler Plant enable/disable Hot water supply setpoint																																		
Boiler alarm (6) Boiler firing rate (6) Boiler status (6) Boiler leaving temp (6)																																+		
Boiler pump status (6) HWS loop to building HWR loop from building Hot water pump (HWP-1/2)																																		_
HWS loop DP sensor Boiler Room Carbon Monoxide VAV series fan-reheat boxes (VAV-1 to 15)																																		
Primary air damper Primary airflow (cfm) Supply fan Hot water reheat valve																																		
Discharge air Space Space occupancy																												-				+		
VAV shutoff-reheat boxes (all other vav's) Primary air damper Primary airflow (cfm) Hot water reheat valve																												-				-		
Ceiling radiation heat Discharge air Space Space occupancy																												-						
Fan Coil Units (HW/CHW) Fan start/stop Space																																		
Chilled water valve Hot water valve																																		
Toilet Exhaust Fans (EF-#) Fan start/stop Fan motor status																																		
Control damper General Exhaust Fans (EF-#) Local start/stop switch																																		
Fan motor status Control damper Domestic water heater plant																																		
Water heater status (2) Water heater circ pump status (2) Storage tank temp Thermo <u>sta</u> tic mixing valve disch																												-						
Lighting Control Relays Exterior photo sensor		$\checkmark$			$\mathbf{i}$															Y			$\mathbf{r}$				Y			$\mathbf{r}$			∎γ 	-
Exterior lighting contactors (10) Exterior lighting contactors (19) TORX time clock contactor (1) (Refer to electrical drawing for locations)																																		_
Greenhouse Hot water ciriculation pump Space temp sensor		$\overline{\ }$			ノ				X												_									人				
Data Room (MDF and IDF's) Space temperature (5)																												-				+	_	
Power Monitor Voltage of each phase (3) Amps of each phase (3) KW of each phase (3)																																		
Total Amps Total KW Cabinet Unit Heaters																																+		_
Space HW control valve Supply fan																																+	+	
Kitchen Freezer (1)																													F			+	-	

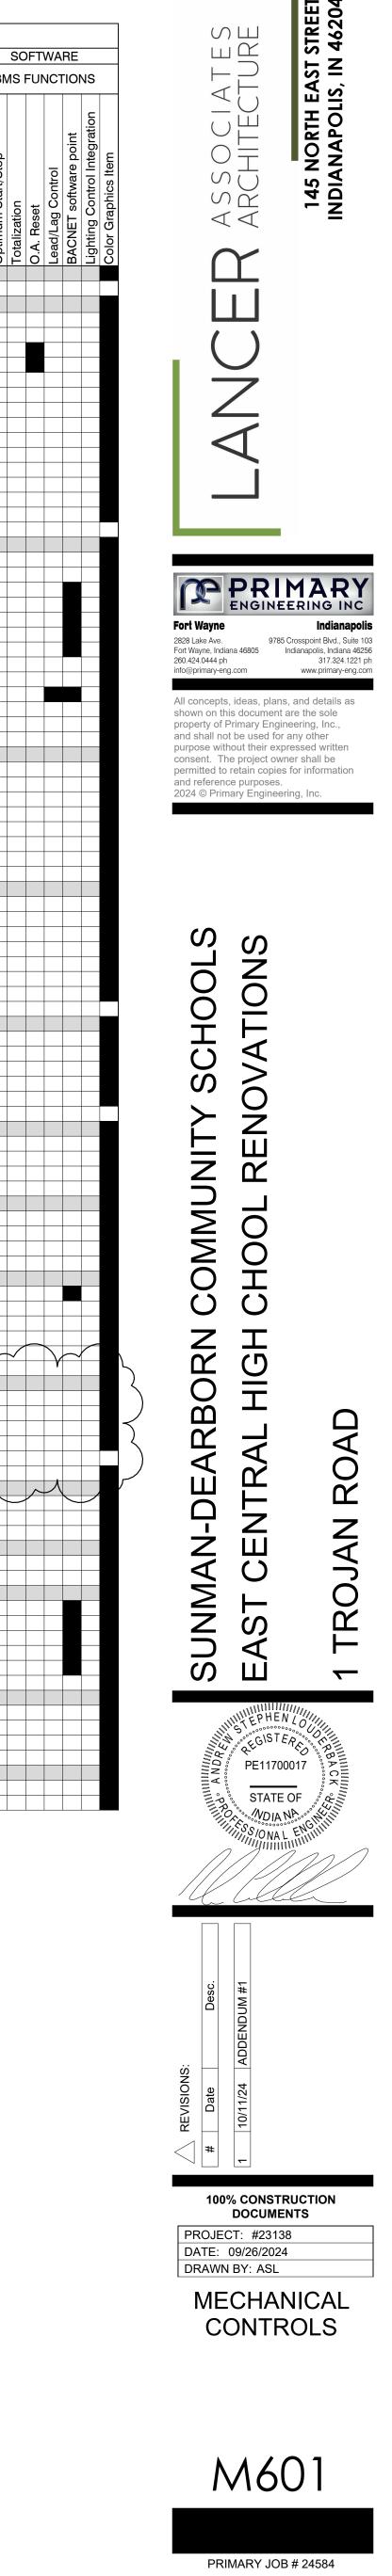

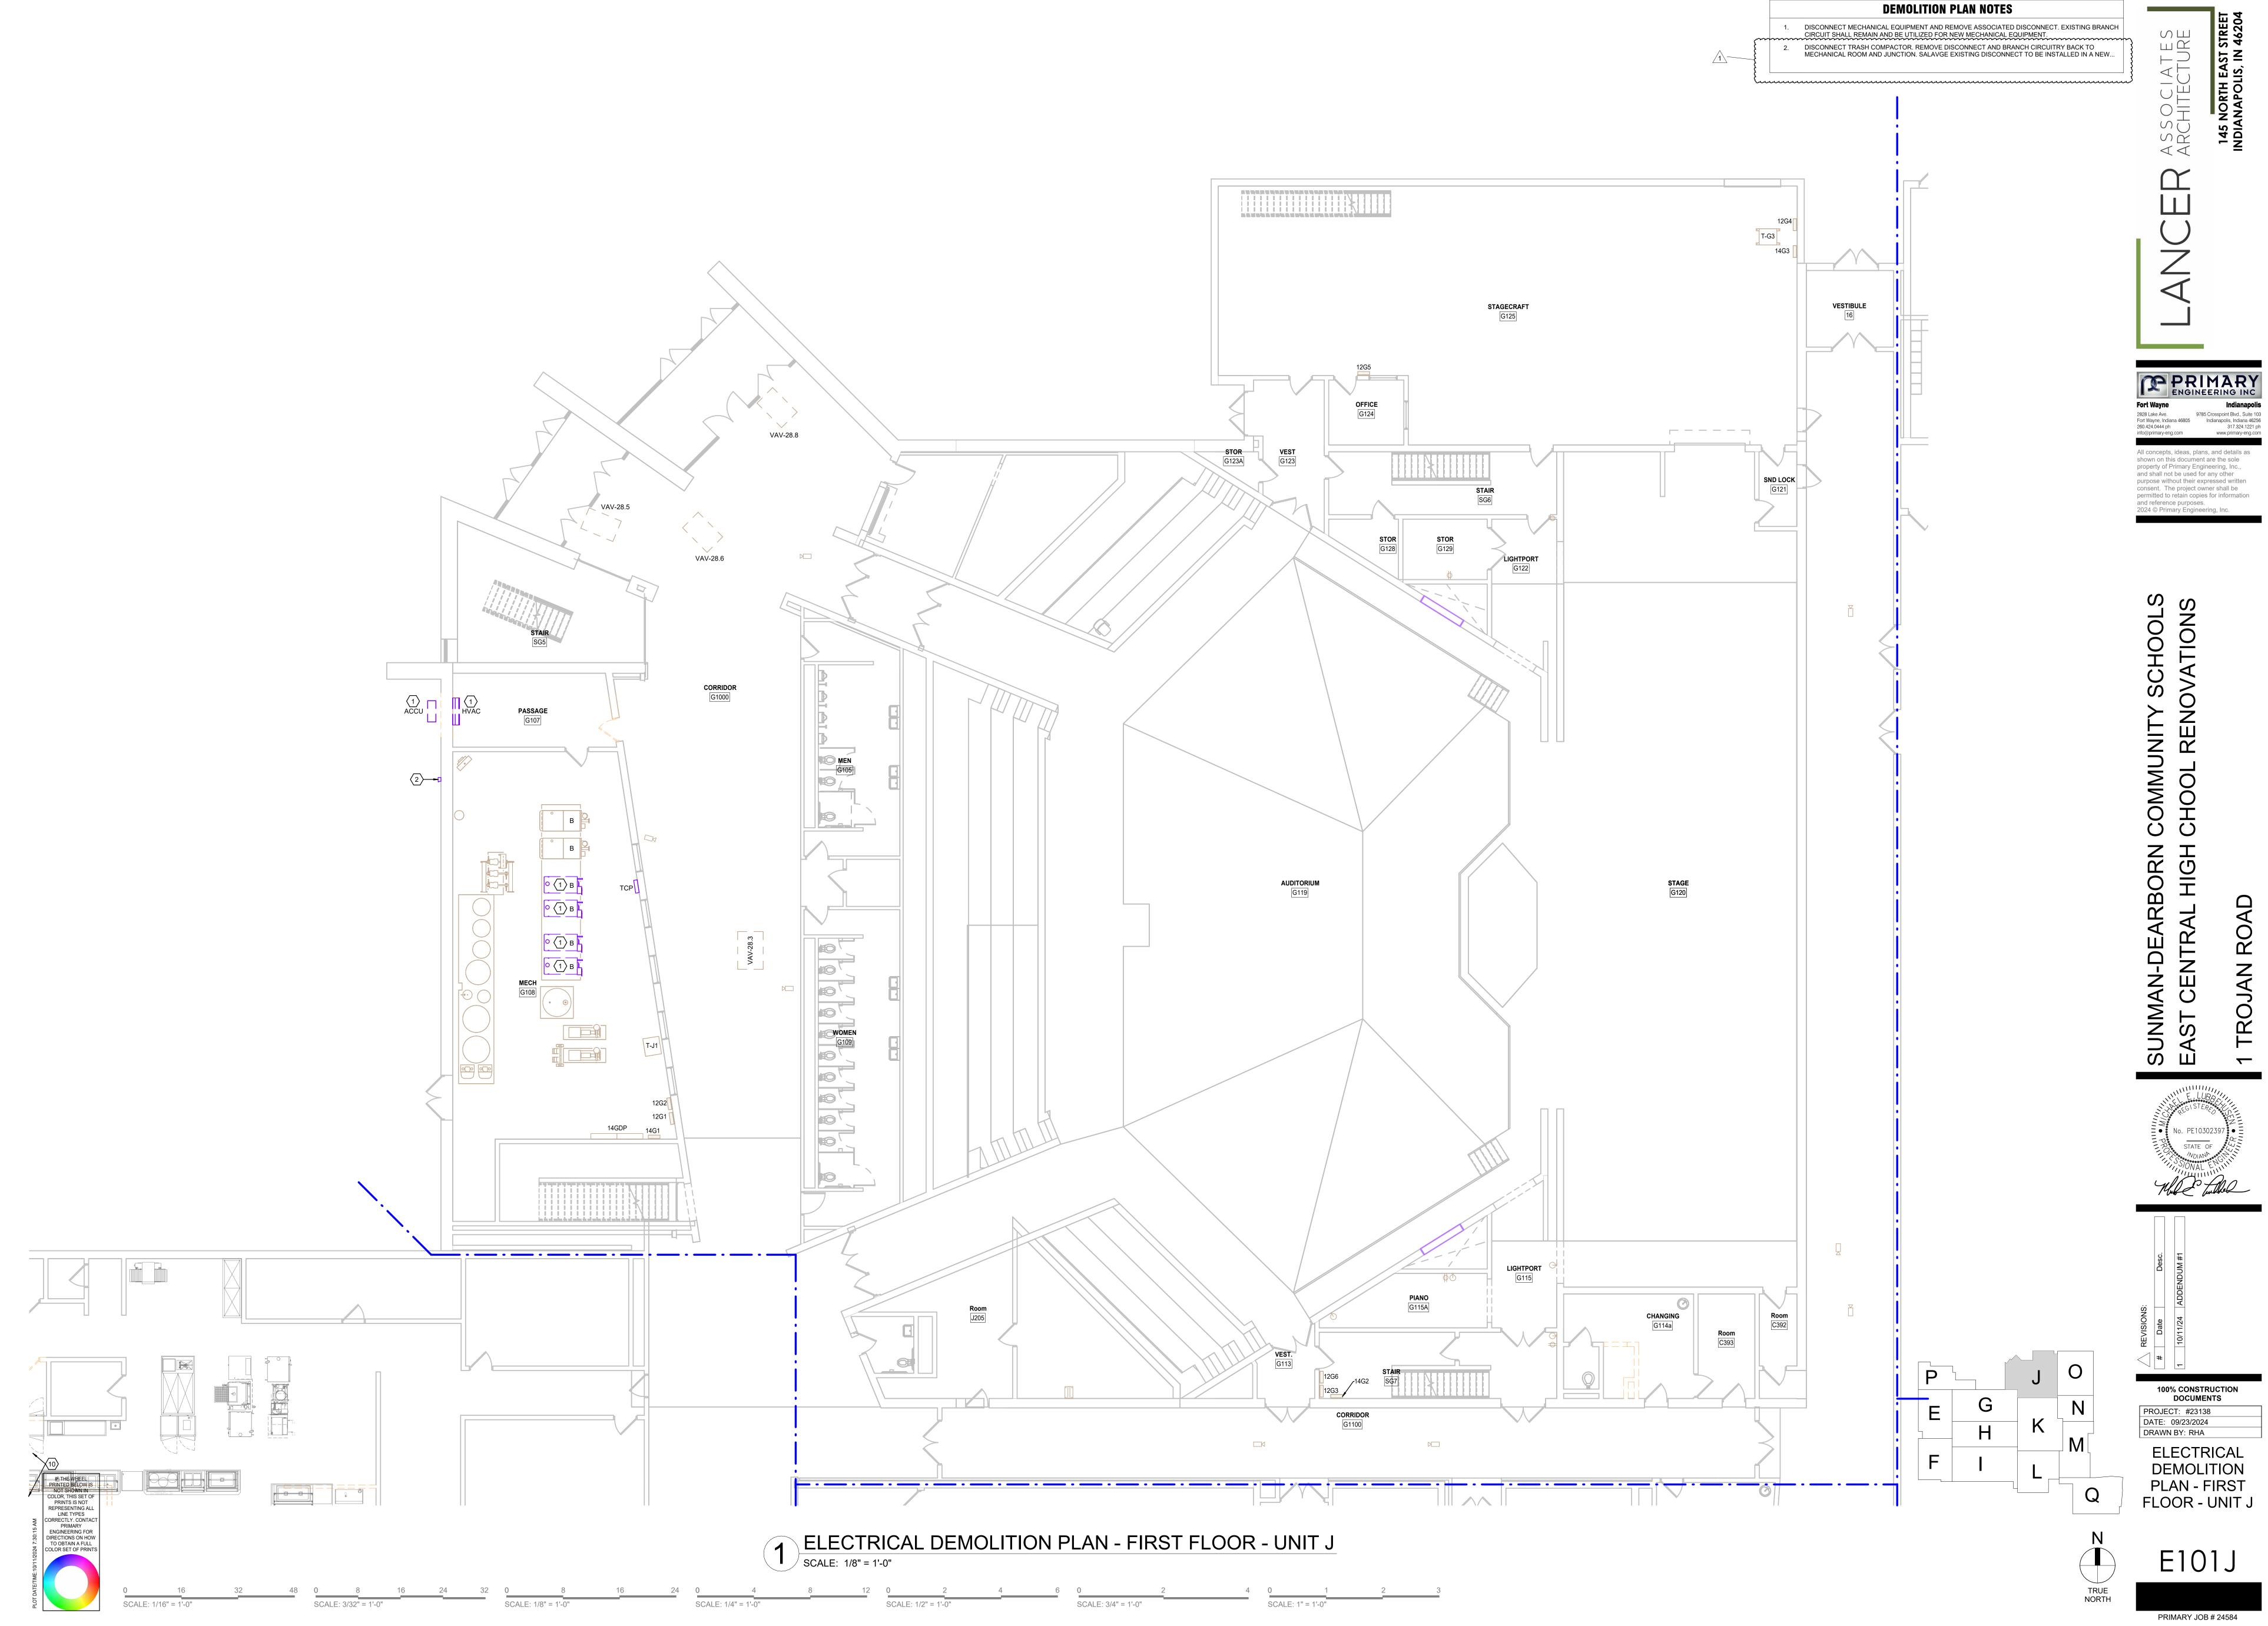

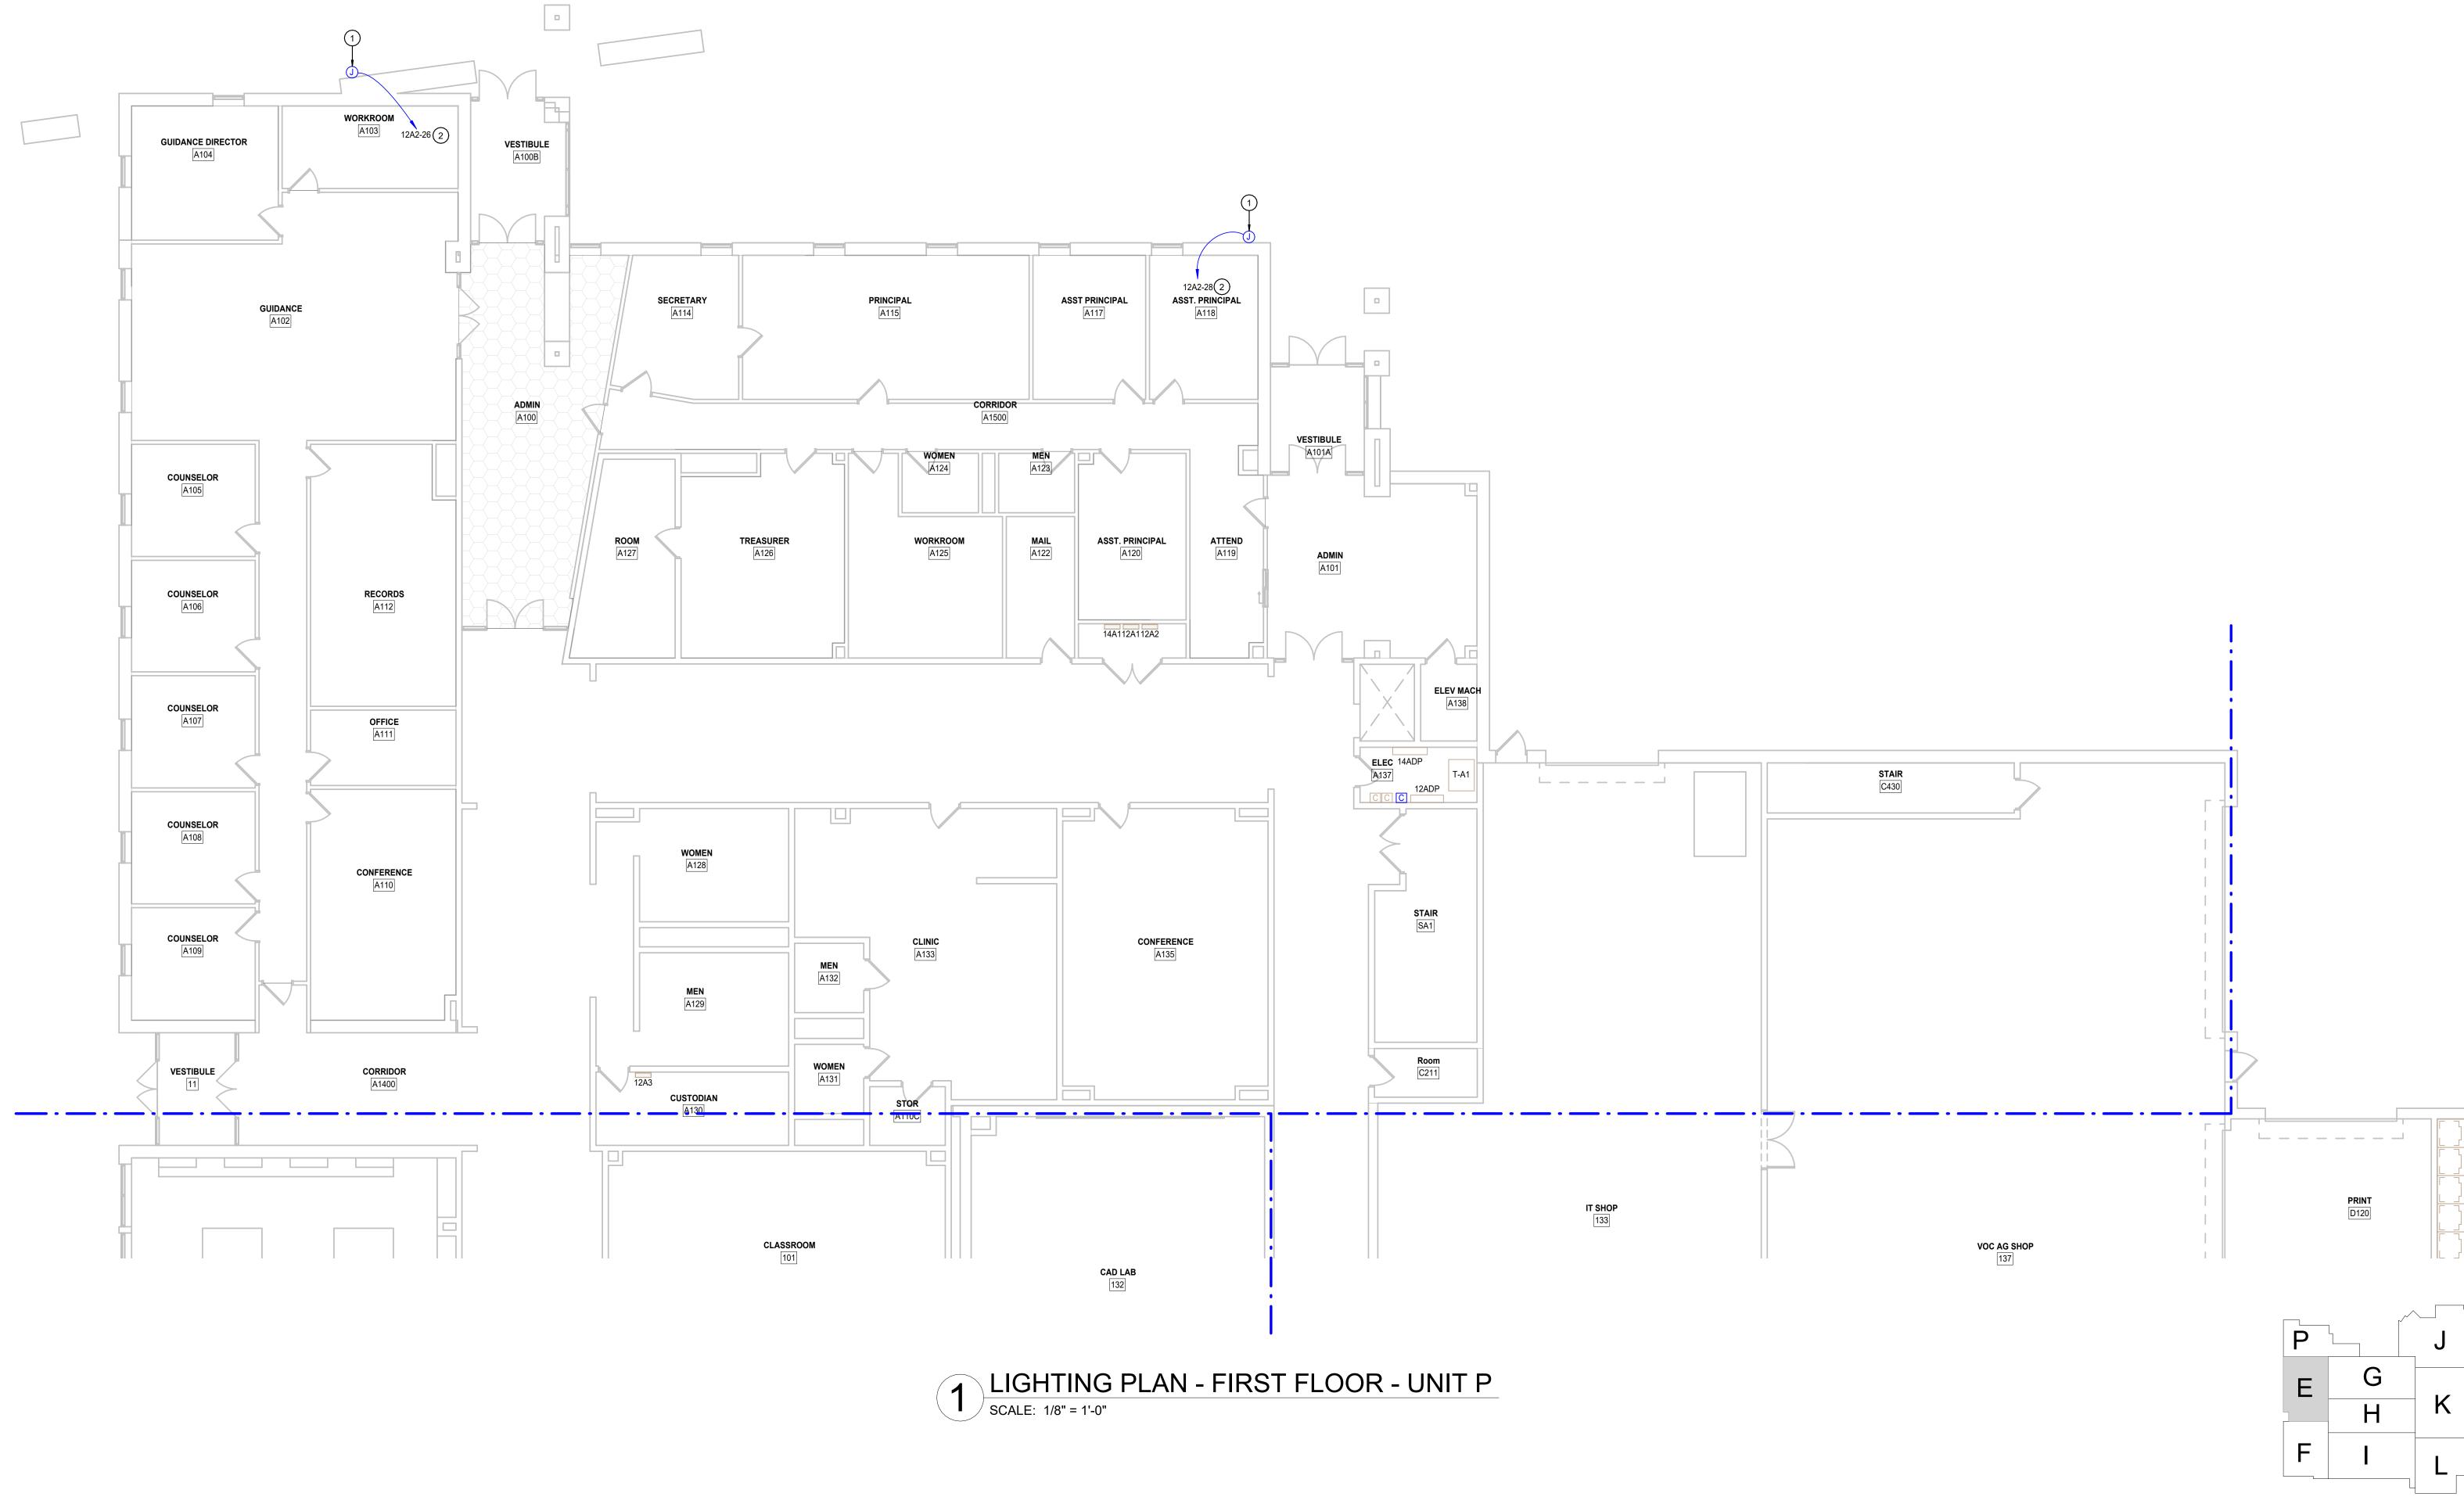

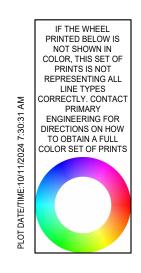

\_\_\_\_\_






 
 2828 Lake Ave.
 9785 Crosspoint Blvd., Suite 103

 Fort Wayne, Indiana 46805
 Indianapolis, Indiana 46256

 260.424.0444 ph
 317.324.1221 ph

 info@primary-eng.com
 www.primary-eng.com
 All concepts, ideas, plans, and details as shown on this document are the sole property of Primary Engineering, Inc., and shall not be used for any other purpose without their expressed written consent. The project owner shall be permitted to retain copies for information and reference purposes. 2024 © Primary Engineering, Inc.

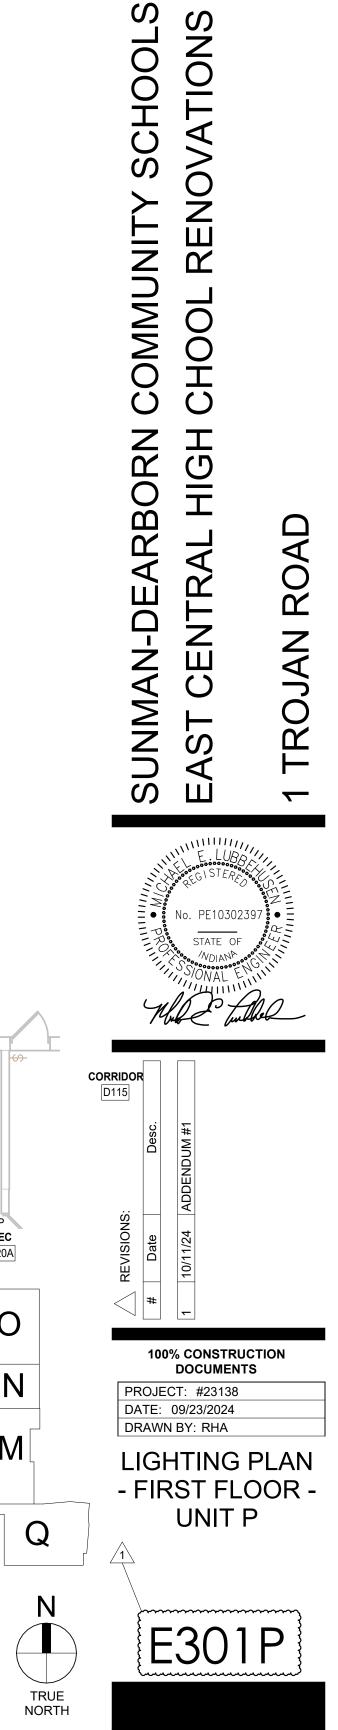



1MDP ELEC D120A


0


Ν

Μ

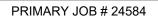

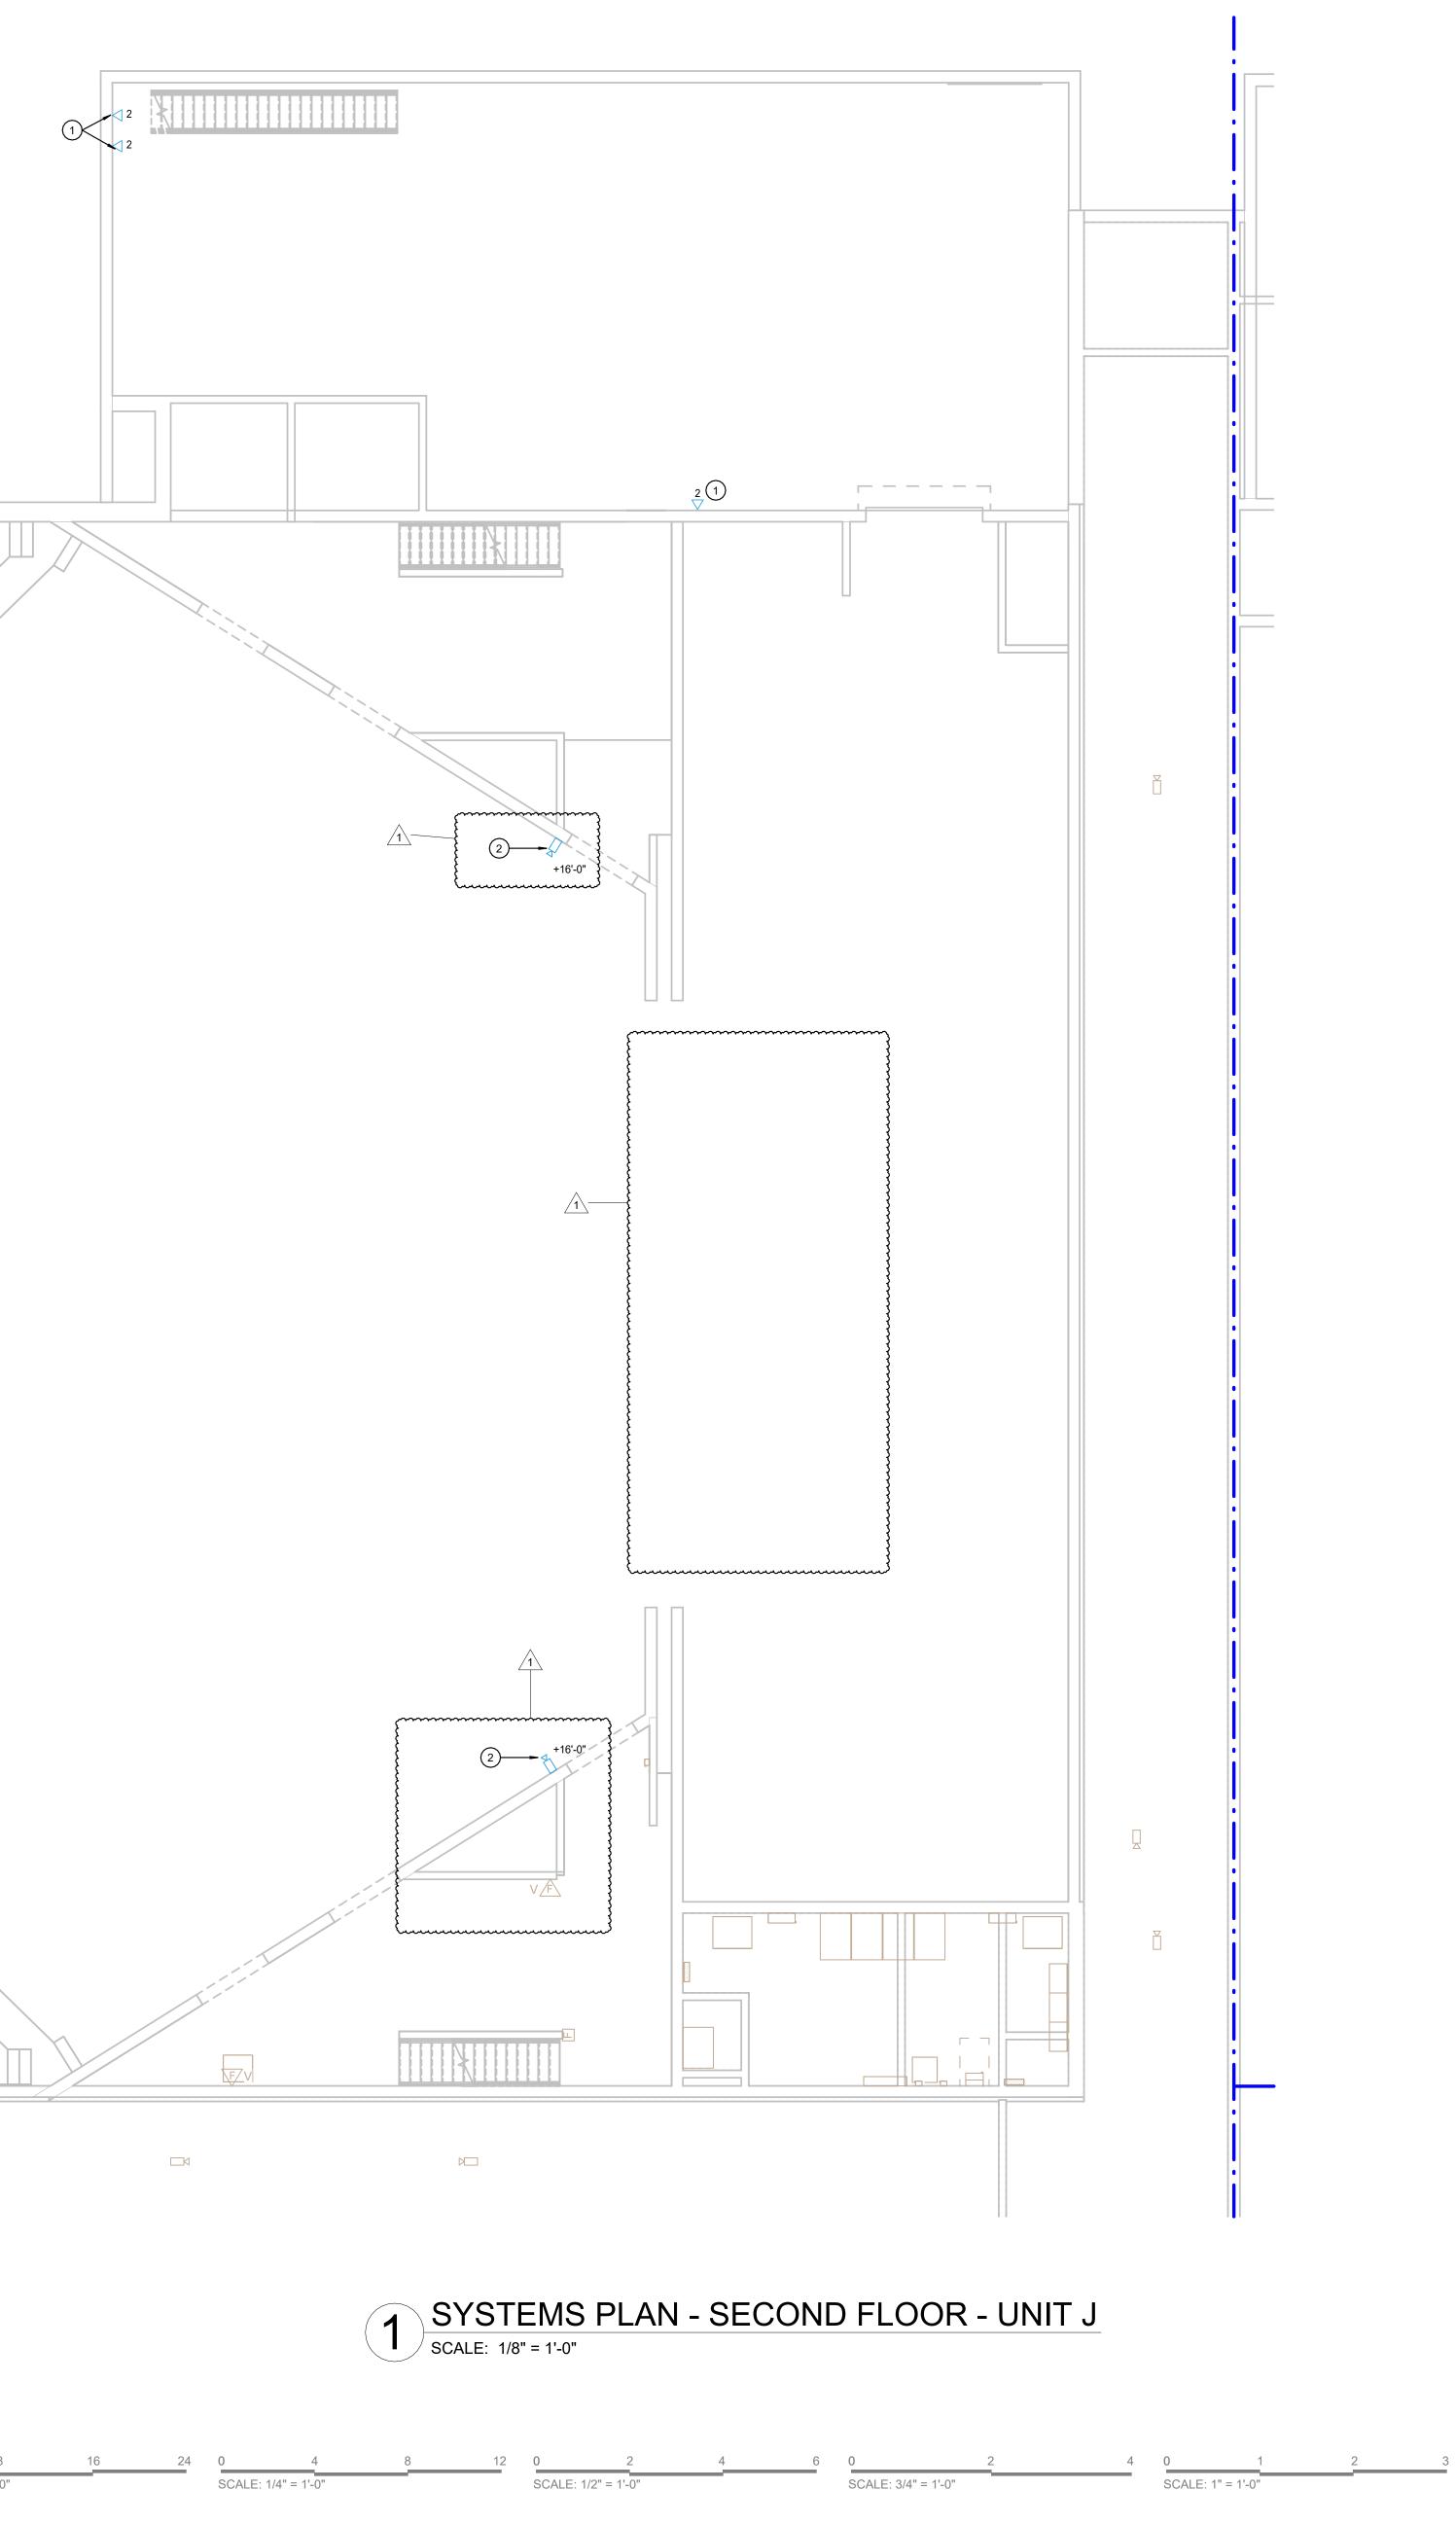

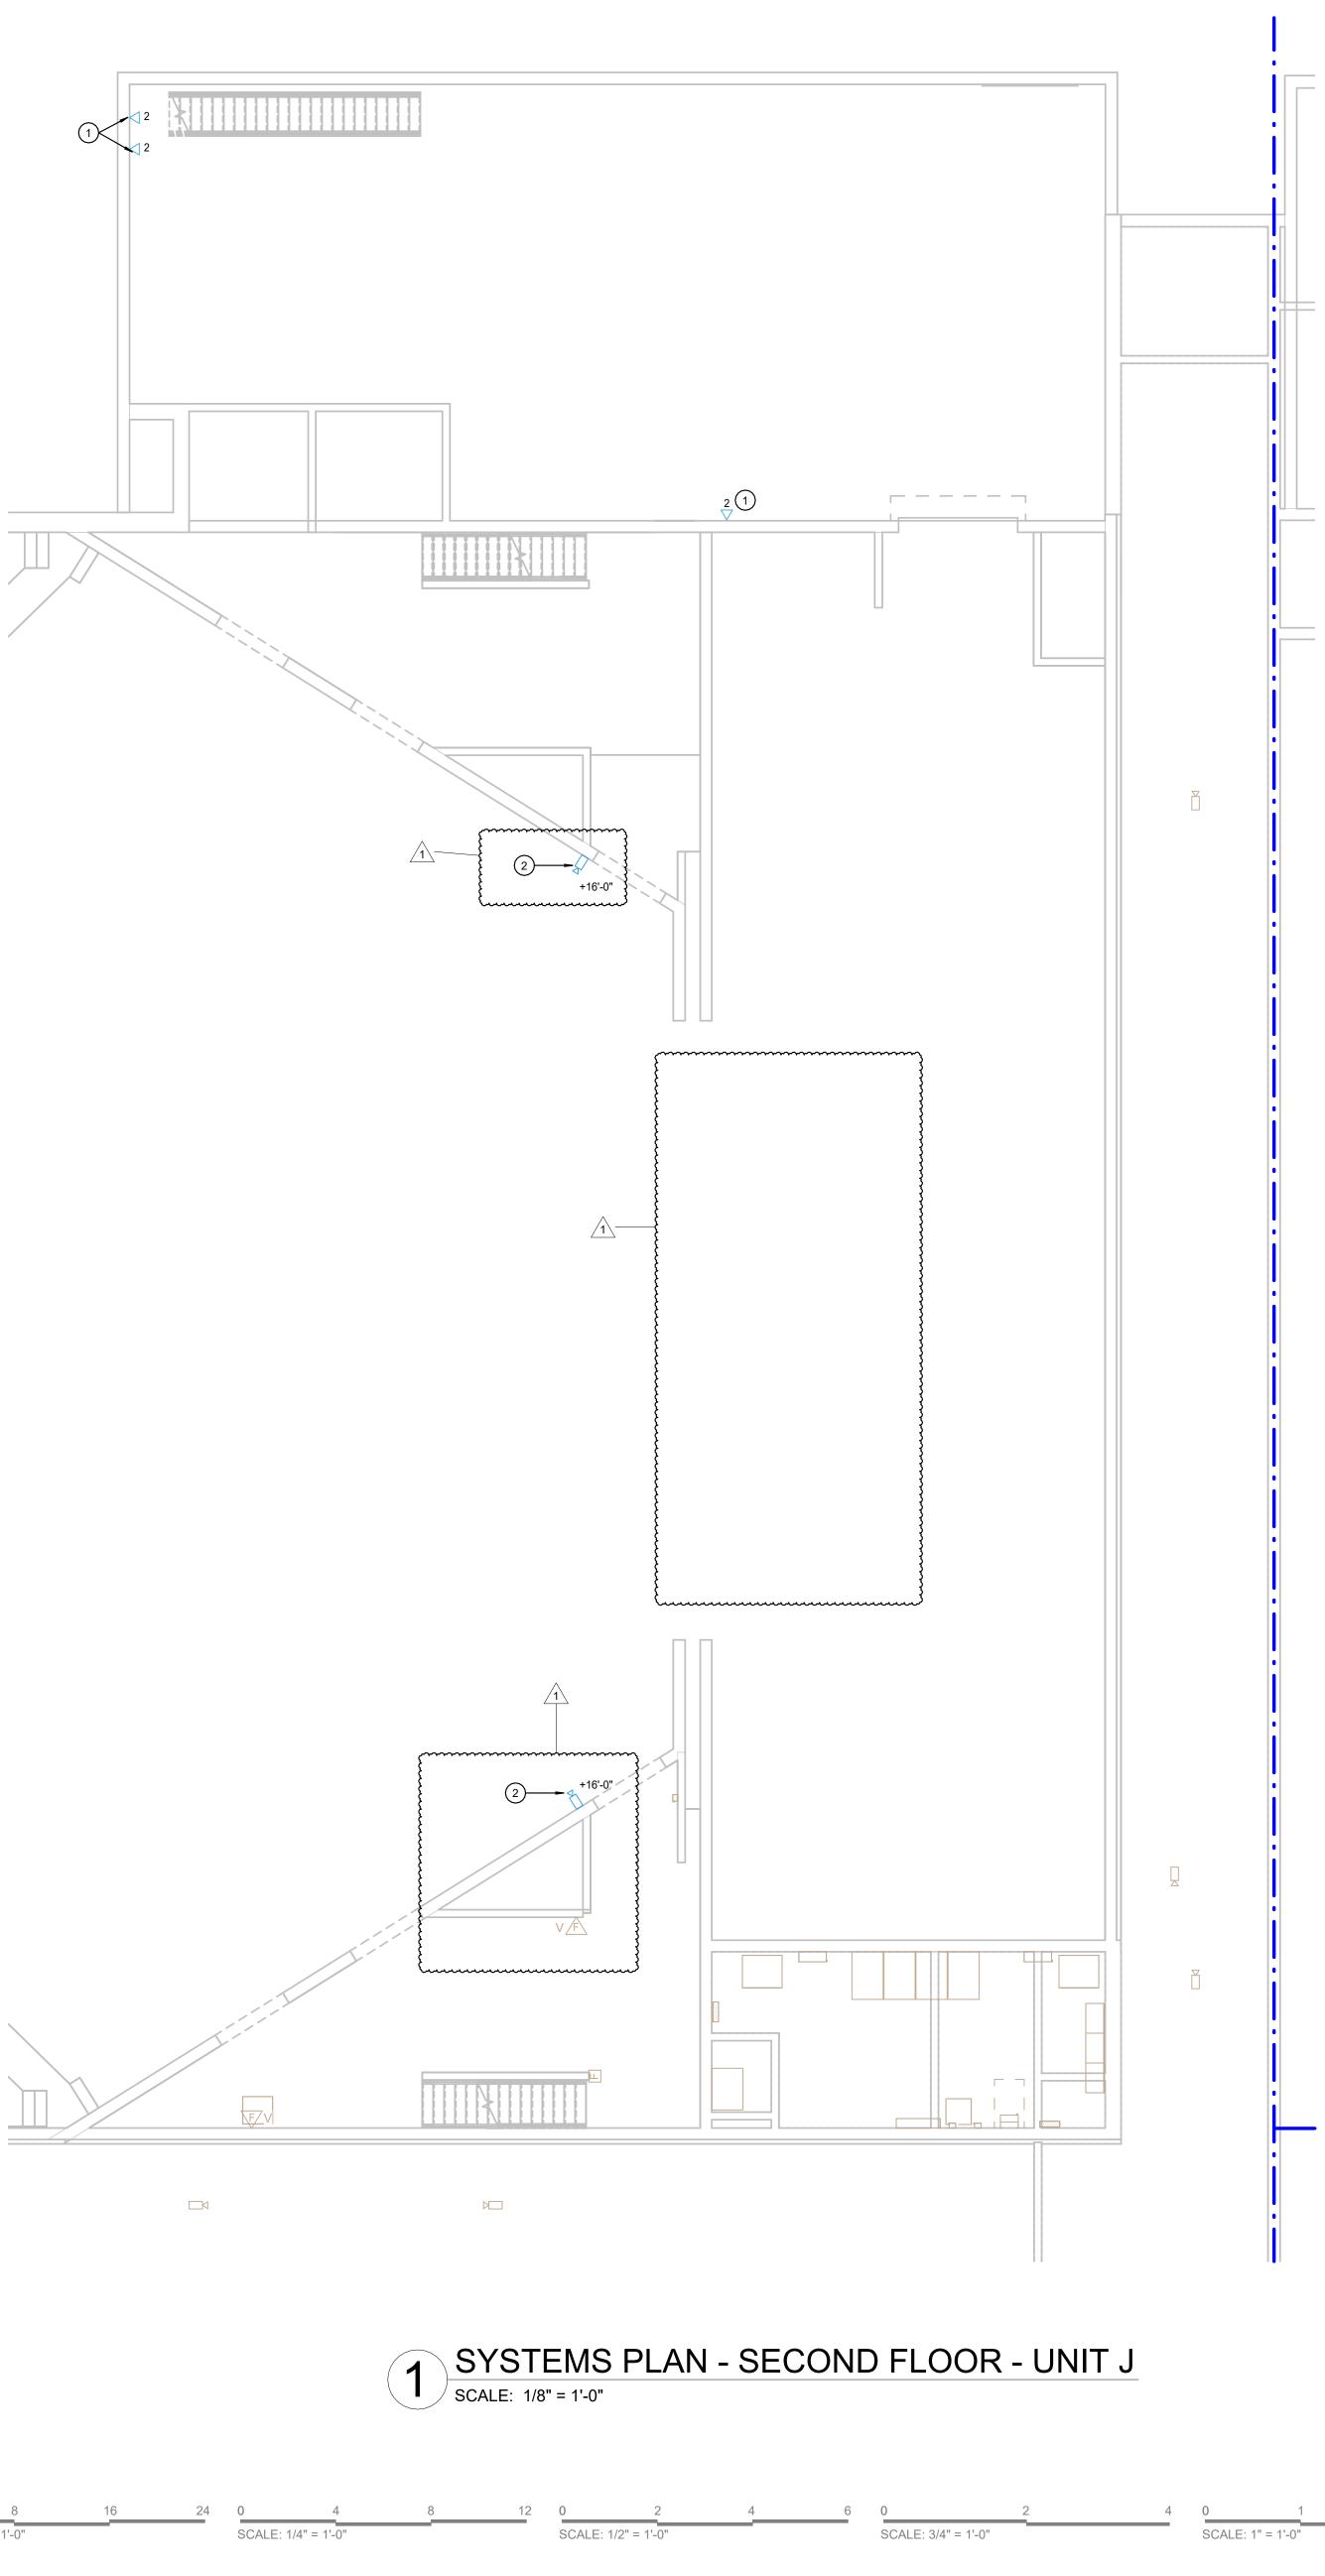

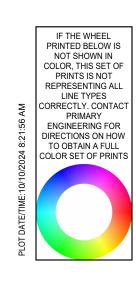





### **PLAN NOTES**

2.	CONTRACTOR SHALL INSTALL NEW CAMERA AND PATCH CORD TO CONNECT CAMERA SHALL BE PROVIDED BY OTHER, TYPICAL	то
1.	MOUNT DATA OUTLET ADJACENT TO TEMPERATURE CONTROL PANEL. MOUN FINISHED FLOOR.	IT O

ALL DATA ON THIS SHEET TO BE TERMINATED TO TRG

Ρ G Ε Κ Н F 

UTLET AT +44" ABOVE
DATA OUTLET.



Fort Wayne Indianapolis 
 2828 Lake Ave.
 9785 Crosspoint Blvd., Suite 103


 Fort Wayne, Indiana 46805
 Indianapolis, Indiana 46256


 260.424.0444 ph
 317.324.1221 ph


 info@primary-eng.com
 www.primary-eng.com

All concepts, ideas, plans, and details as shown on this document are the sole property of Primary Engineering, Inc., and shall not be used for any other purpose without their expressed written consent. The project owner shall be permitted to retain copies for information and reference purposes. 2024 © Primary Engineering, Inc.




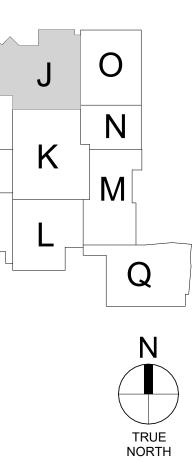


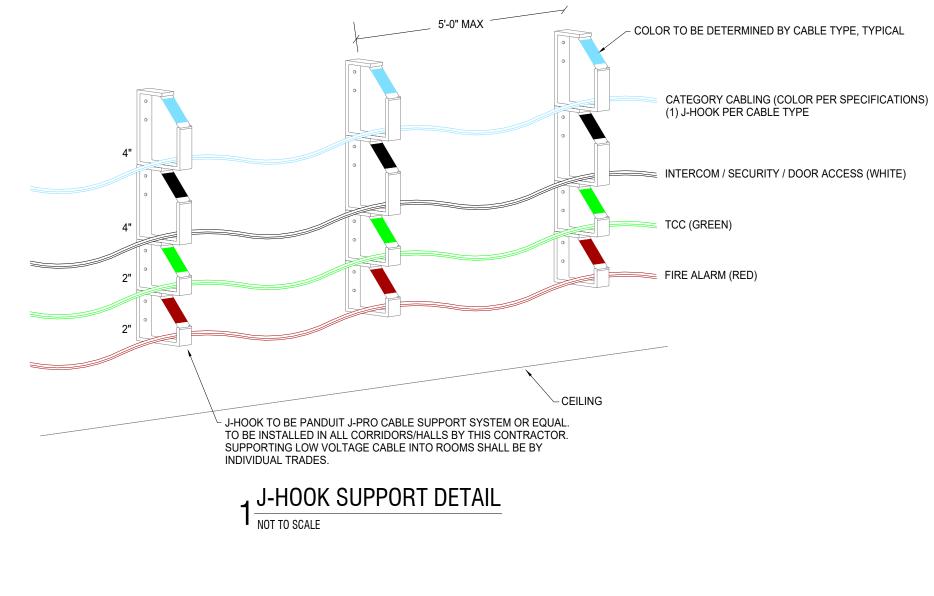


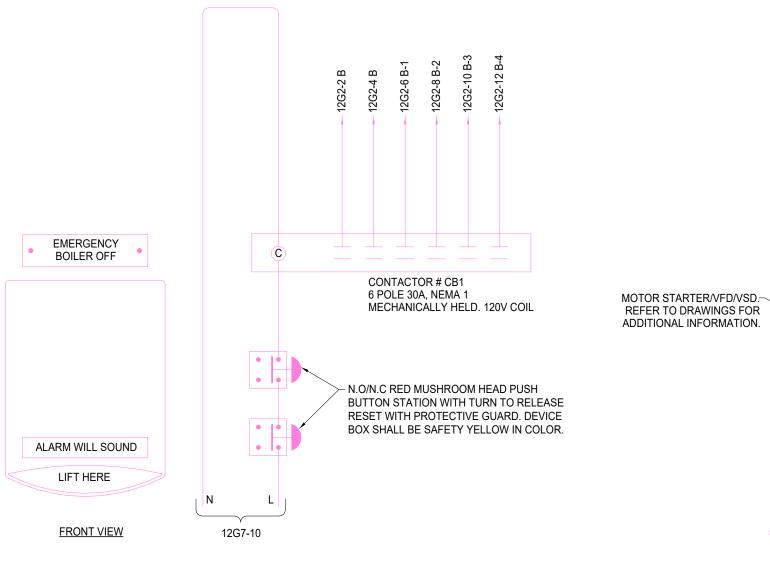




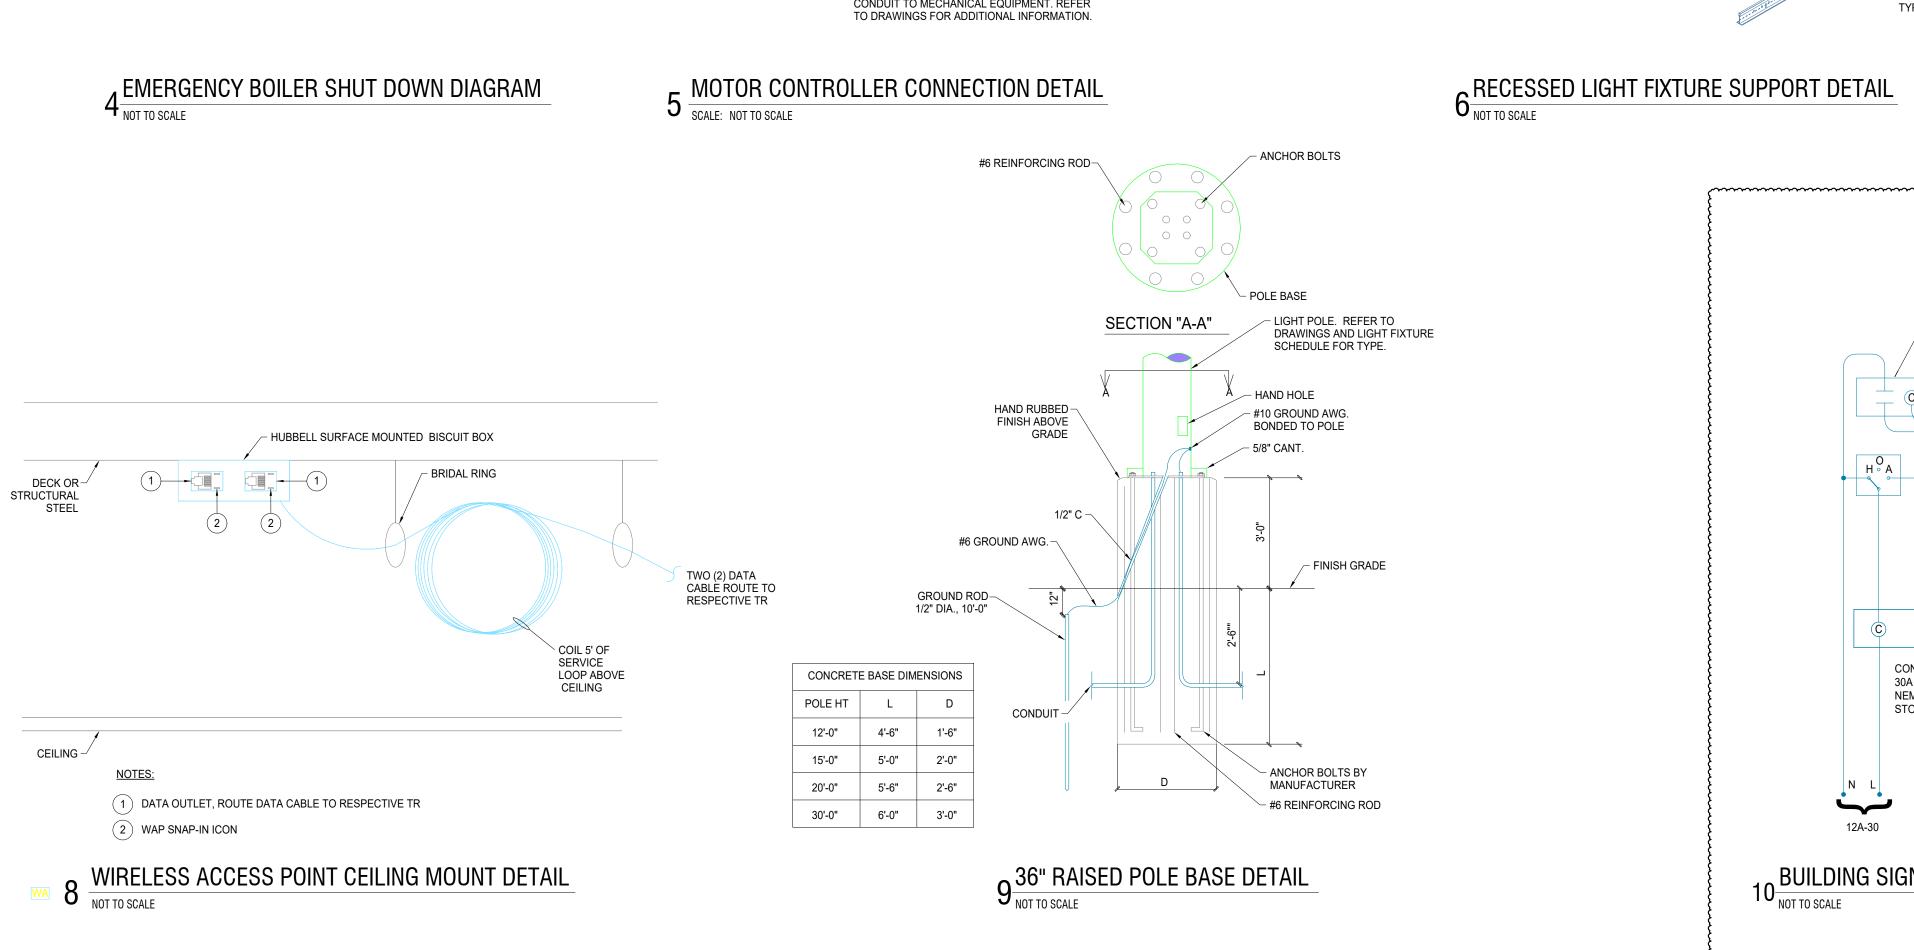

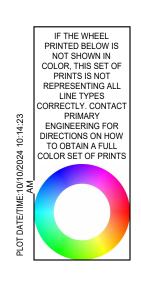


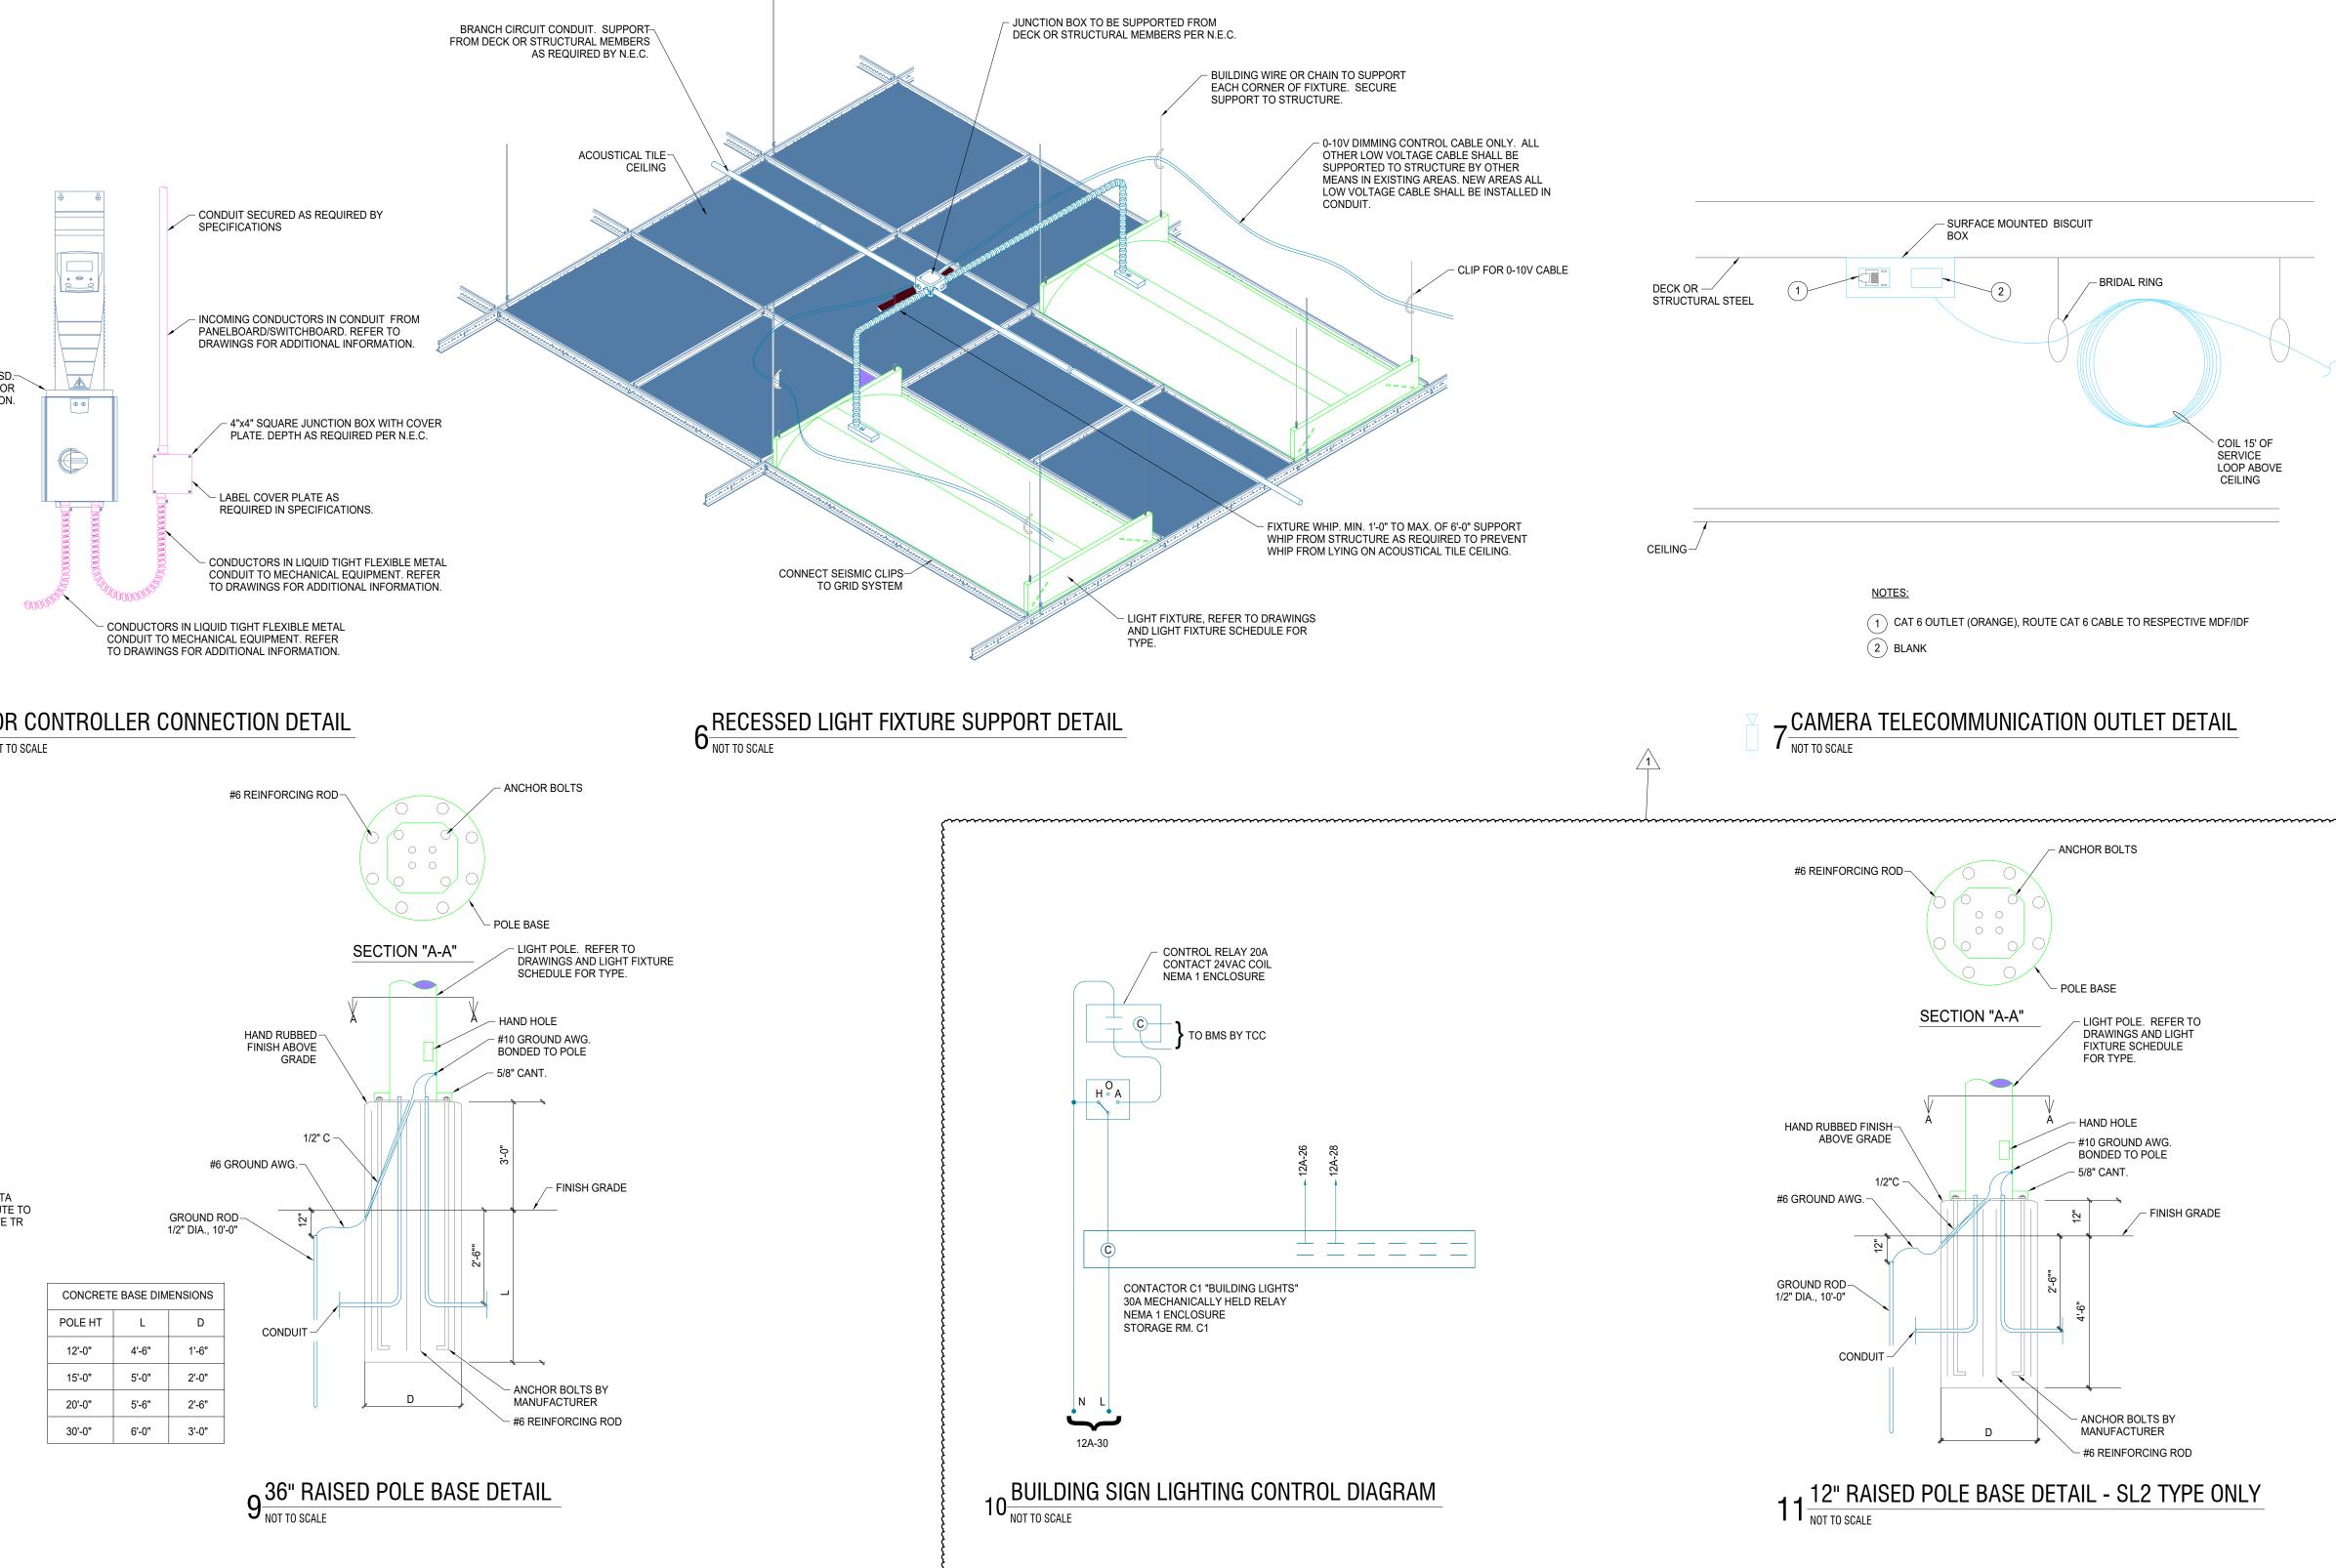

### 2 DATA WIRING CONNECTION NOT TO SCALE

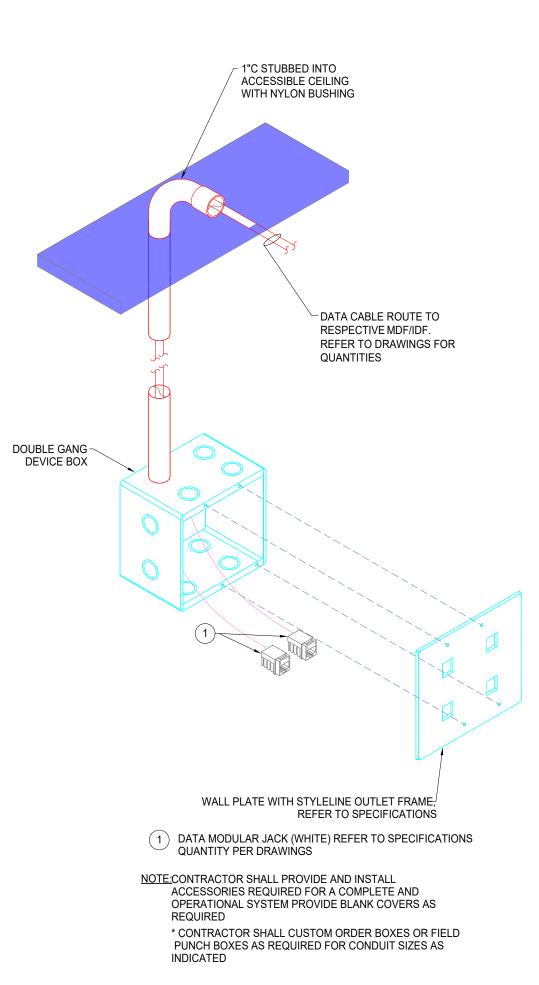

# COLOR TO BE DETERMINED BY CABLE TYPE, TYPICAL

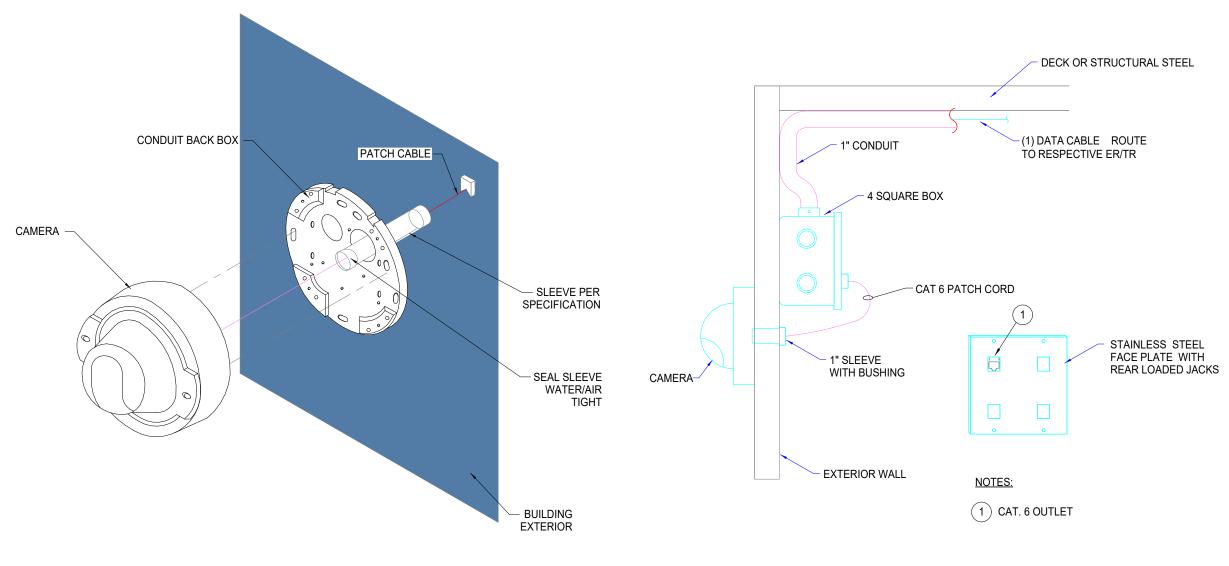

3 EXTERIOR CAMERA MOUNT DETAIL



 
 Fort Wayne, Indiana 46805
 Indianapolis, Indiana 46256

 260.424.0444 ph
 317.324.1221 ph
 info@primarv-eng.com www.primary-eng.com All concepts, ideas, plans, and details as shown on this document are the sole property of Primary Engineering, Inc., and shall not be used for any other purpose without their expressed written consent. The project owner shall be permitted to retain copies for information and reference purposes.


2024 © Primary Engineering, Inc.

Indianapoli


9785 Crosspoint Blvd., Suite 103


Fort Wayne

2828 Lake Ave.

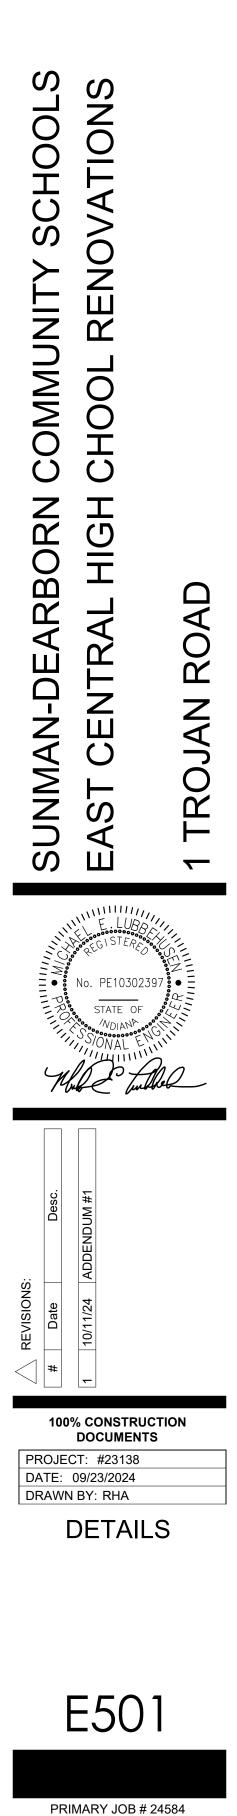

# DATA CABLE ROUTE TO RESPECTIVE MDF/IDF

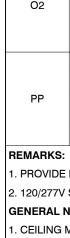

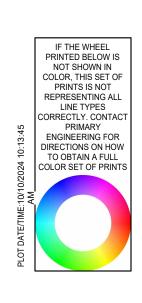

	LIC	GHTIN	IG SEN	SOR SCHEDULE	
TAG	MANUFACTURER'S CATALOG NUMBER	INPUT VOLTAGE	MOUNT	REMARKS	REMARKS
01	WATTSTOPPER #DT-300 SENSOR SWITCH #CM-PDT-9-R GREENGATE #OAC-DT-R HUBBELL #OMNI-DT-XXXX-RP	24V	CEILING	DUAL TECHNOLOGY CEILING SENSOR WITH A COMBINATION OF ULTRASONIC AND PASSIVE INFRARED. SENSOR TO BE EQUIPPED WITH SELF ADJUSTING TECHNOLOGY AND ISOLATED RELAY OUTPUTS. SENSOR SHALL OPERATE AS AUTOMATIC "ON" AND AUTOMATIC "OFF" WITH A 15 MINUTE TIME DELAY.	1
02	WATTSTOPPER #DW-100 SENSOR SWITCH #WSD-PDT GREENGATE #ONW-D-1001-MV HUBBELL #LH-MT-S-1 LUTRON #MS-B102	120/277V	WALL	DUAL TECHNOLOGY WALL SWITCH SENSOR WITH A COMBINATION OF ULTRASONIC AND PASSIVE INFRARED. SENSOR TO BE EQUIPPED WITH SELF ADJUSTING TECHNOLOGY. SENSOR SHALL OPERATE AS AUTOMATIC "ON" AND AUTOMATIC "OFF" WITH A 15 MINUTE TIME DELAY. COLOR TO BE SELECTED BY ARCHITECT.	
PP	WATTSTOPPER #BZ150 SENSOR SWITCH #PP20 GREENGATE #SP20-MV HUBBELL	120/277V	4 SQUARE BOX ABOVE ACCESSIBLE CEILING	POWER PACK TO OPERATE LOW VOLTAGE (24VDC) OCCUPANCY SENSORS. RELAY TO BE 20A RATED.	

1. PROVIDE POWER PACKS AS REQUIRED TO OPERATE LIGHTING AS SHOWN ON FLOOR PLANS


2. 120/277V SENSOR IN LIEU OF POWER PACK IS ACCEPTABLE. GENERAL NOTES:

1. CEILING MOUNTED OCCUPANCY SENSORS SHALL BE INSTALLED 6'-0" AWAY FROM ANY SUPPLY DIFFUSERS, COORDINATE WITH MECHANICAL CONTRACTOR.

MARKS					MIN.			
1	TAG	MANUFACTURER'S CATALOG NUMBER PORTFOLIO #LD6C30D010-EU6C30409040-6LBM1H PRESCOLITE #LF6MLDM1-6LFML40K8SS	WAX. WATTS	MOUNT	OUTPUT *(D/I)	сст	CRI	DESCRIPTION RI 120-277V, 6" DIAMETER DOWNLIGHT WITH MEDIUM DISTRIBUTION AND SELF-FLANGED SEMI-SPECULAR CLEAR REFLECTOR. ELECTRONIC 0-10V DIMMING DRIVER WITH RANGE
	DL1	GOTHAM #EVO-40/30-6AR-MD-LD-MVOLT-GZ1	37 DL1 EXCEPT WITH	RECESSED	3,000	4000		FROM 100% TO 1%. UL LISTED
	L1	ALS #LPTW-4-WH-UD NEW STAR #AGG-G-24-OP-UN-TW0-CW56WATTS LITHONIA #CPXTW 2X4 TUWH RHYR 6000LM 80CRI SWL MVOLT NLT	56	RECESSED				120-277V, 2'X4' COLOR TUNNING FLAT PANEL. ELECTRONIC 0-10V DIMMING DRIVER WITH RANGE FROM 100% TO 10%. UL LISTED
	L1A L2	SAME AS         METALUX #24FPSL2SCT3-LOW         COLUMBIA #CFP24-LSCS         LITHONIA #CPX-2X4-AL08-80CRI-SWW7-SWL-MVOLT	27	RECESSED		4000		120-277V, 2'X4' LED FLAT PANEL WITH SELECTABLE LUMENS AND COLOR TEMPERAUTRE. 0-10V ELECTRONIC DIMMING TO 10% UL LISTED. COLOR TEMPERATURE AND LUMEN OUTPUT TO BE SET AT FACTORY AS INDICATED
	L2A		S L2 EXCEPT WITH E				R	120-277V, 2'X4' LED FLAT PANEL WITH SELECTABLE LUMENS AND COLOR
	L3	METALUX #24FPSL2SCT3-MID COLUMBIA #CFP24-LSCS LITHONIA #CPX-2X4-AL08-80CRI-SWW7-SWL-MVOLT	40 S L3 EXCEPT WITH E	RECESSED	4,291	4000		TEMPERAUTRE. 0-10V ELECTRONIC DIMMING TO 10% UL LISTED. COLOR TEMPERATURE AND LUMEN OUTPUT TO BE SET AT FACTORY AS INDICATED
	L4	METALUX #24FPSL2SCT3-HIGH COLUMBIA #CFP22-LSCS LITHONIA #CPX-2X2-AL07-80CRI-SWW7-SWL	56	RECESSED	6,011	4000		120-277V, 2'X4' LED FLAT PANEL WITH SELECTABLE LUMENS AND COLOR TEMPERAUTRE. 0-10V ELECTRONIC DIMMING TO 10% UL LISTED. COLOR TEMPERATURE AND LUMEN OUTPUT TO BE SET AT FACTORY AS INDICATED
	L4A L5-8	SAME AS         LUMENWERX #VIA4R-HLO-FH-SW-80-1500-40-8FT         LITECONTROL #4L-LG-D-8-8-SOF-C1-40K-D150-D01-1C-UNV-W1         MARK LIGHTING #SL4L LOP 8FT FLP XX 80CRI 40K 1500LMF MIN1 120 ZT	S L4 EXCEPT WITH E	RECESSED	<b>BATTERY IN</b> 12,000	4000		120V - 277V, 4"x 8'-0", RECESSED LINEAR FIXTURE WITH FLUSH LENS, WHITE FINISH. 0-10V DIMMING DRIVER, DIMMABLE TO 1%. ELECTRONIC DRIVER WITH <20% THD. UL LISTED. CONTROL WIRING REQUIRED FOR OPERATION OF 0-10V DIMMING.
	L5-8A	SAME AS           LUMENWERX #VIA4R-HLO-FH-SW-80-1500-40-10FT           LITECONTROL #4L-LG-D-10-2-SOF-C1-40K-D150-D01-1C-UNV-W1	L5-8 EXCEPT WITH	EMERGENCY RECESSED				120V - 277V, 4"x 10'-0", RECESSED LINEAR FIXTURE WITH FLUSH LENS, WHITE FINISH. 0-10V DIMMING DRIVER, DIMMABLE TO 1%. ELECTRONIC DRIVER WITH <20% THD. UL LISTED.
	L5-10A	MARK LIGHTING #SL4L LOP 10FT FLP XX 80CRI 40K 1500LMF MIN1 120 ZT SAME AS LUMENWERX #VIA4R-HLO-FH-SW-80-1500-40-12FT	L5-10 EXCEPT WITH					CONTROL WIRING REQUIRED FOR OPERATION OF 0-10V DIMMING. 120V - 277V, 4"x 12'-0", RECESSED LINEAR FIXTURE WITH FLUSH LENS, WHITE FINISH. 0-10V DIMMING DRIVER, DIMMABLE TO 1%. ELECTRONIC DRIVER WITH <20% THD. UL
	L5-12 L5-12A	LITECONTROL #4L-LG-D-12-4-SOF-C1-40K-D150-D01-1C-UNV-W1 MARK LIGHTING #SL4L LOP 12FT FLP XX 80CRI 40K 1500LMF MIN1 120 ZT SAME AS	180	RECESSED EMERGENCY				LISTED. CONTROL WIRING REQUIRED FOR OPERATION OF 0-10V DIMMING.
	L5-16	LUMENWERX #VIA4R-HLO-FH-SW-80-1500-40-16FT LITECONTROL #4L-LG-D-16-4-SOF-C1-40K-D150-D01-1C-UNV-W1 MARK LIGHTING #SL4L LOP 16FT FLP XX 80CRI 40K 1500LMF MIN1 120 ZT	240	RECESSED	,	4000		120V - 277V, 4"x 16'-0", RECESSED LINEAR FIXTURE WITH FLUSH LENS, WHITE FINISH. 0-10V DIMMING DRIVER, DIMMABLE TO 1%. ELECTRONIC DRIVER WITH <20% THD. UL LISTED. CONTROL WIRING REQUIRED FOR OPERATION OF 0-10V DIMMING.
	L5-16A L8	SAME AS         METALUX #22FP4240C         COLUMBIA #CFP22-LSCS         LITHONIA #CPX-2X2-AL07-80CRI-SWW7-SWL	L5-16 EXCEPT WITH	RECESSED		4000		120-277V, 2'X2' RECESSED LED PANEL. ELECTRONIC 0-10V DIMMING DRIVER WITH RANGE FROM 100% TO 10%. UL LISTED.
	L8A L9	SAME AS LUMENWERX #VIA4W-DI-ARO2-ARO2-H-CLO-SW-80CRI-1200LMF-1200LMF-40K-8FT-277-D1-2C-DMB-CF LITECONTROL MARK LIGHTING	S L8 EXCEPT WITH E	MERGENCY E	9,600 /9,600	4000		120V - 277V, 4"x 8'-0", WALL MOUNTED DIRECT/INDIRECT LINEAR FIXTURE WITH AYMMETRIC OPTIC DIRECT AND INDIRECT, WHITE FINISH. 0-10V DIMMING DRIVER, DIMMABLE TO 1%. ELECTRONIC DRIVER WITH <20% THD. UL LISTED. CONTROL WIRING REQUIRED FOR OPERATION OF 0-10V DIMMING.
	L9A		S L9 EXCEPT WITH E			IVERTE	R	120-277V, 8' LINEAR STRIP FIXTURE WITH FROSTED LENS AND COLD ROLLED STEEL HOUSING. ELECTRONIC 0-10V DIMMING DRIVER WITH RANGE FROM 100% TO 10%. UL
	L10	COLUMBIA #CSL8-LSCS	82 5 L10 EXCEPT WITH I	SUSPENDED	,			LISTED 120-277V, 4' LED VAPOR TIGHT STRIP LIGHT, FULLY GASKETED, FIBERGLASS HOUSING
	L11	COLUMBIA LITHONIA	50 5111 EXCEPT WITH 1			4000		AND LENS. UL WET LOCATION LISTED.
~~~	L12	LUMENWERX #VIA4W-DI-ARO2-ARO2-H-CLO-SW-80CRI-1200LMF-1200LMF-40K-4FT-277-D1-2C-DMB-CF LITECONTROL MARK LIGHTING	98	WALL	4,800 /4,800	4000		120V - 277V, 4"x 4'-0", WALL MOUNTED DIRECT/INDIRECT LINEAR FIXTURE WITH AYMMETRIC OPTIC DIRECT AND INDIRECT, WHITE FINISH. 0-10V DIMMING DRIVER, DIMMABLE TO 1%. ELECTRONIC DRIVER WITH <20% THD. UL LISTED. CONTROL WIRING REQUIRED FOR OPERATION OF 0-10V DIMMING.
	L12A	SAME AS         METALUX #14FPSL1SCT3         COLUMBIA         LITHONIA #CPANL 1X4 ALO1 SWW7 M4	L12 EXCEPT WITH	RECESSED		4000		120-277V, 1'X4' LED FLAT PANEL WITH SELECTABLE LUMENS AND COLOR TEMPERAUTRE. 0-10V ELECTRONIC DIMMING TO 10% UL LISTED. COLOR TEMPERATURE AND LUMEN OUTPUT TO BE SET AT FACTORY AS INDICATED
	L13A BL1	SAME AS MCGRAW EDISON #ISS-SA1-A-740-U-T4W BEACON #QSP1-24L-25-4K7-4-UNV	5 L13 EXCEPT WITH 1	EMERGENCY I	2,780	<b>NVERTE</b>		120-277V, SMALL QUARTER SPHERE DIE CAST ALUMINUM, ELECTRONIC DRIVER. UL ~LISTED: COLOR BY ARCHITECT: MOUNT FIXTURE AT 10-0"A.F.G. UNLESS OTHERWISE NOTED.
	BL1A	LITHONIA #WSQ LED-P2-40K-SR4-XX SAME AS LUMENWERX #VIA4PD-FH-SW-80-1200-40-12FT	BL1 EXCEPT WITH					120V - 277V, 4"x 12'-0", DIRECT LINEAR FIXTURE WITH FLUSH LENS, WHITE FINISH. 0-10V DIMMING DRIVER, DIMMABLE TO 1%. ELECTRONIC DRIVER WITH <20% THD. UL LISTED.
	PD1-12	LITECONTROL #4L-P-D-12-6-SOF-C1-40K-D120-D01-1C-UNV-W1-FA1 MARK LIGHTING #S4PD LLP 12FT MSL6 80CRI 40K 1200LMF SCT MIN1 FLL MVOLT WHTT ZT LUMENWERX #VIA4PD-FH-SW-80-1200-40-16FT	132	PENDANT	14,400	4000	80	DIMINING DRIVER, DIMINIABLE TO 1%. ELECTRONIC DRIVER WITH <20% THD. OL LISTED.
	PD1-16	LITECONTROL #4L-P-D-16-6-SOF-C1-40K-D120-D01-1C-UNV-W1-FA1 MARK LIGHTING #S4PD LLP 16FT MSL6 80CRI 40K 1200LMF SCT MIN1 FLL MVOLT WHTT ZT LUMARK #PRV-xI-C75-740-D-UNV-T4-MA-XX-HSS	172	PENDANT	19,200	4000	80	CONTROL WIRING REQUIRED FOR OPERATION OF 0-10V DIMMING. PROVIDE WITH 2 CIRCUITS. 120-277V, TYPE IV DISTRBUTION WITH HOUSE SIDE SHIELD AND STRAIGHT SQUARE
£	SL1	LITHONIA EXO	176	POLE	26,098	4000		STEEL AT 30'-0" IN LENGTH. COLOR TO BE SELECTED BY ARCHITECT.
	SL2	STERNBERG #PT-ML760-32L-40-T5-MDL104-CA-XX US ARCHITECTURAL LIGHTING #RZR-PTY-PLED-V-SQ-W-40LED-1050MA-277-RAL-XXXX	134	PENDANT	1,362	4000	70	277V, SQUARE POST-TOP MOUNT FIXTURE WITH STAINLESS STEEL HARDWARE TOOLESS ACCESS. ELECTRONIC DRIVER, UL LISTED. MOUNTED ON 12'-0" SQUARE POLE.
tum	EX1	ча <del>SURE-LITE-#LPX-7/SD</del> LITHONIA #LQM-S-W-3-R-120/277-EL N-SD DUAL LITE #EVE-U-R-W-E-I		UNIVERSAL	0	-	-	
	EX2	LIFE SAFETY LIGHTING #LSWLEZTEU-R-G-EM-CW-SDT BEGHELLI #PX-A-R-SA-AT LITHONIA #WLTE-GY-1-R-EL-SD	4	WALL	0	-	-	120-277C, POLYCARBONATE HOUSING WITH UV-STABILIZED POLYCARBONATE MOUNTING CANOPY WITH CLEAR LENSE. UL LISTED FOR WET LOCATIONS.
		L REMARKS: RACTOR SHALL REFER TO DRAWINGS FOR LOCATIONS THAT REQUIRE DRYWALL FRAMES FOR RECESSED FIXT	TURES.		1			




epts, ideas, plans, and details as not be used for any other se without their expressed written . The project owner shall be ed to retain copies for information erence purposes. Primary Engineering, Inc.

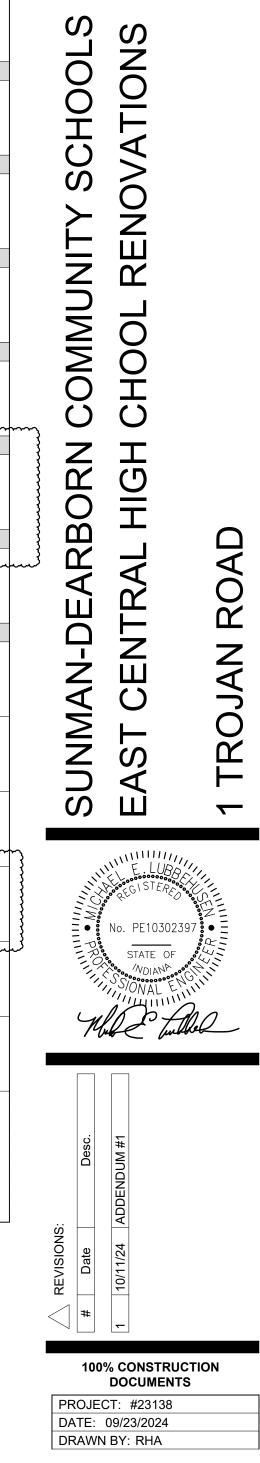

E702

SCHEDULES



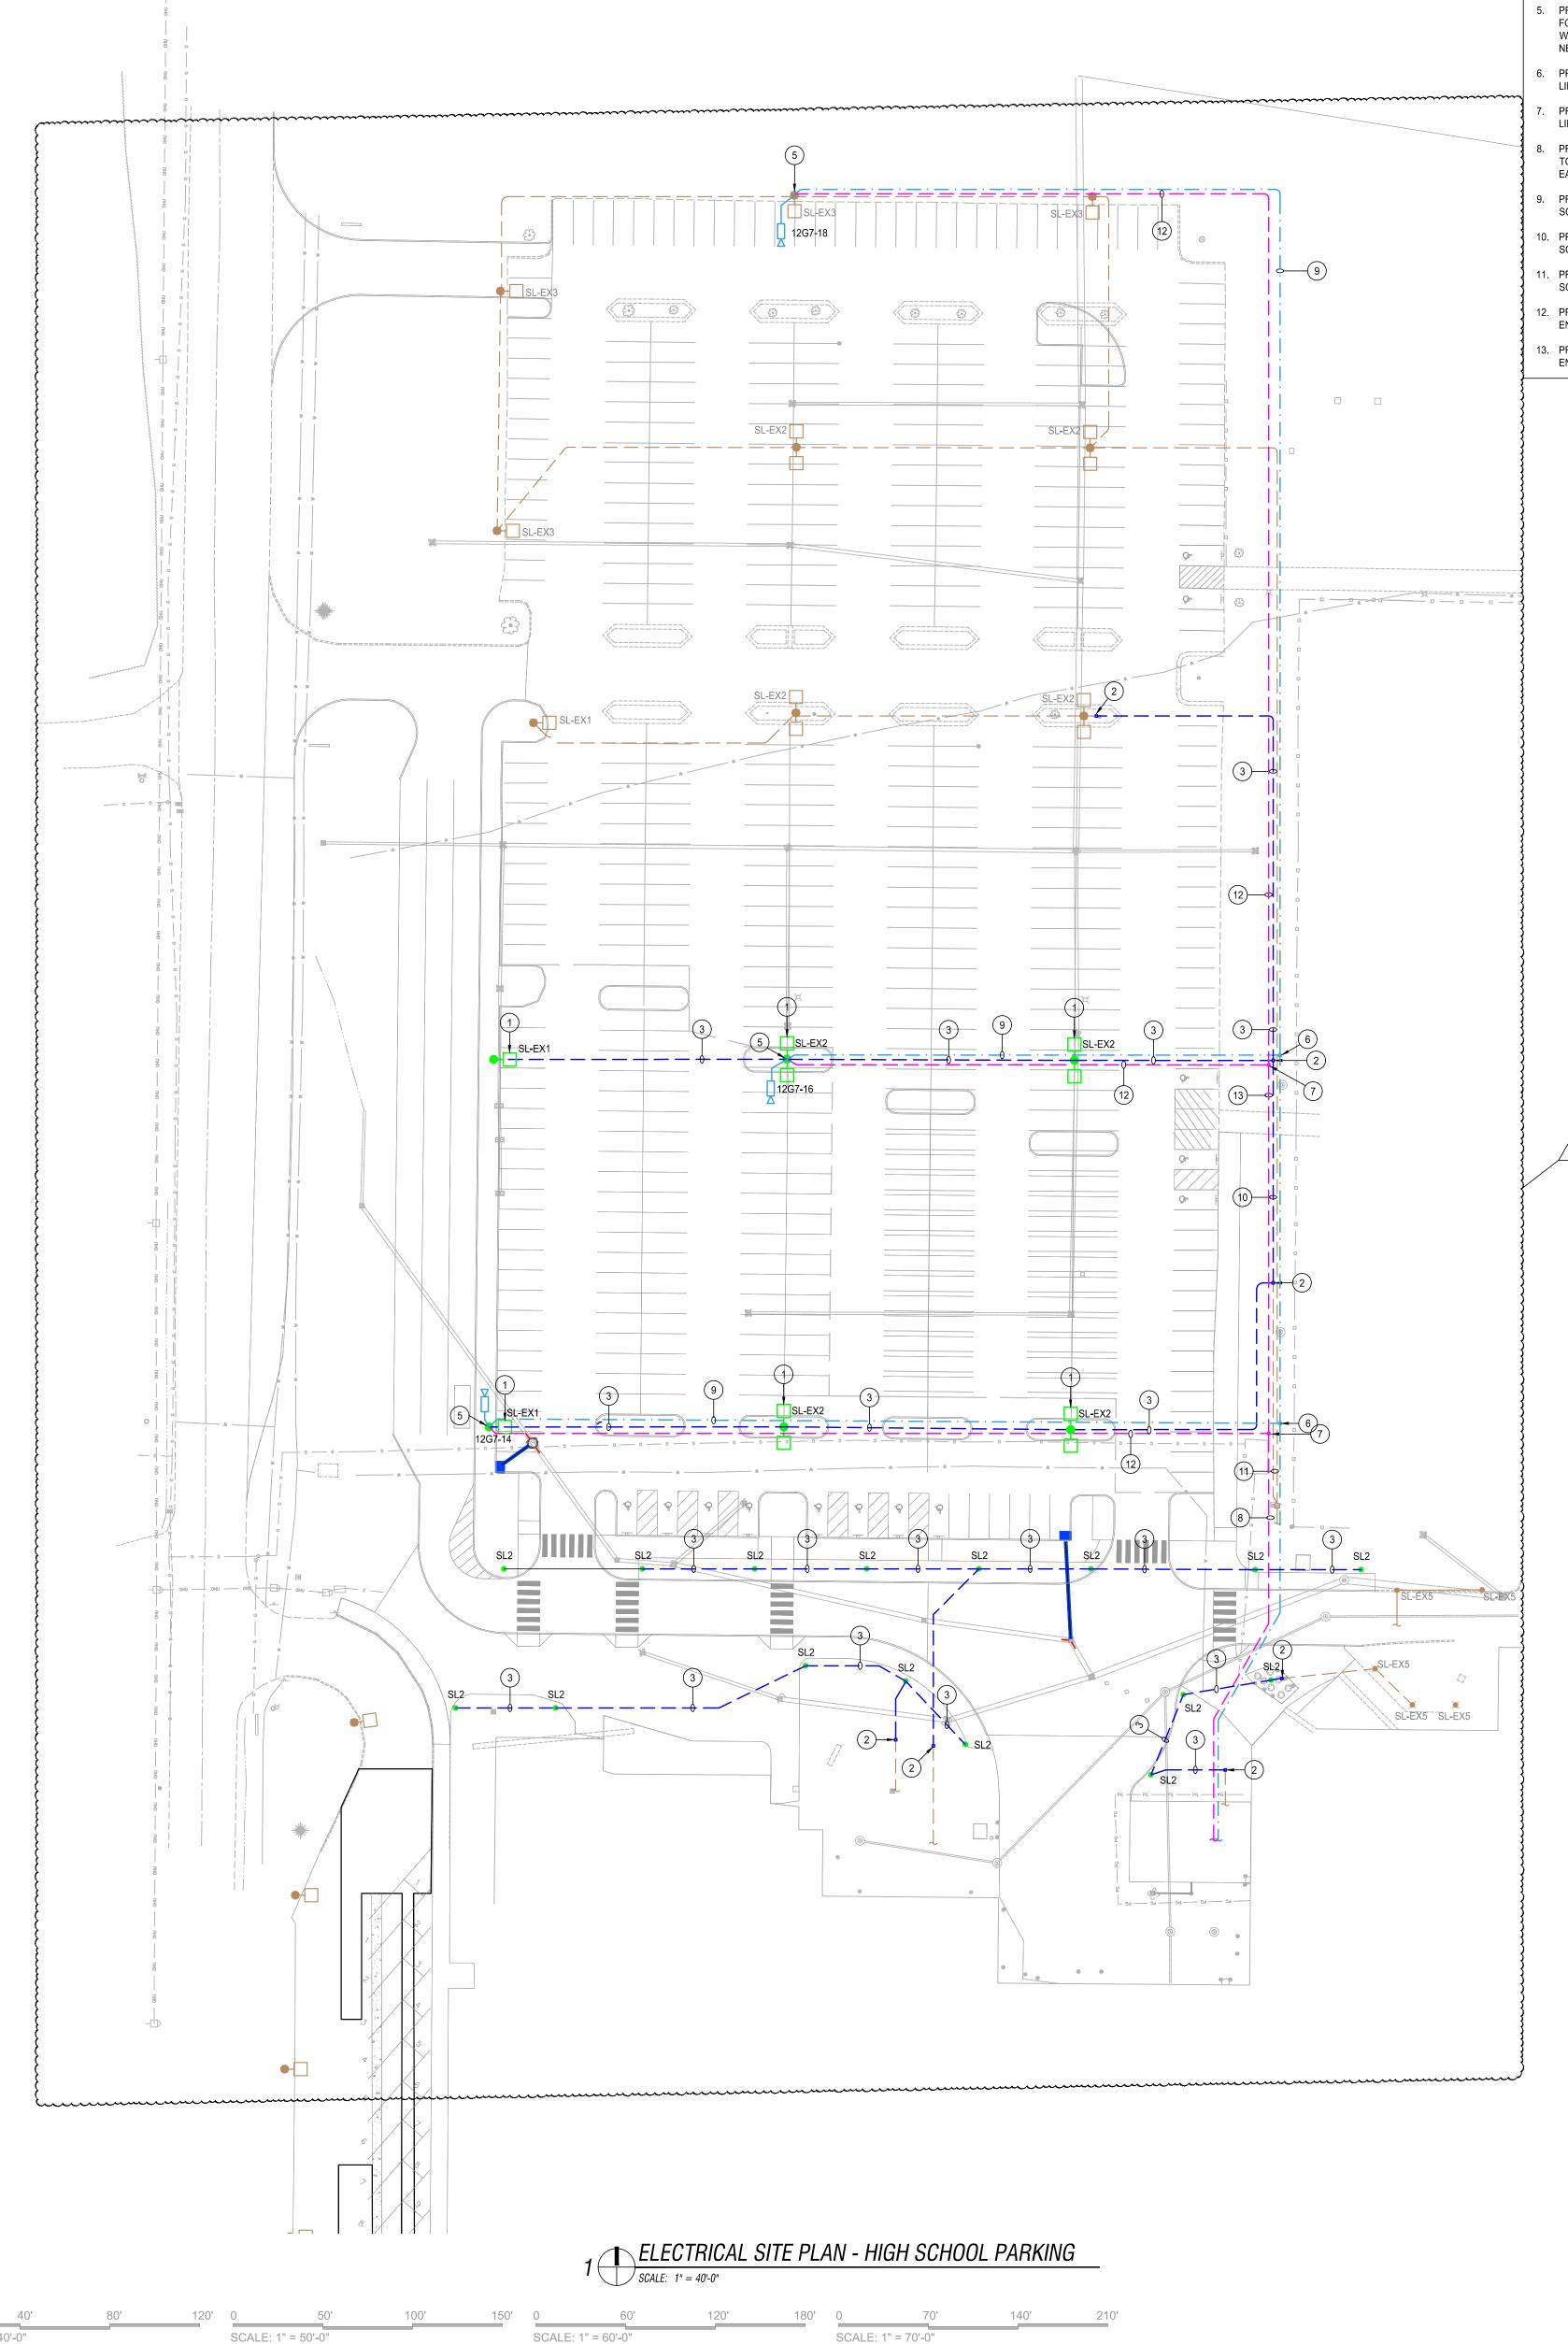

90'

### **PLAN NOTES**

- INSTALL SALVAGED POLE AND FIXTURE HEAD ON NEW CONCRETE POLE BASE.
- . PROVIDE AND INSTALL 12"X12" IN-GROUND PULL BOX WITH OPEN BOTTOM TO SERVE SITE LIGHTING CIRCUIT(S). EQUAL TO PG SERIES. LID SHALL BE MARKED "LIGHTING." CONTRACTOR SHALL BUTT SPLICE AND HEAT SHRINK WRAP NEW CONDUCTORS TO EXISTING TO REMAIN BRANCH CIRCUIT.
- PROVIDE AND INSTALL 2-#8,1-#8G IN 1" RNC AT -24" BELOW GRADE TO SERVE SITE FIXTURE(S). CONNECT TO BRANCH CIRCUIT/CONTRACTOR TO SITE FIXTURE(S) AS INDICATED.
- PROVIDE AND INSTALL ONE (1) 1" CONDUIT WITH 2-STRANDS OF OS2 OPTICAL FIBER AT -24" BELOW GRADE FROM ENCLOSURE MOUNTED ON POLE TO THE TELECOMMUNICATION RACK IN PRESSBOX. PROVIDE AND INSTALL 15"x12"x6 NEMA 4X ALUMINUM ENCLOSURE WITH LOCKABLE DOOR AND POLE MOUNT KIT ON SITE POLE FOR MEDIA CONVERTER, DIM RAIL, AND POWER SUPPLY. PROVIDE AND INSTALL A ANTAIRA #LPN-0702G-SFP-24-T OR EQUAL WITH DIN RAIL, MEAN WELL #SDR-240-24 POWER SUPPLY AND ANTAIRA #SFP-10-T TRANSCEIVER IN THE ENCLOSURE. PROVIDE
- NECESSARY CONNECTIONS AND PATCH CORDS FOR A COMPLETE SYSTEM. MOUNT ENCLOSURE AT +8'-0" ABOVE GRADE. PROVIDE AND INSTALL 12"X12" IN-GROUND PULL BOX WITH OPEN BOTTOM TO SERVE OPTICAL FIBER. EQUAL TO PG SERIES. LID SHALL BE MARKED "OPTICAL FIBER."
- PROVIDE AND INSTALL 12"X12" IN-GROUND PULL BOX WITH OPEN BOTTOM TO SERVE OPTICAL FIBER. EQUAL TO PG SERIES. LID SHALL BE MARKED "POWER."
- PROVIDE AND INSTALL ONE (1) 1-1/4"C WITH 6-#6,1-#6G FROM PANEL 12G7 LOCATED IN HIGH SCHOOL. ROUTE BRANCH CIRCUIT TO SECURITY CAMERA ENCLOSURE TO POWER MEDIA CONVERTERS, REFER TO DRAWINGS FOR CIRCUIT DESIGNATION FOR EACH ENCLOSURE.
- PROVIDE AND INSTALL ONE (1) 1" CONDUIT WITH 2-STRANDS OF OS2 OPTICAL FIBER AT -24" BELOW GRADE TO THE HIGH SCHOOL AND TERMINATE IN TELECOMMUNICATION RACK TRG.
- ). PROVIDE AND INSTALL ONE (1) 1" CONDUIT WITH 4-STRANDS OF OS2 OPTICAL FIBER AT -24" BELOW GRADE F TO THE HIGH SCHOOL AND TERMINATE IN TELECOMMUNICATION RACK TRG.
- PROVIDE AND INSTALL ONE (1) 1" CONDUIT WITH 6-STRANDS OF OS2 OPTICAL FIBER AT -24" BELOW GRADE TO THE HIGH SCHOOL AND TERMINATE IN TELECOMMUNICATION RACK TRG.
- PROVIDE AND INSTALL ONE (1) 1"CONDUIT WITH 2-#6,1-#6G AT -24" BELOW GRADE FROM PULL BOX TO SECURITY CAMERA ENCLOSURE FOR BRANCH CIRCUIT AS DESIGNATED.
- 8. PROVIDE AND INSTALL ONE (1) 1-1/4"CONDUIT WITH 4-#6,1-#6G AT -24" BELOW GRADE FROM PULL BOX TO SECURITY CAMERA ENCLOSURE FOR BRANCH CIRCUIT AS DESIGNATED.



and reference purposes.


2024 © Primary Engineering, Inc.

S Ζ HOOL Ο \_\_\_\_\_ PE1030239 **100% CONSTRUCTIONS** DOCUMENTS PROJECT: #22130 DATE: 09/23/2024 DRAWN BY: Author ELECTRICAL SITE PLAN HIGH SCHOOL PARKING LOT ES201



PRIMARY JOB # 24584


# ECMS ADDENDUM #1 DRAWINGS 10/11/24

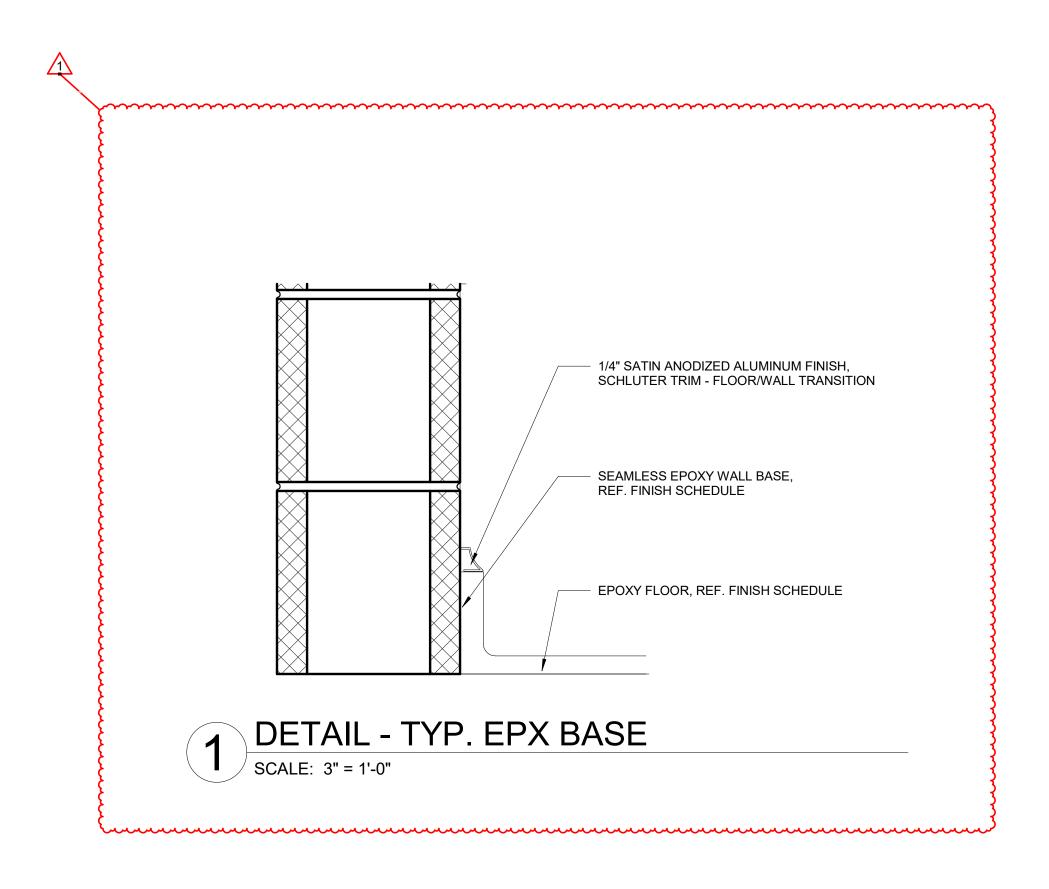

### A. CONTRACTOR TO VERIFY EXISITING CONDITIONS AND REPAIR ALL EXISTING WALLS, SLAB, AND CEILINGS TO A CONDITION SUITABLE FOR ACCEPTING NEW FINISHES AS PER MANUFACTURER'S RECOMMENDED INSTALLATION METHODS. MINIMUM LEVEL 4 FINISH ON EXISTING AND NEW WALLS, UNLESS NOTED OTHERWISE.

- B. ALL FLOORING TRANSITIONS TO COMPLY WITH ADA GUIDELINES AND TO OCCUR UNDER CENTER OF DOORWAYS AND OR AT CENTERLINE OF WALL, UNLESS INDICATED DIFFERENTLY ON FINISH PLANS. PROVIDE REDUCER STRIPS WHEREVER CARPET OR LVT MEET CONCRETE.
- C. CONTRACTOR TO PROVIDE PROTECTION AS NEEDED DURING CONSTRUCTION. IF, ANY, TO PERSERVE NEW FINISHES WHILE COMPLETING CONSTRUCTION.
- D. CONTRACTOR SHALL BE RESPONSIBLE FOR VERIFICATION OF DIMENSIONS AND JOB CONDITIONS. ANY DEVIATION FROM WHAT IS INDICATED ON THE FINISH PLANS SHALL BE BROUGHT TO THE ATTENTION OF THE ARCHITECTS AND DESIGNERS. ALL DIMENSIONS SHOWN ARE TO FACE OF FINISH MATERIAL, UNLESS NOTED OTHERWISE.
- E. WHERE WALLS ARE INDICATED TO RECEIVE PAINT FINISH, PRIME AND PAINT GRILLES, FIRE EXTINGUISHER CABINETS, AND OTHER ITEMS EMBEDDED IN WALL CONSTRUCTION TO MATCH SURFACE ON WHICH THEY OCCUR.
- F. CONTRACTOR TO PROVIDE DRYWALL REVEAL JOINT WHERE DRYWALL MEETS DISSIMILAR MATERIALS.
- G. CONTRACTOR TO PROVIDE SCHLUTER EDGE WHERE TILE MEETS DISSIMILAR MATERIALS. REFER TO INTERIOR ELEVATIONS FOR FURTHER DETAILS. H. DO NOT INSTALL GYPSUM BOARD BEHIND TILE BACKER BOARD LOCATIONS.
- I. IF ONLY PAINT IS INDICATED AS THE FINISH, REFER TO ARCHITECTURAL FLOOR PLANS FOR SUBSTRATE INFORMATION.
- J. ALL MECHANICAL CLOSETS TO HAVE A SEALED CONCRETE FLOOR FINISH. PROVIDE **RESILIENT TRANSITION STRIP TO MATCH RB-1.** K. ALL WALLS, COLUMNS, AND CEILINGS TO BE PAINTED PT-1, UNLESS NOTED OTHERWISE.
- L. PAINT ALL HM DOOR FRAMES WITHIN SCOPE PT-4, IF NOT ALREADY PAINTED PT-4.

## FINISH LEGEND

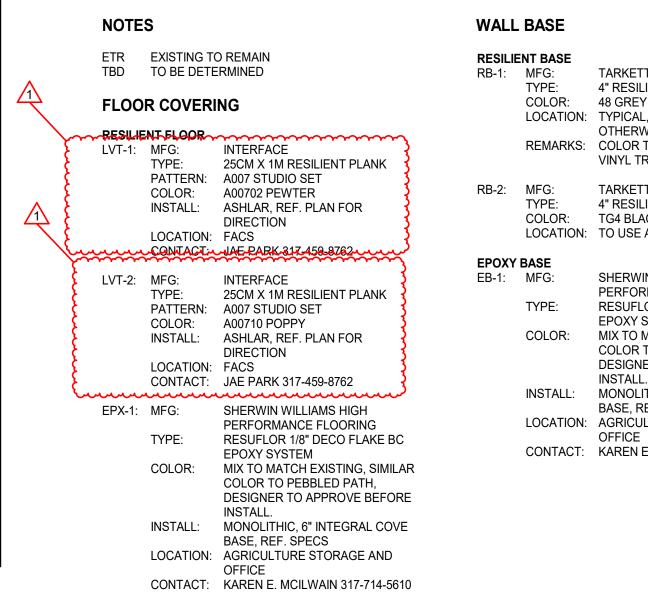

ETT JOHNSONITE	
SILIENT WALL BASE	
CAL, UNLESS NOTED ERWISE	
OR TO BE USED WITH A	LL
L TRANSITION STRIPS	
ETT JOHNSONITE	
SILIENT WALL BASE BLACK MAGIC	

LOCATION: TO USE AT ALL PL-2 LOCATIONS PT-3: SHERWIN WILLIAMS HIGH PERFORMANCE FLOORING

RESUFLOR 1/8" DECO FLAKE BC EPOXY SYSTEM COLOR: MIX TO MATCH EXISTING, SIMILAR COLOR TO PEBBLED PATH, DESIGNER TO APPROVE BEFORE INSTALL. INSTALL: MONOLITHIC, 6" INTEGRAL COVE BASE, REF. SPECS LOCATION: AGRICULTURE STORAGE AND

CONTACT: KAREN E. MCILWAIN 317-714-5610

,	
	SHERWIN WILLIAMS REF. SPECS FOR TYPE SW7570 EGRET WHITE TYPICAL
COLOR: LOCATION:	SHERWIN WILLIAMS REF. SPECS FOR TYPE SW7066 GRAY MATTERS ACCENT TO PATCH EXISTING PAINT AS NEEDED.
LOCATION:	SW7067 CITYSCAPE
MFG: TYPE:	SHERWIN WILLIAMS REF. SPECS FOR TYPE

PAINT/WALL FINISH

PAINT

PT-1:

PT-2:

PT-4:

COLOR: SW7068 GRIZZLE GRAY LOCATION: HM DOOR FRAMES REMARKS: TO PATCH EXISTING PAINT AS NEEDED. STAINLESS STEEL COUNTERTOP

PLASTIC LAMINATE/SOLID SURFACE

FORMICA

PLAST	C LAMINATE	
PL-1:	TYPE: COLOR: INSTALL:	FORMIC PLASTIC DANISH MONOLI FACS KYLIE LE
PL-2:	MFG: Type: Color: Install: Location:	FORMIC PLASTIC TERRIL MONOLI AGRICU

FORMICA PLASTIC LAMINATE TERRIL 2297-58 MONOLITHIC, VERTICAL GRAIN ION: AGRICULTURE CONTACT: KYLIE LEYBA 317-869-8717

PLASTIC LAMINATE

DANISH MAPLE 8906-58

MONOLITHIC, VERTICAL GRAIN

SOLID SURFACE PAINT AS NEEDED. SS-1: MFG: CORIAN TYPE: 1/2" SOLID SURFACE

> STS-1: TYPE: STAINLESS STEEL COUNTERTOP REMARKS: TO INCLUDE 4" STAINLESS STEEL BACKSPLASH

KYLIE LEYBA 317-869-8717

COLOR: ASH CONCRETE INSTALL: MONOLITHIC, HORIZONTAL GRAIN LOCATION: FACS


LOCATION: AGRICULTURE

WOOD COUNTERTOP

WD-1: TYPE: BUTCHER BLOCK COUNTERTOP

COLOR: NATURAL AND SEALED INSTALL: MONOLITHIC, HORIZONTAL GRAIN LOCATION: AGRICULTURE

### MISC.

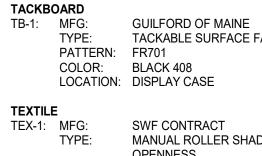


OPENNESS PATTERN: CROSSHATCH R COLOR: WHITE/FOG C8214

LOCATION: SECOND FLOOR CLASSROOMS

TACKABLE SURFACE FABRIC


MANUAL ROLLER SHADES - 3%




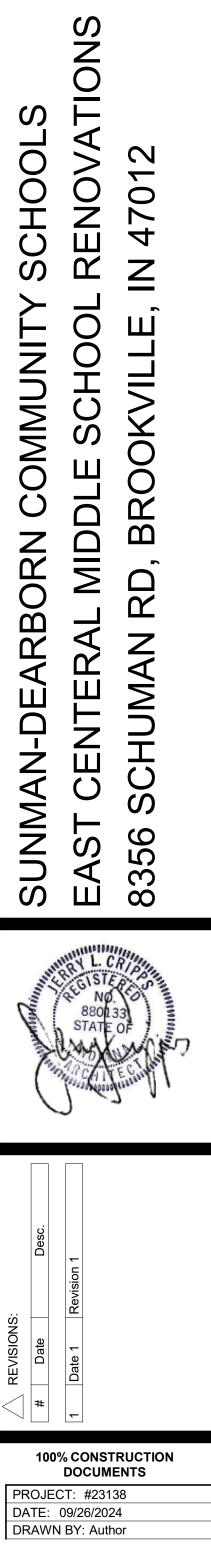





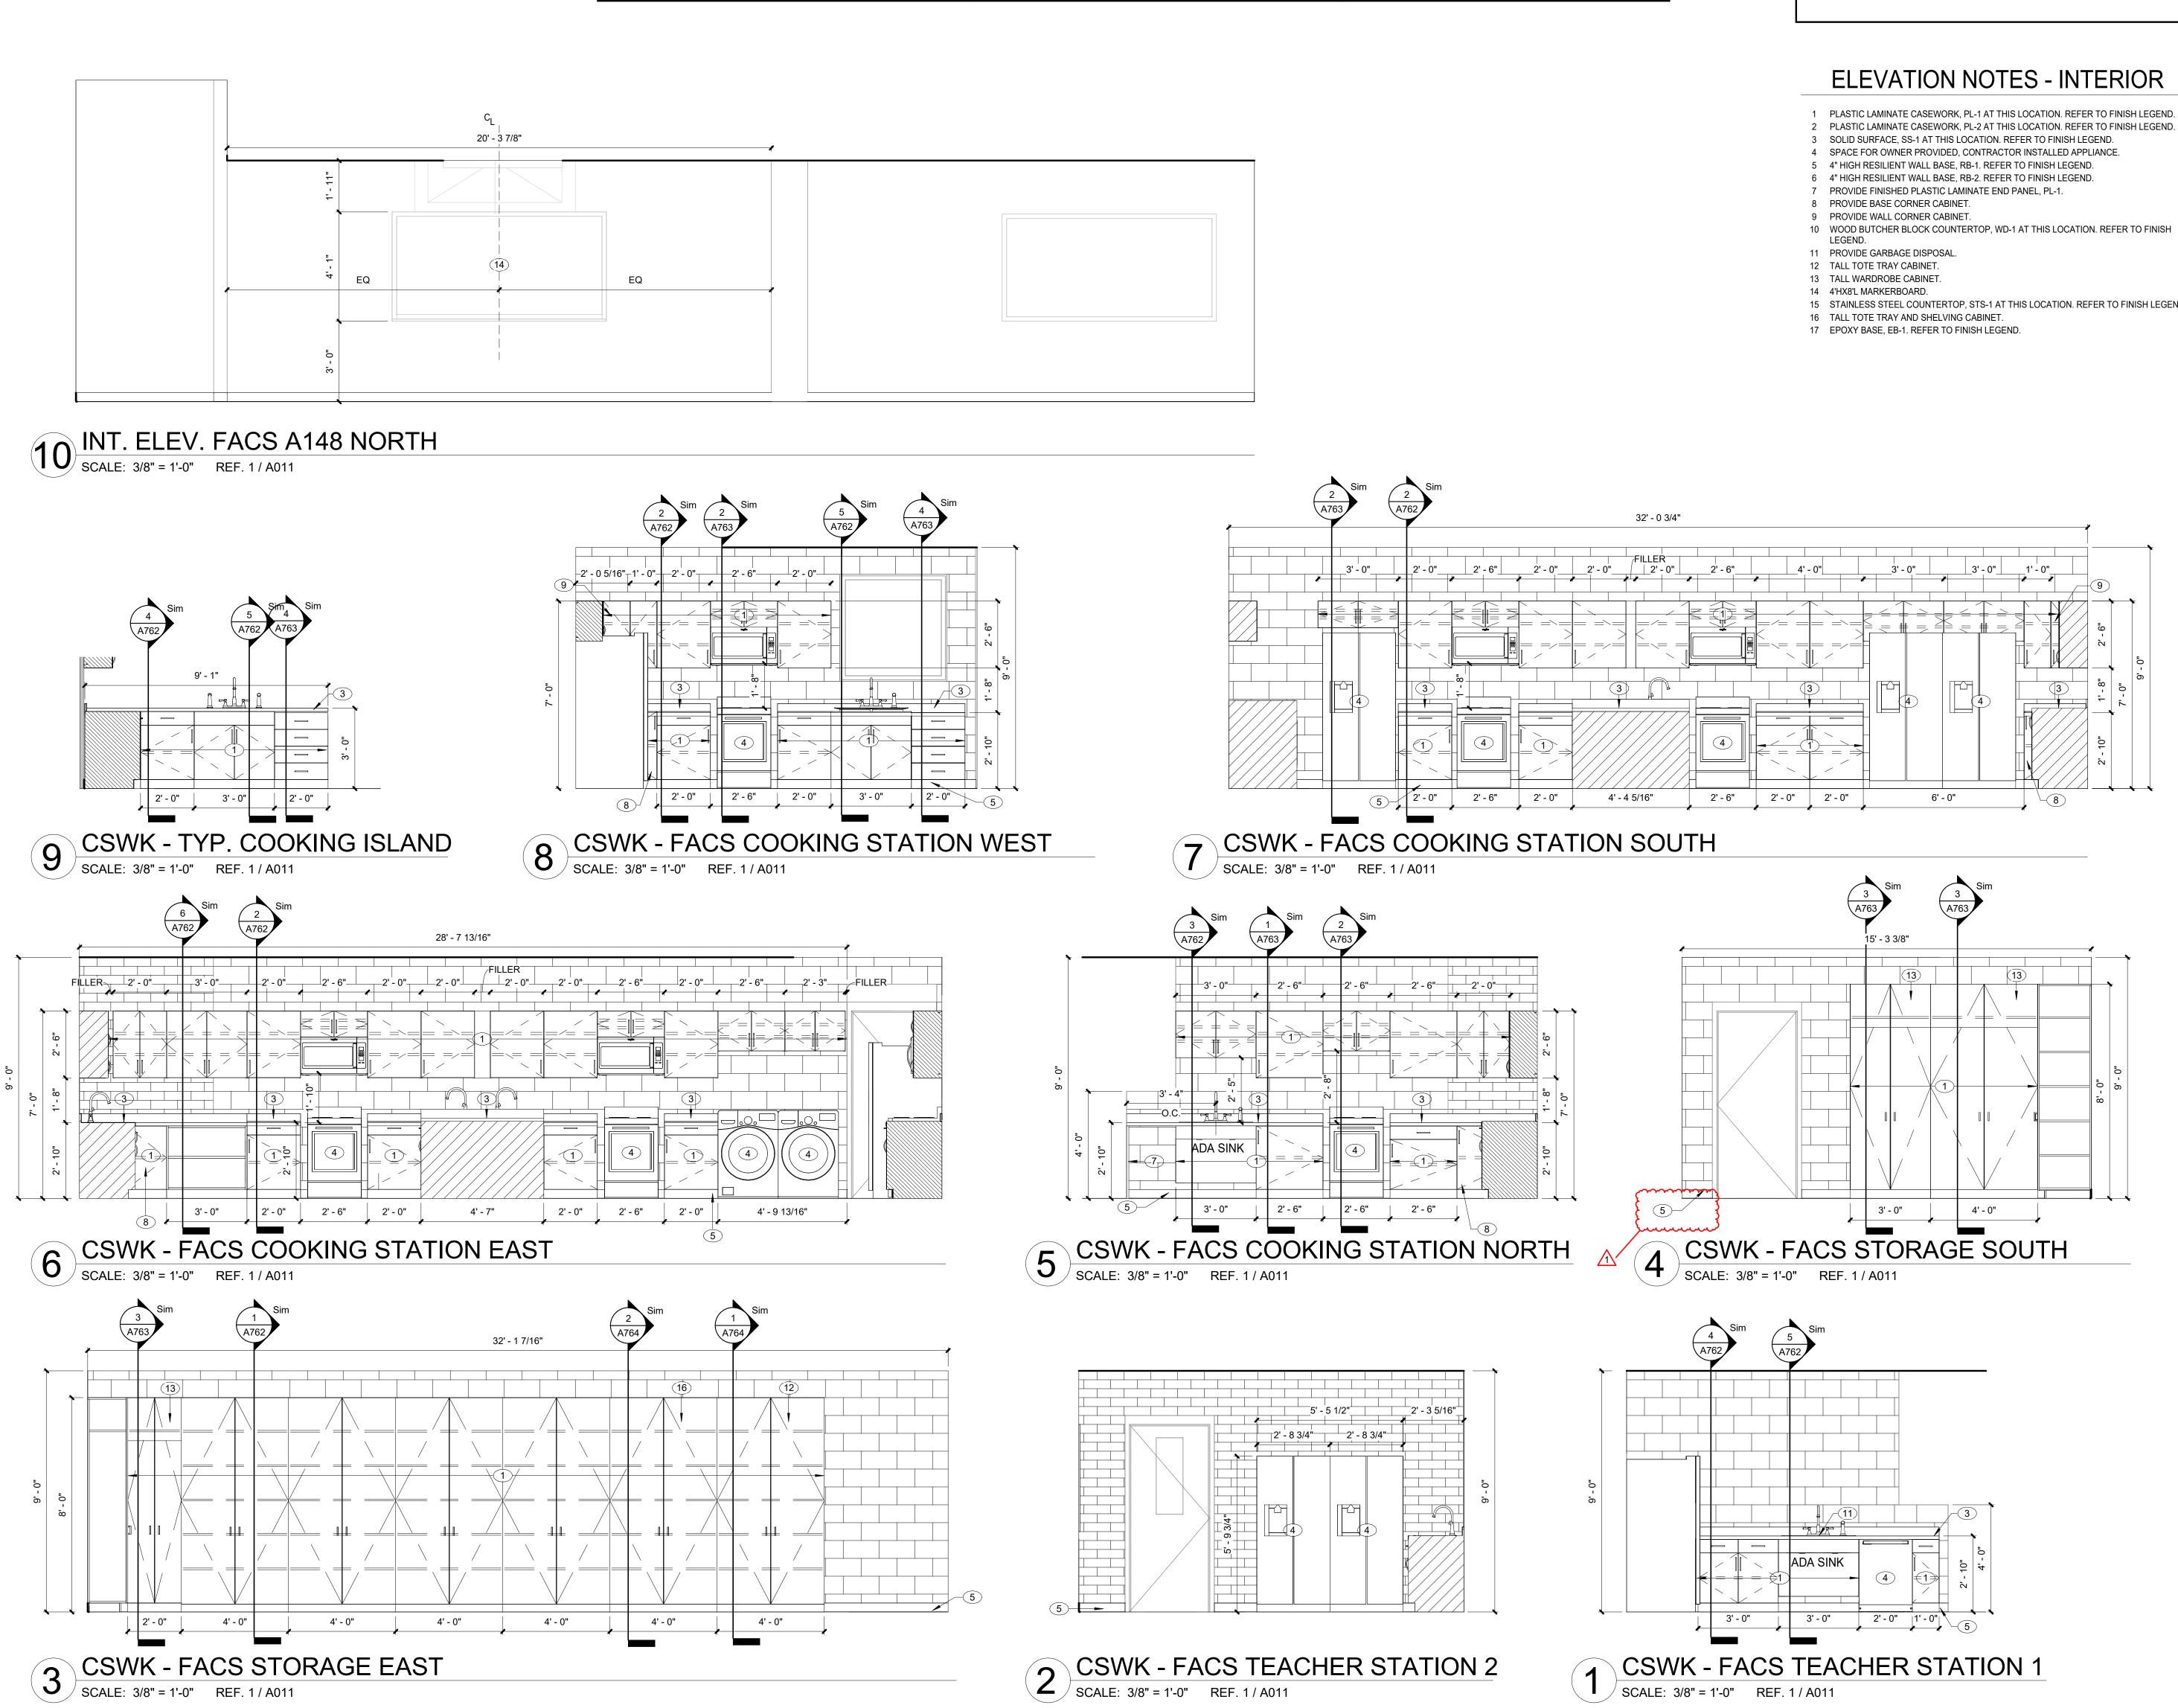

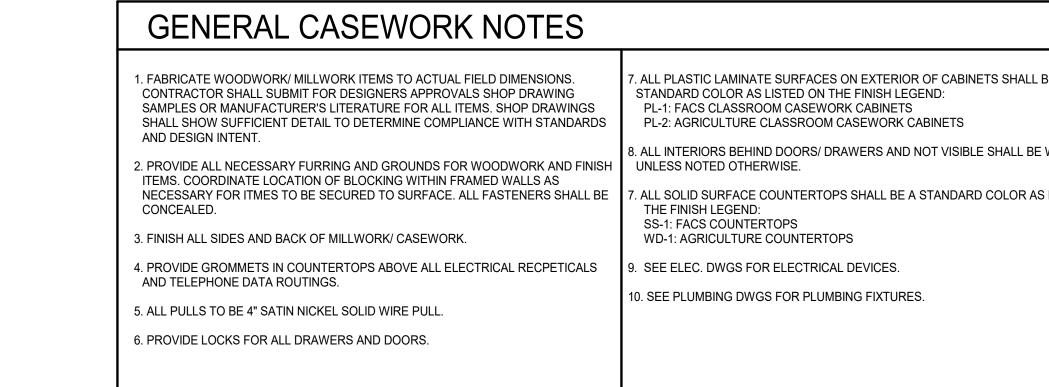

L BE A	
BE WHITE,	
AS LISTED ON	

A. CONTRACTOR TO PROVIDE SCHLUTER TRIM WHERE TILE MEETS DISSIMILAR MATERIALS. REFER TO INTERIOR ELEVATIONS FOR FURTHER DETAILS.

B. DO NOT INSTALL GYPSUM BOARD BEHIND BACKER BOARD WHERE TILE FINISH IS INDICATED.

- C. CONTRACTOR TO PROVIDE DRYWALL REVEAL JOINT WHERE DRYWALL MEETS DISSIMILAR MATERIALS.
- D. IF ONLY PAINT IS INDICATED AS THE FINISH, REFER TO ARCHITECTURAL FLOOR PLANS FOR SUBSTRATE INFORMATION.

E. CONTRACTOR SHALL BE RESPONSIBLE FOR VERIFICATION OF DIMENSIONS AND JOB CONDITIONS. ANY DEVIATION FROM WHAT IS INDICATED ON THE FINISH PLANS SHALL BE BROUGHT TO THE ATTENTION OF THE ARCHITECTS AND DESIGNERS.

F. ALL DIMENSIONS SHOWN ARE TO FACE OF FINISH MATERIAL, UNLESS NOTED OTHERWISE.

G. ALL EXPOSED METAL SURFACES, SUCH AS GRILLES, FIRE EXTINGUISHER CABINETS, ETC., ARE TO BE PRIMED AND PAINTED TO MATCH THE SURFACE ON WHICH THEY OCCUR. H. ALL WALLS AND COLUMNS TO BE PAINTED PT-1, UNLESS NOTED OTHERWISE.


- 1 PLASTIC LAMINATE CASEWORK, PL-1 AT THIS LOCATION. REFER TO FINISH LEGEND. 2 PLASTIC LAMINATE CASEWORK, PL-2 AT THIS LOCATION. REFER TO FINISH LEGEND.

- 15 STAINLESS STEEL COUNTERTOP, STS-1 AT THIS LOCATION. REFER TO FINISH LEGEND.









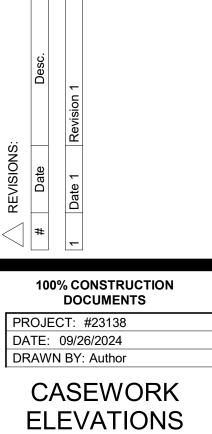




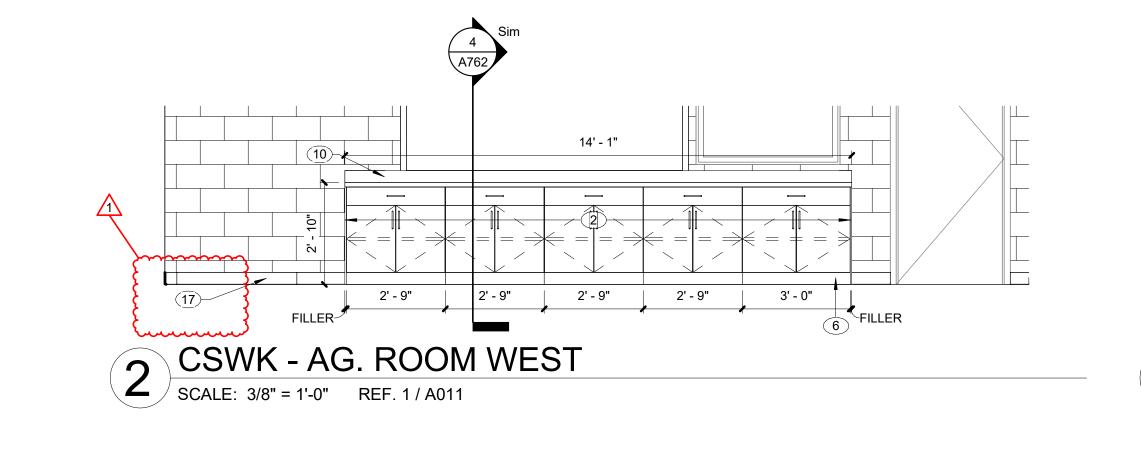

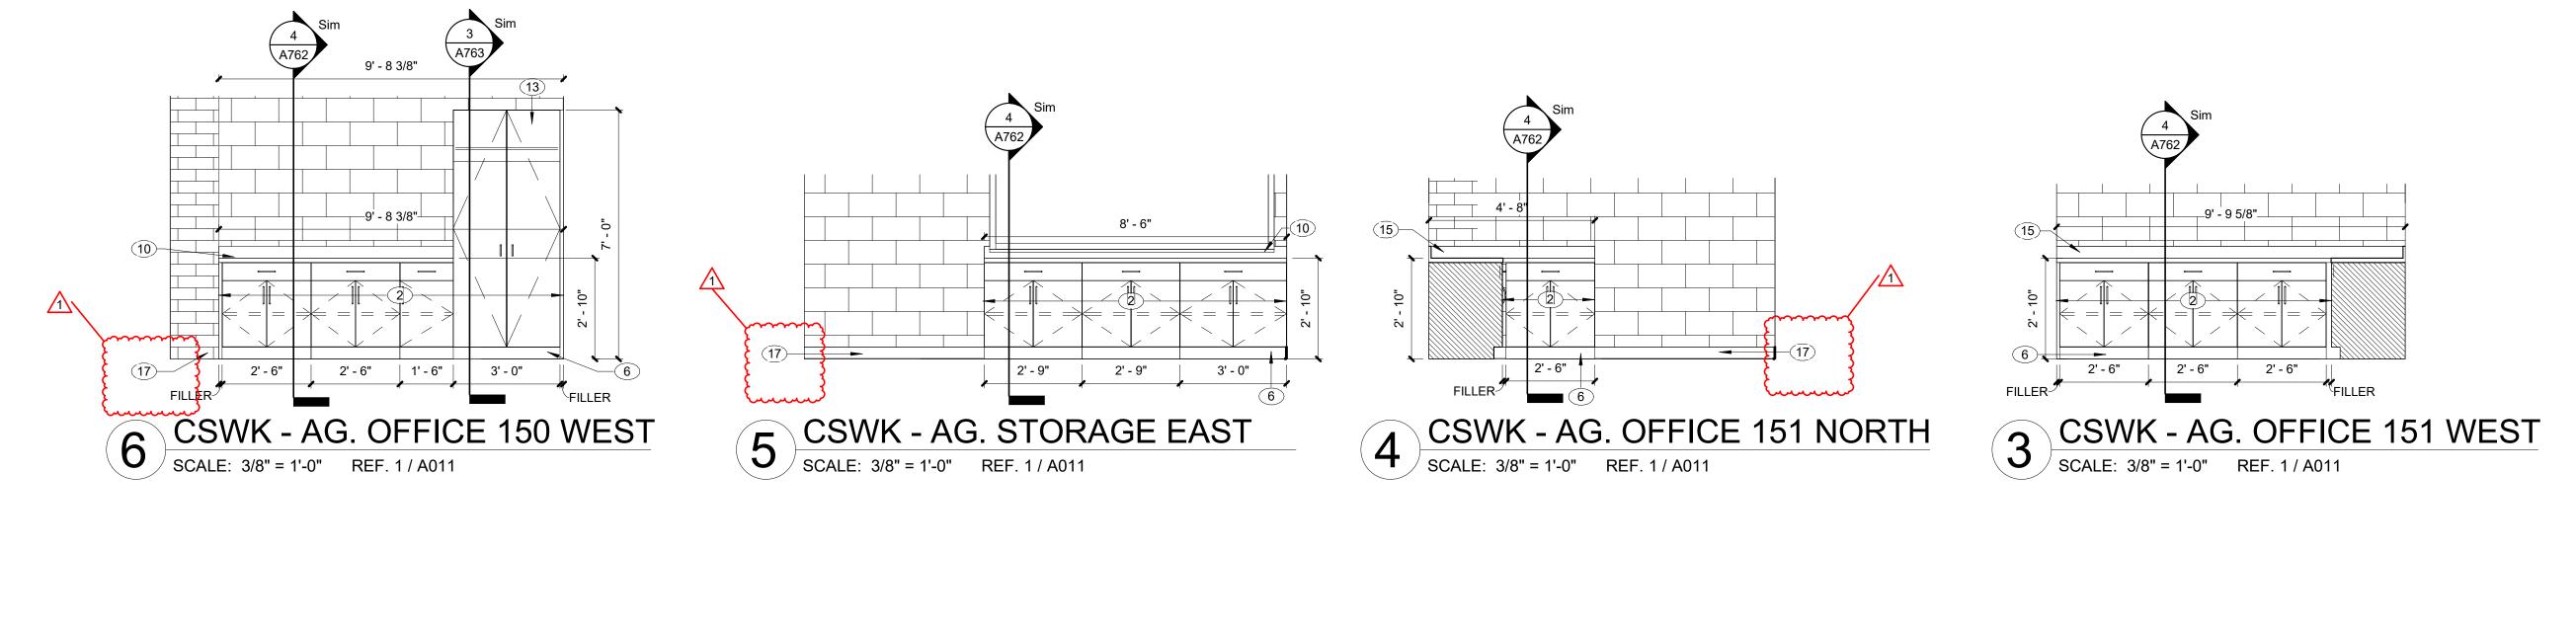

GENERAL CASEWORK NOTES	
<ol> <li>FABRICATE WOODWORK/ MILLWORK ITEMS TO ACTUAL FIELD DIMENSIONS. CONTRACTOR SHALL SUBMIT FOR DESIGNERS APPROVALS SHOP DRAWING SAMPLES OR MANUFACTURER'S LITERATURE FOR ALL ITEMS. SHOP DRAWINGS SHALL SHOW SUFFICIENT DETAIL TO DETERMINE COMPLIANCE WITH STANDARDS AND DESIGN INTENT.</li> <li>PROVIDE ALL NECESSARY FURRING AND GROUNDS FOR WOODWORK AND FINISH ITEMS. COORDINATE LOCATION OF BLOCKING WITHIN FRAMED WALLS AS NECESSARY FOR ITMES TO BE SECURED TO SURFACE. ALL FASTENERS SHALL BE CONCEALED.</li> <li>FINISH ALL SIDES AND BACK OF MILLWORK/ CASEWORK.</li> </ol>	<ol> <li>ALL PLASTIC LAMINATE SURFACES ON EXTERIOR OF CABINETS STANDARD COLOR AS LISTED ON THE FINISH LEGEND: PL-1: FACS CLASSROOM CASEWORK CABINETS PL-2: AGRICULTURE CLASSROOM CASEWORK CABINETS</li> <li>ALL INTERIORS BEHIND DOORS/ DRAWERS AND NOT VISIBLE SH UNLESS NOTED OTHERWISE.</li> <li>ALL SOLID SURFACE COUNTERTOPS SHALL BE A STANDARD CO THE FINISH LEGEND: SS-1: FACS COUNTERTOPS WD-1: AGRICULTURE COUNTERTOPS</li> </ol>
<ol> <li>PROVIDE GROMMETS IN COUNTERTOPS ABOVE ALL ELECTRICAL RECPETICALS AND TELEPHONE DATA ROUTINGS.</li> <li>ALL PULLS TO BE 4" SATIN NICKEL SOLID WIRE PULL.</li> <li>PROVIDE LOCKS FOR ALL DRAWERS AND DOORS.</li> </ol>	<ol> <li>9. SEE ELEC. DWGS FOR ELECTRICAL DEVICES.</li> <li>10. SEE PLUMBING DWGS FOR PLUMBING FIXTURES.</li> </ol>

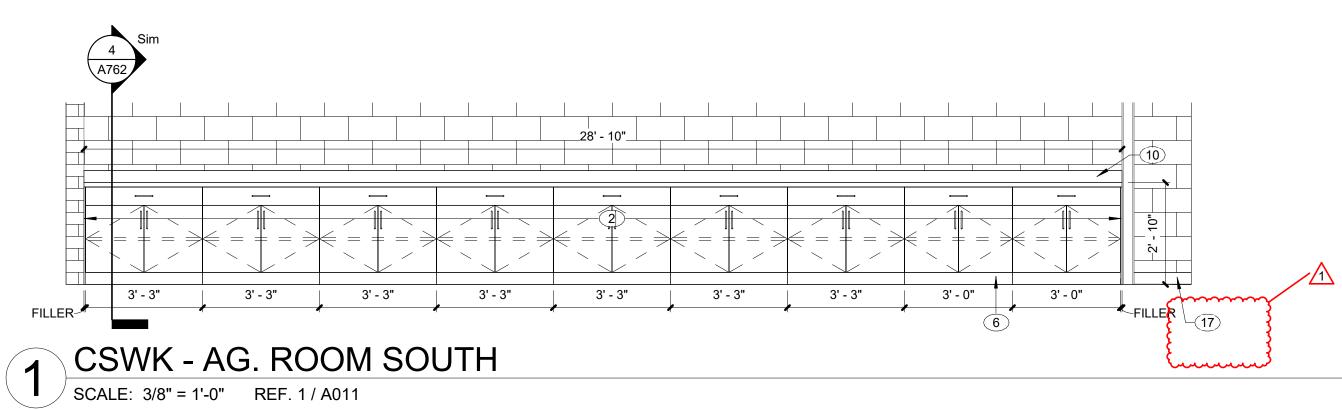

- A. CONTRACTOR TO PROVIDE SCHLUTER TRIM WHERE TILE MEETS DISSIMILAR MATERIALS. REFER TO INTERIOR ELEVATIONS FOR FURTHER DETAILS. B. DO NOT INSTALL GYPSUM BOARD BEHIND BACKER BOARD WHERE TILE FINISH IS
- INDICATED.
- C. CONTRACTOR TO PROVIDE DRYWALL REVEAL JOINT WHERE DRYWALL MEETS DISSIMILAR MATERIALS.
- D. IF ONLY PAINT IS INDICATED AS THE FINISH, REFER TO ARCHITECTURAL FLOOR PLANS FOR SUBSTRATE INFORMATION. E. CONTRACTOR SHALL BE RESPONSIBLE FOR VERIFICATION OF DIMENSIONS AND JOB CONDITIONS. ANY DEVIATION FROM WHAT IS INDICATED ON THE FINISH PLANS SHALL BE BROUGHT TO THE ATTENTION OF THE ARCHITECTS AND DESIGNERS.
- F. ALL DIMENSIONS SHOWN ARE TO FACE OF FINISH MATERIAL, UNLESS NOTED OTHERWISE. G. ALL EXPOSED METAL SURFACES, SUCH AS GRILLES, FIRE EXTINGUISHER CABINETS, ETC.,
- ARE TO BE PRIMED AND PAINTED TO MATCH THE SURFACE ON WHICH THEY OCCUR. H. ALL WALLS AND COLUMNS TO BE PAINTED PT-1, UNLESS NOTED OTHERWISE.

# **ELEVATION NOTES - INTERIOR**


- 1 PLASTIC LAMINATE CASEWORK, PL-1 AT THIS LOCATION. REFER TO FINISH LEGEND. 2 PLASTIC LAMINATE CASEWORK, PL-2 AT THIS LOCATION. REFER TO FINISH LEGEND.
- 3 SOLID SURFACE, SS-1 AT THIS LOCATION. REFER TO FINISH LEGEND.
- 4 SPACE FOR OWNER PROVIDED, CONTRACTOR INSTALLED APPLIANCE. 5 4" HIGH RESILIENT WALL BASE, RB-1. REFER TO FINISH LEGEND.
- 6 4" HIGH RESILIENT WALL BASE, RB-2. REFER TO FINISH LEGEND. 7 PROVIDE FINISHED PLASTIC LAMINATE END PANEL, PL-1.
- 8 PROVIDE BASE CORNER CABINET.
- 9 PROVIDE WALL CORNER CABINET. 10 WOOD BUTCHER BLOCK COUNTERTOP, WD-1 AT THIS LOCATION. REFER TO FINISH
- LEGEND. 11 PROVIDE GARBAGE DISPOSAL.
- 12 TALL TOTE TRAY CABINET. 13 TALL WARDROBE CABINET.
- 14 4'HX8'L MARKERBOARD. 15 STAINLESS STEEL COUNTERTOP, STS-1 AT THIS LOCATION. REFER TO FINISH LEGEND.
- 16 TALL TOTE TRAY AND SHELVING CABINET. 17 EPOXY BASE, EB-1. REFER TO FINISH LEGEND.







A761

# BES ADDENDUM #1 DRAWINGS 10/11/24

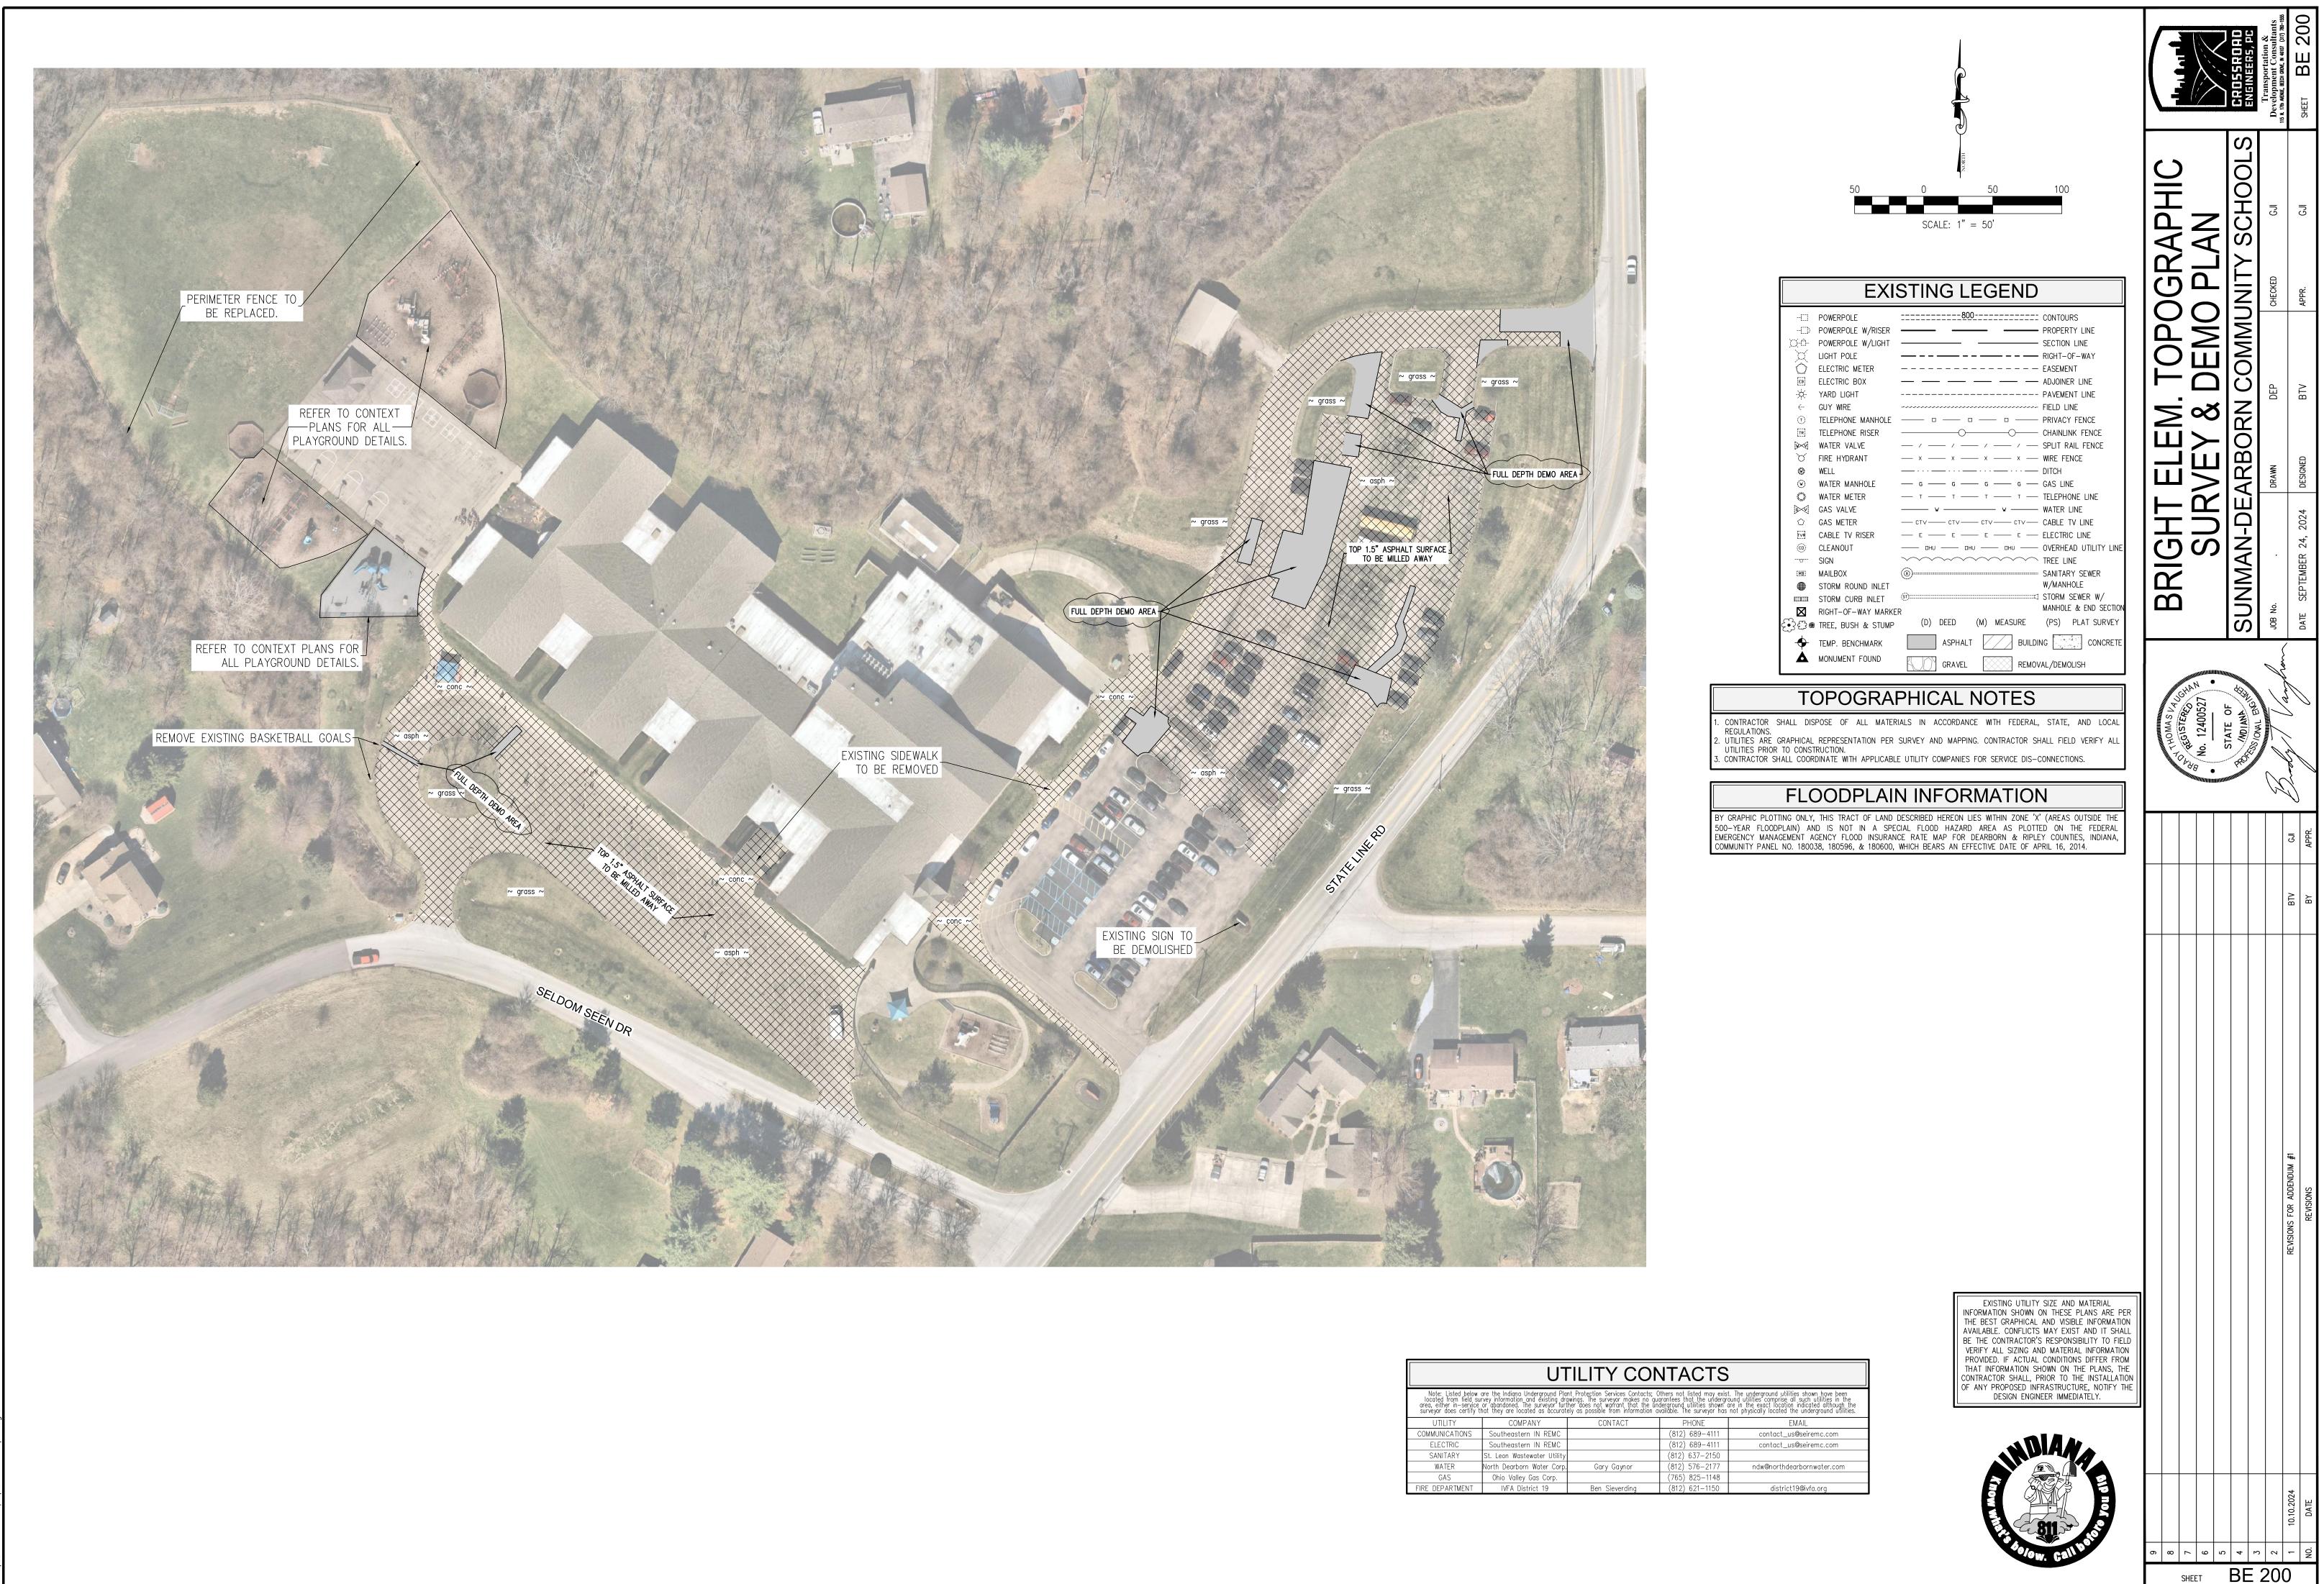


e		
	UT	<b>TILIT</b>
Note: Listed below located from field su area, either in-service surveyor does certify tl	are the Indiana Underground Pla rvey information and existing dro or abandoned. The surveyor furt hat they are located as accurat	nt Protection Ser awings. The surve ther does not wa ely as possible fr
UTILITY	COMPANY	CON
COMMUNICATIONS	Southeastern IN REMC	
ELECTRIC	Southeastern IN REMC	
SANITARY	St. Leon Wastewater Utility	
WATER	North Dearborn Water Corp.	Gary
GAS	Ohio Valley Gas Corp.	
FIRE DEPARTMENT	IVFA District 19	Ben Si

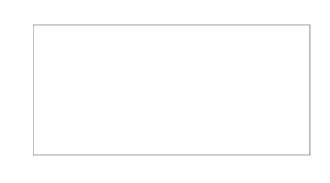

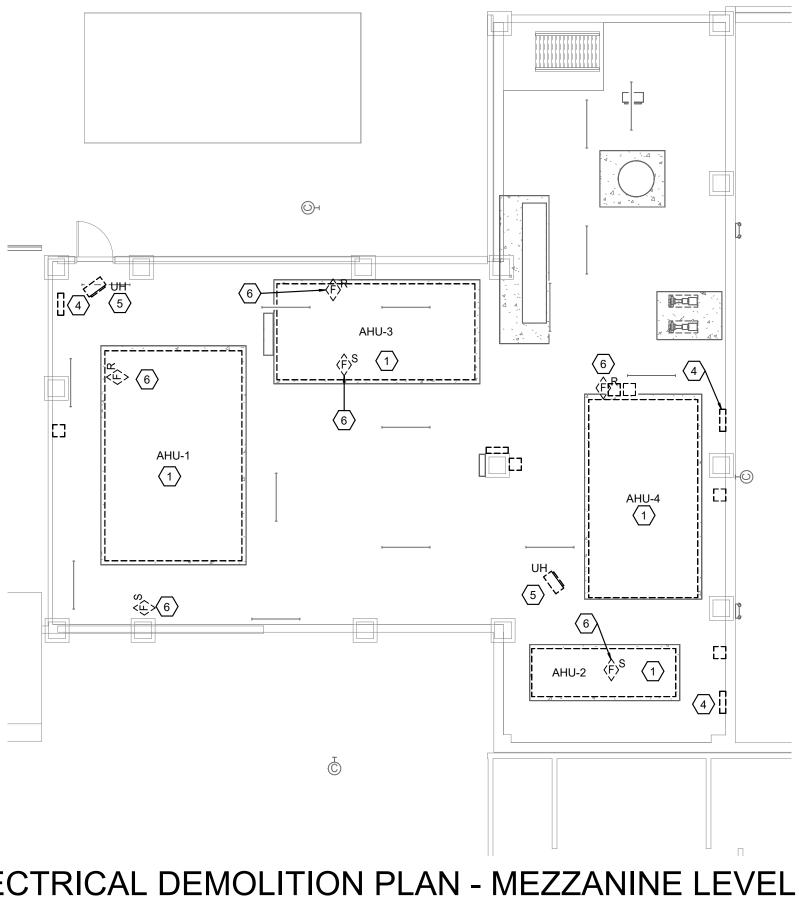



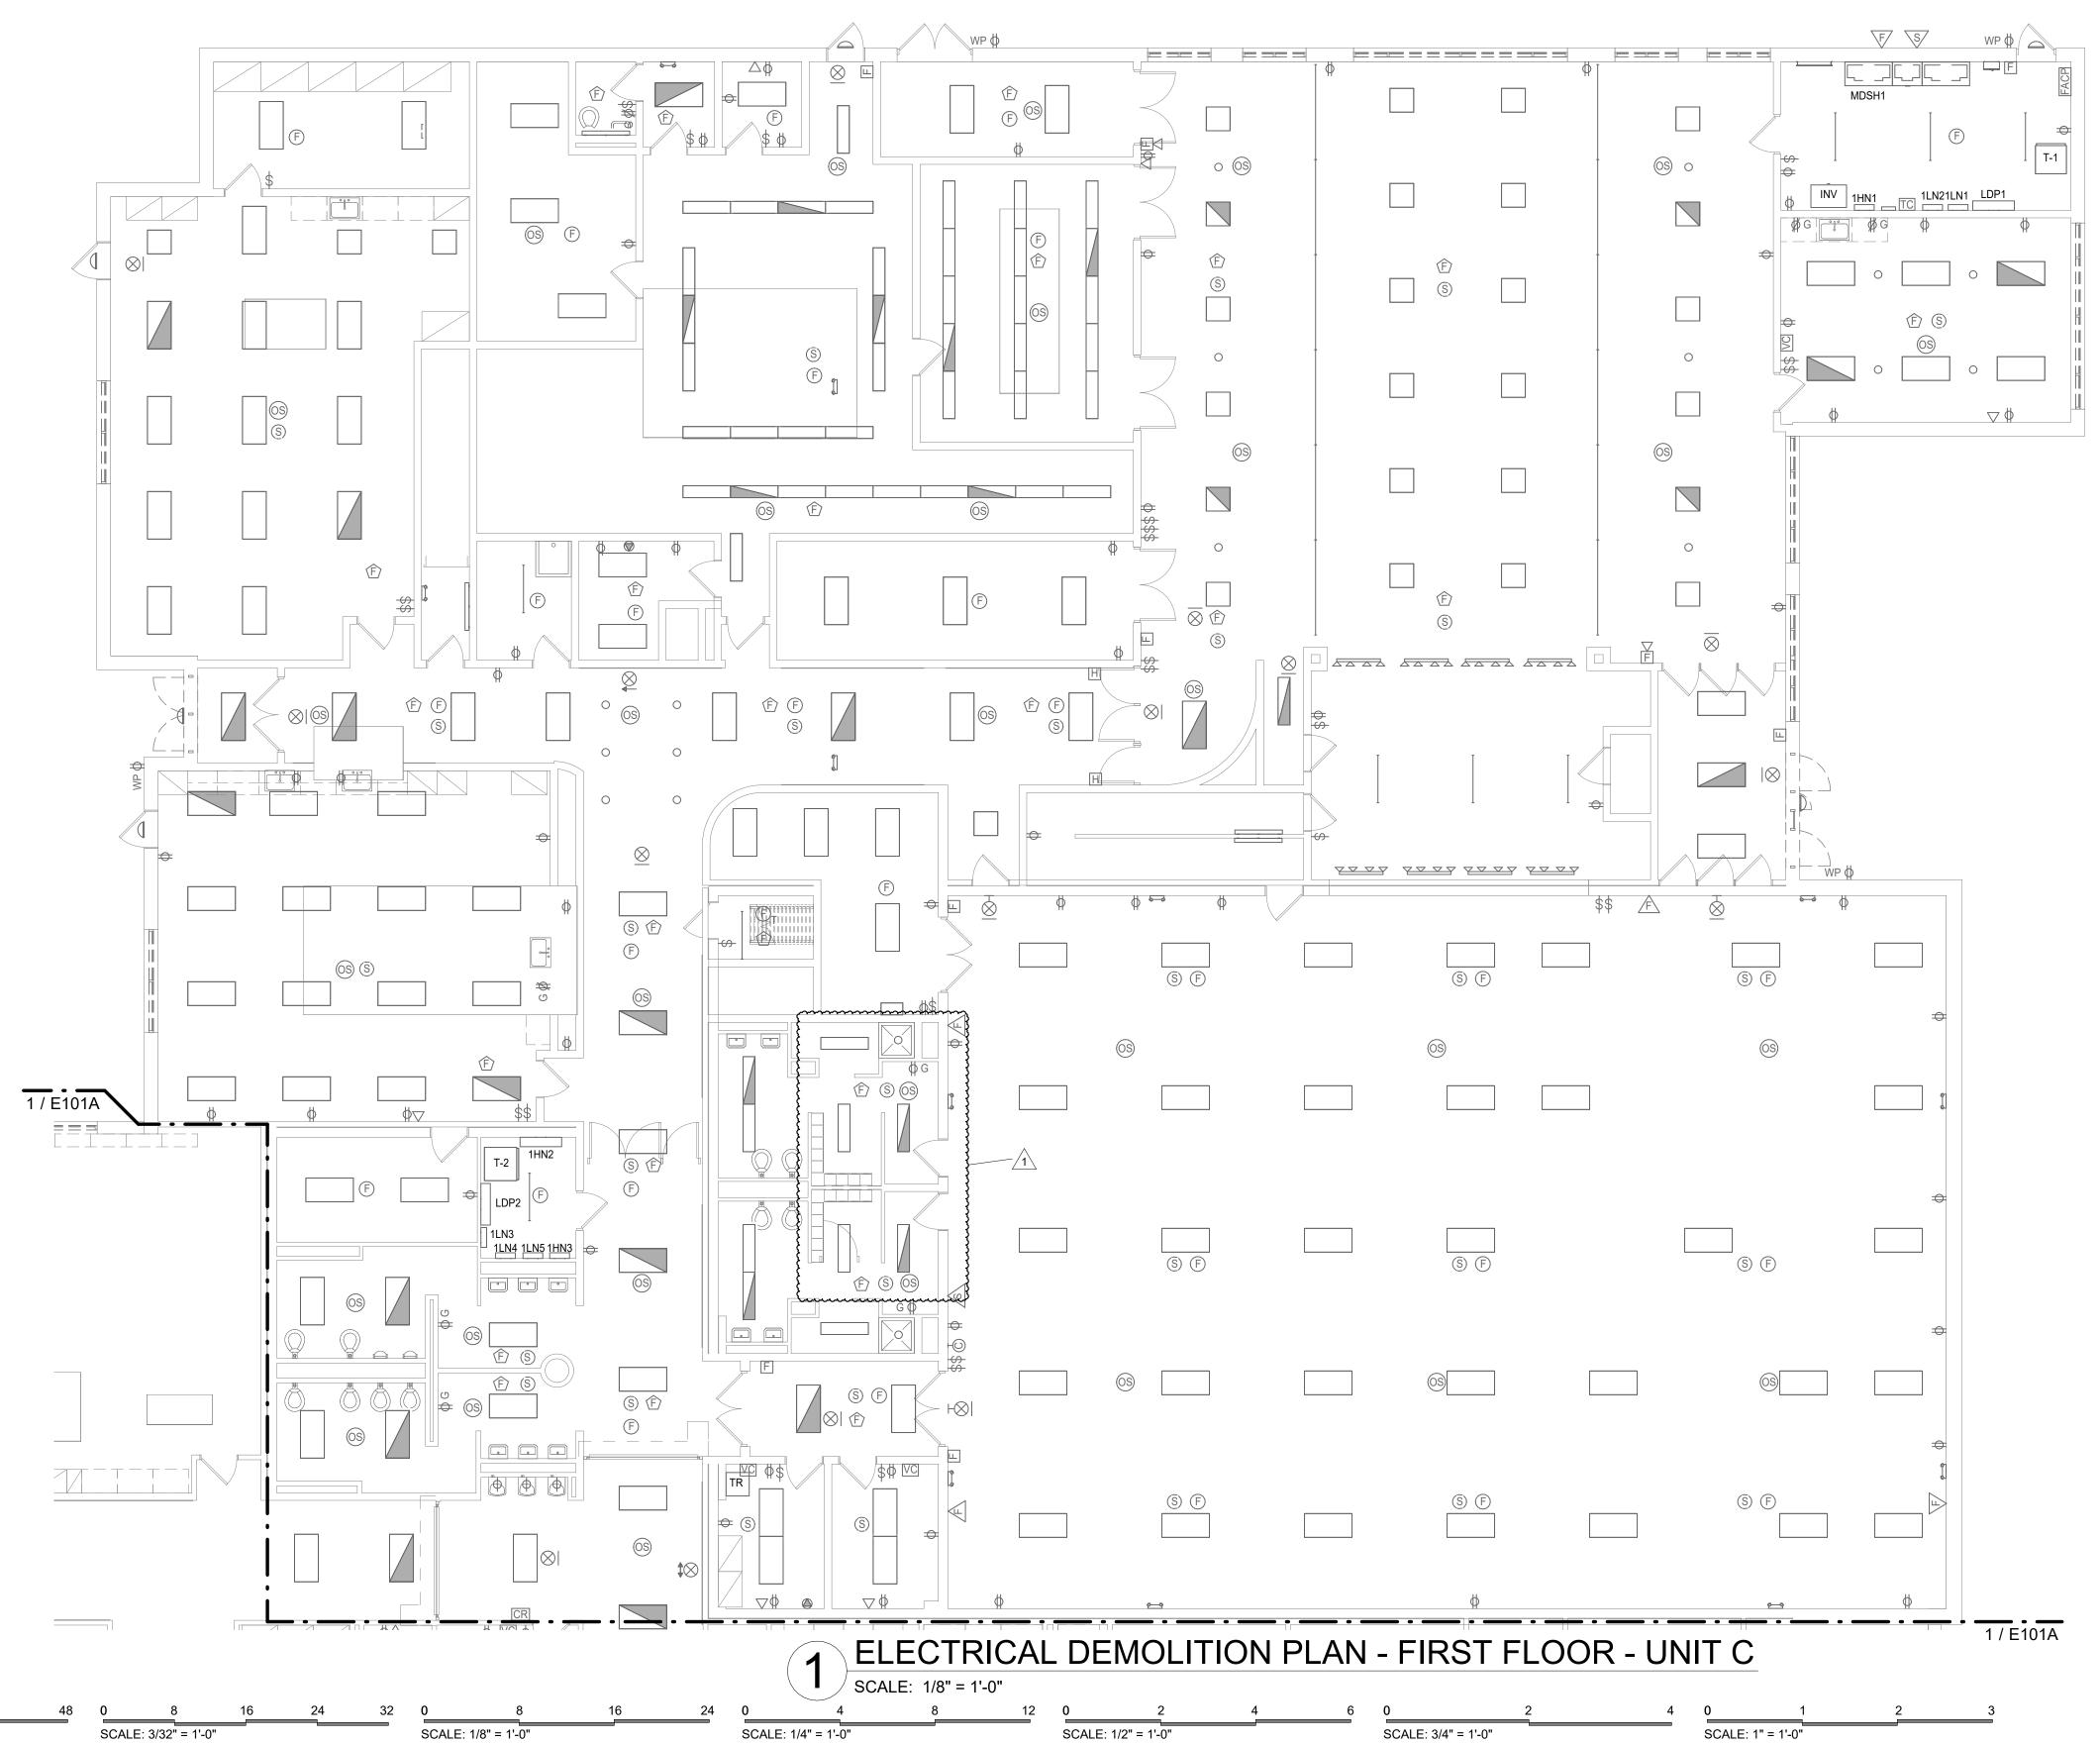


IF THE WHEEL PRINTED BELOW IS NOT SHOWN IN COLOR, THIS SET OF PRINTS IS NOT REPRESENTING ALL LINE TYPES CORRECTLY. CONTACT PRIMARY ENGINEERING FOR DIRECTIONS ON HOW TO OBTAIN A FULL COLOR SET OF PRINTS


SCALE: 1/16" = 1'-0"

### **DEMOLITION PLAN NOTES**

- DISCONNECT BRANCH CIRCUIT FROM AIR HANDLER. REMOVE ASSOCIATED VARIABLE SPEED DRIVE, CONDUCTORS AND CONDUIT BACK TO DRIVE. JUNCTION EXISTING BRANCH CIRCUIT, AS REQUIRED,
- TO BE EXTENDED TO NEW VARIABLE SPEED DRIVE. DISCONNECT FIRE ALARM CONTROL CABLING FROM AIR HANDLER THAT SERVES DUCT DETECTOR
- SHUT-DOWN. JUNCTION CABLING, AS REQUIRED, TO EXTEND TO NEW AIR HANDLER. DISCONNECT GAS WATER HEATER. REMOVE ASSOCIATED DISCONNECT, CONDUCTORS AND CONDUIT
- BACK TO SOURCE. DISCONNECT TEMPERATURE CONTROL PANEL. JUNCTION BRANCH CIRCUIT, AS REQUIRED, TO BE
- EXTENDED TO NEW TEMPERATURE CONTROL PANEL. DISCONNECT UNIT HEATER. JUNCTION BRANCH CIRCUIT, AS REQUIRED, TO BE EXTENDED TO NEW
- UNIT HEATER DISCONNECT FIRE ALARM CONTROL CABLING FROM AIR HANDLER THAT SERVES DUCT DETECTOR
- SHUT-DOWN. REMOVE DUCT DETECTOR AND ASSOCIATED SAMPLING TUBE FROM DUCTWORK. JUNCTION CABLING, AS REQUIRED, TO EXTEND TO NEW AIR HANDLER.
- REMOVE LIGHT FIXTURE AND ASSOCIATED FIXTURE WHIP BACK TO JUNCTION BOX.

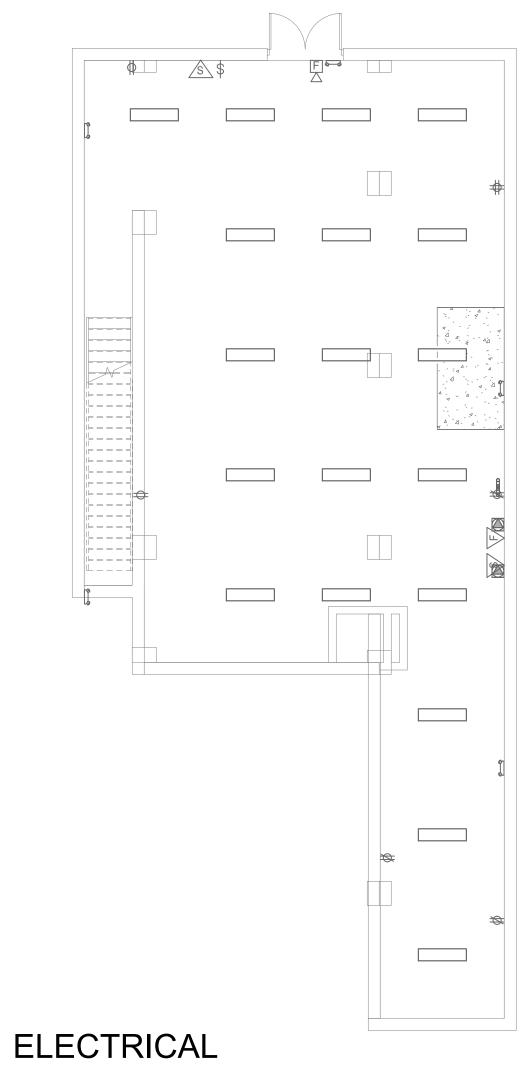


2 DEMOLITION PLAN - BASEMENT - UNIT C SCALE: 1/8" = 1'-0" <sup>/</sup> SCALE: 1/8" = 1'-0"  $\searrow$ 

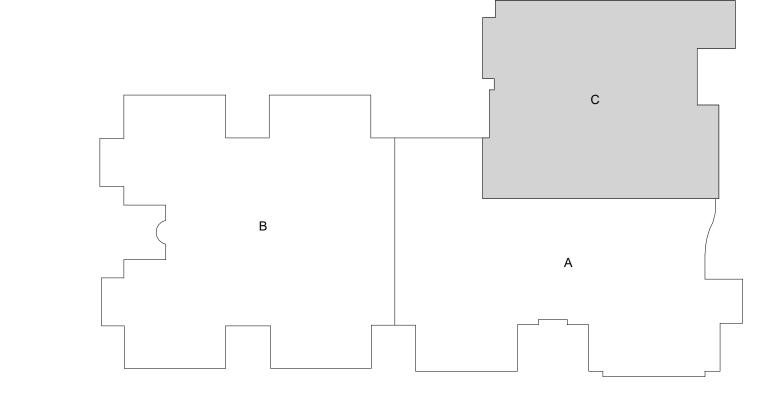




permitted to retain copies for information

and reference purposes. 2024 © Primary Engineering, Inc.

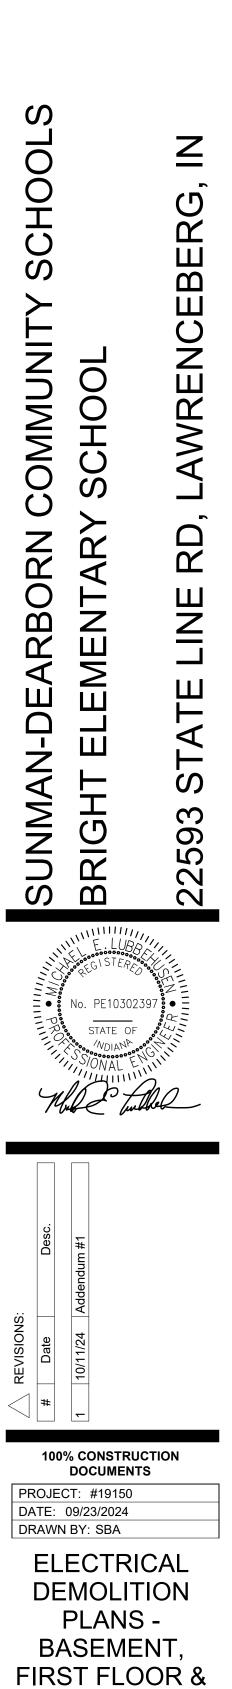


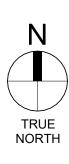



PRIMARY JOB # 24586


MEZZ. - UNIT C

E101C

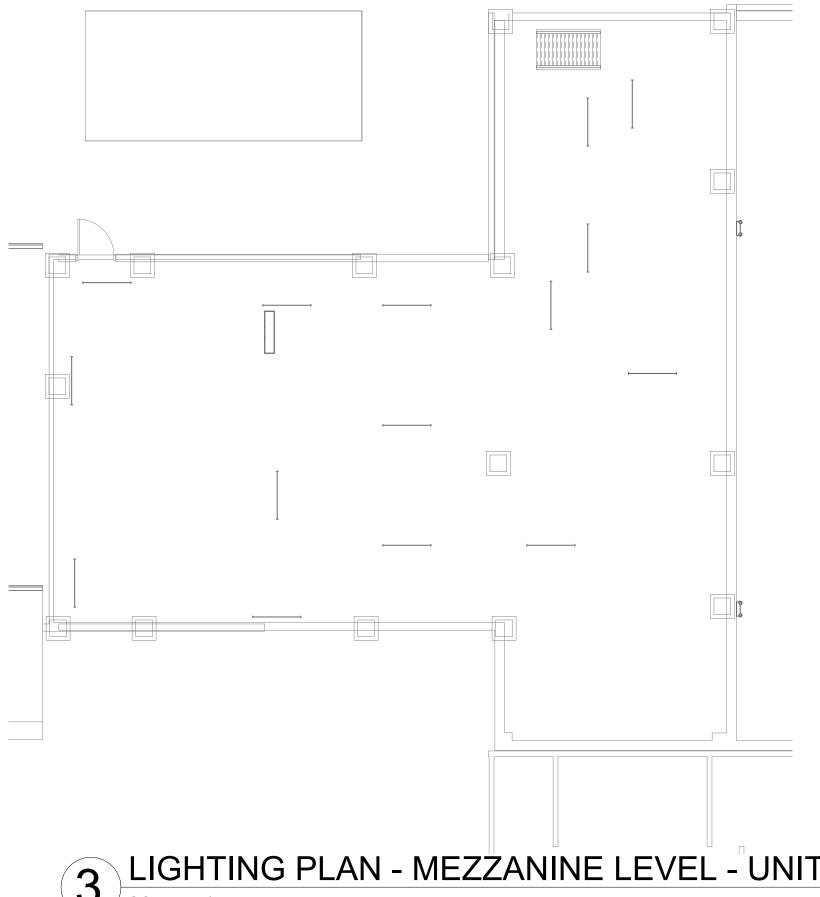


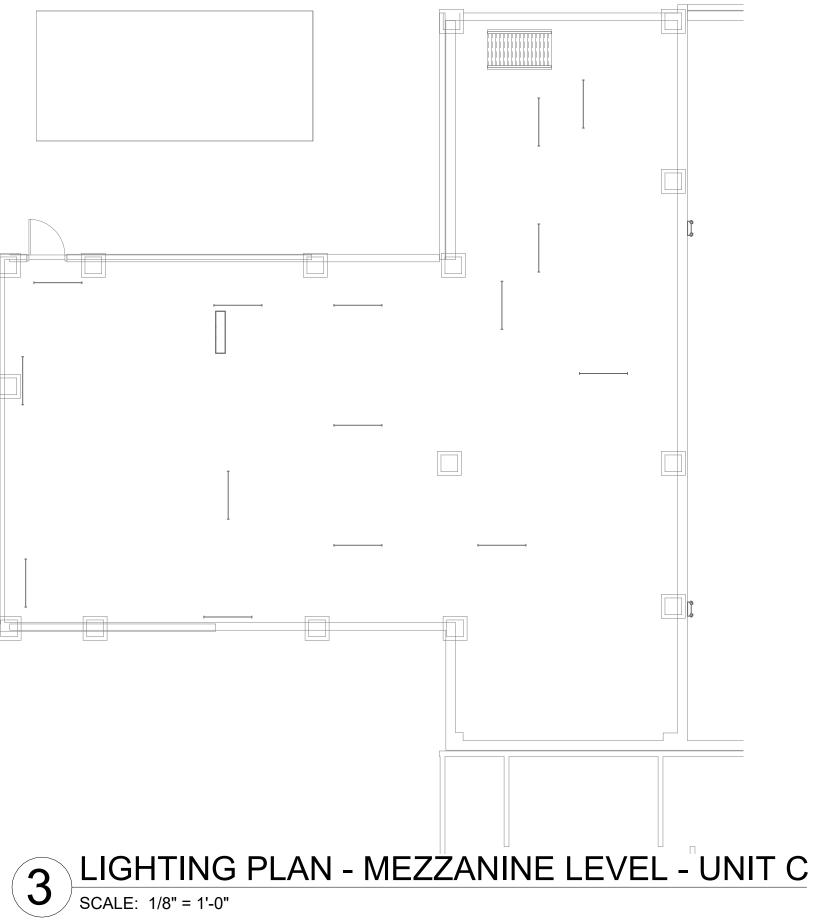


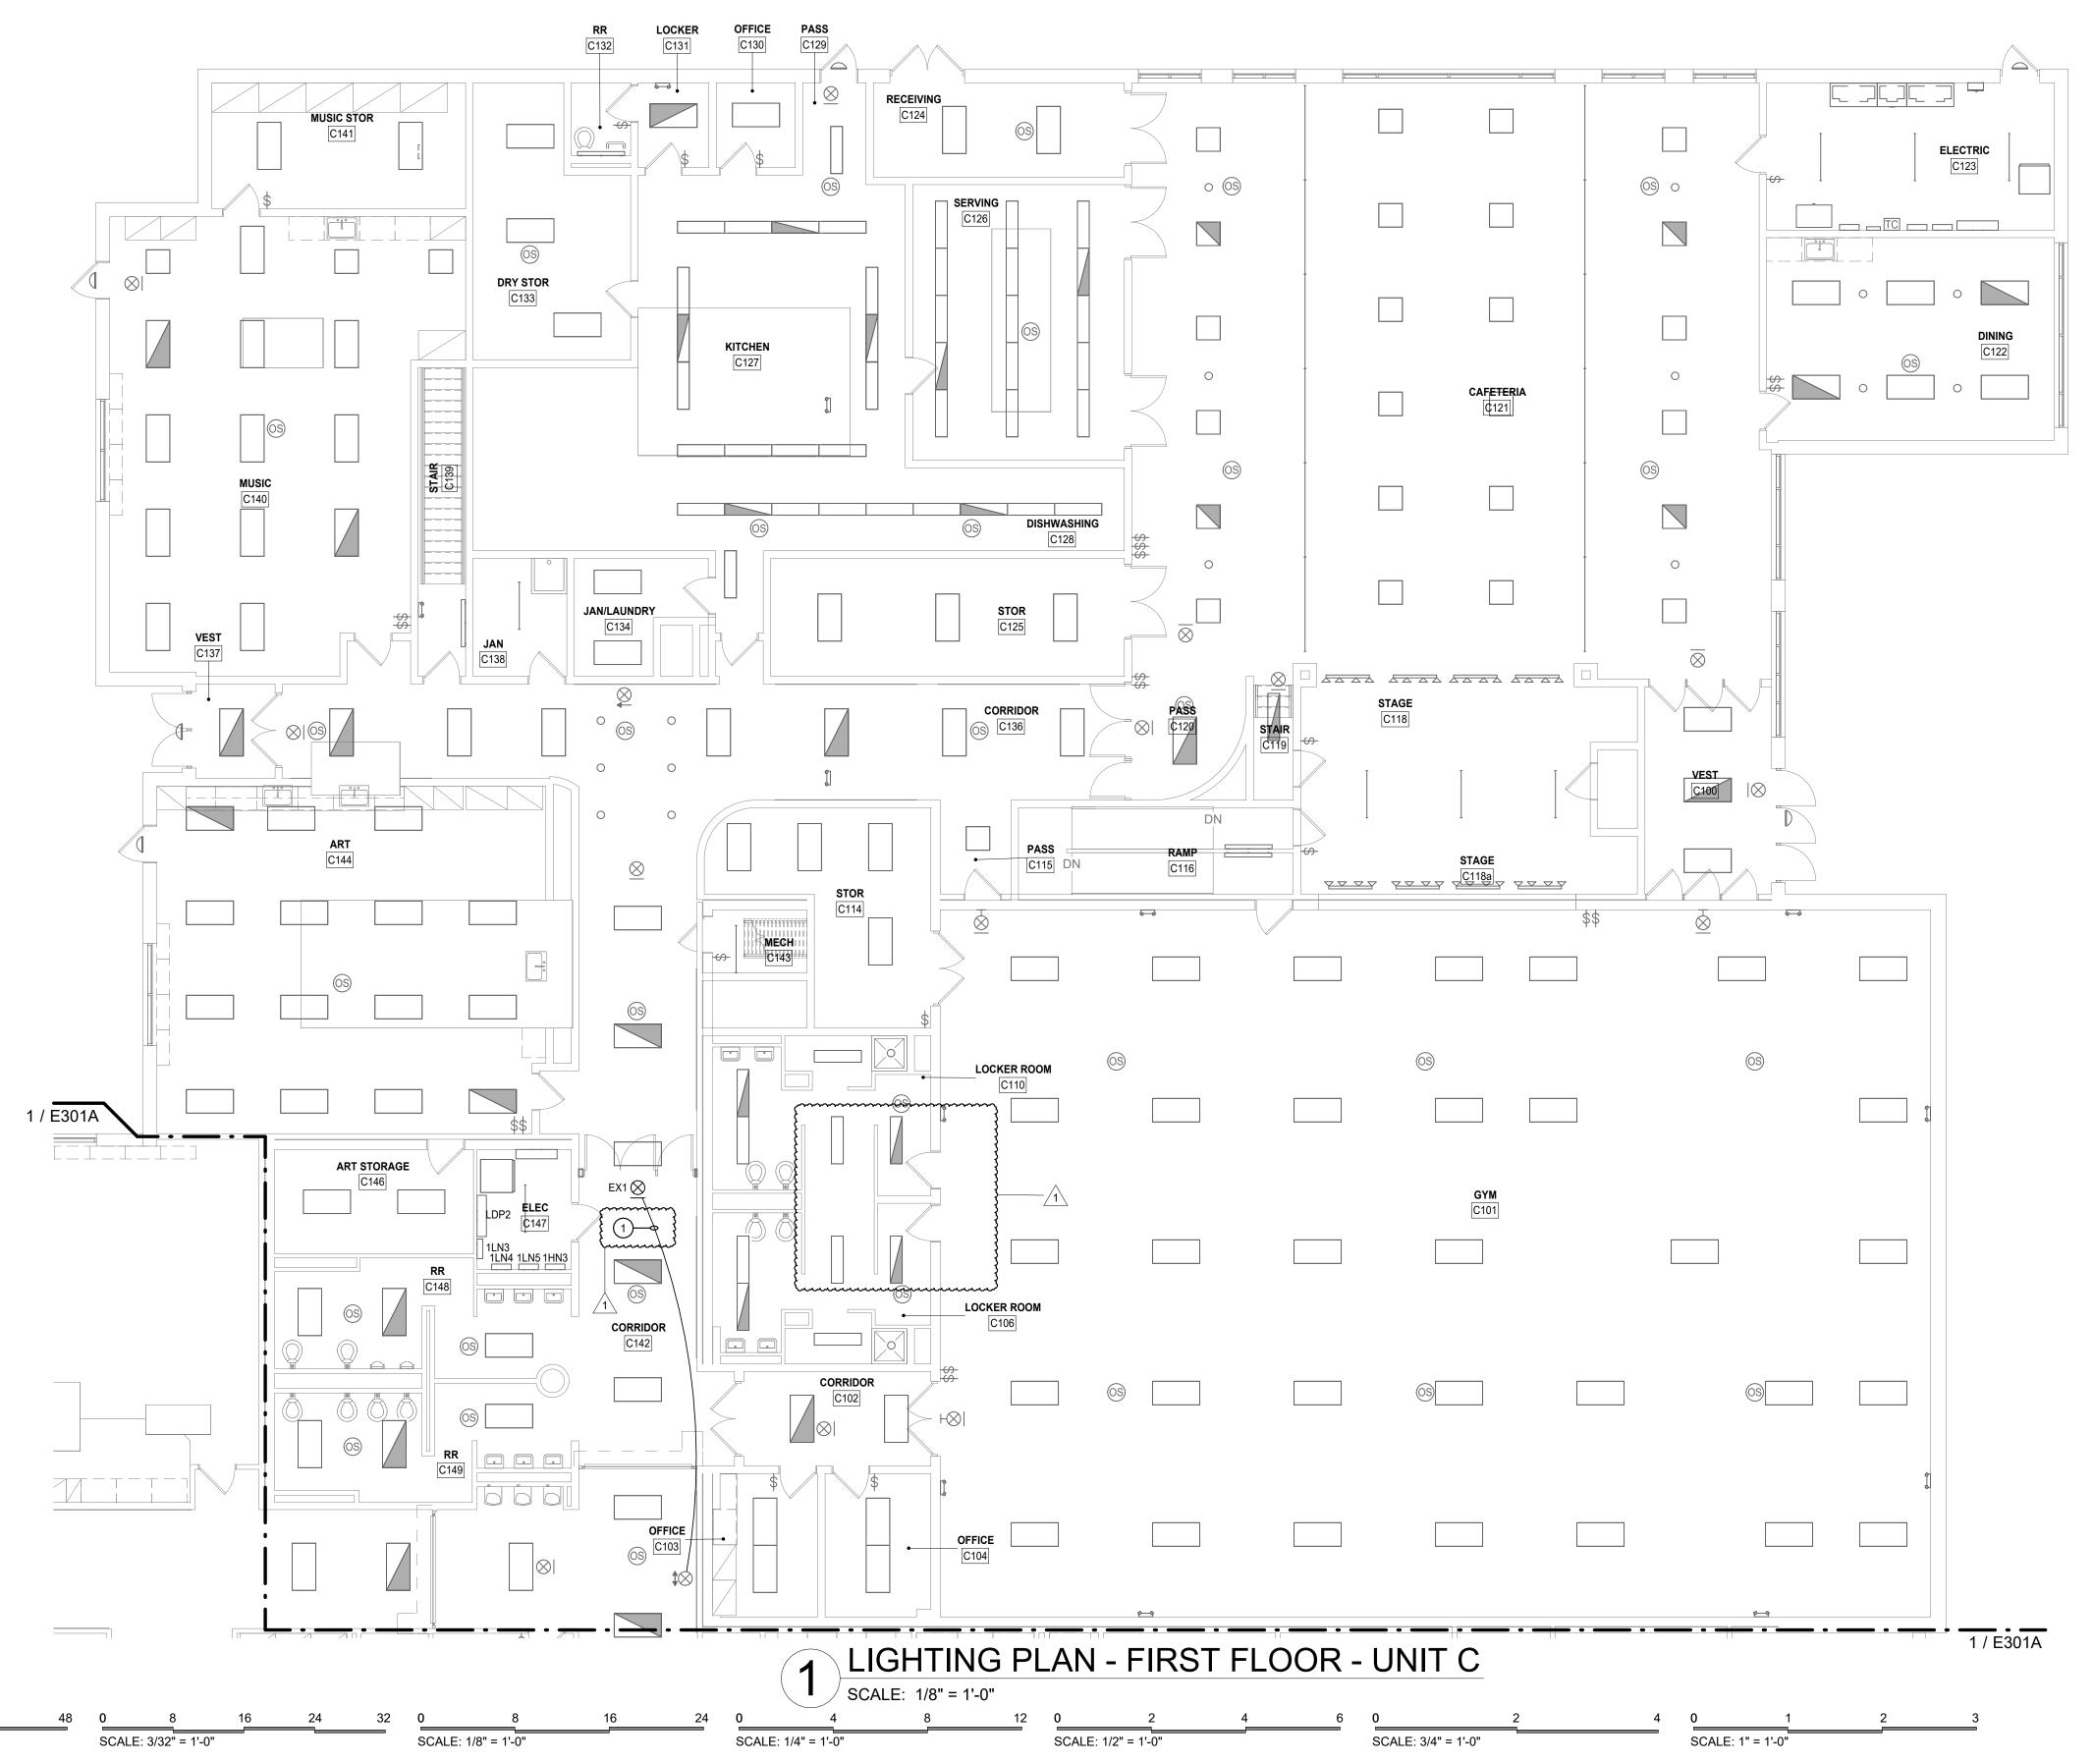

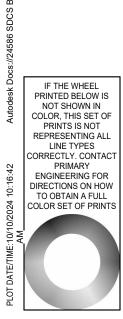


SCALE: 1/16" = 1'-0"

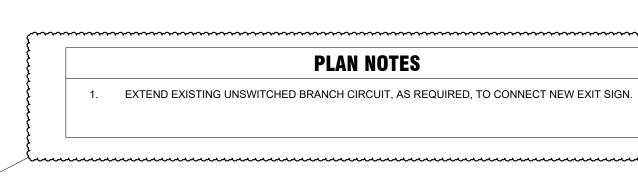


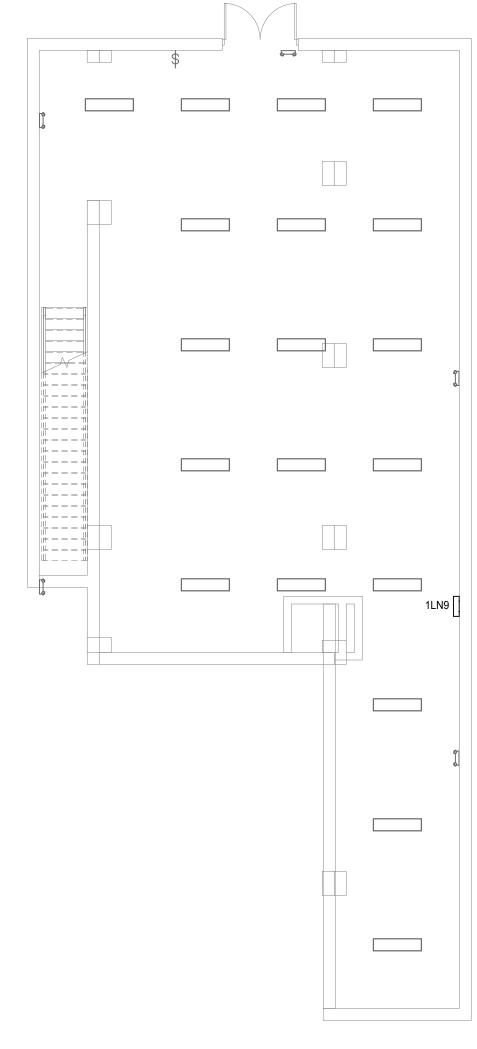



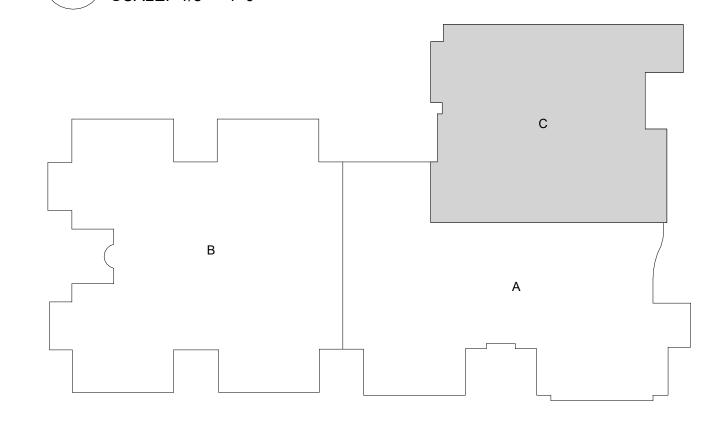




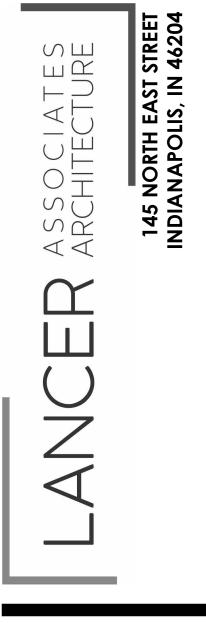

PRIMARY ENGINEERING INC Fort Wayne 2828 Lake Ave. 9785 Crosspoint Blvd., Suite 103 
 Fort Wayne, Indiana 46805
 Indianapolis, Indiana 46256

 260.424.0444 ph
 317.324.1221 ph
 info@primarv-eng.com www.primary-eng.com All concepts, ideas, plans, and details as

shown on this document are the sole property of Primary Engineering, Inc., and shall not be used for any other purpose without their expressed written consent. The project owner shall be permitted to retain copies for information and reference purposes. 2024 © Primary Engineering, Inc.

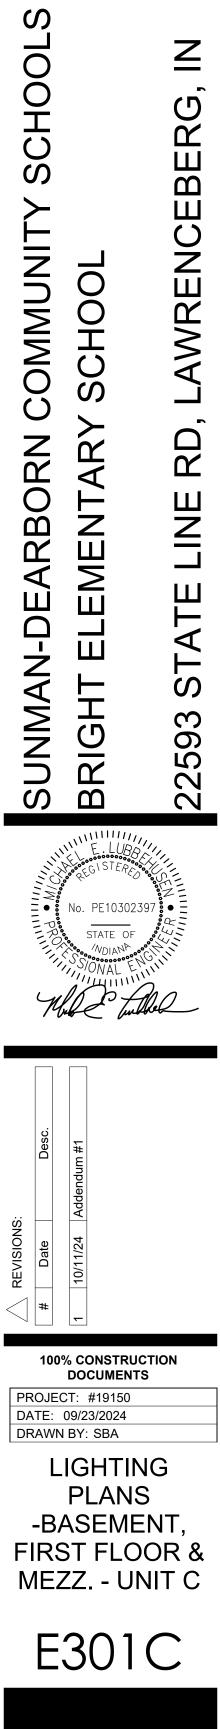




PRIMARY JOB # 24586

# NDES ADDENDUM #1 DRAWINGS 10/11/24



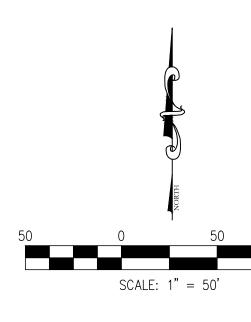

UTILITY CONTACTS									
Note: Listed below located from field su area, either in-service surveyor does certify t	are the Indiana Underground Plar rvey information and existing dra or abandoned. The surveyor furth hat they are located as accurate	nt Protection Services Contacts; C wings. The surveyor makes no gu- ner does not warrant that the un ly as possible from information a	)thers not listed may exis arantees that the undergr derground utilities shown a vailable. The surveyor has	t. The underground utilities shown have been ound utilities comprise all such utilities in the are in the exact location indicated although the not physically located the underground utilities.					
UTILITY	COMPANY	CONTACT	PHONE	EMAIL					
COMMUNICATIONS	Southeastern IN REMC		(812) 689-4111	contact_us@seiremc.com					
ELECTRIC	Southeastern IN REMC		(812) 689-4111	contact_us@seiremc.com					
SANITARY	St. Leon Wastewater Utility		(812) 637-2150						
WATER	North Dearborn Water Corp.	Gary Gaynor	(812) 576-2177	ndw@northdearbornwater.com					
GAS	Ohio Valley Gas Corp.		(765) 825-1148						
FIRE DEPARTMENT	IVFA District 19	Ben Sieverding	(812) 621-1150	district19@ivfa.org					

			EGEND	
[]]	POWERPOLE	800	)	CONTOURS
-[])	POWERPOLE W/RISER			PROPERTY LINE
) <u>C</u> -0-	POWERPOLE W/LIGHT			· SECTION LINE
X	LIGHT POLE			· RIGHT-OF-WAY
Ô	ELECTRIC METER			EASEMENT
EB	ELECTRIC BOX			· ADJOINER LINE
*	YARD LIGHT			PAVEMENT LINE
€	GUY WIRE		~~~~~~~~~~~~~~~~~~~~~~~~~~~~~~~~~~~~~~~	FIELD LINE
Ē	TELEPHONE MANHOLE	0 0	·	PRIVACY FENCE
TR	TELEPHONE RISER	O	O	CHAINLINK FENCE
	WATER VALVE	/ /	— / <u>— / —</u>	SPLIT RAIL FENCE
У	FIRE HYDRANT	x x	— x — x —	WIRE FENCE
Ø	WELL			DITCH
$\odot$	WATER MANHOLE	— G — G —	—	GAS LINE
Ô	WATER METER	— T — T —	— т — т —	TELEPHONE LINE
[\$>≪?]	GAS VALVE	w	w	WATER LINE
Ó	GAS METER	CTV CTV	— стv —— стv —	CABLE TV LINE
EV.	CABLE TV RISER	— е — е —	— E — E —	ELECTRIC LINE
$_{\odot}$	CLEANOUT	—— они —— он	и —— они ——	OVERHEAD UTILITY LIN
0	SIGN	$\sim$	$\sim \sim \sim \sim$	TREE LINE
[MB]	MAILBOX	(i)		SANITARY SEWER
	STORM ROUND INLET			W/MANHOLE
123423	STORM CURB INLET	(ST):	τ.	•
$\boxtimes$	RIGHT-OF-WAY MARKE			MANHOLE & END SECTIO
€€€	TREE, BUSH & STUMP	(D) DEED	(M) MEASURE	(PS) PLAT SURVEY
•	TEMP. BENCHMARK	ASPHALT	BUILDI	
À	MONUMENT FOUND			
		GRAVEL	REMO	VAL/DEMOLISH
Т	OPOGRAI	PHICAL	NOTES	

 UTILITIES ARE GRAPHICAL REPRESENTATION PER SURVEY AND MAPPING. CONTRACTOR SHALL FIELD VERIFY ALL UTILITIES PRIOR TO CONSTRUCTION.
 CONTRACTOR SHALL COORDINATE WITH APPLICABLE UTILITY COMPANIES FOR SERVICE DIS-CONNECTIONS.

## FLOODPLAIN INFORMATION

BY GRAPHIC PLOTTING ONLY, THIS TRACT OF LAND DESCRIBED HEREON LIES WITHIN ZONE 'X' (AREAS OUTSIDE THE 500-YEAR FLOODPLAIN) AND IS NOT IN A SPECIAL FLOOD HAZARD AREA AS PLOTTED ON THE FEDERAL EMERGENCY MANAGEMENT AGENCY FLOOD INSURANCE RATE MAP FOR DEARBORN & RIPLEY COUNTIES, INDIANA, COMMUNITY PANEL NO. 180038, 180596, & 180600, WHICH BEARS AN EFFECTIVE DATE OF APRIL 16, 2014.

<u>NOTE:</u> SECTION LINES, PROPERTY LINES, AND RIGHT-OF-WAY LINES ARE BASED ON GIS IMAGERY. CONTRACTOR WILL NEED TO FIELD VERIFY BEFORE CONSTRUCTION BEGINS.

EXISTING UTILITY SIZE AND MATERIAL INFORMATION SHOWN ON THESE PLANS ARE PER THE BEST GRAPHICAL AND VISIBLE INFORMATION AVAILABLE. CONFLICTS MAY EXIST AND IT SHALL BE THE CONTRACTOR'S RESPONSIBILITY TO FIELD VERIFY ALL SIZING AND MATERIAL INFORMATION PROVIDED. IF ACTUAL CONDITIONS DIFFER FROM THAT INFORMATION SHOWN ON THE PLANS, THE CONTRACTOR SHALL, PRIOR TO THE INSTALLATION OF ANY PROPOSED INFRASTRUCTURE, NOTIFY THE DESIGN ENGINEER IMMEDIATELY.



						ENGINEERS, PC	Transportation & Development Consultants		SHEET NUE ZUU
				-	S IOOHOS	_	GJI	-	GJI
			Ŷ				CHECKED		APPR.
	-AKKOKN		APHIC: SI		RN COMMI		DEP		BIV
					FARRO		DRAWN	+	DESIGNED
	Y C Y C Y		10	5	SUNMAN-DEARBORN COMMUNITY SCHOOLS		JOB No.		DATE SEPTEMBER 24, 2024
	THOMAS LAL	A REGISTERED OF	No. 12400527		A INDIANE	ESS/ONAL ENCL	R ITTI	Fredy Cange and	l l
								CJI	APPR.
								BTV	ВΥ
								REVISIONS FOR ADDENDUM #1	REVISIONS
								10.10.2024	DATE
6	8	7	9	5			5 T		NO.

SHEET NDE 200

# **GENERAL NOTES**

A. CONTRACTOR TO VERIFY EXISITING CONDITIONS AND REPAIR ALL EXISTING WALLS, SLAB, AND CEILINGS TO A CONDITION SUITABLE FOR ACCEPTING NEW FINISHES AS PER MANUFACTURER'S RECOMMENDED INSTALLATION METHODS. MINIMUM LEVEL 4 FINISH ON EXISTING AND NEW WALLS, UNLESS NOTED OTHERWISE.
B. ALL FLOORING TRANSITIONS TO COMPLY WITH ADA GUIDELINES AND TO OCCUR UNDER CENTER OF DOORWAYS AND OR AT CENTERLINE OF WALL, UNLESS INDICATED DIFFERENTLY ON FINISH PLANS. PROVIDE REDUCER STRIPS WHEREVER CARPET OR LVT MEET CONCRETE.
C. CONTRACTOR TO PROVIDE PROTECTION AS NEEDED DURING CONSTRUCTION. IF, ANY, TO PERSERVE NEW FINISHES WHILE COMPLETING CONSTRUCTION.
D. CONTRACTOR SHALL BE RESPONSIBLE FOR VERIFICATION OF DIMENSIONS AND JOB CONDITIONS. ANY DEVIATION FROM WHAT IS INDICATED ON THE FINISH PLANS SHALL BE BROUGHT TO THE ATTENTION OF THE ARCHITECTS AND DESIGNERS. ALL DIMENSIONS SHOWN ARE TO FACE OF FINISH MATERIAL, UNLESS NOTED OTHERWISE.
E. WHERE WALLS ARE INDICATED TO RECEIVE PAINT FINISH, PRIME AND PAINT GRILLES, FIRE EXTINGUISHER CABINETS, AND OTHER ITEMS EMBEDDED IN WALL CONSTRUCTION TO MATCH SURFACE ON WHICH THEY OCCUR.
F. CONTRACTOR TO PROVIDE DRYWALL REVEAL JOINT WHERE DRYWALL MEETS DISSIMILAR MATERIALS.
G. CONTRACTOR TO PROVIDE SCHLUTER EDGE WHERE TILE MEETS DISSIMILAR MATERIALS. REFER TO INTERIOR ELEVATIONS FOR FURTHER DETAILS.
H. DO NOT INSTALL GYPSUM BOARD BEHIND TILE BACKER BOARD LOCATIONS.
. IF ONLY PAINT IS INDICATED AS THE FINISH, REFER TO ARCHITECTURAL FLOOR PLANS FOR SUBSTRATE INFORMATION.
J. ALL MECHANICAL CLOSETS TO HAVE A SEALED CONCRETE FLOOR FINISH. PROVIDE RESILIENT TRANSITION STRIP TO MATCH RB-1.
K. ALL WALLS, COLUMNS, AND CEILINGS TO BE PAINTED PT-1, UNLESS NOTED OTHERWISE.

# FINISH LEGEND

## NOTES

ETR EXISTING TO REMAIN TBD TO BE DETERMINED

## FLOOR COVERING

RESILIE	NT FLOOR	
EPX-1:	MFG:	SHERWIN WILLIAMS HIGH
		PERFORMANCE FLOORING
	TYPE:	RESUFLOR DECO QUARTZ BC23
		EPOXY SYSTEM
	COLOR:	MIX TO MATCH EXISTING, SIMILAR
		COLOR TO PEBBLED PATH,
		DESIGNER TO APPROVE BEFORE
		INSTALL.
	INSTALL:	MONOLITHIC, 6" INTEGRAL COVE
		BASE, REF. SPECS
	LOCATION:	RESTROOM
	CONTACT:	KAREN E. GALVIN 317-714-5610

### RUB-1: MFG: NORA TYPE: RUBBER SHEET PATTERN: NORAPLAN CONVIA

COLOR: PEARL GRAY 7351 INSTALL: MONOLITHIC, 6" INTEGRAL COVE BASE, REF. SPECS LOCATION: QUIET ROOM CONTACT: ROB GROM 317-764-9025 WALL BASE

# RESILIENT BASE RB-1: MFG: TARKETT JOHNSONITE TYPE: 4" RESILIENT WALL BASE COLOR: 20 CHARCOAL

LOCATION: TYPICAL, UNLESS NOTED OTHERWISE REMARKS: TO PATCH EXISTING BASE AS NEEDED. RB-2: MFG: NORA TYPE: INTEGRAL RUBBER WALL BASE

PATTERN: NORAPLAN CONVIA COLOR: PEARL GRAY 7351 INSTALL: MONOLITHIC, 6" INTEGRAL COVE BASE, REF. SPECS LOCATION: QUIET ROOM REMARKS: CAP RUBBER BASE WITH

CONTACT: ROB GROM 317-764-9025 EPOXY BASE EB-1: MFG:

INSTALL: INSTALL: MONOLITHIC, 6" INTEGRAL COVE BASE, REF. SPECS LOCATION: RESTROOM CONTACT: KAREN E. GALVIN 317-714-5610

### PAINT/WALL FINISH

PAINT PT-1:	MFG: TYPE: COLOR: LOCATION: REMARKS:	SHERWIN WILLIAMS REF. SPECS FOR TYPE TO MATCH SCHOOL STANDARD WHITE WALL PAINT TYPICAL COLOR AND SHEEN TO MATCH SCHOOL STANDARD CLASSROOM WALL PAINT. COLOR TO BE APPROVED BY DESIGNER.
WALL T WT-1:	ILE MFG: TYPE: PATTERN: COLOR: GROUT:	DALTILE 12" X 24" GLAZED PORCELAIN TILE VOLUME 1.0 STEREO GREY VL73 MAPEI 93 WARM GRAY

INSTALL: HORIZONTAL 1/3 OFFSET LOCATION: RESTROOM WALLS CONTACT: ROBIN BRADFORD 317-946-0823 mmmmmmmmmmmm

PERFORMANCE FLOORING TYPE: **RESUFLOR DECO QUARTZ BC23** EPOXY SYSTEM COLOR: MIX TO MATCH EXISTING, SIMILAR COLOR TO PEBBLED PATH, DESIGNER TO APPROVE BEFORE INSTALL.


# SHERWIN WILLIAMS HIGH

SCHLUTER RONDEC-MC TRIM.

ALUMINUM BRUSHED NICKEL.

COLOR TO BE ANODIZED




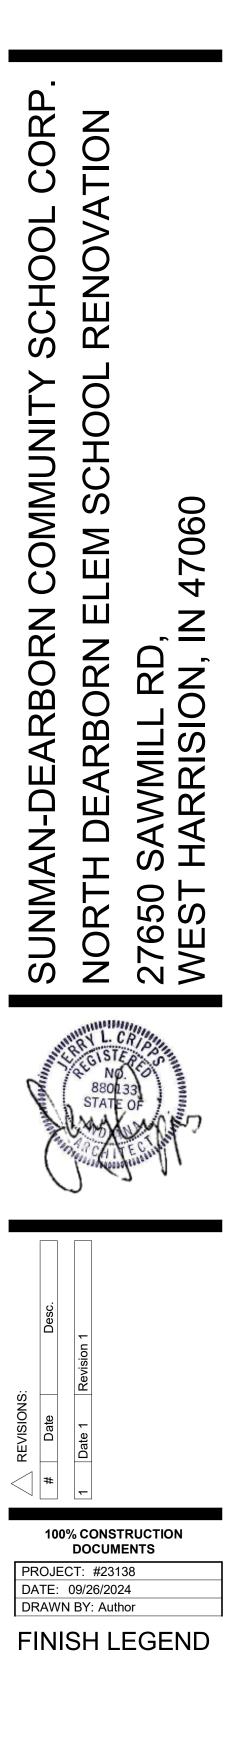

A720




		PLAN NOTES
	1.	COORDINATE LOCATION, ROUGH-IN AND ELECTRICAL REQUIREMENTS WITH C APPROVED SHOP DRAWINGS PRIOR TO ROUGH-IN. REFER TO EQUIPMENT SC FOR ADDITIONAL INFORMATION.
~~~~~~~~~~~~~~~~~~~~~~~~~~~~~~~~~~~~~~~	$\sim$	~~~~~~~~~~~~~~~~~~~~~~~~~~~~~~~~~~~~~~~
, }	2.	CONTRACTOR SHALL MAKE FINAL CONNECTION TO GFCI RECEPTACLE MOUN EQUIPMENT.
	3.	PROVIDE AND INSTALL NEW 20A/1P CIRCUIT BREAKER IN EXISTING SPARE IN F

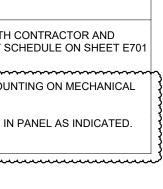





Fort WayneIndianapolis2828 Lake Ave.9785 Crosspoint Blvd., Suite 103Fort Wayne, Indiana 46805Indianapolis, Indiana 46256260.424.0444 ph317.324.1221 phinfo@primary-eng.comwww.primary-eng.com

All concepts, ideas, plans, and details as shown on this document are the sole property of Primary Engineering, Inc., and shall not be used for any other purpose without their expressed written consent. The project owner shall be permitted to retain copies for information and reference purposes. 2024 © Primary Engineering, Inc.

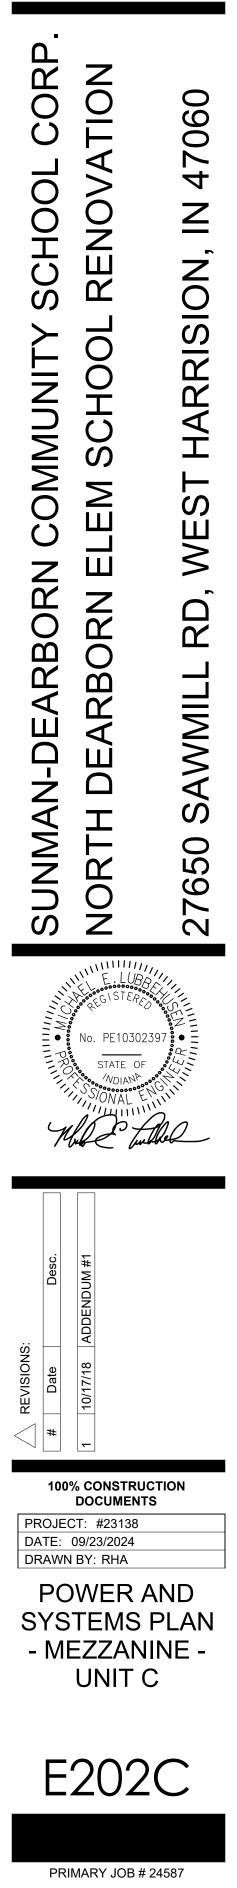

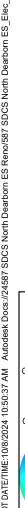

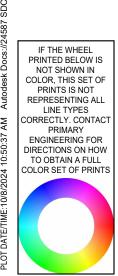


		LIGHT FIXTU	RE SCHEDU	JLE			EQUIPMENT SCHEDULE					DULE	<u>:</u>					
TAG	MANUFACTURER'S CATALOG NUM	BER MAX. WATTS	MOUNT MIN. LUMEN OUTPUT *(D/l)	CCT CRI	DESCRIPTION	REMARKS	ATION	NO			CIRCUIT INFORMATION		DISCON	NECT	A	FREQUE	RIABLE NCY/SPEED (VFD/VSD)	
L1	ALS #LPTW-4-WH-UD NEW STAR #AGG-G-24-OP-UN-TW0-CW56WATTS LITHONIA #CPXTW 2X4 TUWH RHYR 6000LM 80CRI SWL MVOLT NLT	56	RECESSED 4750-5250 60		120-277V, 2'X4' COLOR TUNNING FLAT PANEL. ELECTRONIC 0-10V DIMMING DRIVER WIT RANGE FROM 100% TO 10%. UL LISTED	H 1	QUIPMENT DESIGN	QUIPMENT LOCATI	QUIPMENT LOAD	OLTAGE/PHASE	CONDUIT AND CONDUCTOR SIZE	BRANCH CIRCUIT DESIGNATION	ROVIDED BY USED OR ON-FUSED EMA ENCLOSURE	SCONNECT WITCH SIZE JSE RATING	QUIPMENT MOUNTE ONTROL PANEL	TOVIDED BY	ISTALLED BY	REM
L1A L2	METALUX #24FPSL2SCT3-MED COLUMBIA #CFP24-LSCS LITHONIA #CPX-2X4-AL08-80CRI-SWW7-SWL-MVOLT	40	RECESSED 4,291 40	000 80	120-277V, 2'X4' LED FLAT PANEL WITH SELECTABLE LUMENS AND COLOR TEMPERAUTRE. 0-10V ELECTRONIC DIMMING TO 10% UL LISTED. COLOR TEMPERATUF AND LUMEN OUTPUT TO BE SET AT FACTORY AS INDICATED	E	ACCU-A1 ACCU-B1 ACCU-B1		20 MCA 47.7 MCA	480V/3PH	1"C,3-#6,1-#10G	14C1-14(16,18)		25A 30A			~~~~ <u>~~~~</u> ~~~~~~~~~~~~~~~~~~~~~~~~~~~~	
L2A		SAME AS L2 EXCEPT WITH		RTER			B-2	UNIT C	7.5 MCA			14E2-7(9,11)						+
GENERAL R	EMARKS:											(0,)						
	TOR SHALL REFER TO DRAWINGS FOR LOCATIONS THAT REQUIRE DRYW	ALL FRAMES FOR RECESSED FIXTURES.					EF-1 EF-2 MAU-1 P-1 P-2	UNIT C RM. 224B UNIT C UNIT C UNIT C	2.0 HP 128 W 5.0 HP 15.0 HP 15.0 HP	208V/1PH 120V/1PH 208V/3PH 480V/3PH 480V/3PH	3/4"C,2-#12,1-#12G 3/4"C,3-#8,1-#10G 3/4"C,3-#8,1-#10G	12E2-37(39) 22A1-38 12DK1-28(30,32) 14E2-25(27,29) 14E2-31(33,35)	INT Constraints of the second	20A		MC MC	EC EC	
			LIGHTING	SEN	SOR SCHEDULE		SCHEDULE	ABBREVATIONS										
	TAC	MANUFACTURER'S CATALOG NUMBE	INDUT		REMARKS	REMARKS	A EC	AMPACITY ELECTRICAL CO		HLO HOA	HIGH/LOW/OFF SWITCH HAND/OFF/AUTO	NF N	IOMENTARY HIGH/LO ION-FUSED					
	01	WATTSTOPPER #DT-300 SENSOR SWITCH #CM-PDT-9-R GREENGATE #OAC-DT-R HUBBELL #OMNI-DT-XXXX-RP WATTSTOPPER #BZ150	24V CI	EILING	DUAL TECHNOLOGY CEILING SENSOR WITH A COMBINATION OF ULTRASONIC AND PASSIVE INFRARED. SENSOR TO BE EQUIPPED WITH SELF ADJUSTING TECHNOLOGY AND ISOLATED RELAY OUTPUTS. SENSOR SHALL OPERATE AS AUTOMATIC "ON" AND AUTOMATIC "OFF" WITH A 15 MINUTE TIME DELAY.	1	FFUSEDIFLAFULL LOAD AMPSLFVNRFULL VOLTAGE NON-REVERSINGMFVRFULL VOLTAGE REVERSINGM			HP INT LOR M MC MCA	HORSE POWER INTEGRAL WITH EQUIPMENT LOCAL/OFF REMOTE SWITCH MOMENTARY ON/OFF SWITCH MECHANICAL CONTRACTOR MIN CIRCUIT AMPACITY	GRAL WITH EQUIPMENTRLARUNNING LOAD AMPSAL/OFF REMOTE SWITCHSON/OFF SWITCHENTARY ON/OFF SWITCHWWATTSHANICAL CONTRACTORXA/YPX AMP CIRCUIT BREAKER, Y POLE		ER, Y POLE				
	PP	SENSOR SWITCH #PP20	120/277V ACC	UARE BOX ABOVE CESSIBLE EILING	BE 20A RATED.			D EXISTING BRANC	H CIRCUITS, AS I		MOMENTARY HIGH/LOW SWITCH							
	2. 120/2	INDE POWER PACKS AS REQUIRED TO OPERATE LIGH		PLANS		1	3. REPLAC 4. REPLAC	CE EXISTING 30A/31 CE EXISTING 50A/31	P CIRCUIT BREAK P WITH NEW 35A/	KER WITH NEV /3P CIRCUIT E	TO SERVE NEW EXHAUST FAN. CONTRA W 40A/3P CIRCUIT BREAKER. BREAKER. IROUGH NEW CONTRACTOR FOR BOILE		NATE EXHAUST FAN T	U TWO (2) PHASE	OF CIRC	UII BREAKE	<b>н</b> .	


	LIGHT FIXTUR	RE S	CHE	DUI	LE							EQUIPMEN	IT SCH	EDl	JLE					
ALOG NUMBE	R MAX. WATTS	MOUNT	001901		T CRI	DESCRIPTION	REMARKS	ATION	X			CIRCUIT INFORMATIC	DN		DISC	CONNECT		G	VARI FREQUEN DRIVE (\	CY/SP
LT NLT	56 SAME AS L1 EXCEPT WITH E		*(D/I) D 4750-525			120-277V, 2'X4' COLOR TUNNING FLAT PANEL. ELECTRONIC 0-10V DIMMING DRIVER WITH RANGE FROM 100% TO 10%. UL LISTED	1	EQUIPMENT DESIGN	EQUIPMENT LOCATIC	EQUIPMENT LOAD	VOLTAGE/PHASE	CONDUIT AND CONDUCTOR SIZE	BRANCH CIRCUIT DESIGNATION	ROVIDED BY	USED OR KON-FUSED	GEMA ENCLOSURE		QUIPMENT MOUNT ONTROL PANEL	ROVIDED BY	
						120-277V, 2'X4' LED FLAT PANEL WITH SELECTABLE LUMENS AND COLOR		ACCU-A1	UNIT B	20 MCA	480V/3PH	3/4"C-3-#10,1-#10G	14C1-14(16,18)		F		A 30			
						TEMPERAUTRE. 0-10V ELECTRONIC DIMMING TO 10% UL LISTED. COLOR TEMPERATURE AND LUMEN OUTPUT TO BE SET AT FACTORY AS INDICATED	Ξ	ACCU-B1	UNIT A	47.7 MCA	480V/3PH	1"C,3-#6,1-#10G	24BDP-5	EC	F	3R 60	A 100	A	······	سسم
	40	RECESSE	D 4,291	4000	0 80	AND LUMEN OUTPUT TO BE SET AT FACTORY AS INDICATED					,									
								B-1	UNIT C	7.5 MCA	480V/3PH	3/4"C,3-#12,1-#12G	14E2-1(3,5)							
	SAME AS L2 EXCEPT WITH E		Y BATTERY I	NVERT	ER			B-2	UNIT C	7.5 MCA	480V/3PH	3/4"C,3-#12,1-#12G	14E2-7(9,11)							l
UIRE DRYWALI	FRAMES FOR RECESSED FIXTURES.							EF-1	UNIT C	2.0 HP	208V/1PH	3/4"C,3-#12,1-#12G	12E2-37(39)	INT						
								EF-2	RM. 224B	128 W	120V/1PH	3/4"C,2-#12,1-#12G	22A1-38	EC	NF	1 20	A			
								MAU-1	UNIT C	5.0 HP	208V/3PH	3/4"C,3-#8,1-#10G	12DK1-28(30,32)							
											2001/0111		1.22.00 20(00,02)							
								P-1	UNIT C	15.0 HP	480V/3PH	3/4"C,3-#8,1-#10G	14E2-25(27,29)						MC	E
								P-2	UNIT C	15.0 HP	480V/3PH	3/4"C,3-#8,1-#10G	14E2-31(33,35)						MC	E
											1001/0111		1122 01(00,00)							
		LIG	HTIN	G S	SEN	SOR SCHEDULE		SCHEDULE	ABBREVATIONS AMPACITY		HLO	HIGH/LOW/OFF SWITCH	MHLO			l/LOW/OFF				
		_	INPUT	MO		DEMAD//Q	DEMARKO	EC	ELECTRICAL CON	TRACTOR	HOA	HAND/OFF/AUTO	NF	NON-FL			SWIICH			
TAG	MANUFACTURER'S CATALOG NUMBEF	۲ ۲	VOLTAGE	MO	UNI	REMARKS	REMARKS	EC				, ,	NF O							
	WATTSTOPPER #DT-300					DUAL TECHNOLOGY CEILING SENSOR WITH A COMBINATION OF ULTRASONIC AND				ENI	HP		-				ALLED			
	SENSOR SWITCH #CM-PDT-9-R					PASSIVE INFRARED. SENSOR TO BE EQUIPPED WITH SELF ADJUSTING TECHNOLOGY AND ISOLATED RELAY OUTPUTS. SENSOR SHALL OPERATE AS AUTOMATIC "ON" AND			FUSED		INT		RLA			/IPS				
01	GREENGATE #OAC-DT-R		24V	CEIL	ING	AUTOMATIC "OFF" WITH A 15 MINUTE TIME DELAY.	1	FLA	FULL LOAD AMPS		LOR	LOCAL/OFF REMOTE SWITCH	S		SWITCH					
	HUBBELL #OMNI-DT-XXXX-RP							FVNR	FULL VOLTAGE NO			MOMENTARY ON/OFF SWITCH	W	WATTS						
								FVR	FULL VOLTAGE RE		MC	MECHANICAL CONTRACTOR	,			EAKER, Y P	DLE			
	WATTSTOPPER #BZ150					POWER PACK TO OPERATE LOW VOLTAGE (24VDC) OCCUPANCY SENSORS. RELAY TO		G	GENERAL CONTR		MCA	MIN CIRCUIT AMPACITY	XAF	SWITCH	I WITH X AN	/IP FUSE(S)				
	SENSOR SWITCH #PP20			4 SQUA	RE BOX	BE 20A RATED.		HL	HIGH/LOW SWITC	H	MHL	MOMENTARY HIGH/LOW SWITCH								
PP	GREENGATE #SP20-MV		120/277V	ABC	OVE															
	HUBBELL		,	ACCES CEIL				REMARKS												
								1. EXTEND	EXISTING BRANCH	CIRCUITS, AS F	REQUIRED, CO	DNNECT NEW UNIT.								
REMARKS	· ·							2. PROVID	E AND INSTALL NEV	/ 20A/3P CIRCU	T BREAKER T	O SERVE NEW EXHAUST FAN. CONTRA	CTOR SHALL TERI	MINATE E	XHAUST F	AN TO TWO	(2) PHAS	E OF CIRCU	JIT BREAKER	
	E POWER PACKS AS REQUIRED TO OPERATE LIGHT							3. REPLAC	E EXISTING 30A/3P	CIRCUIT BREAK	ER WITH NEW	40A/3P CIRCUIT BREAKER.								
	V SENSOR IN LIEU OF POWER PACK IS ACCEPTABL				-110			4. REPLAC	E EXISTING 50A/3P	WITH NEW 35A/	3P CIRCUIT B	REAKER.								
GENERAL		L.						5. INTERC	EPT EXISTING BRAN	CH CIRCUIT AN	D ROUTE THF	OUGH NEW CONTRACTOR FOR BOILER	R SHUT-OFF.							
							1													


GENERAL NOTES: 1. CEILING MOUNTED OCCUPANCY SENSORS SHALL BE INSTALLED 6'-0" AWAY FROM ANY SUPPLY DIFFUSERS, COORDINATE WITH MECHANICAL CONTRACTOR.

6. PROVIDE POWER PACK AND WIRE TO LOW VOLTAGE OCCUPANCY SENSOR SERVING RESTROOMS.

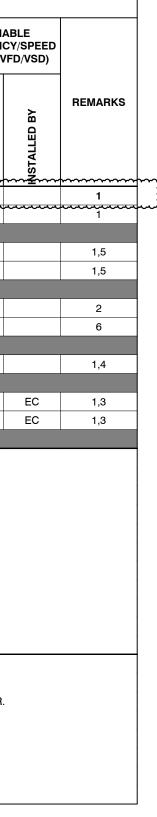




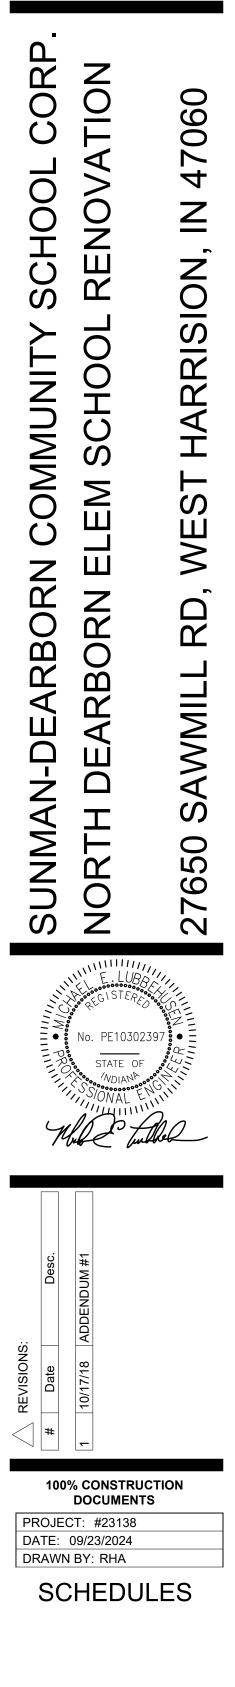

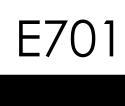

# <u>SES</u> ADDENDUM #1 DRAWINGS 10/11/24

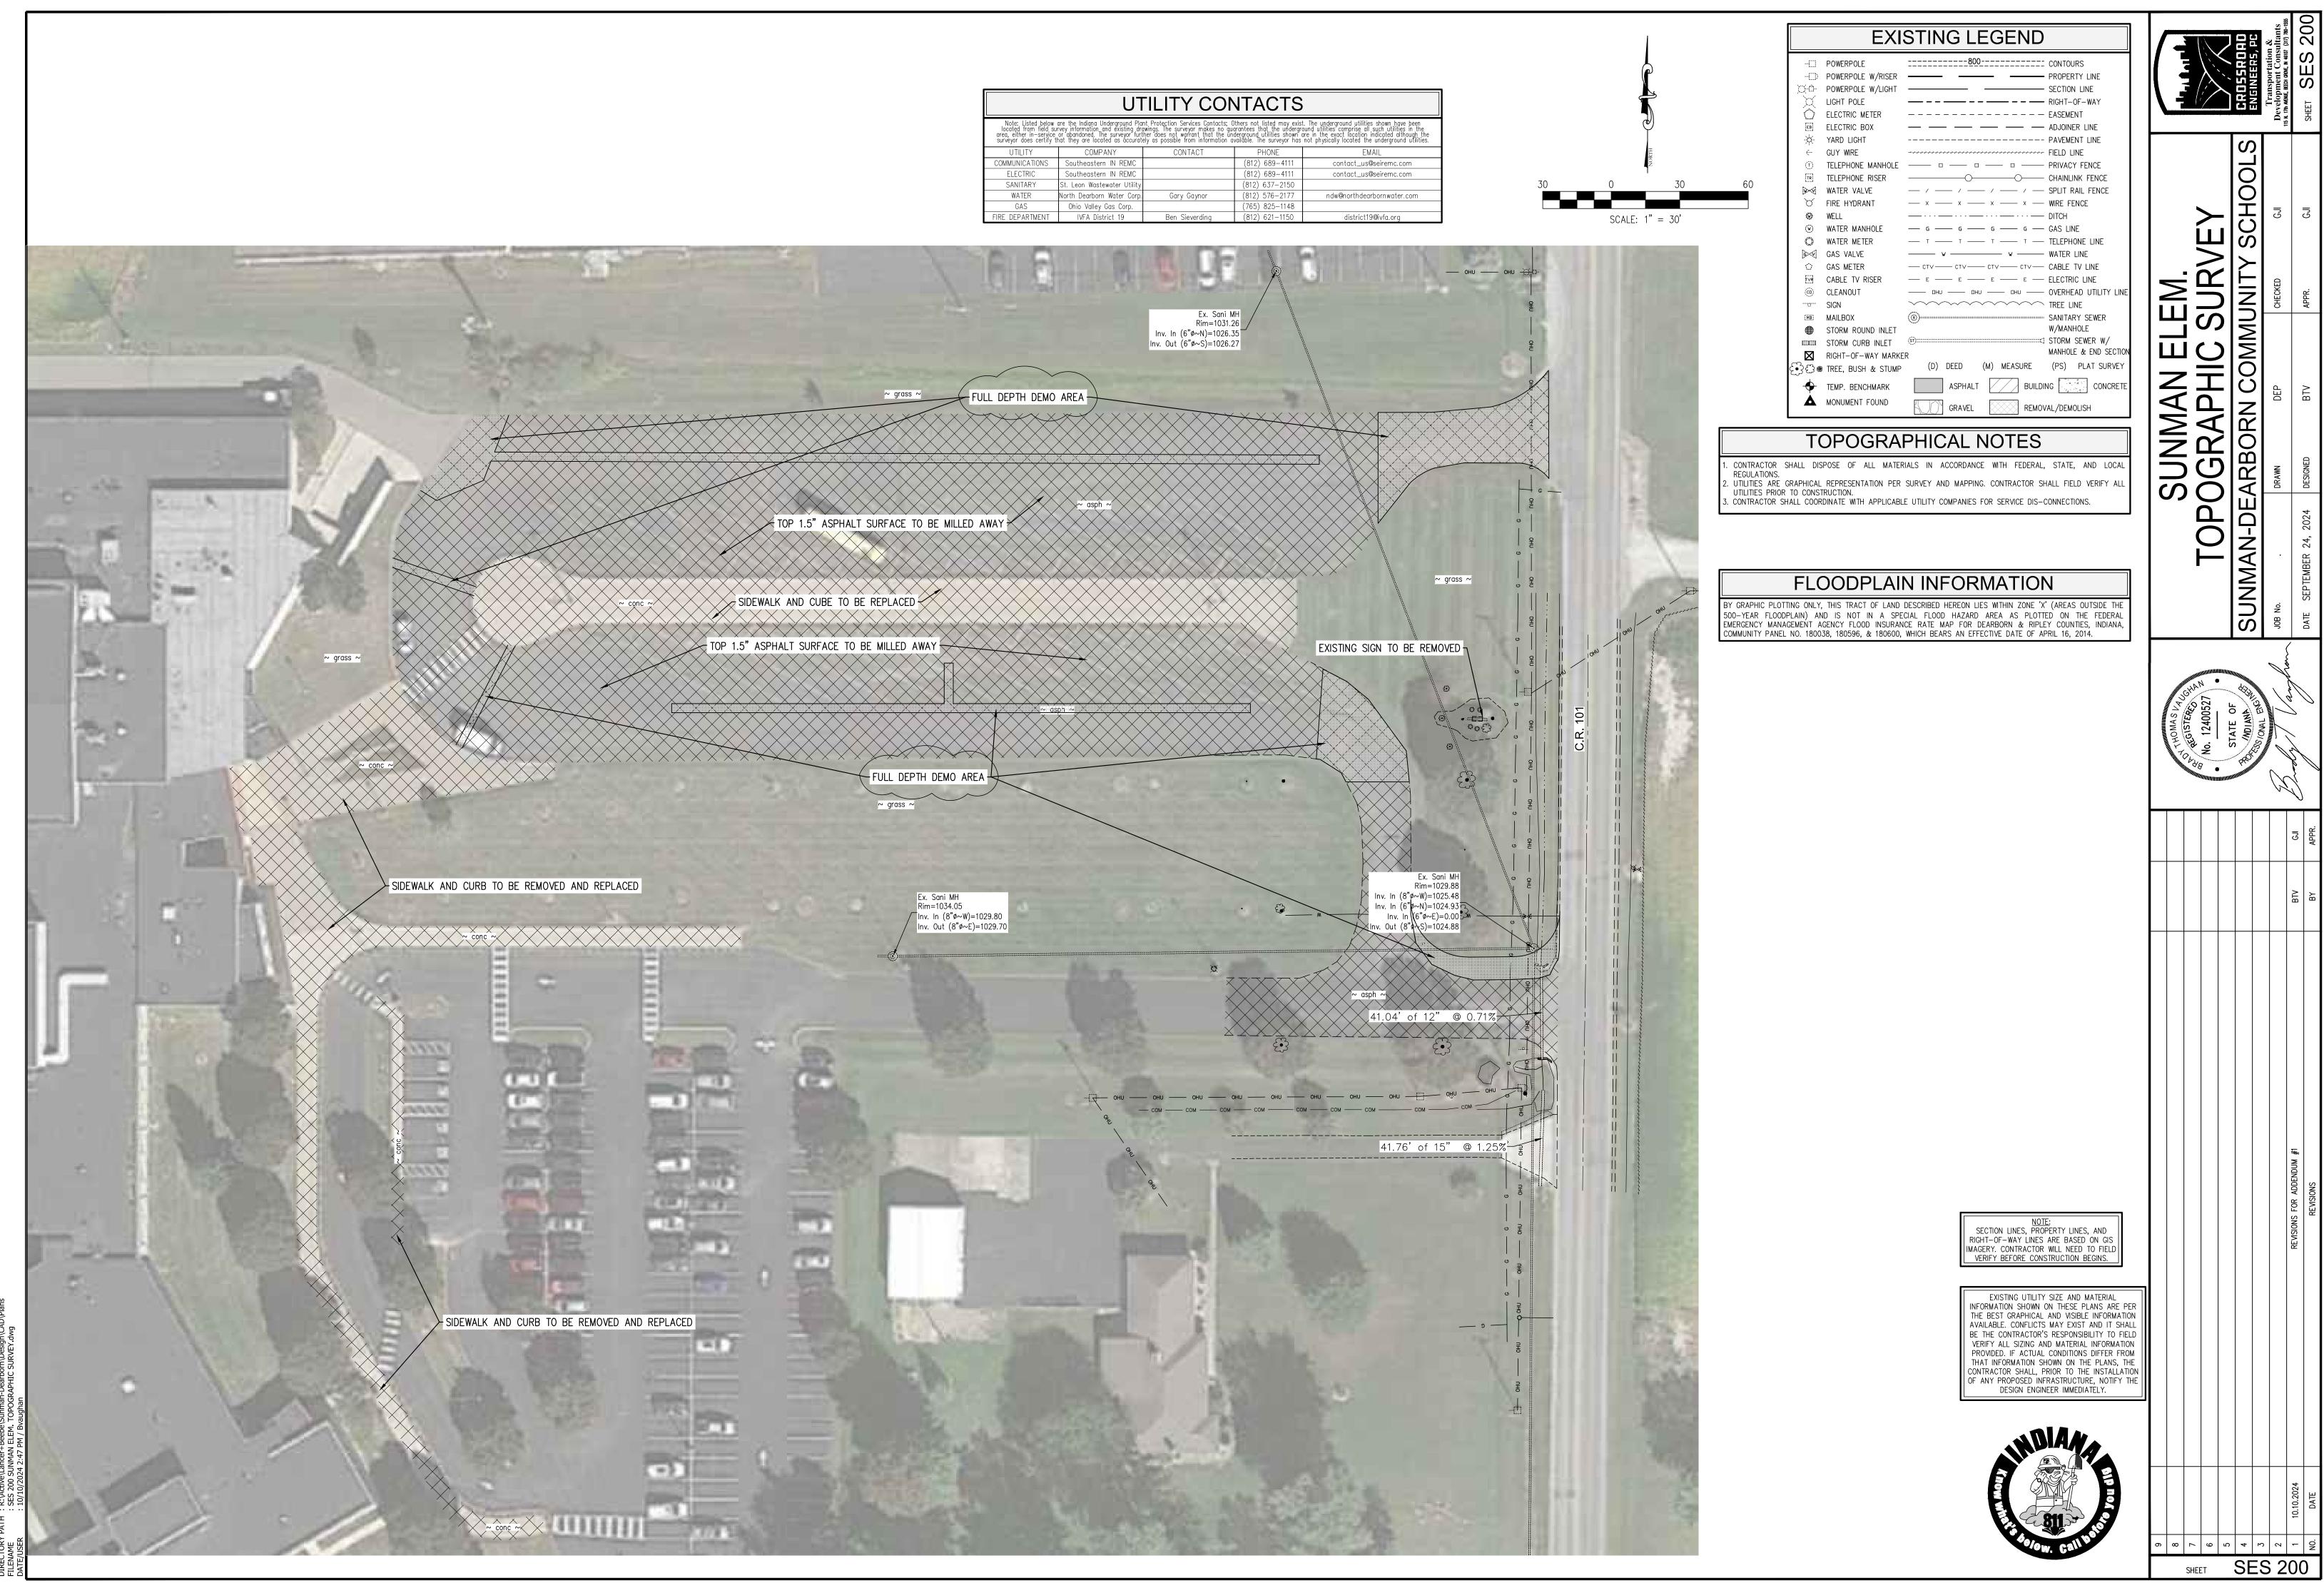

UTILITY CONTACTS									
Note: Listed below are the Indiana Underground Plant Protection Services Contacts; Others not listed may exist. The underground utilities shown have been located from field survey information and existing drawings. The surveyor makes no guarantees that the underground utilities comprise all such utilities in the area, either in-service or abandoned. The surveyor further does not warrant that the underground utilities shown are in the exact the underground utilities shown have been surveyor does certify that they are located as accurately as possible from information available. The surveyor has not physically located the underground utilities.									
UTILITY	COMPANY	CONTACT	PHONE	EMAIL					
COMMUNICATIONS	Southeastern IN REMC		(812) 689-4111	contact_us@seiremc.com					
ELECTRIC	Southeastern IN REMC		(812) 689-4111	contact_us@seiremc.com					
SANITARY	St. Leon Wastewater Utility		(812) 637-2150						
WATER	North Dearborn Water Corp.	Gary Gaynor	(812) 576-2177	ndw@northdearbornwater.com					
GAS	Ohio Valley Gas Corp.		(765) 825-1148						
FIRE DEPARTMENT	IVFA District 19	Ben Sieverding	(812) 621-1150	district19@ivfa.org					

## GENERAL NOTES

OTHERWISE.

A. CONTRACTOR TO VERIFY EXISITING CONDITIONS AND REPAIR ALL EXISTING WALLS, SLAB, AND CEILINGS TO A CONDITION SUITABLE FOR ACCEPTING NEW FINISHES AS PER MANUFACTURER'S RECOMMENDED INSTALLATION METHODS. MINIMUM LEVEL 4 FINISH ON EXISTING AND NEW WALLS, UNLESS NOTED

B. ALL FLOORING TRANSITIONS TO COMPLY WITH ADA GUIDELINES AND TO OCCUR UNDER CENTER OF DOORWAYS AND OR AT CENTERLINE OF WALL, UNLESS INDICATED DIFFERENTLY ON FINISH PLANS. PROVIDE REDUCER STRIPS WHEREVER CARPET OR LVT MEET CONCRETE.

C. CONTRACTOR TO PROVIDE PROTECTION AS NEEDED DURING CONSTRUCTION. IF, ANY, TO PERSERVE NEW FINISHES WHILE COMPLETING CONSTRUCTION. D. CONTRACTOR SHALL BE RESPONSIBLE FOR VERIFICATION OF DIMENSIONS AND JOB CONDITIONS. ANY DEVIATION FROM WHAT IS INDICATED ON THE FINISH

PLANS SHALL BE BROUGHT TO THE ATTENTION OF THE ARCHITECTS AND DESIGNERS. ALL DIMENSIONS SHOWN ARE TO FACE OF FINISH MATERIAL, UNLESS NOTED OTHERWISE.

E. WHERE WALLS ARE INDICATED TO RECEIVE PAINT FINISH, PRIME AND PAINT GRILLES, FIRE EXTINGUISHER CABINETS, AND OTHER ITEMS EMBEDDED IN WALL CONSTRUCTION TO MATCH SURFACE ON WHICH THEY OCCUR.

F. CONTRACTOR TO PROVIDE DRYWALL REVEAL JOINT WHERE DRYWALL MEETS DISSIMILAR MATERIALS.

G. CONTRACTOR TO PROVIDE SCHLUTER EDGE WHERE TILE MEETS DISSIMILAR MATERIALS. REFER TO INTERIOR ELEVATIONS FOR FURTHER DETAILS. H. DO NOT INSTALL GYPSUM BOARD BEHIND TILE BACKER BOARD LOCATIONS.

I. IF ONLY PAINT IS INDICATED AS THE FINISH, REFER TO ARCHITECTURAL FLOOR PLANS FOR SUBSTRATE INFORMATION.

J. ALL MECHANICAL CLOSETS TO HAVE A SEALED CONCRETE FLOOR FINISH. PROVIDE RESILIENT TRANSITION STRIP TO MATCH RB-1.

K. ALL WALLS, COLUMNS, AND CEILINGS TO BE PAINTED PT-1, UNLESS NOTED OTHERWISE.

NOTES ETR EXISTING TO REMAIN TBD TO BE DETERMINED FLOOR COVERING

COLOR: 104672 GREIGE LOCATION: CLASSROOMS

> COLOR: 1518 BYPASS BLACK LOCATION: VESTIBULES

# FINISH LEGEND

50CM X 50CM CARPET TILE INSTALL: MATCH EXISTING SCHOOL

STANDARD REMARKS: TO PATCH EXISTING CARPET AS NEEDED. CONTACT: JAE PARK 317-459-8762

WOM-1: MFG: MANNINGTON TYPE: 24"x24" CARPET TILE PATTERN: RECOARSE II

> INSTALL: NON-DIRECTIONAL CONTACT: NEIL MACK 317-800-0680

WALL BASE **RESILIENT BASE** 

RB-1: MFG: TARKETT JOHNSONITE TYPE: 4" RESILIENT WALL BASE COLOR: 48 GRAY 4" RESILIENT WALL BASE LOCATION: CLASSROOMS REMARKS: NEW KNEE WALLS AND TO PATCH EXISTING BASE AS NEEDED.

PT-2:

PAINT/WALL FINISH PAINT


PT-1: MFG: SHERWIN W TYPE: REF. SPECS COLOR: SW1053 LIG SHERWIN WILLIAMS REF. SPECS FOR TYPE LOCATION: TYPICAL

REF. SPEC


MISC.		
SOLID S SS-1:	INSTALL: LOCATION: <b>V TREATMEN</b> MFG:	MECHO SYSTEMS
	COLOR: LOCATION:	MOTORIZED ROLLER SI OPENNESS, TENSIONEI SOHO 1600 DOVE GREY ART PROVIDE SIDE CHANNE CABLES

MFG: SHERWIN TYPE: REF. SPEC COLOR: SW6668 SI LOCATION: ACCENT REMARKS: TO PATCH

LIGHT MOVES	
N WILLIAMS ECS FOR TYPE SUNRISE	
H EXISTING PAINT AS NEEDED	Э.

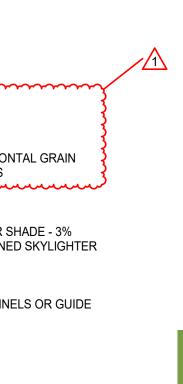




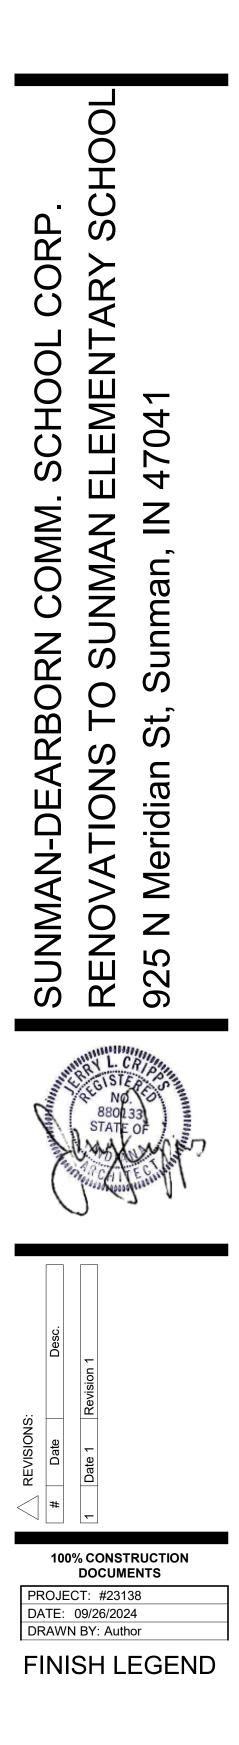


A720


TIME:10/8/2024 10:42:28 AM Autodesk Docs://24588 SDCS Sunman ES Reno/588 SDCS Sunman ES\_Elec\_v23

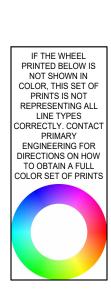





1 POWER AND SYSTEMS PLAN - ROOF - OVERALL SCALE: 1" = 20'-0"

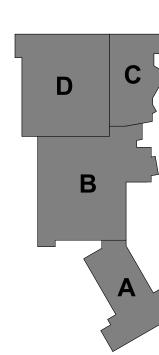

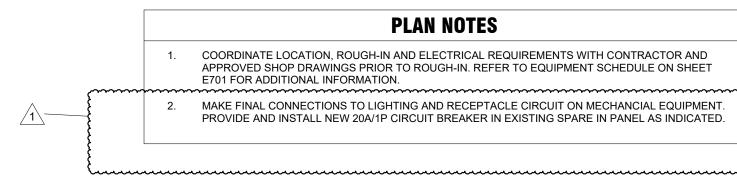

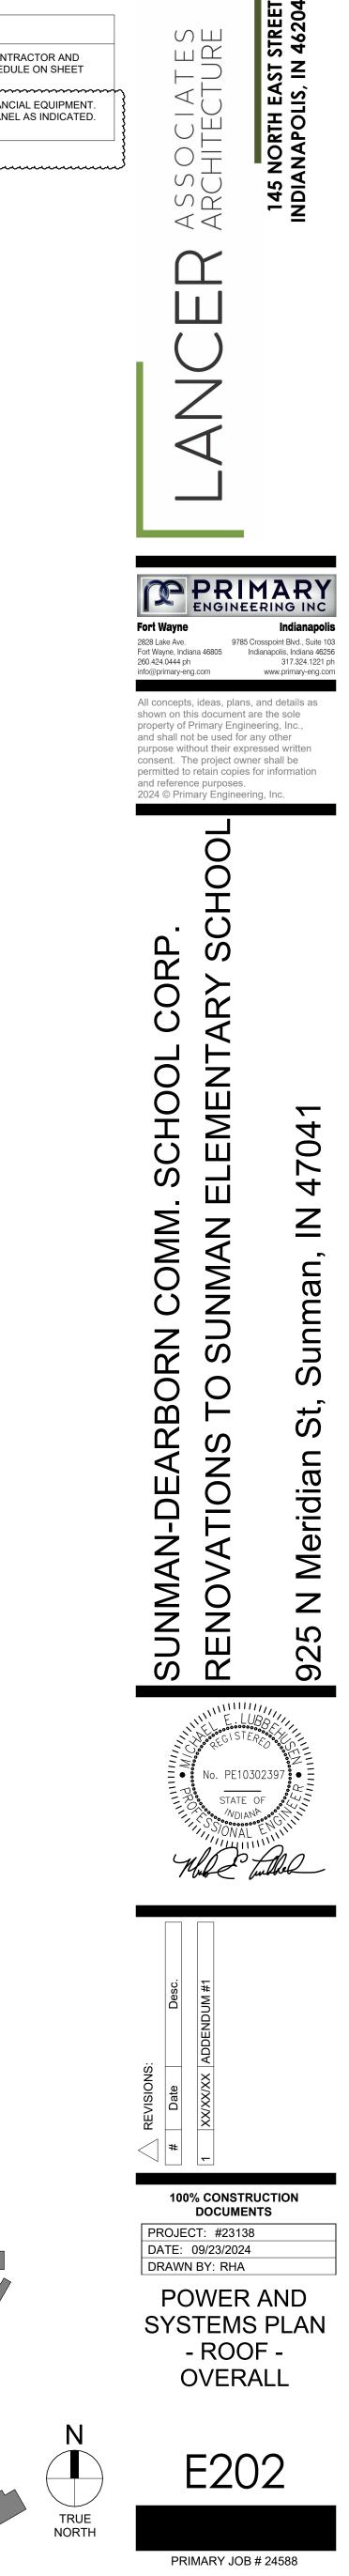




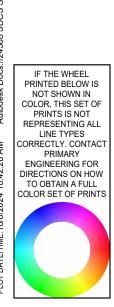

ACCU-1 ACCU-2 ACCU-3 ACCU-3 ACCU-3 FCU-1 FCU-1	ROOF ROOF ROOF ROOF ROOF	40 MCA 40 MCA 40 MCA 11 MCA	<b>35000000000000000000000000000000000000</b>	CONDUIT AND CONDUCTOR SIZE 3/4"C,3-#12,1-#12G	BRANCH CIRCUIT DESIGNATION	DED BY	O	OSURE	<b>F</b>	J		DRIVE	(VFD,
B-2 ACCU-1 ACCU-2 ACCU-3 ACCU-6 EF-1 FCU-1	RM. B131B ROOF ROOF ROOF ROOF	8.1 MCA 40 MCA 25 MCA 40 MCA	208V/3PH 480V/3PH			PROVIDED	FUSED OR NON-FUSED	NEMA ENCLOSURE	DISCONNECT SWITCH SIZE	FUSE RATING	EQUIPMENT MOUNTED CONTROL PANEL	PROVIDED BY	
ACCU-2 ACCU-3 ACCU-6 EF-1 FCU-1	ROOF ROOF ROOF ROOF	<b>25 MCA</b> 40 MCA	,	3/4"C,3-#12,1-#12G	14B2-14(16,18) 14B2-20(22,24)								
ACCU-3 ACCU-6 EF-1 FCU-1	ROOF ROOF ROOF	40 MCA	480V/3PH	3/4"C,3-#8,1-#10G	14AD9-8(10,12)	EC	NF	3R	60A				
ACCU-6 EF-1 FCU-1	ROOF	******	480V/3PH	<b>3/4"C,3-#10,1-#10G</b> 3/4"C,3-#8,1-#10G	14BDP-7 14BDP8	EC EC	F NF	<b>3R</b> 3R	<b>30A</b> 60A	30A			
FCU-1			208V/1PH	3/4"C,3-#10,1-#10G	12B5-1(3)	EC	NF	3R	30A	~~~~~			-
		2.0 HP	208V/1PH	3/4"C,3-#12,1-#12G	12B5-25(27)	INT							I
MAU-1	UNIT B	1.58 FLA	120V/1PH	3/4"C,3-#12,1-#12G	12B5-29	INT							I
	ROOF	18.8 MCA	208V/3PH	3/4"C,4-#10,1-#10G	12AK1-22(24,	INT							
HVAC-1	UNIT B	1.0 MCA	208V/1PH	3/4"C,3-#12,1-#12G	ACCU-6	EC	NF	1	20A				
DBP-1	RM. B131B	29 FLA	480V/3PH	3/4"C,3-#8,1-#10G	14B2-19(21,23)						INT		
P 1	PM B121B			2/4"C 2 #8.1 #10G								MC	
P-1 P-2	RM. B131B RM. B131B	15.0 HP 15.0 HP	480V/3PH 480V/3PH	3/4"C,3-#8,1-#10G 3/4"C,3-#8,1-#10G	14B2-2(4,6) 14B2-8(10,12)							MC MC	
RTU-1	ROOF	45.6 MCA	480V/3PH	1"C, 3-#6,1-#8G	14CDP-7	INT							
RTU-2 RTU-3	ROOF ROOF	20.0 MCA 33.0 MCA	480V/3PH 480V/3PH	3/4"C,3-#10,1-#10G 3/4"C,3-#8,1-#10G	14CDP-10 14CDP-2	INT INT							+
RF-1	ROOF	2 HP	208V/1PH	3/4"C,3-#12,1-#12G	12B5-31(33,35)	INT							
RF-2	ROOF	1 HP	120V/1PH	3/4"C,2-#12,1-#12G	12B5-32	INT							+
RF-3 RF-4	ROOF	1 HP 1 HP	120V/1PH 120V/1PH	3/4"C,2-#12,1-#12G 3/4"C,2-#12,1-#12G	12B5-34 12C1-35	INT INT							+
RF-5 RF-6	ROOF	1 HP 2 HP	120V/1PH 208V/1PH	3/4"C,2-#12,1-#12G 3/4"C,3-#12,1-#12G	12D3-19 12D3-21(23,25)	INT INT							+
UH-1	RM. B131B	1/3 HP	120V/1PH	3/4"C,2-#12,1-#12G	12B4-36	INT							
			· ·										
UV-1 UV-2	RM. 106 RM. 108	4.23 MCA 4.23 MCA	277V/1PH 277V/1PH	3/4"C,2-#12,1-#12G 3/4"C,2-#12,1-#12G	14A1-25 14A1-26	INT INT							<u> </u>
UV-3 UV-4	RM. 109 RM. 110	4.23 MCA 4.23 MCA	277V/1PH 277V/1PH	3/4"C,2-#12,1-#12G 3/4"C,2-#12,1-#12G	14A1-27 14A1-29	INT INT							+
UV-5 UV-6	RM. 124 RM. 126	4.23 MCA 4.23 MCA	277V/1PH 277V/1PH	3/4"C,2-#12,1-#12G 3/4"C,2-#12,1-#12G	14A1-30 14A1-31	INT INT							-
UV-7	RM. 128	4.23 MCA	277V/1PH	3/4"C,2-#12,1-#12G	14A1-32	INT							+
UV-8 UV-9	RM. 129 RM. 130	4.23 MCA 4.23 MCA	277V/1PH 277V/1PH	3/4"C,2-#12,1-#12G 3/4"C,2-#12,1-#12G	14B2-37 14B2-38	INT INT							+
UV-10 UV-11	RM. 131 RM. 155b	4.23 MCA 4.23 MCA	277V/1PH 277V/1PH	3/4"C,2-#12,1-#12G 3/4"C,2-#12,1-#12G	14B2-39 14C1-23	INT INT							-
UV-12	RM. 1558	4.23 MCA 4.23 MCA	277V/1PH	3/4"C,2-#12,1-#12G	14C1-25	INT							<u> </u>
UV-13 UV-14	RM. 153 RM. 151	4.23 MCA 4.23 MCA	277V/1PH 277V/1PH	3/4"C,2-#12,1-#12G 3/4"C,2-#12,1-#12G	14C1-27 14D2-13	INT INT							+
UV-15	RM. 148	4.23 MCA	277V/1PH	3/4"C,2-#12,1-#12G	14D2-15	INT							+
UV-16 UV-17	RM. 146 RM. 145	4.23 MCA 4.23 MCA	277V/1PH 277V/1PH	3/4"C,2-#12,1-#12G 3/4"C,2-#12,1-#12G	14D2-17 14D2-19	INT INT							<u> </u>
UV-18 UV-19	RM. 144 RM. 143	4.23 MCA 4.23 MCA	277V/1PH 277V/1PH	3/4"C,2-#12,1-#12G 3/4"C,2-#12,1-#12G	14D2-21 14B1-28	INT INT							+
UV-20 UV-21	RM. 141 RM. 140	4.23 MCA 4.23 MCA	277V/1PH 277V/1PH	3/4"C,2-#12,1-#12G 3/4"C,2-#12,1-#12G	14B1-30 14B1-32	INT INT							+
UV-22	RM. 139	4.23 MCA	277V/1PH	3/4"C,2-#12,1-#12G	14B1-34	INT							$\pm$
UV-23	RM. 138	6.08 MCA	277V/1PH	3/4"C,2-#12,1-#12G	14B1-36	INT							
VAV-1	UNIT C	1.0 KW	120V/1PH	3/4"C,2-#12,1-#12G	14C1-21	EC	NNF	1	20A				
GWH-1	RM. B131B	15 MCA 3/4 HP	120V/1PH 208V/3PH	3/4"C,2-#12,1-#12G 3/4"C,3-#12,1-#12G	12B5-17 12B5-19(21,23)	EC	NF	1	20A				—
GWH-2	RM. B131B	15 MCA 3/4 HP	120V/1PH 208V/3PH	3/4"C,2-#12,1-#12G 3/4"C,3-#12,1-#12G	12B5-18(21,25) 12B5-18 12B5-20(22,24)	EC	NF	1	20A				
	BBREVATIONS		HLO	HIGH/LOW/OFF SWITCH	MHLO		TADVING			-СП			
EC E	ELECTRICAL CONTRACTOR HOA			HAND/OFF/AUTO	NF	MOMENTARY HIGH/LOW/OFF SWITCH NON-FUSED			СП				
	EXISTING EQUIPMENT HP FUSED INT			HORSE POWER INTEGRAL WITH EQUIPMENT	o Rla	OWNER FURNISHED AND INSTALLED RUNNING LOAD AMPS				ED			
	FULL LOAD AMPS LOR FULL VOLTAGE NON-REVERSING M			LOCAL/OFF REMOTE SWITCH MOMENTARY ON/OFF SWITCH	S W	ON/OFF SWITCH WATTS							
FVR F	FULL VOLTAGE REVERSING MC		MC	MECHANICAL CONTRACTOR	XA/YP	X AMP CIRCUIT BREAKER, Y POLE							
	GENERAL CONTRA HIGH/LOW SWITCH		MCA MHL	MIN CIRCUIT AMPACITY MOMENTARY HIGH/LOW SWITCH	XAF	SWITCH WITH X AMP FUSE(S)							
2. REPLACE E 3. REPLACE E	EXISTING 40A/3P ( EXISTING 40A/3P (	CIRCUIT BREAK	ER WITH NEW	CONNECT TO NEW MECHANICAL EQUIP 2 20A/3P CIRCUIT BREAKER. 2 30A/3P CIRCUIT BREAKER. 1 EXISTING SPACE AS INDICATED.	MENT								

9. CONNECT INDOOR UNIT THROUGH OUTDOOR ACCU UNIT. 10. PROVIDE AND INSTALL NEW 20A/3P CIRCUIT BREAKER IN EXISTING SPACE AS INDICATED. CONTRACTOR SHALL TERMINATE FAN TO TWO (2) PHASES OF CIRCUIT BREAKER.

10. PROVIDE AND INSTALL NEW 20A/3P CIRCUIT BREAKER IN EXISTING SPACE AS INDICATED. CONTRACTOR SHALL TERMINATE FAN TO TWO (2) PHASES OF CIRCUIT BREAKE 11. REPLACE EXISTING 20A/2P CIRCUIT BREAKER WITH NEW 25A/2P CIRCUIT BREAKER.

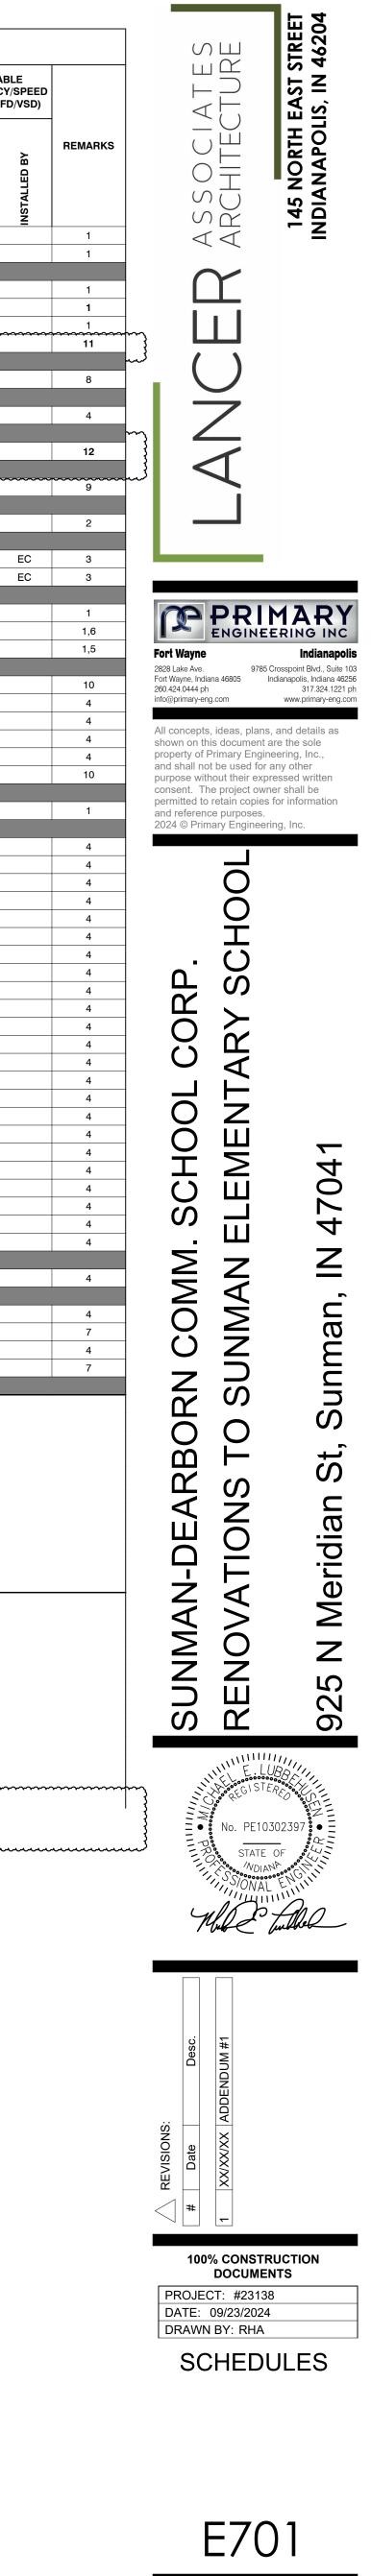

PRIMARY JOB # 24588