




Primary Engineering, Inc.
2828 Lake Ave.
Fort Wayne, Indiana 46805
260-424-0444 ph
www.primary-eng.com

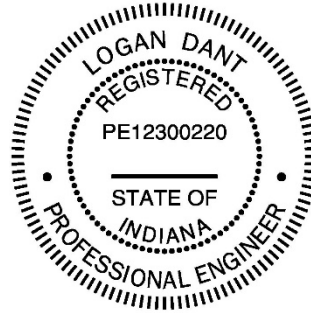

Addendum: 1
Date: 10/31/2024
Project: **Clinton Central Rooftop Unit Replacement**
Comm #: 24594

The following items shall be incorporated into the specifications and drawings and are considered to be integral to the bid documents for the project. Acknowledgement of receipt of this addendum is required on the bid form.

Item #1: General Clarifications.

- A. *Question: "Does the owner want any of the demolished equipment or salvaged refrigerant?"*
Answer: No, the contractor is responsible for disposal of all materials.
- B. *Question: "Is there any existing roof warranties?"*
Answer: Yes, refer to the double box note on sheet ES-M203 and HS-M203.
- C. *Question: "Do we need to remove and replace the existing roof curb and transition?"*
Answer: Existing roof curb is to remain and only the transition curb is to be new. Intent is not to stack a new transition curb onto an already existing transition curb.
- D. *Question: "Does the existing red box on the exposed unit ventilator need to stay functional?"*
Answer: No, that box and the associated switch will be removed. New unit ventilator and thermostat will take the place of that box and switch.
- E. *Question: "Do we need to protect the stage while working on the indoor air handler at the high school?"*
Answer: Yes, use 2 layers of plywood on the stage at least 10 ft from the access point into the mezzanine.
- F. See attached for the pre-bid meeting agenda and the sign-in sheet.
- G. See attached for the existing rooftop units' model/serial numbers for both elementary school and the high school.

Item #2: Drawing Sheet S1.1, "Structural Framing Plan, Notes, and Details"

- A. See added new sheet for structural reinforcing for AHU-4 at the high school.

Item #3: Drawing Sheet HS-M201, "Mechanical Plans – Unit A and B"

- A. Revised plan notes and sections to remove the concrete housekeeping pad under AHU-C1. New steel beams will be under the new air handler in lieu of a concrete pad.

Item #4: Drawing Sheet HS-M501, "Mechanical Schedule Sheet"

- A. Revised the base rail height on AHU-C1 from 8" down to 2.5".



Primary Engineering, Inc
2828 Lake Ave.
Fort Wayne, Indiana 46805

(260) 424-0444 phone
info@primary-eng.com

Pre-Bid Meeting Agenda

Date: October 30, 2024

Project Name: Clinton Central Rooftop Unit Replacement

Project #: 24594

Agenda Items:

- Introductions of Owner Representative, Project Design Team, and Prime Contractors.
 - o Logan Dant, Primary Engineering, ldant@primary-eng.com, 260-657-0153
 - o Levi Yowell, Superintendent, levi.yowell@clinton.k12.in.us, 317-730-6396
 - o Curt Whitcomb, Building Maintenance, curt.whitcomb@clinton.k12.in.us, 765-652-3103

- Project Information
 - o Bids are due: November 6, 2024 at 1:30pm. North entrance door N2, board room on the left.
 - o Submit bid forms in duplicate
 - o School board approval of the contract is scheduled on: November 18, 2024. Potential board meeting November 7th.
 - o Work may begin: June 1, 2025
 - o Substantial completion of the project is: August 1, 2025


- Project scope of work
 - o Elementary School: Replacement of (9) rooftop units. The replacement of (2) split systems are under an alternate bid.
 - o High School: Replacement of (1) rooftop unit, (1) indoor air handler with split DX, and (1) split system. The replacement of (1) rooftop unit and (1) unit ventilator with split DX are under an alternate bid.
 - o Controls shall be Distech controls install by Ermco.

- Owner specific requirements
 - o Ermco point of contact will be Steve Davis, sdavis@ermco.com, 317-423-3860 and Danny Brewer, dbrewer@ermco.com, 317-396-4976

- Procedures for site visits – contact Curt Whitcomb.

- Deadline for addendum items and additional manufacturers by Monday 11/4 by 9am. Last addendum will go out no later than Monday 11/4 at noon.

ELEMENTARY SCHOOL				
Existing Tag	Manufacturer	Model #	Serial #	Tons
RTU-4	TRANE	TSC120E4R0B07FX	102111495L	10
RTU-3	TRANE	TSC090E4E0A07FX	102111364L	7.5
RTU-2	TRANE	TSC120E4R0B0SH	102111533L	10
RTU-1	TRANE	THC102E4R0A176F	102111966L	8.5
ACCU-10	MITSUBISHI	MU24WN	-	2
ACCU-11	MITSUBISHI	MU24WN	-	2
RTU-6	TRANE	TSC120E4R0B07FX	120111543L	10
RTU-5	TRANE	TSC120E4R0B07FX	102111505L	10
RTU-10	TRANE	TSC090E4R0A07FX	102111378L	7.5
HV-3	TRANE	TSC120A4R0A29D000A	627100687L	10
HV-2	TRANE	TSC120A4R0A2	-	10
HIGH SCHOOL				
Existing Tag	Manufacturer	Model #	Serial #	Tons
ACCU-C1	BRYANT	576BEX360000AAAA	3400F27000	30
HP-1	TRANE	4WCC3024A1000AA	10204WBU9H	2
ACCU-B4	TRANE	XB13	-	-
RTU-B5	TRANE	TSC036E4R0A07FX	102111227L	3
ACCU-20	MITSUBISHI	-	-	2
AHU-C1	DUNHAM-BUSH	AHD2FS080HM	603000418	-

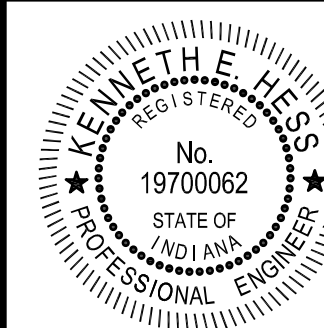

DRAWN BY: EPH
 CHECKED BY: KEH
 EXAM. NO: 24,395
 EXPIRES: 10-31-2024
 DATE

CERTIFIED BY: *Keith E. Hennessey*

STRUCTURAL ENGINEERING SERVICES, LLC
 15610 Lima Road, Huntcraven, IN 46748
 Phone: 260-637-7867 www.structuraleng.com


THIS CONCEPT DESIGN IS PRELIMINARY AND NOT FOR CONSTRUCTION. IT IS THE RESPONSIBILITY OF THE CONTRACTOR TO VERIFY ALL DIMENSIONS AND CONDITIONS ON THE JOB SITE. THE ENGINEER'S LIABILITY IS LIMITED TO THE DESIGN AND CALCULATIONS PROVIDED HEREON AND DOES NOT EXTEND TO THE CONSTRUCTION OF THE PROJECT OR TO THE SAFETY OF THE PROJECT OR TO THE SAFETY OF THE PUBLIC. THE ENGINEER'S LIABILITY IS LIMITED TO THE DESIGN AND CALCULATIONS PROVIDED HEREON AND DOES NOT EXTEND TO THE CONSTRUCTION OF THE PROJECT OR TO THE SAFETY OF THE PROJECT OR TO THE SAFETY OF THE PUBLIC.

GENERAL

- Contractor shall be responsible for all existing dimensions and job site conditions. If discrepancies between actual conditions and those shown on documents exist, notify Architect/Engineer in writing prior to construction.
 - Latest International Building Code and Indiana Construction Rules.
 - A.C.I. Building Code Requirements for Reinforced Concrete (A.C.I. 318-11).
 - Code of Standard Practice for Steel Construction, A.I.S.C. 14th Edition.
- The structure is designed to be self-supporting and stable after the building is fully completed. It is solely the contractor's responsibility to determine erection procedure and sequence and to insure the safety of the building and its component parts during erection. This includes the addition of whatever shoring, sheeting, temporary bracing, guys or tie-downs which might be necessary. Such material shall remain the contractor's property after completion of the project.
- Do not determine dimensions by "scaling" off the plans. The Contractor shall accept all risk associated with "scaling" and shall be responsible for all inadequate work resulting therefrom. Questions regarding missing or conflicting dimensions shall be directed, in writing, to the Structural Engineer.
- The Contractor shall coordinate and check all dimensions relating to architectural finishes, structural framing, mechanical openings, equipment, etc. Notify Architect/Engineer of any discrepancies before proceeding with work in area under question.

STRUCTURAL STEEL

- All structural steel shall be detailed with load transmitting field connections made with bearing-type 3/4" diameter ASTM A-325 bolts (snug-tight) UNO. All high-strength bolts shall be designed as bearing "N" type so that continuous special inspection is not needed unless indicated otherwise on drawings. Shop connections shall be welded. Use no more than two bolt diameters for the project UNO. Skip one size between bolt diameters.
- Structural steel material is as follows:
 - Wide flange shapes ASTM A992
 - Structural steel plates and rolled shapes other than wide flange shapes ASTM A36
- Set leveling or bearing plates on cleaned bearing surfaces using wedges or other adjustments as required. Solidly pack open spaces with non-shrink, non-metallic grout.
- Field welds to be made with E70XX electrodes according to AWS. Welded connections using ASTM A992 steel as a base metal shall be made with E70XX low hydrogen electrodes.
- All design, fabrication and erection of structural steel shall be in accordance with AISC and AWS specifications.
- All connections not specifically detailed on contract documents shall be designed and detailed by the structural steel fabricator in compliance with AISC standards. All connections shall be clearly shown on final shop drawings submitted for approval prior to fabrication.
- Lintels not indicated on plans are as follows:
 - Provide angle lintels over all openings and recesses in both interior and exterior walls unless otherwise noted. All lintels for mechanical and electrical openings are not shown. See mechanical and electrical plans for locations of lintels and lengths required for ductwork, pipes, electrical conduits, etc.
 - Angle lintels shall have a minimum end bearing on masonry of 4 1/2", but not less than 1" of such bearing for each foot of opening width. Angles in pairs shall be welded or bolted together with 1/2" diameter bolts at 18" oc. In case of single angle, anchor to concrete or masonry backup with 1/2" diameter expansion type anchors at 18" oc.
 - For 6" block partitions use two (2)-L3 1/2x 2 1/2x 5/16 (LLV) for spans up to 10'-0". For 8" to 10" block partitions use two (2)-L4x 3 1/2x 5/16 (LLV) for spans up to 7'-0". For spans 7'-0" to 10'-0" use two (2)-L5x 3 1/2x 3/8 (LLV). For 12" walls use three (3) angles as specified for 8" to 10" walls above.
 - Coordinate masonry rough openings with all trades.
- Shop drawings shall show complete details and schedules for fabrication, layout and erection. Submit shop drawings for approval prior to fabrication.
- All beams and beam lintels shall be field welded to bearing plates with 3/16" fillet weld each side of bottom flange.
- Field drilled holes shall be reamed, cleaned and deburred prior to assembly of the connection.
- Beams with specified camber shall be cambered upward. Beams without specified camber shall be fabricated so that after erection any minor camber due to rolling or shop assembly is upward.
- Thermal cutting shall preferably be done by machine. Hand thermally cut edges subjected to substantial stress or are to be welded, shall be reasonably free of notches or gouges. Notches or gouges larger than 3/16" that remain from cutting shall be removed by grinding. Re-entrant corners shall be shaped notch-free to a radius of at least 1/2".
- Fabricator shall be responsible for design of all connections not specifically detailed on the plans. Where end reaction are not shown on the plans, design simple beam connections for at least 50% of the allowable uniform load given in the beam tables in Chapter 3 of the AISC Steel Construction Manual - Allowable Stress Design (14th Ed.) for the given span and beam size. Use ASD values unless noted otherwise.

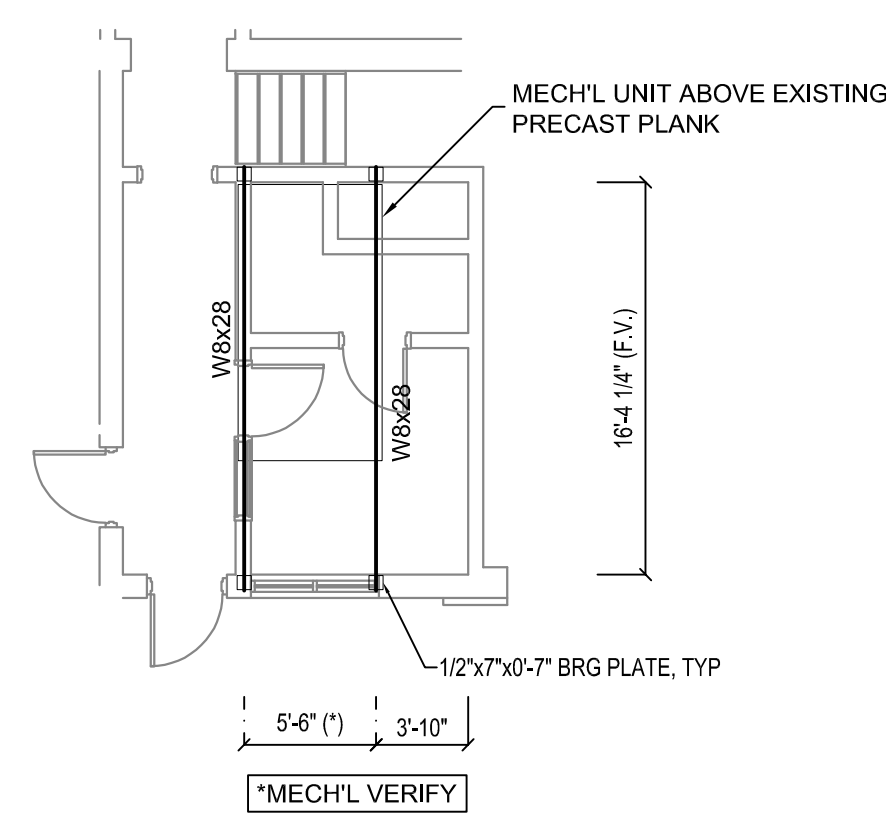


HOLD W8x24 TIGHT TO BOTTOM OF EXTG PRECAST PLANK. GROUT OPEN SPACES SOLID WITH NON SHRINK, NON METALLIC GROUT.

Mezzanine Reinforcing Plan
 SCALE: 1/8" = 1'-0"






- NOTES:
- SEE STRUCTURAL STEEL NOTE #7, SHEET S1.1 FOR NON-LOAD BEARING LINTELS (UNO). THESE WOULD INCLUDE ALL NEW DOORS, WINDOWS, WALL OPENINGS AND MECHANICAL WALL PENETRATIONS NOT INDICATED ON PLANS.
 - PROVIDE BRG PLATES 12x7x0-7" UNDER EACH END OF BEAMS AND BEAM LINTELS. WELD BEAMS/BEAM LINTELS TO PLATE (TYP UNO).
 - ALL BRG PLATES SHALL HAVE (2)-1/2" DIA x 4" HEADED STUDS.
 - ALL BRG PLATES NOT LOCATED AT MP'S SHALL HAVE (2) COURSES GROUTED SOLID UNDER PLATE.
 - BEAMS AND BEAM LINTELS SHALL HAVE FULL LENGTH (OR WIDTH) BRG ON

Clinton Central Jr./Sr High
 815 IN-29, Michigantown, IN 46057
 STRUCTURAL FRAMING PLAN, NOTES, AND DETAILS

SHEET
S1.1

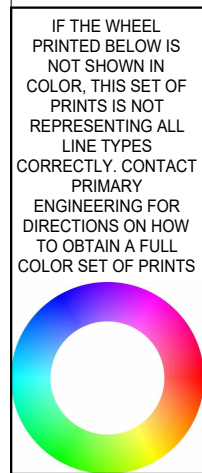

SCALE: 1/16" = 1'-0" SCALE: 3/32" = 1'-0" SCALE: 1/8" = 1'-0" SCALE: 1/4" = 1'-0" SCALE: 1/2" = 1'-0" SCALE: 3/4" = 1'-0" SCALE: 1" = 1'-0"

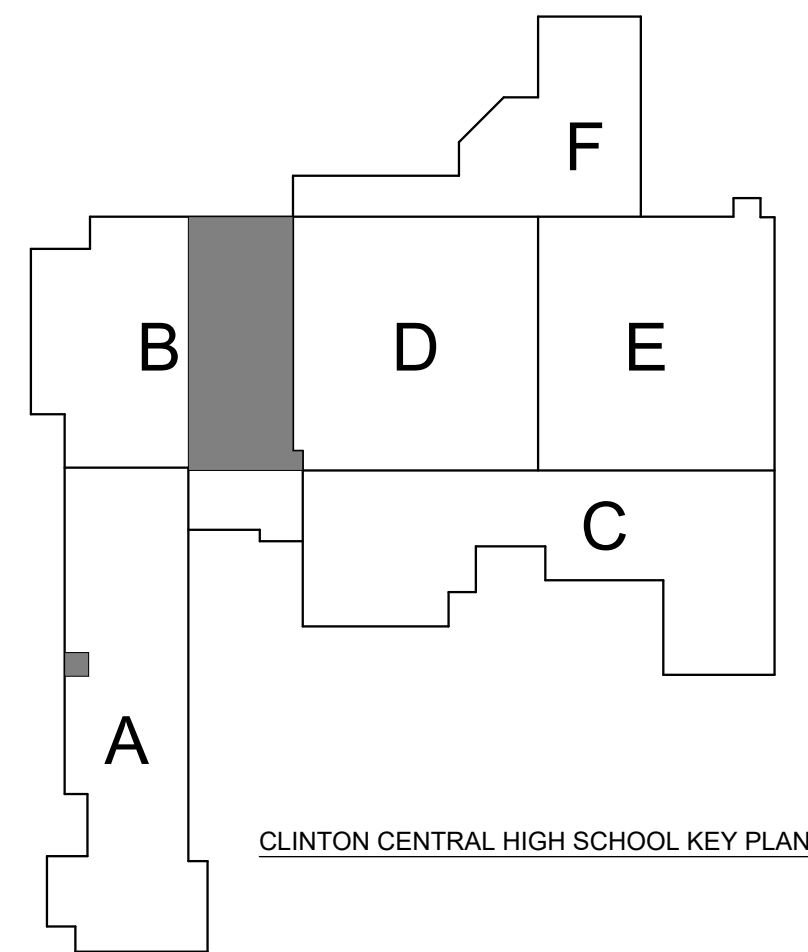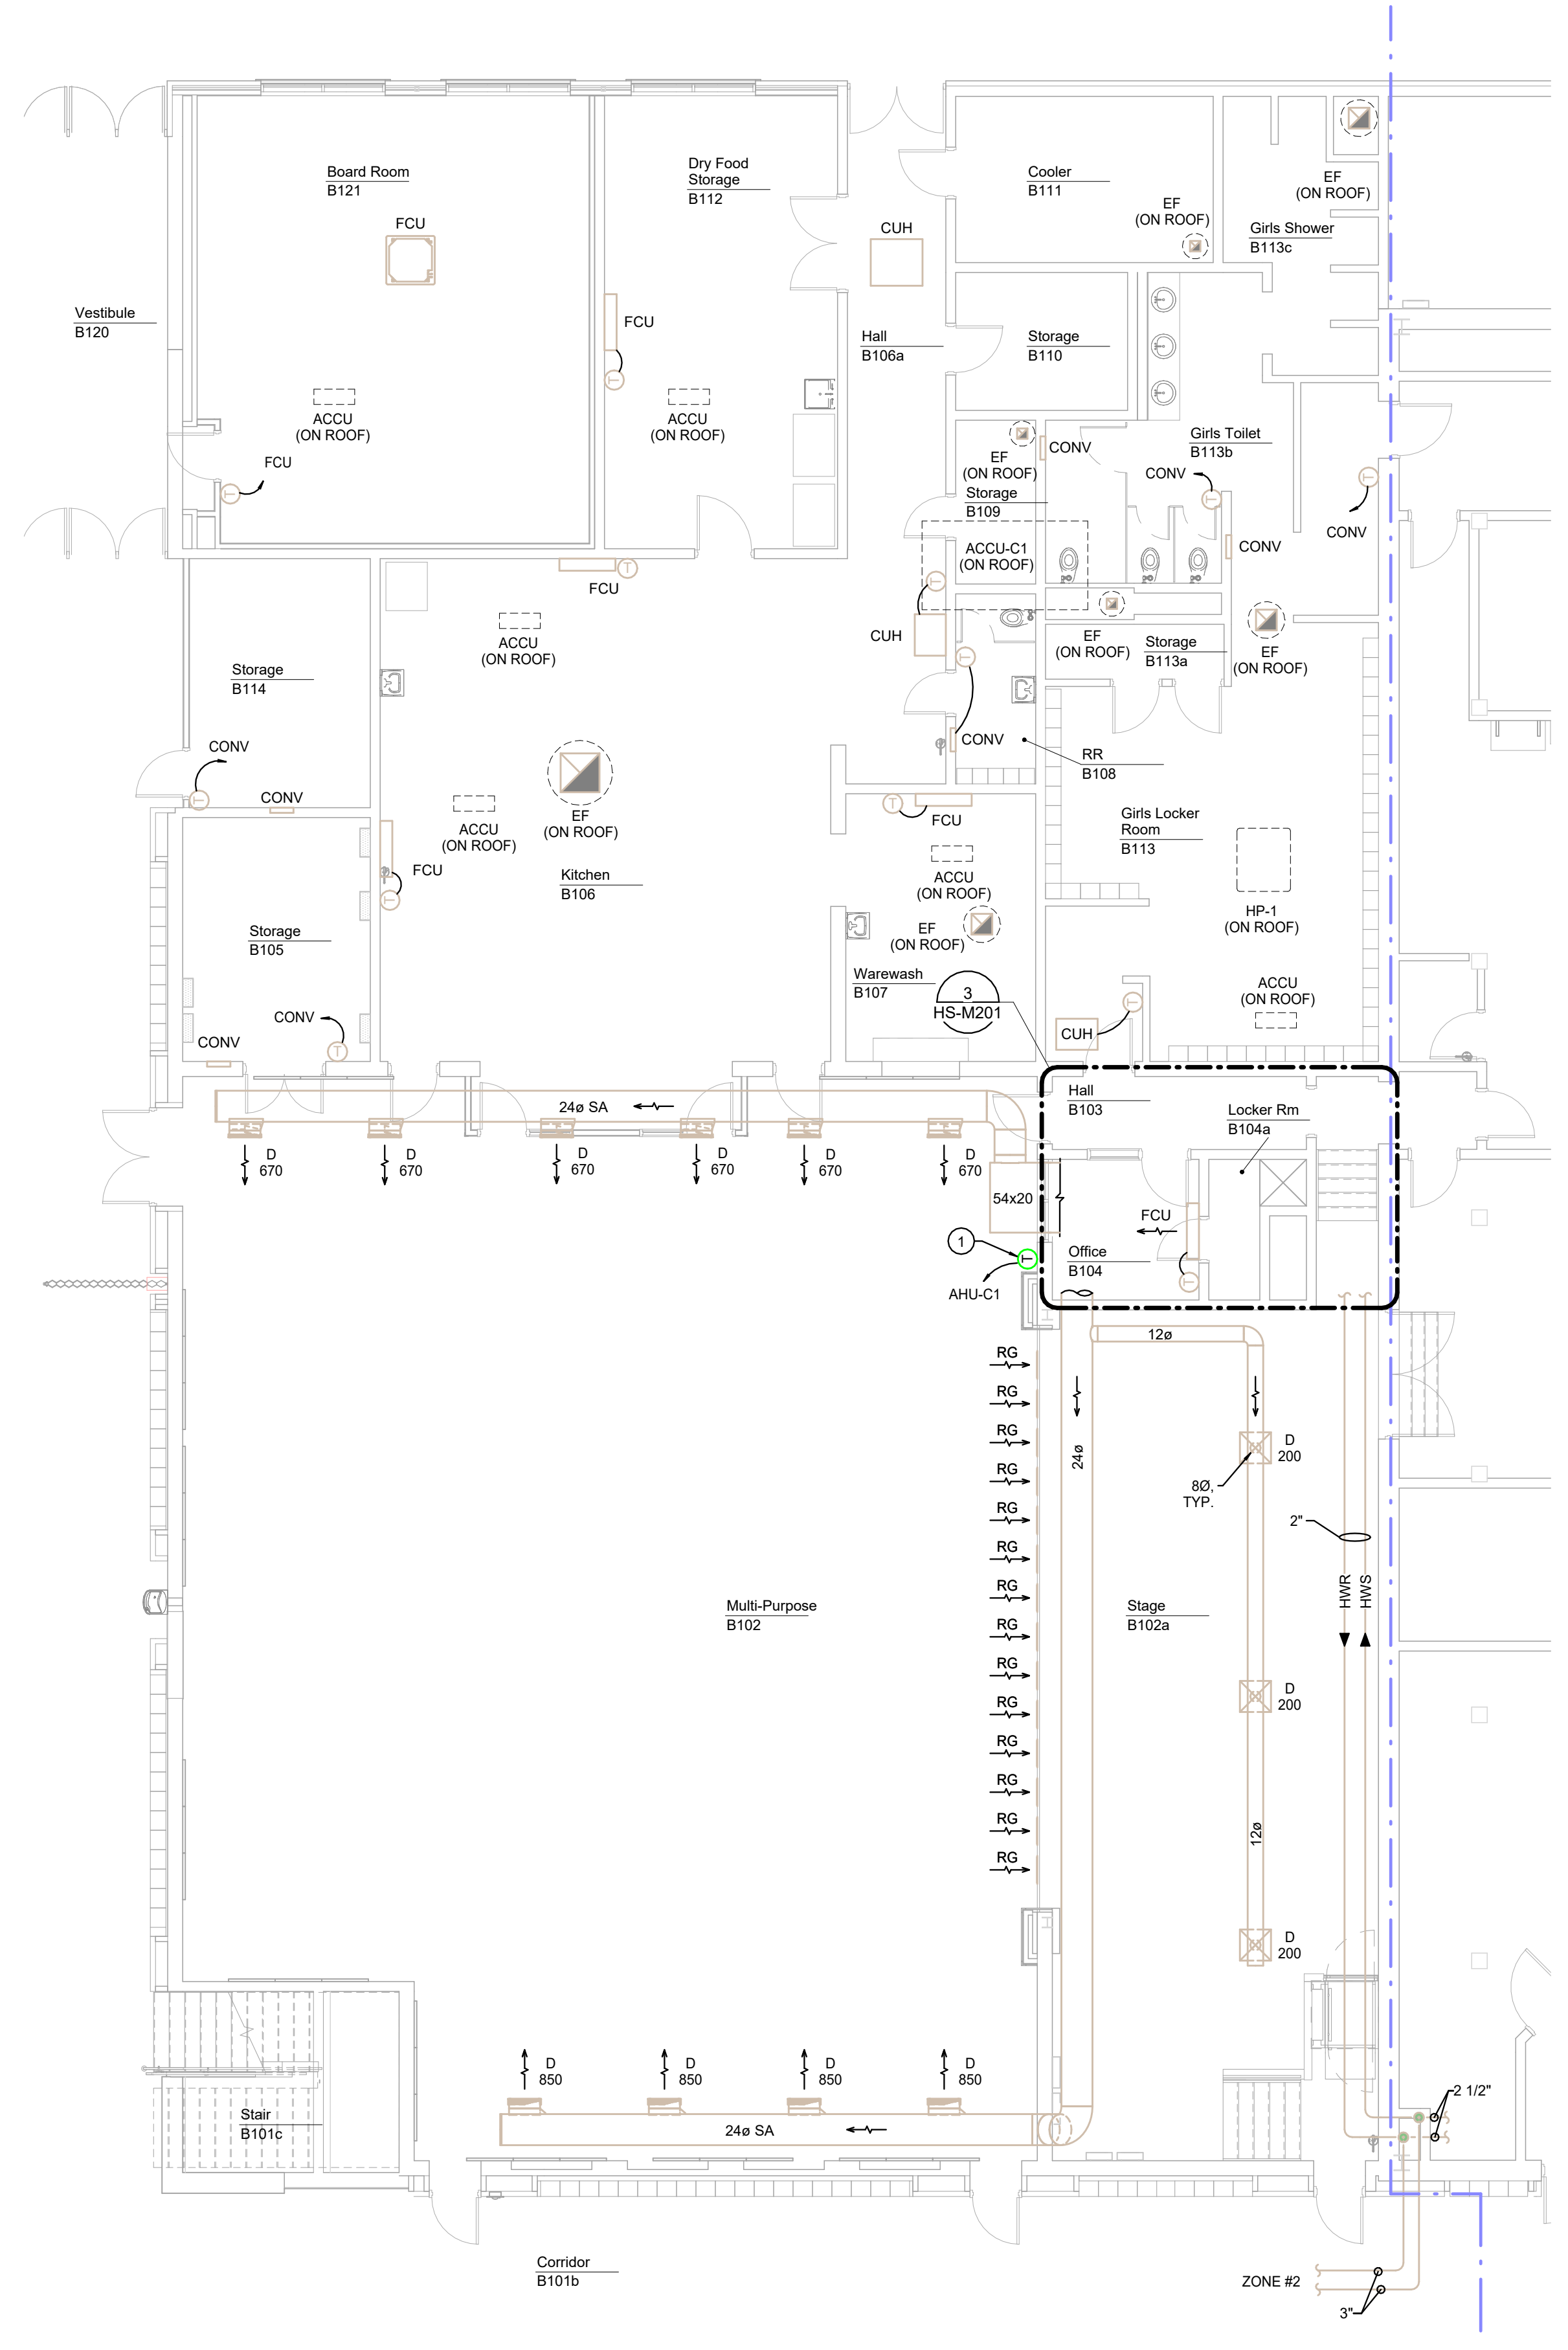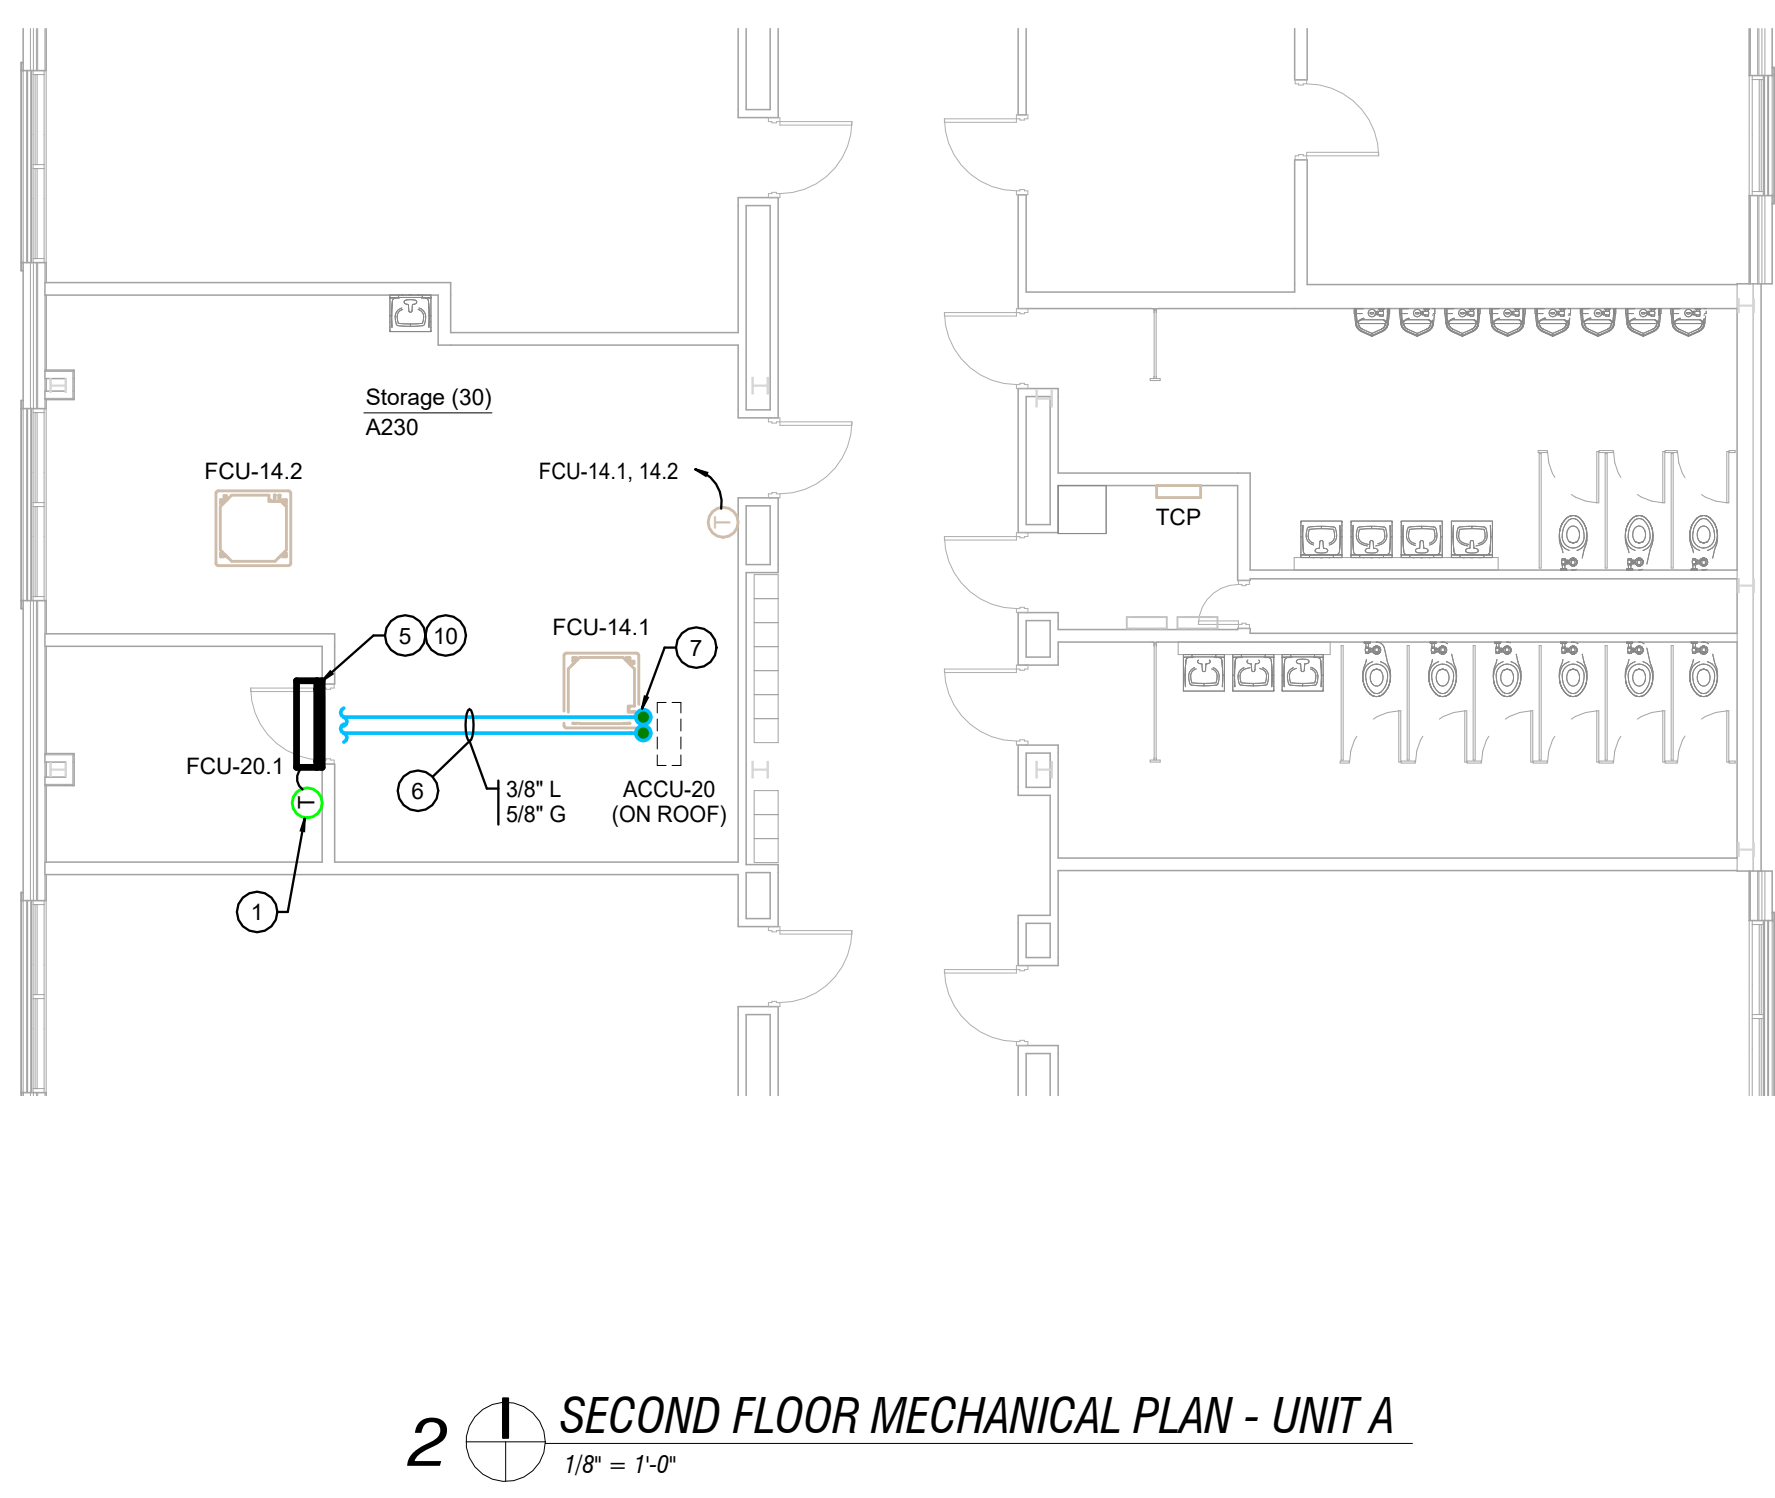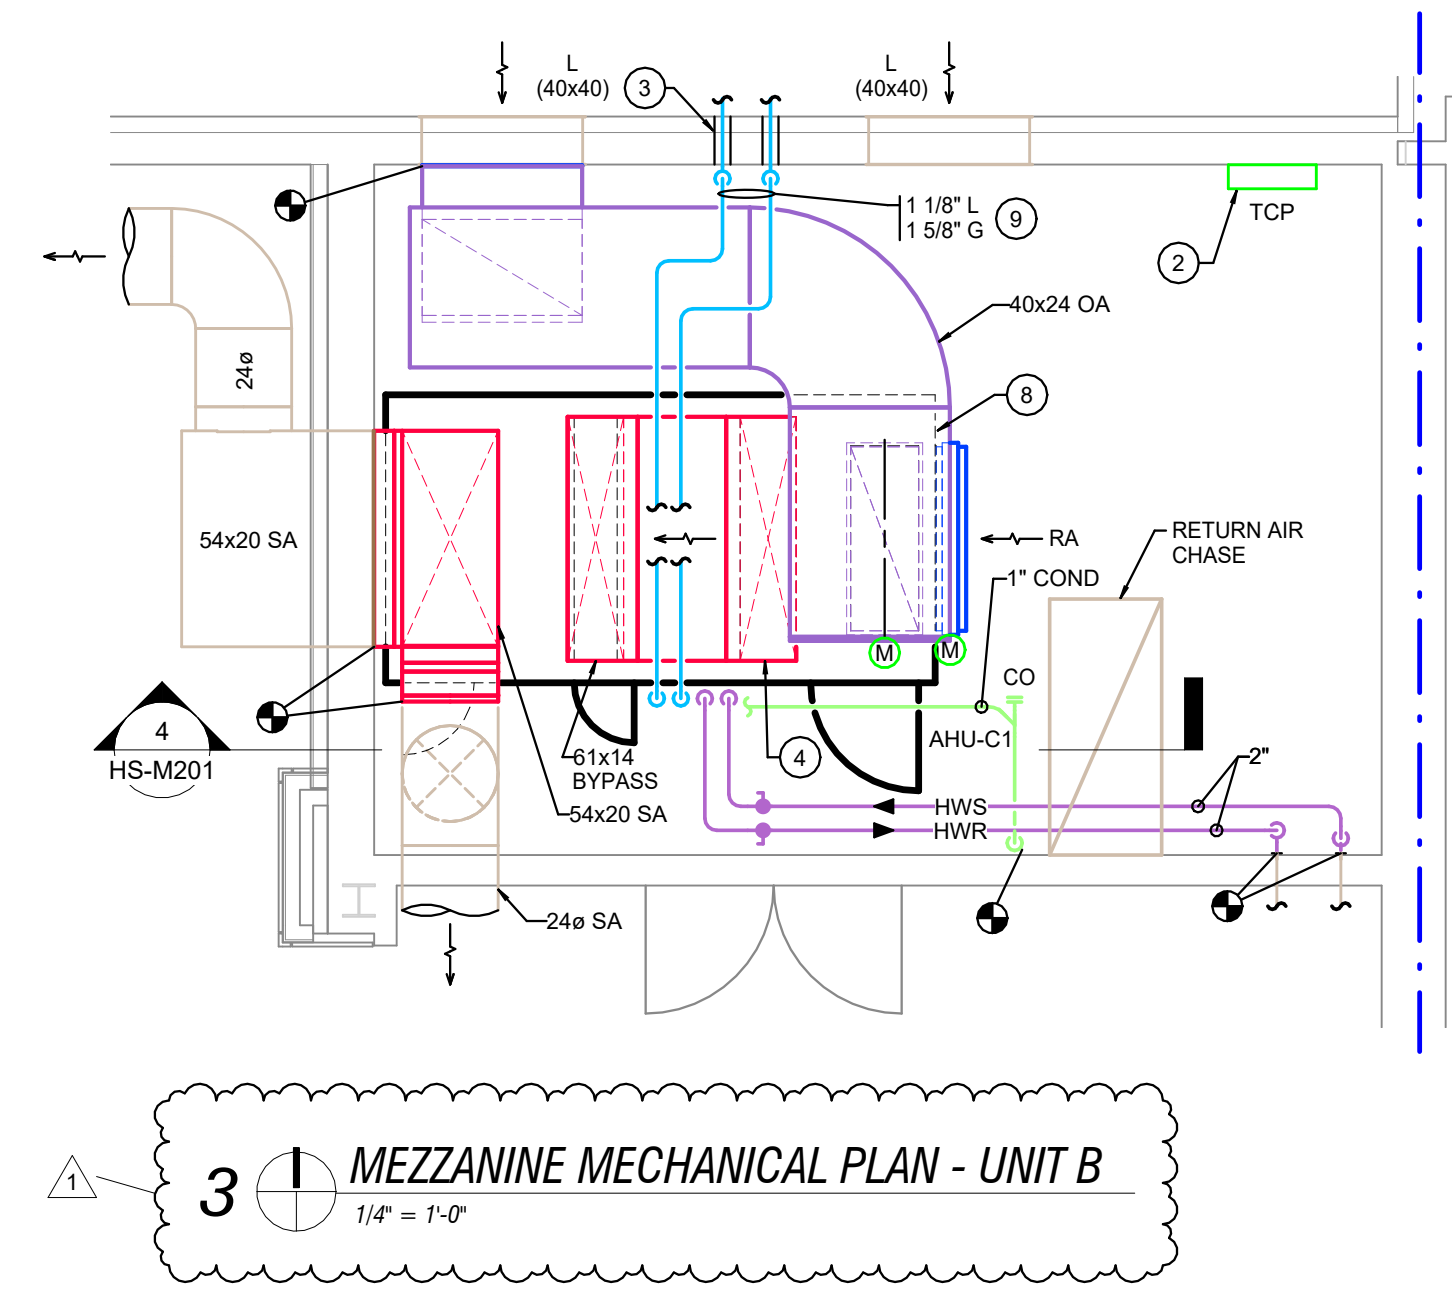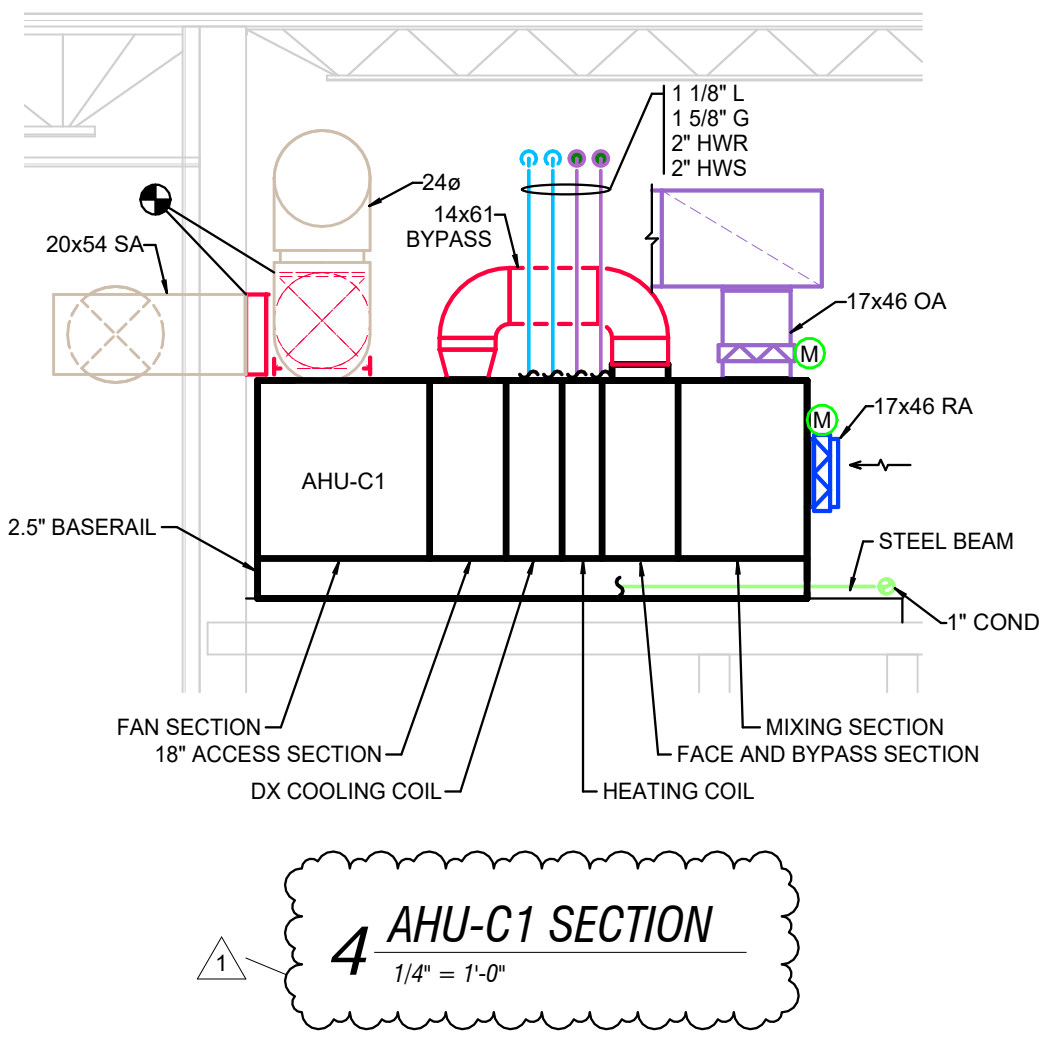

CONTRACTOR IS RESPONSIBLE TO REMOVE EXISTING & INSTALL NEW HARD OR RE-INSTALL LAY-IN CEILINGS AS REQUIRED TO GAIN ACCESS FOR DUCTWORK, PIPING, CONTROL WORK, ETC.

CONTRACTOR SHALL BE RESPONSIBLE TO REPLACE ANY DAMAGED CEILINGS. COORDINATE WITH OWNER FOR MATCHING GRID AND TILE.

PROVIDE AND INSTALL NEW EQUIPMENT TAGS, EQUIPMENT ID, UPDATED ELECTRICAL CIRCUIT DIRECTORY, AND UPDATED BUILDING MANAGEMENT SYSTEM CONTROL GRAPHICS TAG.

- PLAN NOTES**
1. PROVIDE AND INSTALL NEW THERMOSTAT IN SAME LOCATION AS PREVIOUS DEVICE.
 2. NEW TEMPERATURE CONTROL PANEL. REUSE EXISTING POWER FOR NEW PANEL IN SAME LOCATION. MOUNT NEW CONTROLS INSIDE NEW CONTROL PANEL.
 3. CORE DRILL EXTERIOR WALL AS REQUIRED FOR NEW REFRIGERANT PIPING. SEAL AIR AND WATER TIGHT.
 4. EXTERNAL FACE AND BYPASS DUCTWORK. ROUTE FULL SIZE OF AHU FACE AND BYPASS OPENING.
 5. PROVIDE AND INSTALL NEW WALL MOUNTED FAN COIL UNIT IN SAME LOCATION AS PREVIOUS UNIT. PATCH ALL SURFACES TO MATCH SURROUNDINGS.
 6. INSULATE NEW REFRIGERANT PIPING WITH FLEXIBLE ELASTOMERIC INSULATION. REFER TO SPECIFICATIONS FOR MORE INFORMATION.
 7. ROUTE REFRIGERANT PIPING UP THROUGH ROOF WITH NEW PATE PIPE CURB. PATCH ROOF AS REQUIRED TO MAINTAIN ROOF WARRANTY. INSULATE AND JACKET EXTERIOR REFRIGERANT PIPING. REFER TO SPECIFICATIONS FOR MORE INFORMATION.
 8. INSTALL NEW AIR HANDLER ONTO NEW STEEL BEAMS. REFER TO SHEET S1.1 FOR MORE INFORMATION.
 9. REFER TO MANUFACTURER FOR SIZING OF REFRIGERANT PIPING.
 10. TIE INTO EXISTING CONDENSATE PIPING AS REQUIRED.

PRIMARY ENGINEERING INC
Indianapolis
Fort Wayne
2020 Lake Park
280.424.0444
info@primary-eng.com

All concepts, ideas, plans, and details as shown on this document are the sole property of Primary Engineering, Inc. and shall not be used for any other purpose without their expressed written consent. The project owner shall be permitted to retain copies for information and reference purposes.
2024 © Primary Engineering, Inc.

Clinton Central Rooftop Unit Replacement

815 IN-29, Michigantown, IN 46057


CERTIFICATION:

DATE: 10-16-2024
COMM: 24594

SCHOOL: Clinton Central Jr/Sr High
815 IN-29
Michigantown, IN 46057

TITLE:
**MECHANICAL
PLANS - UNIT A
AND B**

SHEET:
HS-M201

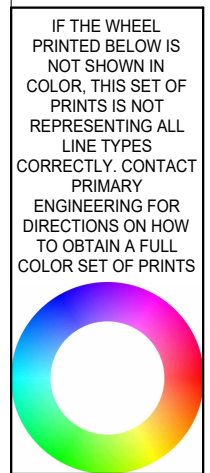

IF THE LABEL PRINTED BELOW IS NOT SHOWN IN COLOR, THIS SET OF PRINTS IS NOT REPRESENTING ALL LINE TYPES. CORRECTLY CONTACT ENGINEERING FOR INSTRUCTIONS ON HOW TO OBTAIN A FULL COLOR SET OF PRINTS.

ROOFTOP UNIT SCHEDULE table with columns for TAG, MFR, MODEL, SERVICE, AIRFLOW, ESP, MIN. O.A., DRIVE TYPE, SUPPLY MOTOR, RELIEF MOTOR, SUPPLY RPM, RELIEF AIRFLOW, RELIEF MOTOR (HP), INPUT (KW), EAT/LAT, STAGES, ELEC (V/PH), MCA, MOCOP, TOTAL (TONS), SENS. (MBH), TONS, EDB/EWB, LDB/LWB, AMBIENT TEMP, STAGES, EER, ELEC (V/PH), MCA, MOCOP, FILTER TYPE, OP. WEIGHT, REFRIGERANT, REMARKS.

UNIT VENTILATOR SCHEDULE (DX COOLING) table with columns for TAG, MFR, MODEL, SERVICE, AIRFLOW, MIN. O.A., FAN SPEED, FAN (HP), ESP (IN. W.C.), TOTAL CAP., SENS. CAP., EDB/EWB, LDB/LWB, TOTAL, EAT/LAT, EWT/LWT, FLOW (CFM), WPD (FT), ROWS, CONTROL VALVE, ELEC (V/PH), MCA, MAX FUSE SIZE, FILTER TYPE, REMARKS.

VRF OUTDOOR HEAT PUMP UNIT SCHEDULE table with columns for TAG, MODULE #, MFR, MODEL, EQUIP SERVED, COOLING CAP, SENS COOLING CAP, CAPACITY, HEATING CAP, # OF MODULES, MAX REF LINE LENGTH, COOLING COP, HEATING COP, REFRIG, REFRIG CHARGE, ELEC (V/PH), MCA/UNIT, MOP/UNIT, WT/UNIT, REMARKS.

VRF INDOOR UNITS table with columns for TAG, MFR, MODEL, TYPE, LOCATION, COOLING CAP, HEATING CAP, CFM, REFRIG, CONTROL TYPE, ELEC (V/PH), MCA (A), REMARKS.

CONDENSING UNIT SCHEDULE table with columns for TAG, MFR, MODEL, EQUIP SERVED, REFRIG, TOTAL CAP, SENS CAP, SUCTION AMB, EVAP CFM, EVAP EDB/EWB, MIN EER, ELEC (V/PH), MCA, MOP, WEIGHT, REMARKS.


AIR HANDLER SCHEDULE - REV. 10/31/2024 table with columns for TAG, SPACE SERVED, MFR, MODEL, UNIT DIM WxLxH, UNIT WEIGHT, FILTER AREA, FILTER APD, FILTER TYPE, SUPPLY FAN, OUTSIDE AIR, TSP, ESP, RPM, FAN TYPE, DRIVE TYPE, MOTOR (HP), MOTOR (BHP), ELECTRICAL, MODULATION, DX COOLING COIL, SENS CAP, EAT, LDB, LWT, COIL FLOW, WPD, APD, ROWS, FINS, DRAW THRU TRAP DEPTH, HOT WATER COIL, TOTAL CAP, EAT, ENT, LWT, WPD, APD, ROWS, FINS, TUBE WALL THICK, CONTROL VALVE, REMARKS.

INPUT/OUTPUT SUMMARY TABLE with columns for OUTPUT (DIGITAL/ANALOG), INPUT (DIGITAL/ANALOG), ALARMS, and SOFTWARE. Includes rows for High School, Point Description, Outside Air, SZ Rooftop Units, VRF split system, Air Handler, and Unit Ventilator.



All concepts, ideas, plans, and details as shown on this document are the sole property of Primary Engineering, Inc., and shall not be used for any other purpose without their expressed written consent.

Clinton Central Rooftop Unit Replacement 815 IN-29, Michigantown, IN 46057

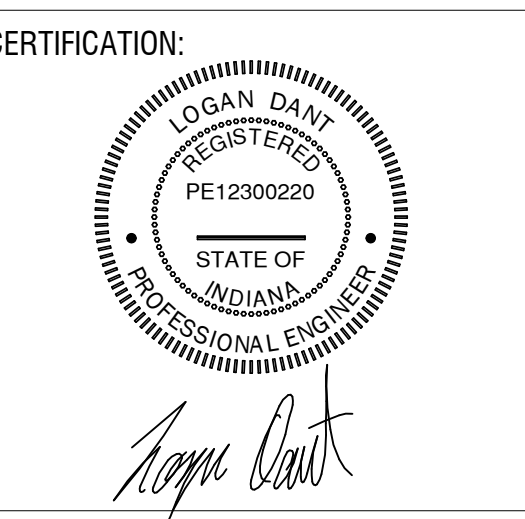

CERTIFICATION: DATE: 10-16-2024 COMM: 24594 SCHOOL: Clinton Central Jr/Sr High 815 IN-29 Michigantown, IN 46057

MECHANICAL SCHEDULE SHEET

SHEET:

HS-M501