

People-first places.

CLIENT NAME Project Name & Number Fort Wayne Community Schools

Wayne HS Dining - 20230232

Date 11/4/2024

ADDENDUM NO. 3

This addendum is issued as a supplement to the plans and specifications and shall be considered an integral part of the same.

Item: 3.01

Location: Sheets A2.1F, A5.1, A6.1, A6.2, A7.1, A10.1

Description: Clarification provided for 'screenwalls' and booth details in Dining area.

Item: 3.02 Location: Sheet A5.1

Description: Detail 4 modified to align with structural drawings.

Item: 3.03

Location: Sheet A9.1F, A9.2, A10.1

Description: Projection screen added in Dining.

Item: 3.04

Location: Sheets A9.1F, A10.2, M2.1F, M2.4F, E2.1F, E2.4, E3.1F, E6.2, E6.3, KH25 THRU KH32

Description: Add new Hood-6 and accompanying exhaust fan, grease duct and make-up air unit added to Test Kitchen

F1. Add gas line on the roof to the new make-up air unit. Modify duct layout in F1 to accommodate added equipment and ductwork. See electrical drawings for circuitry and wiring information. Rooftop maintenance receptacle shifted to be in proximity to new equipment. Lighting and TV placement adjusted accordingly.

Item: 3.05

Location: Sheet A11.1F

Description: Hatch region modified for clarification on floor finishes in Serving and Kitchen. Detail 5 omitted from sheet.

Item: 3.06

Location: Sheets P2.0F, P3.2

Description: Remove the sink along the south wall of Storage F35. Change the floor drains in Warewash F38 to be

trench drains provided by FSEC and installed by plumbing contractor.

Item: 3.07

Location: Sheet E2.1F

Description: Circuits feeding equipment located underneath hoods noted to have shunt trip breakers.

Item: 3.08

Location: Sheets E2.1F, E2.4, E3.1F

Description: Provide unit price for electrical contractor to provide the following items in their entirety: (1) panelboard K,

(51) F1 light fixtures, (6) SW2 on/off switches with integral occupancy sensor, and (7) SW3 on/off switches.

Item: 3.09

Location: Sheets E2.1F, E6.2, E6.3

Description: Power to KE-163 Test Kitchen Service Counter adjusted to include Drop-In Induction Cooktop.

3.10 Item:

Specifications Location:

Add the following specifications sections: 02 00 00 Existing Materials Available for Project, 09 51 00 Description:

Acoustical Ceilings, 10 44 13 Fire Protection Cabinets, 10 44 16 Fire Extinguishers, and 11 52 13

Projection Screens.


Each contractor is responsible for incorporating all changes into their bid.

Respectfully submitted,

Jeremiah Hatfield, Senior Architect Design Collaborative, Inc. JMH/KLB

3 BUILDING SECTION

SCALE: 1/8" = 1'-0"

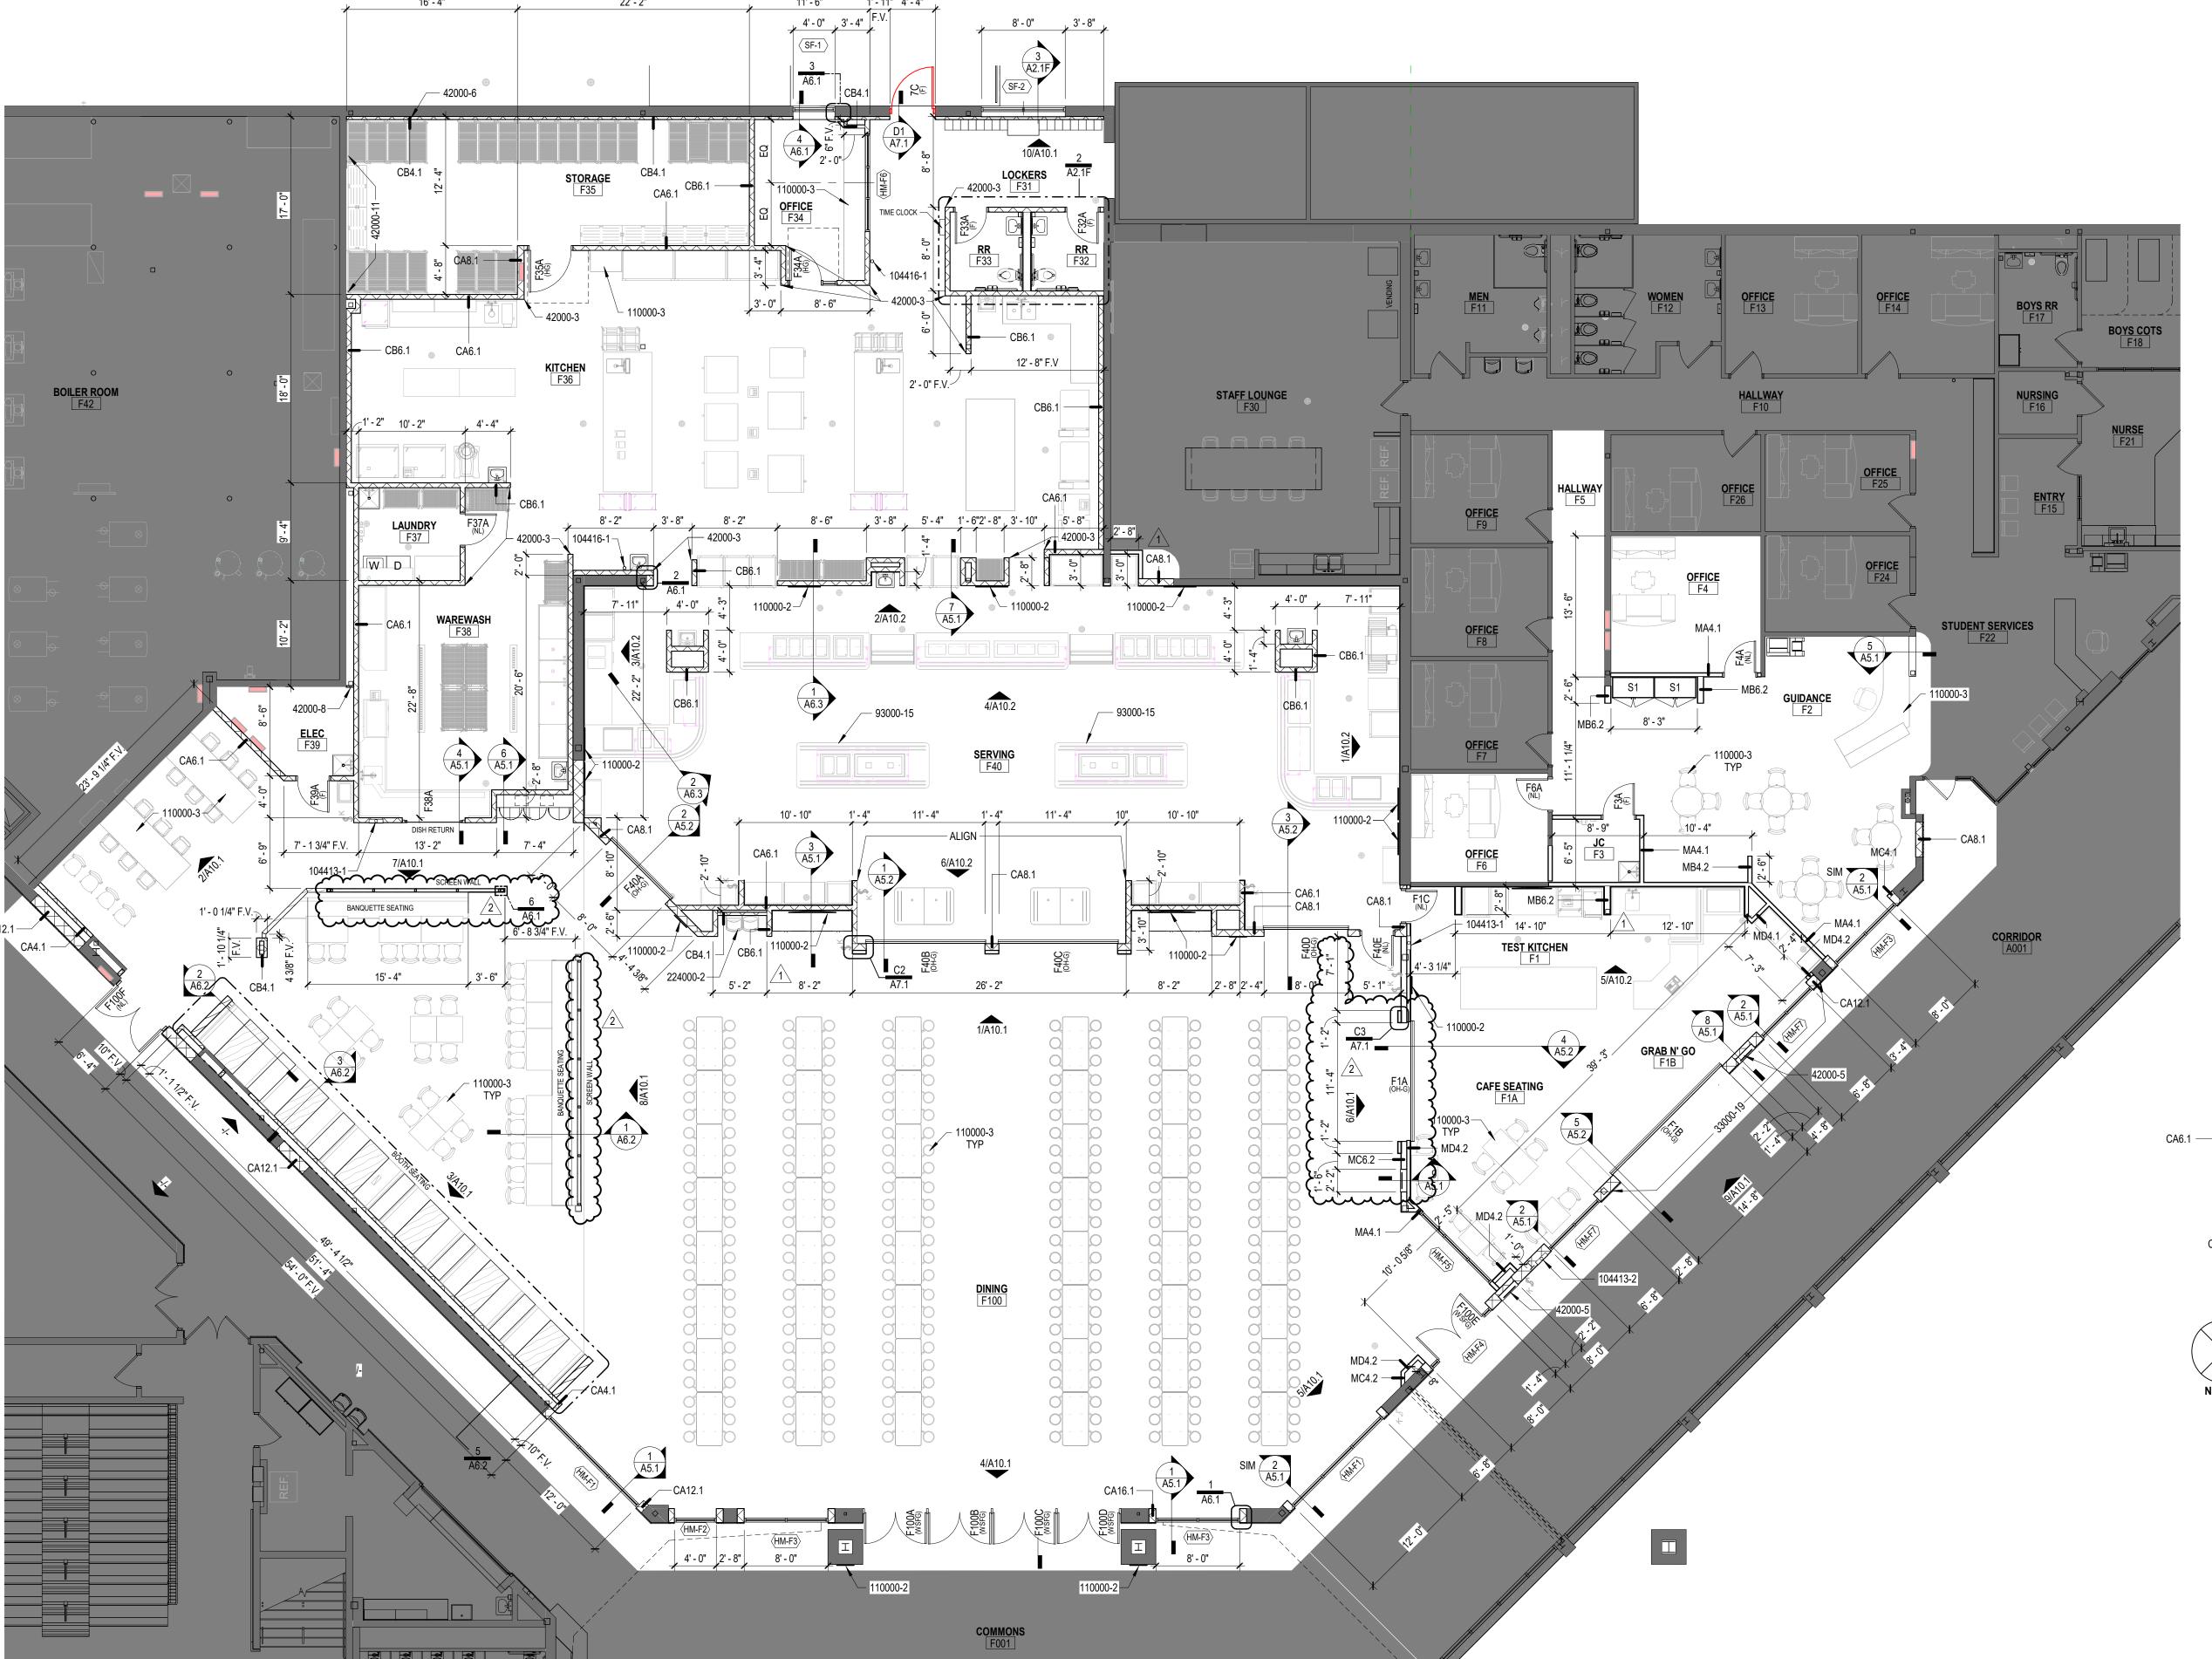

FLOOR PLAN - MAIN LEVEL - UNIT F SCALE: 1/8" = 1'-0"

GENERAL CONSTRUCTION NOTES

REFER TO GENERAL INFORMATION SHEET G0.2 FOR SYMBOLS LEGENDS AND ABBREVIATIONS.

CONTRACTORS INSTALLED WORK IS TO COMPLY WITH ALL LOCAL, STATE AND NATIONAL BUILDING CORPORATION AND THE AMERICANO MUTUADIO AND THE AMERICAN

NATIONAL BUILDING CODES AND THE AMERICANS WITH DISABILITY ACT

CONTRACTORS ARE TO OBTAIN ALL NECESSARY PERMITS REQUIRED TO COMPLETE
THE PROJECT.

CONTRACTORS SHALL FULLY REVIEW ALL PROJECT DOCUMENTS AND PROVIDE ALL
INFORMATION AS REQUIRED FOR SUBMITTALS. CONTRACTORS ARE RESPONSIBLE
TO REVIEW THE FULL EXTENT OF THE WORK PRIOR TO EXECUTION OF THE RIDS.

CONTRACTORS SHALL FULLY REVIEW ALL PROJECT DOCUMENTS AND PROVIDE ALL INFORMATION AS REQUIRED FOR SUBMITTALS. CONTRACTORS ARE RESPONSIBLE TO REVIEW THE FULL EXTENT OF THE WORK PRIOR TO EXECUTION OF THE BIDS.

DO NOT SCALE THE DRAWINGS. PLEASE FORWARD ALL QUESTIONS REGARDING CLARIFICATION OF DIMENSIONS TO THE ARCHITECT/ ENGINEER FOR IMMEDIATE RESOLUTION.

NOTIFY ARCHITECT IMMEDIATELY OF ANY DISCREPANCIES PRIOR TO SHOP DRAWING PREPARTION, MATERIAL FABRICATION AND/OR INSTALLATION OF WORK.

CONTRACTOR SHALL INCLUDE A SIGNED AUTHORIZATION WITH ALL MATERIAL AND EQUIPMENT SHOP DRAWING SUBMITTALS INDICATING THAT FIELD DIMENSIONS WERE OBTAINED AND ARE ACCURATE TO THE BEST OF THEIR KNOWLEDGE.

CONTRACTOR SHALL FIELD VERIFY ALL DIMENSIONS & CONDITIONS RELATIVE TO THE PROJECT PRIOR TO MATERIAL FABRICATION & INSTALLATION. CONFLICTS, OMMISSIONS AND/OR DISCREPANCIES SHALL BE BROUGHT TO THE ATTENTION OF THE ARCHITECT/ ENGINEER IMMEDIATELY FOR RESOLUTION AND PRIOR TO PROCEEDING WITH THE WORK.

CONTRACTOR SHALL COORDINATE ALL WORK WITH THE EQUIPMENT MANUFACTURER TO ENSURE APPROPRIATE WALL BLOCKING REQUIREMENTS FOR SUPPORT OF THE EQUIPMENT AND ROUGH IN CLEARANCE REQUIREMENTS FOR EQUIPMENT INSTALLATION AND USE.

CONTRACTOR TO LAY OUT AND MARK ALL WALLS AND OPENINGS PRIOR TO CONSTRUCTION. ANY DISCREPANCIES SHALL BE REPORTED TO THE ARCHITECT IMMEDIATELY FOR RESOLUTION.

DETAILS AND NOTES ON THESE PAGES MAY BE GENERALIZED AND SHALL SERVE TO AID THE CONTRACTOR IN EVALUATION OF THIS WORK AS REQUIRED FOR NEW CONSTRUCTION, BUT DRAWINGS SHALL NOT BE HELD TO BE ALL INCLUSIVE. CONTRACTOR TO PERFORM FIELD ALTERATIONS, PATCHING AND PREPARATION FOR ALL NEW WORK AS REQUIRED WHETHER OR NOT IT IS SPECIFICALLY NOTED IN THESE DRAWINGS. CONSULT WITH PRODUCT MANUFACTURER FOR ALL THEIR REQUIREMENTS OF INSTALLATION.

IT IS PREFERRED THAT ALL CONTRACTORS UTILIZE THE SAME FIRESTOPPING CONTRACTOR FOR THE FIRESTOPPING SCOPE OF WORK. SEE THE FIRESTOPPING NOTES ON THE LIFE SAFETY PLAN FOR MORE INFORMATION.


ALL MASONRY CUTTING/INFILL IS INTENDED TO ALIGN TO EXISTING STACK BOND JOINTS AT 16" O.C., REQUEST CLARIFICATION FROM ARCHTECT IF LAYOUT DOES NOT ALLOW.


	DI ANI CONCEDITATIONI VEVNOTES
	PLAN CONSTRUCTION KEYNOTES
33000-19	THICKENED EDGE SLAB DOWELLED INTO EXISTING ADJACENT SLAB - SEE STRUCTURAL
42000-3	PROVIDE BULLNOSE CMU UNITS AT CORNER, TYP. IN KITCHEN AREA.
42000-5	6" RECESS IN NEW CMU WALL FOR MONITOR NICHE. VERIFY SIZE WITH MONITOR SIZE.
42000-6	NEW 4" CMU WALL TIED TO EXISTING EXTERIOR WALL.
42000-8	NEW CMU SOAPS AROUND EXISTING COLUMN
42000-11	ASSUME 25 SF OF JOINTS AT DEMO'D CHASE TO BE RETOOLED. PATCH CMU A REQUIRED AT DEMO'D WALL AND SINK.
93000-15	CWT-5 TO BE INSTALLED ON COLD BARS. BOTTOM EDGE OF TILE TO RECEIVE SCHLUTER ECK-E.
104413-1	FIRE EXTINGUISHER CABINET, FULLY RECESSED. MOUNTING HEIGHT PER AD REQUIREMENTS.
104413-2	FIRE EXTINGUISHER CABINET. SURFACE MOUNTED. MOUNTING HEIGHT PER ADA REQUIREMENTS
104416-1	SURFACE MOUNTED FIRE EXTINGUISHER W/BRACKET. MOUNTING HEIGHT PE ADA REQUIREMENTS.
110000-2	OWNER FURNISHED/CONTRACTOR INSTALLED TV / DISPLAY MONITOR. PROVIDE ROUGH-INS FOR POWER AND DATA. COORDINATE FINAL MOUNTING HEIGHT WITH OWNER.
110000-3	OWNER FURNISHED MOBILE CASEWORK / FURNITURE.
224000-2	WATER COOLER, PAIR, ADA COMPLIANT, SEE PLUMBING DRAWINGS AND SPECIFICATIONS.


GENERAL NOTE: KITCHEN SERVICE EQUIPMENT SHOWN HALFTONED ON ARCHITECTURAL SHEETS -SEE KITCHEN SERVICE EQUIPMENT DRAWINGS FOR MORE INFORMATION

#	DESCRIPTION	MODEL	MFGR.	COMMENTS
1	1 1/4" DIAM. GRAB BAR, 18" LONG	B-5806 x 18	BOBRICK	
2	1 1/4" DIAM. GRAB BAR, 36" LONG	B-5806 x 36	BOBRICK	
3	1 1/4" DIAM. GRAB BAR, 48" LONG	B-5806 x 48	BOBRICK	
4.2	TOILET TISSUE HOLDER, DOUBLE ROLL, SURFACE-MOUNTED	RT23	CONTINENTAL	
5	SANITARY NAPKIN DISPOSAL	6140	RUBBERMAID	
8	LIQUID SOAP DISPENSER, MANUAL, WALL MOUNT	9390	IMPACT	BY OWNER
9	PAPER TOWEL DISPENSER, MANUAL, WALL MOUNT	B-263	BOBRICK	
11	18" x 36" ANGLE FRAME MIRROR	B-165 1836	BOBRICK	

UNLESS OTHERWISE NOTED, ALL ACCESSORIES TO BE PROVIDED AND INSTALLED BY CONTRACTOR

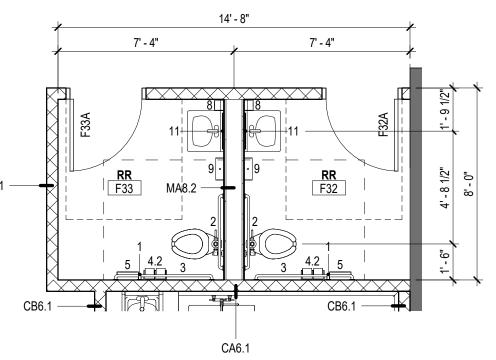

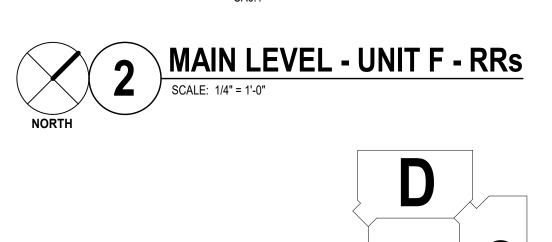

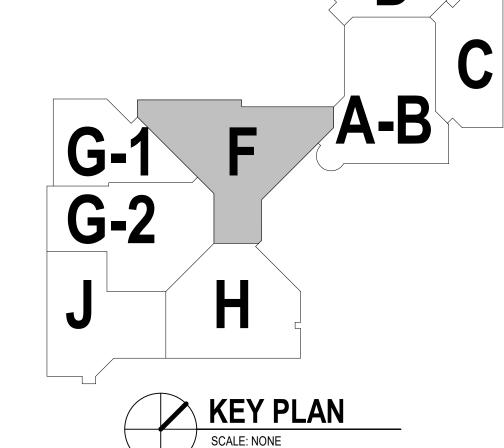

ESIGN OLLABORAT

DINING & KITCHEN

No.

10500162

STATE OF

NOINANA

APCHITECTUME

APCHITECTU

All concepts, ideas, designs, plans and details as shown on this document are the sole property of Design Collaborative, Inc., and shall not be used for any purpose without their expressed written consent. The owner shall be permitted to retain copies for information and reference.

pies for information and reference.

BID/PRICING SET

BID/PRICING SET

REVISIONS

DATE DESCRIPTION

10/17/2024 ADD-01
11/04/2024 ADD-03

FLOOR PLAN - MAIN LEVEL - UNIT F

A2.1F

42000-5 6" RECESS IN NEW CMU WALL FOR MONITOR NICHE. VERIFY SIZE WITH MONITOR SIZE. NEW CMU LINTEL, SEE STRUCTURAL. PROVIDE NEW CMU SOAPS AT NEW STEEL LINTEL. 2x WOOD BLOCKING. SECURE TO SUBSTATE. 5/4" THICK OAK CAP W/ EASED EDGES ALUMINUM FRAME, NO GLAZING, 2" X 3" RECTANGULAR TUBES. INTERSECTIONS TO BE WELDED AND ANCHOR POINTS TO BE CONCEALED. FINISH: 2 COAT CUSTOM COLOR MOTORIZED OVERHEAD COILING COUNTER DOOR, REFER TO SECTION AND SPECIFICATIONS. NEW THIN SET EPOXY TERRAZZO INFILL, FEATHER EDGE FLUSH WITH ADJACENT TERRAZZO. COLOR TO MATCH EXISTING TERRAZZO. 3-5/8" LIGHT GA. METAL STUDS 6" LIGHT GA. METAL STUDS 5/8" AQUA-TOUGH GYPSUM-FIBER ABUSE-RESISTANT PANELS, PAINTED. SCHLUTER QUADEC PIECE TO BE INSTALLED AT EDGE OF EXPOSED TILE. SCHLUTER DESIGN LINE DECORATIVE BORDER PROFILE TO BE INSTALLED AT TOP EDGE OF EXPOSED TILE IN SERVING AREA.

24"X24" SUSPENDED ACOUSTICAL TILE [ACT] SYSTEM. SEE REFLECTED CEILING PLAN FOR SIZE & LOCATIONS 2" THICK SOUND-ABSORBING WALL PANEL WITH SQUARE EDGE. BASIS OF DESIGN KINETICS NOISE CONTROL, INC. "HARDSIDE PANELS", MIN NRC 0.95. VERIFY FINISHES - FABRIC: GUILFORD OF MAINE FR701 2100, COLOR: STEEL

110000-2 OWNER FURNISHED/CONTRACTOR INSTALLED TV / DISPLAY MONITOR. PROVIDE ROUGH-INS FOR POWER AND DATA. COORDINATE FINAL MOUNTING HEIGHT WITH OWNER.

114000-4 NEW STAINLESS STEEL SILL

123661-1 SOLID SURFACE COUNTERTOP. SEE FINISH PLANS & SCHEDULE FOR LOCATIONS & TYPES. SEE A10. SERIES SHEETS FOR COUNTER HEIGHTS. 1/4" THICK SOLID SURFACE INSTALLED ON WALL WITH 100% SILICONE, ALL SEAMS TO BE EPOXYED.


8 MONITOR NICHE @ CMU WALL

SCALE: 3/4" = 1'-0"


____ 110000-2

42000-5


____ 123661-1

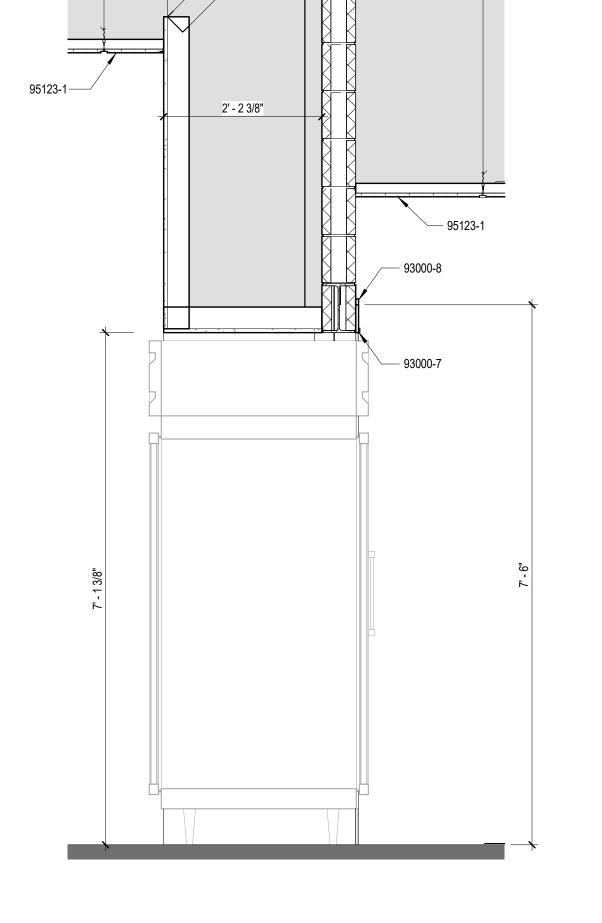

KITCHEN TO SERVING SECTION SCALE: 3/4" = 1'-0"

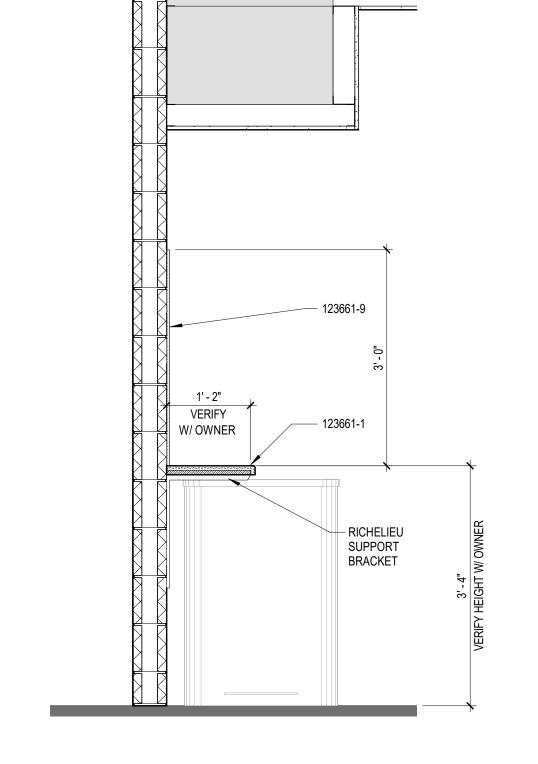

TRASH ALCOVE SECTION

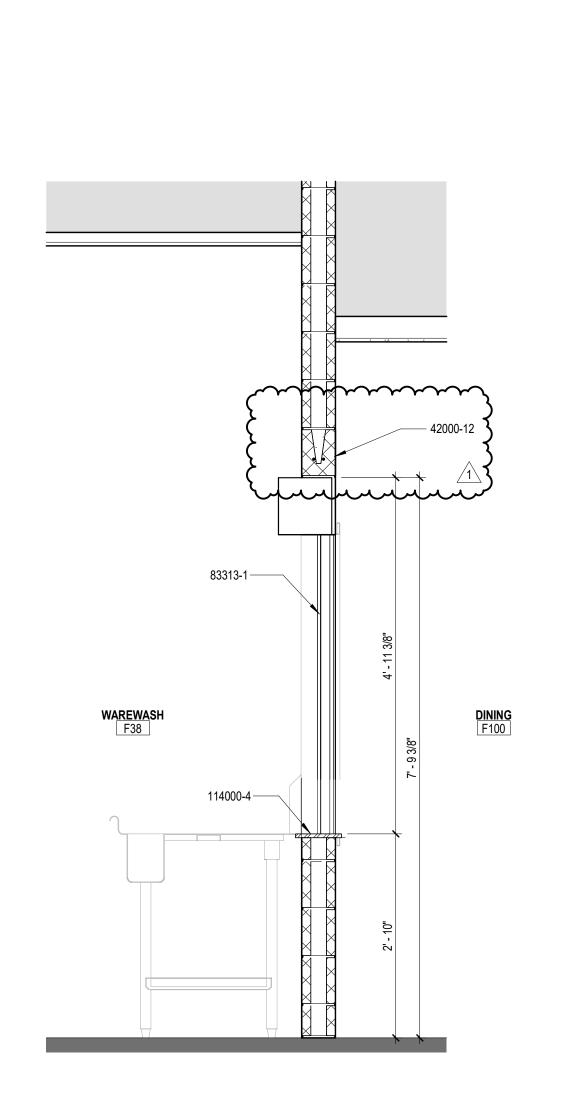

DISH RETURN SECTION

SCALE: 3/4" = 1'-0"

110000-2-

123661-1

92216-6-

9 MONITOR NICHE IN STUD/GYP WALL
SCALE: 3/4" = 1'-0"

 \cdots

SEE BANQUETTE

SECTION ON A6.2

FOR MORE INFORMATION — 81216-1

____ 3/4" PL-1 WALL CAP

— WOOD BLOCKING

- 1/2" PLYWOOD, EXPOSED -SURFACES TO BE PL-1

AS REQUIRED

RUBBER BASE

10 NORTH SCREEN WALL
SCALE: 3/4" = 1'-0"


COLUMN (BEYOND)

92216-6

5 HALFWALL SECTION


SCALE: 3/4" = 1'-0"

----- 1/2" REVEAL

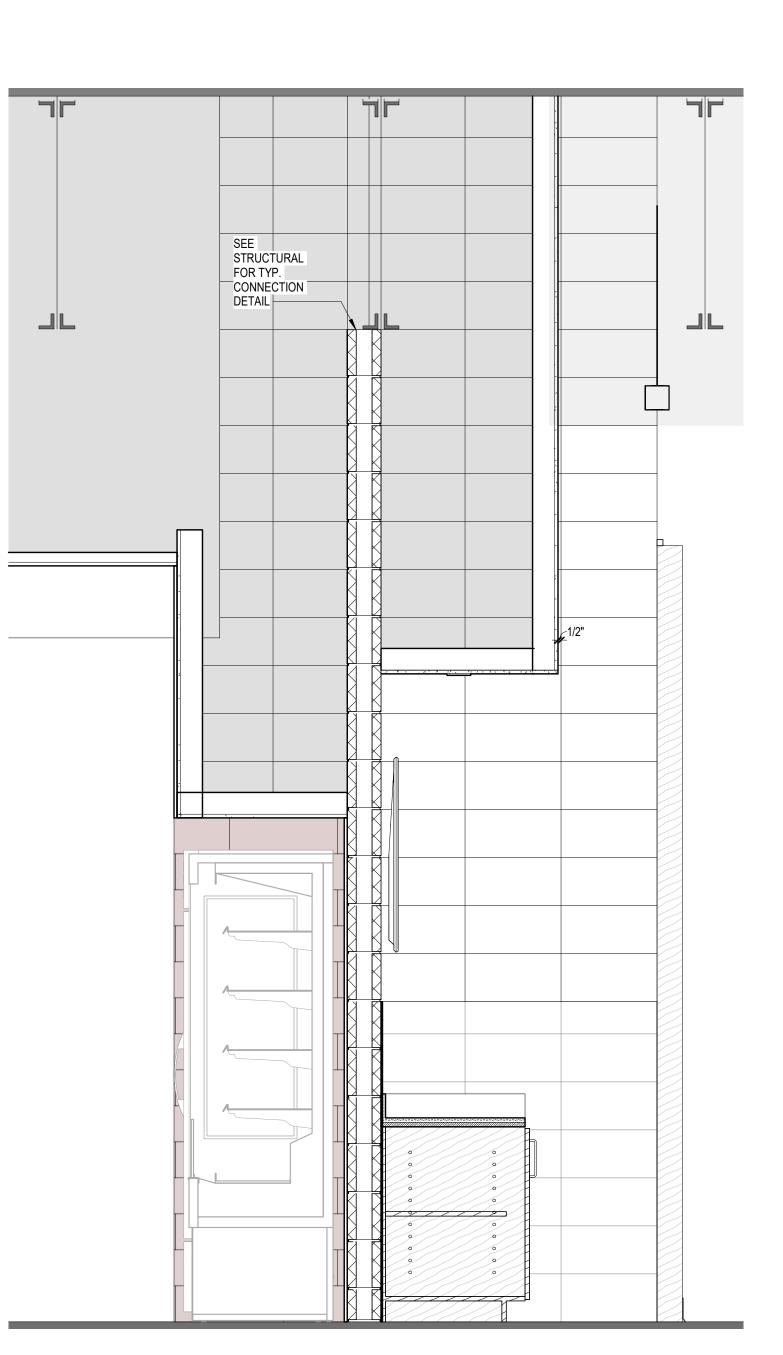


3 CONDIMENT/MERCH SECTION

SCALE: 3/4" = 1'-0"

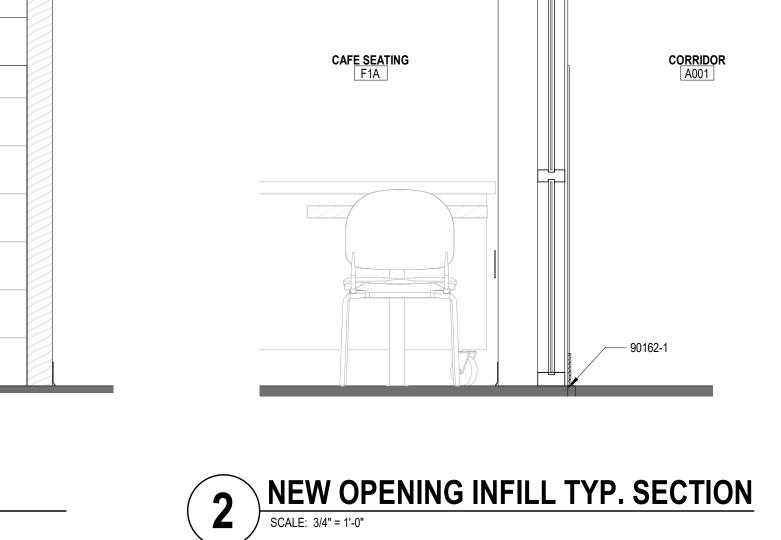

ADDED SUPPORT FOR CMU ABOVE AS NEEDED, SEE STRUCTURAL —

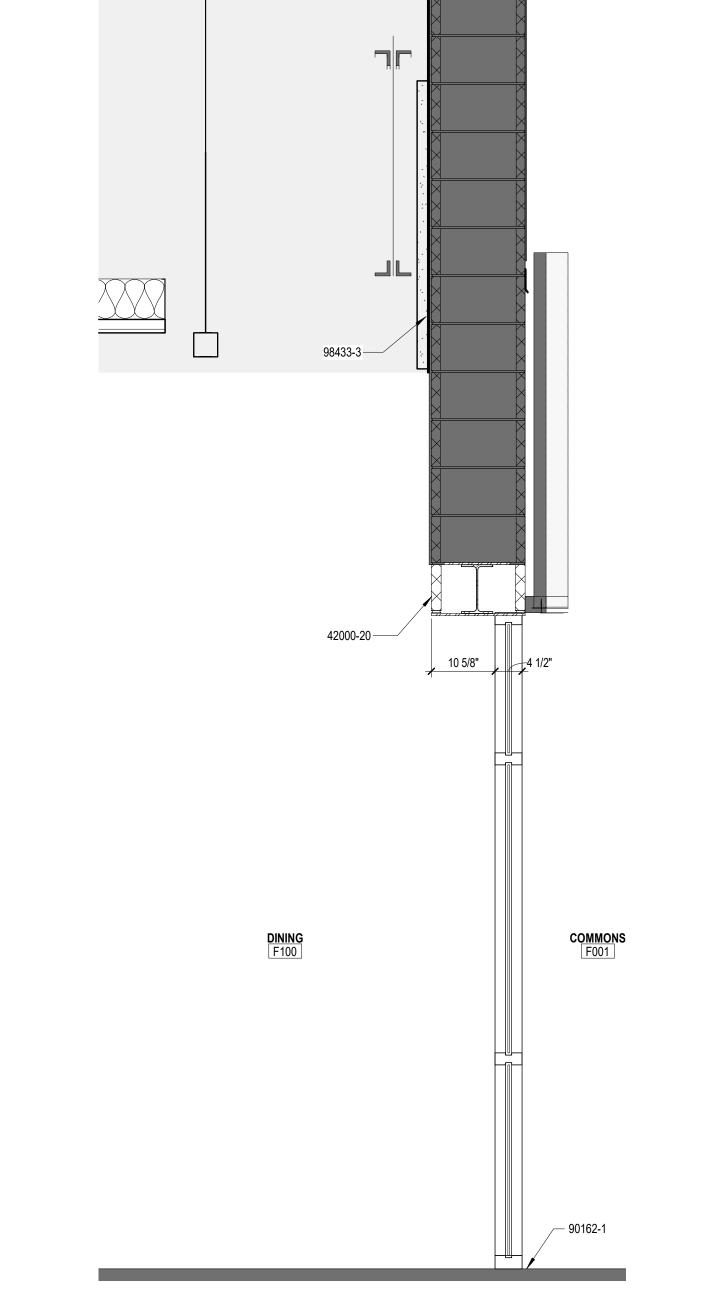

1 NEW OPENING @ CMU WALL

SCALE: 3/4" = 1'-0"

WALL SECTIONS

All concepts, ideas, designs, plans and details as shown on this document are the sole property of Design Collaborative, Inc., and shall not be used for any purpose without their expressed written consent. The owner shall be permitted to

BID/PRICING SET

ISSUE DATE: 9/13/2024

REVISIONS

retain copies for information and reference.

1 11/04/2024

DOORS F40B, F40C








SECTION @ DOOR F1A SCALE: 3/4" = 1-0"


SECTION @ DOOR F1B SCALE: 3/4" = 1-0"


2

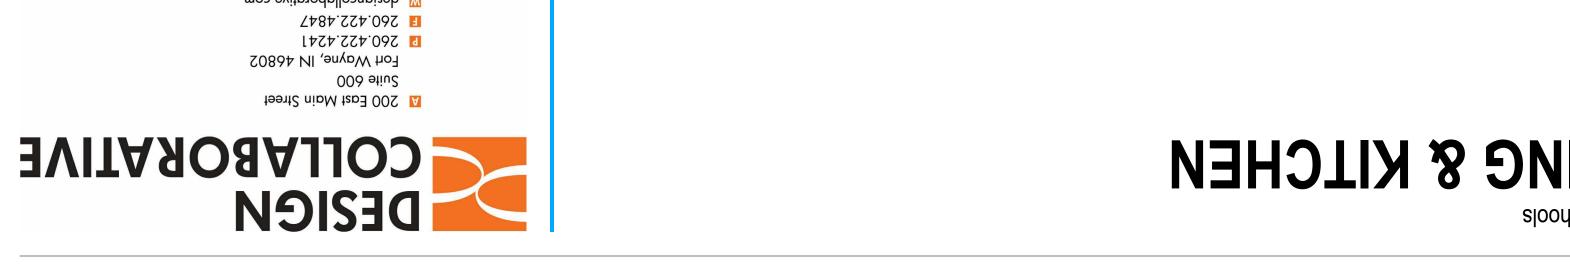

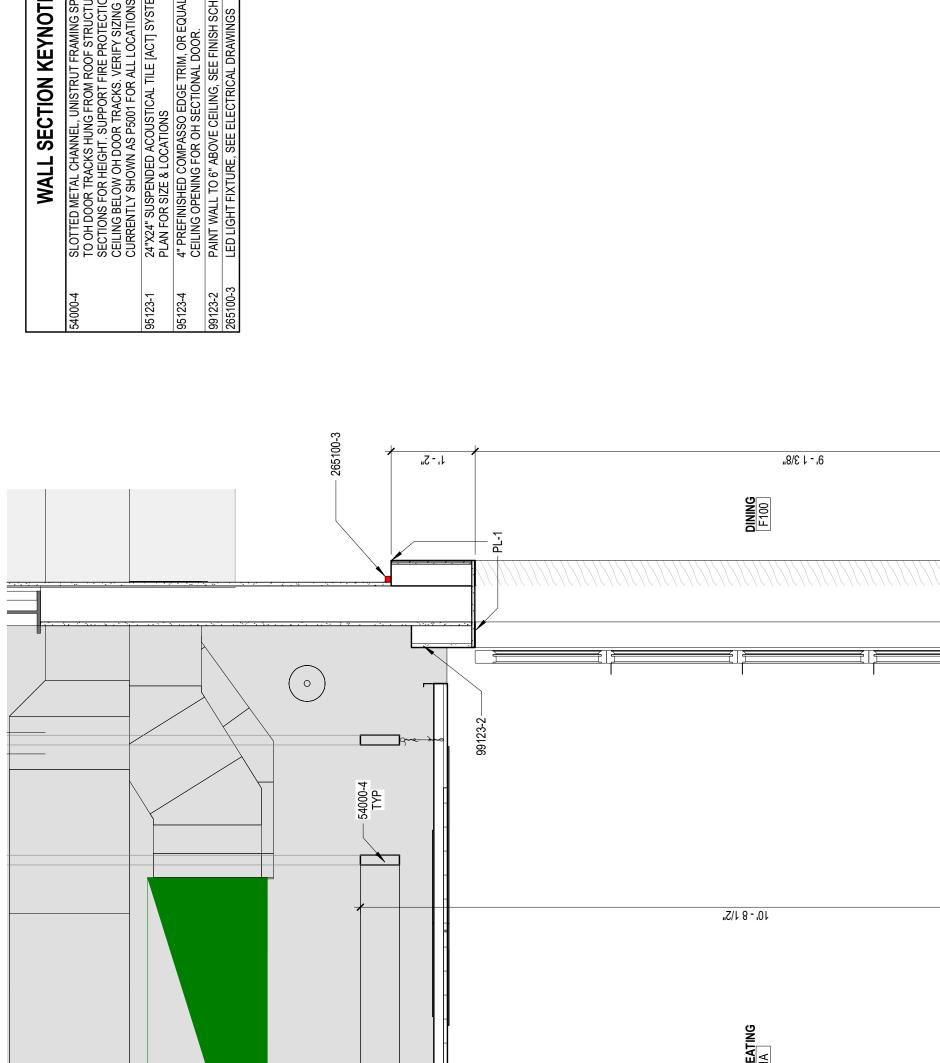


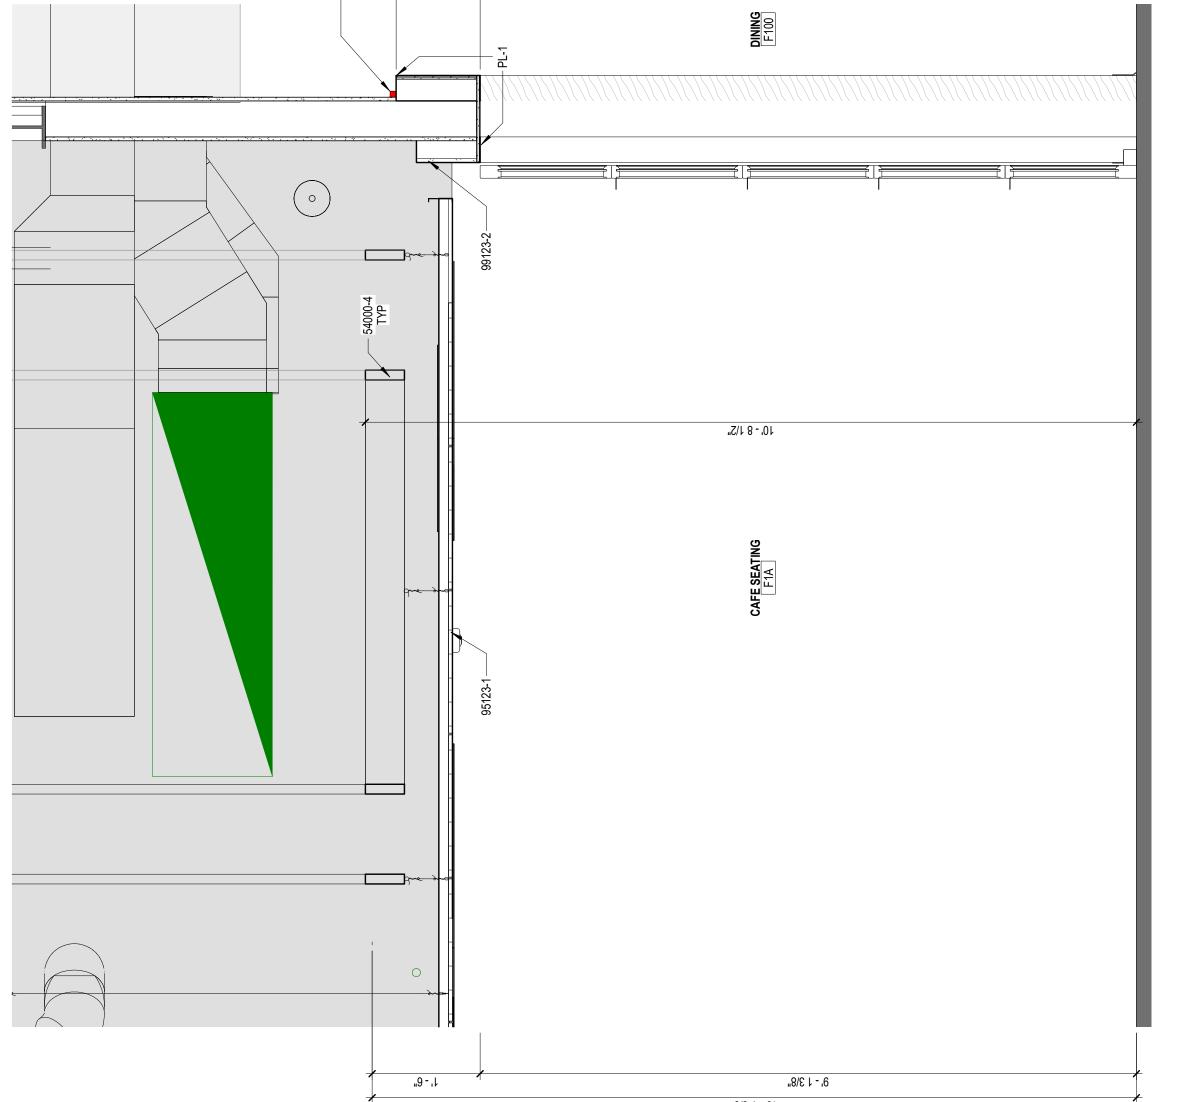


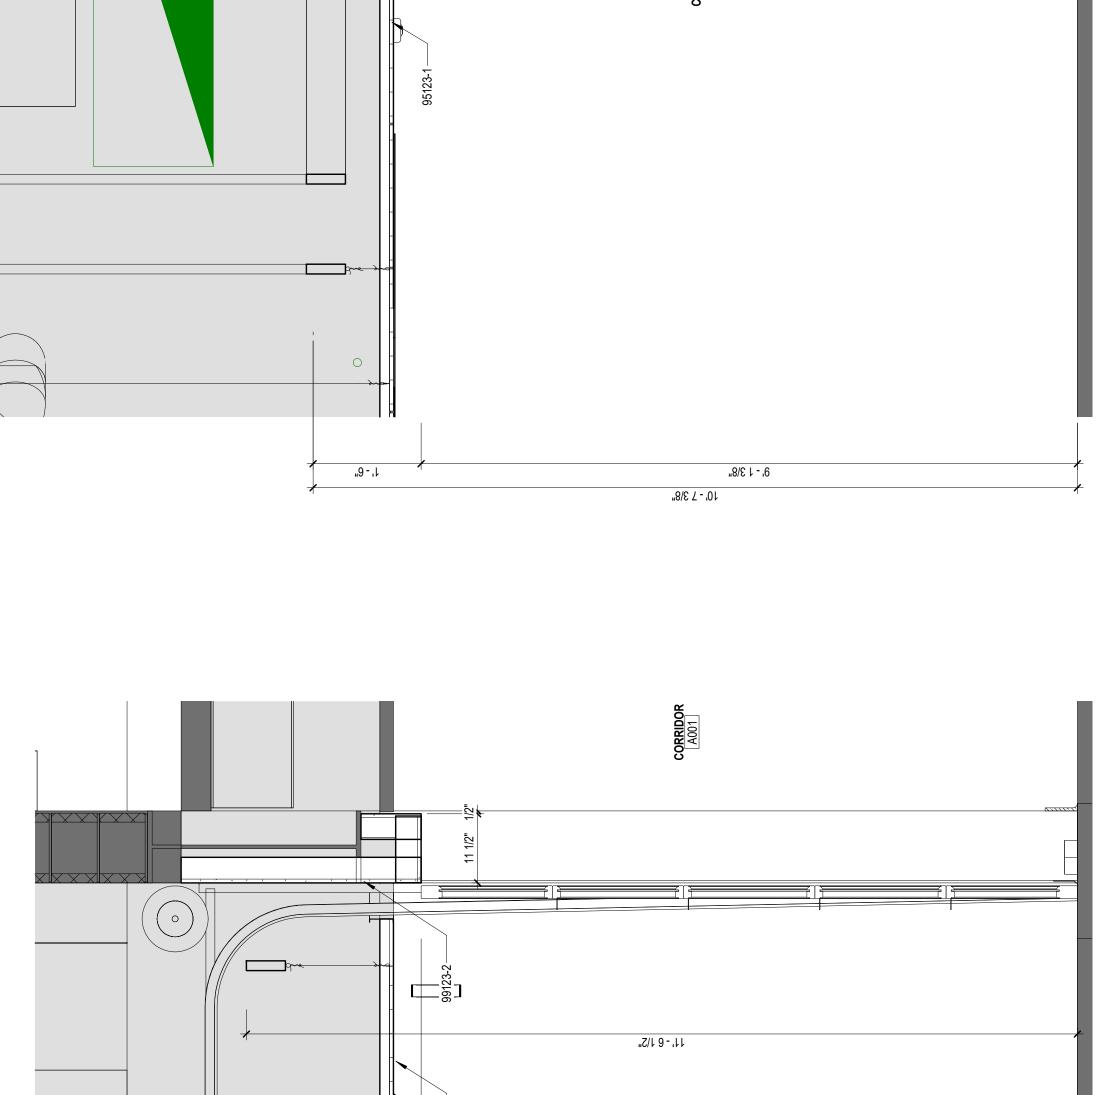

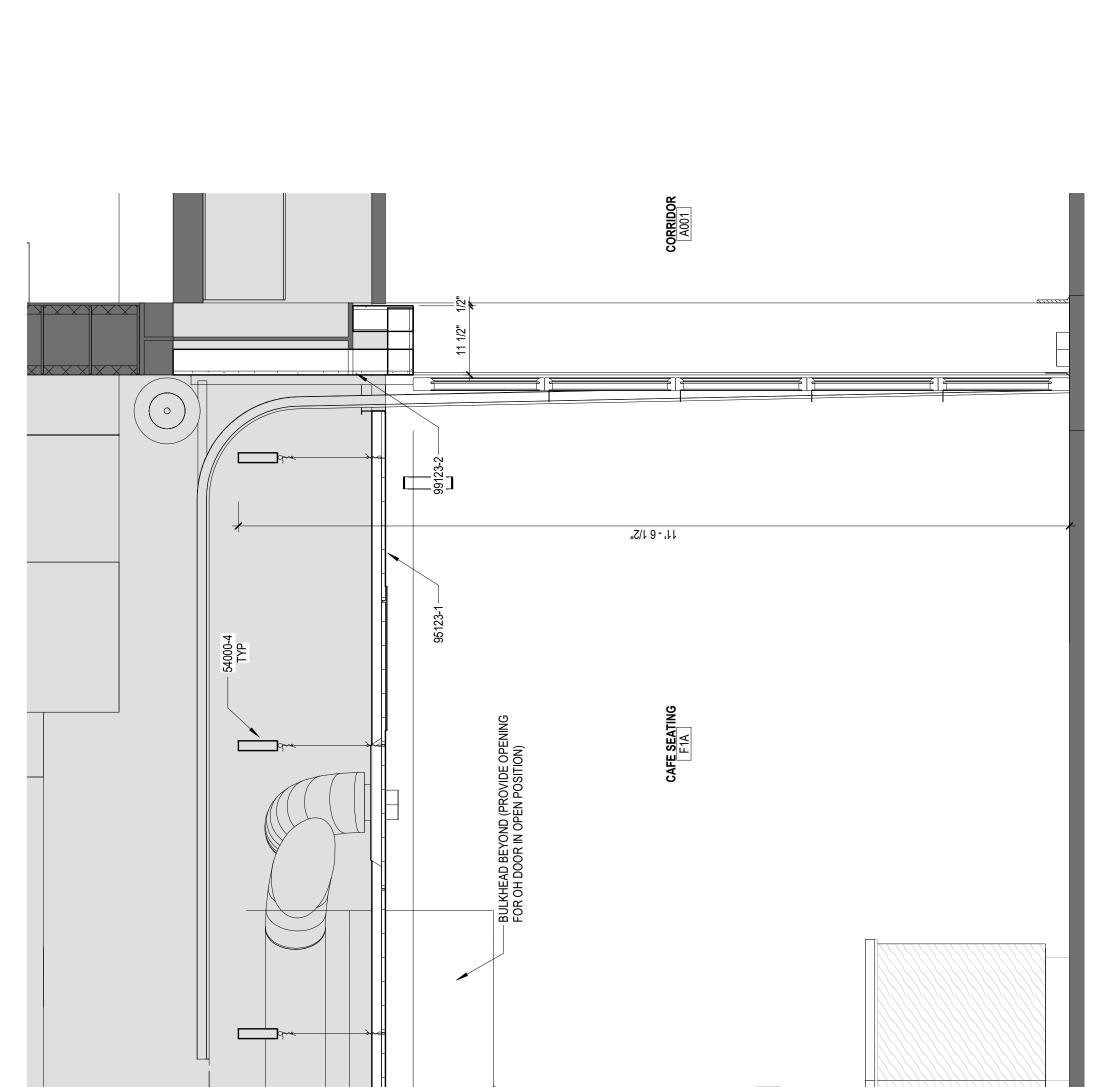


11. - 11 3/8" (F.V. W/ MECH EXIST. CONDITIONS)

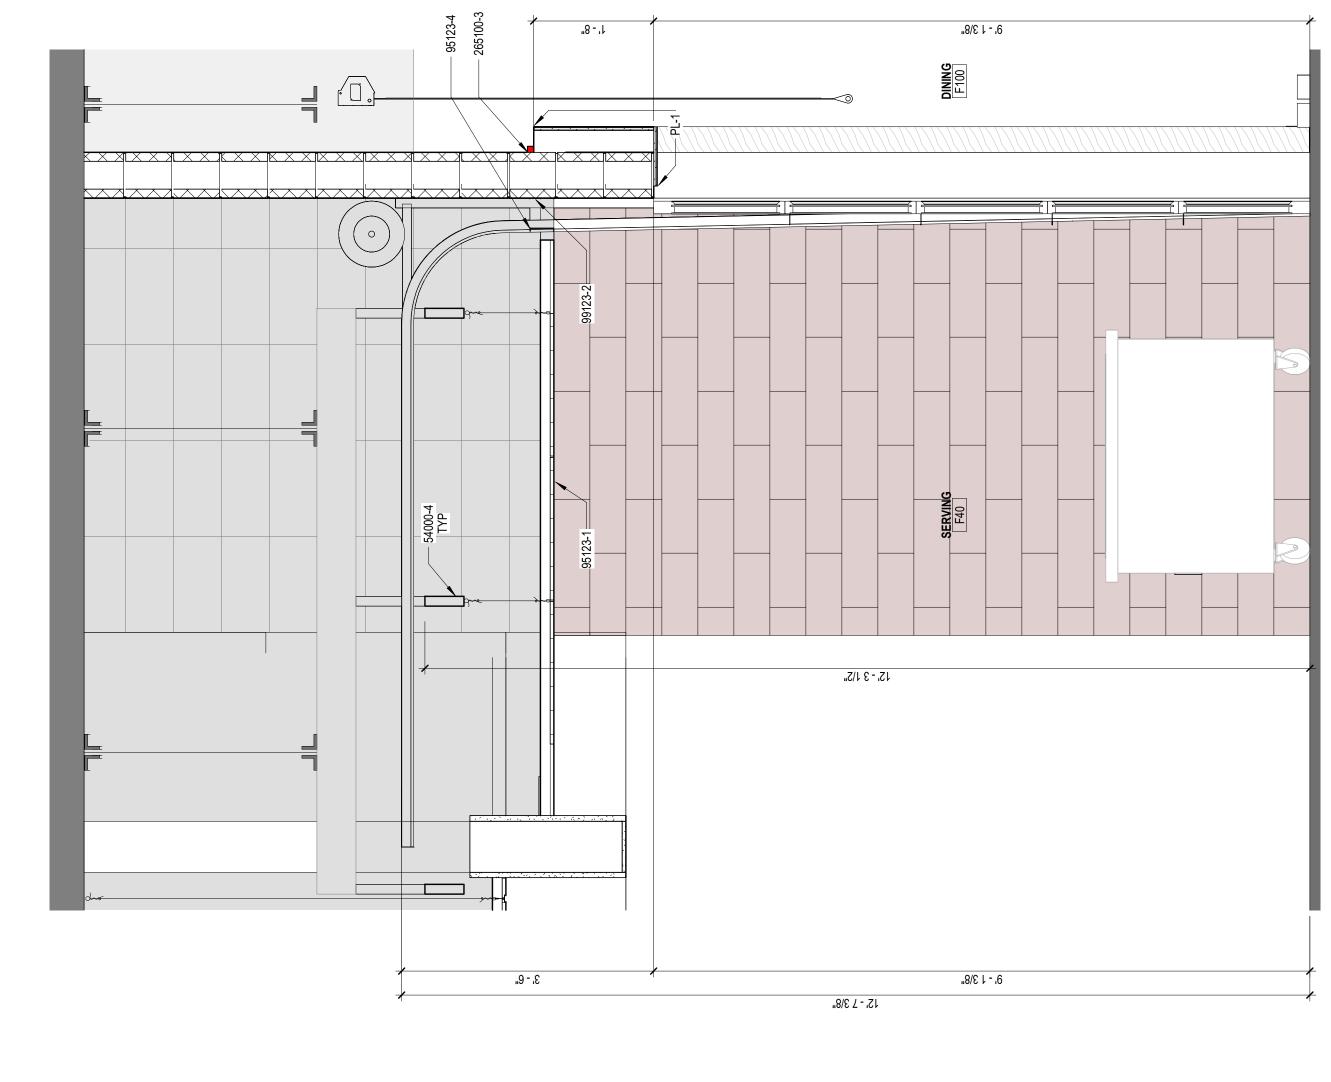

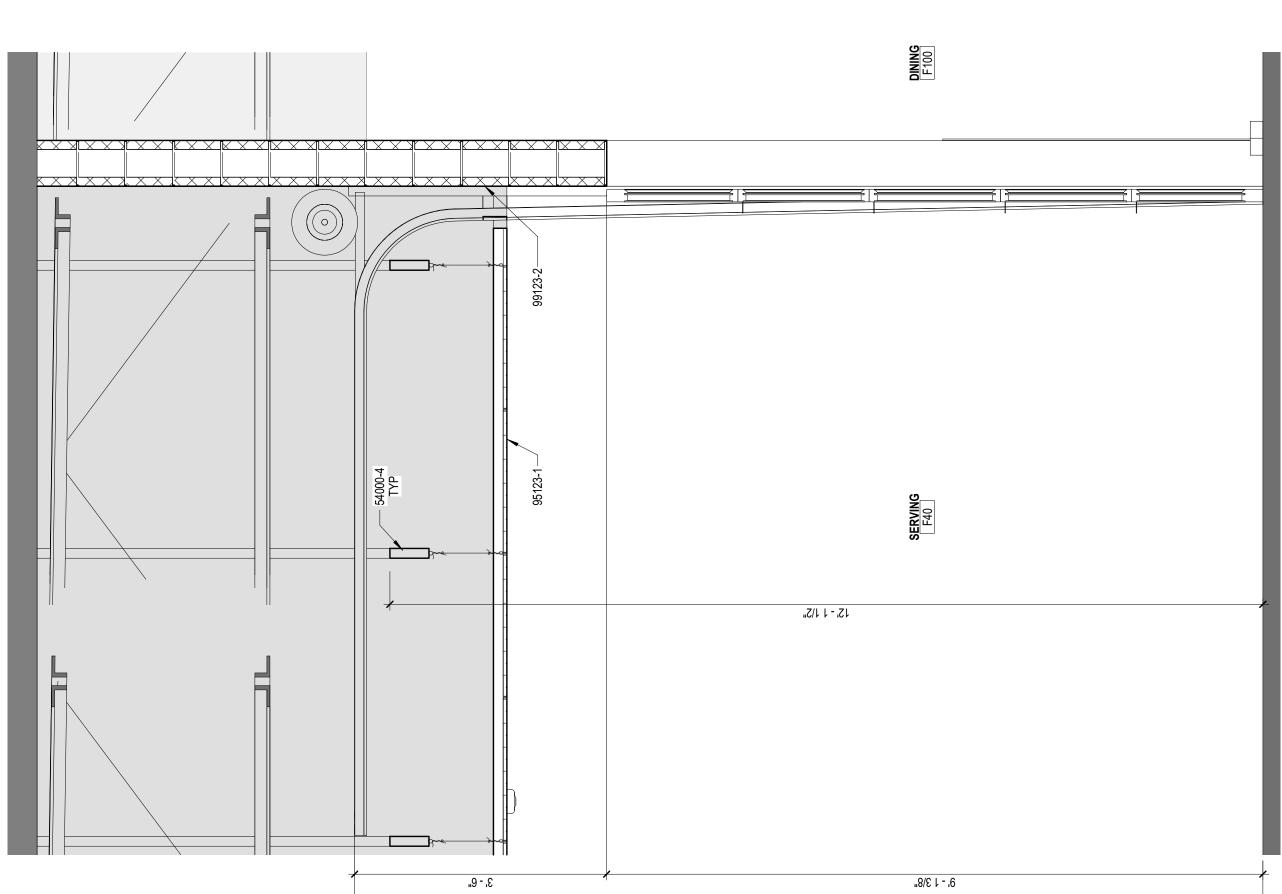

12' - 7 3/8"

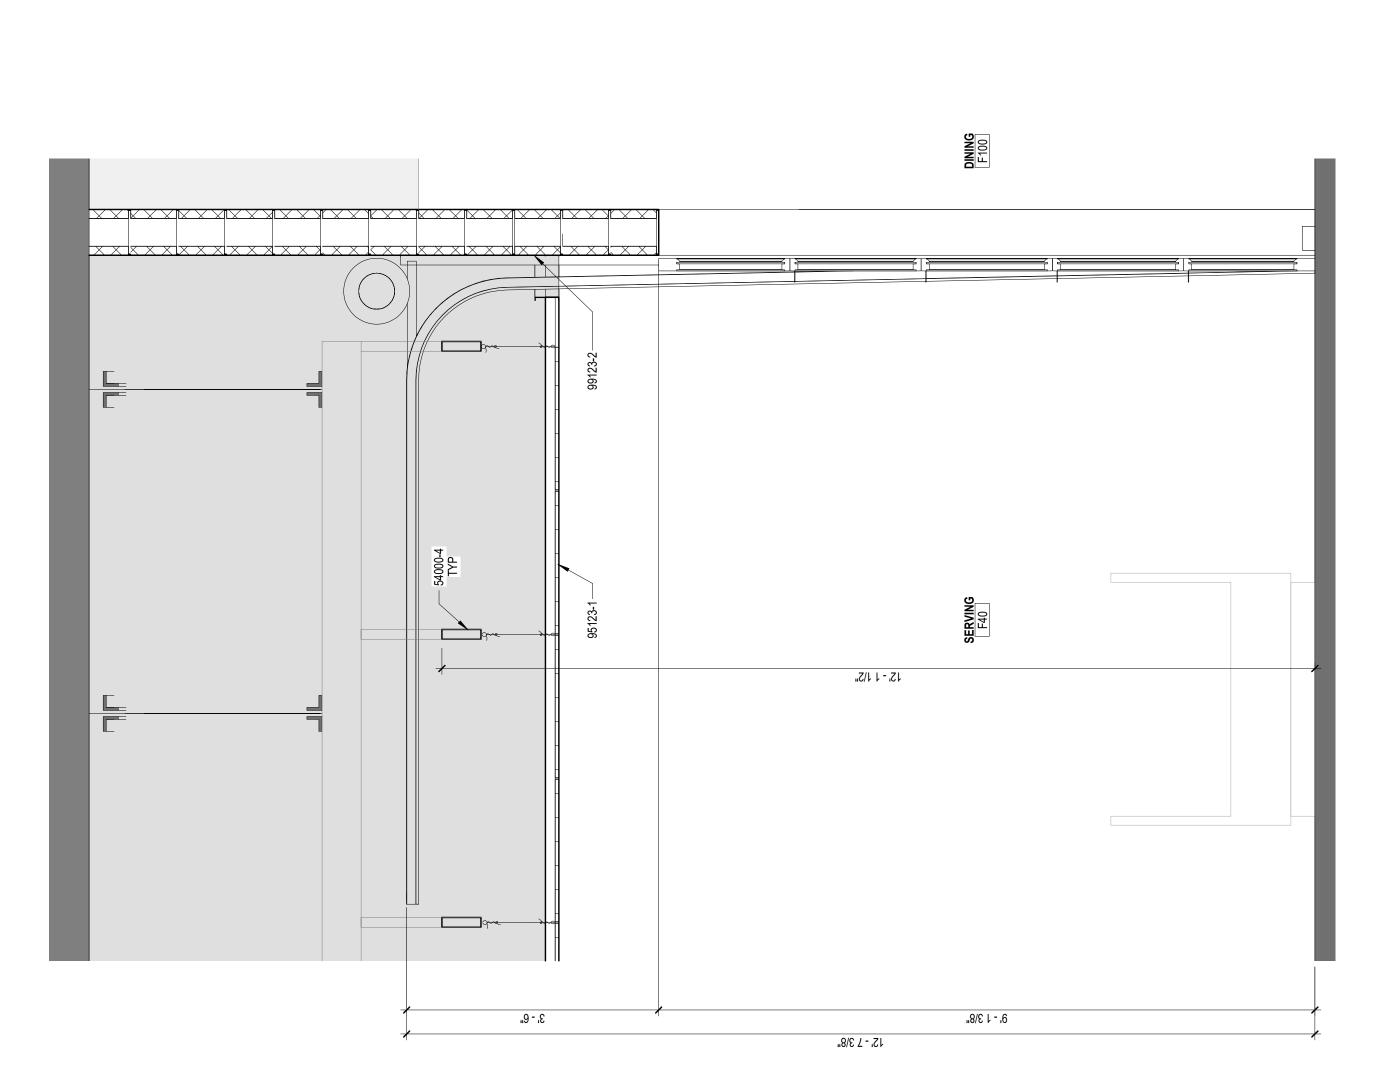





3


EXISTING TERRAZZO BASE TO REMAIN. 3-5/8" LIGHT GA. METAL STUDS SCHLUTER QUADEC PIECE TO BE INSTALLED AT EDGE OF EXPOSED TILE. 123661-6 SOLID SURFACE WINDOW SILLS [TYPICAL]. SEE A5. & A6. SERIES SHEETS FOR


SIZES AND INSTALLATION DETAILS.

 λ — 3/4" PL-1 WALL CAP — 1/2" PLYWOOD EXPOSED SURFACES TO BE PL-1

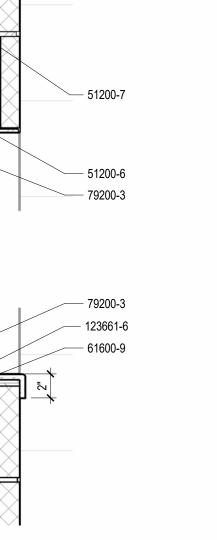

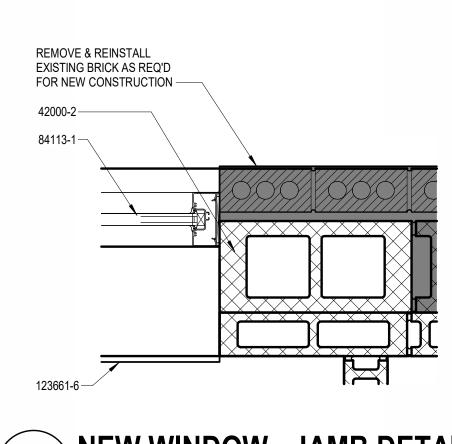

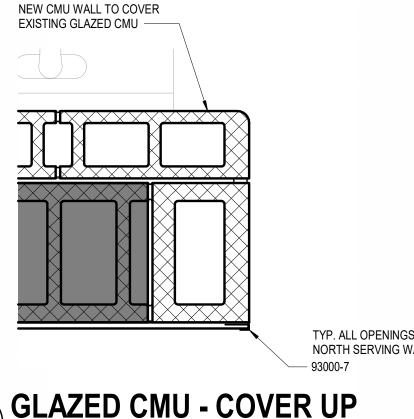

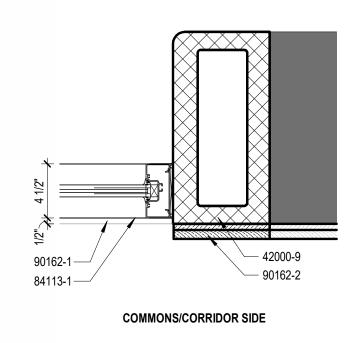

TYPICAL JAMB @ NEW HM FRAME

ENLARGED DETAILS

A6.1

All concepts, ideas, designs, plans and details as shown on this document are the sole property of Design Collaborative, Inc., and shall not be used for any purpose without their expressed written consent. The owner shall be permitted to

BID/PRICING SET


ISSUE DATE: 9/13/2024


REVISIONS


NO. DATE DESCRIPTION

1 11/04/2024


retain copies for information and reference.

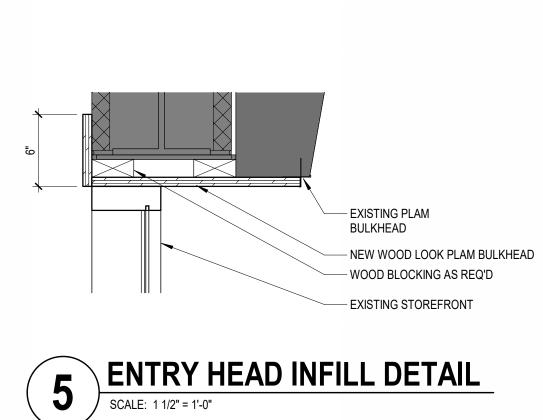

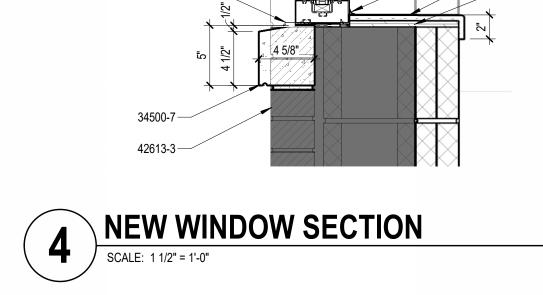

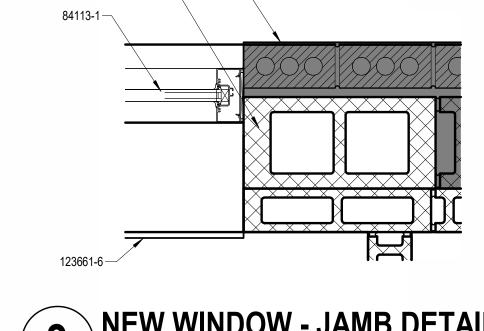



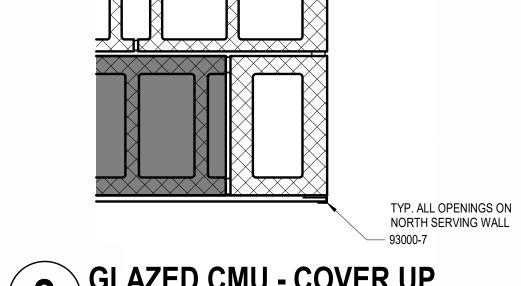

GLAZED CMU - COVER UP

SCALE: 1 1/2" = 1'-0"

NOTE: REMOVE EXISTING BRICK IN SECTIONS TO INSTALL NEW 51200-7 — 42613-17 —

FLASHING. REINSTALL EXISTING BRICK.

2" 4 1/2"

NEW WINDOW - JAMB DETAIL

SCALE: 1 1/2" = 1'-0"

DETAIL KEYNOTES

FRY REGLET MILLWORK CLEAT SYSTEM.

LID OF BOOTHS TO BE SUSPENDED FROM STRUCTURE.


SHOWN IN ELEVATION, EDGES BUTTED TO EACH OTHER.

CUSTOM COLOR


PLAN FOR SIZE & LOCATIONS


OWNER FURNISHED MOBILE CASEWORK / FURNITURE. 265100-3 LED LIGHT FIXTURE, SEE ELECTRICAL DRAWINGS 64219-2 PL-1 98433-7 **→** WP-1 — **→** PROVIDE MOCK UP OF (1) BACK TO BACK BOOTH AS INDICATED PRIOT TO PROCEEDING WITH OTHER 64219-4 ——/ TYP BOOTH OR BANQUETTE SECTIONS. BASED ON APPROVAL FROM INTERIOR DESIGNER.


F100 DINING - SOUTHWEST - BOOTHS 6 F100 DIN

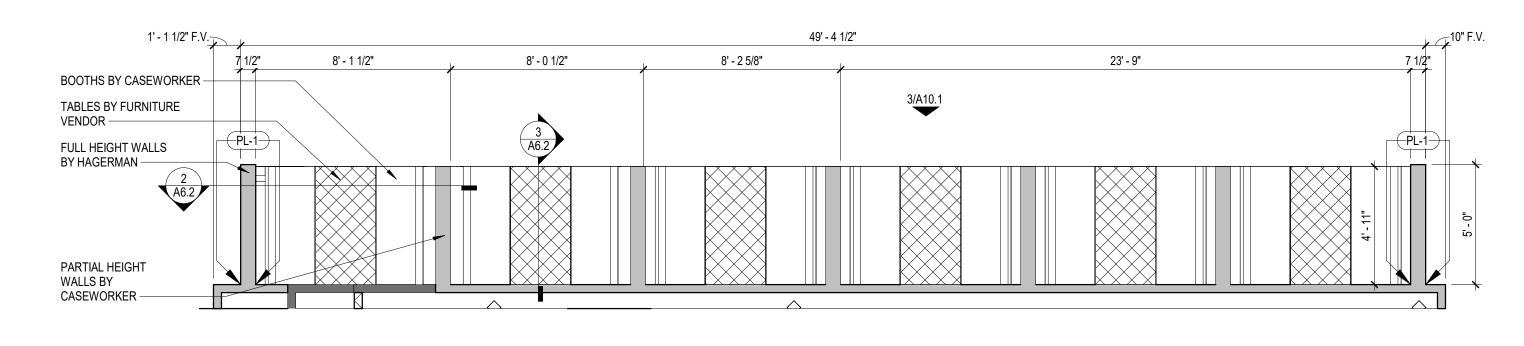

BOOTHS - ENLARGED PLAN

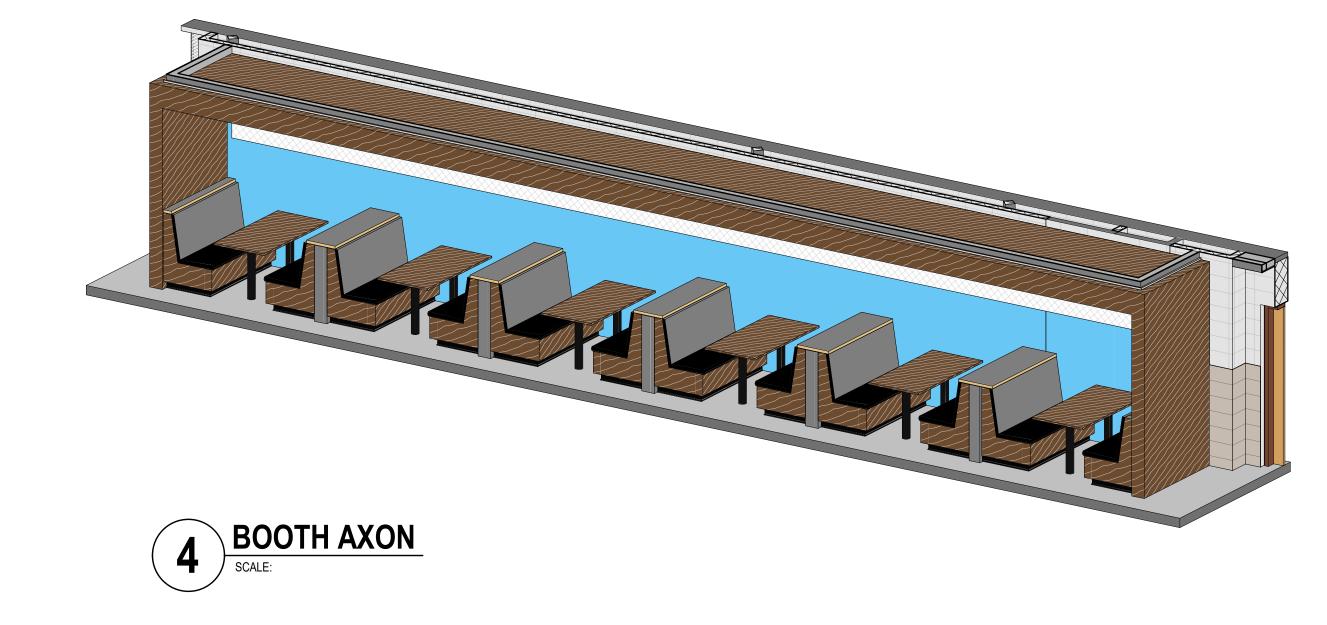

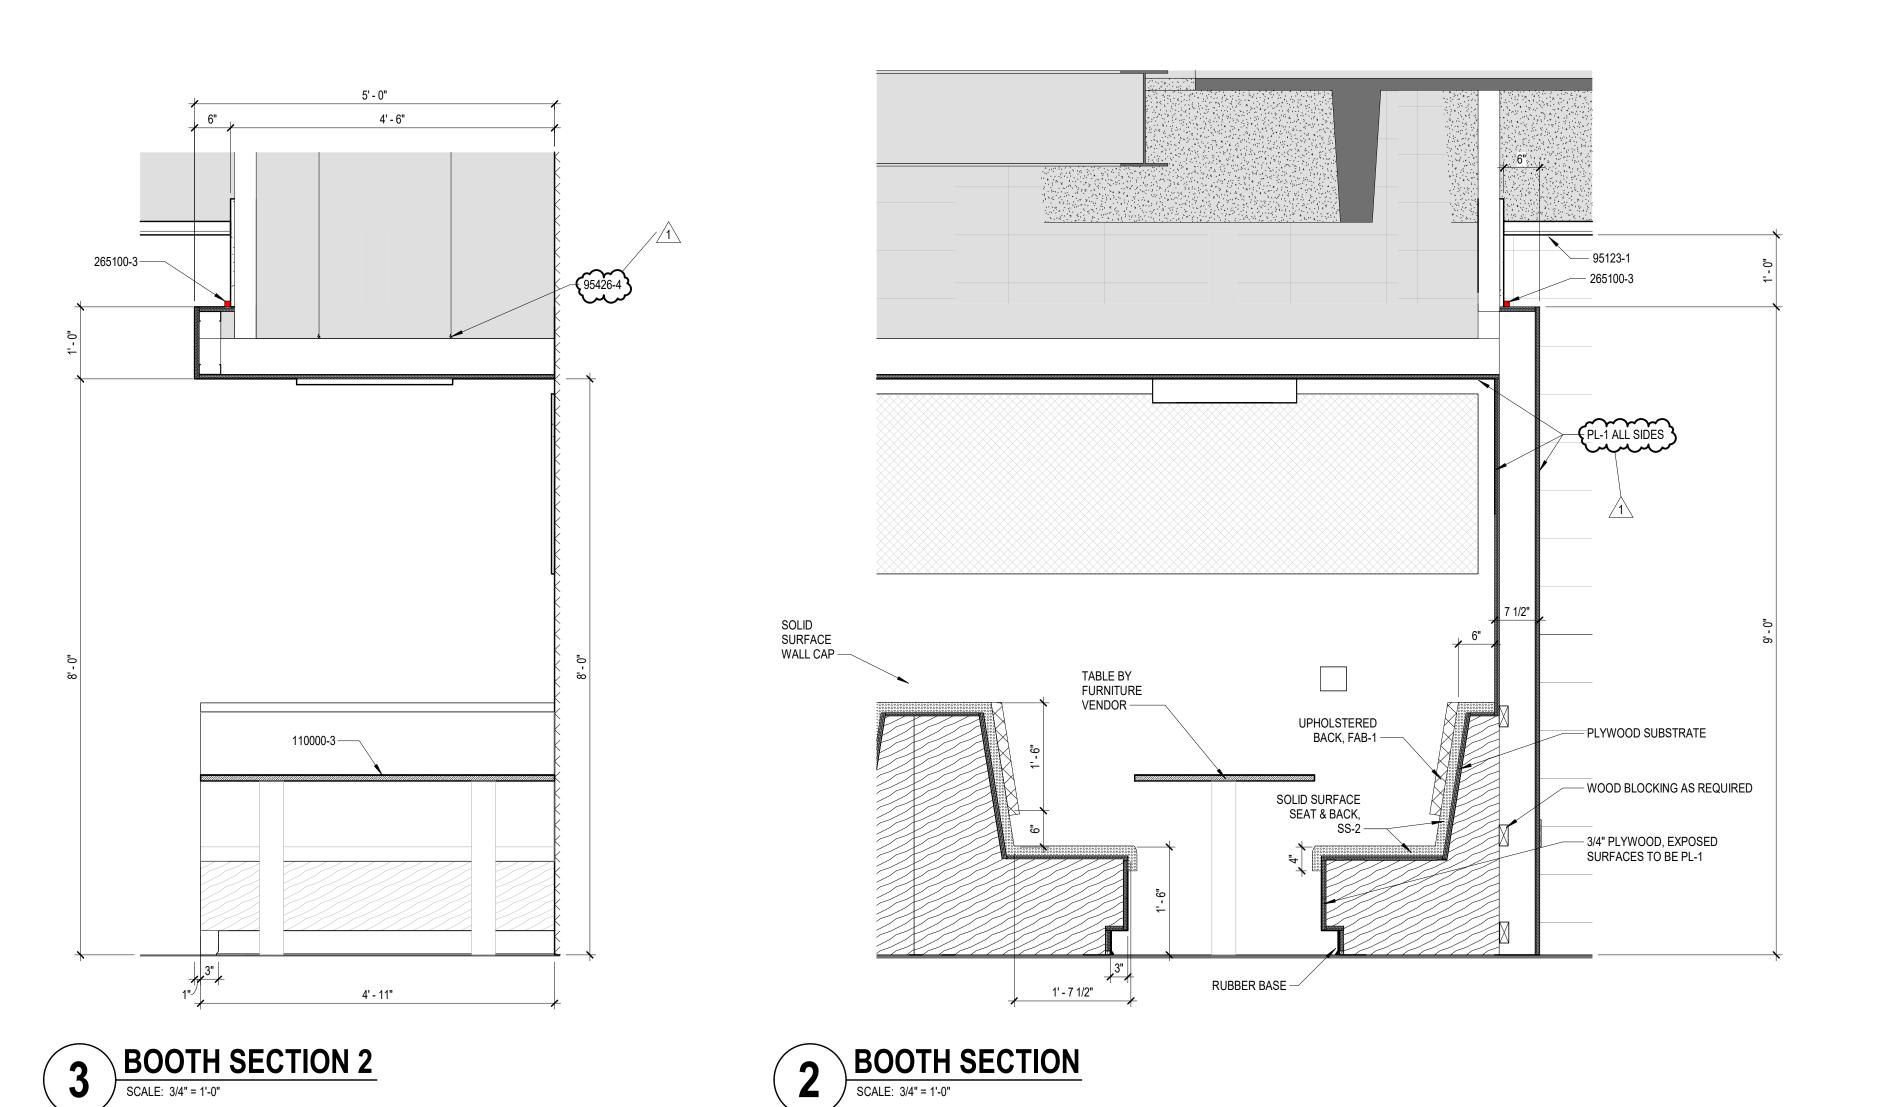

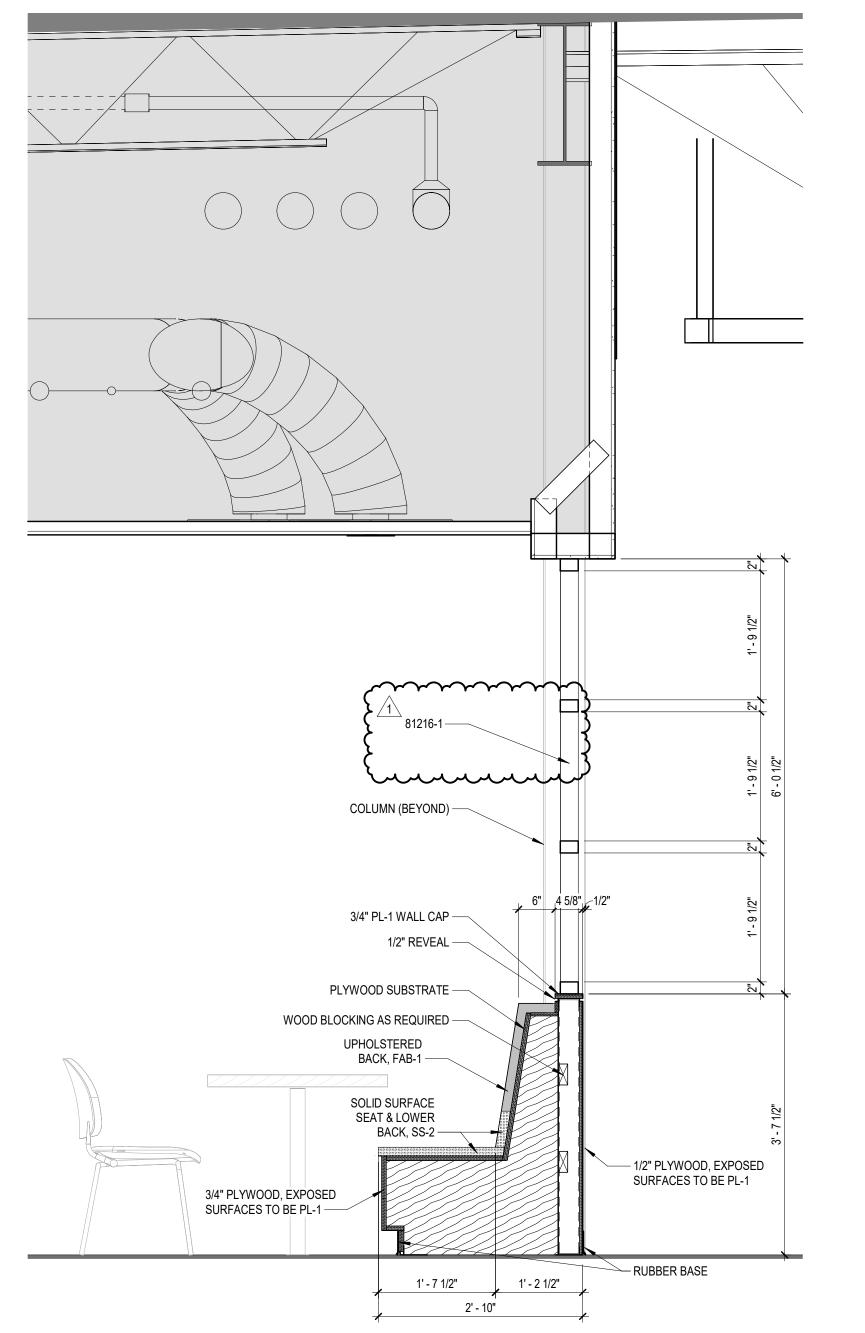

BANQUETTE SECTION SCALE: 3/4" = 1'-0"

All concepts, ideas, designs, plans and details as shown on this document are the sole property of Design Collaborative, Inc., and shall not be used for any purpose without their expressed written consent. The owner shall be permitted to retain copies for information and reference.

8

BID/PRICING SET

ISSUE DATE: 9/13/2024

REVISIONS 1 11/04/2024

BOOTH DETAILS

ර

DINING

WINDOW GLAZING AND FRAME GENERAL NOTES ALL FRAME ELEVATIONS NOTED AS "CW-X" ARE TO BE CURTAINWALL ASSEMBLY REFERENCE SPECIFICATIONS (SECTION 84413 & 84423) FOR SYSTEM REQUIREMENTS AND CONFIGURATIONS. ALL FRAME ELEVATIONS NOTED AS "SF-X" ARE TO BE STOREFRONT ASSEMBLY.


REFERENCE SPECIFICATIONS (SECTION 84113) FOR SYSTEM REQUIREMENTS AND CONFIGURATIONS. ALL FRAME ELEVATIONS NOTED AS "HM-X" ARE TO BE HOLLOW METAL FRAMING ASSEMBLY, REFERENCE SPECIFICATIONS (SECTION 81113) FOR SYSTEM REQUIREMENTS AND CONFIGURATIONS. ALL FRAME ELEVATIONS NOTED AS "AG-X" ARE TO BE ALL GLASS ENTRY SYSTEM,

NOTE: SEE A10.1 FOR "SCREEN WALL" ELEVATIONS


REFERENCE SPECIFICATIONS (SECTION 84210) FOR SYSTEM REQUIREMENTS AND CONFIGURATIONS. ALL H.M. WINDOW FRAMES SHALL WRAP WALL ASSEMBLY UNLESS NOTED OTHERWISE, OR INDICATED IN THE DETAILS. CONTRACTOR TO VERIFY WALL THICKNESS IN FIELD.

ALL H.M. FRAMES ARE TO BE PAINTED, SEE ROOM FINISH SCHEDULE FOR ADDITIONAL INFORMATION. ALL GLAZING TO MEET REQUIREMENTS FOR CHAPTER 24, 2014 INDIANA BUILDING CODE (2012 IBC). ALL WINDOW FRAMES ARE TO RECEIVE SEALANT BOTH SIDES, TYP. SUBMIT COLOR

SELECTION FOR ARCHITECT APPROVAL OF SEALANT COLORS. WINDOW FRAME DIMENSIONS SHOWN ARE NOMINAL, SEE SPECS. ALL MULLIONS/CAP EXTENSIONS ARE TO DIMENSIONS AS SPECIFICED UNLESS OTHERWISE INDICATED IN FRAME ELEVATION.

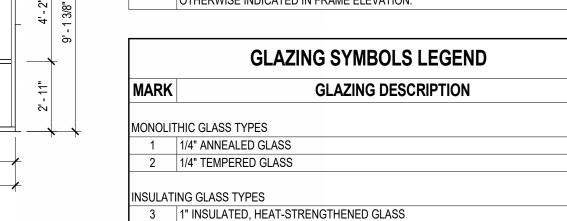

4 1" INSULATED, FULLY-TEMPERED GLASS

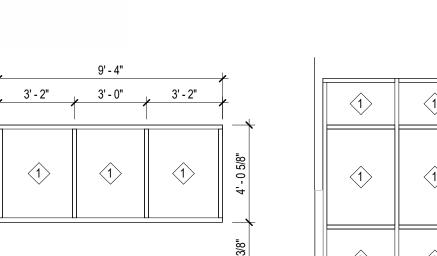



4' - 0"

SF-2

SCALE: 1/4" = 1'-0"

4' - 0"

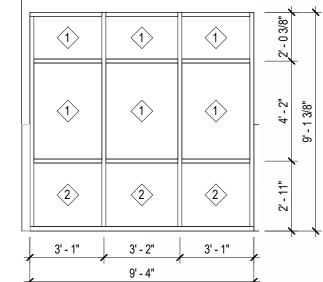


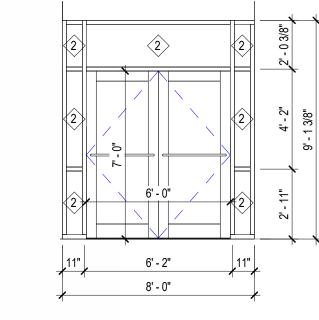



SF-1

SCALE: 1/4" = 1'-0"

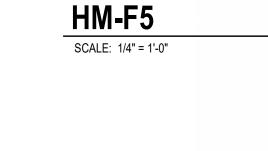


3' - 4"


6' - 8"

HM-F7

SCALE: 1/4" = 1'-0"



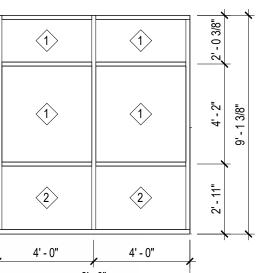

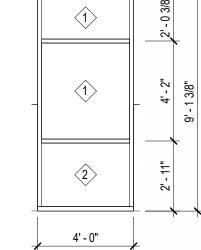

1	(1)	(1)	2'-03/8"
1	1	1>	4'-2"
<u>(2)</u>	2>	2>	2'-11"
4' - 0"	4' - 0" 12' - 0"	4' - 0"	<u> </u>

HM-F3 SCALE: 1/4" = 1'-0"


HM-F2

SCALE: 1/4" = 1'-0"

HM-F1 SCALE: 1/4" = 1'-0"


							DC	OOR SC	HEDULE	- ENTRIES					
	DOOR FRAME HEAD/ FIRE RATING ELECTRICAL COORDINATION MACNITION														
NO.		W	Н	Т	MAT.	ELEV.	MAT.	ELEV.	JAMB	(MIN.)	ADA OPERATOR	CARD READER	MAGNETIC HOLD	COMMENTS	
MAIN LEV	ΈL														
7C		4' - 0"	7' - 0"	1 3/4"	HM	F	HM	HM-1	D1/A7.1	-		•		3, 8	

						D	OOR S	CHEDUL	E - UNIT F				
		DO	OR			FR/	AME	LIEAD/	FIDE DATING	ELECTR	RICAL COORDII	NATION	
NO.	w	Н	Т	MAT.	ELEV.	MAT.	ELEV.	HEAD/ JAMB	FIRE RATING (MIN.)	ADA OPERATOR	CARD READER	MAGNETIC HOLD	COMMEN
MAIN LEV	EL									1			
F1A	11' - 4"	9' - 1 3/8"	2 1/8"	AL	OH-G	STL	-	C3/A7.1					5
F1B	14' - 8"	9' - 1 3/8"	2 1/8"	AL	OH-G	STL	-	C1/A7.1					5, 7
F1C	3' - 0"	7' - 0"	1 3/4"	FRP	NL	HM	HM-1	B2/A7.1	-				6
F3A	3' - 0"	7' - 0"	1 3/4"	WD	F	HM	HM-1	B1/A7.1	-				
F4A	3' - 0"	7' - 0"	1 3/4"	WD	NL	HM	HM-1	B1/A7.1	-				
F6A	3' - 0"	7' - 0"	1 3/4"	WD	NL	HM	HM-1	B1/A7.1	-				
F32A	3' - 0"	7' - 0"	1 3/4"	WD	F	HM	HM-1	B2/A7.1					
F33A	3' - 0"	7' - 0"	1 3/4"	WD	F	HM	HM-1	B2/A7.1					
F34A	3' - 0"	7' - 0"	1 3/4"	WD	HG	HM	HM-2	B2/A7.1					
F35A	4' - 0"	7' - 0"	1 3/4"	FRP	HG	HM	HM-1	B2/A7.1					6
F37A	3' - 0"	7' - 0"	1 3/4"	FRP	NL	HM	HM-1	B2/A7.1					6
F38A	6' - 0"	4' - 2 1/2"		AL	OH-C	STL	-	C4/A7.1					2
F39A	3' - 0"	7' - 0"	1 3/4"	WD	F	HM	HM-1	B2/A7.1					
F40A	8' - 0"	9' - 1 3/8"	2 1/8"	AL	OH-G	STL	-	C1/A7.1					5
F40B	11' - 4"	9' - 1 3/8"	2 1/8"	AL	OH-G	STL	-	C2/A7.1					5
F40C	11' - 4"	9' - 1 3/8"	2 1/8"	AL	OH-G	STL	-	C2/A7.1					5
F40D	8' - 0"	9' - 1 3/8"	2 1/8"	AL	OH-G	STL	-	C1/A7.1					5
F40E	3' - 0"	7' - 0"	1 3/4"	FRP	NL	HM	HM-1	B2/A7.1	-				6
F100A	(2) 2' - 11 1/2"	7' - 0"	1 3/4"	WD	WSFG	EXIST HM	EXIST	-	-				1
F100B	(2) 3' - 0"	7' - 0"	1 3/4"	WD	WSFG	EXIST HM	EXIST	-	-				1
F100C	(2) 3' - 0"	7' - 0"	1 3/4"	WD	WSFG	EXIST HM	EXIST	-	-				1
F100D	(2) 2' - 11 1/2"	7' - 0"	1 3/4"	WD	WSFG	EXIST HM	EXIST	-	-				1
F100E	(2) 3' - 0"	7' - 0"	1 3/4"	WD	WSFG	HM	HM-F4	B3/A7.1					
F100F	(2) 3' - 0"	7' - 0"	1 3/4"	FRP	NL	HM	HM-1	B4/A7.1					6

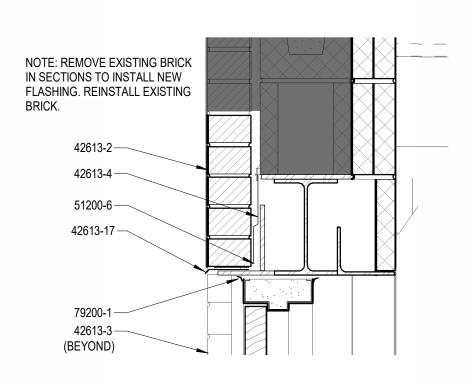


NEW EXT. DOOR HEAD DETAIL

SCALE: 1 1/2" = 1'-0"

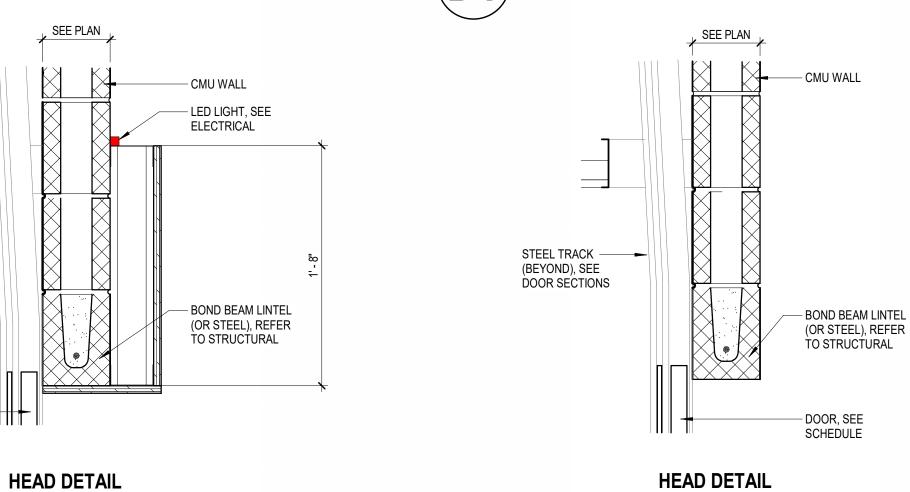



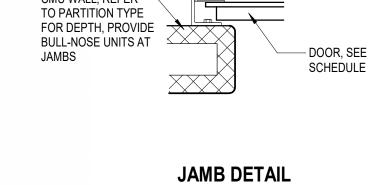

SCALE: 1 1/2" = 1'-0"

HEAD DETAIL

JAMB DETAIL

HM FRAME - METAL STUD

DOOR SCHEDULE COMMENTS

OVERHEAD SECTIONAL GLASS DOOR, REFER TO SPECIFICATION 08 36 13 FOR MORE INFORMATION.

THIS SECTIONAL DOOR SHALL BE TIED INTO FIRE ALARM FORCING DOOR TO AUTOMATICALLY RAISE

COILING COUNTER GRILLE AT DISH RETURN WINDOW, REFER TO SPECIFICATIONS 08 33 13

EMERGENCY EGRESS GRILLE EQUAL TO CORNELL CROSSINGGARD MODEL ERG-IBC

UTILIZ HARDWARE FROM PREVIOUS BUILDING RENOVATION PROJECT.

IMPACT RESISTANT DOOR, REFER TO SPECIFICATION SECTION 08 14 23

INSULATED HOLLOW METAL DOOR, PAINTED.

PROVIDE WIDE ANGLE PEEP HOLE

DURING ALARM.

5/8" GYP. BD

EACH SIDE —

DOOR, SEE

SCHEDULE

SEALANT CONT.

EACH SIDE

EACH SIDE

5/8" GYP. BD —

(2) METAL STUDS EACH — 1"

SCALE: 1 1/2" = 1'-0"

SIDE - SEE PARTITION

OH DOOR FRAME - CMU WALL

- METAL STUDS SEE

PARTITION TYPES

- SEALANT CONT.

- HOLLOW METAL


FRAME PAINTED

— HOLLOW METAL FRAME

PAINTED W/ (3) JAMB

ANCHORS PER JAMB, TYP.

EACH SIDE

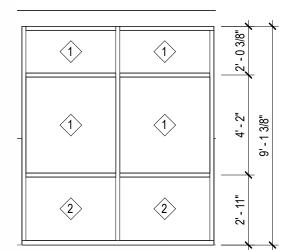



	~				Ш	
		~				
	4'-2"	9' - 1 3/8"				
		~				
	2' - 11"					
	¹		-		_=	
,	<u> </u>				+	

2>	2'-11"
4' - 0"	-

						DC	OOR SC	HEDULE	- ENTRIES				
		DO	OR			FR	AME	LIEAD/	FIDE DATING	ELECTR	ICAL COORDII	NATION	
NO.	W	Н	Т	MAT.	ELEV.	MAT.	ELEV.	HEAD/ JAMB	FIRE RATING (MIN.)	ADA OPERATOR	CARD READER	MAGNETIC HOLD	COMMENT
MAIN LEVEL													
7C	4' - 0"	7' - 0"	1 3/4"	HM	F	НМ	HM-1	D1/A7.1	-		•		3, 8

						D	OOR SO	CHEDUL	E - UNIT F				
		DO	OR			FRA	AME	LIEAD/	FIDE DATING	ELECTR	RICAL COORDIN	NATION	
NO.	W	Н	Т	MAT.	ELEV.	MAT.	ELEV.	HEAD/ JAMB	FIRE RATING (MIN.)	ADA OPERATOR	CARD READER	MAGNETIC HOLD	COMMENT
MAIN LEVEL													
F1A	11' - 4"	9' - 1 3/8"	2 1/8"	AL	OH-G	STL	-	C3/A7.1					5
F1B	14' - 8"	9' - 1 3/8"	2 1/8"	AL	OH-G	STL	-	C1/A7.1					5, 7
F1C	3' - 0"	7' - 0"	1 3/4"	FRP	NL	HM	HM-1	B2/A7.1	-				6
F3A	3' - 0"	7' - 0"	1 3/4"	WD	F	HM	HM-1	B1/A7.1	-				
F4A	3' - 0"	7' - 0"	1 3/4"	WD	NL	HM	HM-1	B1/A7.1	-				
F6A	3' - 0"	7' - 0"	1 3/4"	WD	NL	HM	HM-1	B1/A7.1	-				
F32A	3' - 0"	7' - 0"	1 3/4"	WD	F	HM	HM-1	B2/A7.1					
F33A	3' - 0"	7' - 0"	1 3/4"	WD	F	HM	HM-1	B2/A7.1					
F34A	3' - 0"	7' - 0"	1 3/4"	WD	HG	HM	HM-2	B2/A7.1					
F35A	4' - 0"	7' - 0"	1 3/4"	FRP	HG	HM	HM-1	B2/A7.1					6
F37A	3' - 0"	7' - 0"	1 3/4"	FRP	NL	HM	HM-1	B2/A7.1					6
F38A	6' - 0"	4' - 2 1/2"		AL	OH-C	STL	-	C4/A7.1					2
F39A	3' - 0"	7' - 0"	1 3/4"	WD	F	HM	HM-1	B2/A7.1					
F40A	8' - 0"	9' - 1 3/8"	2 1/8"	AL	OH-G	STL	-	C1/A7.1					5
F40B	11' - 4"	9' - 1 3/8"	2 1/8"	AL	OH-G	STL	-	C2/A7.1					5
F40C	11' - 4"	9' - 1 3/8"	2 1/8"	AL	OH-G	STL	-	C2/A7.1					5
F40D	8' - 0"	9' - 1 3/8"	2 1/8"	AL	OH-G	STL	-	C1/A7.1					5
F40E	3' - 0"	7' - 0"	1 3/4"	FRP	NL	HM	HM-1	B2/A7.1	-				6
F100A (2)) 2' - 11 1/2"	7' - 0"	1 3/4"	WD	WSFG	EXIST HM	EXIST	-	-				1
F100B (2)) 3' - 0"	7' - 0"	1 3/4"	WD	WSFG	EXIST HM	EXIST	-	-				1
F100C (2)) 3' - 0"	7' - 0"	1 3/4"	WD	WSFG	EXIST HM	EXIST	-	-				1
F100D (2)) 2' - 11 1/2"	7' - 0"	1 3/4"	WD	WSFG	EXIST HM	EXIST	-	-				1
F100E (2)		7' - 0"	1 3/4"	WD	WSFG	HM	HM-F4	B3/A7.1					
F100F (2)) 3' - 0"	7' - 0"	1 3/4"	FRP	NL	HM	HM-1	B4/A7.1					6

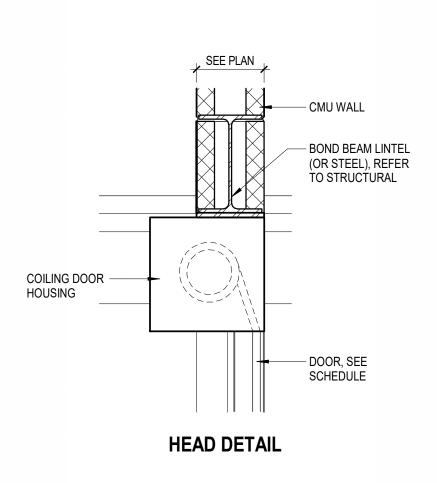

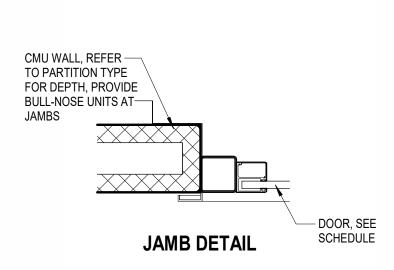

SCALE: 1 1/2" = 1'-0"

DOOR, SEE -SCHEDULE

CMU WALL, REFER -

TO PARTITION TYPE

SCALE: 1 1/2" = 1'-0"

DOOR ELEVATIONS

FOR DEPTH



— CMU WALL

- BOND BEAM LINTEL

(OR STEEL), REFER

TO STRUCTURAL

- SEALANT (TYPICAL)

EACH SIDE

- HOLLOW METAL

FRAME PAINTED,

- JAMB ANCHORS,

HOLLOW METAL

FRAME PAINTED,

GROUT SOLID

(3) PER JAMB

GROUT SOLID

5-3/4" @ 6" CMU 7-3/4" @ 8" CMU

HEAD DETAIL

JAMB DETAIL

HM FRAME W/ REVEAL - CMU WALL

EQ. PANEL SIZE SEE ELEVATIONS FOR # OF COLUMNS



SEE PLAN

HEAD DETAIL

AT EXISTING WALLS, JAMBS MAY NEED REPLACED WITH BULLNOSE UNITS WHEN THIS JAMB DETAIL IS INDICATED.

JAMB DETAIL

B3 HM FRAME W/ THROAT - CMU WALL

SCALE: 1 1/2" = 1'-0"

1' - 2"

CMU WALL, REFER — TO PARTITION TYPE

SEALANT (TYPICAL) — EACH SIDE

FOR DEPTH, PROVIDE

BULL-NOSE UNITS AT

JAMB DETAIL

HEAD DETAIL

- LED LIGHT, SEE

ELECTRICAL

— DOOR, SEE SCHEDULE

- DOOR, SEE

- (2) METAL STUDS EACH

SIDE - SEE PARTITION

— BOND BEAM LINTEL

(OR STEEL), REFER

SEALANT (TYPICAL)

- EACH SIDE

- HOLLOW METAL

GROUT SOLID

BLOCK BEYOND

FRAME PAINTED,

- JAMB ANCHORS,

- HOLLOW METAL

FRAME PAINTED,

GROUT SOLID

(3) PER JAMB

TO STRUCTURAL

5/8" GYP. BD EACH SIDE —


STEEL TRACK -

DOOR SECTIONS

5/8" GYP. BD -

EACH SIDE

(BEYOND), SEE

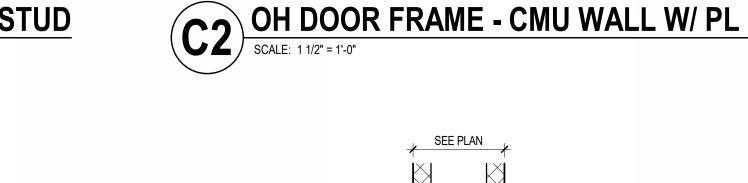

B2 HM FRAM


STEEL TRACK (BEYOND), SEE

DOOR SECTIONS


FOR LIFT


HEIGHTS


DOOR, SEE -SCHEDULE

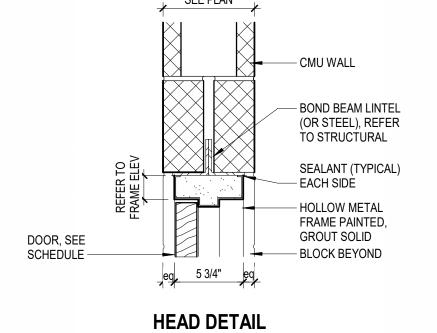

JAMB DETAIL

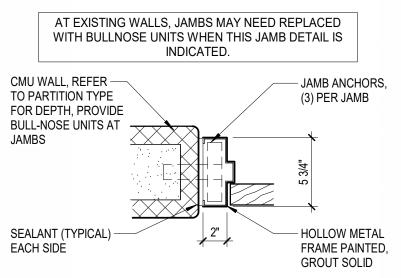

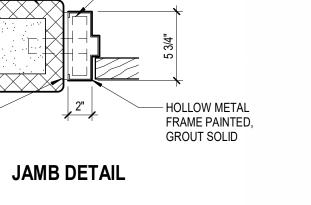

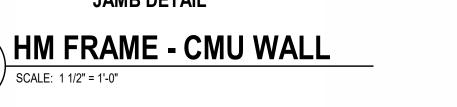



- DOOR, SEE

SCHEDULE

JAMBS

- CMU WALL, REFER TO PARTITION TYPE FOR DEPTH, PROVIDE **BULL-NOSE UNITS AT**

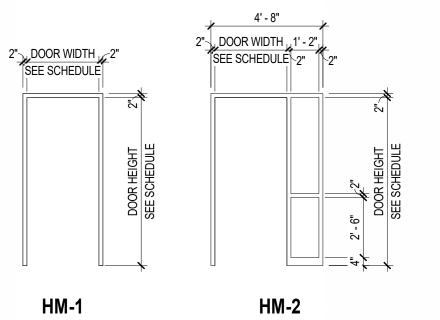

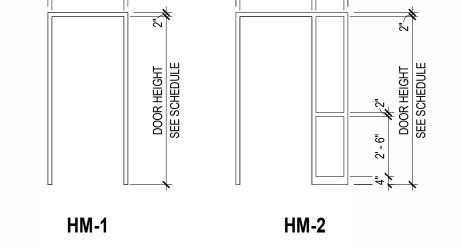

DOOR FRAME ELEVATIONS

FRAME ELEVATIONS,

SCHEDULES &

DETAILS

this document are the sole property of Design Collaborative,

expressed written consent. The owner shall be permitted to

BID/PRICING SET

ISSUE DATE: 9/13/2024

REVISIONS

Inc., and shall not be used for any purpose without their

retain copies for information and reference.

NO. DATE 11/04/2024

GENERAL RCP NOTES

ALL SUSPENDED ACOUSTICAL CEILING TILE TO BE 11' 0 A.F.F., UNLESS NOTED

BOTTOM OF ALL GYP. BOARD CEILING TO BE PAINTED PNT-8 WITH FLAT FINISH, UNLESS NOTED OTHERWISE ON REFLECTED CEILING PLAN

REFLECTED CEILING PLAN KEYNOTES

CEILING OPENING FOR OH SECTIONAL DOOR.

PERIMETER OF CEILING CLOUD.

PERIMETER OF CEILING CLOUD.

NEW KITCHEN HOOD, SEE MECHANICAL

METAL TRIM TO MATCH VENT HOOD.

SPECIFICATIONS.

SPECIFICATIONS.

INFILL WALL WITH CMU TO MATCH EXISTING. PATCH WITH WHOLE CMU. ACOUSTICAL CEILING BAFFLES SUSPENDED BETWEEN LINEAR LIGHTS 4" PREFINISHED COMPASSO EDGE TRIM, OR EQUAL. PROVIDE AROUND

9" PREFINISHED COMPASSO EDGE TRIM, OR EQUAL. PROVIDE AROUND ENTIRE

6" PREFINISHED COMPASSO EDGE TRIM, OR EQUAL. PROVIDE AROUND ENTIRE

24X24 CEILING MOUNTED PROJECTOR PLATE. COORDINATE FINAL LOCATION WITH OWNER. SEE ELECTRICAL SHEETS FOR POWER/DATA INFORMATION.

POST MOUNT PROJECTOR STEM MOUNTED TO UNISTRUT SECURED TO BOTTOM CHORD OF JOIST. COORDINATE FINAL LOCATION WITH OWNER. SEE

10000-12 STRUCTURE SUSPENDED OVERHEAD PROJECTOR, PROVIDE EXTRA LONG

115213-1 STRUCTURE MOUNTED MOTORIZED PROJECTION SCREEN, 116" WIDE, SEE

RCP SYMBOLS LEGEND

COLOR: WHITE, GRID: A- DX/DXL

GRID: A DONN DX/DXL

GRID TO MATCH.

OTHERWISE.

NOTED OTHERWISE.

PATTERN AS SHOWN ON A9.2.

CEILNG NOT IN SCOPE

KEY PLAN

SCALE: NONE

X'-X" / X'-X"

G-2

WIREWORKS CEILING. USG, STYLE:

2'x2' SUSPENDED ACOUSTICAL CEILING TILE AND GRID SYSTEM. USG (OR ARMSTRONG EQUAL 3278), STYLE: HALCYON ECO, ITEM NO.: 97312, SIZE: 2' X 2' X 3/4", PROFILE: SQUARE SQ,

2'x2' SUSPENDED ACOUSTICAL CLEANABLE CEILING TILE AND GRID SYSTEM. USG, STYLE: SHEETROCK BRAND LAY-IN CEILING PANEL CLIMAPLUS VINYL, ITEM NO.: 3260, SIZE: 2' X 2' X 1/2", PROFILE: SQUARE SQ, COLOR: WHITE,

2'x2' SUSPENDED METALWORKS CLEANABLE CEILING TILE AND GRID SYSTEM. ARMSTRONG, STYLE: METALWORKS TEGULAR, ITEM NO.: 646M1, SIZE: 2' X 2' X 5/16", PROFILE: SQUARE TEGULAR 9/16, COLOR: CUSTOM COLOR BLACK,

2'x2' EXISTING SUSPENDED ACOUSTICAL CEILING TILE AND GRID SYSTEM TO REMAIN

EXISTING GYP. BD. CEILING TO REMAIN. PAINTED PNT-8 UNLESS NOTED

GYP. BD. CEILING. PAINTED PNT-8 UNLESS

ACOUSTICAL CEILING PANEL. 4'-0" x 8'-0" BLACK ACOUSTICAL CEILING PANEL EQUAL TO OWENS CORNING 2" SELECTSOUND BLACK ACOUSTICAL BOARD. ATTACHED DIRECTLY TO DECK IN

WIREWORKS OPEN CELL FORMS, PATTERN: WEAVE, SIZE: 2' X 2' X 3/16", COLOR: SILVER

EXPOSED STRUCTURE ABOVE, PAINTED PNT-3.

WOOD LOOK PANELS OR WOOD TRIM. SEE FINISH LEGEND & SPECIFICATIONS.

SLOPE ARROW - INDICATES SLOPE OF CEILING

A-B

ELECTRICAL SHEETS FOR POWER/DATA INFORMATION.

115213-2 CEILING MOUNTED MOTORIZED PROJECTION SCREEN 92" WIDE, SEE

SEE GENERAL INFORMATION SHEET G0.2 FOR TYPICAL SYMBOLS. SEE MECHANICAL AND ELECTRICAL DRAWINGS FOR ADDITIONAL COORDINATION

REFLECTED CEILING PLAN

this document are the sole property of Design Collaborative, Inc., and shall not be used for any purpose without their expressed written consent. The owner shall be permitted to retain copies for information and reference.

BID/PRICING SET


ISSUE DATE: 9/13/2024

REVISIONS NO. DATE 10/17/2024 11/04/2024

ADD-01

REFLECTED CEILING PLAN - MAIN LEVEL -UNIT F



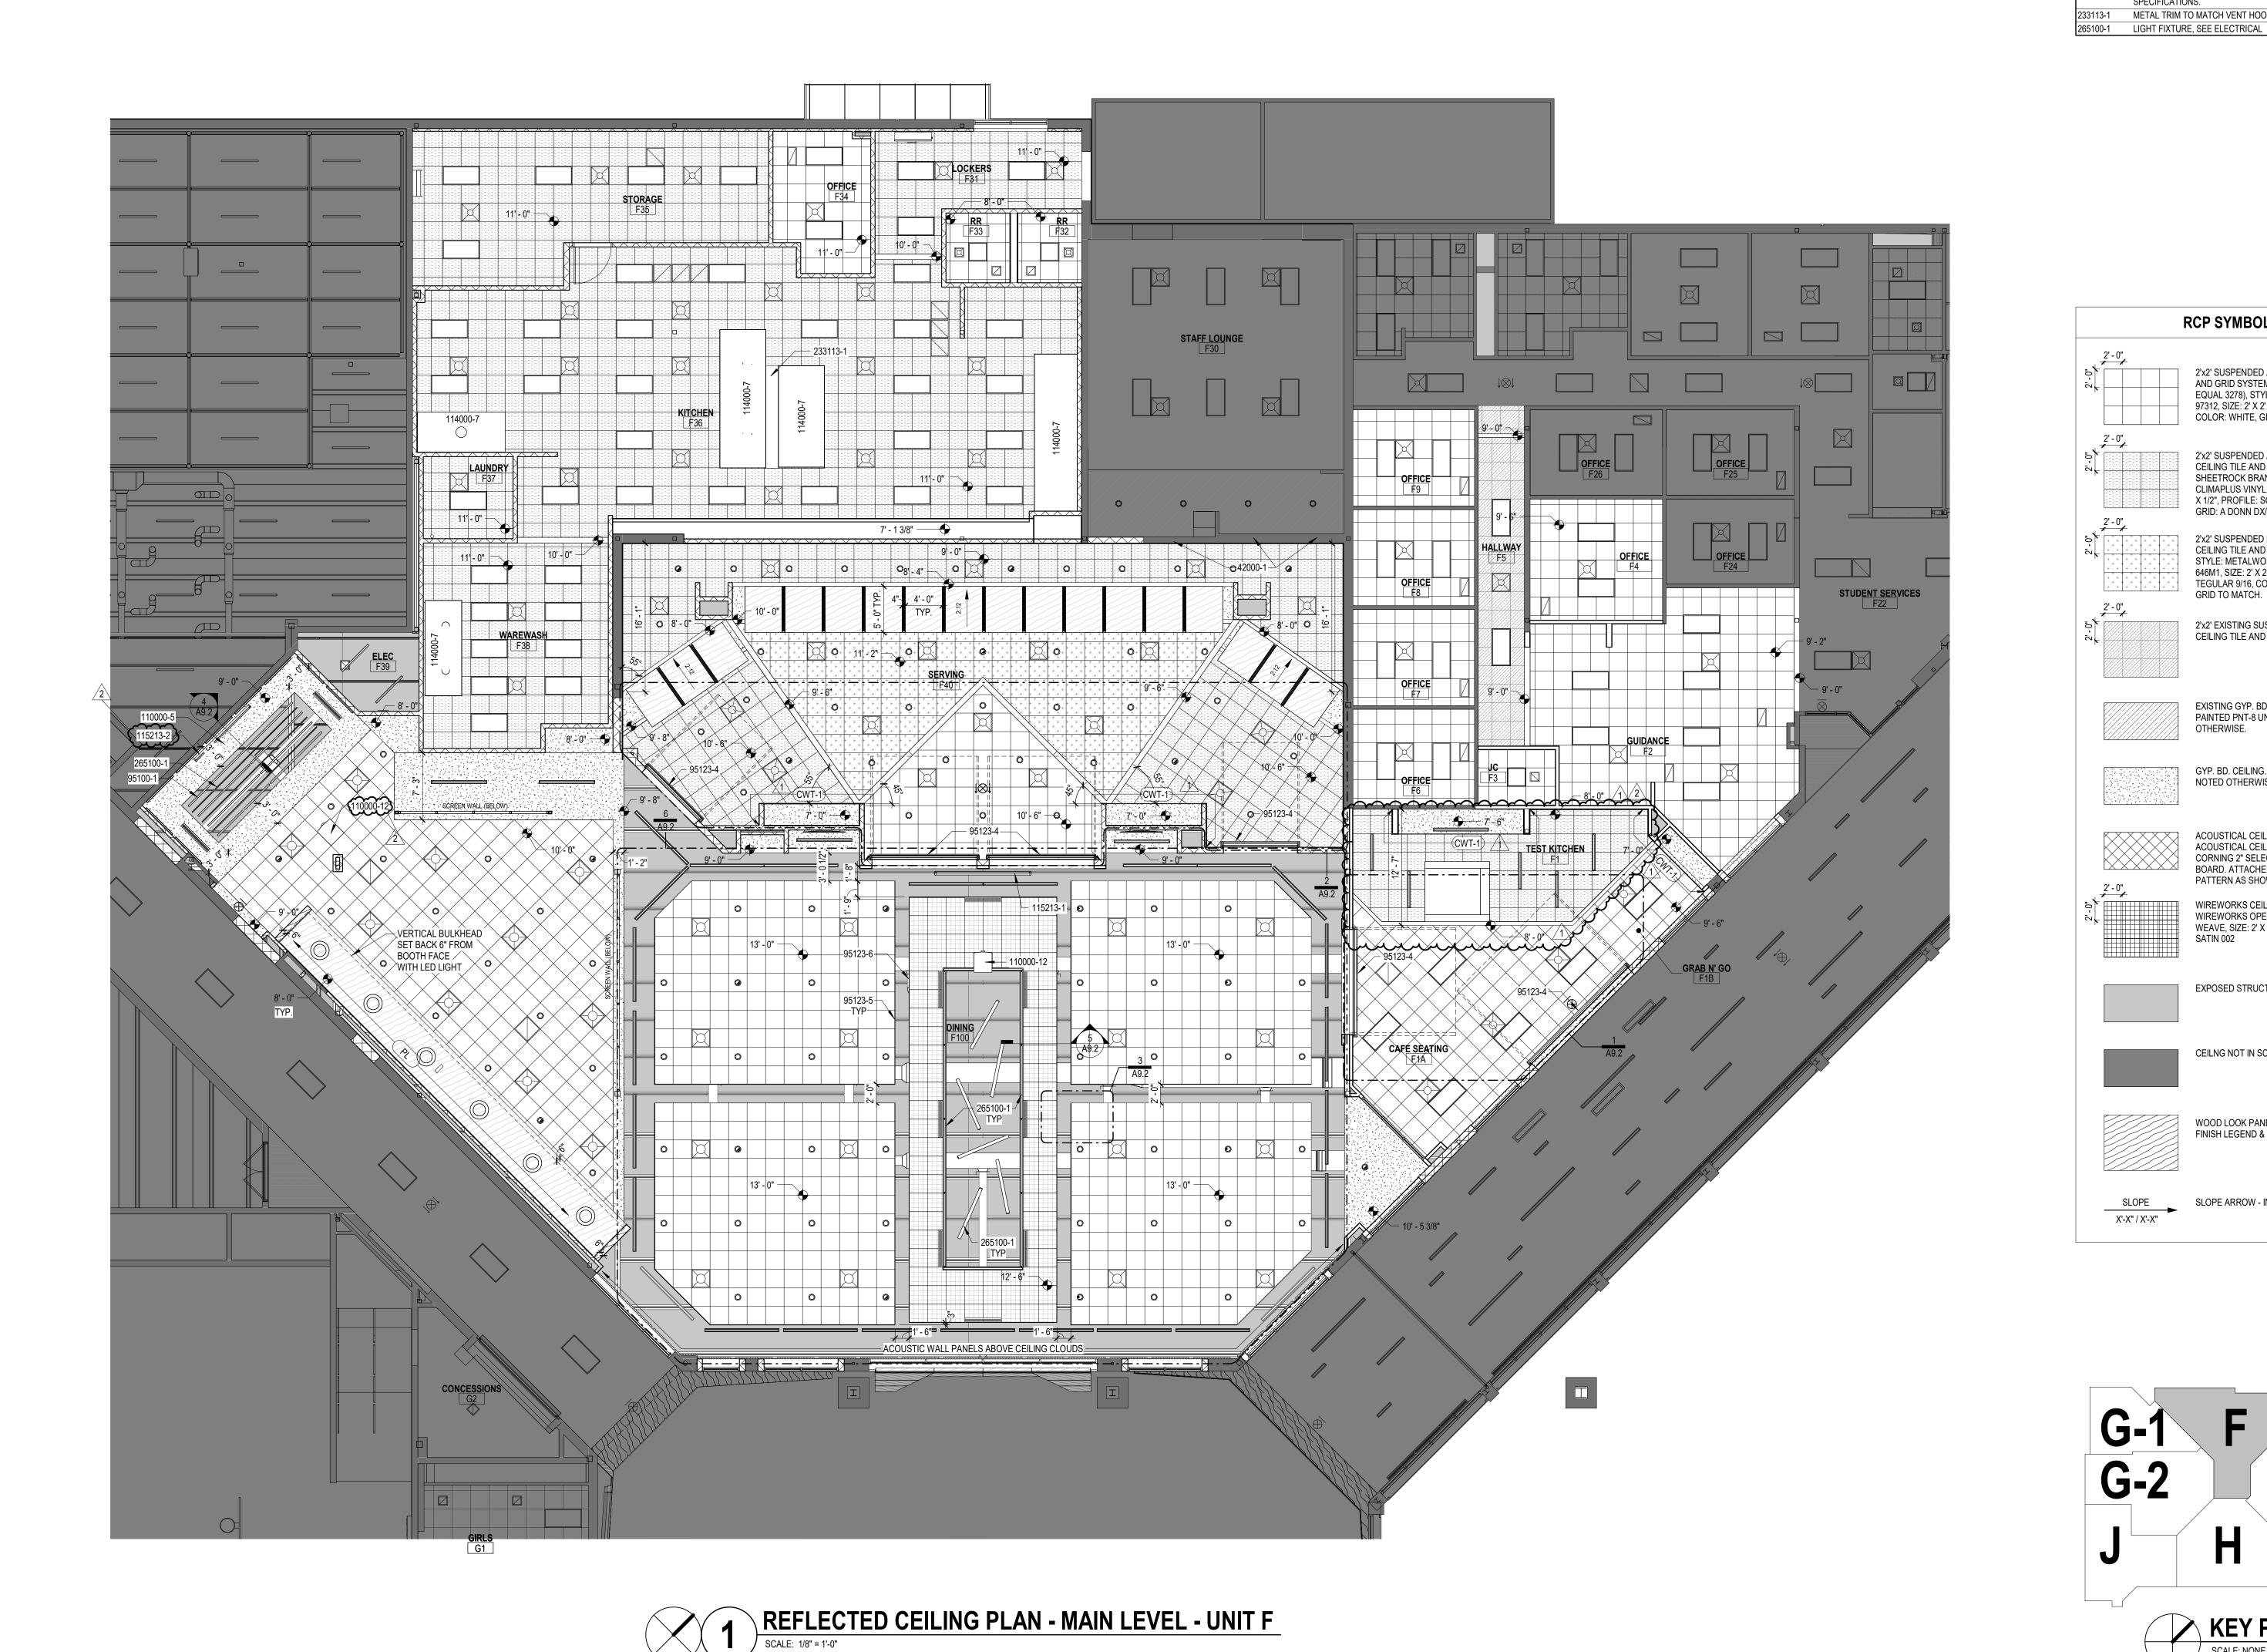

MAIN LEVEL - CAFE AREA - UNISTRUT PLAN

Fort Wayne, IN 46819

9100 Winchester Road

WHS DINING & KITCHEN





\$\text{\text{\QUIDE Cast Main Street}}\$

Suite 600


Fort Wayne, IN 46802


\$\text{\QUID CAS2.4241}\$


\$\text{\QUID CAS2.4847}\$

\$\text{\QUID CAS2.4847}\$

DESIGN

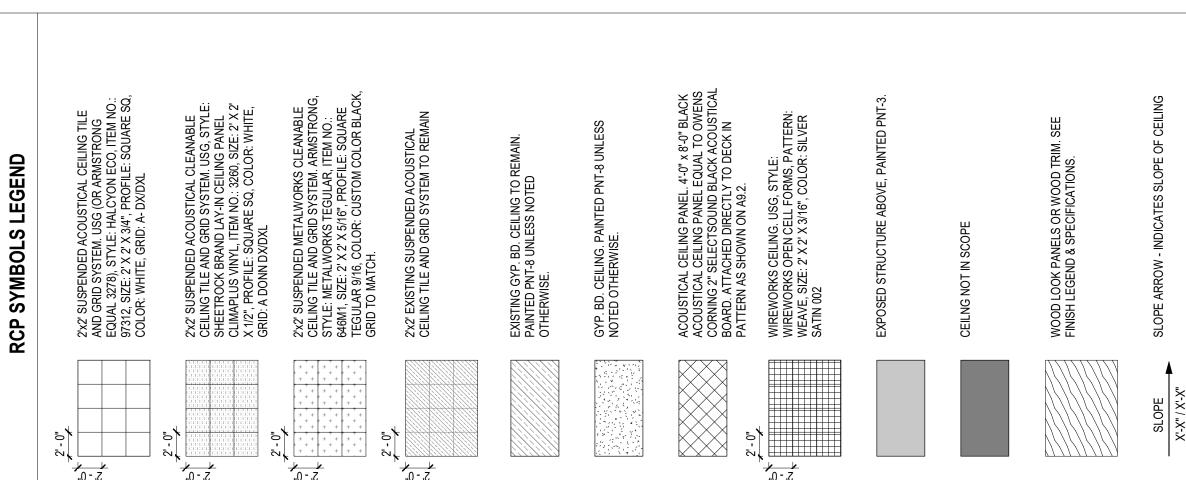


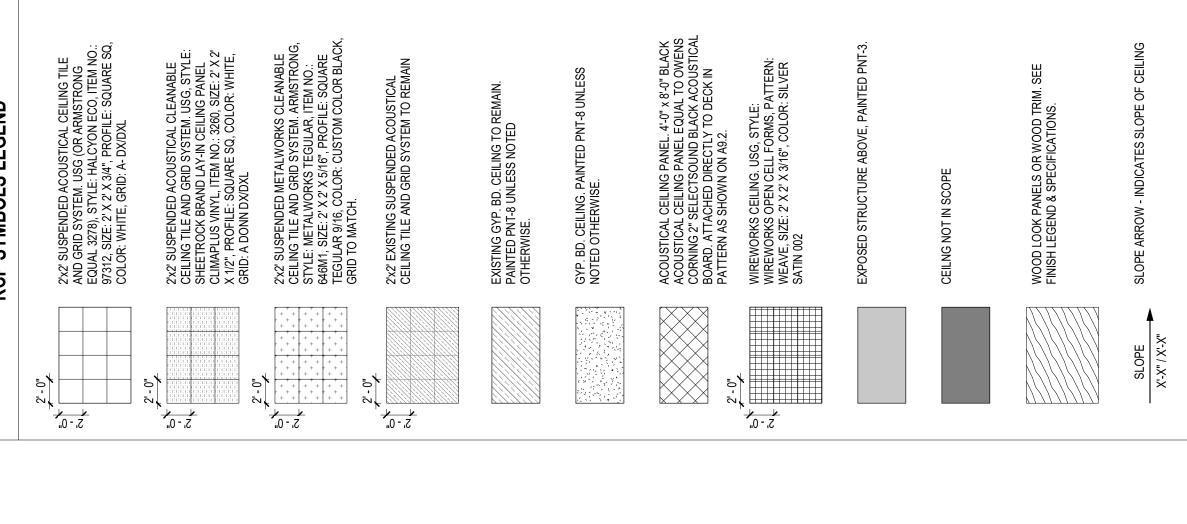


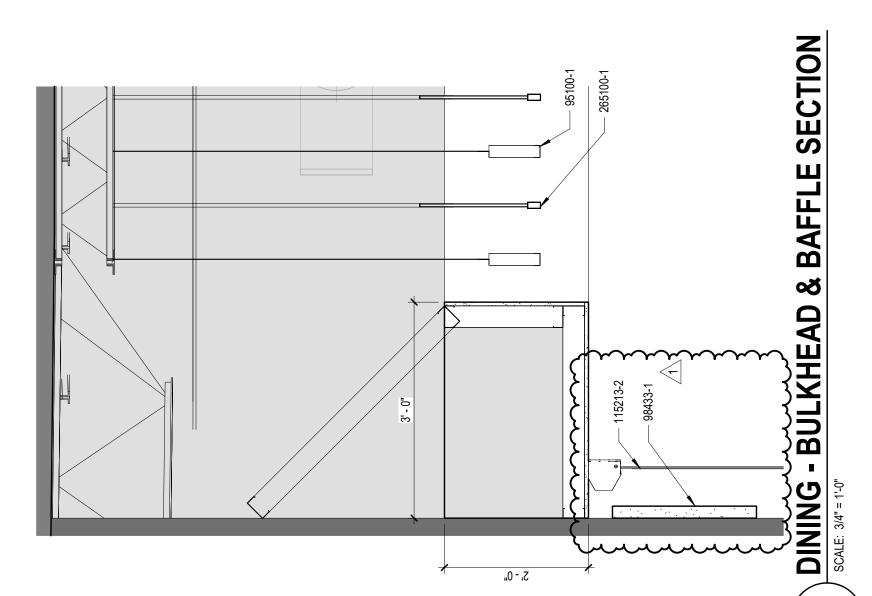



REFLECTED CEILING PLAN - DINING AREA (ABOVE CEILING) SCALE: 1/8" = 11-0"

(မ)

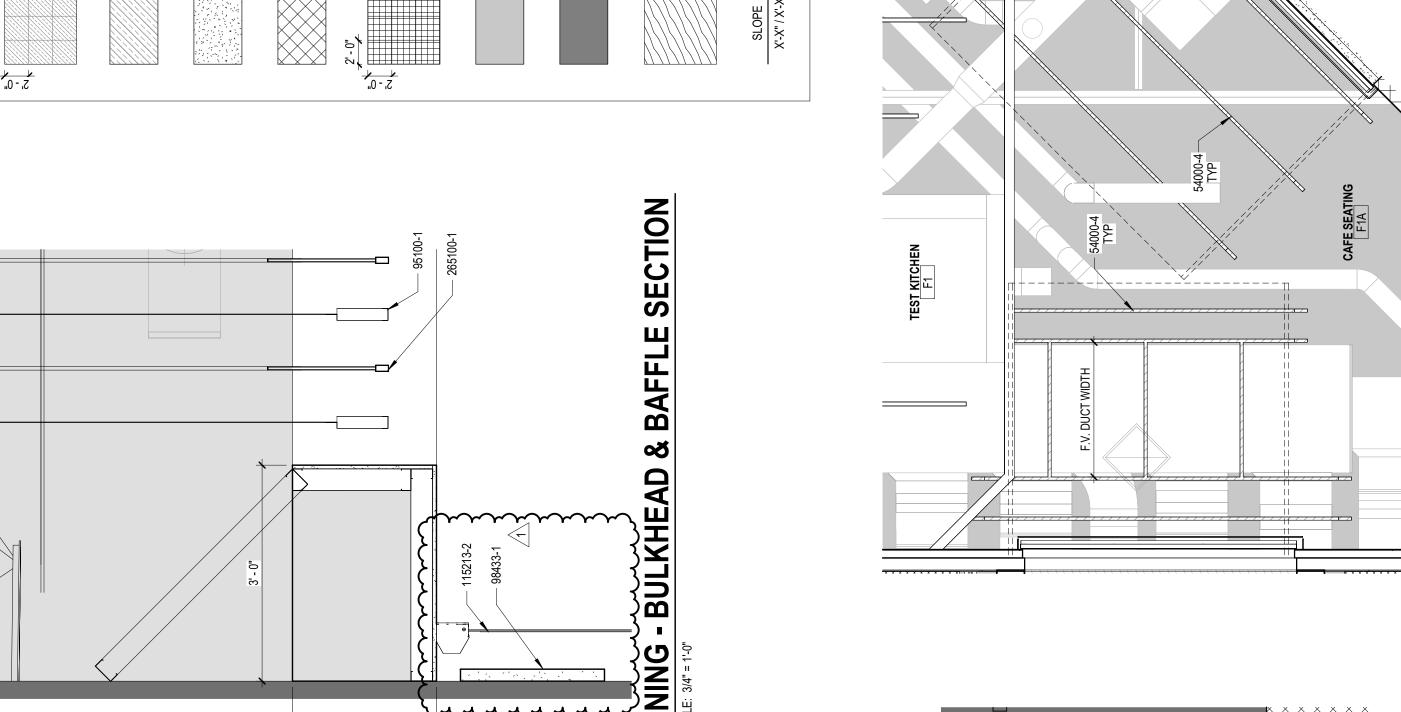

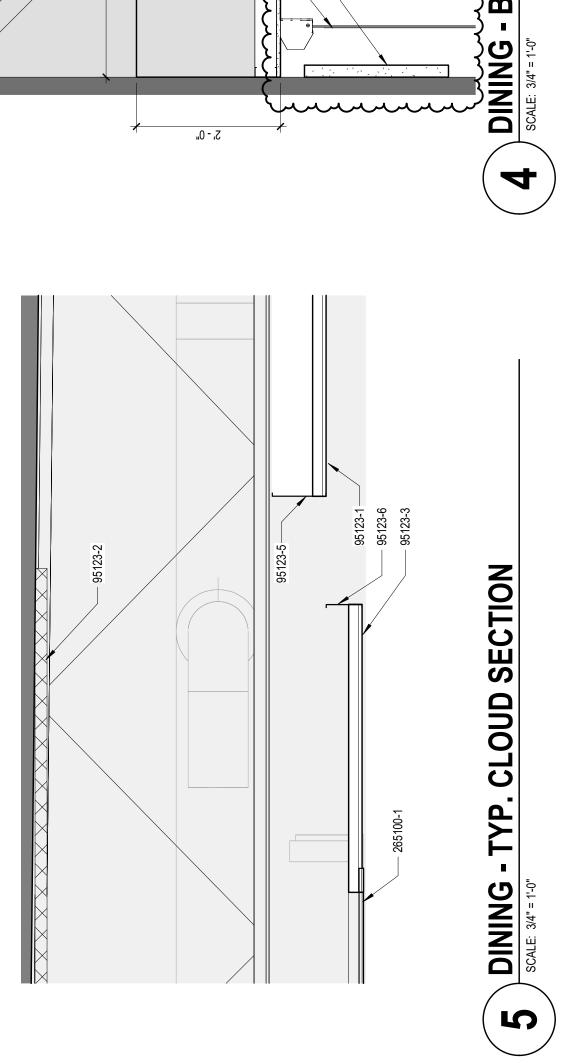

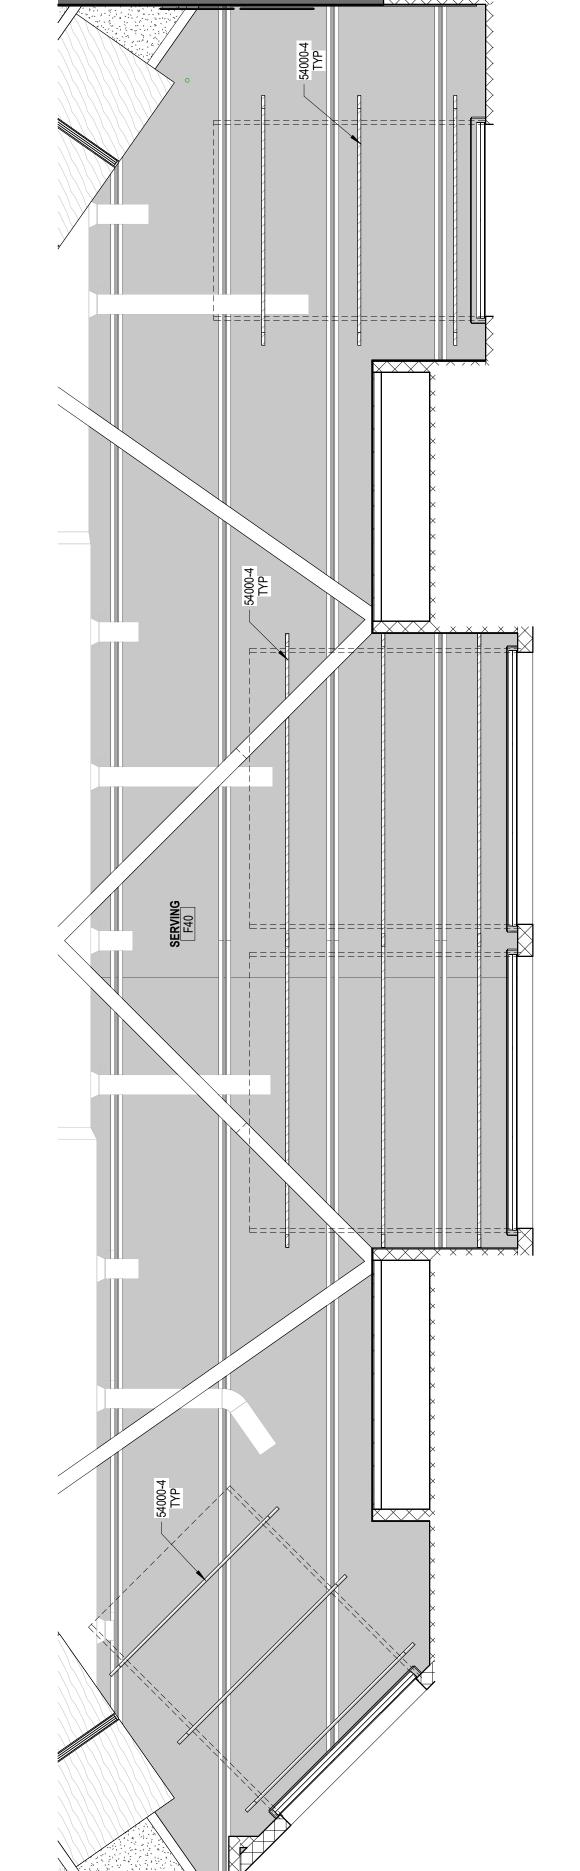

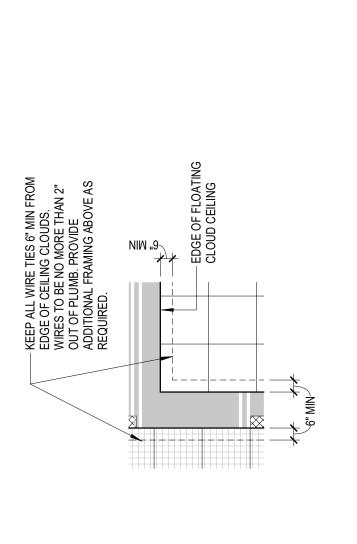


JD DETAIL

MAIN LEVEL - SERVING AREA - UNISTRUT PLAN scale: 1/4" = 1'-0"

Fort Wayne, IN 46819 Fort Wayne, IN 46819

PROJECT: 2023.0232



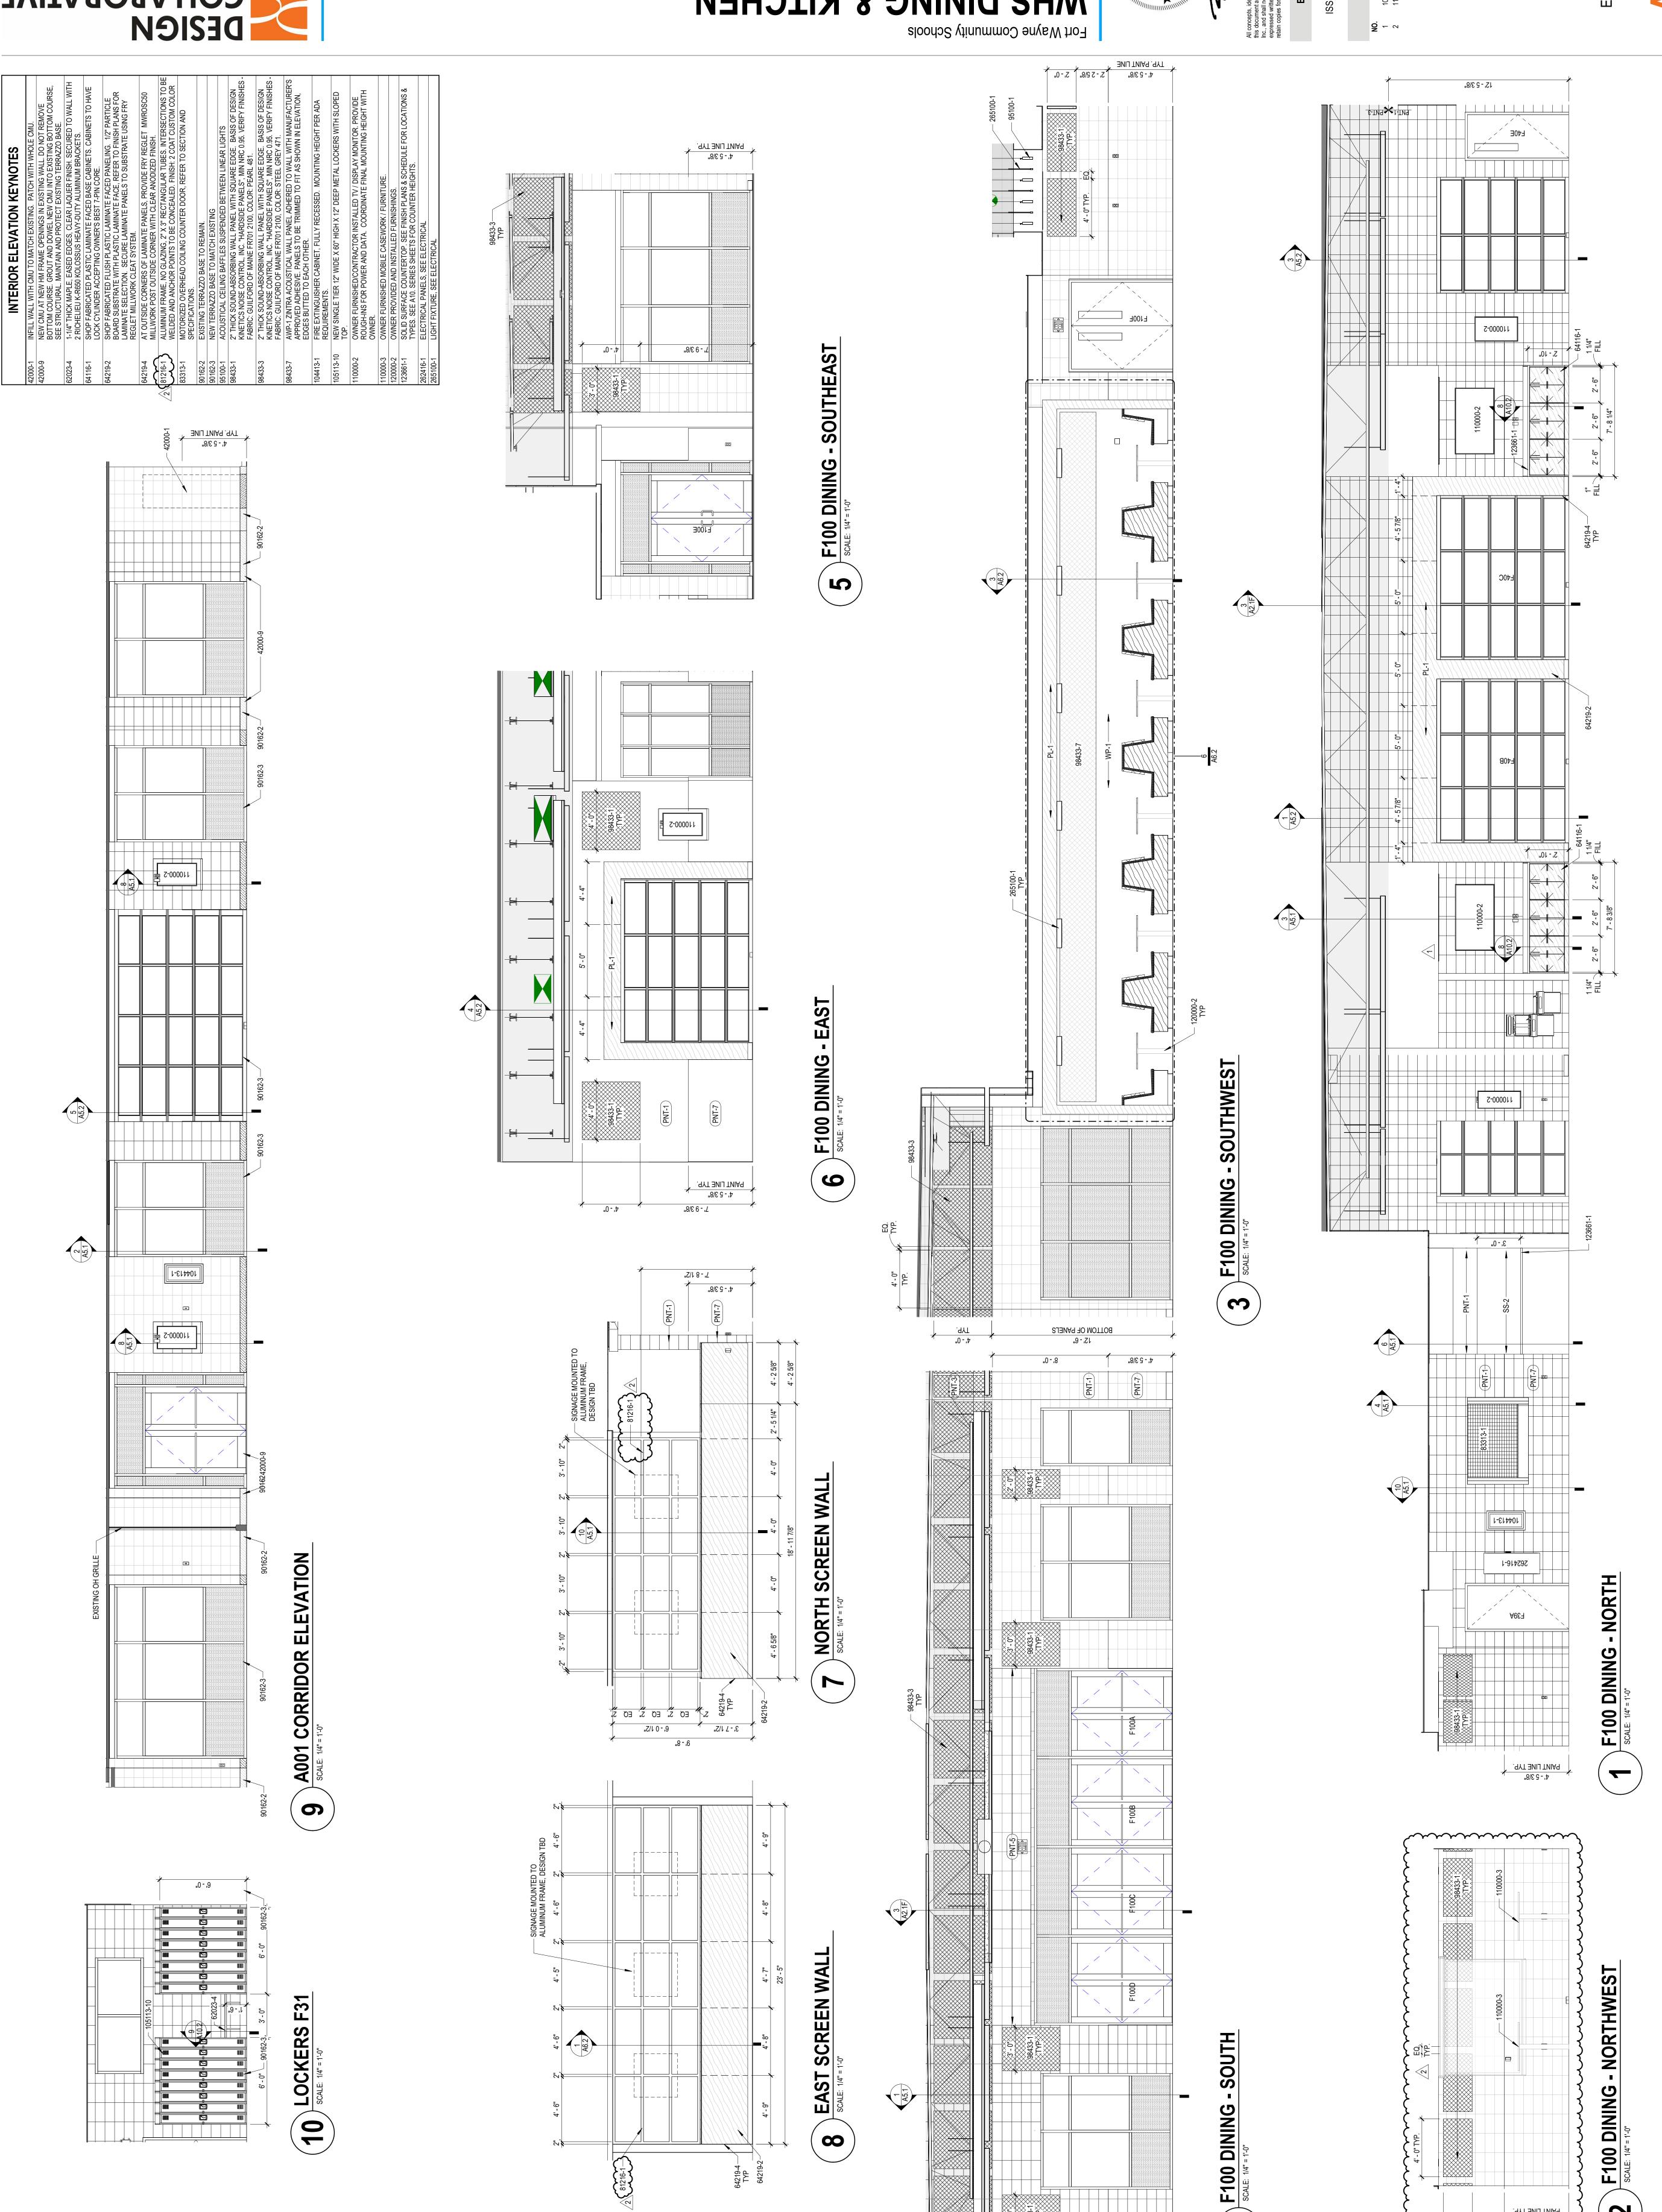

4' - 5 3/8" PAINT LINE TYP.












mos.evitanoallaborative.com

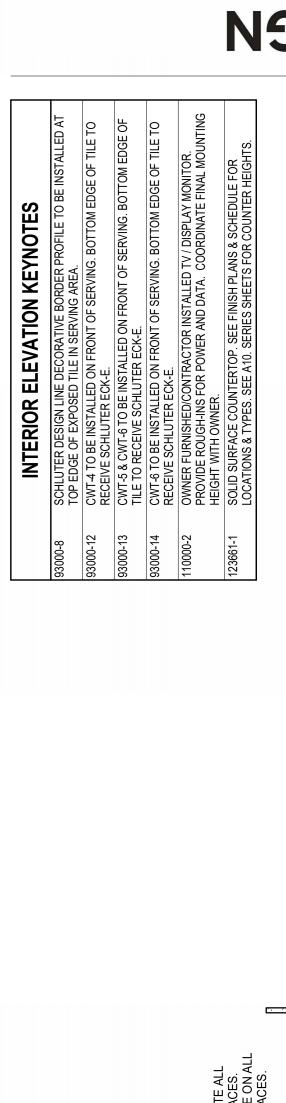

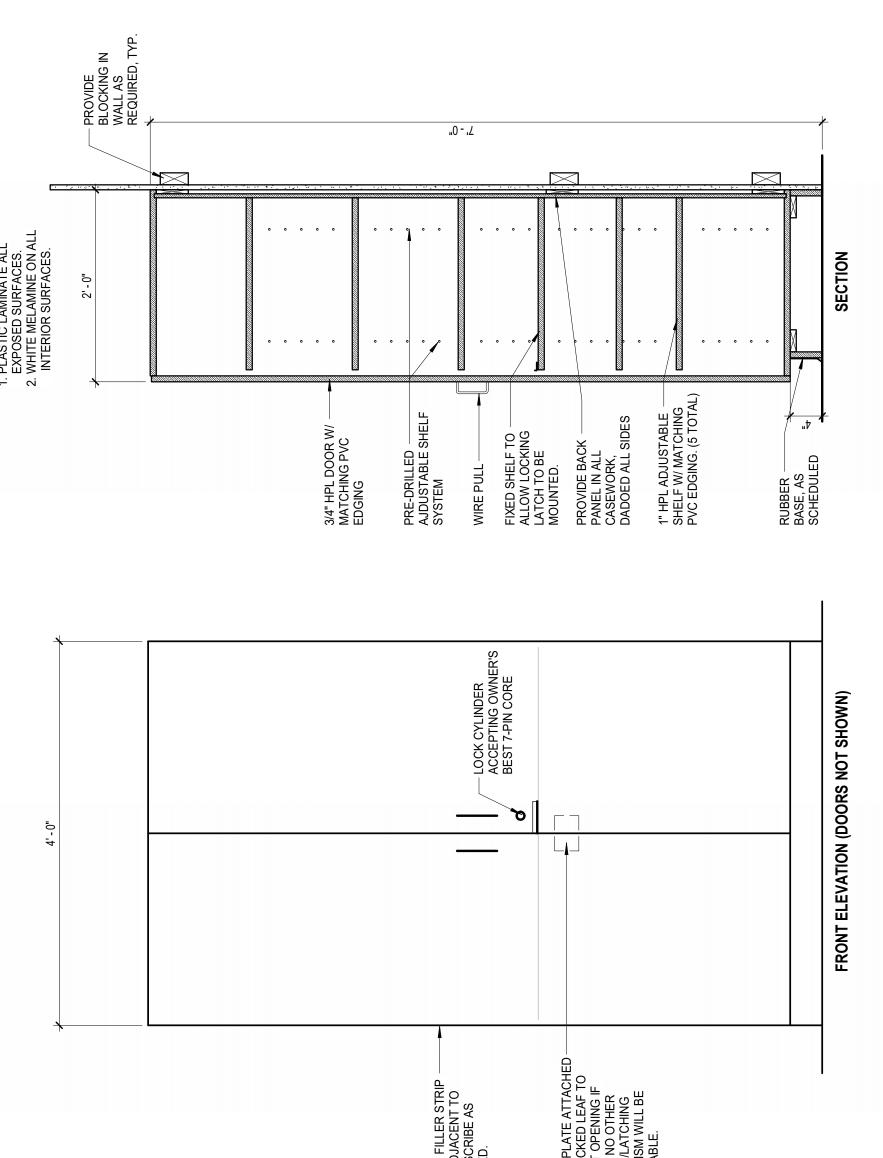

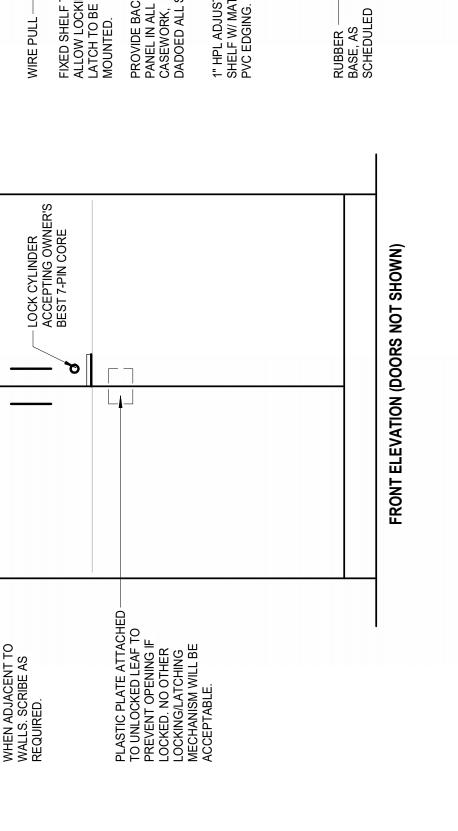


TYPICAL STORAGE CABINET (S1)


10

LOCKER BENCH SCALE: 1"= 1:0"

တ

1-1/4" THICK MAPLE, EASED EDGES, CLEAR LAQUER FIN

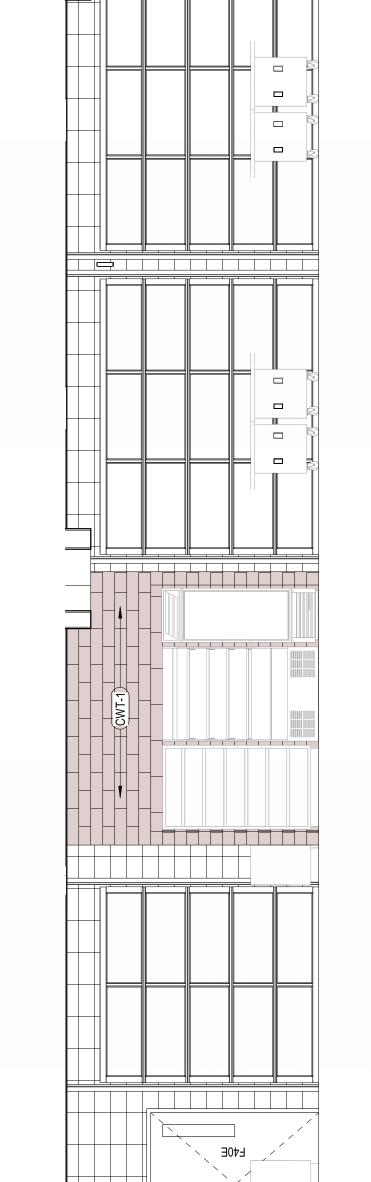

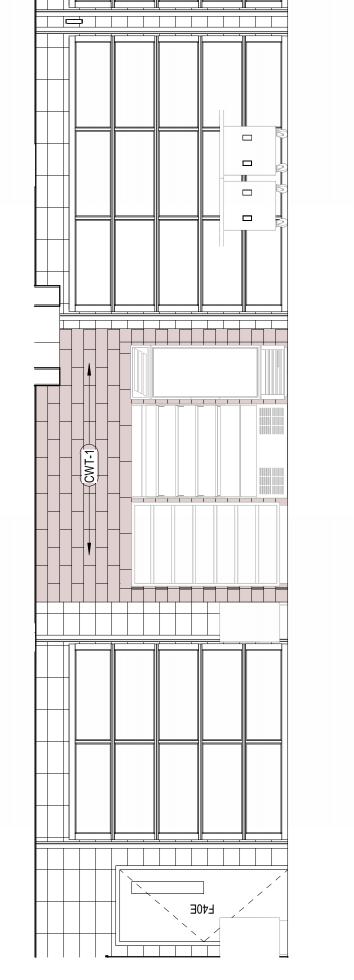

CHECKOUT ELEVATION


9


CASEWORK - TYP. BASE - SS


 ∞

PRE-DRILLED ADJ. SHELF SYSTEM

P-LAM BASE CAB RUBBER BASE, AS SCHEDULED

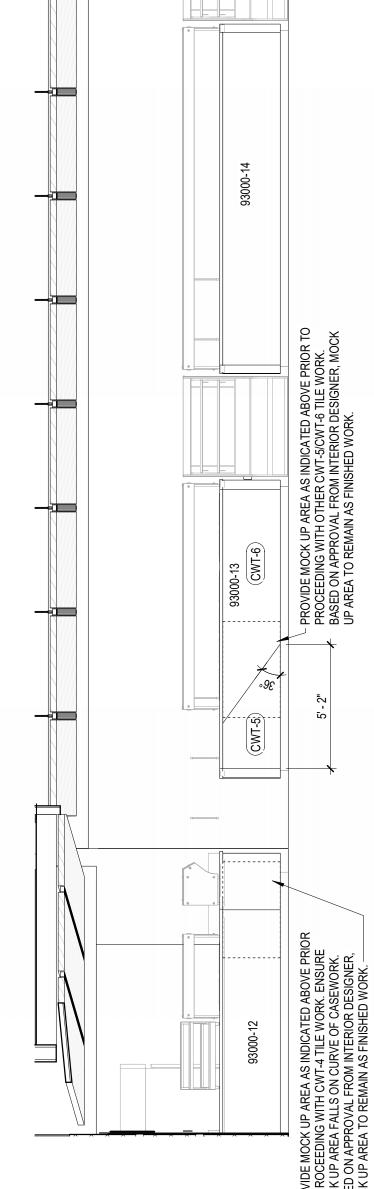

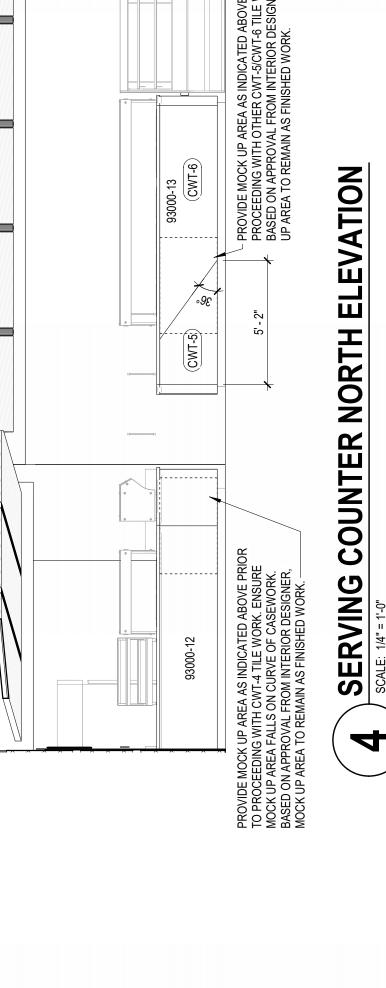

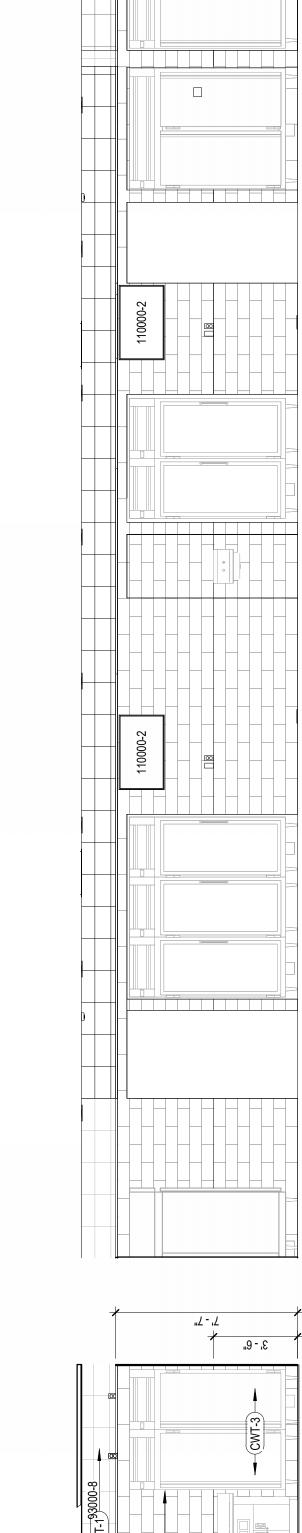

F1 NORTHSCALE: 1/4" = 1-n"

2




BOH SERVING EAST

3. - 6"

3, - 6"

BOH SERVING WEST SCALE: 1/4" = 1'-0"

MA S1:85:8 4202/8/11

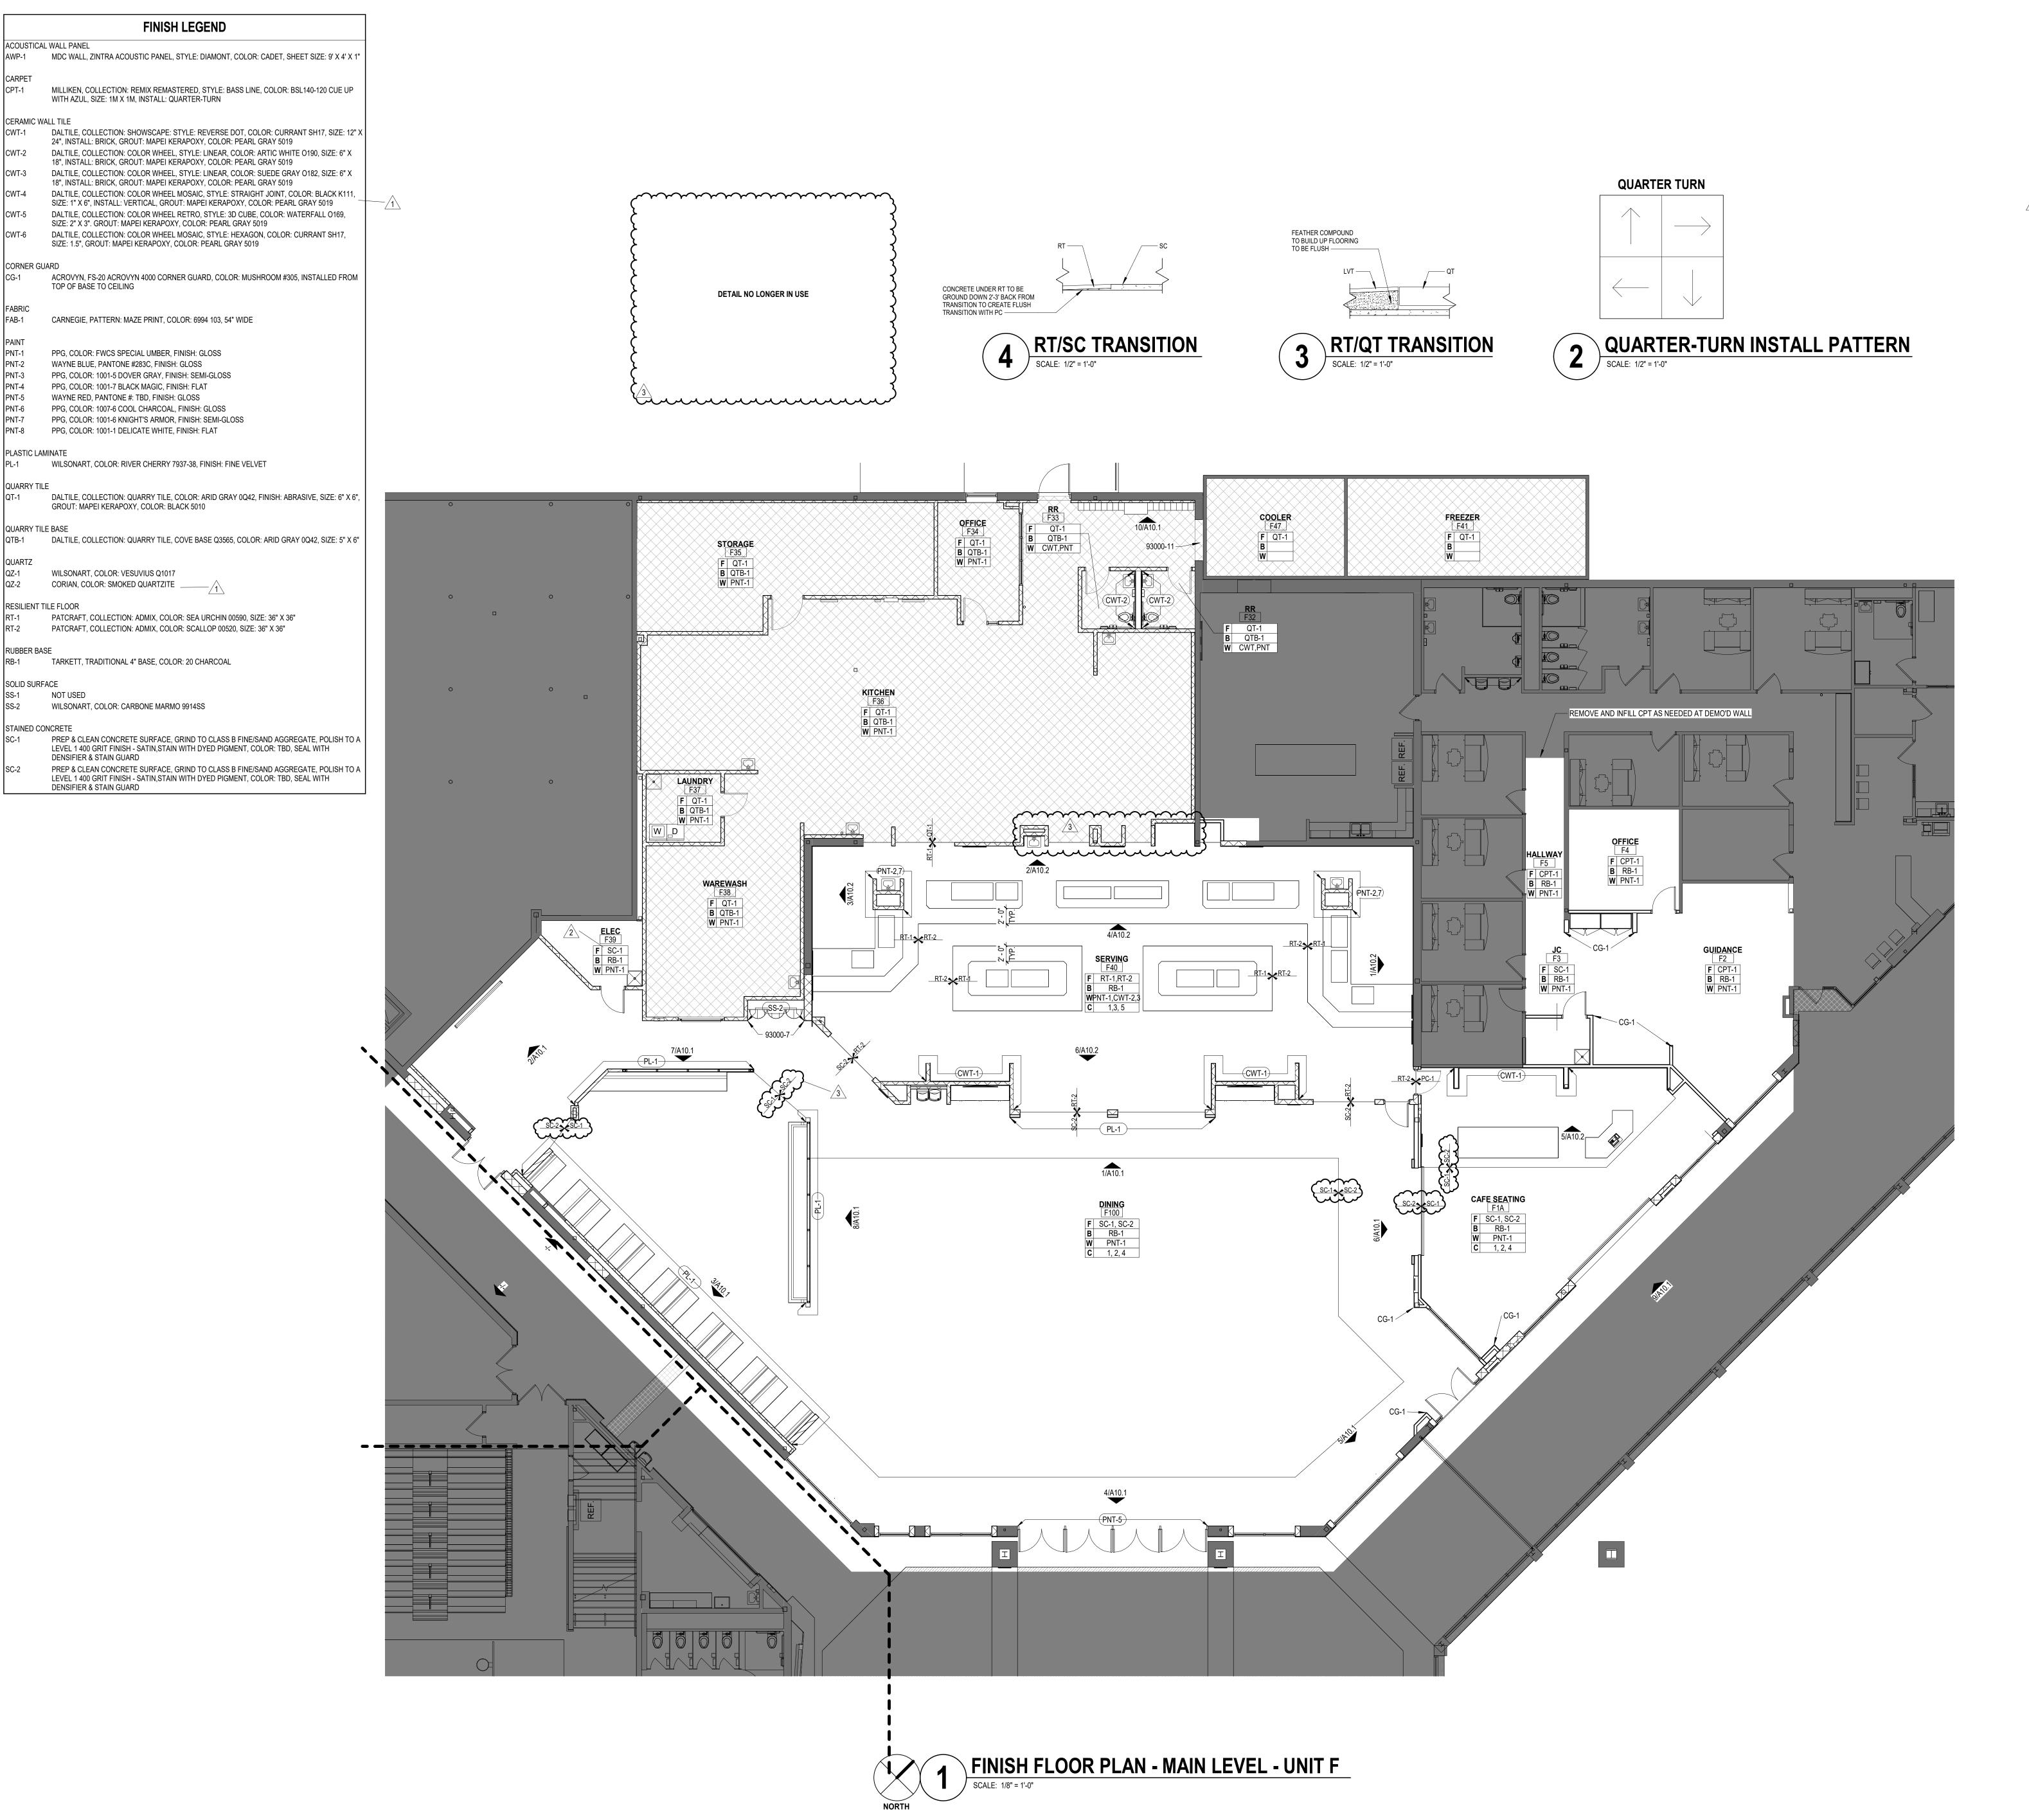

QUARTZ

GENERAL ROOM FINISH NOTES

SEE "GENERAL" SHEETS IN THE FRONT OF THE WORKING DRAWING SET FOR DEFINITION OF ABBREVIATIONS. THE SCHEDULED MATERIALS AND FINISHES SHALL NOT BE ORDERED OR INSTALLED BEFORE THE CONTRACTOR'S ACTUAL COLOR SAMPLE SUBMITTALS HAVE BEEN APPROVED AS CALLED FOR ON THE DRAWINGS AND IN THE SPECIFICATIONS.

ALL FLOOR FINISH TRANSITIONS TO OCCUR IN THE MIDDLE OF DOOR FRAME, UNLESS NOTED OTHERWISE ON FLOOR FINISH PLAN.

PROVIDE SCHLUTER SCHIENE TRANSITIONS STRIP WHEREVER DIFFERING FLOOR MATERIALS MEET, UNLESS NOTED OTHERWISE. ALL HOLLOW METAL DOOR FRAMES AND WINDOWS FRAMES TO BE PAINTED PNT-7

WITH ZERO VOC ACRYLIC BASED PAINT WITH A SEMI-GLOSS FINISH. BASIS OF DESIGN, ALL SOLID WOOD DOORS TO BE MASONITE DOOR SYSTEMS, SPECIES: WHITE BIRCH, CUT: ROTARY, STAIN: COCOA BEAN ALL EXPOSED STEEL STRUCTURE TO BE PAINTED PNT-3 WITH SEMI-GLOSS FINISH

REFER TO A10 SERIES FOR ADDITIONAL WALL FINISH INFORMATION ALL COUNTERTOPS AND 4" BACKSPLASHES TO BE QZ-1 IN SERVING AND QZ-2 IN CAFE, UNLESS NOTED OTHERWISE.

ALL CASEWORK TO BE PL-1, UNLESS NOTED OTHERWISE. REFER TO FLOOR FINISH PLAN FOR FLOORING INSTALL DIRECTION.

ALL CASEWORK HARDWARE TO BE WIRE PULL UNLESS NOTED OTHERWISE. PROVIDE SCHLUTER QUADEC TRIM PIECE WITH EB FINISH AT ALL EXPOSED TILE

FINISH FLOOR PLAN KEYNOTES

SCHLUTER QUADEC PIECE TO BE INSTALLED AT EDGE OF EXPOSED TILE. SUBSTRATE TO BE TREATED AS NEEDED TO PROVIDE LEVEL TRANSITION BETWEEN COOLER AND BUILDING.


FINISH COMMENTS

EXPOSED CEILING TO BE PAINTED PNT-3. PNT-6 FROM TOP OF BASE TO 4'-5" A.F.F., PNT-1 ABOVE TO CEILING. PAINT LINE TO BE ALIGNED WITH CMU COURSING. CWT-3 TO BE INSTALLED FROM FLOOR TO 4'-5" A.F.F., CWT-2 TO CONTINUE TO 7'-7" A.F.F. PNT-1 ABOVE. CWT-3 HEIGHT TO ALIGN WITH WAINSCOT LINE NOTED IN

FINISH COMMENT #2. SC-1 & SC-2 PATTERN TBD. COLUMNS TO BE PNT-6 FROM TOP OF BASE TO 4'-5" A.F.F., PNT-2 ABOVE TO

CEILING. PAINT LINE TO BE ALIGNED WITH CMU COURSING.

ROOM FINISH TAG KEY FLOOR — COMMENTS - C NOTE: FINISHES INDICATED IN FINISH LEGEND BOXES ARE GENERAL OVERALL FINISHES FOR THE ROOM, UNLESS NOTED OTHERWISE BY A COMMENT, DETAIL, OR INTERIOR ELEVATION.

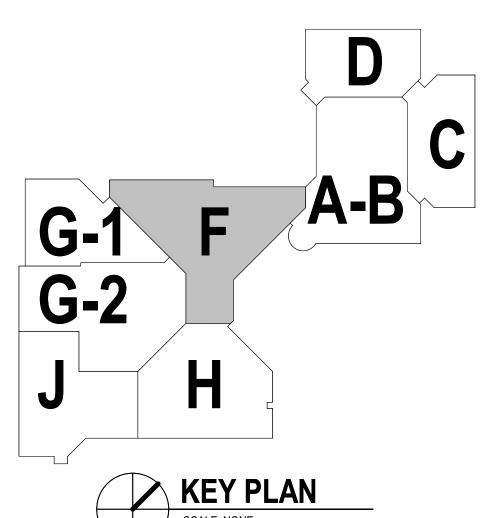



this document are the sole property of Design Collaborative, Inc., and shall not be used for any purpose without their expressed written consent. The owner shall be permitted to retain copies for information and reference.

BID/PRICING SET

ISSUE DATE: 9/13/2024

REVISIONS 10/17/2024 10/24/2024 11/04/2024

FLOOR FINISH PLAN -

MAIN LEVEL - UNIT F

KITCHEN HOOD

SYSTEM

Inc., and shall not be used for any purpose without their

expressed written consent. The owner shall be permitted to

retain copies for information and reference.

DRAWN BY: brett.payn SCALE:

9

 \triangle

 \cong

10

00d 681

4

Z

Ø

3/4" = 1'-0"

MASTER DRAWING

SHEET NO.

FOR QUESTIONS, CALL THE Indiana Mechanical REGION 38 PHONE: (317) 215 - 0671 EMAIL: reg38@captiveaire.com

HOOD	INFORM	JATION – JOE	3#7134093	-																
ноор	TAG	MODEL	MANIJEACTI IDED				APPLIANCE		TOTAL				UST PL				TDTAL SUPPLY	HOOD	HOOD C	
ND	THU	MODEL	MANOF ACTORER	LENGTH	COOKING TEMP	TYPE	DUTY	CFM/FT	EXH CFM	WIDTH	LENG	HEIGHT	DIA	CFM	VEL	SP	CFM	CONSTRUCTION	END	R□W
1	Demo Hood	6024 EX-2WI-PSP-FB	ECON-AIR	6′ 0″	450 DEG	Ι	MEDIUM	269	1614			4"	14"	1614	1510	-0.916"	1325	430 SS WHERE EXPOSED	ALONE	ALONE
$\mu \alpha \alpha D$	INFODM	IATION																		

			F	FILTER(S>			LIGHT(S)					UTILITY CABINET(S)			FIRE	НООО
HOOD	TAG					EFFICIENCY @ 7	QTY TYPE		WIRE			FIR	RE SYSTEM	ELECTRICAL	SWITCHES	SYSTEM	
ND	THO	TYPE	QTY	HEIGHT	LENGTH	MICRONS	QTY	QTY TYPE		LOCATION	SIZE	TYPE	SIZE	MODEL #	QUANTITY	PIPING	
1	Demo Hood	CAPTRATE SOLO FILTER	4	16"	16"	85% SEE FILTER	3	RECESSED ROUND	ND	RIGHT	12"×60"×24"	TANK FS	4.0	SC-211110MA	1 LIGHT	YES	726
	Hood	CHITRATE SUED FIETER		10		SPEC		RECESSED REGIND		RIGITI	16 700 764	THINK 13	4.0	3C LITTONA	1 FAN	123	LBS
HOOD	<i>OPTION</i>	S															

- 1														
+		1	Down Hood	FIELD	WRAPPE	R 30.0	00″ HIG	H FF	RONT, L	EFT, R	IGHT,	BACK.		
		1	Demo Hood	FINISHED	BACK-	ISL/RE	V INSTA	LL 72	2.00″ L	DNG, (F	FILTER	S TO	THE BACK	<>.
		PERF	ORATED S	UPPLY	PLEN	UM(S)								
		HDDD				, ,				·	RISER	(2		
		ND LUDUD	TAG	POS	LENGTH	WIDTH	HEIGHT	TYPE	WIDTH	LENG	DIA	CFM	SP	
				Do el c	84"	9"	6"	MUA	6″	28″		331	0.091"	
		1	Demo Hood	Back	04	ד	Ь	MUA	6″	28"		331	0.091"	
MZ.	т	1	מסטת הפויוט ו	Front	84"	9"	6"	MUA	6″	28"		331	0.091"	
M.				Front	04	7	6	MUA	6"	28"		331	0.091"	

CLEARANCE TO COMBUSTIBLES


TAG

HOODS #	SURFACE	*CLEARANCE
	TOP	18"
	FRONT	0"
1	BACK	0"
	LEFT	18"
	RIGHT	0"

- *0" CLEARANCE TO COMBUSTIBLES CONFORMS TO UL710 STANDARD. - HODD MOUNTED UTILITY CABINETS REQUIRE 36" SERVICE CLEARANCE.

SUPPLY PLENUM <u>HANGING ANGLE</u> (HARDWARE BY INSTALLER) 1/2' GRADE 5 (MINIMUM) STEEL FLAT WASHER 1/2" - 13 TPI GRADE 5 (MINIMUM) -STEEL ALL-THREAD 1/2' - 13 TPI GRADE 5 (MINIMUM) \ STEEL HEX NUT HANGING ANGLE (WEIGHT BEARING — ANCHOR POINT FOR SUPPLY PLENUM) 1/2' GRADE 5 (MINIMUM) STEEL FLAT WASHER

ASSEMBLY INSTRUCTIONS

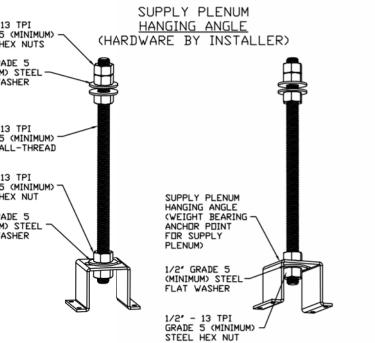


HANGING ANGLE MUST BE SUPPORTED WITH 1/2" - 13 TPI GRADE 5 (MINIMUM) ALL-THREAD. SANDWICH HANGING ANGLES AND CEILING ANCHOR POINTS WITH 1/2" GRADE 5 (MINIMUM) STEEL FLAT WASHERS AND 1/2" - 13 TPI GRADE 5 (MINIMUM) HEX NUTS AS SHOWN, MUST USE DOUBLED HEX NUT CONFIGURATION ABOVE CEILING ANCHORS, SINGLE HEX NUT BENEATH HANGING ANGLE IS ACCEPTABLE FOR PSP HANGING ANGLES. MAINTAIN 1/4" OF EXPOSED THREADS BENEATH BOTTOM HEX NUT. TORQUE

ALL HEX NUTS TO 57 FT-LBS.

System Design Verification (SDV)

Any field related discrepancies that are discovered during the SDV will be brought to the will be documented and forwarded to the appropriate sales office. If CAS Service has to billed for the work. Should a return trip be required due to any field related discrepancy

During the SDV, CAS Service will address any discrepancy that is the fault of the manufacturer. Should a return trip be required, the general contractor and appropriate sales office will be notified. There will be no additional charges for manufacturer discrepancies.

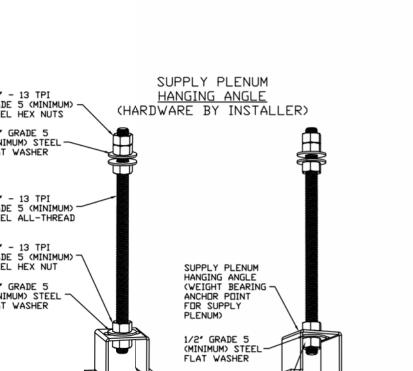

If ordered, CAS Service will perform a System Design Verification (SDV) once all equipment has had a complete start up per the Operation and Installation Manual Typically, the SDV will be performed after all inspections are complete.

1/2" - 13 TPI GRADE 5 (MINIMUM) — STEEL ALL-THREAD

GRADE 5 (MINIMUM) 7 STEEL HEX NUT

1/2" GRADE 5 (MINIMUM) STEEL FLAT WASHER

ASSEMBLY INSTRUCTIONS

HANGING ANGLE MUST BE SUPPORTED WITH 1/2" - 13 TPI

ANGLES AND CEILING ANCHOR POINTS WITH 1/2" GRADE 5

DOUBLED HEX NUT CONFIGURATION BENEATH HOOD HANGING

FULL LENGTH

HANGING ANGLE

(HARDWARE BY INSTALLER)

FULL LENGTH
HANGING ANGLE
(WEIGHT BEARING —
ANCHOR POINT
FOR HOOD)

1/2" GRADE 5 (MINIMUM) STEEL FLAT WASHER

ASSEMBLY INSTRUCTIONS

HANGING ANGLE MUST BE SUPPORTED WITH 1/2" - 13 TPI

ANGLES AND CEILING ANCHOR POINTS WITH 1/2" GRADE 5

GRADE 5 (MINIMUM) ALL-THREAD. SANDWICH HANGING

(MINIMUM) STEEL FLAT WASHERS AND 1/2" - 13 TPI

ANCHORS. SINGLE HEX NUT BENEATH HANGING ANGLE IS

MAINTAIN 1/4" OF EXPOSED THREADS BENEATH BOTTOM

GRADE 5 (MINIMUM) HEX NUTS AS SHOWN, MUST USE

DOUBLED HEX NUT CONFIGURATION ABOVE CEILING

ACCEPTABLE FOR FULL LENGTH HANGING ANGLES.

HEX NUT. TORQUE ALL HEX NUTS TO 57 FT-LBS.

1/2" - 13 TPI GRADE 5 (MINIMUM) -STEEL HEX NUT

ANGLES AND ABOVE CEILING ANCHORS, MAINTAIN 1/4" OF EXPOSED THREADS BENEATH BOTTOM HEX NUT. TORQUE

GRADE 5 (MINIMUM) ALL-THREAD, SANDWICH HANGING

(MINIMUM) STEEL FLAT WASHERS AND 1/2" - 13 TPI GRADE 5 (MINIMUM) HEX NUTS AS SHOWN, MUST USE

ALL HEX NUTS TO 57 FT-LBS.

1/2' GRADE 5 (MINIMUM) STEEL ' FLAT WASHER

1/2' GRADE 5 (MINIMUM) STEEL FLAT WASHER

GRADE 5 (MINIMUM) — STEEL ALL-THREAD

1/2' GRADE 5 (MINIMUM) STEEL FLAT WASHER

attention of the general contractor and corresponding trades on site. These issues resolve a discrepancy that is a field issue, the general contractor will be notified and that cannot be resolved during the SDV, there will be additional trip charges.

1/2" DIA. HEAVY DUTY NUT 1/2" DIA. ALL THREAD ROD ONE ABOVE AND ONE BELOW CONNECTED TO ROOF JOIST *ROD AND NUTS TO BE SUPPLIED BY INSTALLING CONTRACTOR

	PRE-PUNCHED AT			
HANGING	<u>ANGLE</u>	DETAIL	5	
HOOD STYLE / MODEL	450 DEGREES cfm/ft.	600 DEGREES cfm/ft.	700 DEGREES cfm/ft.	
CANOPY ND2	150	200	250	
WITH END PANELS (15% reduction)	127.5	170	212.5	
SLOPED SND-2	228	294	-	
ISLAND ND-2WI	269	300	350	
NDI	346	422	475	

ETL HOOD LISTING DETAIL EXHAUST CFM=LENGTH OF HOOD X CFM/LIN.FT. (LOAD) SUPPLY CFM=EXHAUST CFM X PERCENTAGE REQUIRED TOTAL DUCT AREA=144 X CFM

DUCT LENGTH= TOTAL DUCT AREA DUCT DEPTH *CAPTIVE-AIRE VENTILATOR DUCT SIZES ARE CALCULATED USING AN EXHAUST VELOCITY OF 1500-1800 FPM AND A SUPPLY VELOCITY OF 1000 FPM.

CALCULATIONS UTILIZED CAPTIVE-AIRE HOODS ARE BUILT IN COMPLIANCE WITH Intertek

Intert STANDARD 710

Listed under ETL File number 3054804-001/002 BUILDING CODES

REDUCTION SYSTEMS AVAILABLE AS FOLLOWS: MATERIAL CLEARANCE REDUCTION SYSTEM NON-COMBUSTIBLE NONE REQUIRED 3" UNINSULATED STANDOFF

CAPTIVE-AIRE HOODS HAVE OPTIONAL CLEARANCE

COMBUSTIBLE 1" INSULATED STANDOFF CLEARANCE TO COMBUSTIBLES

INSTALLATION

ALL ELECTRICAL "FIELD" CONNECTIONS AND RELATED INTERCONNECTIONS BY ELECTRICAL CONTRACTORS. ALL PLUMBING "FIELD" CONNECTIONS AND RELATED INTERCONNECTIONS BY PLUMBING CONTRACTORS.

- HANGING BRACKETS LOCATED AND WELDED AS SHOWN ON PLANS. ALL OTHER HANGER MATERIALS PROVIDED BY INSTALLING CONTRACTORS.
- ALL CONNECTIONS FROM CAPTIVE—AIRE DUCT PER MECHANICAL CONTRACTORS'S PLANS. 5. COOKING EQUIPMENT TO SHUTOFF IN EVENT OF FIRE. 6. EXHAUST FANS TO TURN ON IN EVENT OF FIRE.
- ALL LIGHTS FIXTURE SHOWN INSTALLED BY CAPTIVE—AIRE ARE FACTORY PREWIRED. INTERCONNECTIONS BETWEEN HOODS AND TO SWITCHES BY ELECTRICAL CONTRACTORS. B. LAMPS FOR LIGHT FIXTURES BY INSTALLING CONTRACTORS.
- SEISMIC RESTAINTS ARE RESPONSIBILITY OF INSTALLING CONTRACTOR. 10. INSTALLING CONTRACTOR.

 10. INSTALLING CONTRACTORS ASSUME ALL RELATED REPONSIBILITY FOR VERIFICATION OF DIMENSIONAL DATA CONTAINED ON THESE DOCUMENTS FOR ACCURACY, INTEGRATION, AND ADMINISTRATION OF CODE REQUIREMENTS IN EFFECT PRIOR TO ANY RELEASE FOR PRODUCTION OF EQUIPMENT SHOWN.

11. KITCHEN HOODS MUST BE BALANCED WITH KITCHEN. 12. KITCHEN SHALL BE NEGATIVE WITH RESPECT TO DINING AREA.

13. RESTAURANT SHALL BE POSITIVE WITH RESPECT TO AMBIENT PRESSURE.

<u>ADDITIONAL</u> 14. WRITTEN HOOD DIMENSIONS HAVE PRECEDENCE OVER SCALE.

70									
GEN	ERAL	NO	TES	3					
	FII	LTER C	DLLEC	CTION E	FFIC	IENC	Υ		
		5, 0	Captra	te Grease	-Stop	Solo	Filt	er	
	100		ПП		П	П	П	Ţ	
	90		Ш		Н	$\dashv \vdash$	1	\mathbf{f}	
8	80		+++		Н		/	††	
.NCY	70		+++		Н	1	#	††	
FICE	60		+++		Н	\mathcal{I}	#	††	
7	50	$\dashv \uparrow$	Ш		П		#	Ħ	
4TID	40	$\dashv \vdash$	Ш			/	#	Ħ	
FILTRATION EFFICIENCY	30	\top	Ш			\top	#	††	
L	20		Ш		1	\top	77	Ħ	
	10					\sqcap	77	П	
	0.1	DAE	OTICI	E DIAME	TED	· · · · ·		1	10
		FAR	KIICL	C DIAME	ILK,	(um.	,		
fin			TIT						
			ll [®]					Λ	
			Ш	AW					
H		444444	111	UH	<i>\</i>			M/	(

CaptiveAire Captrate Solo Filter Made From 430 Stainless Steel

*** NOTE *** ALL WALLS AND STRUCTURES THAT COME WITHIN 18" OF HOOD MUST BE METAL STUDS AND SHEETROCK, WOOD STUDS OR ANY OTHER COMBUSTIBLE

*** NOTE ***

HOOD MANUFACTURER ! RECOMMENDS NO RETURNS DR 4-WAY DIFFUSERS

*** NOTE *** MAKE-UP AIR SHALL BE DELIVERED INTO SPACE IN MANNER THAT WILL NOT!

WITHIN 10 FEET OF HOOD ETL Listed Grease Extracting Filters MATERIAL WITHIN 18" OF HOOD IN ALL DIRECTIONS. NOT ALLOWED FILTER DETAIL

DISRUPT HOODS ABILITY TO CAPTURE AND CONTAIN.

Road, 46819

'ayne,

9100 Fort

DATE: 10/29/2024

DWG.#: 7134093

DRAWN BY: brett.payn

SCALE: 3/4" = 1'-0"


MASTER DRAWING


SHEET NO.

Wayn

NO. DATE DESCRIPTION 1 11/4/2024 ADDENDUM 3


KITCHEN HOOD SYSTEM

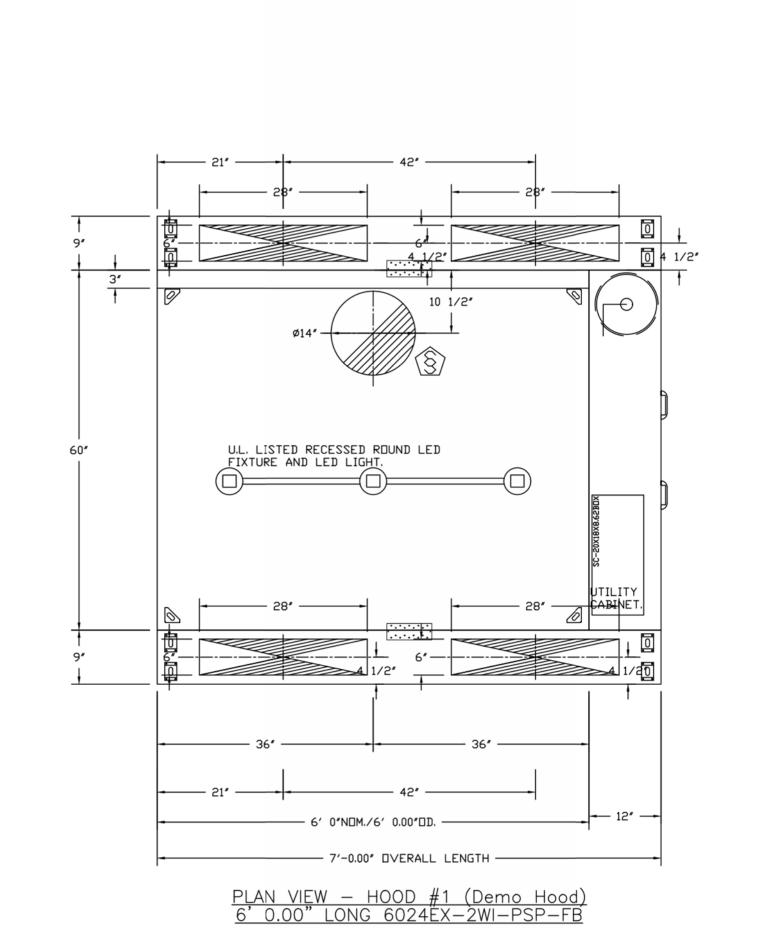

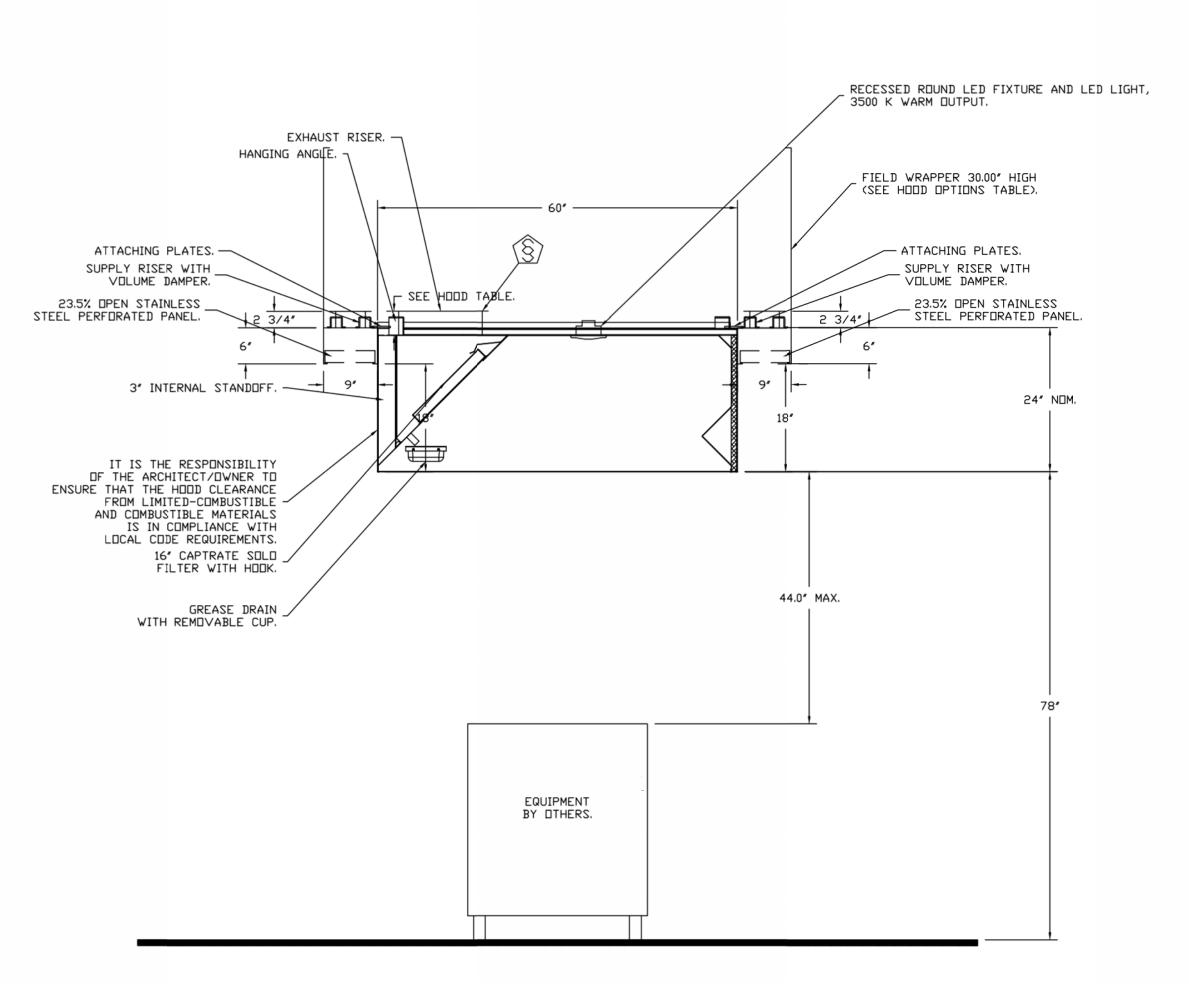

<u>SECTION VIEW - MODEL 6024EX-2WI-PSP-FB</u> <u>HOOD - #1 (Demo Hood)</u>

8

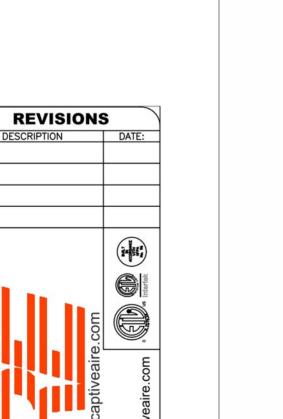



Road, 46819 Wayne ation Q

> NO. DATE DESCRIPTION 100 1 11/4/2024 ADDENDUM 3 Dem **Ф** Г

DATE: 10/29/2024 DWG.#: 7134093

DRAWN BY: brett.payn

SCALE: 1/2" = 1'-0"**MASTER DRAWING**

SHEET NO.

KITCHEN HOOD SYSTEM

this document are the sole property of Design Collaborative,


BID SET

ISSUE DATE: 9/13/2024

REVISIONS

Inc., and shall not be used for any purpose without their expressed written consent. The owner shall be permitted to

retain copies for information and reference.

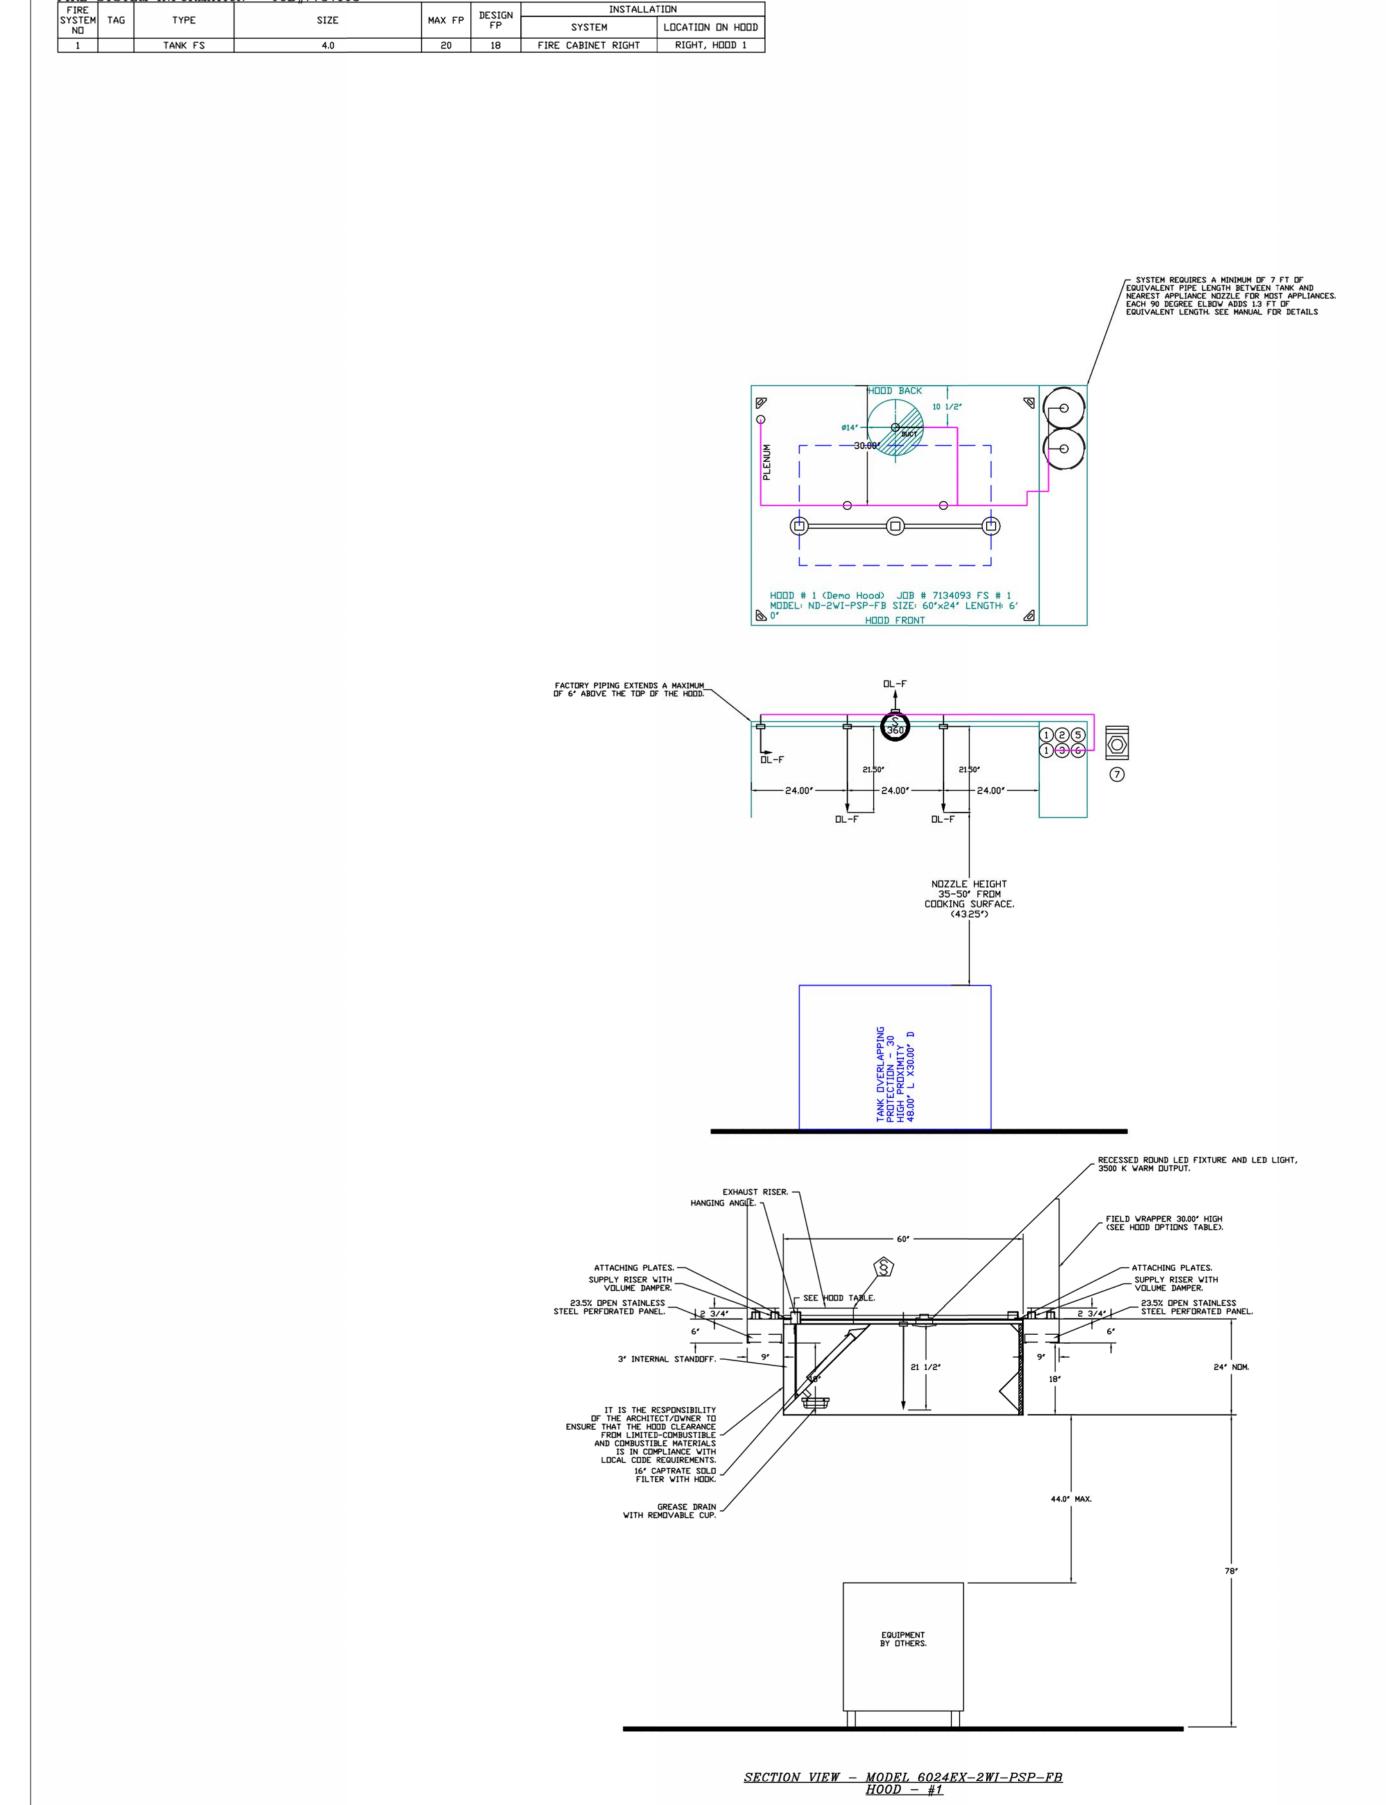

NOTES
- FIELD PIPE DROPS AS SHOWN
PIPING, ELBOWS, TEES, AND NOZZLES SUPPLIED BY CAS.
- FIELD INSTALLED DROP: FACTORY WILL PROVIDE QTY 2 60IN LONG PIECES OF CHROME
PLATED PIPING SHIPPED LOOSE TO BE FIELD-INSTALLED.
- SHIP LOOSE DROP: FACTORY WILL PROVIDE THE EXACT CHROME PIPE LENGTH NEEDED
SHIPPED LOOSE TO BE FIELD-INSTALLED.
- RELOCATE NOZZLES IF FLOW PATTERN IS BLOCKED BY SHELVING,
SALAMANDERS, ETC.
- OVERLAPPING COVERAGE SHALL NOT BE USED ON ANY APPLIANCE WITH AN OBSTRUCTION.
- IF APPLICABLE, EXTENDED PRE-PIPED DROPS ARE SHIPPED LOOSE.
- FACTORY PIPING EXTENDS A MAXIMUM OF 6" ABOVE THE TOP OF THE HOOD.

- APPLIANCE DIMENSIONS LISTED REPRESENT THE COOKING SURFACE SIZE, NOT THE OVERALL APPLIANCE SIZE. - THIS FIRE SYSTEM COMPLIES WITH U.L. 300 REQUIREMENTS.

- DL-F NDZZLE PART NUMBER REPLACES 3070-3/8H-10-SS

JOB #: 7134093. JOB NAME: DEMONSTRATION KITCHEN - WAYNE HIGH SCHOOL.

SYSTEM SIZE: TANK-SP-2 DESIGN FP: 18. MAXIMUM FP: 40. HDDD # 1 6' 0.00" LDNG × 60" WIDE × 24" HIGH. RISER # 1 SIZE: 14" DIA. HDDD # 1 METAL BLDW-DFF CAPS INCLUDED.

- HEAVY-DUTY APPLIANCES (RATED 600°F) WILL REQUIRE AN ADDITIONAL DOWNSTREAM FIRESTAT IN THE EVENT THAT THE DUCTWORK CONTAINS ANY HORIZONTAL RUNS OVER 25 FT IN LENGTH.

- MEDIUM TO LIGHT-DUTY APPLIANCES (RATED 450°F) WILL NOT REQUIRE

AGENT DISTRIBUTION PIPING LIMITATIONS								
PIPE SECTION	MAX PIPE LENGTH (FT)							
MAX SUPPLY LINE TO FIRST OVERLAPPING NOZZLE	42							
OVERLAPPING NOZZLE APPLIANCE BRANCH	10							
DEDICATED NOZZLE APPLIANCE BRANCH	10							

<u>LEGEND - FIRE CABINET TANK SYSTEM</u> 4 GALLON TANK.

ANY ADDITIONAL DOWNSTREAM DETECTION.

PRIMARY ACTUATOR RELEASE.
SECONDARY ACTUATOR RELEASE. PRESSURE SUPERVISION SWITCH. PRIMARY HOSE ASSEMBLY.

SECONDARY HOSE ASSEMBLY. REMOTE MANUAL ACTUATION DEVICE.

All concepts, ideas, designs, plans and details as shown on this document are the sole property of Design Collaborative, Inc., and shall not be used for any purpose without their expressed written consent. The owner shall be permitted to retain copies for information and reference.

BID SET ISSUE DATE: 9/13/2024

REVISIONS NO. DATE DESCRIPTION

1 11/4/2024 ADDENDUM 3

7134093 DRAWN BY: brett.payn **SCALE:** 3/4" = 1'-0" **MASTER DRAWING**

KITCHEN HOOD SHEET NO.

Road, 46819 Wayne Kitch 100 Dem , О Г **DATE:** 10/29/2024 DWG.#:

REVISIONS

FAN UNIT TAG QTY FAN UNIT MODEL # MAN 1 KEF - DEMO 1 EADU85H ECDN-AIR 1614 1.250 1421 TEAD-ECM 0.750 0.5050 1 208 5.2 MUA FAN INFORMATION - JOB#7134093 MIN CFM FAN UNIT MODEL # BLOWER HOUSING EA1-D.250-15D GAS FIRED MAKE-UP AIR UNIT(S)

FAN UNIT TAG INPUT DUTPUT TEMP RISE BURNER
FICIENCY(%)
92


	UNIT ND	TAG	INPU' BTUs		TEMP RISE	REQUIRED INPUT GAS PRESSURE	GAS TYPE	EFFIC
	2	MAU - DEMO	10616	97668	71°F	7 IN. W.C. – 14 IN. W.C.	NATURAL	
	FAN	<i>OPTIONS</i>						_
	FAN UNIT ND	TAG	QTY			DESCRIPTION		
			1	GREASE BO	Χ			
	1	KEF - DEMO	1	FAN BASE	CERAMIC SEAL	L - DU/DR85HFA - INSTALLED AT PLANT - FOR GREASE	DUCTS	
	1	NEF - DEMIL	1	ECM WIRING	PACKAGE -	PWM SIGNAL FROM ECPMO3 PREWIRE (TELCO MOTOR), CCV	√ ROTATION	
- 1				0 1/5 10 51	DTO 14455441			


		1	GREASE BOX
	NEE DEMO	1	FAN BASE CERAMIC SEAL - DU/DR85HFA - INSTALLED AT PLANT - FOR GREASE DUCTS
1	KEF - DEMO	1	ECM WIRING PACKAGE - PWM SIGNAL FROM ECPMO3 PREWIRE (TELCO MOTOR), CCW ROTATION
		1	2 YEAR PARTS WARRANTY
		1	SIZE 1 TEMPERED COMMERCIAL DOWN DISCHARGE FOR DIRECT DRIVE AHUS
		1	INLET PRESSURE GAUGE, 0-35"
		1	MANIFOLD PRESSURE GAUGE, -5 TO 15" WC
	MAU - DEMO	1	SHIP LOOSE GAS STRAINER 3/4"
2		1	MOTORIZED BACKDRAFT DAMPER FOR A1-D HOUSING - MEETS AMCA CLASS 1A RATING
		1	ECM WIRING PACKAGE - DD SUPPLY - PWM SIGNAL FROM ECPMO3 PREWIRE (TELCO MOTOR)
		1	2 YEAR PARTS WARRANTY
		1	EXTERIOR GAS CONNECTION PROVIDED BY FACTORY WITH QUICK SEAL AND ANTI-ROTATION BRACKET


FAN ACCESSORIES									
FAN			EXHAUST						
UNIT ND	TAG	GREASE CUP	GRAVITY DAMPER		SIDE DISCHARGE		MOTORIZED DAMPER	WALL MOUNT	
1	KEF - DEMO	YES							
2	MAU - DEMO						YES		

	2	MAL	ן אבער – ו			JE2	
(CUR	B AS	SSEMBLIES				
	NO	□N FAN	TAG	WEIGHT	ITEM		SIZE
	1	# 1	KEF - DEMO	41 LBS	CURB	23.000″W	X 23.000"L X 24.000"H VENTED HINGED.
	2	# 2	MAU - DEMO	63 LBS	CURB	21.000"W	X 71.000"L X 18.000"H INSULATED.

HMI SCHEDULE										
UNIT NUMBER	HMI #	HMI LOCATION	TEMP	A∨ERAGING	MODBUS ADDRESS					
FAN #2	HMI #1 - UNIT	IN UNIT	NDT	AVERAGED	55					

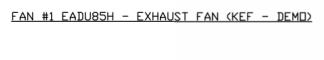

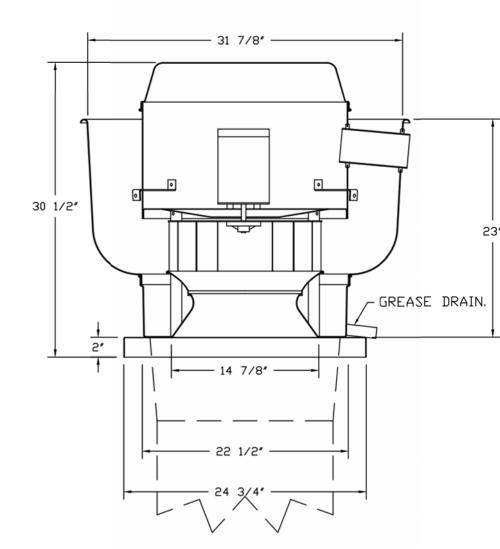

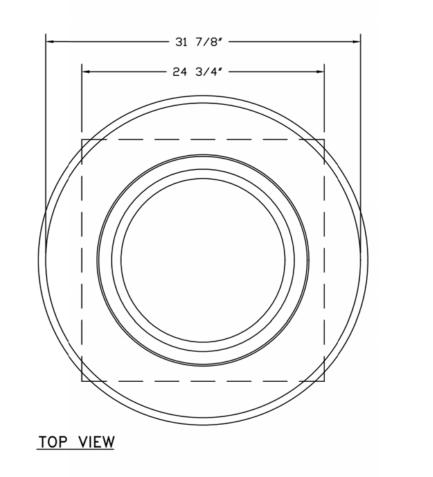

FEATURES:

- DIRECT DRIVE CONSTRUCTION (NO BELTS/PULLEYS). - ROOF MOUNTED FANS. - RESTAURANT MODEL.
- UL705 AND UL762 AND ULC-S645 - VARIABLE SPEED CONTROL.
- INTERNAL WIRING.
- THERMAL OVERLOAD PROTECTION (SINGLE PHASE). - HIGH HEAT OPERATION 300°F (149°C).
- GREASE CLASSIFICATION TESTING. - NEMA 3R SAFETY DISCONNECT SWITCH.
- NORMAL TEMPERATURE TEST
 EXHAUST FAN MUST OPERATE CONTINUOUSLY WHILE EXHAUSTING AIR AT 300°F (149°C) UNTIL ALL FAN PARTS HAVE REACHED THERMAL EQUILIBRIUM, AND WITHOUT ANY
- DETERIORATING EFFECTS TO THE FAN WHICH WOULD CAUSE UNSAFE OPERATION. ABNORMAL FLARE-UP TEST EXHAUST FAN MUST OPERATE CONTINUOUSLY WHILE EXHAUSTING BURNING GREASE VAPORS AT 600°F (316°C) FOR A PERIOD OF

15 MINUTES WITHOUT THE FAN BECOMING DAMAGED TO ANY EXTENT THAT COULD CAUSE


<u>OPTIONS</u>

AN UNSAFE CONDITION.

- GREASE BOX. FAN BASE CERAMIC SEAL DU/DR85HFA INSTALLED AT PLANT FOR GREASE DUCTS.

 - ECM WIRING PACKAGE - PWM SIGNAL FROM ECPMO3 PREWIRE (TELCO MOTOR), CCW ROTATION.

 - 2 YEAR PARTS WARRANTY.

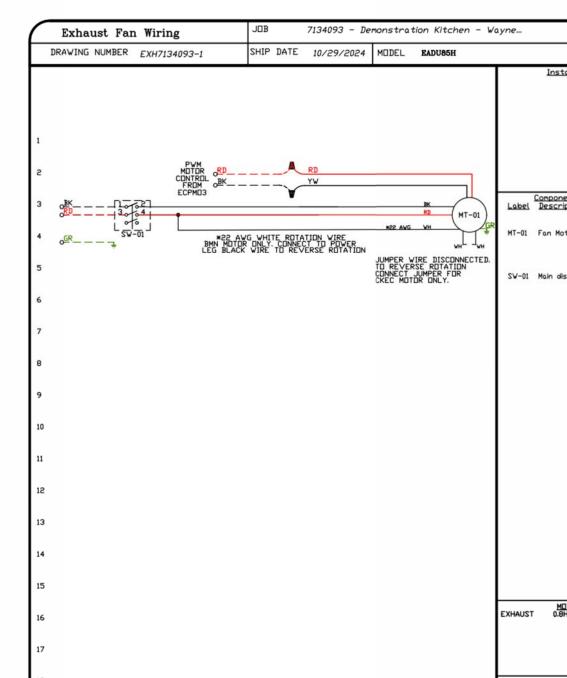

MT-01 Fan Motor ELECTRICAL INFORMATION MOTOR/CTRL MCA: 6.5A MOTOR/CTRL MOP: 15A — DENDTES FIELD WIRING
— DENDTES INTERNAL WIRING

SV-01 Main disconnect switch [3] EXHAUST MOTOR INFO EXHAUST 0.8HP-208V-1P-5.2FLA


20 GAUGE

ROOF OPENING


/22 1/2" DIMENSIONS.

STEEL CONSTRUCTION.

SYSTEM

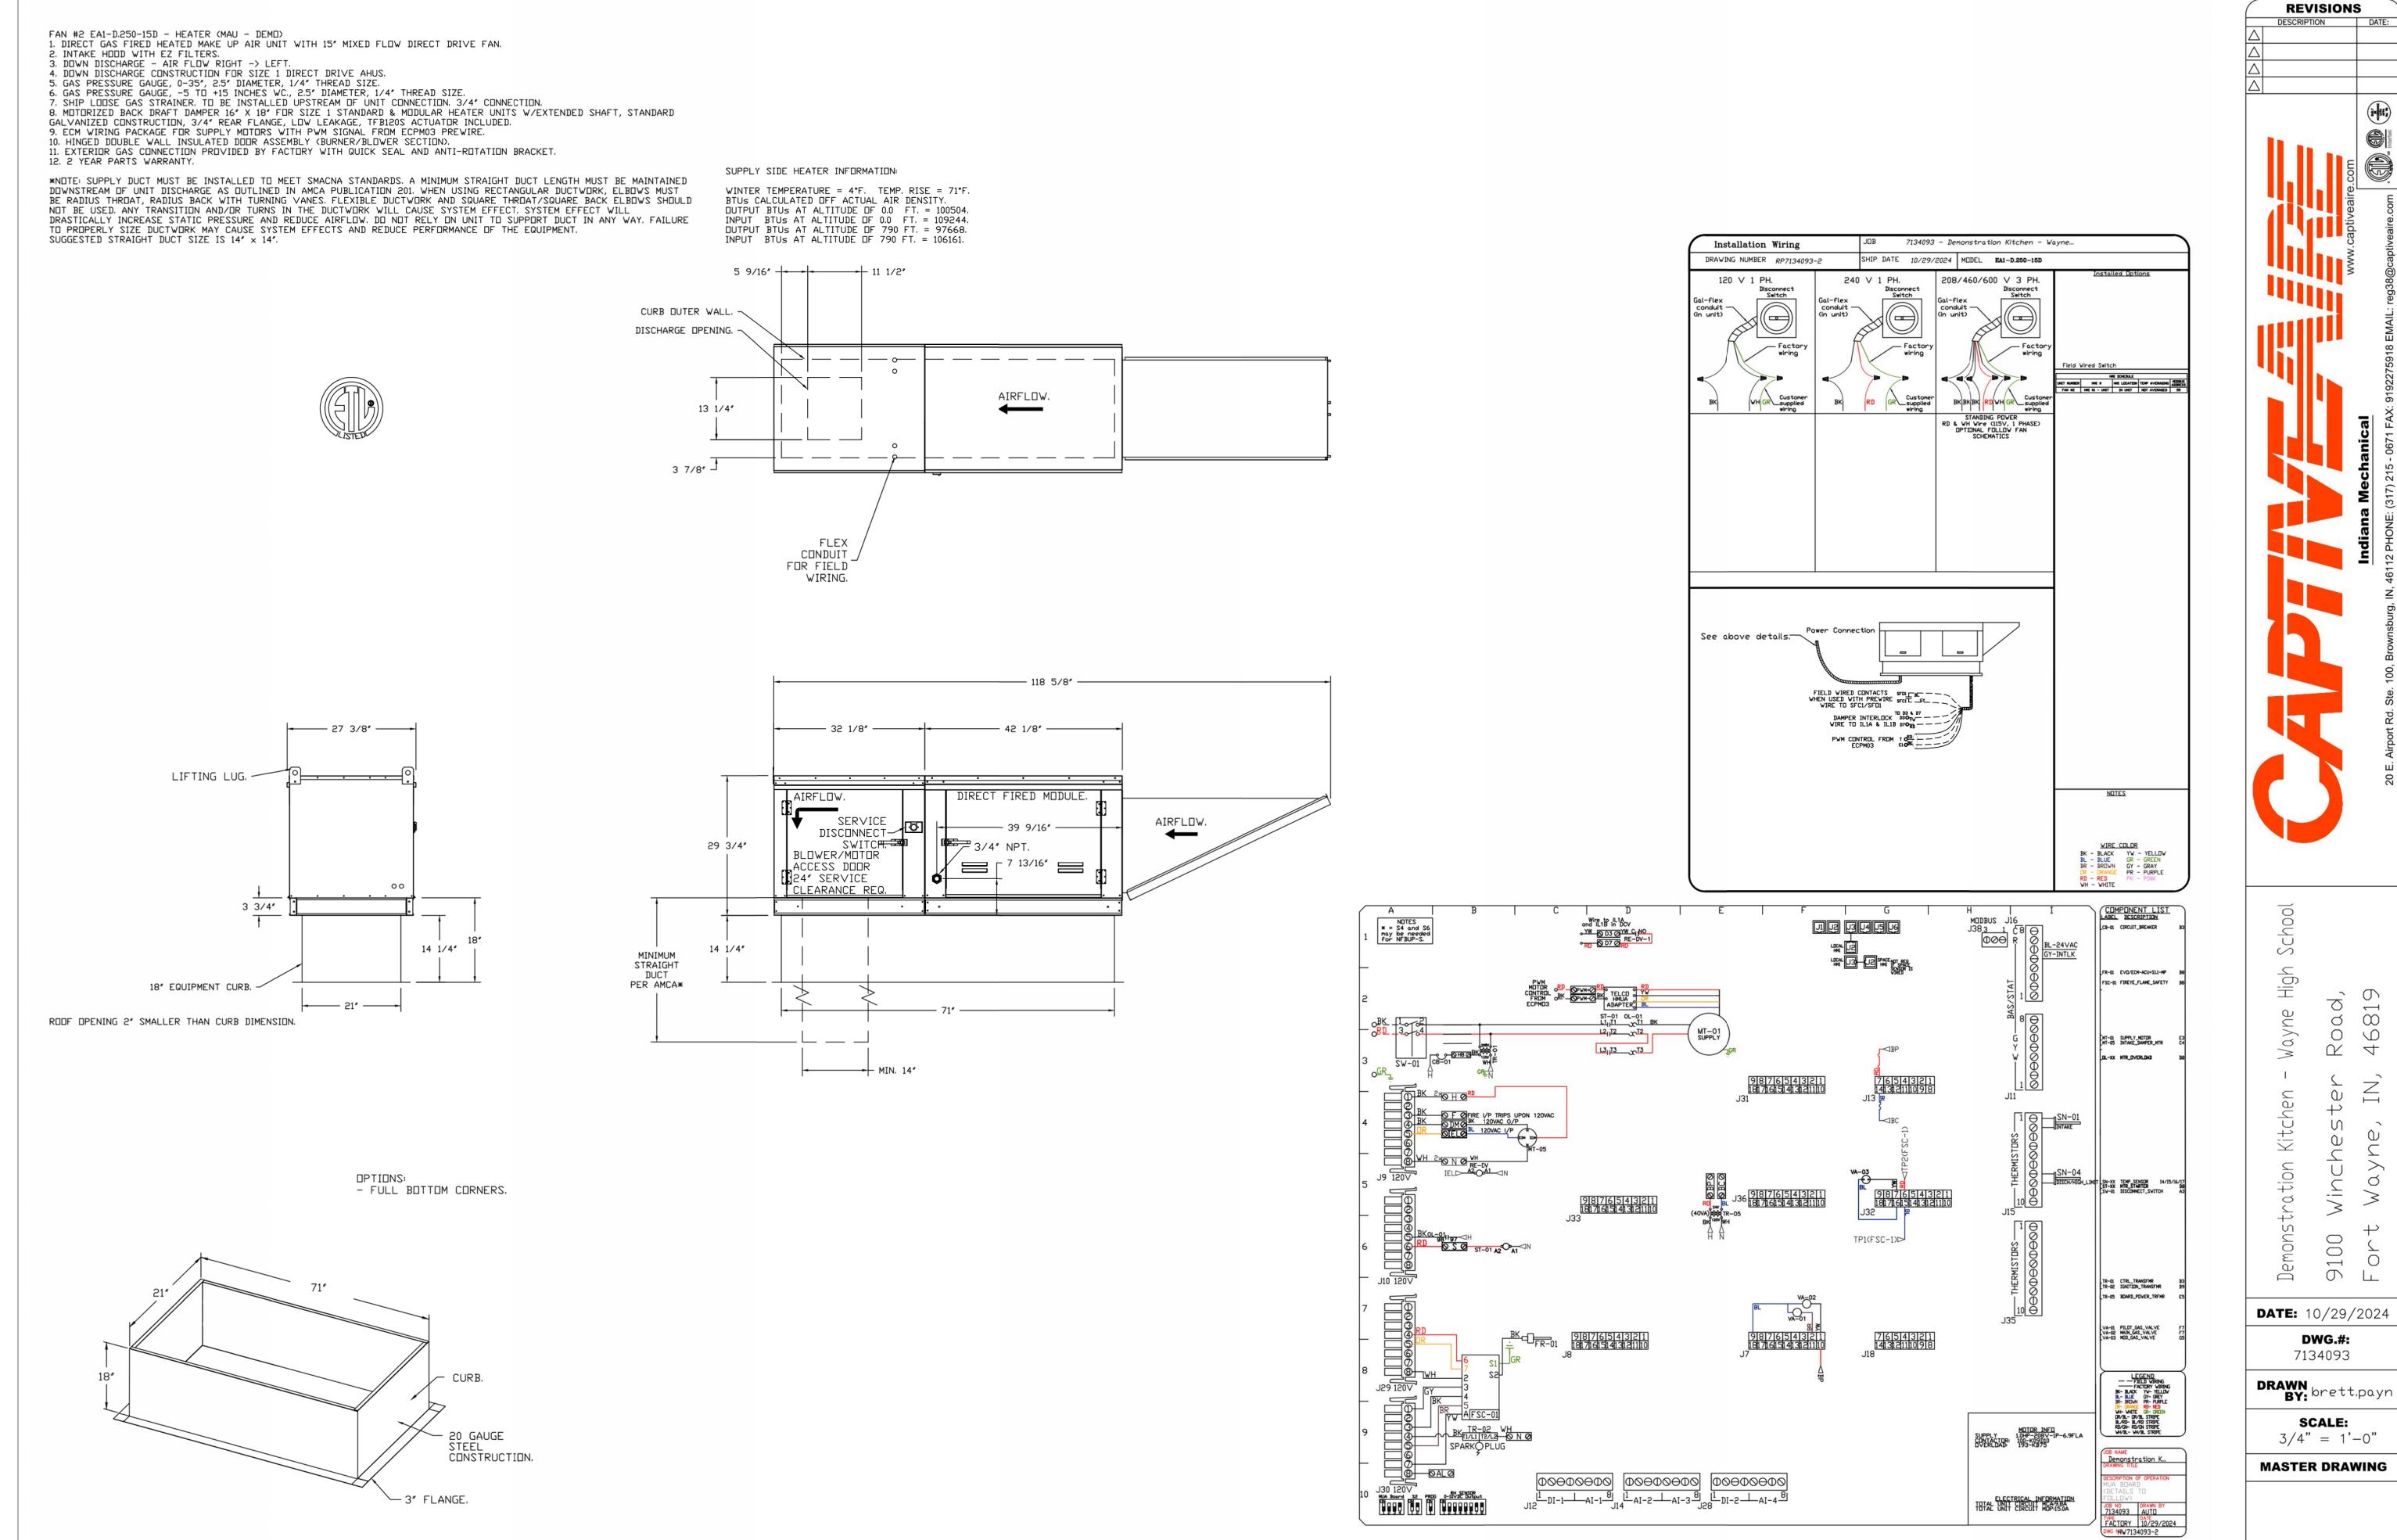



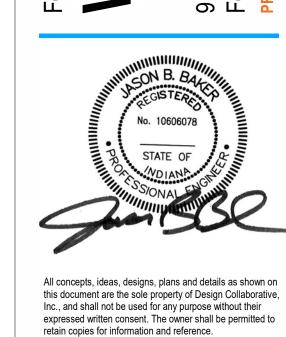

BID SET

ISSUE DATE: 9/13/2024 REVISIONS

11/4/2024 ADDENDUM 3

KITCHEN HOOD SYSTEM

SHEET NO.

REVISIONS DESCRIPTION DATE:



Road, 46819 this document are the sole property of Design Collaborative, Inc., and shall not be used for any purpose without their expressed written consent. The owner shall be permitted to

Q

9100 Fort

DATE: 10/29/2024

7134093

DRAWN BY: brett.payn

SCALE: 3/4" = 1'-0"

MASTER DRAWING

SHEET NO.

DWG.#:

De


retain copies for information and reference. BID SET


S


ISSUE DATE: 9/13/2024 REVISIONS


NO. DATE DESCRIPTION ADDENDUM 3 1 11/4/2024


KITCHEN HOOD SYSTEM

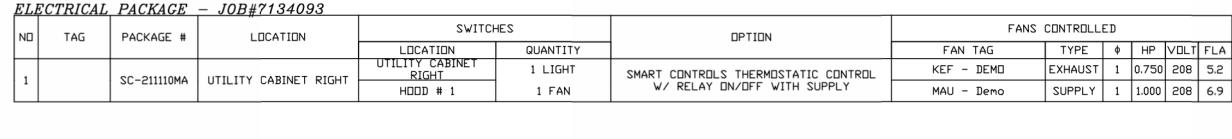

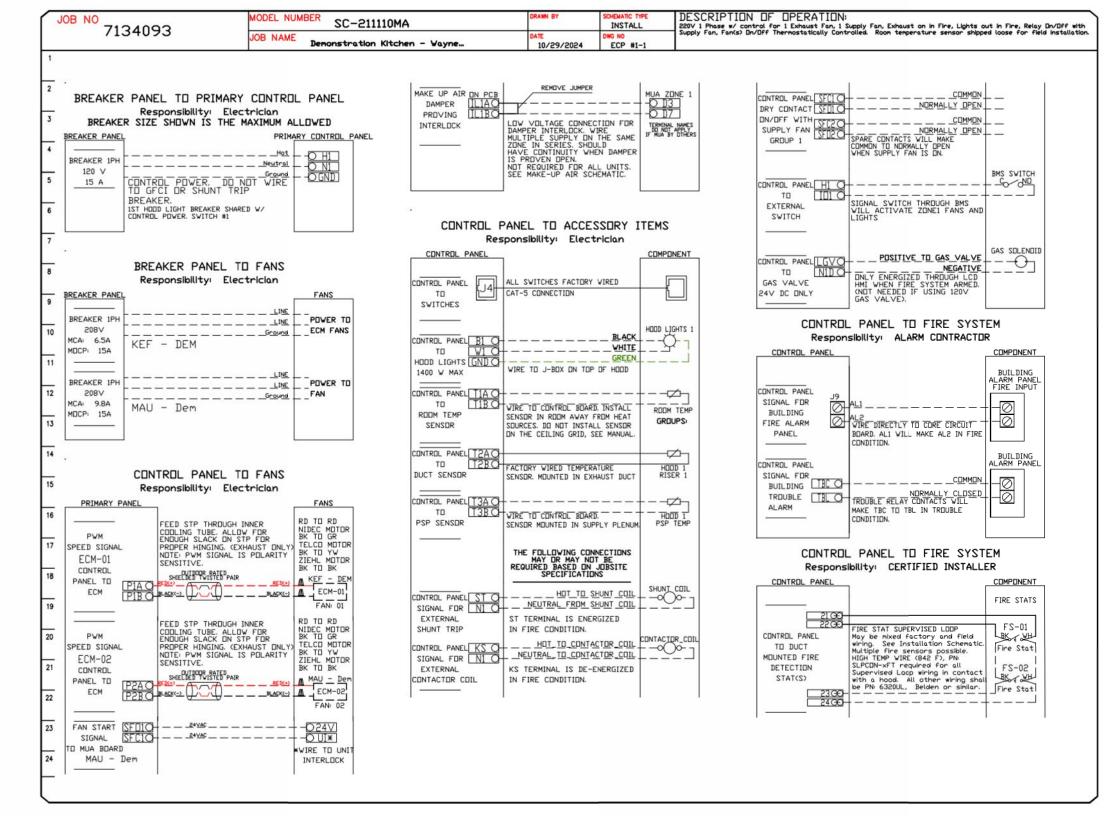

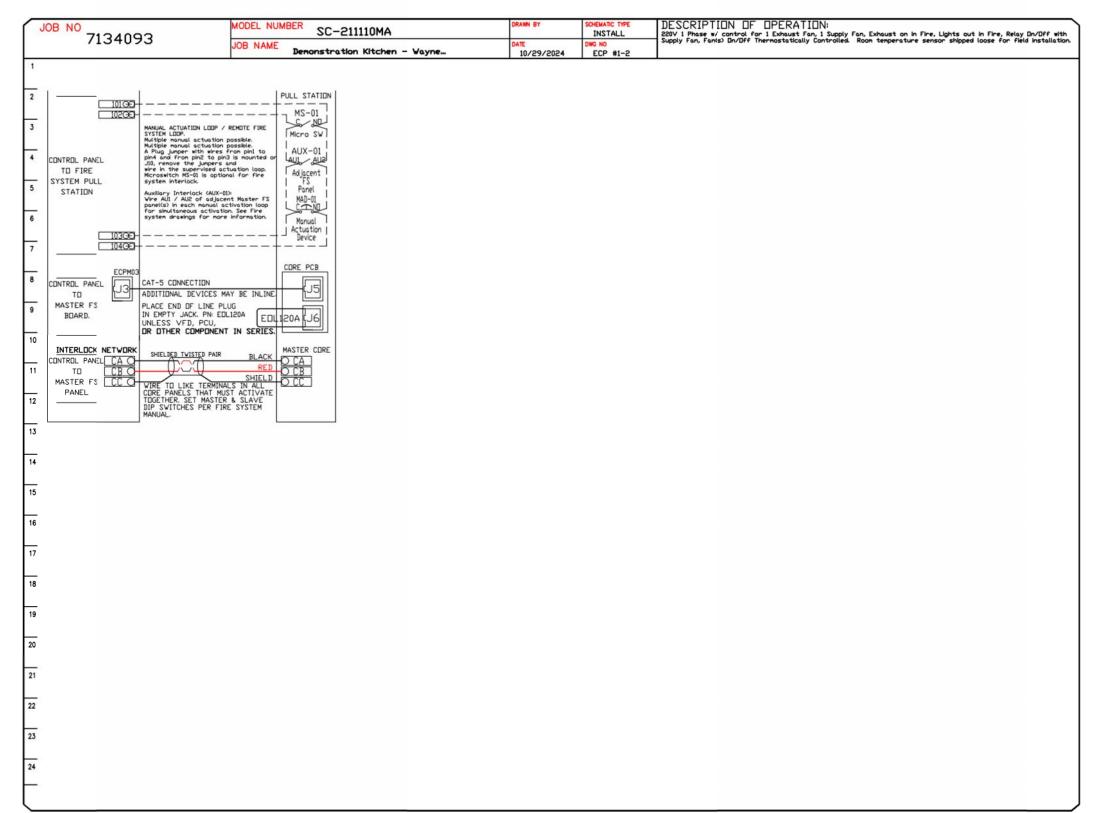

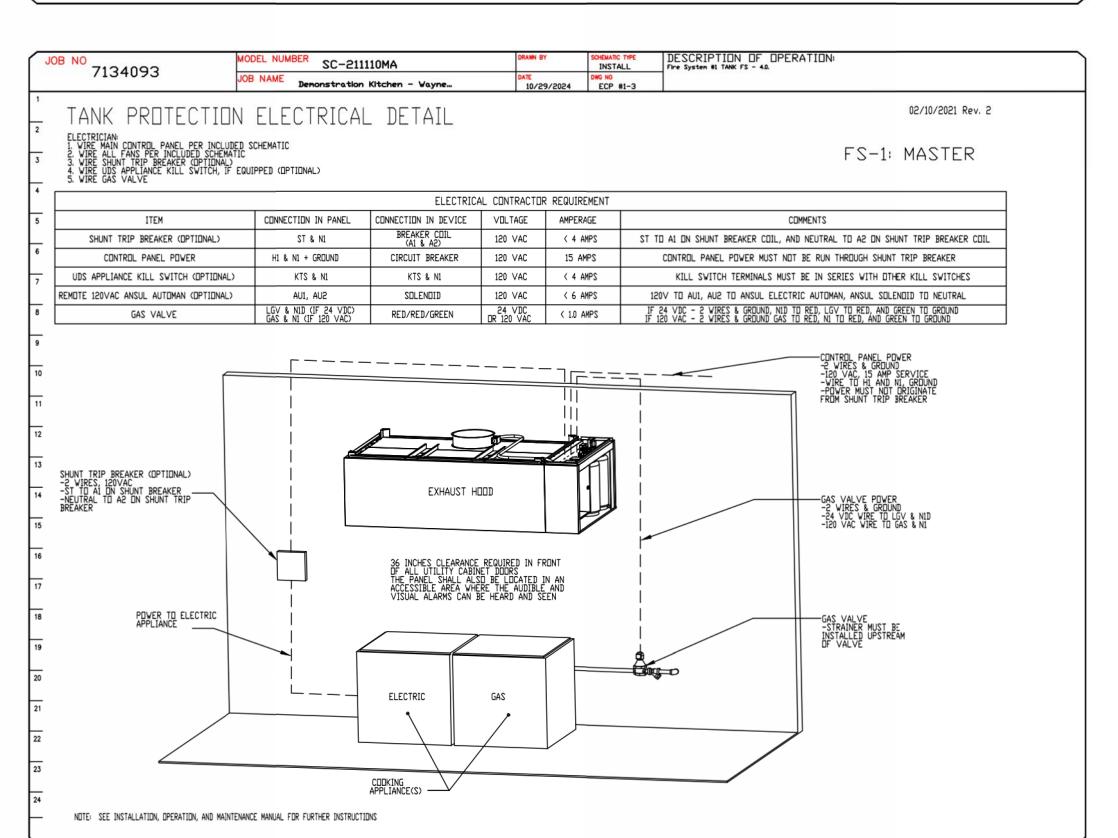

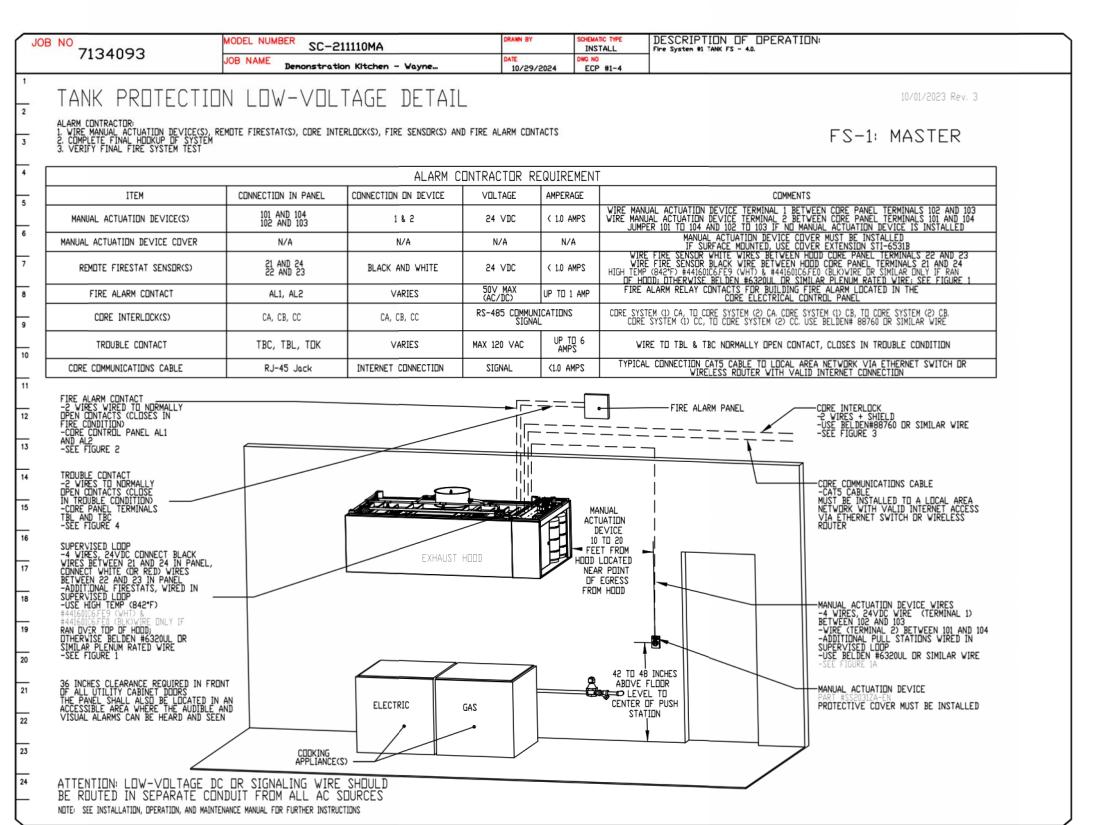



REVISIONS



Road, 46819 Wayn this document are the sole property of Design Collaborative, Inc., and shall not be used for any purpose without their expressed written consent. The owner shall be permitted to retain copies for information and reference. Q

ISSUE DATE: 9/13/2024 REVISIONS

NO. DATE DESCRIPTION ADDENDUM 3

BID SET

9100 Fort 1 11/4/2024 \circ **DATE:** 10/29/2024


DWG.#: 7134093 DRAWN BY: brett.payn **SCALE:** 3/4" = 1'-0"


De


MASTER DRAWING


SHEET NO.

KITCHEN HOOD SYSTEM

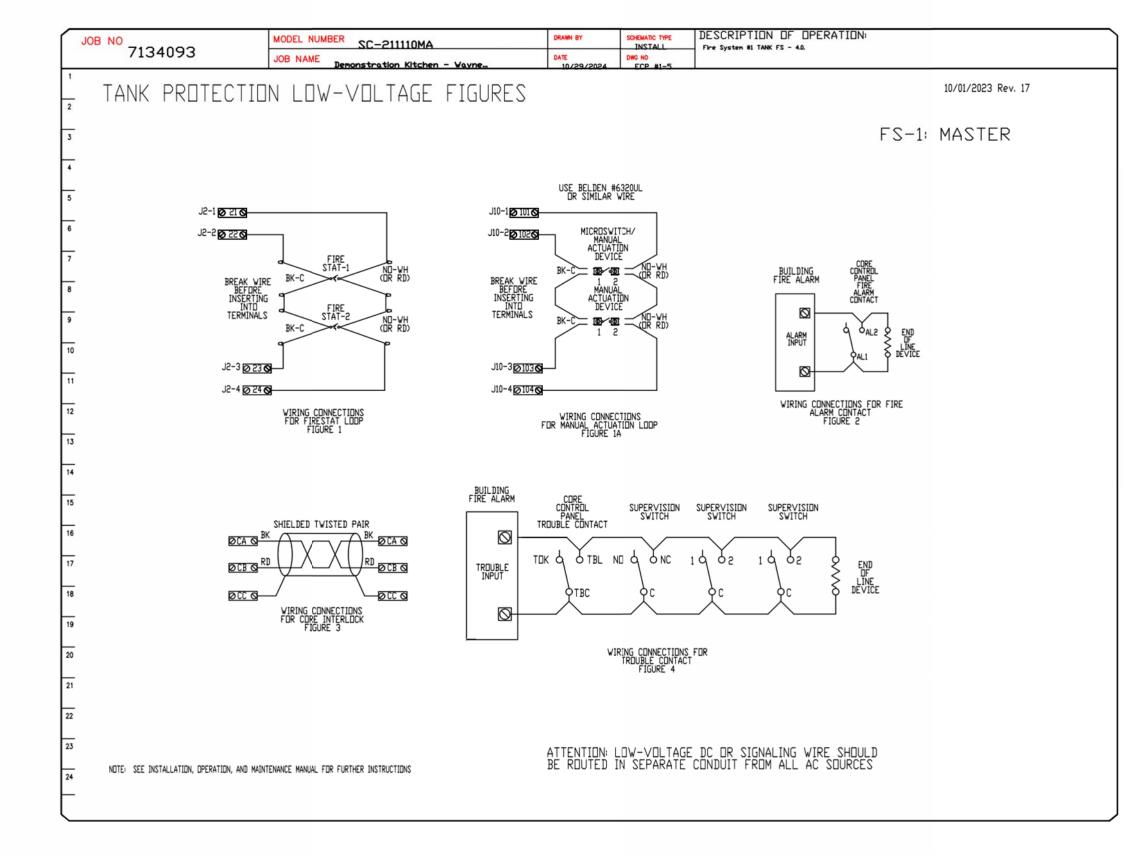

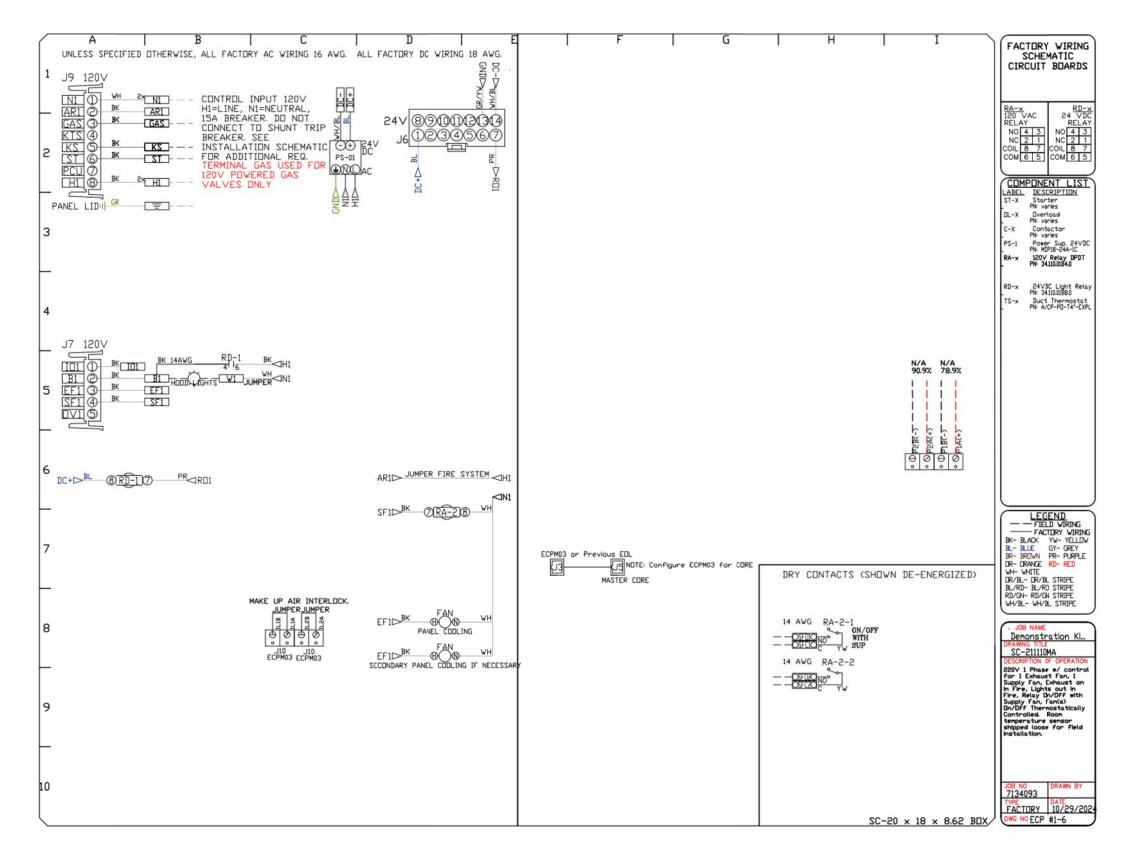

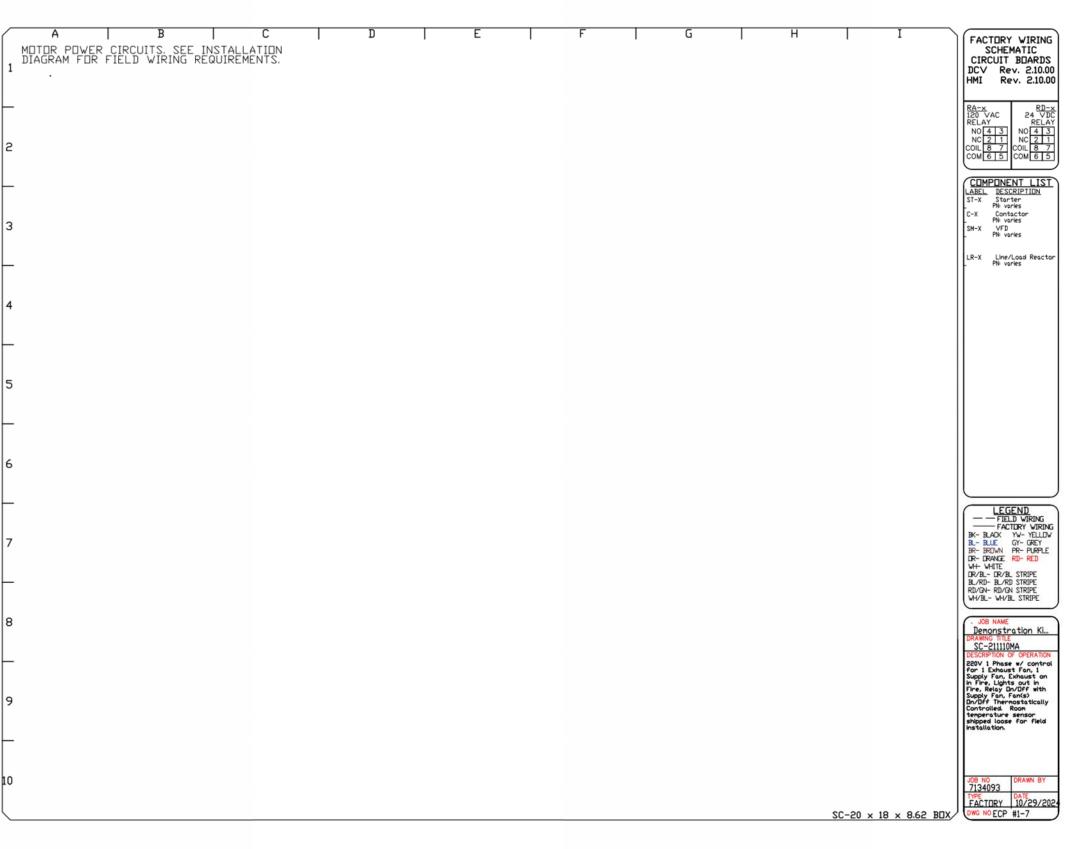

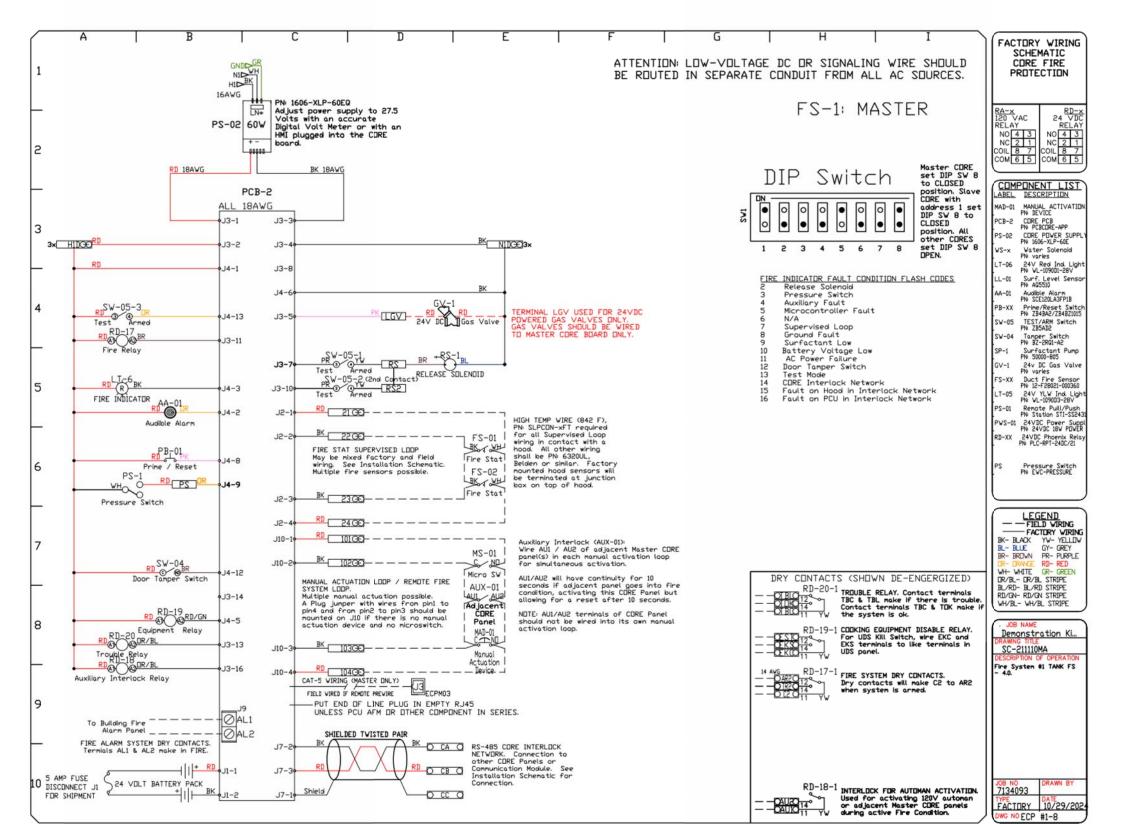

	A 200 East Main S	Suite 600	Fort Wayne, IN	260.422.4241	260.422.4847	designcollaborat
J	Ā			d .		M

DUCTWORK #1 PARTS - JOB#7134093 DOUBLE WALL

TAG	PART #	CFM	GPM	ZONE	COVEREDBY	SP	WEIGHT	VELOCITY	QTY	DESCRIPTION
H1-E1	DW18DWRISER-2R-S	1614				-0.916	8.15	0.00	1	DOUBLE WALL RISER COVER - USED ON 14" INNER RISER, 4" LONG - 2 LAYERS REDUCED CLEARANCE - 18" STAINLESS STEEL OUTER RISER SHELL ASSEMBLY. INCLUDES INSULATION & SINGLE V CLAMPS FOR INNER & OUTER CONNECTIONS.
P1	DW1445DWASY-2R-S	1614				-0.0368	19.87	1509.80	1	DOUBLE WALL DUCT - 14" INNER 45 DUCT - 2 LAYERS REDUCED CLEARANCE - 18" STAINLESS STEEL OUTER SHELL.
P2	DW1445DWASY-2R-S	1614				-0.0525	19.87	1509.80		DOUBLE WALL DUCT - 14" INNER 45 DUCT - 2 LAYERS REDUCED CLEARANCE - 18" STAINLESS STEEL OUTER SHELL.
P3	DW1423DWLT-2R-S	1614				-0.008	30.75	1509.80	1	DOUBLE WALL DUCT - 14" INNER DUCT, 23" LONG - 2 LAYERS REDUCED CLEARANCE - 18" STAINLESS STEEL OUTER SHELL.
Р4	DW1447DWAJD-2R-S	1614				-0.01	93.18	1509.80	1	DOUBLE WALL ADJUSTABLE DUCT - 14" INNER DUCT - 2 LAYERS REDUCED CLEARANCE - 18" STAINLESS STEEL OUTER SHELL. MIN LENGTH = 11" / MAX LENGTH = 48.5" / ADJUSTMENT = 30.5" / ADJUSTABLE SECTION MAY NEED TO BE CUT. INCLUDES SINGLE AND DOUBLE WALL "V" CLAMPS.
P5 ASSEMBLED W/P6	DW144550DWLTTP-2R-S	1614				-0.015	61.01	1509.80		DOUBLE WALL DUCT - 14" INNER DUCT, 45.5" LONG - 2 LAYERS REDUCED CLEARANCE - 18" STAINLESS STEEL OUTER SHELL - USED WITH TRANSITION PLATE.
P6 ASSEMBLED W/P5 D=B	DW2314TPDBEX	1614					8.00	1509.80	1	DUCT TO CURB TRANSITION 3/4" DOWN TURN, 23" CURB TO 14" DUCT, 16 GA ALUMINIZED. USED ON NCA14FA & NCA14HPFA. TRANSITION PLATE OD IS 23.5" DESIGNED FOR USE WITH EXHAUST FAN.
SYSTEM AT P6						-1.0383	0.00			
RC1	DW18DWRISER-2R-S						8.15		1	DOUBLE WALL RISER COVER - USED ON 14" INNER RISER, 4" LONG - 2 LAYERS REDUCED CLEARANCE - 18" STAINLESS STEEL OUTER RISER SHELL ASSEMBLY. INCLUDES INSULATION & SINGLE V CLAMPS FOR INNER & OUTER CONNECTIONS.
	3M-2000PLUS						0.80		2	DUCT - 3M FIRE BARRIER 2000 PLUS SILICONE - USED AS SEALANT TO SEAL DUCT JOINTS.
	DW14DWCLASY-2R-S						7.21		2	DUCT - 14" DUCT - 18" DOUBLE "V" CLAMP - 2R INSULATION & SINGLE "V" CLAMP INCLUDED - REDUCED CLEARANCE.
TOTAL WEIGHT							265.00			

DUUBLE WALL FACTURY BUILT DUCTWURK

- ALL DUCTWORK IS REQUIRED TO BE INSTALLED WITH THE MAXIMUM SUPPORT SPACING LISTED BELOW.
- FOR A COMPLETE LIST OF APPROVED SUPPORT METHODS, SEE THE ENTIRE INSTALLATION AND OPERATION MANUAL
- DUCTWORK SHALL SLOPE NOT LESS THAN 1/16" PER LINEAR FOOT TOWARDS THE HOOD OR AN APPROVED GREASE COLLECTION RESERVOIR.

DO NOT LEAK TEST USING SMOKE BOMBS CONTAINING CHLORINES/CHLORIDES, CONSULT WITH CAPTIVEAIRE


FOR PROPER LEAK TESTING METHODS.

- WHERE HORIZONTAL DUCTS EXCEED 75 FEET IN LENGTH, THE SLOPE SHALL NOT BE LESS THAN 3/16" PER LINEAR FOOT.


HORI	ZONTAL
DUCT DIAMETER	SUPPORT SPACING (FT)
5″	7′
6"	7′
7"	7′
8"	7′
10"	7′
12"	7′
14"	7′
16"	7′
18"	5′
20"	5′
22"	5′
24"	5′
26"	5′
28"	5′
30"	5′
32"	5′
34"	5′

	VERT	TICAL	
TYPE	WALL SUPPORT (FT)	CURB SUPPORT (FT)	FLOOR SUPPORT (FT)
2R & 2R HT (5"-16")	20′	24′	24′
2R (18")	18′	24′	24′
3R & 3Z (5"-24")	10′	24′	24′
3Z (26″ -36″)	10′	20′	20′

DUCTWORK #1 SIDE VIEW

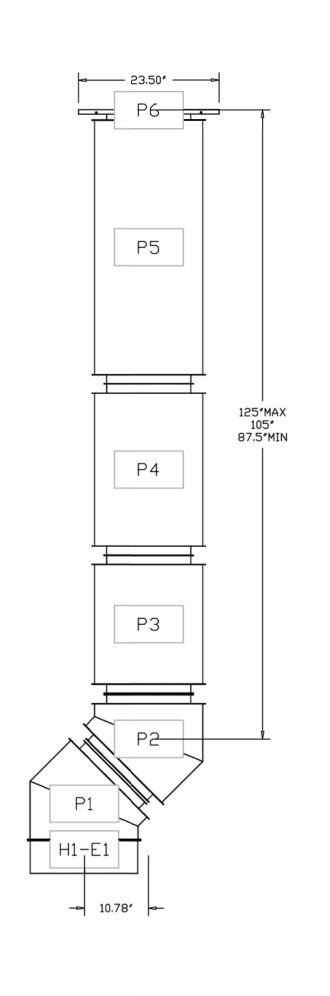

DUCTWORK #1 SE VIEW

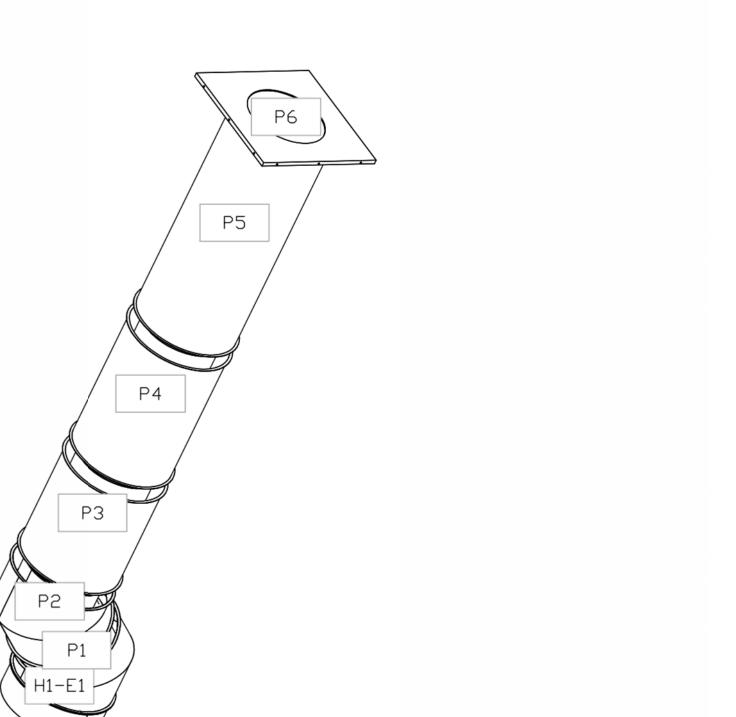

DETAIL

REDUCED CLEARANCE

3/4" REDUCED CLEARANCE

__COMBUSTIBLE SURFACE

UDUBLE V-BAND



REVISIONS





this document are the sole property of Design Collaborative, Inc., and shall not be used for any purpose without their expressed written consent. The owner shall be permitted to retain copies for information and reference.

BID SET

ISSUE DATE: 9/13/2024

REVISIONS

11/4/2024

9100 Fort

DATE: 10/29/2024

DWG:#: 7134093

DRAWN brett.payn

SCALE: 3/4" = 1'-0"

MASTER DRAWING

SHEET NO.

KITCHEN HOOD SYSTEM

CAPTIVE-AIRE FACTORY BUILT GREASE DUCT IS BUILT IN COMPLIANCE WITH:

Listed under ETL File number 3114021, and complies with UL-1978.


Models 2R and 3R are listed in accordance with Condition B of UL Standard 2221 - installation within non-ventilated combustible enclosure.

Model 3Z is listed in accordance with Condition A and Condition B of UL Standard 2221 - Condition A represents all installation conditions except for installation within non-ventilated combustible enclosure. Condition B represents installation within a non-ventilated combustible structure.







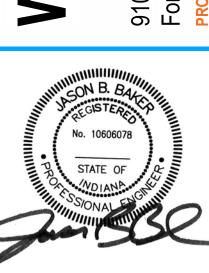

this document are the sole property of Design Collaborative, Inc., and shall not be used for any purpose without their expressed written consent. The owner shall be permitted to retain copies for information and reference.

BID SET

ISSUE DATE: 9/13/2024

REVISIONS

NO. DATE DESCRIPTION
1 11/4/2024 ADDENDUM 3

PLUMBING PLAN -UNDERGROUND -UNIT F

P2.0F

PLUMBING NOTES

GENERAL PLUMBING NOTES

DEAD ENDS SHALL BE AVOIDED IN A DRAINAGE SYSTEM, EXCEPT WHERE

A FLOOR OR MORE THAN TEN (10) FEET HORIZONTALLY FROM THE NÉAREST VENTED CONNECTION MUST HAVE A VENTED CONNECTION TO THE OUTSIDE

PIPING LOCATIONS, INVERTS AND SIZES SHALL BE VERIFIED ON SITE TO

DETERMINE EXACT LOCATION AND SIZE.

WITH CLOSED CELL RUBBER FOAM INSULATION.

TESTS SHALL REMAIN ONSITE.

ALL FLOOR DRAINS SHALL BE INSTALLED WITH A ZURN Z1072 TRAP SEAL DEVICE. ALL LAVATORY FAUCETS FOR PUBLIC USE SHALL BE PROVIDED WITH AN AUTOMATIC SAFETY WATER-MIXING DEVICE AND SHALL COMPLY WITH ANSI/ASSE 1016-1996 OR 1017-1998. THE SAFETY-MIXING DEVICE SHALL BE ADJUSTED TO A MAXIMUM SETTING OF 110 DEGREES FAHRENHEIT, AT THE TIME OF INSTALLATION.

ALL DOUBLE CHECK BACKFLOW PREVENTORS (DCV), DOUBLE CHECK DETECTORS

AND APPROVED BY A CROSS CONNECTION CONTROL DEVICE INSPECTOR (CCCDI) BEFORE INITIAL OPERATION, AND AT LEAST ANNUALLY THEREAFTER. RECÒRDS ÓF

ALL FAN COILS, UNIT VENTILATORS, AND DUCTLESS SPLIT UNITS SHOWN ON THE MECHANICAL PLANS SHALL HAVE CONDENSATE ROUTED TO FLOOR DRAIN OR EXTERIOR WALL. UNITS LOCATED ALONG THE EXTERIOR SHALL HAVE

CONDENSATE DISCHARGED DIRECTLY THROUGH WALL. UNITS LOCATED WITHIN INTERIOR SPACES SHALL HAVE CONDENSATE ROUTED TO NEAREST FLOOR DRAIN. ALL EXISTING DOMESTIC WATER AND STORM DRAIN PIPING SHALL BE REINSULATED

NECESSARY TO EXTEND THE SYSTEM TO INSTALL A CLEANOUT IN AN ACCESSIBLE

- RELOCATE FIRE PROTECTION PIPE TO BE ROUTED ABOVE MAIN LEVEL CEILING.
- PROVIDE DOMESTIC WATER ROUGH-INS AND MAKE FINAL CONNECTIONS TO
- PROVIDE DOMESTIC WATER ROUGH-INS AND EXTEND THROUGH KEC FURNISHED
- PROVIDE DOMESTIC WATER ROUGH-INS DOWN THROUGH UTILITY CHASE AND MAKE FINAL CONNECTIONS TO EQUIPMENT PROVIDED BY KEC. CONNECT INDIRECT DRAIN TO EACH PIECE OF EQUIPMENT AND EXTEND TO THE DRAIN. SEE KITCHEN FOODSERVICE DRAWINGS AND SCHEDULES FOR SIZES AND QUANTITIES. INDIRECT DRAINS SHALL BE ALL COPPER.
- KITCHEN HOOD SYSTEM DRAWINGS. ROUTE VENT PIPING UP AND TERMINATE AT ROOF WITH NEW VENT THROUGH ROOF
- INSTALL HOT WATER BALANCING VALVE ON THE HOT WATER RETURN LINE AT THIS LOCATION AND SET TO THE FLOW INDICATED.
- ROUTE WATER PIPING DOWN INTO WALL AND CONNECT TO EACH INDIVIDUAL FIXTURE PER THE MINIMUM CONNECTION SIZE IN THE PLUMBING FIXTURE
- CONNECT TO DRAIN TEMPERING KIT ON DISHWASHER DRAIN. ROUTE 1-1/2" DRAIN FROM DISHWASHER, 3/4" DRAIN FROM THE PRESSURE RELIEF
- ROUTE DOMESTIC WATER DOWN WITHIN WALL AND STUB OUT FOR HOSE REEL.
- INSTALL THERMOSTATIC MIXING VALVE ON THE WALL AT THIS LOCATION. PIPE PER
- CONNECT NEW PIPING INTO EXISTING AT THIS LOCATION. INSTALL TRENCH DRAINS PROVIDED BY FSEC PER THE DETAILS ON THE FOOD

- RE-INSTALL SALAVAGED WATER COOLER AT THIS LOCATION.
- CONNECT INDIRECT DRAIN TO EACH PIECE OF KITCHEN EQUIPMENT AND EXTEND TO DRAIN. SEE KITCHEN FOODSERVICE DRAWINGS AND SCHEDULES FOR SIZES AND QUANTITIES OF DRAINS. INDIRECT DRAINS SHALL BE ALL COPPER.
- EQUIPMENT PROVIDED BY KEC. CONNECT INDIRECT DRAIN TO EACH PIECE OF EQUIPMENT AND EXTEND TO THE DRAIN. SEE KITCHEN FOODSERVICE DRAWINGS AND SCHEDULES FOR SIZES AND QUANTITIES. INDIRECT DRAINS SHALL BE ALL
- WATER FILTER AND MAKE FINAL CONNECTIONS TO EQUIPMENT PROVIDED BY KEC. CONNECT INDIRECT DRAIN TO EACH PIECE OF EQUIPMENT AND EXTEND TO THE DRAIN. SEE KITCHEN FOODSERVICE DRAWINGS AND SCHEDULES FOR SIZES AND QUANTITIES. INDIRECT DRAINS SHALL BE ALL COPPER.
- ROUTE DOMESTIC COLD WATER PIPING DOWN AND CONNECT TO UDS SYSTEM. SEE
- (VTR). MAINTAIN ALL ROOF WARRANTIES.
- ROUTE 3/4" 140 DEGREE HOT WATER WITHIN WALL AND CONNECT TO RPZ AND
- CONNECT TO BOOSTER HEATER. EXTEND 3/4" 180° LINE FROM BOOSTER HEATER TO ROUTE 3/4" COLD WATER LINE DOWN TO 12" AFF AND ROUTE THROUGH RPZ AND
- VALVE ON BOOSTER HEATER AND 1" DRAIN FROM CONDENSATE HOOD TO FLOOR
- CONNECT THROUGH RPZ ON THE WALL AND MAKE FINAL CONNECTIONS TO EQUIPMENT PROVIDED BY KEC.
- MANUFACTURERS REQUIREMENTS.
- SERVICE DRAWINGS.

LOUNGE



2148 23 2148

9 P28 9 9 9

ENLARGED PLUMBING PLANS - KITCHEN

this document are the sole property of Design Collaborative, Inc., and shall not be used for any purpose without their expressed written consent. The owner shall be permitted to

BID SET

ISSUE DATE: 9/13/2024

ADDENDUM 3

retain copies for information and reference.

1 11/4/2024

GENERAL MECHANICAL NOTES

PAINT ALL EXTERIOR GAS PIPING WITH 2 COATS OF SAFETY YELLOW ENAMEL PAINT WITH RUSTOLEUM PRIMER. MECHANICAL CONTRACTOR SHALL PROVIDE ANY ADDITIONAL OFFSETS AS REQUIRED TO COMPLETE THE INSTALLATION OF THE DUCT AND PIPING SYSTEMS.

LAYOUTS ARE SCHEMATIC IN NATURE AND PROVIDE GENERAL ROUTING SOLUTIONS. CONTRACTOR SHALL COORDINATE ALL ROUTES ON SITE. ALL DUCTS SHALL BE SEALED AND INSULATED PER SPECIFICATIONS.

INSTALL ALL DUCTS AND PIPING AS HIGH AS POSSIBLE TO ALLOW FOR CLEARANCE WITH CEILINGS AND OTHER TRADES. SEE THE REFLECTED CEILING PLANS FOR EXACT LOCATIONS OF ALL DIFFUSERS IN THE CEILINGS. CONTRACTOR SHALL COORDINATE WITH THE PHASING PLANS ON THE G SHEETS FOR WHEN EQUIPMENT, PIPING AND FIXTURES SHALL BE REMOVED AND

CONTRACTOR SHALL COORDINATE WITH ALL TRADES FOR DEMOLITION AND PATCH OF ALL CEILINGS, WALLS, FLOORS AND ROOFS WHERE PIPING AND EQUIPMENT NEED TO BE INSTALLED WITH A MATERIAL MATCHING THE EXISTING CONSTRUCTION. MASONRY SHALL BE TOOTHED BACK IN AT ALL LOCATIONS WITH FULL SIZE UNITS. TYPICAL ALL AREAS. PROVIDE ALL TAPS AND VALVES ON THE NEW MAINS AS PART OF PHASE 1 & 2 FOR

FUTURE CONNECTIONS TO FUTURE PHASES. PROVIDE TIE-INS TO EXISTING LINES TO KEEP EXISTING EQUIPMENT OPERATIONAL DURING COLD WEATHER MONTHS PROVIDE ALL SENSOR WELLS FOR INSTALLATION OF TCC CONTROLS. COORDINATE WITH AUTOMATED LOGIC PRIOR TO THE BID FOR QUANTITIES AND LOCATIONS.

- ROUTE DUCTWORK THROUGH OPENING IN TRUSS. TYPICAL ALL DUCT BRANCHES IF
- PAINTED TO MATCH WALL MOUNTED ON.
- OFFSET DUCT UP AS SHOWN TO GET AIR TERMINAL ABOVE PAINT LINE. SEE SECTION FOR ELEVATION.
- SECTION FOR DIMENSIONS AND DETAILS OF INSTALLATION OF DOOR AND TRACK. RELOCATE EXISTING THERMOSTAT TO NEW LOCATION SHOWN. ROUTE HOT AND CHILLED WATER PIPING UP THROUGH AIR HANDLER PIPING
- DETAIL INDICATED FOR PIPING CONNECTIONS TO UNITS. CONTROL VALVES AND TRIM TO BE INSTALLED ABOVE CEILING, BELOW UNITS. CONNECT EXHAUST DUCTWORK TO KITCHEN HOOD. TRANSITION AS REQUIRED TO MAKE CONNECTION. ROUTE DUCTWORK UP TO ROOF AND CONNECT TO EXHAUST
- FAN. SEE KITCHEN HOOD AND DUCTWORK DETAIL SHEETS FOR ADDITIONAL INSTALL AIR CURTAIN ON WALL ABOVE DOOR AT THIS LOCATION. INSTALL ELECTRIC
- DOOR CONTACT TO ACTIVATE AIR CURTAIN WHEN DOOR OPENS. HEATING CONTROLLED BY OUTSIDE AIR TEMPERATURE PER TCC. ROUTE EXHAUST DUCT UP TO FAN ON ROOF ABOVE.
- OFFSET DUCT AT THIS LOCATION. INSTALL TERMINAL BOX IN ACCESSIBLE LOCATION PER DETAIL INDICATED. INSTALL SALVAGED VAV CONTROLLER AND THERMOSTAT FROM EXISTING BOX TO THIS NEW
- INSTALL EXISTING DIFFUSER SALVAGED FROM DEMOLITION IN THIS LOCATION. DIFFUSER TO BE CLEANED BEFORE INSTALLATION IN NEW LOCATION.
- MAKE FLEX CONNECTION TO EXISTING DUCT BRANCH AS SHOWN. LOCATION OF EXISTING OPENING IN ROOF FOR PRESSURE RELIEF FANS. SHOWN
- INSTALL FABRICATED SOUND TRANSFER ABOVE THE CEILING PER THE DETAIL
- MANUFACTURERS REQUIREMENTS.
- THIMBLE AT ROOF LEVEL.

MECHANICAL NOTES

TIE NEW DUCT INTO EXISTING AT THIS APPROXIMATE LOCATION.

- INSTALL AIR TERMINAL ABOVE PAINT LINE IN THIS AREA. DIFFUSER TO BE FIELD
- OFFSET DUCT BELOW STRUCTURE AT THIS LOCATION.
- KEEP AREA CLEAR FOR OVERHEAD DOOR AND TRACK. SEE ARCHITECTURAL
- VESTIBULE AND CONNECT TO COIL CONNECTIONS ON THE UNIT. PIPING VESTIBULE SHALL HAVE FULL PERIMETER CURB AROUND IT AND HAVE THE BOTTOM OPEN TO THE PLENUM SPACE BELOW TO ALLOW HEAT TO RISE UP INTO THE VESTIBULE. SEE

- ROUTE DUCT UP THROUGH CURB TO ROOFTOP AIR HANDLER ON THE ROOF ABOVE
- TIE NEW PIPING INTO EXISTING AT THIS LOCATION.
- FOR REFERENCE ONLY.
- PROVIDE AND INSTALL KITCHEN HOOD SYSTEMS PER THE SCHEDULES AND DETAILS INDICATED ON THE K-SHEETS. INSTALL IN STRICT COMPLIANCE WITH
- INSTALL DRYER DUCT BEHIND DRYER AND ROUTE 4" DRYER DUCT UP THROUGH ROOF AND TERMINATE WITH GOOSENECK POINTED TOWARD THE EAST. THERE SHALL BE NO SCREWS USED IN THE DUCT FOR LINT TO SNAG PER CODE. PROVIDE

ROUTE SUPPLY DUCT UP AND CONNECT TO MAKEUP AIR UNIT ON THE ROOF

this document are the sole property of Design Collaborative, Inc., and shall not be used for any purpose without their expressed written consent. The owner shall be permitted to retain copies for information and reference.

BID SET

A-B

KEY PLAN

SCALE: NONE

ISSUE DATE: 9/13/2024

REVISIONS

11/4/2024

MECHANICAL PLAN -MAIN LEVEL - UNIT F

M2.1F

M08 PROVIDE ISOLATION VALVE AND PRESSURE REGULATOR. PRESSURE REGULATOR SHALL REDUCE BUILDING NATURAL GAS PRESSURE TO PRESSURE REQUIRED BY MECHANICAL EQUIPMENT. MAKE FINAL CONNECTION TO EQUIPMENT.

FUTURE CONNECTIONS TO FUTURE PHASES. PROVIDE TIE-INS TO EXISTING LINES TO KEEP EXISTING EQUIPMENT OPERATIONAL DURING COLD WEATHER MONTHS PROVIDE ALL SENSOR WELLS FOR INSTALLATION OF TCC CONTROLS. COORDINATE WITH AUTOMATED LOGIC PRIOR TO THE BID FOR QUANTITIES AND LOCATIONS.

PROVIDE AND INSTALL KITCHEN EXHAUST FAN ON ROOF IN THIS LOCATION. LOCATE BETWEEN STRUCTURAL MEMBERS AND PROVIDE ANY ADDITIONAL FRAMING TO SUPPORT FAN AS NEEDED. SEE K SHEETS FOR EQUIPMENT INFORMATION AND

INSTALL ALL ROOFTOP EQUIPMENT A MINIMUM OF 10' AWAY FROM THE EDGE OF

INSTALL AIR HANDLING UNIT ON PERIMETER ROOF CURB AT THIS LOCATION. COORDINATE STRUCTURAL SUPPORT WITH STRUCTURAL DRAWINGS. INSTALL SIMILAR TO DETAIL INDICATED. PROVIDE ADDITIONAL PIPING CURBS FOR POWER AND CONTROL WIRING AS REQUIRED. MODIFY ROOFING AND STRUCTURE AS

EXISTING FAN POWERED RELIEF VENTILATORS AND CONTROLS TO REMAIN. ROUTE HOT AND CHILLED WATER PIPING UP THROUGH AIR HANDLER PIPING VESTIBULE AND CONNECT TO COIL CONNECTIONS ON THE UNIT. PIPING VESTIBULE SHALL HAVE FULL PERIMETER CURB AROUND IT AND HAVE THE BOTTOM OPEN TO THE PLENUM SPACE BELOW TO ALLOW HEAT TO RISE UP INTO THE VESTIBULE. SEE DETAIL INDICATED FOR PIPING CONNECTIONS TO UNITS. CONTROL VALVES AND TRIM TO BE INSTALLED ABOVE CEILING, BELOW UNITS.

TIE NEW PIPING INTO EXISTING AT THIS LOCATION. ROUTE NEW GAS PIPING ON DURABLOCK ROOF SUPPORTS WITH INTEGRAL STRUT

TO MATCH EXISTING SUPPORTS. PAINT ALL NEW GAS PIPING SAFETY YELLOW. PROVIDE AND INSTALL DOAS UNIT FOR KITCHEN MAKEUP AIR ON PERIMETER ROOF CURB AT THIS LOCATION. COORDINATE STRUCTURAL SUPPORT WITH STRUCTURAL DRAWINGS. INSTALL SIMILAR TO DETAIL INDICATED. PROVIDE ADDITIONAL PIPING CURBS FOR POWER AND CONTROL WIRING AS REQUIRED. MODIFY ROOFING AND STRUCTURE AS REQUIRED. SEE KITCHEN HOOD SHEETS FOR SCHEDULE AND

PROVIDE AND INSTALL MAKEUP AIR UNIT FOR HOOD SYSTEM ON PERIMETER ROOF CURB AT THIS LOCATION. COORDINATE STRUCTURAL SUPPORT WITH STRUCTURAL DRAWINGS. INSTALL SIMILAR TO DETAIL INDICATED. PROVIDE ADDITIONAL PIPING CURBS FOR POWER AND CONTROL WIRING AS REQUIRED. MODIFY ROOFING AND STRUCTURE AS REQUIRED. SEE KITCHEN HOOD SHEETS FOR SCHEDULE AND

M36 OFFSET GAS PIPING UP AND OVER ROOF EXPANSION JOINT. TYPICAL ALL AREAS.

this document are the sole property of Design Collaborative, Inc., and shall not be used for any purpose without their expressed written consent. The owner shall be permitted to retain copies for information and reference.

BID SET

ISSUE DATE: 9/13/2024

REVISIONS 11/4/2024


MECHANICAL PLAN -ROOF LEVEL - UNIT F


A-B

KEY PLAN

SCALE: NONE

M2.4F

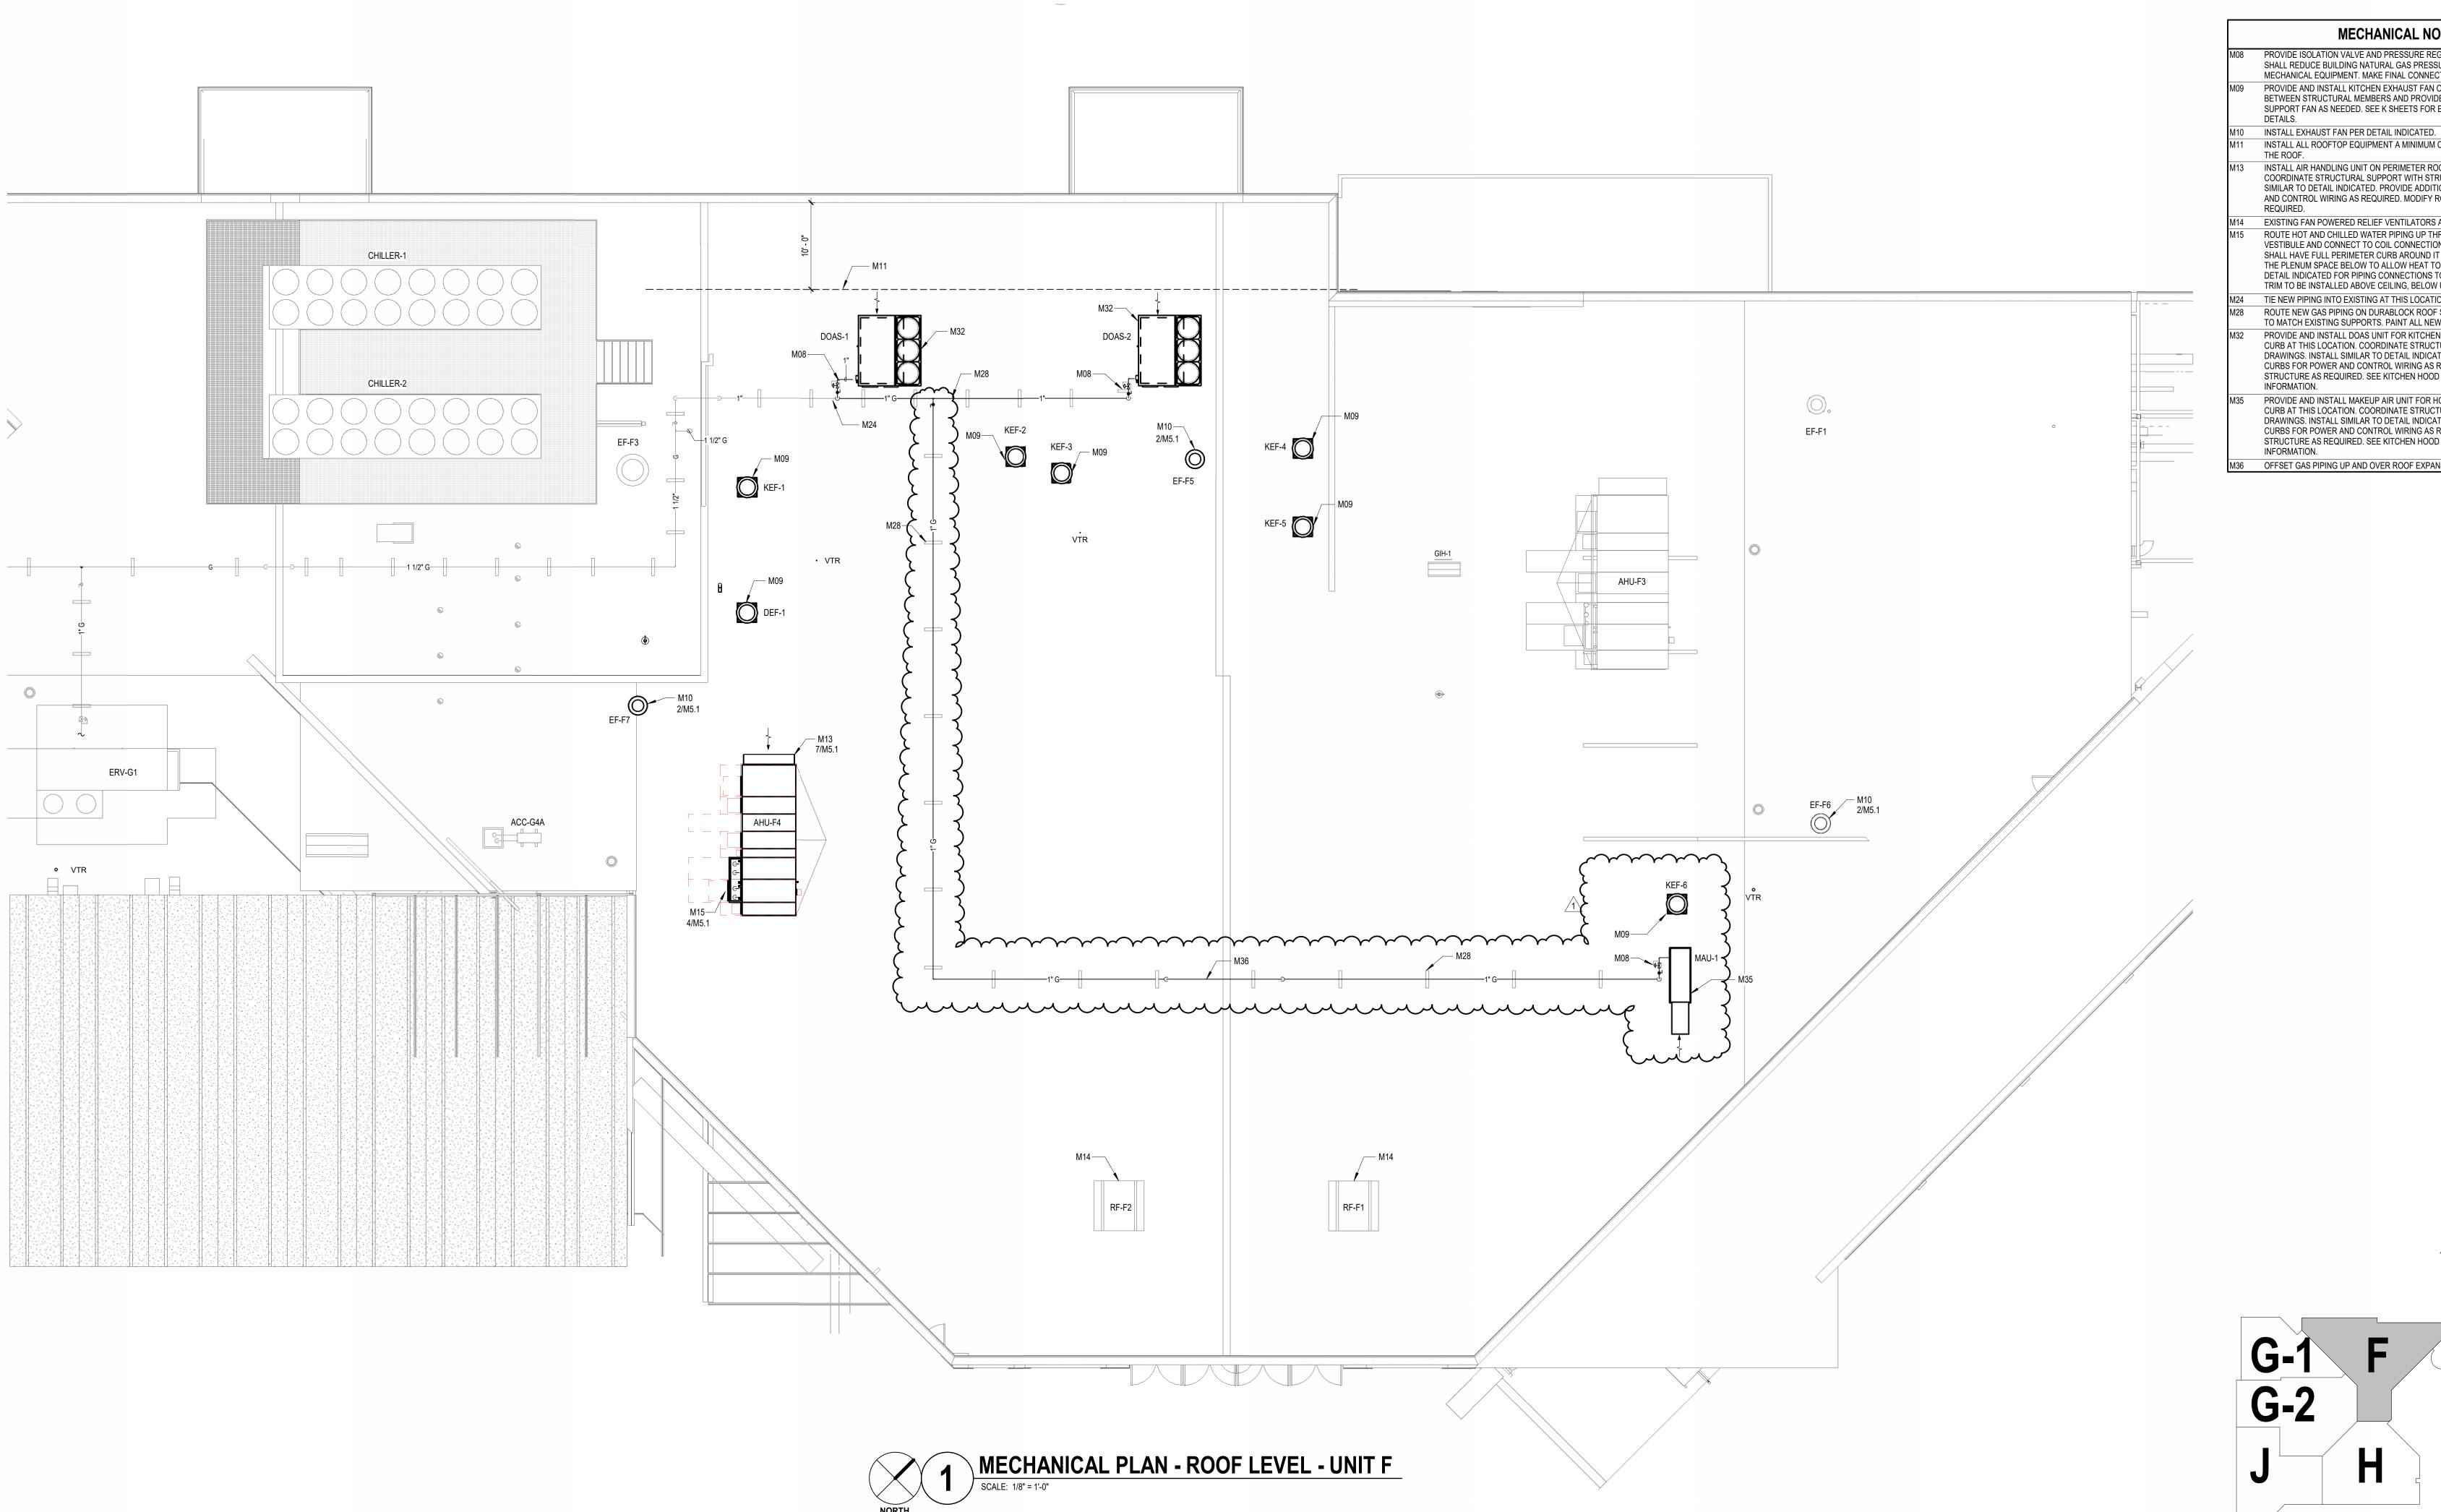

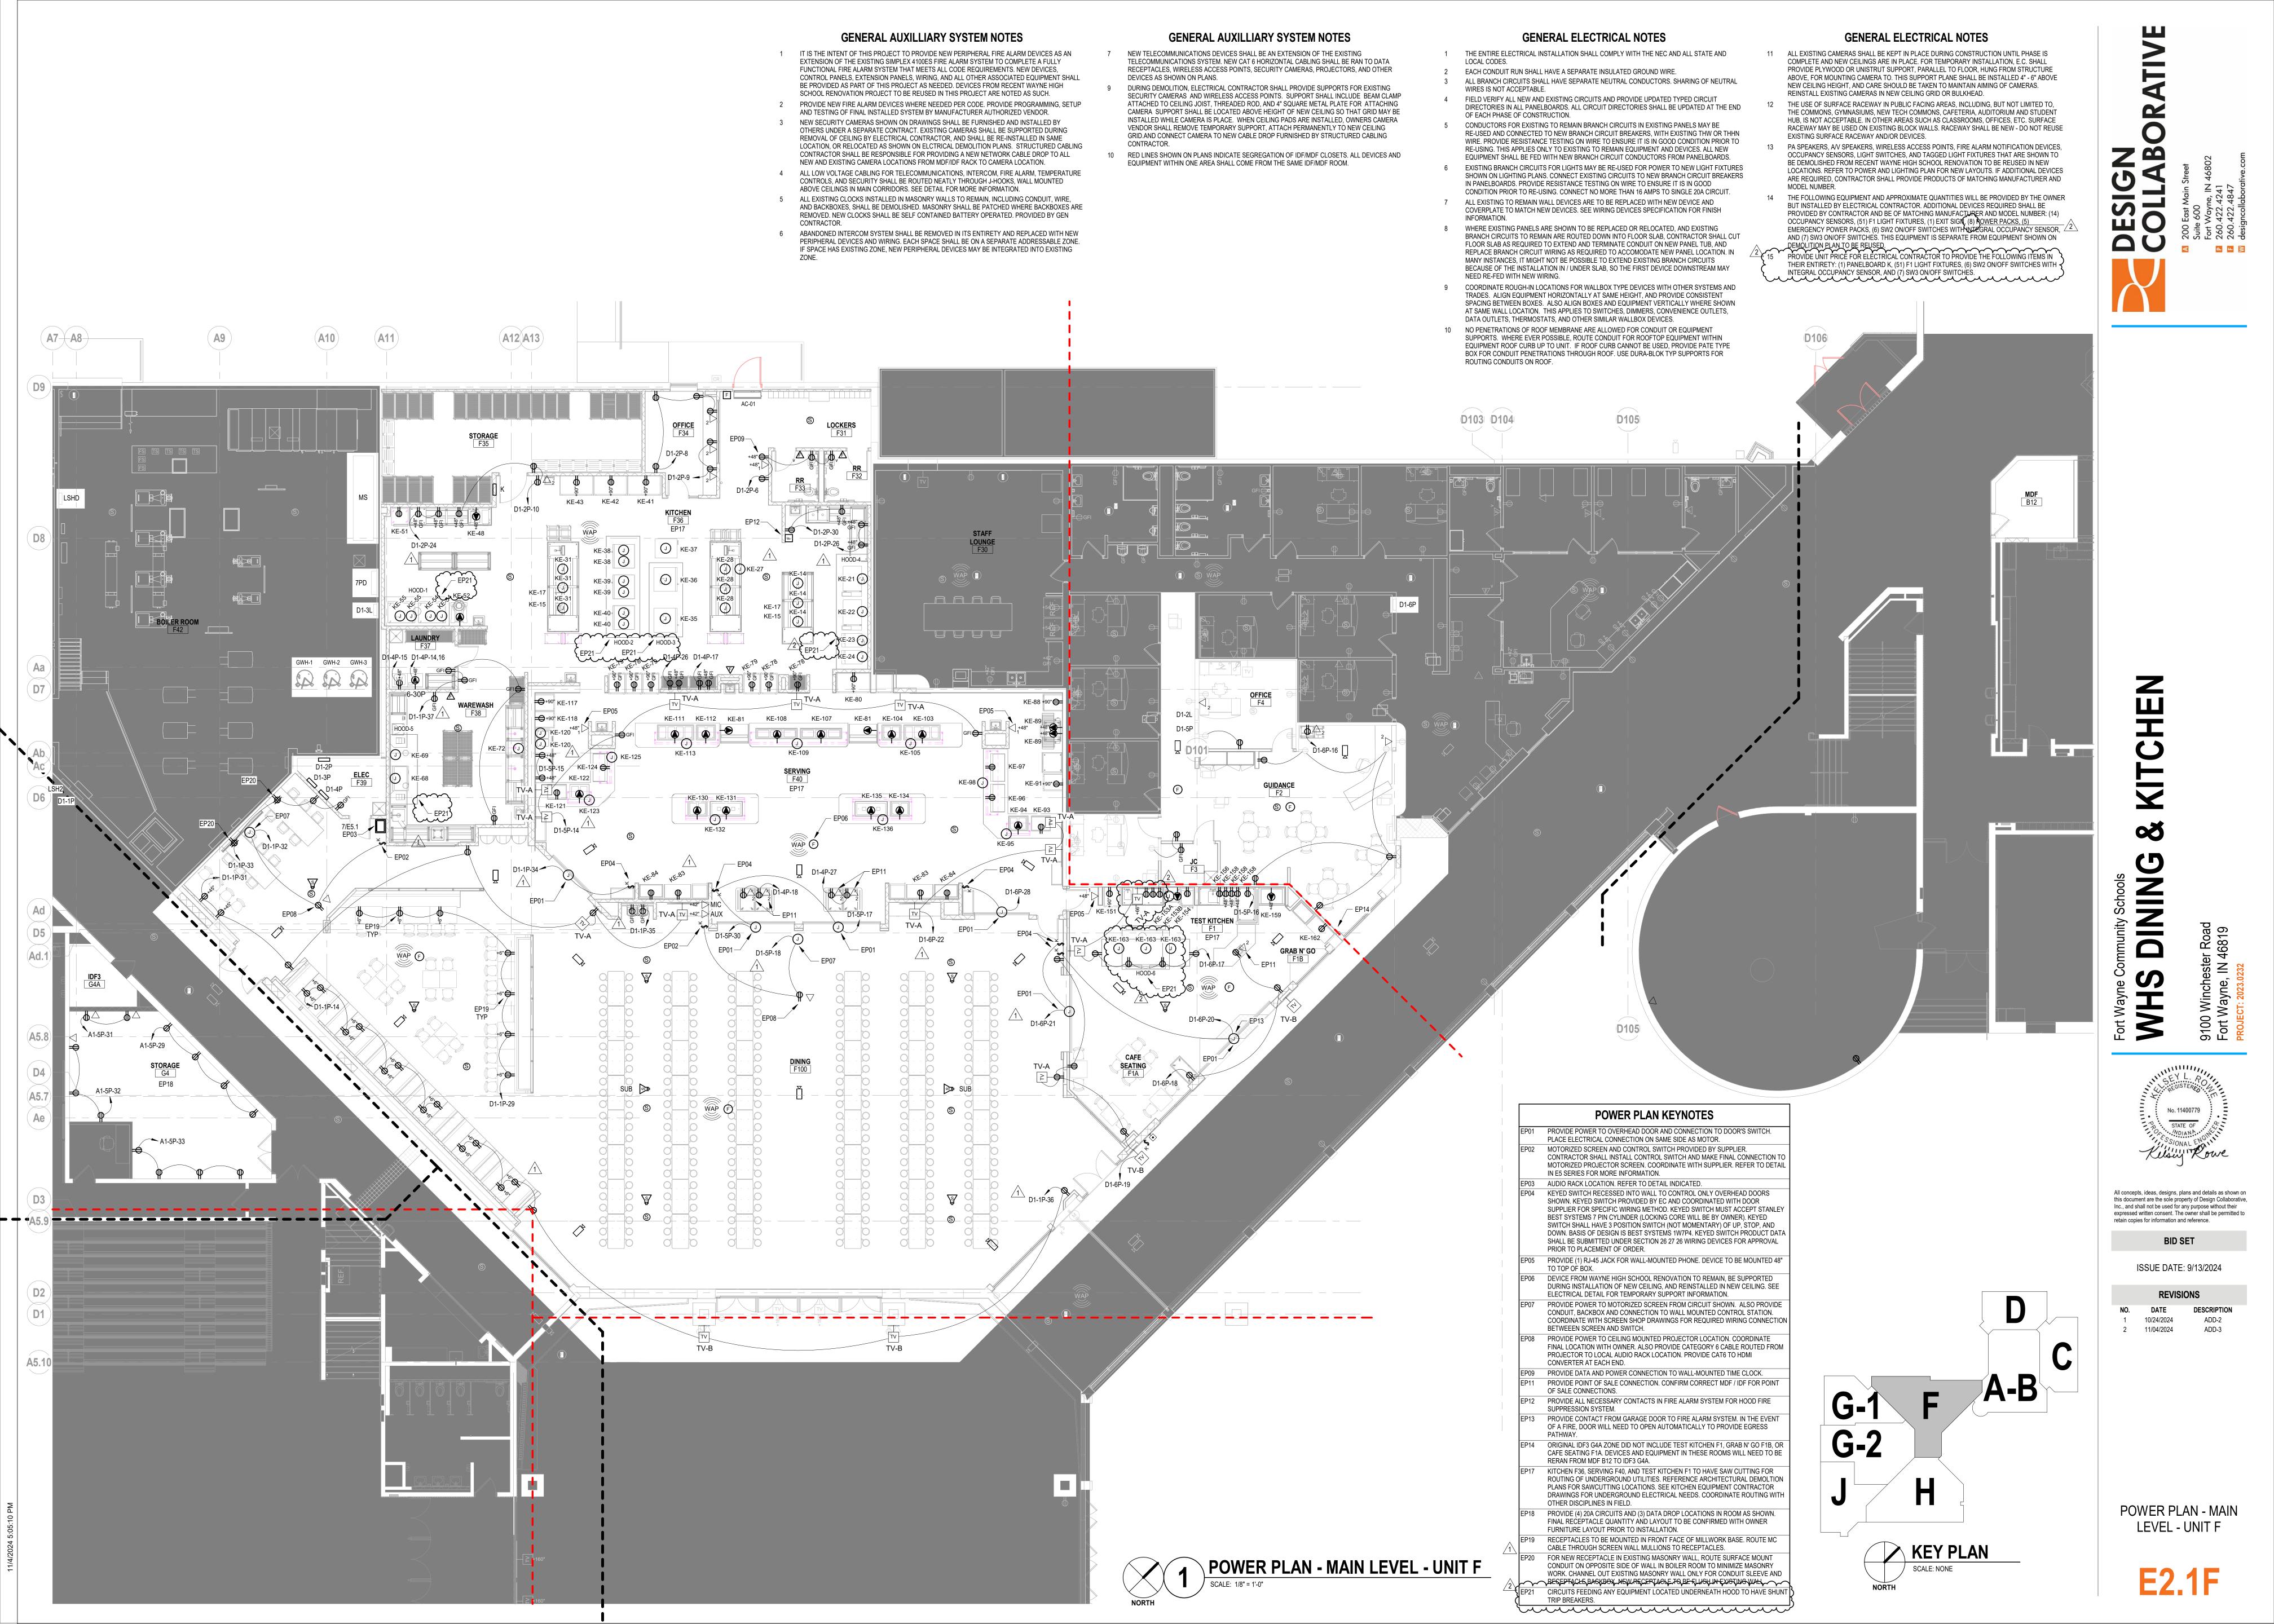

POWER PLAN - ROOF

SCALE: 1/8" = 1'-0"

GENERAL ELECTRICAL NOTES

- 1 THE ENTIRE ELECTRICAL INSTALLATION SHALL COMPLY WITH THE NEC AND ALL STATE AND LOCAL CODES.
- EACH CONDUIT RUN SHALL HAVE A SEPARATE INSULATED GROUND WIRE. ALL BRANCH CIRCUITS SHALL HAVE SEPARATE NEUTRAL CONDUCTORS. SHARING OF NEUTRAL
- WIRES IS NOT ACCEPTABLE. 4 FIELD VERIFY ALL NEW AND EXISTING CIRCUITS AND PROVIDE UPDATED TYPED CIRCUIT
- DIRECTORIES IN ALL PANELBOARDS. ALL CIRCUIT DIRECTORIES SHALL BE UPDATED AT THE END OF EACH PHASE OF CONSTRUCTION. 5 CONDUCTORS FOR EXISTING TO REMAIN BRANCH CIRCUITS IN EXISTING PANELS MAY BE RE-USED AND CONNECTED TO NEW BRANCH CIRCUIT BREAKERS, WITH EXISTING THW OR THHN WIRE. PROVIDE RESISTANCE TESTING ON WIRE TO ENSURE IT IS IN GOOD CONDITION PRIOR TO RE-USING. THIS APPLIES ONLY TO EXISTING TO REMAIN EQUIPMENT AND DEVICES. ALL NEW
- EQUIPMENT SHALL BE FED WITH NEW BRANCH CIRCUIT CONDUCTORS FROM PANELBOARDS. EXISTING BRANCH CIRCUITS FOR LIGHTS MAY BE RE-USED FOR POWER TO NEW LIGHT FIXTURES SHOWN ON LIGHTING PLANS. CONNECT EXISTING CIRCUITS TO NEW BRANCH CIRCUIT BREAKERS IN PANELBOARDS. PROVIDE RESISTANCE TESTING ON WIRE TO ENSURE IT IS IN GOOD CONDITION PRIOR TO RE-USING. CONNECT NO MORE THAN 16 AMPS TO SINGLE 20A CIRCUIT.
- 7 ALL EXISTING TO REMAIN WALL DEVICES ARE TO BE REPLACED WITH NEW DEVICE AND COVERPLATE TO MATCH NEW DEVICES. SEE WIRING DEVICES SPECIFICATION FOR FINISH INFORMATION. WHERE EXISTING PANELS ARE SHOWN TO BE REPLACED OR RELOCATED, AND EXISTING
- BRANCH CIRCUITS TO REMAIN ARE ROUTED DOWN INTO FLOOR SLAB, CONTRACTOR SHALL CUT FLOOR SLAB AS REQUIRED TO EXTEND AND TERMINATE CONDUIT ON NEW PANEL TUB, AND REPLACE BRANCH CIRCUIT WIRING AS REQUIRED TO ACCOMODATE NEW PANEL LOCATION. IN MANY INSTANCES, IT MIGHT NOT BE POSSIBLE TO EXTEND EXISTING BRANCH CIRCUITS BECAUSE OF THE INSTALLATION IN / UNDER SLAB, SO THE FIRST DEVICE DOWNSTREAM MAY NEED RE-FED WITH NEW WIRING.
- COORDINATE ROUGH-IN LOCATIONS FOR WALLBOX TYPE DEVICES WITH OTHER SYSTEMS AND TRADES. ALIGN EQUIPMENT HORIZONTALLY AT SAME HEIGHT, AND PROVIDE CONSISTENT SPACING BETWEEN BOXES. ALSO ALIGN BOXES AND EQUIPMENT VERTICALLY WHERE SHOWN AT SAME WALL LOCATION. THIS APPLIES TO SWITCHES, DIMMERS, CONVENIENCE OUTLETS, DATA OUTLETS, THERMOSTATS, AND OTHER SIMILAR WALLBOX DEVICES.
- 10 NO PENETRATIONS OF ROOF MEMBRANE ARE ALLOWED FOR CONDUIT OR EQUIPMENT SUPPORTS. WHERE EVER POSSIBLE, ROUTE CONDUIT FOR ROOFTOP EQUIPMENT WITHIN EQUIPMENT ROOF CURB UP TO UNIT. IF ROOF CURB CANNOT BE USED, PROVIDE PATE TYPE BOX FOR CONDUIT PENETRATIONS THROUGH ROOF. USE DURA-BLOK TYP SUPPORTS FOR ROUTING CONDUITS ON ROOF.
- 11 ALL EXISTING CAMERAS SHALL BE KEPT IN PLACE DURING CONSTRUCTION UNTIL PHASE IS COMPLETE AND NEW CEILINGS ARE IN PLACE. FOR TEMPORARY INSTALLATION, E.C. SHALL PROVIDE PLYWOOD OR UNISTRUT SUPPORT, PARALLEL TO FLOOR, HUNG FROM STRUCTURE ABOVE, FOR MOUNTING CAMERA TO. THIS SUPPORT PLANE SHALL BE INSTALLED 4" - 6" ABOVE NEW CEILING HEIGHT, AND CARE SHOULD BE TAKEN TO MAINTAIN AIMING OF CAMERAS. REINSTALL EXISTING CAMERAS IN NEW CEILING GRID OR BULKHEAD.
- 12 THE USE OF SURFACE RACEWAY IN PUBLIC FACING AREAS, INCLUDING, BUT NOT LIMITED TO, THE COMMONS, GYMNASIUMS, NEW TECH COMMONS, CAFETERIA, AUDITORIUM AND STUDENT HUB, IS NOT ACCEPTABLE. IN OTHER AREAS SUCH AS CLASSROOMS, OFFICES, ETC. SURFACE RACEWAY MAY BE USED ON EXISTING BLOCK WALLS. RACEWAY SHALL BE NEW - DO NOT REUSE EXISTING SURFACE RACEWAY AND/OR DEVICES.
- 13 PA SPEAKERS, A/V SPEAKERS, WIRELESS ACCESS POINTS, FIRE ALARM NOTIFICATION DEVICES, OCCUPANCY SENSORS, LIGHT SWITCHES, AND TAGGED LIGHT FIXTURES THAT ARE SHOWN TO BE DEMOLISHED FROM RECENT WAYNE HIGH SCHOOL RENOVATION TO BE REUSED IN NEW LOCATIONS. REFER TO POWER AND LIGHTING PLAN FOR NEW LAYOUTS. IF ADDITIONAL DEVICES ARE REQUIRED, CONTRACTOR SHALL PROVIDE PRODUCTS OF MATCHING MANUFACTURER AND MODEL NUMBER.
- 14 THE FOLLOWING EQUIPMENT AND APPROXIMATE QUANTITIES WILL BE PROVIDED BY THE OWNER BUT INSTALLED BY ELECTRICAL CONTRACTOR. ADDITIONAL DEVICES REQUIRED SHALL BE PROVIDED BY CONTRACTOR AND BE OF MATCHING MANUFACTURER AND MODEL NUMBER: (14) OCCUPANCY SENSORS, (51) F1 LIGHT FIXTURES, (1) EXIT SIGN, (8) NOWER PACKS, (5) EMERGENCY POWER PACKS, (6) SW2 ON/OFF SWITCHES WITHINDEGRAL OCCUPANCY SENSOR, 1 AND (7) SW3 ON/OFF SWITCHES. THIS EQUIPMENT IS SEPARATE FROM EQUIPMENT SHOWN ON DEMOLÍTION PLAN TO BE REUSED.

 15 PROVIDE UNIT PRICÉ FOR ELÉCTRICAL CONTRACTOR TO PROVIDE THE FOLLOWING ITEMS IN
- THEIR ENTIRETY: (1) PANELBOARD K, (51) F1 LIGHT FIXTURES, (6) SW2 ON/OFF SWITCHES WITH INTEGRAL OCCUPANCY SENSOR, AND (7) SW3 ON/OFF SWITCHES.

GENERAL AUXILLIARY SYSTEM NOTES

- 1 IT IS THE INTENT OF THIS PROJECT TO PROVIDE NEW PERIPHERAL FIRE ALARM DEVICES AS AN EXTENSION OF THE EXISTING SIMPLEX 4100ES FIRE ALARM SYSTEM TO COMPLETE A FULLY FUNCTIONAL FIRE ALARM SYSTEM THAT MEETS ALL CODE REQUIREMENTS. NEW DEVICES, CONTROL PANELS, EXTENSION PANELS, WIRING, AND ALL OTHER ASSOCIATED EQUIPMENT SHALL BE PROVIDED AS PART OF THIS PROJECT AS NEEDED. DEVICES FROM RECENT WAYNE HIGH SCHOOL RENOVATION PROJECT TO BE REUSED IN THIS PROJECT ARE NOTED AS SUCH.
- PROVIDE NEW FIRE ALARM DEVICES WHERE NEEDED PER CODE. PROVIDE PROGRAMMING, SETUP AND TESTING OF FINAL INSTALLED SYSTEM BY MANUFACTURER AUTHORIZED VENDOR. NEW SECURITY CAMERAS SHOWN ON DRAWINGS SHALL BE FURNISHED AND INSTALLED BY OTHERS UNDER A SEPARATE CONTRACT. EXISTING CAMERAS SHALL BE SUPPORTED DURING REMOVAL OF CEILING BY ELECTRICAL CONTRACTOR, AND SHALL BE RE-INSTALLED IN SAME LOCATION, OR RELOCATED AS SHOWN ON ELCTRICAL DEMOLITION PLANS. STRUCTURED CABLING CONTRACTOR SHALL BE RESPONSIBLE FOR PROVIDING A NEW NETWORK CABLE DROP TO ALL NEW AND EXISTING CAMERA LOCATIONS FROM MDF/IDF RACK TO CAMERA LOCATION.
- ALL LOW VOLTAGE CABLING FOR TELECOMMUNICATIONS, INTERCOM, FIRE ALARM, TEMPERATURE CONTROLS, AND SECURITY SHALL BE ROUTED NEATLY THROUGH J-HOOKS, WALL MOUNTED ABOVE CEILINGS IN MAIN CORRIDORS. SEE DETAIL FOR MORE INFORMATION. ALL EXISTING CLOCKS INSTALLED IN MASONRY WALLS TO REMAIN, INCLUDING CONDUIT, WIRE, AND BACKBOXES, SHALL BE DEMOLISHED. MASONRY SHALL BE PATCHED WHERE BACKBOXES ARE
- REMOVED. NEW CLOCKS SHALL BE SELF CONTAINED BATTERY OPERATED. PROVIDED BY GEN CONTRACTOR. ABANDONED INTERCOM SYSTEM SHALL BE REMOVED IN ITS ENTIRETY AND REPLACED WITH NEW PERIPHERAL DEVICES AND WIRING. EACH SPACE SHALL BE ON A SEPARATE ADDRESSABLE ZONE.
- IF SPACE HAS EXISTING ZONE, NEW PERIPHERAL DEVICES MAY BE INTEGRATED INTO EXISTING NEW TELECOMMUNICATIONS DEVICES SHALL BE AN EXTENSION OF THE EXISTING TELECOMMUNICATIONS SYSTEM. NEW CAT 6 HORIZONTAL CABLING SHALL BE RAN TO DATA
- RECEPTACLES, WIRELESS ACCESS POINTS, SECURITY CAMERAS, PROJECTORS, AND OTHER DEVICES AS SHOWN ON PLANS.
- 9 DURING DEMOLITION, ELECTRICAL CONTRACTOR SHALL PROVIDE SUPPORTS FOR EXISTING SECURITY CAMERAS AND WIRELESS ACCESS POINTS. SUPPORT SHALL INCLUDE BEAM CLAMP ATTACHED TO CEILING JOIST, THREADED ROD, AND 4" SQUARE METAL PLATE FOR ATTACHING CAMERA SUPPORT SHALL BE LOCATED ABOVE HEIGHT OF NEW CEILING SO THAT GRID MAY BE INSTALLED WHILE CAMERA IS PLACE. WHEN CEILING PADS ARE INSTALLED, OWNERS CAMERA VENDOR SHALL REMOVE TEMPORARY SUPPORT, ATTACH PERMANENTLY TO NEW CEILING GRID.AND CONNECT CAMERA TO NEW CABLE DROP FURNISHED BY STRUCTURED CABLING CONTRACTOR.
- 10 RED LINES SHOWN ON PLANS INDICATE SEGREGATION OF IDF/MDF CLOSETS. ALL DEVICES AND EQUIPMENT WITHIN ONE AREA SHALL COME FROM THE SAME IDF/MDF ROOM.

POWER PLAN KEYNOTES

ELECTRICAL CONNECTION TO AHU TO RUN THROUGH AHU CURB AND CONNECT TO CONTROL BOX AS SHOWN IN ACCOMPANYING PHOTO. SEE MECHANICAL DETAIL FOR MORE INFORMATION. P16 ELECTRICAL CONNECTION TO ROOFTOP MECHANICAL EQUIPMENT MUST RUN THROUGH EQUIPMENT CURB. NO ADDITIONAL CURBS OR ROOF PENETRATIONS WILL BE ALLOWED. SEE MECHANICAL DETAIL FOR MORE INFORMATION.

G-2

KEY PLAN
SCALE: NONE

No. 11400779

this document are the sole property of Design Collaborative, Inc., and shall not be used for any purpose without their expressed written consent. The owner shall be permitted to retain copies for information and reference.

All concepts, ideas, designs, plans and details as shown on

BID SET

ISSUE DATE: 9/13/2024

REVISIONS

1 11/04/2024

POWER PLAN - ROOF

E2.4

NO. DATE DESCRIPTION

A-B

GENERAL LIGHTING NOTES

- CONNECT ALL EXIT SIGNS, SELF CONTAINED, BATTERY POWERED EMERGENCY LIGHTS UNSWITCHED TO LIFE SAFETY LIGHTING CIRCUIT IN THAT AREA, BYPASSING ALL SWITCHES OR CONTROLS.
- IN AREAS WHERE FIXTURES ARE SHOWN TO BE DIMMED, CONTRACTOR SHALL RUN LOW VOLTAGE CONTROL CABLE TO EACH FIXTURE IN ADDITION TO LINE VOLTAGE WIRING. CONTROL WIRING MAY BE RUN USING OPEN CABLING. LIGHT FIXTURES SHALL BE AS SCHEDULED OR APPROVED EQUAL 10 DAYS PRIOR
- TO BID. ALL LIGHTING CONTROLS TO BE SENSORWORX BRAND TO MATCH EXISTING TO BE REUSED LIGHTING CONTROLS AND REST OF SCHOOL. OCCUPANCY SENSORS SHALL HAVE SEPARATE LINE VOLTAGE RELAYS/POWER PACKS FOR CONTROL OF LIGHTING CIRCUIT AND LOW VOLTAGE WIRING CONNECTION TO SENSOR TO ALLOW FOR RELOCATION OR MULTIPLE SENSORS.
- SENSORS SHALL BE DUAL TECHNOLOGY TYPE. OCCUPANCY SENSOR LOCATIONS ON PLANS ARE SHOWN TO INDICATE AREAS TO BE COVERED, AND LIGHTS TO BE CONTROLLED. OCCUPANCY SENSOR MANUFACTURER SHALL ADJUST LOCATIONS, QUANTITIES, AND SENSOR TYPES TO ENSURE PROPER COVERAGE OF ALL AREAS. PROVIDE ADDITIONAL SENSORS IF NEEDED TO COVER ENTIRE AREA. USE WALL MOUNTED, LONG THROW SENSORS FOR CORRIDORS WHERE APPLICABLE, AND CEILING MOUNTED SENSORS IN OTHER
- WALLBOX TYPE SENSORS SHALL HAVE INTEGRAL ON/OFF OVERRIDE SWITCH, ADJUSTABLE TIME DELAY, AND PROGRAMMABLE MODES OF OPERATION (MANUAL ON/AUTO OFF, AUTO ON/AUTO OFF, ETC). SENSORS SHALL BE CAPABLE OF BEING MASKED OFF TO PREVENT FALSE ON SIGNAL FROM CERTAIN AREAS OF COVERAGE. E.C. SHALL PROVIDE ALL REQUIRED CABLING TO INTERCONNECT ALL CONTROL DEVICES, INCLUDING RF-45 PLUGS ON ALL CABLES
- THE FOLLOWING EQUIPMENT AND APPROXIMATE QUANTITIES WILL BE PROVIDED BY THE OWNER BUT INSTALLED BY ELECTRICAL CONTRACTOR. ADDITIONAL DEVICES REQUIRED SHALL BE PROVIDED BY CONTRACTOR AND BE OF MATCHING MANUFACTURER AND MODEL NUMBER: (14) OCCUPANCY SENSORS, (51) F1 LIGHT FIXTURES, (1) EXIT SIGN. (8) POWER PACKS, (5) EMERGENCY POWER PACKS, (6) SW2 ON/OFF SWITCHES WITH INTEGRAL OCCUPANCY SENSOR, AND (7) SW3 ON/OFF SWITCHES. THIS EQUIPMENT IS SEPARATE FROM EQUIPMENT SHOWN ON DEMOLITION PLAN TO BE REUSED.

 9 PROVIDE UNIT PRICE FOR ELECTRICAL CONTRACTOR TO PROVIDE THE FOLLOWING
- ITEMS IN THEIR ENTIRETY: (1) PANELBOARD K, (51) F1 LIGHT FIXTURES, (6) SW2 ON/OFF SWITCHES WITH INTEGRAL OCCUPANCY SENSOR, AND (7) SW3 ON/OFF www.www.www

WALL SWITCH SCHEDULE

SWITCH ID	DESCRIPTION
1	ON/OFF SWITCH - NO AUTOMATIC CONTROLS
2	WALL BOX MOUNTED OCCUPANCY SENSOR WITH ON/OFF
3	ON/OFF WALL SWITCH OVERRIDE WITH CEILING OCCUPANCY SENSOR(S)
4	ON/OFF/RAISE/LOWER WALL SWITCH OVERRIDE WITH CEILING OCCUPANCY SENSOR(S)
5	NPODM sX SERIES SCENE SELECTOR - REFER TO DETAIL FOR WIRING AND NOTES FOR LIGHTING CONTROL IN THIS SPACE.

LIGHTING PLAN KEYNOTES

- EL01 E.C. SHALL PROVIDE AND INSTALL ALL NECESSARY CABLING, BOXES, AND CONDUIT TO EXTEND OR REROUTE EXISTING BRANCH CIRCUIT AS REQUIRED TO CONNECT NEW LIGHT FIXTURES AND CONTROLS.
- EL02 CONNECT EMERGENCY LIGHTS TO EXISTING GENERATOR-BACKED LIFE SAFETY CIRCUIT IN UNIT ON PANEL LSHD. SEE POWER PLAN FOR PANEL LOCATION.

this document are the sole property of Design Collaborative, Inc., and shall not be used for any purpose without their expressed written consent. The owner shall be permitted to retain copies for information and reference.

No. 11400779

BID SET

ISSUE DATE: 9/13/2024

REVISIONS NO. DATE DESCRIPTION 11/04/2024

A-B

KEY PLAN

SCALE: NONE

G-1

G-2

LIGHTING PLAN - MAIN LEVEL - UNIT F

E3.1F

LIGHTING PLAN - MAIN LEVEL - UNIT F

Branch Panel: D1-3P

NEEDED TO BE PROVIDED BY EC.

CKT Circuit Description

3 KE-54 (CONTROLS) 5 KE-54 (CONTROLS) 7 HOOD-2 (KE-34)

1 KE-105

9 KE-113 11 KE-78 13 KE-109 15 KE-81

19 KE-107

23 KE-108

27 KE-96 29 KE-123 31 KE-112

35 KE-94

41 KE-79

39 HOOD-3 (KE-34)

Load Classification

KITCHEN EQUIP

Location: ELEC F39

Enclosure: TYPE 1

Supply From: 7PD

Location: ELEC F39 Volts: 120/2 Phases: 3 Mounting: RECESSED Wires: 4

RECONNECT EXISTING CIRCUITS TO REMAIN. BREAKERS NEEDED FOR SPACES 21 **Circuit Description** 1 30A EXISTING CIRCUIT 5 20A EXISTING CIRCUIT ' KE-27 20 A 1 1.44 kW 0.72 kW 20 A 1 0.36 kW 0.54 kV 20 A 1 1.92 kW 0.20 kW 9 RCPT OFFICE F34 11 GWH-1, GWH-2, GWH-3 13 KE-14 20 A 1 1.92 NVV 0.20 NVV 0.72 F 20 A 1 1.83 kW 0.72 F 15 KE-51 17 KE-31 20 A 1 1.92 kW 0.40 kW 19 KE-28 20 A 1 0.86 kW 0.40 k 20 A 1 0.36 kW 21 EF-F6 23 KE-28 25 KE-48

-- -- 2.59 kW 0.86 k 50 A 3 -- -- 3.17 kW 1.73 kW 29 KE-37 -- -- 3.17 kW 1.92 k 20 A 2 -- 0.40 kW 1.73 kW 35 KEF-3 20 A 2 0.54 kW 0.40 kV 39 KEF-4 50 A 2 7.20 kW 0.54 kW 7.20 kW 0.54 k\
30 A 2 2 -- -- 2.50 kW 0.54 kW 43 AC-01 47 KE-14 30 A 2 2.50 kW 2.50 51 KE-31 55 KE-72 30 A 3 3.20 kW 2.40 kW -- -- 3.20 kW 2.40 l Total Load: 32.95 kW 32.53 kW Total Amps: 279 A 276 A

Load Classification Connected Load **Demand Factor** KITCHEN EQUIP 65.00% 66.47 kW 5.04 kW 100.00% 22.75 kW 100.00%

Volts: 120/208

112 A 126 A

25.22 kW

1.08 kW

Phases: 3

PANEL D1-3P AND (42) 20A/1P BREAKERS TO BE PROVIDED BY OWNER FROM RECENT WAYNE HIGH SCHOOL RENOVATION. ALL OTHER BREAKERS

Total Load: 11.80 kW 13.19 kW 14.90 kW

65.00%

100.00%

Demand Factor Estimated Demand

Total Amps: 98 A

Connected Load

38.81 kW

1.08 kW

/208			M	nine Tv	ma: MLO		
				-	/pe: MLO ing: 225 A		
		AYNE HIGI ROVIDED I		OL RE	NOVATION. EXTEND AND		
		С	Poles	Trip	Circuit Description	СКТ	
			1		20A EXISTING CIRCUIT	2	
			1		20A EXISTING CIRCUIT	4	
		1.58 kW	1	20 A	RCPT ROOM F36, F33, F32	6	
			1		RCPT ROOM F34, EF-F5	8	
4 kW			1		RCPT KITCHEN F36	10	
	0.15 kW	1.92 kW	1	20 A	KE-31	12	
			1		HOOD-1 (KE-53)	14	
2 kW			1		ROOFTOP RCPT	16	
	1.92 kW	0.20 kW	1		HOOD-5 (KE-67)	18	
			2		DEF-1	20	
0 kW						22	_
	1.92 kW	0.36 kW	1	20 A	RCPT KITCHEN F36	24	<u>/1</u> \
			1		RCPT KITCHEN F36	26	
6 kW			1		EF-F7	28	_
	3.17 kW	0.36 kW	1		RCPT ROOM F36	30	<u>/1</u> \
			1		KE-41	32	
2 kW			1		KE-14	34	
	0.40 kW	2.23 kW	1		KE-43	36	
			1		KE-42	38	
0 kW			2		KEF-1	40	
	0.54 kW	0.40 kW				42	
	J.J F KVV	5. 15 KVV	2		KEF-2	44	
4 kW						46	
	2.50 kW	0.54 kW	2		KEF-5	48	
	55 KVV	5.5 T KVV				50	
0 kW			2		KE-28	52	
- NVV	2.50 kW	2.50 kW				54	
	2.50 KVV	2.50 1(1)	3		KE-52	56	
0 kW						58	
O IXVV	3 20 kW	2.40 kW				60	
/		8 kW				1 30	
•		0 A	J				
mater	I Demand	- / ·			Panel Totals		
43.20					i and rotals		
5.04			т.	otal C	onn. Load: 94.26 kW		
22.75					Demand: 70.99 kW		
۷۷.۱	/ I\ V V				n. Current: 262 A		
		Tot			d Current: 197 A		
		100	.uı LƏL. L	Jonall	a Julient, 107 A		

Mains Type: MLO

Panel Totals

Total Est. Demand Current: 73 A

Total Conn. Load: 39.89 kW

Total Est. Demand: 26.30 kW Total Conn. Current: 111 A

		Location: K Supply From: M Mounting: R Enclosure: T	IS ECESSI			Volts: Phases: Wires:					-	/pe: MLO ing: 400 A	
		BREAKER TO BE I	PROVID	ED BY OW	/NER FRO	M RECEN	IT WAYNE	E HIGH SC	CHOOL RE	NOVATI	ON. AL	L OTHER BREAKERS NEEDE	D TC
СКТ		ption Trip	Poles		A		3		С	Poles	Trip	Circuit Description	(
	KE-21	60 A	3	14.67 kW	14.67 kW					3	60 A	KE-22	
3						14.67 kW	14.67 kW						
5				40.50.134/	40.50 114			14.67 kW	14.67 kW				
7	KE-23	40 A	3	10.50 KVV	10.50 kW		10.50 kW			3		KE-24	
11						10.50 KVV	10.50 KVV		10.50 kW				
	KE-35	90 A	3	22.63 kW	22.63 kW			10.50 KVV	10.50 KVV	3		KE-36	
15				22.00 101		22.63 kW	22.63 kW						
17									22.63 kW				
19	KE-38	40 A	3	7.47 kW	6.00 kW					3	20 A	KE-54	
21						7.47 kW	6.00 kW						
23								7.47 kW	6.00 kW				
	KE-55	20 A	3	6.00 kW	14.31 kW					3	50 A	KE-68	
27						6.00 kW	14.31 kW						
29								6.00 kW	14.31 kW				
	KE-69	20 A	3	4.35 kW	7.47 kW	4.05.1144	- 4-114			3		KE-38	
33						4.35 KW	7.47 kW	4.05.134/	7.471384				
35 37	 KE-39	 40 A	3	7.47 kW	7.47 kW			4.35 kW	7.47 kW	3	40 A	 KE-39	
39				7.47 KVV	7.47 KVV	7 17 KM	7.47 kW				40 A		
41						7.47 KVV	7.47 KVV	7.47 kW	7.47 kW				
	KE-40	40 A	3	7 47 kW	7.47 kW			7.47 KVV	7.47 KVV	3		KE-40	
45				7.17 100	7.17 KVV	7.47 kW	7.47 kW						
47								7.47 kW	7.47 kW				
49													
51													
53													
55													
57													
59			<u> </u>										
			al Load:		06 kW		06 kW		06 kW				
ا ممما	I Classification	Connected L	I Amps:		8 A mand Fac		8 A Estimata	b1 Demand	8 A			Panel Totals	
	HEN EQUIP	513.18 kV		De	65.00%	tor	333.5					Pariei Totais	
11110	TIEN EQUI	010.10 KV			00.0070		333.5	77 KVV		т	otal Co	onn. Load: 513.18 kW	
												t. Demand: 333.57 kW	
												n. Current: 617 A	
									Tot			d Current: 401 A	

Branch Panel: K

	Supply Mou Encl	cation: B From: M Inting: S osure: T	ICC-4 URFACE	ROOM F42		Volts Phases Wires					-	rpe: MCB ng: 200 A	
Note PAN	PS: EL D1-3L IS AN EXISTING TO F	REMAIN F	PANEL. I	BREAKER	S NEEDEI	D FOR NE	EW CIRCU	ITS TO BE	PROVIDE	ED BY E	C.		
СКТ	Circuit Description	Trip	Poles		4		В		C	Poles	Trip	Circ	uit Description
1	20A EXISTING SPARE		1	0.00 kW	<u> </u>					3			ING CIRCUIT
3	20A EXISTING SPARE		1			0.00 kW							
5	20A EXISTING CIRCUIT		3										
7										3		40A EXIST	ING CIRCUIT
9													
11	20A EXISTING SPARE		1					0.00 kW					
13	DOAS-1	80 A	3	16.39 kW	16.39 kW					3	80 A	DOAS-2	
15						16.39 kV	/ 16.39 kW						
17								16.39 kW	16.39 kW				
19	AHU-F4	20 A	3	1.88 kW	0.00 kW					1		20A EXIST	ING SPARE
21						1.88 kW	0.00 kW			1		20A EXIST	ING SPARE
23								1.88 kW	0.00 kW	1		20A EXIST	ING SPARE
25	20A EXISTING SPARE		1	0.00 kW	0.00 kW					1		20A EXIST	ING SPARE
27	20A EXISTING SPARE		1			0.00 kW	0.00 kW			1			ING SPARE
29	20A EXISTING SPARE		1					0.00 kW	0.00 kW	1			ING SPARE
31	20A EXISTING SPARE		1	0.00 kW	0.00 kW					1			ING SPARE
33	20A EXISTING SPARE		1			0.00 kW	0.00 kW			1			ING SPARE
35	20A EXISTING SPARE		1					0.00 kW	0.00 kW	1			ING SPARE
37	20A EXISTING SPARE		1	0.00 kW	0.00 kW					1			ING SPARE
39	20A EXISTING SPARE		1			0.00 kW	0.00 kW			1			ING SPARE
41	20A EXISTING SPARE		1					0.00 kW		1		20A EXIST	ING SPARE
			al Load:	34.66			66 kW		6 kW				
_			I Amps:		5 A		25 A		5 A				_
		nected L		Dei	mand Fac			d Demand				Panel Tot	als
HVA	C	103.97 kV	V		100.00%		103.9	97 kW					400.07.134
													103.97 kW
													103.97 kW
									T			n. Current:	
									10	iai EST. L	Jeman	d Current:	125 A

		Supply Fr	om: M ing: S	ICC-4 URFACE	OOM F42		Volts: Phases: Wires:					-	/pe: MCB ing: 200 A	
Note PAN	S: EL D1-3L IS AN EXIS	TING TO RE	MAIN F	PANEL. E	BREAKER	S NEEDEI	FOR NE	W CIRCUI	ТЅ ТО ВЕ	PROVIDE	D BY E	C.		
CKT	Circuit Descr	intion	Trip	Poles		4		В		С	Poles	Trip	Circuit Description	СКТ
	20A EXISTING SPA	-		1	0.00 kW	- -			'		3		40A EXISTING CIRCUIT	2
	20A EXISTING SPA			1	U.UU KVV		0.00 kW							4
<u> </u>	20A EXISTING SPA			3			0.00 KVV							6
7		7011									3		40A EXISTING CIRCUIT	8
9														10
	20A EXISTING SPA	DE .		1					0.00 kW					12
	DOAS-1		80 A	3	16 30 k\//	16.39 kW			0.00 KVV		3		DOAS-2	14
15					10.55 KVV	10.00 KVV	16 30 kW	16.39 kW						16
17	_						10.55 KVV	10.55 KVV		16.39 kW				18
	AHU-F4		20 A	3	1.88 kW	0.00 kW			10.00 KVV	10.00 KW	1		20A EXISTING SPARE	20
21					1.00 KVV	0.00 KVV	1 88 kW	0.00 kW			1		20A EXISTING SPARE	22
23							1.00 KVV	0.00 KVV	1.88 kW	0.00 kW	1		20A EXISTING SPARE	24
	20A EXISTING SPA	RF		1	0.00 kW	0.00 kW			1.00 KVV	0.00 KVV	1		20A EXISTING SPARE	26
	20A EXISTING SPA			1	0.00 KVV	0.00 KVV	0 00 kW	0.00 kW			1		20A EXISTING SPARE	28
29	20A EXISTING SPA			1			0.00 KVV	0.00 KVV	0.00 kW	0.00 kW	1		20A EXISTING SPARE	30
	20A EXISTING SPA			1	0.00 kW	0.00 kW			0.00 100	0.00 KVV	1		20A EXISTING SPARE	32
	20A EXISTING SPA			1	0.00 KVV	0.00 KW	0.00 kW	0.00 kW			1		20A EXISTING SPARE	34
	20A EXISTING SPA			1			0.00	0.00	0.00 kW	0.00 kW	1		20A EXISTING SPARE	36
	20A EXISTING SPA			1	0.00 kW	0.00 kW			0.00 100	0.00 1111	1		20A EXISTING SPARE	38
	20A EXISTING SPA			1			0 00 kW	0.00 kW			1		20A EXISTING SPARE	40
	20A EXISTING SPA			1			0.00	0.00	0 00 kW	0.00 kW	1		20A EXISTING SPARE	42
	20/(2/(0/11/0/01//		Tota	al Load:	34.6	⊥ 6 kW	34.6	6 kW		6 kW	•		20,12,110,11110,01,71112	
				l Amps:		5 A		5 A		5 A	J			
Load	l Classification	Conne		-		mand Fac		Estimated					Panel Totals	
HVA	C	103	3.97 kV	V		100.00%		103.9	7 kW					
											Т	otal Co	onn. Load: 103.97 kW	
											То	tal Est	:. Demand: 103.97 kW	
											Tota	al Coni	n. Current: 125 A	
										Tot	al Est. [Deman	d Current: 125 A	

		Loca Supply F Moun	rom : 7	ECESSE			Volts: Phases: Wires:	-			Mains Type: MLO Mains Rating: 100 A				
Note PAN	es: EL D1-1P IS AN EXIS	TING TO RI	EMAIN F	PANEL.	SPACES 1	4 AND 29-	-33 HAVE	EXISTING	6 120V/1P	20A BREA	KERS T	O BE F	REUSED.		
СКТ	Circuit Descr	intion	Trip	Poles	A	\		В		С	Poles	Trip	Circ	uit Description	CI
1	20A EXISTING			1	0.00 kW		-	_			1		20A EXIST		2
3	20A EXISTING			1			0.00 kW	0.00 kW			1		20A EXIST	ING	
5	20A EXISTING			1					0.00 kW	0.00 kW	1		20A EXIST	ING	6
7	20A EXISTING			1	0.00 kW	0.00 kW					1		20A EXIST	ING	8
9	20A EXISTING			1			0.00 kW	0.00 kW			1		20A EXIST	ING	1
11	20A EXISTING			1					0.00 kW	-	1		20A EXIST	ING	1
	20A EXISTING			1		1.44 kW					1	20 A	RCPT DIN		1
15	20A EXISTING			1							1		20A EXIST		1
17	20A EXISTING			1							1		20A EXIST		1
19	20A EXISTING			2							1		20A EXIST		2
21											1		20A EXIST		2:
23	20A EXISTING			1							1		20A EXIST		2
25 27	20A EXISTING 20A EXISTING			1							2		20A EXIST		2
29	RCPT DINING F100		20 A	1					1.26 kW				JUA EXIS	ING	3
31	RCPT DINING F100		20 A	1	1.26 kW	0.86 kW			1.20 KVV		1		PROJECT	OR	3:
	RCPT ROOM F100,	F39	20 A	1	1.20 KVV	0.00 KVV	0.72 kW	0.68 kW			1		OVERHEA		3
	RCPT DINING ROOF		20 A	1			0.72 KVV	0.00 100	0.36 kW	1.80 kW	1		RCPT DIN		3
	RCPT ROOM F38, F		20 A	1	0.90 kW	0.00 kW					1		20A SPAR		3
	20A SPARE	<u>- </u>		1			0.00 kW	0.00 kW			1		20A SPAR		4
41	20A SPARE			1					0.00 kW	0.00 kW	1		20A SPAR	 E	4:
			Tota	al Load:	4.46	kW	1.40	kW	3.42	2 kW					
			Total	Amps:	40	Α	12	2 A	3′	1 A	1				
Load	d Classification	Conn	ected L	.oad	Dei	mand Fac	tor	Estimated	d Demand				Panel Tot	als	
POV		1	.00 kW			100.00%		1.00	kW						
RCP	Т	8	3.28 kW			100.00%		8.28	kW				onn. Load:		
													. Demand:		
										_			n. Current: d Current:		
													-1 0	A	

	Branc							100/005							
		Supply Fi	rom: 4l ting: R	ECESSE			Volts: Phases: Wires:					_	ype: MLO ing: 225 A		
	s: EL D1-5P IS AN EXIS VIDED BY EC.	STING TO RE	EMAIN I	PANEL.	SPACES 1	3-42 HAV	E EXISTII	NG 120V/1	P 20A BRE	AKERS T	O BE RE	EUSEC), OTHER BI	REAKERS NEEDEI	D TO BE
CKT	Circuit Desci	ription	Trip	Poles		A		В		:	Poles	Trip	Circ	uit Description	СКТ
1	20A EXISTING CIRC	CUIT		1							1		20A EXIST	ING CIRCUIT	2
3	20A EXISTING CIRC	CUIT		1							1		20A EXIST	ING CIRCUIT	4
5	20A EXISTING CIRC	CUIT		1							1		20A EXIST	ING CIRCUIT	6
7	20A EXISTING CIRC	CUIT		1							1		20A EXIST	ING CIRCUIT	8
9	20A EXISTING CIRC	CUIT		1							1		20A EXIST	ING CIRCUIT	10
11	20A EXISTING CIRC	CUIT		1							1		20A EXIST	ING CIRCUIT	12
13	KE-154		20 A	1	0.60 kW	1.26 kW					1	20 A	RCPT ROO	OM F40	14
15	RCPT SERVING F4	0	20 A	1			0.36 kW	0.18 kW			1	20 A	RCPT TES	T KITCHEN F1	16
17	OVERHEAD DOOR		20 A	1					0.68 kW	0.86 kW	1	20 A	PROJECTO	OR	18
19	RCPT CONFERENCE	E F4	20 A	1	1.08 kW	1.14 kW					1	20 A	KE-151		20
21	KE-156		20 A	1			1.20 kW	1.73 kW			1	20 A	KE-80		22
23	KE-88		20 A	1					1.31 kW	1.92 kW	1	20 A	KE-162		24
25	KE-91		20 A	1	1.74 kW	1.50 kW					2	20 A	KE-159		26
27	KE-153B		20 A	2			1.60 kW	1.50 kW							28
29	~~~~~~			~~~			~~~		1.60 kW	0.68 kW	1	20 A	OVERHEA	D DOOR	30
31	KE-163	* 	50 A	2	4.65 kW	1.92 kW	Y - Y -	3			1	20 A	KE-163		32
33							4.65 kW	1.98 kW			1	20 A	KE-158		34
35	KE-163		20 A	\sim_1	\sim				1.92 kW	1.98 kW	1	20 A	KE-158		36
37	KE-158		20 A	1	1.98 kW	2.50 kW					3	30 A	KE-153A		38
39	KE-83		20 A	1			2.10 kW	2.50 kW							40
	KE-84		20 A						1.22 kW	2.50 kW					42
	<u> </u>			Load:	18.3	7 kW	17.8	BO kW	14.67			1	1		
				l Amps:		7 A		52 A	122		1				
Load	Classification	Conn	ected L			mand Fac			d Demand				Panel Tot	als	
	HEN EQUIP	38	3.90 kW	1		65.00%			9 kW		raner rotars				
POW	'ER		.50 kW			100.00%		1.50	kW		T	otal C	onn. Load:	50.84 kW	
RCP	Т	5	.04 kW			100.00%		5.04	kW		То	tal Est	t. Demand:	37.23 kW	
HVA	2	5	.40 kW			100.00%		5.40	kW		Tota	al Con	n. Current:	141 A	
										To	tal Est. [Deman	nd Current:	103 A	
										1					

Nata		Supply Fro	om: 41 ing: R	ECESSE			Volts: Phases: Wires:					-	vpe: MLO ing: 225 A		
	s: EL D1-6P IS AN EXIS DED TO BE PROVIDI		MAIN I	PANEL.	SPACES 1	6-22 AND	27 HAVE	EXISTING	9 120V/1P	20A BREA	KERS T	O BE F	REUSED, O	OTHER BREAKER Cuit Description TING CIRCUIT TING CIRCUIT	
СКТ	Circuit Descr	iption	Trip	Poles	A			В		С	Poles	Trip	Circ	uit Description	СК
	20A EXISTING CIRC	•		1							1			•	2
	20A EXISTING CIRC	_		1							1				4
	20A EXISTING CIRC			1							1			ING CIRCUIT	6
	20A EXISTING CIRC			1							1			ING CIRCUIT	8
	20A EXISTING CIRC			1							1			ING CIRCUIT	10
	20A EXISTING CIRC			1							1			ING CIRCUIT	12
13	20A EXISTING CIRC	CUIT		1							1		20A EXIST	ING CIRCUIT	14
15	20A EXISTING CIRC	CUIT		1				0.18 kW			1	20 A		GUIDANCE F2	16
17	RCPT ROOM F1		20 A	1					1.08 kW	0.90 kW	1	20 A	RCPT RO	OM F1B, F1A	18
	RCPT CAFE SEATIN	NG F1A	20 A	1	1.26 kW	0.68 kW					1		OVERHEA	· · · · · · · · · · · · · · · · · · ·	20
24	OVERHEAD DOOR		20_A	-4-0	\-O-O-	0-0-0	0.68 kW	0.54 kW	0-0-0		~ 1	20 A	RCRIRO	DM E100	~~~2/
Y -	KEF-6		20 A	2	, , , ,	rr	r r	rrr	0.54 kW	0.72 kW	2	Y -	MAU-1		24
25					0.54 kW	0.72 kW									20
27	HOOD-6		20 A	1 .			0.20 kW	0.68 kW			. 1.	20 A	OVERHEA	D DOOR	. 28
29	20A EXISTING SPAI	RE	سيىر				-		0.00 KW	0.00 kW	\sim_1	٠٠	20A EXIST	ING SPARE	$\frac{1}{3}$
31	20A EXISTING SPAI	RE		1	0.00 kW	0.00 kW					1		20A EXIST	ING SPARE	32
33	20A EXISTING SPAI	RE		1			0.00 kW	0.00 kW			1		20A EXIST	ING SPARE	34
35	20A EXISTING SPAI	RE		1					0.00 kW	0.00 kW	1		20A EXIST	ING SPARE	36
37	20A EXISTING SPAI	RE		1	0.00 kW	0.00 kW					1		20A EXIST	ING SPARE	38
39	20A EXISTING SPAI	RE		1			0.00 kW	0.00 kW			1		20A EXIST	ING SPARE	40
41	20A EXISTING SPAI	RE		1					0.00 kW	0.00 kW	1		20A EXIST	ING SPARE	42
			Tota	al Load:	3.20	kW	2.28	3 kW	3.2	4 kW		-	1		
			Total	l Amps:	28	Α	19	9 A	2	8 A					
Load	l Classification	Conne	cted L	oad.	Dei	mand Fac	tor	Estimated	d Demand	I			Panel Tot	als	
POW	'ER	1.9	50 kW			100.00%		1.50	kW						
RCP	Т	4.5	50 kW			100.00%		4.50	kW		Т	otal Co	onn. Load:	8.72 kW	
HVA	C	2.	72 kW			100.00%		2.72	2 kW		To	tal Est	. Demand:	8.72 kW	
											Tota	al Coni	n. Current:	24 A	
										1			d Current:		

		Supply Fro Mounti Enclosu	ng: R	ECESSE	′ G10 :D		Phases Wires					-	vpe: MLO ing: 225 A		
Note PAN	S: EL A1-5P IS AN EXIS	TING TO REI	MAIN F	PANEL. S	SPACES 2	9-33 HAVI	E EXISTII	NG 120V/1	P 20A BRI	EAKERS T	O BE RE	EUSED			
CKT	Circuit Descri	iption	Trip	Poles	Į.	1		В		С	Poles	Trip	Circ	uit Description	CK.
1	20A EXISTING CIRC	-		1							1			ING CIRCUIT	2
3	20A EXISTING CIRC	UIT		1							1		20A EXIST	ING CIRCUIT	4
5	20A EXISTING CIRC			1							1			ING CIRCUIT	6
7	20A EXISTING CIRC			1							2			ING CIRCUIT	8
9	20A EXISTING CIRC	_		1											10
	20A EXISTING CIRC			1							1			ING CIRCUIT	12
	20A EXISTING CIRC			1							1			ING CIRCUIT	14
	20A EXISTING CIRC			1							1			ING CIRCUIT	16
	20A EXISTING CIRC			1							3			ING CIRCUIT	18
	20A EXISTING CIRC			1										1110 01110011	20
	20A EXISTING CIRC			1											22
	20A EXISTING CIRC			1							1		200 EXIST	ING CIRCUIT	24
	20A EXISTING CIRC			1							1			ING CIRCUIT	26
	20A EXISTING CIRC			1							1			ING CIRCUIT	28
	RCPT STORAGE G4		20 A	1					0.72 kW		1			ING CIRCUIT	30
	RCPT STORAGE G4		20 A	1	0.36 kW	0.54 kW			0.72 KVV		1	20 A	-		32
	RCPT STORAGE G4		20 A	1	U.30 KVV	U.34 KVV	0.72 kW	0.00 kW			1			ING SPARE	34
				-			0.72 KVV	0.00 KVV	0.00 1944	0.00 kW	-				
	20A EXISTING SPAR			1	0.00 1/1/	0.00 kW			0.00 kW	U.UU KVV	1			ING SPARE	36 38
	20A EXISTING SPA			1	0.00 KVV	0.00 KVV	0.00.134				1			ING SPARE	
	20A EXISTING SPAR			1			0.00 kW	0.00 kW			1			ING SPARE	40
	20A EXISTING SPAR			1					0.00 kW	0.00 kW	1			ING SPARE	42
	20A EXISTING SPAR			1	0.00 kW	0.00 kW					1			ING SPARE	44
	20A EXISTING SPAR			1			0.00 kW	0.00 kW			1			ING SPARE	46
	20A EXISTING SPAR			1					0.00 kW	0.00 kW	1			ING SPARE	48
	20A EXISTING SPAR			1	0.00 kW	0.00 kW	_				1			ING SPARE	50
	20A EXISTING SPAR			1			0.00 kW	0.00 kW			1			ING SPARE	52
	20A EXISTING SPAR			1					0.00 kW	0.00 kW	1			ING SPARE	54
	20A EXISTING SPAR			1	0.00 kW	0.00 kW					1			ING SPARE	56
	20A EXISTING SPAR			1			0.00 kW	0.00 kW			1			ING SPARE	58
59	20A EXISTING SPAR	RE		1					0.00 kW		1		20A EXIST	ING SPARE	60
				l Load:	0.90			2 kW		2 kW					
				Amps:	8			6 A		Α					
	d Classification	Conne		.oad	Dei	mand Fac	tor	Estimated					Panel Tot	als	
RCP	Т	2.3	34 kW			100.00%		2.34	kW						
													onn. Load:		
													. Demand:		
											Tota	al Con	n. Current:	6 A	
_				_						Tot	I Eat E	3 0mon	d Current:	6 4	_

									D	14 1	ما. Г	h Dan	Drana	
												h Pan	Branc	
Mains Type: MLO Mains Rating: 225 A						: 120/208)	_EC F39				
	-	-					Phases Wires		-D			Supply F		
	ilg. 220 A	is Kali	IVIAIII			. 4	vvires		טב	ECESSE /DE 1	ung. N			
											ouic. I	Lilolos		
													es:	Note
20A/1P	ACES 10-42 HAVE EXISTING 2	IN. SP	O REMA	RCUITS T	ISTING CIF									
						EC.	IDED BY	BE PROV	EEDED TO	(ERS NE	BREAK	SED, OTHER	EAKERS TO BE REUS	BRE.
01/7	Oliverald December 1 av	Tuin	Dalaa			D				Dalaa	Tain		Olassalt Danas	OL/T
CKT 2	Circuit Description 20A EXISTING CIRCUIT	Trip	Poles	•	С	В		0.00 kW	<i>P</i>	Poles 1	Trip		Circuit Desci	CKT
4	20A EXISTING CIRCUIT		1			0.00 kW		0.00 KVV		1			20A EXISTING CIRC	
6	20A EXISTING CIRCUIT		1			0.00 KVV				1			20A EXISTING CIRC	
8	20A EXISTING CIRCUIT		1							1			20A EXISTING CIRC	7
10	KE-136		1			0.12 kW				1			20A EXISTING CIRC	
12	KE-84		1	1.22 kW	0.18 kW	0.12 100				1	20 A		RCPT DINING ROO	
14	DRYER		2					1.44 kW	0.12 kW	1	20 A			
16						1.44 kW	1.92 kW		4 11 2 1111	1	20 A		WASHER	
18	RCPT SERVING F40	20 A	1	0.36 kW	0.36 kW					1	20 A		RCPT	17
20	KE-117	20 A	1					1.56 kW	5.43 kW	3	50 A		KE-89	19
22	KE-131	20 A	2			0.43 kW	5.43 kW							21
24				0.43 kW	5.43 kW									23
26	RCPT	20 A	1					0.36 kW	2.10 kW	1	20 A		KE-83	25
28	KE-120	20 A	2			0.83 kW	0.36 kW			1	20 A	0	RCPT SERVING F4	27
30				0.83 kW	0.43 kW					2	20 A		KE-135	
32	KE-120	20 A	2					0.83 kW	0.43 kW					31
34						0.83 kW	1.00 kW			2	20 A		KE-130	
36	KE-134	20 A	2	1.00 kW	1.00 kW									
38								1.00 kW	5.43 kW	3	50 A		KE-89	
40	KE-117		1	. =	- 101111	0.88 kW	5.43 kW							
42	KE-78	20 A	1		5.43 kW		40.4		40.76					41
					18.40 153	66 kW			18.70 156	l Load:				
	Panel Totals			A		56 A Estimate		mand Fac		Amps:	ected L	Conn	d Classification	020
	Failer Totals					31.72	LOI	65.00%	Dei		8.80 kW	-	CHEN EQUIP	
	onn. Load: 55.76 kW	otal Co	To			6.96		100.00%			5.96 kW			RCP
	. Demand: 38.68 kW					0.00		. 5 5 . 5 6 7 6					-	
	n. Current: 155 A													
			al Est. D									1		

PANEL SCHEDULES

No. 11400779

All concepts, ideas, designs, plans and details as shown on this document are the sole property of Design Collaborative, Inc., and shall not be used for any purpose without their expressed written consent. The owner shall be permitted to

BID SET

ISSUE DATE: 9/13/2024

REVISIONS

1 10/24/2024 ADD-2 2 11/04/2024 ADD-3

retain copies for information and reference.

	LIGHT FIXTURE SCHEDULE									
LIGHT FIXTURES SHALL BE AS SCHEDULED OR APPROVED EQUAL (FIXTURE F8) 10 DAYS PRIOR TO BID.										
MARK	MANUFACTURER	MODEL NO.	REMARKS							
EX	MULE LIGHTING	MXARU-SD	UNIVERSAL MOUNT EXIT SIGN. REFER TO PLANS FOR FACES / DIRECTIONAL ARROWS.							
F1	HE WILLIAMS	LT-24-L64/840-AF-DIM1-UNV	2X4 LED LAY-IN, 277V, 0-10V DIMMING, DIMMABLE TO 1%. SEE F1-E FIXTURES ON DEMOLITION PLANS FOR QUANTITIES OF REUSABLE EXISTING FIXTURES.							
F2	HE WILLIAMS	LT-22-L49/840-AF-DIM1-UNV	2X2 LED LAY-IN, 277V, 0-10V DIMMING, DIMMABLE TO 1%. SEE F2-E FIXTURES ON DEMOLITION PLANS FOR QUANTITIES OF REUSABLE EXISTING FIXTURES.							
F3	HE WILLIAMS	6DR-TL-L30-840-DIM1-UNV-OW-OF-CS-MWT-N-F1	6" RECESSED DOWNLIGHT, 277V, 0-10V DIMMING, DIMMABLE TO 1%. SEE F3-E FIXTURES ON DEMOLITION PLANS FOR QUANTITIES OF REUSABLE EXISTING FIXTURES.							
F4	HE WILLIAMS	75R-4-L50/840-(2)VBY-5/PWU-DIM-UNV	CHAIN HUNG INDUSTRIAL STYLE LED SHOP LIGHT WITH LENS. 4 FEET LONG. SEE F4-E FIXTURES ON DEMOLITION PLANS FOR QUANTITIES OF REUSABLE EXISTING FIXTURES.							
F5	ALW LIGHTING	RPD04/HP-6-4000-0/10V/S-BA-UNV1%	CYLINDRICAL PENDANT, 6' LONG, MOUNTED AT VARYING ANGLES FROM CEILING ABOVE. POWER OVER AIRCRAFT CABLE. APPROXIMATELY 650 LUMENS PER FOOT. DIMMING DRIVER 0-10V, DIMMABLE TO 1%. SEE F5-E FIXTURES ON DEMOLITION PLANS FOR QUANTITIES OF REUSABLE EXISTING FIXTURES.							
F6A	ALW LIGHTING	LP3.5RT-TGRID-S4-CSTM1500-80/4000-0/10V/S-EXT-N-N-N-N-SW-UNV	4" WIDE RECESSED LINEAR FIXTURE. APPROXIMATELY 1500 LUMENS PER FOOT. 0-10V DIMMING, DIMMABLE TO 1%. PROVIDE MITRED CORNERS AS SHOWN ON PLANS. 4 FOOT LENGTH WITH GRID MOUNTING.							
F6B	ALW LIGHTING	LP3.5RT-TGRID-S8-HI-80/4000-0/10V/S-EXT-N-N-N-SW-UNV	4" WIDE RECESSED LINEAR FIXTURE. APPROXIMATELY 1000 LUMENS PER FOOT. 0-10V DIMMING, DIMMABLE TO 1%. PROVIDE MITRED CORNERS AS SHOWN ON PLANS. 8 FOOT LENGTH WITH GRID MOUNTING.							
F6C	ALW LIGHTING	LP3.5RT-TGRID-S8'8"-HI-80/4000-0/10V/S-EXT-N-N-N-N-SW-UNV	4" WIDE RECESSED LINEAR FIXTURE. APPROXIMATELY 1000 LUMENS PER FOOT. 0-10V DIMMING, DIMMABLE TO 1%. PROVIDE MITRED CORNERS AS SHOWN ON PLANS. 8 FOOT 8 INCH LENGTH WITH GRID MOUNTING TO ALLOW FOR EVEN RECTANGULAR MITERING.							
F6D	ALW LIGHTING	LP3.5RT-DRY-S6-HI-80/4000-0/10V/S-EXT-N-N-N-N-SW-UNV	4" WIDE RECESSED LINEAR FIXTURE. APPROXIMATELY 1000 LUMENS PER FOOT. 0-10V DIMMING, DIMMABLE TO 1%. PROVIDE MITRED CORNERS AS SHOWN ON PLANS. 6 FOOT LENGTH WITH DRYWALL MOUNTING.							
F7A	ALW LIGHTING	LP1SD-S5-LOW/80/4000-0/10V/S-EXT/F-N-N-N-N-SB-UNV	SUSPENDED LINEAR 1" WIDE BY 5' LONG LENSED PENDANT. APPROXIMATELY 300 LUMENS PER FOOT. BLACK FINISH, CORD, AND CANOPY. SUSPEND BOTTOM OF FIXTURE IN LINE WITH BOTTOM OF ADJACENT WOODEN PANELS.							
F7B	ALW LIGHTING	LP1SD-S4-HI/80/4000-0/10V/S-EXT/F-N-N-N-SB-UNV	SUSPENDED LINEAR 1" WIDE BY 4' LONG LENSED PENDANT. APPROXIMATELY 500 LUMENS PER FOOT. BLACK FINISH, CORD, AND CANOPY. SUSPEND BOTTOM OF FIXTURE IN LINE WITH BOTTOM OF ADJACENT WOODEN SLATS.							
F7C	ALW LIGHTING	LP3.5SD-S8-MED/80/4000-0/10V/S-EXT/F-N-N-N-SB-UNV	SUSPENDED LINEAR 4" WIDE BY 8' LONG LENSED PENDANT. APPROXIMATELY 1000 LUMENS PER FOOT. BLACK FINISH, CORD, AND CANOPY. SUSPEND BOTTOM OF FIXTURE IN LINE WITH BOTTOM OF ADJACENT CEILING CLOUDS.							
² F8	ALW LIGHTING CAMMAN LIGHTING FINELITE PRUDENTIAL LIGHTING	MR3-D2-CM-MIN-80/4000K-V05-LENS-N-N-N-RAL7001-UNV-N-N C1044-24-40K-CLV-MV-WM-RAL7001 HP-4C-SM-D-2'-S-840-F-96LG-277-SC-FC-1%-RAL7001 O-20-LED4-MO-FWA-YRG-D1-SC-UNV-SUR-X3-DM01	2' DIAMETER SURFACE-MOUNT RING. APPROXIMATELY 2500 LUMENS. 0-10V DIMMING, DIMMABLE TO 1%. GRAY FINISH.							


AAD!	DECORIDE	\/A! T	DUAGE	1045			QUIPMENT SCH		AALIIFLITA
WARK KE-14	DESCRIPTION VEGETABLE PREP WORKTABLE	VOLTAGE 120 V	PHASE 1	LOAD 1.92 kW	PANEL D1-2P	CIRCUIT 34	WIRE SIZE #12, #12 G. IN 3/4" C.	DIRECT	COMMENTS STUB UP TO JUNCTION BOX ON UNDERSIDE OF ISLAND WORKTABLE
KE-14	VEGETABLE PREP WORKTABLE	120 V	1	1.92 kW	D1-2P	13	#12, #12 G. IN 3/4" C.	DIRECT	STUB UP TO JUNCTION BOX ON UNDERSIDE OF ISLAND WORKTABLE
	VEGETABLE PREP WORKTABLE COUNTERTOP DIGITAL SCALE	208 V 120 V	1	4.99 kW 0.18 kW	D1-2P PLUG	47,49 PLUG	#10, #10 G. IN 3/4" C. #12, #12 G. IN 3/4" C.	DIRECT 5-20P	STUB UP TO JUNCTION BOX ON UNDERSIDE OF ISLAND WORKTABLE CONNECT TO ANY CONVENIENCE RECEPTACLE OR POWERED WORKTABLE
	COUNTERTOP DIGITAL SCALE	120 V	1	0.18 kW	PLUG	PLUG	#12, #12 G. IN 3/4" C.	5-20P	CONNECT TO ANY CONVENIENCE RECEPTACLE OR POWERED WORKTABLE
	ELECTRIC CAN OPENER ELECTRIC CAN OPENER	120 V 120 V	1	0.18 kW 0.18 kW	PLUG PLUG	PLUG PLUG	#12, #12 G. IN 3/4" C. #12, #12 G. IN 3/4" C.	5-20P 5-20P	CONNECT TO ANY CONVENIENCE RECEPTACLE OR POWERED WORKTABLE CONNECT TO ANY CONVENIENCE RECEPTACLE OR POWERED WORKTABLE
	FORTY GALLON TILTING SKILLET	480 V	3	44.00 kW	K	1,3,5	#4, #8 G. IN 1 1/4" C.	DIRECT	EXTEND TO EQUIPMENT THROUGH SHUNT TRIP CIRCUIT BREAKER
	FORTY GALLON TILTING SKILLET TEN PAN CONVECTION STEAMER	480 V 480 V	3	44.00 kW 31.50 kW	K	2,4,6 7,9,11	#4, #8 G. IN 1 1/4" C. #8, #10 G. IN 3/4" C.	DIRECT	EXTEND TO EQUIPMENT THROUGH SHUNT TRIP CIRCUIT BREAKER EXTEND TO EQUIPMENT THROUGH SHUNT TRIP CIRCUIT BREAKER
	TEN PAN CONVECTION STEAMER	480 V	3	31.50 kW	K	8,10,12	#8, #10 G. IN 3/4" C.	DIRECT	EXTEND TO EQUIPMENT THROUGH SHUNT TRIP CIRCUIT BREAKER
	UNDERCOUNTER NUGGET ICE MAKER KITCHEN PREP WORKTABLE	120 V 120 V	1	1.44 kW 1.92 kW	D1-2P D1-2P	7 23	#12, #12 G. IN 3/4" C. #12, #12 G. IN 3/4" C.	DIRECT	STUB UP TO JUNCTION BOX ON UNDERSIDE OF ISLAND WORKTABLE STUB UP TO JUNCTION BOX ON UNDERSIDE OF ISLAND WORKTABLE
	KITCHEN PREP WORKTABLE	120 V	1	1.92 kW	D1-2P	19	#12, #12 G. IN 3/4" C.	DIRECT	STUB UP TO JUNCTION BOX ON UNDERSIDE OF ISLAND WORKTABLE
	KITCHEN PREP WORKTABLE KITCHEN PREP WORKTABLE	208 V 120 V	1	4.99 kW 1.92 kW	D1-2P D1-2P	52,54 12	#10, #10 G. IN 3/4" C. #12, #12 G. IN 3/4" C.	DIRECT	STUB UP TO JUNCTION BOX ON UNDERSIDE OF ISLAND WORKTABLE STUB UP TO JUNCTION BOX ON UNDERSIDE OF ISLAND WORKTABLE
KE-31	KITCHEN PREP WORKTABLE	120 V	1	1.92 kW	D1-2P	17	#12, #12 G. IN 3/4" C.	DIRECT	STUB UP TO JUNCTION BOX ON UNDERSIDE OF ISLAND WORKTABLE
	KITCHEN PREP WORKTABLE COMBI OVEN / STEAMER (ROLL-IN)	208 V 480 V	3	4.99 kW 67.90 kW	D1-2P K	51,53 13,15,17	#10, #10 G. IN 3/4" C. #3, #8 G. IN 1 1/4" C.	DIRECT	STUB UP TO JUNCTION BOX ON UNDERSIDE OF ISLAND WORKTABLE EXTEND TO EQUIPMENT THROUGH UTILITY DISTRIBUTION SYSTEM (KE-32) AND SHUNT TRIP CIRCUIT BREAKER
KE-36	COMBI OVEN / STEAMER (ROLL-IN)	480 V	3	67.90 kW	K	14,16,18	#3, #8 G. IN 1 1/4" C.	DIRECT	EXTEND TO EQUIPMENT THROUGH UTILITY DISTRIBUTION SYSTEM (KE-32) AND SHUNT TRIP CIRCUIT BREAKER
	REACH-IN BLAST CHILLER COMBI OVEN / STEAMER	208 V 480 V	3	9.51 kW 22.40 kW	D1-2P K	29,31,33 19,21,23	#8, #10 G. IN 3/4" C. #8, #10 G. IN 3/4" C.	DIRECT	EXTEND TO EQUIPMENT THROUGH UTILITY DISTRIBUTION SYSTEM (KE-32) AND SHUNT TRIP CIRCUIT BREAKER EXTEND TO EQUIPMENT THROUGH UTILITY DISTRIBUTION SYSTEM (KE-32) AND SHUNT TRIP CIRCUIT BREAKER
KE-38	COMBI OVEN / STEAMER	480 V	3	22.40 kW	K	32,34,36	#8, #10 G. IN 3/4" C.	DIRECT	EXTEND TO EQUIPMENT THROUGH UTILITY DISTRIBUTION SYSTEM (KE-32) AND SHUNT TRIP CIRCUIT BREAKER
	COMBI OVEN / STEAMER COMBI OVEN / STEAMER	480 V 480 V	3	22.40 kW 22.40 kW	K	37,39,41 38,40,42	#8, #10 G. IN 3/4" C. #8, #10 G. IN 3/4" C.	DIRECT	EXTEND TO EQUIPMENT THROUGH UTILITY DISTRIBUTION SYSTEM (KE-32) AND SHUNT TRIP CIRCUIT BREAKER. EXTEND TO EQUIPMENT THROUGH UTILITY DISTRIBUTION SYSTEM (KE-32) AND SHUNT TRIP CIRCUIT BREAKER.
KE-40	COMBI OVEN / STEAMER	480 V	3	22.40 kW	K	43,45,47	#8, #10 G. IN 3/4" C.	DIRECT	EXTEND TO EQUIPMENT THROUGH UTILITY DISTRIBUTION SYSTEM (KE-32) AND SHUNT TRIP CIRCUIT BREAKER.
	COMBI OVEN / STEAMER TWO DOOR REACH-IN REFRIGERATOR	480 V 120 V	3	22.40 kW 1.55 kW	K D1-2P	44,46,48 32	#8, #10 G. IN 3/4" C. #12, #12 G. IN 3/4" C.	DIRECT 5-20P	EXTEND TO EQUIPMENT THROUGH UTILITY DISTRIBUTION SYSTEM (KE-32) AND SHUNT TRIP CIRCUIT BREAKER MOUNT RECEPTACLE ON WALL DIRECTLY ABOVE EQUIPMENT
	TWO DOOR REACH-IN REFRIGERATOR TWO DOOR REACH-IN REFRIGERATOR	120 V 120 V	1	1.55 kW	D1-2P	38	#12, #12 G. IN 3/4" C.	5-20P 5-20P	MOUNT RECEPTACLE ON WALL DIRECTLY ABOVE EQUIPMENT
	TWO DOOR REACH-IN FREEZER COUNTERTOP HOT WATER DISPENSER	120 V 208 V	1	2.05 kW	D1-2P	36 25.27	#12, #12 G. IN 3/4" C. #10, #10 G. IN 3/4" C.	5-20P 6-30P	MOUNT RECEPTACLE ON WALL DIRECTLY ABOVE EQUIPMENT MOUNT RECEPTACLE ON WALL ABOVE BACKSPLASH
	MOBILE PROOFER / HOLDING CABINET	208 V 120 V	1	5.00 kW 1.65 kW	D1-2P D1-2P	25,27 15	#10, #10 G. IN 3/4" C. #12, #12 G. IN 3/4" C.	6-30P 5-20P	MOUNT RECEPTACLE ON WALL DIRECTLY BEHIND EQUIPMENT
	SIXTY QUART FLOOR MIXER	208 V	3	7.21 kW	D1-2P	56,58,60	#12, #12 G. IN 3/4" C.	L15-20P	MOUNT RECEPTACLE ON WALL DIRECTLY BEHIND EQUIPMENT
	ROTATING RACK BAKERY OVEN ROTATING RACK BAKERY OVEN (CONTROLS)	480 V 120 V	3	18.00 kW 1.13 kW	K D1-3P	20,22,24	#10, #10 G. IN 3/4" C. #12, #12 G. IN 3/4" C.	DIRECT 5-20P	EXTEND TO EQUIPMENT THROUGH SHUNT TRIP CIRCUIT BREAKER EXTEND TO EQUIPMENT THROUGH SHUNT TRIP CIRCUIT BREAKER
KE-55	ROTATING RACK BAKERY OVEN	480 V	3	18.00 kW	K	25,27,29	#10, #10 G. IN 3/4" C.	DIRECT	EXTEND TO EQUIPMENT THROUGH SHUNT TRIP CIRCUIT BREAKER
	ROTATING RACK BAKERY OVEN (CONTROLS) DISHMACHINE W/ BOOSTER HEATER	120 V 480 V	3	1.13 kW 42.93 kW	D1-3P K	3 26,28,30	#12, #12 G. IN 3/4" C. #8, #10 G. IN 3/4" C.	5-20P DIRECT	EXTEND TO EQUIPMENT THROUGH SHUNT TRIP CIRCUIT BREAKER EXTEND TO EQUIPMENT THROUGH ELECTRICAL DISCONNECT
(E-69	DISHMACHINE BLOWER DRYER	480 V	3	13.05 kW	K	31,33,35	#12, #12 G. IN 3/4" C.	DIRECT	EXTEND TO EQUIPMENT THROUGH ELECTRICAL DISCONNECT
	THREE COMPARTMENT SINK (CONTROLS) SINGLE DOOR PASS-THRU HEATED CABINET	208 V 120 V	3	9.61 kW 1.56 kW	D1-2P D1-3P	55,57,59 42	#10, #10 G. IN 3/4" C. #12, #12 G. IN 3/4" C.	DIRECT 5-20P	EXTEND TO EQUIPMENT THROUGH KEC FURNISHED CONTROL PANEL MOUNT RECEPTACLE ON WALL DIRECTLY ABOVE EQUIPMENT
	SINGLE DOOR PASS-THRU HEATED CABINET	120 V	1	1.56 kW	D1-3P	11	#12, #12 G. IN 3/4" C.	5-20P	MOUNT RECEPTACLE ON WALL DIRECTLY ABOVE EQUIPMENT
	SINGLE DOOR PASS THRU HEATED CABINET	120 V	1	1.56 kW	D1-4P	42	#12, #12 G. IN 3/4" C.	5-20P	MOUNT RECEPTACLE ON WALL DIRECTLY ABOVE EQUIPMENT
	SINGLE DOOR PASS-THRU REFRIGERATOR SINGLE DOOR PASS-THRU REFRIGERATOR	120 V 120 V	1	0.88 kW 0.88 kW	D1-3P D1-3P	41	#12, #12 G. IN 3/4" C. #12, #12 G. IN 3/4" C.	5-20P 5-20P	MOUNT RECEPTACLE ON WALL DIRECTLY ABOVE EQUIPMENT MOUNT RECEPTACLE ON WALL DIRECTLY ABOVE EQUIPMENT
	SINGLE DOOR PASS-THRU REFRIGERATOR	120 V	1	0.88 kW	D1-3P	38	#12, #12 G. IN 3/4" C.	5-20P	MOUNT RECEPTACLE ON WALL DIRECTLY ABOVE EQUIPMENT
	TWO DOOR REACH-IN REFRIGERATOR OPEN AIR REFRIGERATED MERCHANDISER	120 V 208 V	1	1.55 kW 2.08 kW	D1-5P D1-3P	22 15,17	#12, #12 G. IN 3/4" C. #12, #12 G. IN 3/4" C.	5-20P DIRECT / 6-15P	MOUNT RECEPTACLE ON WALL DIRECTLY ABOVE EQUIPMENT STUB UP TO JUNCTION BOX ON UNDERSIDE OF SERVING COUNTER BASE
	OPEN AIR REFRIGERATED MERCHANDISER	208 V	1	2.08 kW	D1-3P	16,18	#12, #12 G. IN 3/4" C.	DIRECT / 6-15P	STUB UP TO JUNCTION BOX ON UNDERSIDE OF SERVING COUNTER BASE
	OPEN AIR REFRIGERATED MERCHANDISER OPEN AIR REFRIGERATED MERCHANDISER	120 V 120 V	1	1.92 kW 1.92 kW	D1-5P D1-4P	39 25	#12, #12 G. IN 3/4" C. #12, #12 G. IN 3/4" C.	5-20P 5-20P	MOUNT RECEPTACLE ON WALL DIRECTLY BEHIND EQUIPMENT MOUNT RECEPTACLE ON WALL DIRECTLY BEHIND EQUIPMENT
	GLASS DOOR FREEZER MERCHANDISER	120 V	1	1.04 kW	D1-41	41	#12, #12 G. IN 3/4" C.	5-20P	MOUNT RECEPTACLE ON WALL DIRECTLY BEHIND EQUIPMENT
	GLASS DOOR FREEZER MERCHANDISER	120 V	1	1.04 kW	D1-4P D1-5P	12	#12, #12 G. IN 3/4" C.	5-20P	MOUNT RECEPTACLE ON WALL DIRECTLY BEHIND EQUIPMENT
	SINGLE DOOR ROLL-IN REFRIGERATOR VENTLESS CONVEYOR OVEN	120 V 208 V	3	1.13 kW 16.30 kW	D1-5P D1-4P	23 19,21,23	#12, #12 G. IN 3/4" C. #8, #10 G. IN 3/4" C.	5-20P 15-50P	MOUNT RECEPTACLE ON WALL DIRECTLY ABOVE EQUIPMENT PROVIDE HORIZONTAL RECEPTACLE ABOVE COUNTERTOP
	VENTLESS CONVEYOR OVEN	208 V	3	16.30 kW	D1-4P	37,39,41	#8, #10 G. IN 3/4" C.	15-50P	PROVIDE HORIZONTAL RECEPTACLE ABOVE COUNTERTOP
	SINGLE DOOR REACH-IN HEATED CABINET COUNTERTOP HEATED MERCHANDISER	120 V 120 V	1	1.56 kW 1.25 kW	D1-5P D1-3P	25 6	#12, #12 G. IN 3/4" C. #12, #12 G. IN 3/4" C.	5-20P DIRECT / 5-20P	MOUNT RECEPTACLE ON WALL DIRECTLY ABOVE EQUIPMENT STUB UP TO JUNCTION BOX ON UNDERSIDE OF SERVING COUNTER BASE
	DROP-IN TWO PAN HOT / COLD WELL	208 V	1	2.00 kW	D1-3P	35,37	#12, #12 G. IN 3/4" C.	DIRECT / 14-20P	STUB UP TO JUNCTION BOX ON UNDERSIDE OF SERVING COUNTER BASE
	PIZZA / ITALIAN BREATHGUARD DROP-IN 48-INCH HEATED SHELF	120 V 120 V	1	0.12 kW 1.23 kW	D1-3P D1-3P	27	#12, #12 G. IN 3/4" C. #12, #12 G. IN 3/4" C.	DIRECT / 5-20P	STUB UP TO JUNCTION BOX ON UNDERSIDE OF SERVING COUNTER BASE STUB UP TO JUNCTION BOX ON UNDERSIDE OF SERVING COUNTER BASE
	DROP-IN 48-INCH HEATED SHELF	120 V	1	1.23 kW	D1-3P	30	#12, #12 G. IN 3/4" C.	DIRECT / 5-20P	STUB UP TO JUNCTION BOX ON UNDERSIDE OF SERVING COUNTER BASE
	PIZZA / ITALIAN BREATHGUARD DROP-IN FOUR PAN HOT / COLD WELL	120 V 208 V	1	0.12 kW 3.00 kW	D1-3P D1-3P	24 20,22	#12, #12 G. IN 3/4" C. #12, #12 G. IN 3/4" C.	DIRECT / 14-20P	STUB UP TO JUNCTION BOX ON UNDERSIDE OF SERVING COUNTER BASE STUB UP TO JUNCTION BOX ON UNDERSIDE OF SERVING COUNTER BASE
	DROP-IN TWO PAN HOT / COLD WELL	208 V	1	2.00 kW	D1-3P	10,12	#12, #12 G. IN 3/4" C.	DIRECT / 14-20P	STUB UP TO JUNCTION BOX ON UNDERSIDE OF SERVING COUNTER BASE
	GENERAL'S FAVORITES BREATHGUARD	120 V	1	0.12 kW	D1-3P	1 10.21	#12, #12 G. IN 3/4" C.	DIRECT / 14 20B	STUB UP TO JUNCTION BOX ON UNDERSIDE OF SERVING COUNTER BASE
	DROP-IN THREE PAN HOT / COLD WELL DROP-IN THREE PAN HOT / COLD WELL	208 V 208 V	1	2.50 kW 2.50 kW	D1-3P D1-3P	19,21 23,25	#12, #12 G. IN 3/4" C. #12, #12 G. IN 3/4" C.	DIRECT / 14-20P DIRECT / 14-20P	STUB UP TO JUNCTION BOX ON UNDERSIDE OF SERVING COUNTER BASE STUB UP TO JUNCTION BOX ON UNDERSIDE OF SERVING COUNTER BASE
	MAKE-YOUR-OWN BREATHGUARD	120 V	1	0.12 kW	D1-3P	13	#12, #12 G. IN 3/4" C.	DIRECT	STUB UP TO JUNCTION BOX ON UNDERSIDE OF SERVING COUNTER BASE
	DROP-IN FOUR PAN HOT / COLD WELL DROP-IN TWO PAN HOT / COLD WELL	208 V 208 V	1 1	3.00 kW 2.00 kW	D1-3P D1-3P	26,28 31,33	#12, #12 G. IN 3/4" C. #12, #12 G. IN 3/4" C.	DIRECT / 14-20P DIRECT / 14-20P	STUB UP TO JUNCTION BOX ON UNDERSIDE OF SERVING COUNTER BASE STUB UP TO JUNCTION BOX ON UNDERSIDE OF SERVING COUNTER BASE
E-113	GENERAL'S FAVORITES BREATHGUARD	120 V	1	0.12 kW	D1-3P	9	#12, #12 G. IN 3/4" C.	DIRECT	STUB UP TO JUNCTION BOX ON UNDERSIDE OF SERVING COUNTER BASE
	SINGLE DOOR REACH-IN REFRIGERATOR SINGLE DOOR REACH-IN HEATED CABINET	120 V 120 V	1 1	0.88 kW 1.56 kW	D1-4P D1-4P	40 20	#12, #12 G. IN 3/4" C. #12, #12 G. IN 3/4" C.	DIRECT / 5-20P	MOUNT RECEPTACLE ON WALL DIRECTLY ABOVE EQUIPMENT MOUNT RECEPTACLE ON WALL DIRECTLY ABOVE EQUIPMENT
E-120	BOTTOM-MOUNT HOT FOOD WELL	208 V	1	1.65 kW	D1-4P	28,30	#12, #12 G. IN 3/4" C.	DIRECT	STUB UP TO JUNCTION BOX ON UNDERSIDE OF SERVING COUNTER BASE
	BOTTOM-MOUNT HOT FOOD WELL COUNTERTOP HEATED MERCHANDISER	208 V 120 V	1	1.65 kW 1.25 kW	D1-4P D1-3P	32,34 2	#12, #12 G. IN 3/4" C. #12, #12 G. IN 3/4" C.	DIRECT / 5-20P	STUB UP TO JUNCTION BOX ON UNDERSIDE OF SERVING COUNTER BASE STUB UP TO JUNCTION BOX ON UNDERSIDE OF SERVING COUNTER BASE
E-122	DROP-IN TWO PAN HOT / COLD WELL	208 V	1	2.00 kW	D1-3P	34,36	#12, #12 G. IN 3/4" C.	DIRECT / 14-20P	STUB UP TO JUNCTION BOX ON UNDERSIDE OF SERVING COUNTER BASE
	GRILLED FOOD BREATHGUARD DROP-IN 48-INCH HEATED SHELF	120 V 120 V	1	0.12 kW 1.23 kW	D1-3P D1-3P	29 14	#12, #12 G. IN 3/4" C. #12, #12 G. IN 3/4" C.	DIRECT / 5-20P	STUB UP TO JUNCTION BOX ON UNDERSIDE OF SERVING COUNTER BASE STUB UP TO JUNCTION BOX ON UNDERSIDE OF SERVING COUNTER BASE
	GRILLED FOOD BREATHGUARD	120 V	1	0.12 kW	D1-3P	8	#12, #12 G. IN 3/4 °C. #12, #12 G. IN 3/4 °C.	DIRECT	STUB UP TO JUNCTION BOX ON UNDERSIDE OF SERVING COUNTER BASE
	DROP-IN TWO PAN HOT / COLD WELL DROP-IN FOUR PAN HOT / COLD WELL	208 V 208 V	1	2.00 kW	D1-4P D1-4P	33,35	#12, #12 G. IN 3/4" C. #12, #12 G. IN 3/4" C.	DIRECT / 14-20P	STUB UP TO JUNCTION BOX ON UNDERSIDE OF SERVING COUNTER BASE
	FRESH FOOD BREATH GUARD	208 V 120 V	1	0.85 kW 0.12 kW	D1-4P D1-4P	22,24 13	#12, #12 G. IN 3/4" C. #12, #12 G. IN 3/4" C.	DIRECT / 14-20P DIRECT	STUB UP TO JUNCTION BOX ON UNDERSIDE OF SERVING COUNTER BASE STUB UP TO JUNCTION BOX ON UNDERSIDE OF SERVING COUNTER BASE
	DROP-IN TWO PAN HOT / COLD WELL	208 V	1	2.00 kW	D1-4P	36,38	#12, #12 G. IN 3/4" C.	DIRECT / 14-20P	STUB UP TO JUNCTION BOX ON UNDERSIDE OF SERVING COUNTER BASE
	DROP-IN FOUR PAN HOT / COLD WELL FRESH FOOD BREATH GUARD	208 V 120 V	1	0.85 kW 0.12 kW	D1-4P D1-4P	29,31 10	#12, #12 G. IN 3/4" C. #12, #12 G. IN 3/4" C.	DIRECT / 14-20P DIRECT	STUB UP TO JUNCTION BOX ON UNDERSIDE OF SERVING COUNTER BASE STUB UP TO JUNCTION BOX ON UNDERSIDE OF SERVING COUNTER BASE
E-151	SINGLE DOOR REACH-IN REFRIGERATOR	120 V	1	1.14 kW	D1-5P	20	#12, #12 G. IN 3/4" C.	5-20P	MOUNT RECEPTACLE ON WALL DIRECTLY ABOVE EQUIPMENT
	VENTLESS SPEED OVEN VENTLESS SPEED OVEN	208 V 208 V	1	7.50 kW 3.20 kW	D1-5P D1-5P	38,40,42 27,29	#10, #10 G. IN 3/4" C. #12, #12 G. IN 3/4" C.	DIRECT 6-20P	EXTEND TO TOP OF TWO-PART OVEN MOUNT RECEPTACLE ON WALL DIRECTLY BEHIND BOTTOM OF TWO-PART OVEN
E-154	COFFEE SHOP PREP REFRIGERATOR	120 V	1	0.60 kW	D1-5P	13	#12, #12 G. IN 3/4" C.	DIRECT / 5-20P	MOUNT RECEPTACLE ON WALL DIRECTLY BEHIND EQUIPMENT
	UNDERCOUNTER NUGGET ICE MAKER COUNTERTOP BEVERAGE BLENDER	120 V 120 V	1	1.20 kW 1.80 kW	D1-5P D1-5P	21 36	#12, #12 G. IN 3/4" C. #12, #12 G. IN 3/4" C.	5-20P 5-20P	MOUNT RECEPTACLE ON WALL DIRECTLY BEHIND EQUIPMENT MOUNT RECEPTACLE ON WALL ABOVE BACKSPLASH
Ξ-158	COUNTERTOP BEVERAGE BLENDER	120 V	1	1.80 kW	D1-5P	37	#12, #12 G. IN 3/4" C.	5-20P	MOUNT RECEPTACLE ON WALL ABOVE BACKSPLASH
	COUNTERTOP BEVERAGE BLENDER COUNTERTOP HEATED MERCHANDISER	120 V 208 V	1	1.80 kW 3.00 kW	D1-5P D1-5P	34 26,28	#12, #12 G. IN 3/4" C. #12, #12 G. IN 3/4" C.	5-20P 6-20P	MOUNT RECEPTACLE ON WALL ABOVE BACKSPLASH MOUNT RECEPTACLE ON WALL ABOVE BACKSPLASH
-162~	OPENAIR-REFRIGERATED MERCHANDISER	~120V~	1	3.00 kW	D1-5P	24	#12, #12 G. IN 3/4 °C. #12, #12 G. IN 3/4 °C.	5-202	MOUNT RECEPTACLE ON WALL DIRECTLY BEHIND EQUIPMENT
E-163	TEST KITCHEN SERVICE COUNTER (DROP-IN INDUCTION COOKTOP)	208 V	1	9.30 kW	D1-5P	31,33	#12, #12 G. IN 3/4" C.	DIRECT	STUB UP TO JUNCTION BOX ON UNDERSIDE OF ISLAND WORKTABLE
	TEST KITCHEN SERVICE COUNTER (CONVENIENCE OUTLETS) TEST KITCHEN SERVICE COUNTER (CONVENIENCE OUTLETS)	120 V 120 V	1 1	1.92 kW 1.92 kW	D1-5P D1-5P	35	#12, #12 G. IN 3/4" C. #12, #12 G. IN 3/4" C.	DIRECT	STUB UP TO JUNCTION BOX ON UNDERSIDE OF ISLAND WORKTABLE STUB UP TO JUNCTION BOX ON UNDERSIDE OF ISLAND WORKTABLE
	TEST KITCHEN SERVICE COUNTER (CONVENIENCE OUTLETS) COUNTERTOP INDUCTION COOKER	120	Minute of the second	1.80 kW	PLUG	PLUG	#12, #12 G. IN 3/4" C. #12, #12 G. IN 3/4" C.		STUB UP TO JUNCTION BOX ON UNDERSIDE OF ISLAND WORKTABLE CONNECT TO ANY CONVENIENCE RECEPTACLE OR POWERED WORKTABLE
	COUNTERTOP INDUCTION COOKER COUNTERTOP WAFFLE MAKER	120 V 120 V	1	1.80 kW 2.40 kW	PLUG PLUG	PLUG PLUG	#12, #12 G. IN 3/4" C. #12, #12 G. IN 3/4" C.	5-20P 5-20P	CONNECT TO ANY CONVENIENCE RECEPTACLE OR POWERED WORKTABLE CONNECT TO ANY CONVENIENCE RECEPTACLE OR POWERED WORKTABLE
	EIGHT QUART COUNTERTOP MIXER	120 V 120 V	1	1.44 kW	PLUG	PLUG	#12, #12 G. IN 3/4" C. #12, #12 G. IN 3/4" C.	5-20P 5-20P	CONNECT TO ANY CONVENIENCE RECEPTACLE OR POWERED WORKTABLE CONNECT TO ANY CONVENIENCE RECEPTACLE OR POWERED WORKTABLE
E-172	COUNTERTOP ICE CREAM MAKER	120 V	1	0.42 kW	PLUG	PLUG	#12, #12 G. IN 3/4" C.	5-20P	CONNECT TO ANY CONVENIENCE RECEPTACLE OR POWERED WORKTABLE
	HEAVY DUTY IMMERSION BLENDER SOUS VIDE IMMERSION CIRCULATOR	120 V 120 V	1 1	1.44 kW 1.20 kW	PLUG PLUG	PLUG PLUG	#12, #12 G. IN 3/4" C. #12, #12 G. IN 3/4" C.	5-20P 5-20P	CONNECT TO ANY CONVENIENCE RECEPTACLE OR POWERED WORKTABLE CONNECT TO ANY CONVENIENCE RECEPTACLE OR POWERED WORKTABLE
E-175	CHAMBER VACUUM PACKING MACHINE	120 V	1	1.44 kW	PLUG	PLUG	#12, #12 G. IN 3/4" C.	5-20P	CONNECT TO ANY CONVENIENCE RECEPTACLE OR POWERED WORKTABLE
	COUNTERTOP FOOD BENDER	120 V 120 V	1	1.38 kW	PLUG	PLUG	#12, #12 G. IN 3/4" C.	5-20P	CONNECT TO ANY CONVENIENCE RECEPTACLE OR POWERED WORKTABLE
KE-177	COUNTERTOP FOOD PROCESSOR	120 \/	1	0.84 kW	PLUG	PLUG	#12, #12 G. IN 3/4" C.	5-20P	CONNECT TO ANY CONVENIENCE RECEPTACLE OR POWERED WORKTABLE

	1
DARATE CONTRAC	Т
	1.
E	EPARATE CONTRAC

<sup>ELECTRICAL CIRCUITS TO BE BROUGHT TO ROUGH-INS, JUNCTION BOXES, AND DEVICES AS NOTED BY ELECTRICAL CONTRACTOR.
EQUIPMENT PLACEMENT BY KITCHEN EQUIPMENT CONTRACTOR.
INTERNAL WIRING BY MANUFACTURER.</sup>

	FURNISHED	INSTALLED	POWER	CONTROL / SUPERVISION
SYSTEM	ВҮ	BY	WIRING BY	WIRING BY
DISCONNECT SWITCHES (NON-INTEGRAL)	DIV 26	DIV 26	DIV 26	DIV 22/23
VFD (VARIABLE FREQUENCY DRIVES)	DIV 22/23	DIV 22/23	DIV 26	DIV 23
DUCT SMOKE DETECTOR FIRE/SMOKE DAMPER/ACTUATOR	DIV 28	DIV 23	 DIV 26	DIV 28
FIRE/SMOKE DAMPER/ACTUATOR SMOKE DAMPER / ACTUATOR	DIV 23 DIV 23	DIV 23 DIV 23	DIV 26 DIV 26	DIV 28
SPRINKLER				
DRY PIPE SYSTEM	DIV 21	DIV 21		DIV 28
SUPERVISORY CONTACTS	DIV 21	DIV 21		DIV 28
TAMPER SWITCHES	DIV 21	DIV 21		DIV 28

MARK	VOLTAGE	PHASE	LOAD	PANEL	CIRCUIT	WIRE SIZE	NOTES			
AC-01	208 V	1	14.40 kW	D1-2P	43,45	#8, #10 G. IN 3/4" C.	4			
AHU-F4	480 V	3	5.65 kW	D1-3L	19,21,23	#12, #12 G. IN 3/4" C.	4			
DEF-1	208 V	1	0.79 kW	D1-2P	20,22	#12, #12 G. IN 3/4" C.	4			
DOAS-1	480 V	3	49.16 kW	D1-3L	13,15,17	#4, #8 G. IN 1 1/4" C.	4			
DOAS-2	480 V	3	49.16 kW	D1-3L	14,16,18	#4, #8 G. IN 1 1/4" C.	4			
EF-F5	120 V	1	0.86 kW	D1-2P	6	#12, #12 G. IN 3/4" C.	4, 6			
EF-F6	120 V	1	0.86 kW	D1-2P	21	#12, #12 G. IN 3/4" C.	4, 6			
EF-F7	120 V	1	0.86 kW	D1-2P	28	#12, #12 G. IN 3/4" C.	4, 6			
GWH-1	120 V	1	0.05 kW	D1-2P	11	#12, #12 G. IN 3/4" C.	2			
GWH-2	120 V	1	0.05 kW	D1-2P	11	#12, #12 G. IN 3/4" C.	2			
GWH-3	120 V	1	0.05 kW	D1-2P	11	#12, #12 G. IN 3/4" C.	2			
HOOD-1 (KE-53)	120 V	1	0.20 kW	D1-2P	14	#12, #12 G. IN 3/4" C.	8			
HOOD-2 (KE-34)	120 V	1	0.20 kW	D1-3P	7	#12, #12 G. IN 3/4" C.	8			
HOOD-3 (KE-34)	120 V	1	0.20 kW	D1-3P	39	#12, #12 G. IN 3/4" C.	8			
HOOD-4 (KE-20)	120 V	1	0.20 kW	D1-3P	32	#12, #12 G. IN 3/4" C.	8			
HOOD-5 (KE-67)	1201		0.20 kW	Q1-2P	~~~ ¹⁸ ~~~	#12,#12G.JN-3/4"C.	~~~å~			
HOOD-6	120 V	1 1	0.20 kW	D1-6P	27	#12, #12 G. IN 3/4" C.	8			
MEF-1			0.79 kW	TD-2P	40,42	#12, #12 G. IN 3/4" C.				
KEF-2	208 V	1	1.08 kW	D1-2P	44,46	#12, #12 G. IN 3/4" C.	4			
WEE-3	208 V	1	0.79 kW	D1-2P	35,37	#12, #12 G. IN 3/4" C.	4			
KEF-4	208 V	1	1.08 kW	D1-2P	39,41	#12, #12 G. IN 3/4" C.	4			
KEF-5	2084~~	~~ ^	1.08 kW	~P1-2P~	48,5 0~~	#12#126\N34"6	~~~~			
KEF-6	208 V	1	1.08 kW	D1-6P	23,25	#12, #12 G. IN 3/4" C.	4			
MAU-1	208 V	1 1	1.44 kW	D1-6P	24,26	#12, #12 G. IN 3/4" C.	4			
E.C. TO PRO	OVIDE 120V/1P SNAP S	WITCH WITH PI	LOT LIGHT F	OR DISCONNE	ECTING MEANS.					
E.C. TO PRO	OVIDE DISCONNECT AT	ΓUNIT.								
PROVIDE N	EMA 3R ENCLOSURE F	OR DISCONNE	CTING MEAN	IS.						
E.C. TO WIR	E TO UNIT MOUNTED	DISCONNECT.								
E.C. TO INS	TALL, MOUNT AND WIF	RE TO VFD. VFD	E.C. TO INSTALL, MOUNT AND WIRE TO VFD. VFD PROVIDED BY OTHERS.							

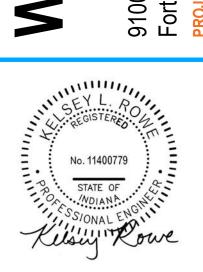

All concepts, ideas, designs, plans and details as shown on this document are the sole property of Design Collaborative, Inc., and shall not be used for any purpose without their expressed written consent. The owner shall be permitted to retain copies for information and reference.

BID SET

ISSUE DATE: 9/13/2024

NO. DATE DESCRIPTION 10/24/2024 ADD-2 2 11/04/2024 ADD-3

ELECTRICAL SCHEDULES

FINAL CONNECTION FROM ROUGH-IN, JUNCTION BOX, OR DEVICE TO EQUIPMENT BY ELECTRICAL CONTRACTOR.

SECTION 02 00 00 - EXISTING MATERIALS AVAILABLE FOR PROJECT

PART 1 - GENERAL

1.1 SUMMARY

A. Section Includes:

- 1. Materials and products available to contractors
 - a. Includes products currently installed
 - b. Includes products previously procured and not installed during 2022-24 Renovation of Wayne High School.

1.2 Materials List

- A. Remove: Detach items from existing construction and legally dispose of them off-site unless indicated to be removed and salvaged or removed and reinstalled.
- B. Remove and Salvage: Carefully detach from existing construction, in a manner to prevent damage, and deliver to Owner ready for reuse.
- C. Remove and Reinstall: Detach items from existing construction, prepare for reuse, and reinstall where indicated.
- D. Existing to Remain: Existing items of construction that are not to be permanently removed and that are not otherwise indicated to be removed, removed and salvaged, or removed and reinstalled.

PART 2 - PRODUCTS

2.1 LIST OF MATERIALS AND PRODUCTS

- A. The following is a documented list of items procured by the Construction Manager as part of the 2022-2024 Wayne High School Renovation project. These items were either unused or previously installed and marked for removal. This list is not exhaustive but includes materials that can be accounted for within this project. Some products listed may not be required; however, they are included here for potential future changes to the work. Please notify the Construction Manager if there is intent to use any of these products.
- B. Division 7 Materials available for use include:
 - 1. 2.5" Compasso Ceiling Grid Edge
 - a. 85.33x36
 - b. 72.0x2
 - c. 80.49x2
 - d. 83.90x1
 - e. 93.20x2

- f. 112.00x3
- g. 73.80x8
- h. 73.85x4
- i. 73.85x4
- j. 90 degree corners x 23
- k. 135 degree corners x 8
- 1. Splice x 136
- 2. 4" Compasso Ceiling Grid Edge
 - a. $9\overline{7.75}$ x1
 - b. 96.88x2
 - c. 91.33x4
 - d. 91.33 w. 45 mtr x2
 - e. 35-143 w pc x 1
 - f. 80.58x1
 - g. 73.72x1
 - h. 24.00x2
 - i. 90 degree corner x12
 - i. Inside corner x4
 - k. Splice x 46
 - 1. 90 degree splice x 3
- 3. 6" Compasso Ceiling Grid Edge
 - a. 112.58x6
 - b. 104.58x7
 - c. 96.88x4
 - d. 84.88x4
 - e. 80.58x21
 - f. 72.77x6
 - g. 73.75x2
 - h. 49.75x3
 - i. 90 degree corner x 31
 - j. Splice x 163
- 4. 12" Compasso Ceiling Grid Edge
 - a. 12" Long Brace x 48
 - b. 3" Long Brace x 143
- C. Division 7 Materials available for use include:
 - 1. Refer to door schedule and door hardware for specific items to be used or reused from previous project.
 - 2. (2) Best Core Keyed Switches
- D. Division 23 Materials available for use include:
 - 1. Refer to Mechanical drawings for items to be used or reused from previous project.
- E. Division 26 & 27 Materials available for use include:
 - 1. Refer to Electrical drawings for items to be used or reused from previous project

PART 3 - EXECUTION

END OF SECTION

SECTION 09 51 00 - Acoustical Ceilings **SoundScapes® Blades Linear Acoustical Panels – Colors**

PART 1 - GENERAL

1.1 RELATED DOCUMENTS

Drawings and general conditions of Contract, including General and Supplementary Conditions and Divisions-1 Specification sections apply to work of this section.

1.2 SUMMARY

A. Section Includes:

- 1. Linear acoustical ceiling and wall panels
- 2. Exposed grid suspension system
- 3. Wire hangers, fasteners, main runners, cross tees, wall angle moldings and accessories

B. Related Sections:

- 1. Section 09 50 00 Ceilings
- 2. Section 09 51 13 Acoustical Panel Ceilings
- 3. Section 09 53 00 Acoustical Ceiling Suspension Assemblies
- 4. Section 09 54 00 Specialty Ceilings
- 5. Section 09 54 33 Decorative Panel Ceilings
- 6. Section 09 54 53 Fiberglass Reinforced Panel Ceilings

C. Alternates

- 1. Prior Approval: Unless otherwise provided for in the Contract documents, proposed product substitutions may be submitted no later than TEN (10) working days prior to the date established for receipt of bids. Acceptability of a proposed substitution is contingent upon the Architect's review of the proposal for acceptability and approved products will be set forth by the Addenda. If included in a Bid are substitute products that have not been pre-approved by the architect and included in the Addenda, the originally specified products shall be provided without additional compensation.
- 2. Submittals that do not provide adequate data for the product evaluation will not be considered. The proposed substitution must meet all requirements of this section, including but not necessarily limited to, the following: Single source materials suppliers; Underwriters' Laboratories Classified Acoustical performance; Panel design, size, composition, color, and finish; Suspension system component profiles and sizes; Compliance with the referenced standards.

1.3 REFERENCES

A. American Society for Testing and Materials (ASTM):

ACOUSTICAL CEILINGS 09 51 00-1

- 1. ASTM A 1008 Standard Specification for Steel, Sheet, Cold Rolled, Carbon, Structural, High-Strength Low-Alloy and High-Strength Low-Alloy with Improved Formability
- 2. ASTM A 641 Standard Specification for Zinc-Coated (Galvanized) Carbon Steel Wire
- 3. ASTM A 653 Standard Specification for Steel Sheet, Zinc-Coated (Galvanized) by the Hot-Dip Process
- 4. ASTM C 423 Sound Absorption and Sound Absorption Coefficients by the Reverberation Room Method
- 5. ASTM C 635 Standard Specification for Metal Suspension Systems for Acoustical Tile and Lay-in Panel Ceilings
- 6. ASTM C 636 Recommended Practice for Installation of Metal Ceiling Suspension Systems for Acoustical Tile and Lav-in Panels
- 7. ASTM D 3273 Standard Test Method for Resistance to Growth of Mold on the Surface of Interior Coatings in an Environmental Chamber
- 8. ASTM E 84 Standard Test Method for Surface Burning Characteristics of Building Materials
- 9. ASTM E 580 Installation of Metal Suspension Systems in Areas Requiring Moderate Seismic Restraint
- 10. ASTM E 1111 Standard Test Method for Measuring the Interzone Attenuation of Ceilings Systems
- 11. ASTM E 1414 Standard Test Method for Airborne Sound Attenuation Between Rooms Sharing a Common Ceiling Plenum
- 12. ASTM E 1264 Classification for Acoustical Ceiling Products
- B. NFPA 286 Standard Methods of Fire Tests for Evaluating Contribution of Wall and Ceiling Interior Finish to Room Fire Growth
- C. ASHRAE Standard 62.1-2004, "Ventilation for Acceptable Indoor Air Quality"
- D. ICC ESR 1308 International Code Council Evaluation Report Independent Evaluation of Armstrong Suspension Components for Seismic Installations
- E. International Building Code
- F. ASCE 7 American Society of Civil Engineers, Minimum Design Loads for Buildings and Other Structures
- G. International Code Council-Evaluation Services AC 156 Acceptance Criteria for Seismic Qualification Testing of Non-structural Components
- H. LEED Leadership in Energy and Environmental Design is a set of rating systems for the design, construction, operation, and maintenance of green buildings

1.4 SYSTEM DESCRIPTION

A. Discontinuous

ACOUSTICAL CEILINGS 09 51 00-2

1.5 SUBMITTALS

- A. Product Data: Submit manufacturer's technical data for each type of acoustical ceiling unit and suspension system required.
- B. Samples: Minimum 6 x 6 submittal sample of specified blade color; 8 inch long sample of suspension system, including main runner and cross tee.
- C. Shop Drawings: Layout and details of acoustical ceilings show locations of items, which are to be coordinated with, or supported by the ceilings.
- D. Acoustical Certifications: Manufacturer's certifications that products comply with specified requirements, including laboratory reports showing compliance with specified tests and standards. For acoustical performance, each carton of material must carry an approved independent laboratory classification, such as Underwriter's Laboratory (UL) of NRC.
 - 1. If the material supplied by the acoustical subcontractor does not have an independent laboratory classification of acoustical performance on every carton, subcontractor shall be required to send material from every production run appearing on the job to an independent or NVLAP approved laboratory for testing, at the architect's or owner's discretion. All products not conforming to manufacturer's current published values must be removed, disposed of, and replaced with complying product at the expense of the Contractor performing the work.

a. SUSTAINABLE MATERIALS

- E. Transparency: Manufacturers will be given preference when they provide documentation to support sustainable requirements for the following: Material ingredient transparency, Removal of Red List Ingredients per LBCV3, Life Cycle impact information, Low-Emitting Materials, and Clean Air performance.
 - 1. End of Life Programs/Recycling: Where applicable, manufacturers that provide the option for recycling of their products into new products at end-of-life through take-back programs will be preferred.

1.6 QUALITY ASSURANCE

- A. Single-Source Responsibility: Provide acoustical panel units and grid components by a single manufacturer.
- B. Fire Performance Characteristics: Identify acoustical ceiling components with appropriate markings of applicable testing and inspecting organization.
 - 1. Surface Burning Characteristics: Class A as follows, tested per ASTM E84 and CAN/ULC S102:

a. Flame Spread: 25 or lessb. Smoke Developed: 50 or less

ACOUSTICAL CEILINGS 09 51 00-3

C. Handle acoustical blades carefully to avoid scratching or denting units in any way.

1.7 DELIVERY, STORAGE, AND HANDLING

- A. Deliver acoustical ceiling units to project site in original, unopened packages and store them in a fully enclosed space where they will be protected against damage from moisture, direct sunlight, surface contamination, and other causes.
- B. Before installing acoustical ceiling units, permit them to reach room temperature and a stabilized moisture content.
- C. Handle acoustical ceiling units carefully to avoid chipping edges or damaged units in any way.

1.8 PROJECT CONDITIONS

A. Space Enclosure:

All ceiling products and suspension systems must be installed and maintained in accordance with Armstrong written installation instructions for that product in effect at the time of installation and best industry practice. Prior to installation, the ceiling product must be kept clean and dry, in an environment that is between 32°F (0°C) and 120°F (49°C) and not subject to Abnormal Conditions. Abnormal conditions include exposure to chemical fumes, vibrations, moisture from conditions such as building leaks or condensation, excessive humidity, or excessive dirt or dust buildup.

<u>HumiGuard Plus Ceilings:</u> Installation of the products shall be carried out where the temperature is between 32°F (0° C) and 120°F (49° C). It is not necessary for the area to be enclosed or for HVAC systems to be functioning. All wet work (plastering, concrete, etc.) must be complete and dry. The ceilings must be maintained to avoid excessive dirt or dust buildup that would provide a medium for microbial growth on ceiling panels. Microbial protection does not extend beyond the treated surface as received from the factory and does not protect other materials that contact the treated surface such as supported insulation materials.

1.9 WARRANTY

- A. Blades: Submit a written warranty executed by the manufacturer, agreeing to repair or replace acoustical panels that fail within the warranty period. Failures include, but are not limited to:
 - 1. Blade Panels: Sagging and warping as a result of defects in materials or factory workmanship.
 - 2. Grid System: Rusting and manufacturer's defects

B. Warranty Period:

- 1. Blades: One (1) year from date of substantial completion
- 2. Suspension System: Ten (10) years from date of substantial completion
- C. The Warranty shall not deprive the Owner of other rights the Owner may have under other provisions of the Contract Documents and will be in addition to and run concurrent with other warranties made by the Contractor under the requirements of the Contract Documents.

1.10 MAINTENANCE

- A. Extra Materials: Deliver extra materials to Owner. Furnish extra materials described below that match products installed. Packaged with protective covering for storage and identified with appropriate labels.
 - 1. Acoustical Ceiling Units: Furnish quality of full-size units equal to 5.0 percent of amount installed.
 - 2. Exposed Suspension System Components: Furnish quantity of each exposed suspension component equal to 2.0 percent of amount installed.

PART 2 - Part 2 - PRODUCTS

2.1 MANUFACTURERS

- A. Basis of Design SoundScapes Blades
 - 1. Armstrong World Industries Inc.

Suspension System

2. Armstrong World Industries Inc.

2.2.1 SoundScapes Blades: Surface Texture: Fine Composition: Fiberglass

Color: custom color to be selected by architect

Size & Design:

10 x 94 x 1-3/4" Rectangle (item 8250F03RH02),

Edge Profile: Square Recycled Content: 43%

Acoustics: Sound absorption up to 1.80 Noise Reduction Coefficient (NRC) ASTM C 423 dependent on

blade depth and spacing:

Panel Depth	6" O.C.	12" O.C.	18" O.C.	24" O.C.
5"	0.80	0.50	0.40	0.30
7-1/2"	1.00	0.65	0.50	0.40
10"	1.15	0.80	0.60	0.50
10-1/2"	1.15	0.80	0.60	0.50
16"	1.35	1.00	0.75	0.55
19-1/2"	1.40	1.00	0.75	0.60
22"	1.45	1.00	0.75	0.65
22-1/2"	1.45	1.00	0.80	0.65
28"	1.80	1.35	1.10	0.95

Flame Spread: ASTM E 1264; Class A (UL)

Dimensional Stability: HumiGuard Plus; Anti-Microbial, inherent

Basis of Design: SoundScapes Blades (item 8250F03RH02) as manufactured by Armstrong World

Industries

2.2.2 Individual Suspension:

Aircraft Cable: Acceptable product as manufactured by Armstrong World Industries

- **a.** Item 6655L8CR 4-Point Hanging Kit (4 per bag)
- **b.** Item 625530 Extended Hanging Aircraft Cables (30' length, 4 per bag). For use with Item 6655L8CR when longer cables are needed.

1) METAL SUSPENSION SYSTEMS

- B. Direct-to-Grid Suspension Acceptable Product: Listed Below as manufactured by Armstrong World Industries, Inc. Items are available in custom colors; contact ASQuote@armstrongceilings.com.
 - 1. Prelude XL in coordinating finishes manufactured by Armstrong World Industries:

7301 _ _ _ 12' HD Main Beam

XL7342 _ _ _ 4' Cross Tee

XL7328 _ _ _ 2' Cross Tee

7800 _ _ 12' Angle Molding 2. 360° painted

2. 360° painted Black (BL) or White (WH) as manufactured by Armstrong World Industries:

730136 12' HD Main Beam

XL734036 4' Cross Tee

XL732036 2' Cross Tee

780036 12' Angle Molding

3. 360° painted made to order colors (RAL) as manufactured by Armstrong World Industries:

56418 12' HD Main Beam

56421 4' Cross Tee

56419 2' Cross Tee

7800 12' Angle Molding

- C. Direct-Attach Acceptable Product: AXM34STR3 _ _ 10' Straight Wall Molding (360° Paint Recommended)
- D. Wire for Hangers and Ties: ASTM A 641, Class 1 zinc coating, soft annealed, with a yield stress load of at least time three design load, but not less than 12 gauge.
- E. Accessories

ARBRKT Adjustable Hanger Bracket 6459BL Black Rigid Attachment Clip

PART 3 - EXECUTION

3.1 EXAMINATION

A. Do not proceed with installation until all wet work such as concrete, terrazzo, plastering and painting has been completed and thoroughly dried out, unless expressly permitted by manufacturer's printed recommendations. (Exception: HumiGuard Max Ceilings)

3.2 PREPARATION

- A. Coordination: Furnish layouts for preset inserts, clips, and other ceiling anchors whose installation is specified in other sections.
 - 1. Furnish concrete inserts and similar devices to other trades for installation well in advance of time needed for coordination of other work.

3.3 INSTALLATION

- A. Install SoundScapes Blades per Armstrong World Industries installation instructions.
- B. For areas having seismic requirements, consult with the Authority Having Jurisdiction or Building Code to determine the local requirements and following the manufacturers seismic guidelines found in the manufacturers Installation instructions.
- C. Install suspension system per ASTM C636 unless otherwise noted in the manufactures Installation Instructions.

3.4 ADJUSTING AND CLEANING

- A. Replace damaged and broken blades.
- B. Clean exposed surfaces of blades, including trim, and suspension members comply with manufacturer's instructions for cleaning and touch up of minor finish damage.
- C. Remove and replace work that cannot be successfully cleaned and repaired to permanently eliminate evidence of damage.

END OF SECTION

SECTION 10 44 13 - FIRE PROTECTION CABINETS

PART 1 - GENERAL

1.1 SUMMARY

- A. Section Includes:
 - 1. Fire-protection cabinets for portable fire extinguishers.

1.2 ACTION SUBMITTALS

A. Product Data: For each type of product.

1.3 CLOSEOUT SUBMITTALS

A. Maintenance data.

1.4 COORDINATION

- A. Coordinate size of fire-protection cabinets to ensure that type and capacity of fire extinguishers indicated are accommodated.
- B. Coordinate sizes and locations of fire-protection cabinets with wall depths.

PART 2 - PRODUCTS

2.1 PERFORMANCE REQUIREMENTS

A. Fire-Rated Fire-Protection Cabinets: Listed and labeled to comply with requirements in ASTM E814 for fire-resistance rating of walls where they are installed.

2.2 FIRE-PROTECTION CABINET

- A. Cabinet Type: Fully-Recessed, suitable for fire extinguisher.
 - 1. Manufacturers: Subject to compliance with requirements, provide JL Heavy Duty School Fire Cabinet or comparable products by the following:
 - a. Guardian Fire Equipment, Inc.
 - b. Larsens Manufacturing Company.
- B. Cabinet Construction: Nonrated, unless indicated in a rated wall.

- C. Cabinet Material: Cold-rolled steel sheet.
- D. Recessed Cabinet:
 - 1. Exposed Flat Trim: One-piece combination trim and perimeter door frame overlapping surrounding wall surface, with exposed trim face and wall return at outer edge (backbend).
- E. Cabinet Trim Material: Steel sheet.
- F. Door Material: Steel sheet.
- G. Door Style: Vertical duo panel with frame.
 - 1. Provide solid door at Gym
- H. Door Glazing: Tempered float glass (clear).
 - 1. Acrylic Sheet Color:
 - a. Clear transparent acrylic sheet.
- I. Door Hardware: Manufacturer's standard door-operating hardware of proper type for cabinet type, trim style, and door material and style indicated.
- J. Accessories:
 - 1. Identification: Lettering complying with authorities having jurisdiction for letter style, size, spacing, and location. Locate as indicated by ArchitectInsert location.
 - a. Identify fire extinguisher in fire-protection cabinet with the words "FIRE EXTINGUISHER."
 - 1) Location: Applied to cabinet door.
 - 2) Lettering Color: White.
 - 3) Orientation: Vertical.
 - 2. Flush Cap Pull
- K. Materials:
 - 1. Cold-Rolled Steel: ASTM A1008/A1008M, Commercial Steel (CS), Type B.
 - a. Finish: Baked enamel, TGIC polyester powder coat, HAA polyester powder coat, epoxy powder coat, or polyester/epoxy hybrid powder coat, complying with AAMA 2603.
 - b. Color: Red.
 - 2. Tempered Float Glass: ASTM C1048, Kind FT, Condition A, Type I, Quality q3, 3 mm thick, Class 1 (clear)Class 2 (tinted, heat absorbing, and light reducing), bronze tint.

2.3 FABRICATION

- A. Fire-Protection Cabinets: Provide manufacturer's standard box (tub) with trim, frame, door, and hardware to suit cabinet type, trim style, and door style indicated.
 - 1. <u>Custom Fabrication: Cabinets shall be custom sized to fit existing openings. Wall trim</u> shall cover the approximate same wall area to prevent exposing existing paint line.

PART 3 - EXECUTION

3.1 INSTALLATION

- A. Prepare recesses for recessed fire-protection cabinets as required by type and size of cabinet and trim style.
- B. Install fire-protection cabinets in locations and at mounting heights indicated.
- C. Fire-Protection Cabinets: Fasten cabinets to structure, square and plumb.
- D. Identification: Apply vinyl lettering.
- E. Adjust fire-protection cabinet doors to operate easily without binding. Verify that integral locking devices operate properly.

END OF SECTION

SECTION 10 44 16 - FIRE EXTINGUISHERS

PART 1 - GENERAL

1.1 SUMMARY

A. Section includes portable, hand-carried fire extinguishers.

1.2 SUBMITTALS

- A. Product Data: For each type of product indicated.
- B. Operation and maintenance data.
- C. Warranty: Sample of special warranty.

1.3 QUALITY ASSURANCE

- A. NFPA Compliance: Fabricate and label fire extinguishers to comply with NFPA 10, "Portable Fire Extinguishers."
- B. Fire Extinguishers: Listed and labeled for type, rating, and classification by an independent testing agency acceptable to authorities having jurisdiction.
- C. Coordinate type and capacity of fire extinguishers with fire protection cabinets to ensure fit and function.

1.4 WARRANTY

- A. Special Warranty: Manufacturer's standard form in which manufacturer agrees to repair or replace fire extinguishers that fail in materials or workmanship within specified warranty period.
 - 1. Failures include, but are not limited to, the following:
- B. Failure of hydrostatic test according to NFPA 10.
- C. Faulty operation of valves or release levers.
- 1. Warranty Period: Six years from date of Substantial Completion.

FIRE EXTINGUISHERS 10 44 16-1 PART 2 - PRODUCTS

1.5 PORTABLE, HAND-CARRIED FIRE EXTINGUISHERS

A. Fire Extinguishers: Type, size, and capacity for each fire protection cabinet indicated.

FIRE EXTINGUISHERS 10 44 16-1

- 1. Basis-of-Design Product: Subject to compliance with requirements, provide J. L. Industries, Inc. Cosmic 10E or comparable product by one of the following:
 - a. Larsen's Manufacturing Company.
- B. Multipurpose Dry-Chemical Type: UL-rated 10 lb. nominal capacity, with monoammonium phosphate-based dry chemical in manufacturer's standard enameled container.

PART 2 - EXECUTION

2.1 INSTALLATION

- A. Examine fire extinguishers for proper charging and tagging.
 - 1. Remove and replace damaged, defective, or undercharged fire extinguishers.
- B. Install fire extinguishers in locations indicated and in compliance with requirements of authorities having jurisdiction.

END OF SECTION

FIRE EXTINGUISHERS 10 44 16-2

FIRE EXTINGUISHERS 10 44 16-2

SECTION 11 52 13 - PROJECTION SCREENS

PART 1 - GENERAL

1.1 SUMMARY

- A. Section Includes:
 - 1. Electrically operated, front-projection screens and controls locations include:
 - a. Dining F100 (multiple)

1.2 ACTION SUBMITTALS

- A. Product Data: For each type of product.
- B. Shop Drawings: Show layouts and types of front-projection screens. Include the following:
 - 1. Location of seams in viewing surfaces.
 - 2. Anchorage details, including connection to supporting structure for suspended units.
 - 3. Location of wiring connections for electrically operated units.
 - 4. Wiring diagrams for electrically operated units.

PART 2 - PRODUCTS

2.1 ELECTRICALLY OPERATED, FRONT-PROJECTION SCREENS

- A. General: Manufacturer's standard units consisting of case, screen, motor, controls, mounting accessories, and other components necessary for a complete installation.
 - 1. Controls: Remote, key-operated, three-position control switch.
 - a. Provide key-operated, power-supply switch.
 - 1) Keyed switch must accept Best standard interchangeable 7-pin core. Core to be provided by FWCS.
- B. Manufacturer: Basis of Design Provide Draper Premier electric projection screen or comparable product by one of the following:
 - 1. Bretford, Inc
 - 2. Da-Lite
- C. Projection Screen Construction

11 52 13-2

- 1. Motor in Roller: Instant-reversing motor of size and capacity recommended by screen manufacturer; with permanently lubricated ball bearings, automatic thermal-overload protection, and positive-stop action to prevent coasting.
- 2. Screen Mounting: Top edge securely anchored to rigid metal roller and bottom edge formed into a pocket holding a 3/8-inch- diameter metal rod with ends of rod protected by plastic caps.
- 3. Case Enclosure: Spring roller operated, steel case 22-gauge steel with end caps finished to match case. Flat back design, with scratch-resistant textured finish.
 - a. Color: Black
- 4. Mounting: Provide mounting brackets for floating ceiling conditions (exposed structure) unless noted otherwise in schedule below.
- 5. Viewing Surface: Matt White XT1000VB (or comparable).
 - a. On axis gain: 1.0
 - b. 180 degree viewing cone
 - c. Washable surface
- 6. Viewing Area: Refer to schedule below.
 - a. Black Masking Border
- 7. Tab-Tensioning System: Viewing surface with integrated tabs and cable on each side of fabric to provide tension and ensure flat viewing surface. Viewing surface and tabs CNC cut as a single piece. Tabs RF welded to back of viewing surface to prevent tab separation. Tab adhesives are not acceptable.
- 8. Screen Drop: Provide black screen drop of 12" unless noted greater in schedule.
- D. Electric Motorized Front-Projection Screen Schedule
 - 1. 16:10 Format 109" Diameter (57-1/2" x 92").
 - a. Dining Room F100
 - 2. 16:10 Format 137" Diameter (72-1/2" x 116").
 - a. Dining F100 (center)

PART 3 - EXECUTION

3.1 INSTALLATION

A. Install front-projection screens at locations indicated to comply with screen manufacturer's written instructions.

PROJECTION SCREENS

- B. Install front-projection screens with screen cases in position and in relation to adjoining construction indicated. Securely anchor to supporting substrate in a manner that produces a smoothly operating screen with vertical edges plumb and viewing surface flat when screen is lowered.
 - 1. Install low-voltage controls according to NFPA 70 and complying with manufacturer's written instructions.
 - a. Wiring Method: Install wiring in raceway except in accessible ceiling spaces and in gypsum board partitions where unenclosed wiring method may be used. Use UL-listed plenum cable in environmental air spaces, including plenum ceilings. Conceal raceway and cables except in unfinished spaces.
 - 2. Test electrically operated units to verify that screen controls, limit switches, closures, and other operating components are in optimum functioning condition.

END OF SECTION

RFI Log

Project Name	Renovation of Wayne Kitchen and Cafeteria		
Project Address	9100 Winchester Rd. Fort Wayne, IN 46819		
Architect	Design Collaborative		
Construction Manager	Hagerman, Inc.		

Addendum 1		10/17/2024
Addendum 2		10/24/2024
Addendum 3		11/5/2024
Bid Date	November 7, 2024 at 2:00PM	

				Responsible		Response	
RFI#	Status	Description of Request	Received By	Party	Date Submitted	Date	Response
001	Complete	Clarification of glazing scope in each package	Hagerman	Hagerman	10/8/2024	10/14/2024	 1.) HM glass will be in BP #4 (Glazing), Wood Door Lites will be supplied by the wood door supplier (BP #13), FRP Door Lites also BP #13 2.) Storefront windows in BP #4 3.) Breath Guards will be part of BP #12 – Food Service Equipment 4.) 2" aluminum frame screen wall will be in BP #4
002	Pending	On DWG sheet S2.1F in WAREWASH room F38, above Door Opening F38A, is a Scheduled CMU Lintel. However on DWG sheet 4/A5.1 there's a detail that calls for a Steel Beam and Bent Plate Lintel above the same opening F38A.	Hagerman	A/E Team	10/17/2024		See Addendum 3
003	Pending	Is there a description in the specifications for the screen walls? If so, what is the CSI section it would be listed in? I have not been able to locate at this point.	Hagerman	A/E Team	10/15/2024		See Addendum 3
004	Pending	If the intent is to be a custom design, the drawings indicate the framing member height to be 2" but the depth is not specified. Is the intent to be square tubing or is this subject to scaling?	Hagerman	A/E Team	10/15/2024		See Addendum 3
005	Pending	If custom, are intersections expected to be welded or can fasteners be exposed in a "clean manner" also, are the anchor points at the head and sill allowed to be exposed?	Hagerman	A/E Team	10/15/2024		See Addendum 3
006	Pending	Are there any minority requirements?	Hagerman	Hagerman	10/18/2024		No minority requirements
007	Pending	Is this and OCIP or CCIP project?	Hagerman	Hagerman	10/18/2024		No OCIP or CCIP
008	Pending	Is this a Union or Prevailing Wage Project?	Hagerman	Hagerman	10/18/2024	6.5	This job does not have prevailing wage requirements
009	Pending	Can you confrim the % the bid bond needs to be?	Hagerman	Hagerman	10/18/2024	T.	Bid Bonds need to be 100% of the bid value
010	Pending	there are two areas in F40 Serving that show the quarry tile pattern. Is this correct or should these areas have RT-1 installed in them? Installed in them	Hagerman	A/E Team	10/28/2024	1	AN
011	Pending	Cut 5 on page A11.1F shows the use of Schluter Dilex Base. Was this detail included by	Hagerman	A/E Team	10/28/2024		Clarified in Addendum 03.
012	Pending	accident? They only situation where there is tile on floors is the quarry tile kitchen which has cove base specified on top of it. The Dilex would not work in this situation. Cut 4 on A11.1F shows the RT/SC transition and calls for the slab to be ground down 2-3' back	Hagerman	Hagerman	10/28/2024		Clarified in Addendum 03.
013	Pending	to create a flush slab. Who is responsible for the grinding Looking at drawing A1.1F demo note D102 confirming that the concrete fill is by bid package #3 (general trades) and not by bid package #7 (flooring), correct?	Hagerman	Hagerman	10/31/2024		This grinding should be completed by BI#7. Confirmed, Concrete is by BP#3.
014	Pending	Please provide specifications for the Fire Extinguisher Cabinets, Fire Extinguishers and Projection Screens.	Hagerman	A/E Team	10/31/2024		Clarified in Addendum 03.
015	Pending	Bid item #6 item #3 – please clarify if this 10x10 glass mesh is just fiberglass tape.	Hagerman	Hagerman	11/1/2024		Confirmed, please use Fiberglass Tape.
016	Pending	Bid item #6 item #11 – this item should be in the drywall and framing bid package. Can this be removed from bid item #6?	Hagerman	Hagerman	11/1/2024		Yes, Delete item #11 from Bid Item #6. All Drywall Expansion joints to be furnish and installed by Bid item #5.

017	Pending	Bid item #3 item #13 – there is no intumescent paint in this project. Can this item be removed from this bid item.	Hagerman	Hagerman	11/1/2024	If no intumescent is shown on the drawings then it does not need to be included.
018	Pending	Can you please advise the basis of design for the ceiling baffles per note 95100-1?	Hagerman	A/E Team	11/1/2024	Clarified in Addendum 03.
019	Pending	Detail 4 on A6.2 do you want the top of booth axon to be laiminated or just the ceiling?	Hagerman	A/E Team	11/1/2024	Clarified in Addendum 03.
020	Pending	Is the framing in the booth axon to be metal stud or what is that wall to be constructed of? I have construcatbility concerns in spanning that far without and intermediate wall.	Hagerman	A/E Team	11/1/2024	Clarified in Addendum 03.
021	Pending	Bonding Revision	Hagerman	Hagerman	11/1/2024	Bid bonds will not be required as part of this project. Please provide 100% P&P Bond.

