

# ADDENDUM

Project No.:2401519Project:YWCA of NE IN Hefner Kitchen

Addendum No: 3 Date: 12/02/2024

### TO: ALL BIDDERS OF RECORD

ADDENDUM NO. 3, to Drawings and Specifications dated 10/30/2024, for the Hefner Kitchen project for the YWCA of Northeast Indiana; as prepared by ELEVATUS Architecture, 111 E. Wayne Street, Suite 555, Fort Wayne, IN 46802

This ADDENDUM shall hereby be and become a part of the Contract Documents the same as if originally bound thereto.

The following clarifications, amendments, additions, revisions, changes, and modifications change the original Contract Documents only in the amount and to the extent hereinafter specified and set forth in this ADDENDUM.

Each Bidder shall acknowledge receipt of this ADDENDUM on the Bid Form.

#### **CLARIFICATIONS:**

ITEM NO. 1.01 – PRIMARY ENGINEERING ADDENDUM 3 REPORT

A. See attachment for more information.

#### ITEM NO. 1.02

A. The areas in the project scope are considered to be commercial kitchens.

#### **DRAWINGS:**

ITEM NO. 2.01 - DRAWING NO. - A2.11 FIRST FLOOR PLAN - UNIT M

A. Walls to be furred out at locations where panelboards K1, K2, and K3 exist.

Submitted By:

Brad Wanek Associate | Architect



- cc: 🗆 File: Document
  - □ Owner:
  - □ Contractor:
  - □ Consultant:
  - □ Consultant:



Primary Engineering, Inc. 2828 Lake Ave. Fort Wayne, Indiana 46805 260-424-0444 ph www.primary-eng.com



Addendum:

Date: **12/02/2024** 

3


Project: YWCA Northeast Indiana Hefner Kitchen

Comm #: 24599

The following items shall be incorporated into the specifications and drawings and are considered to be integral to the bid documents for the project. Acknowledgement of receipt of this addendum is required on the bid form.

## Item #1: Drawing Sheet E2.01

- **A.** All receptacles in Kitchen M104, Kitchen M117, Training Kitchen M121 and Warming Kitchen M122 shall be GFCI protected devices (non feed-through).
- **B.** All exposed conduit in Kitchen M104, Kitchen M117, Training Kitchen M121 and Warming Kitchen M122 shall be ERMC (threaded rigid) type with FS type boxes up to above ceiling. Rooms are to be considered WET location below ceiling.
- C. Panelboards K1, K2 & K3 shall be flush type covers in furred-out wall construction.

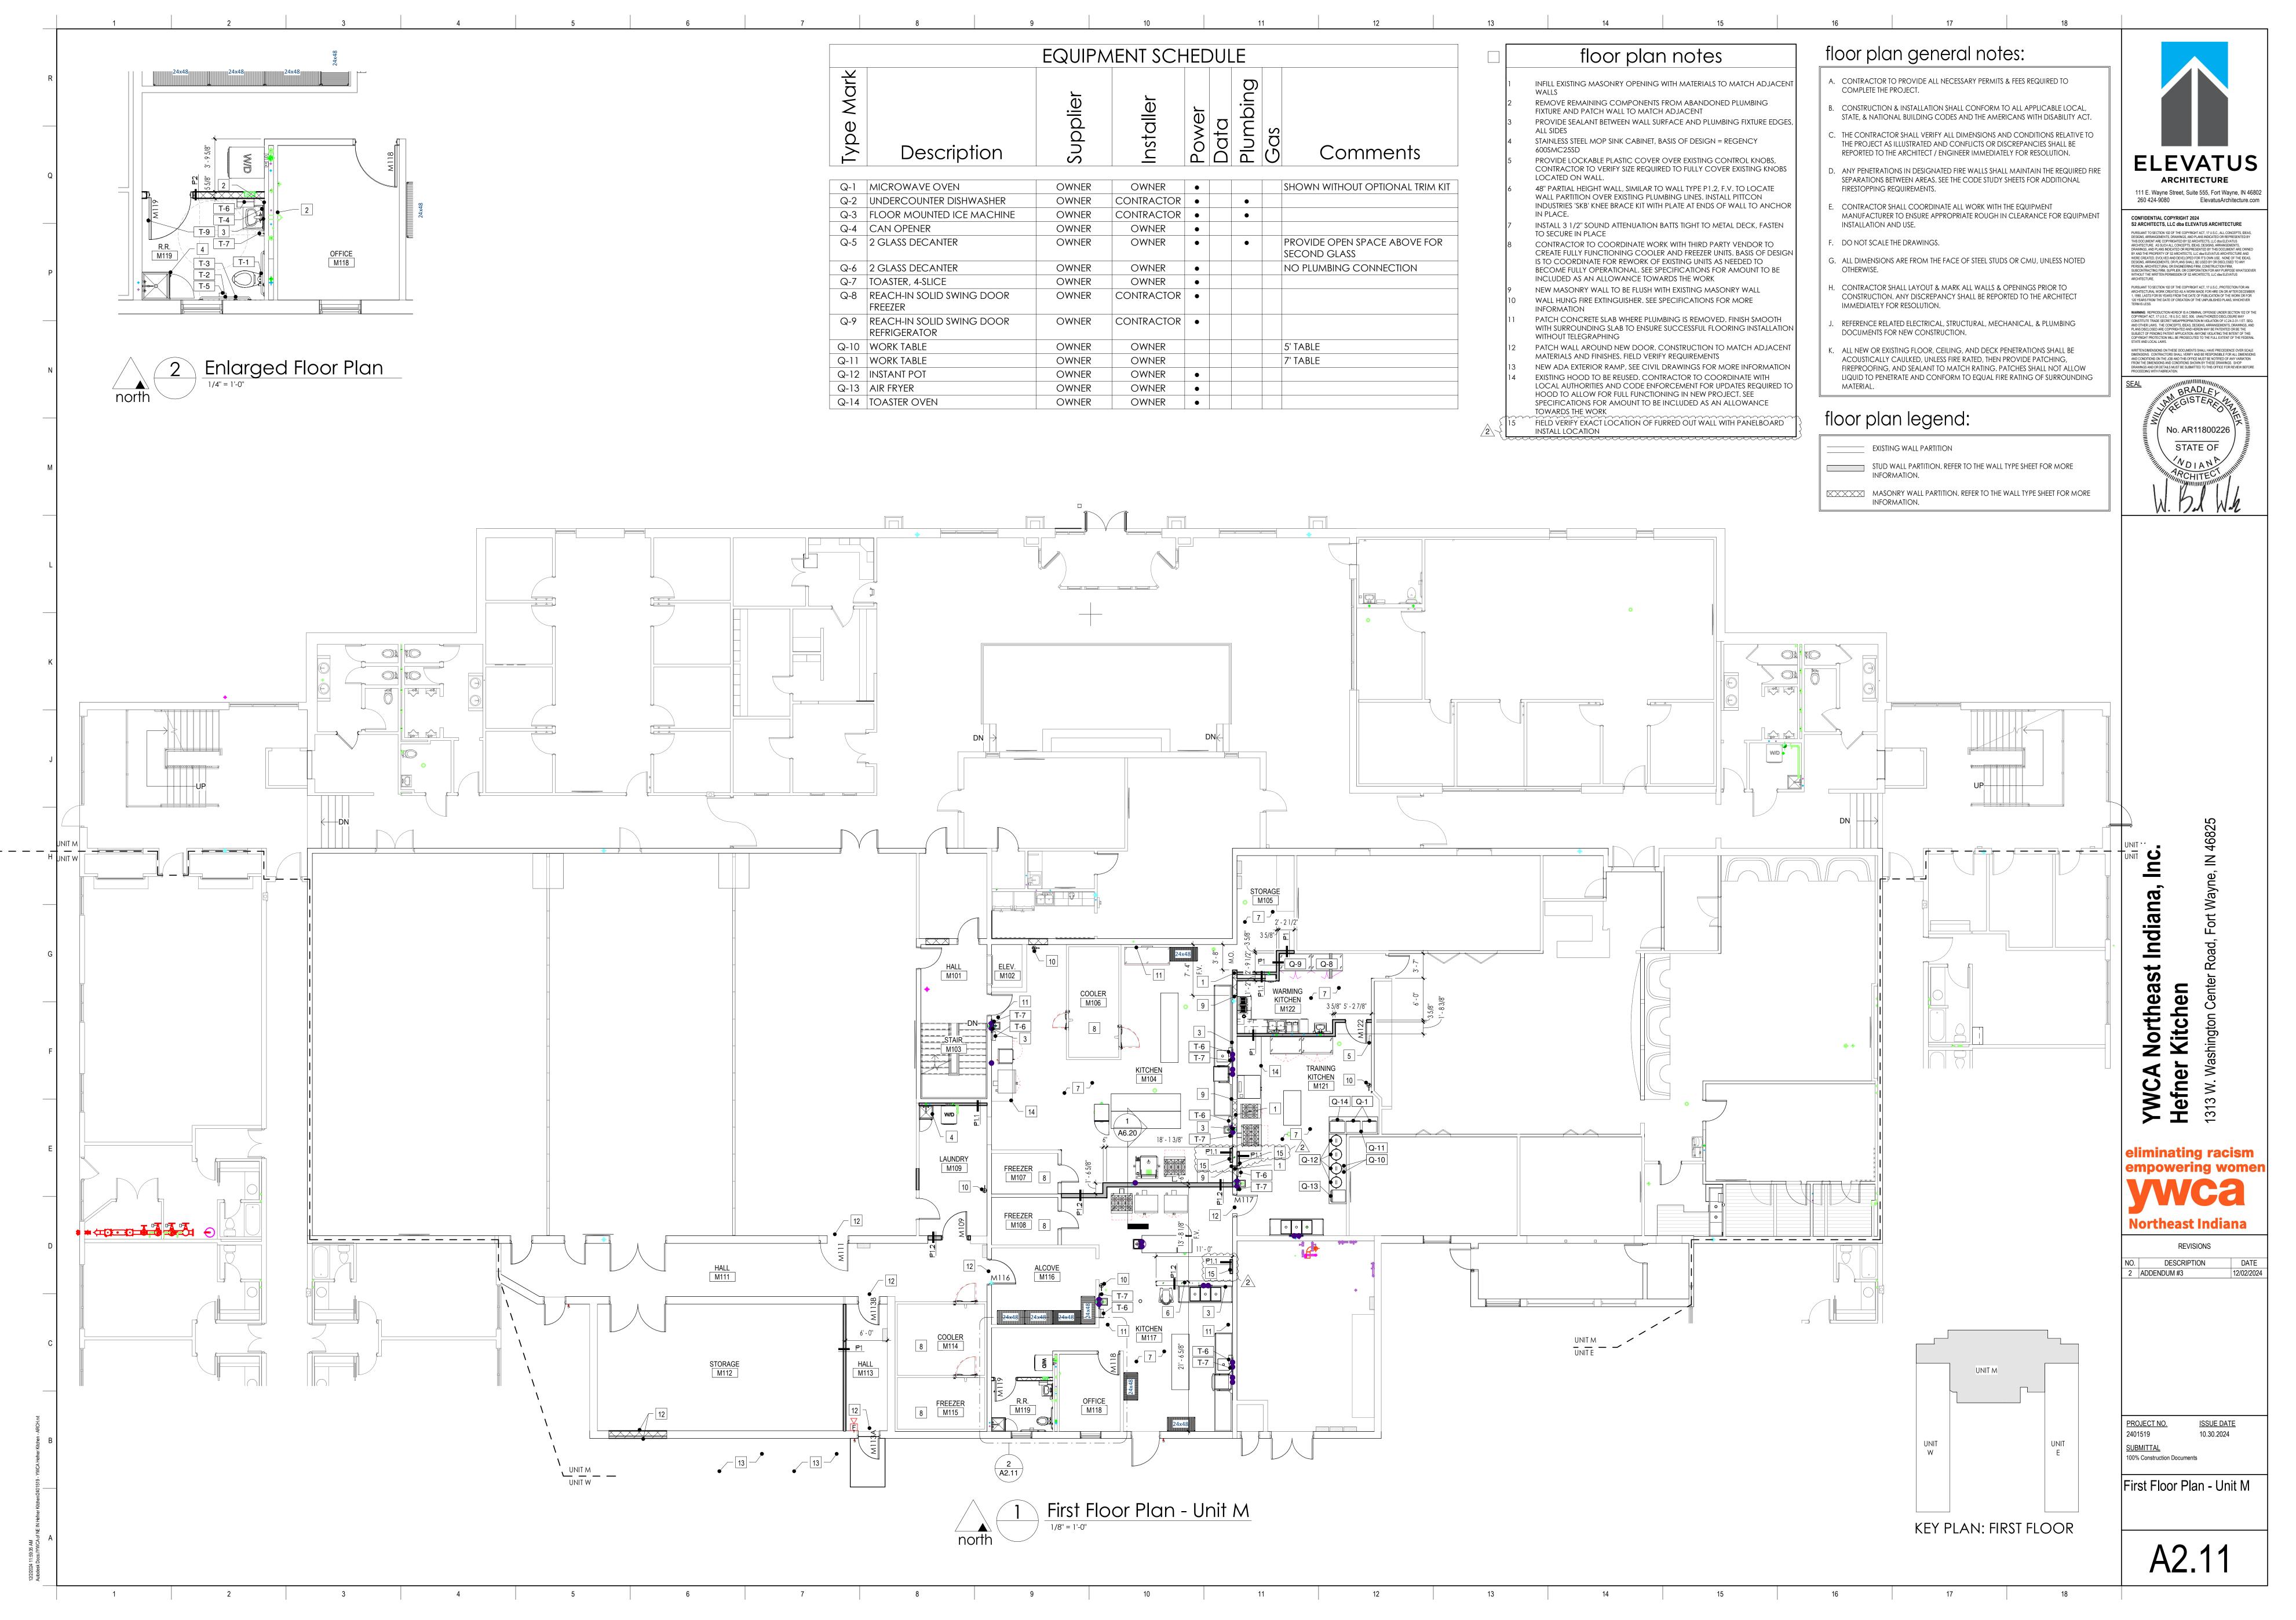

EQUIPMENT SCHEDULE								
Type Mark	Description	Supplier	Installer	Power	Data	Plumbing	Gas	Com
Q-1	MICROWAVE OVEN	OWNER	OWNER	•				SHOWN WITHOUT (
Q-2	UNDERCOUNTER DISHWASHER	OWNER	CONTRACTOR	•		•		
Q-3	FLOOR MOUNTED ICE MACHINE	OWNER	CONTRACTOR	•		•		
Q-4	CAN OPENER	OWNER	OWNER	•				
Q-5	2 GLASS DECANTER	OWNER	OWNER	٠		•		PROVIDE OPEN SPA
Q-6	2 GLASS DECANTER	OWNER	OWNER	•				NO PLUMBING CO
Q-7	TOASTER, 4-SLICE	OWNER	OWNER	•				
Q-8	REACH-IN SOLID SWING DOOR FREEZER	OWNER	CONTRACTOR	٠				
Q-9	REACH-IN SOLID SWING DOOR REFRIGERATOR	OWNER	CONTRACTOR	٠				
Q-10	WORK TABLE	OWNER	OWNER					5' TABLE
Q-11	WORK TABLE	OWNER	OWNER					7' TABLE
Q-12	INSTANT POT	OWNER	OWNER	•				
Q-13	AIR FRYER	OWNER	OWNER	•				
Q-14	TOASTER OVEN	OWNER	OWNER	•				