

Primary Engineering, Inc.

2828 Lake Ave. Fort Wayne, Indiana 46805 260-424-0444 ph www.primary-eng.com



Addendum: 2

Date: 1/3/2024

Project: FWCS Fairfield Elementary School Restroom Renovations 2025

Comm #: **24661**

The following items shall be incorporated into the specifications and drawings and are considered to be integral to the bid documents for the project. Acknowledgement of receipt of this addendum is required on the bid form.

Item #1: General Clarifications.

- A. Refer to attached Architectural Addendum.
- **B.** Existing plumbing chases are not plenums and do not require new PVC piping to be insulated.
- **C.** New lockable thermostat covers for existing radiant ceiling panel thermostats shall be furnished and installed by mechanical contractor.

Item #2: Specification Section 011000 "Summary of Work"

A. Add Part 1.9 H. Refer to attached revised specification section.

Item #3: Drawing Sheet P0.1 "Plumbing Information Sheet"

- A. Delete Typical Mop Sink Detail. Refer to attached drawing revision dated 1/3/25.
- **B.** Plumbing Fixture Schedule: add FD-1. Refer to attached drawing revision dated 1/3/25.

Item #4: Drawing Sheet P1.1 "Plumbing Plans"

- **A.** Intent of Demolition Plan Note 6 and Plan Note 7 is to reconnect piping within existing accessible plumbing chase for fixtures indicated. Existing piping to fixtures from existing accessible plumbing chase is to remain. Contractor is not required to access staff restroom plumbing chases.
- **B.** Revise second floor staff restroom plumbing fixture tags. Add Plan Note 7 to existing second floor plumbing fixtures. Refer to attached drawing revision dated 1/3/25.
- C. Add Demolition Plan Note 9 and Plan Notes 13 and 14. Refer to attached drawing revision dated 1/3/25.
- **D.** Add instances of Plan Note 7 to existing second floor plumbing fixtures. Refer to attached drawing revision dated 1/3/25.
- **E.** Add instances of Plan Note 13 to existing service sinks and mop sinks. Refer to attached drawing revision dated 1/3/25.

F. Remove existing restroom floor drains and replace with new in same location. Reconnect to existing sanitary piping. Refer to attached drawing revision dated 1/3/25.



Addendum D2

re: FORT WAYNE COMMUNITY SCHOOLS

Fairfield Elementary School Restroom Renovation 2025

MPG No. 111029.00

issue date: January 03, 2025

This Addendum forms a part of the Contract Documents for the above-referenced project and is issued in accordance with the Instructions to Bidders. Acknowledge receipt of this addendum by inserting its number in the space provided in the bid form.

ITEM	LOCATION	DESCRIPTION
A2.01	SPECIFICATIONS Section 102113.19 Plastic Toilet Compartments	DELETE: Delete paragraph 2.3 A 4. b. (1) in its entirety. The intent is that urinal screens will be provided by GC and installed as wall hung.
A2.02	SPECIFICATIONS Section 102113.19 Plastic Toilet Compartments	CHANGE: Change 2.3 B 7 to read: Shoe type shall be stainless steel.
A2.03	DRAWING A2.0 (Drawing Reissued)	ADD: Reissue attached Sheet A2.0 Basement, First Floor, & Second Floor Demolition & Floor Plans reissued for clarifications or additions to scope.
A2.04	DRAWING A7.0 (<i>Drawing Reissued)</i>	ADD: Reissue attached Sheet A7.0 Room Finish Schedule, Legends, Finish & Equipment Plans reissued for clarifications or additions to scope.

ITEM

LOCATION

DESCRIPTION

Submitted by:


The Moake Park Group, Inc.





Jeremy M. Ogle, AIA and Principal

attachments: (Reissued Drawing) A2.0 (Reissued Drawing) A7.0

All Plan Holders copies: 111029.00/670

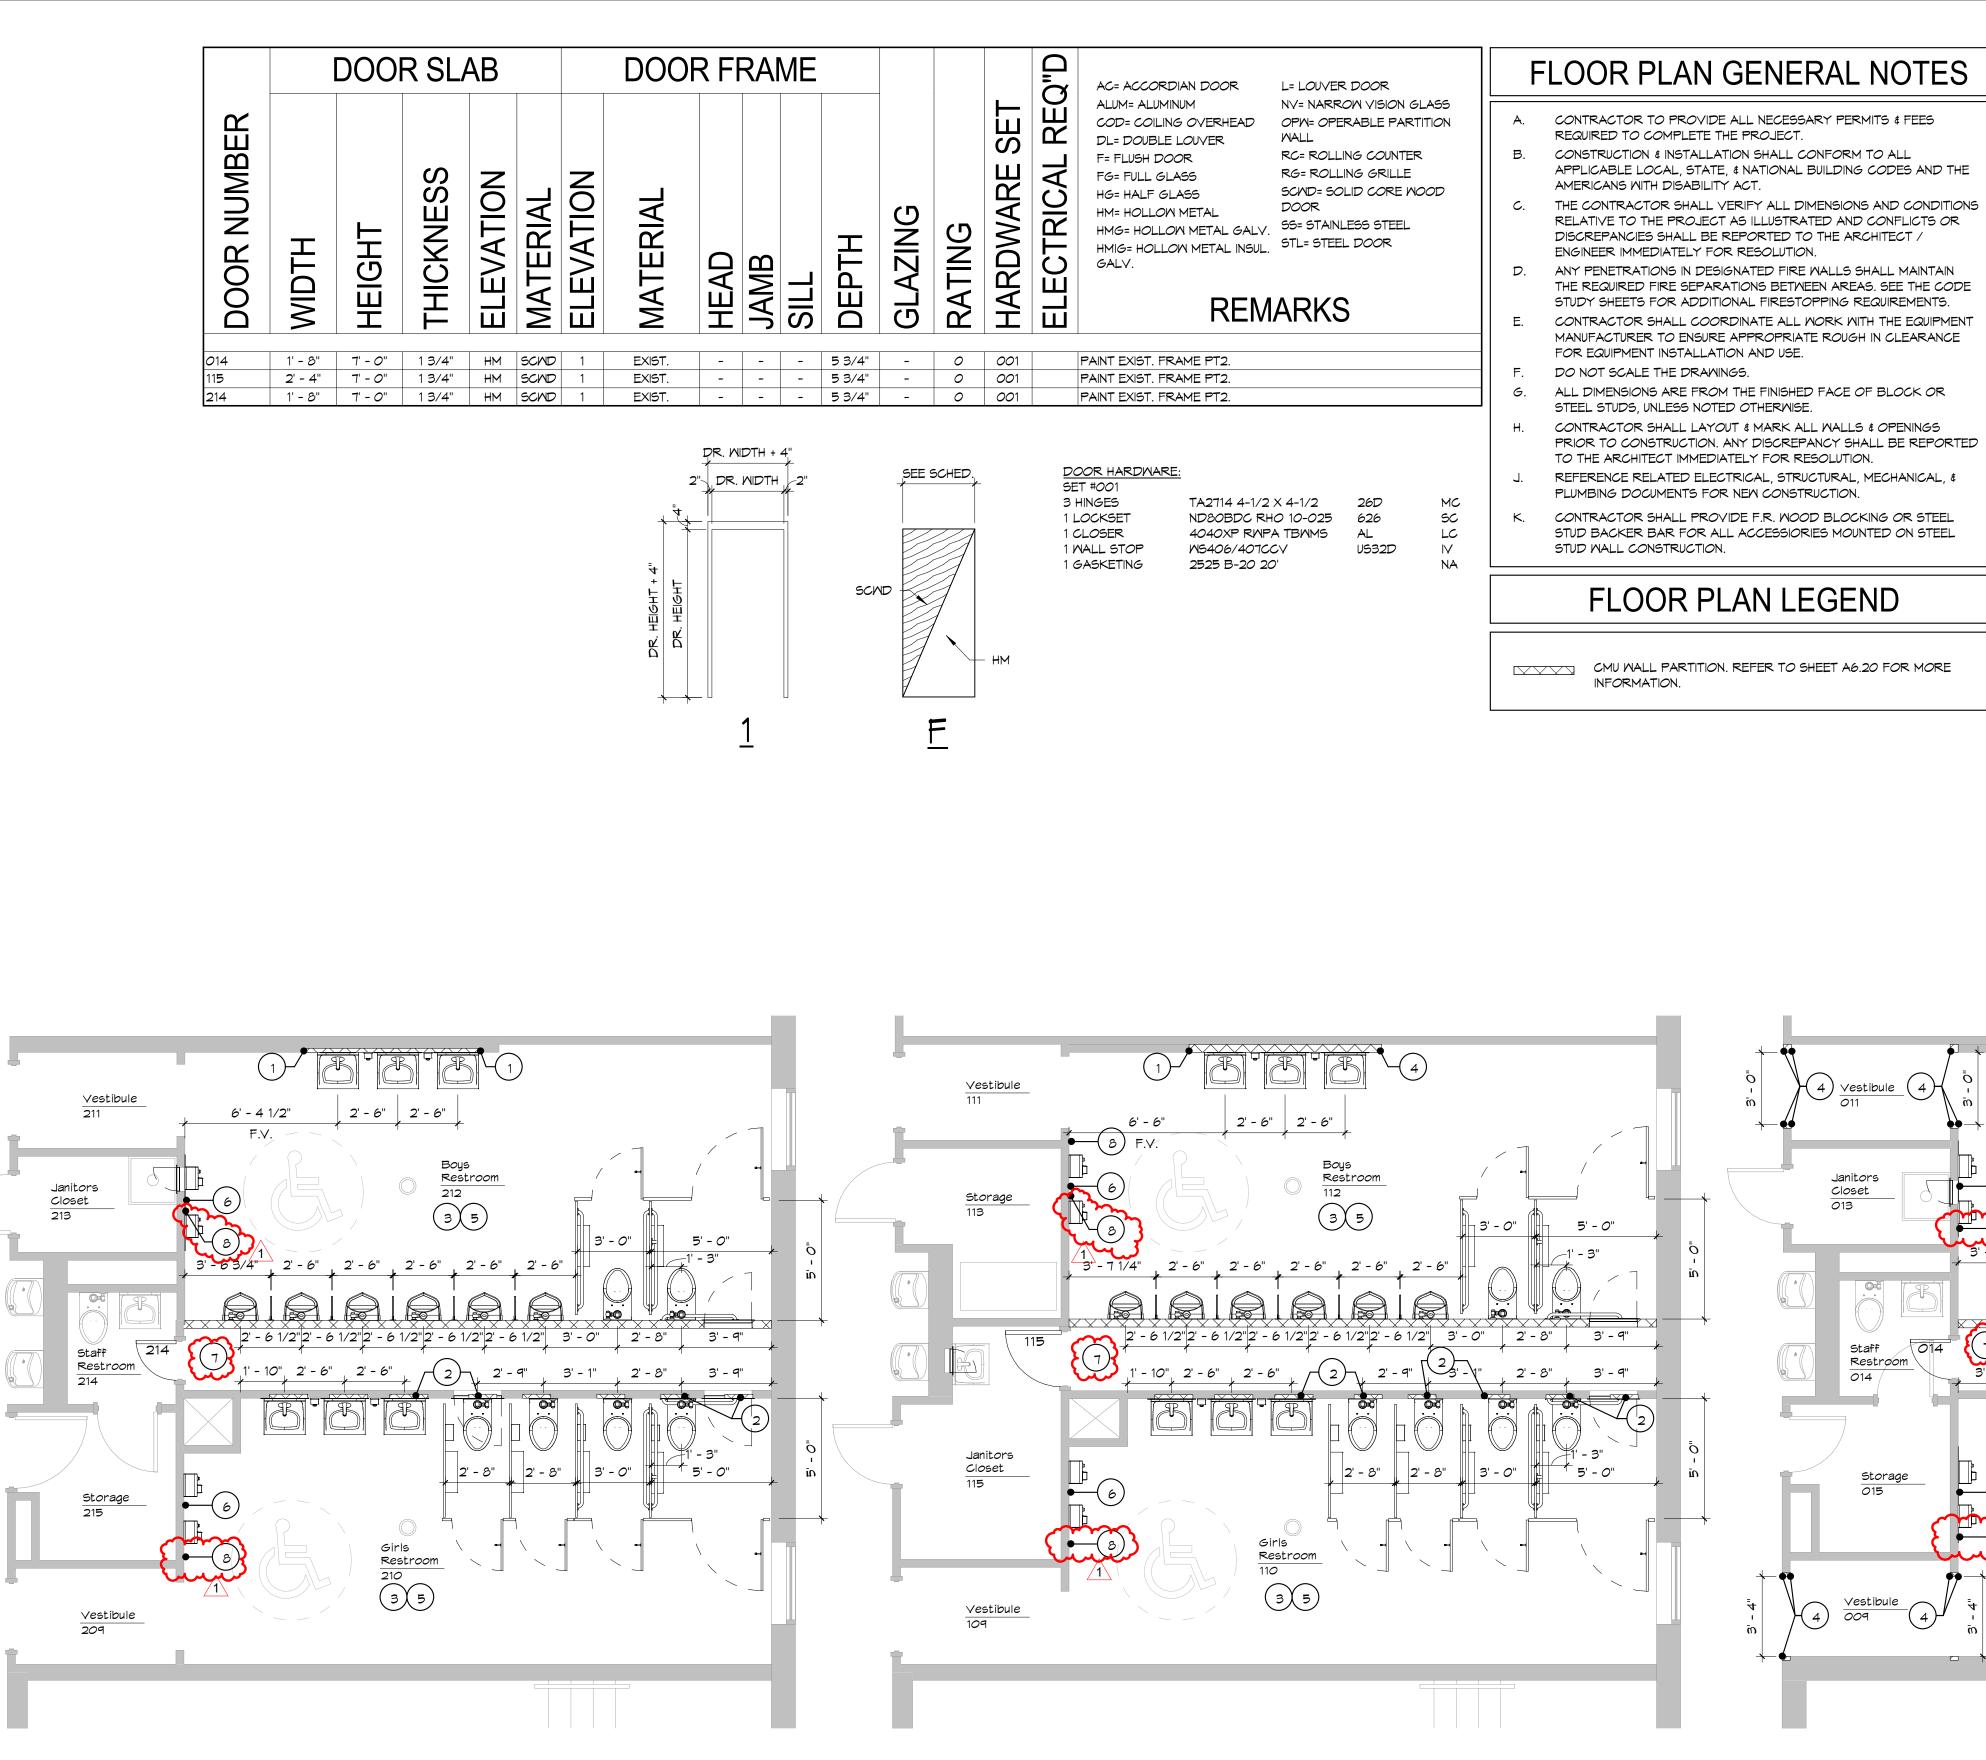

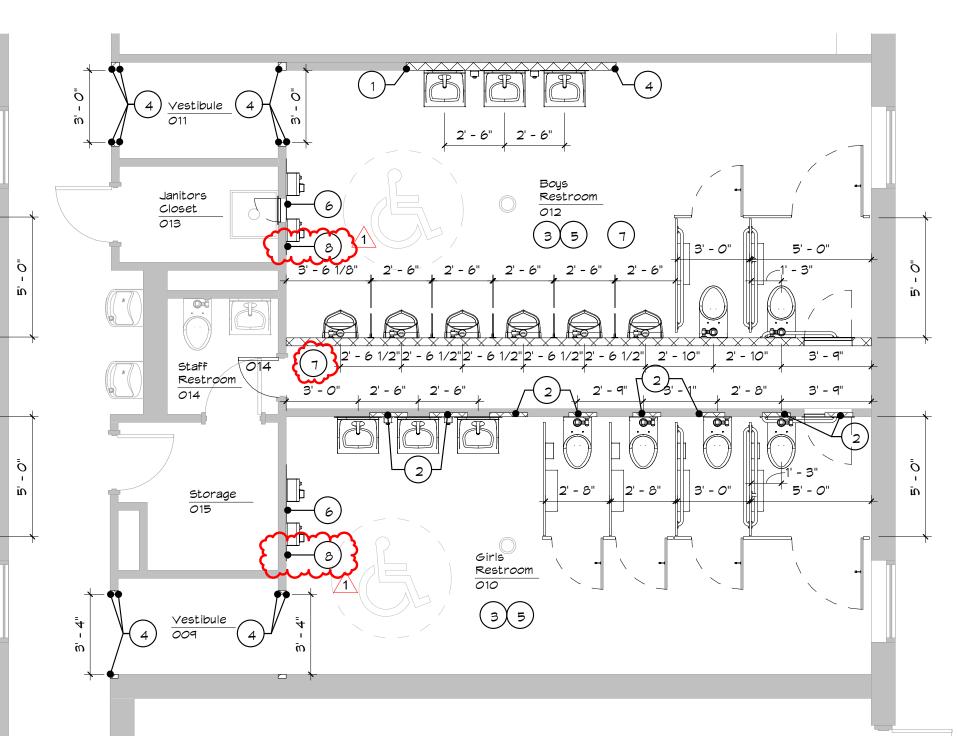


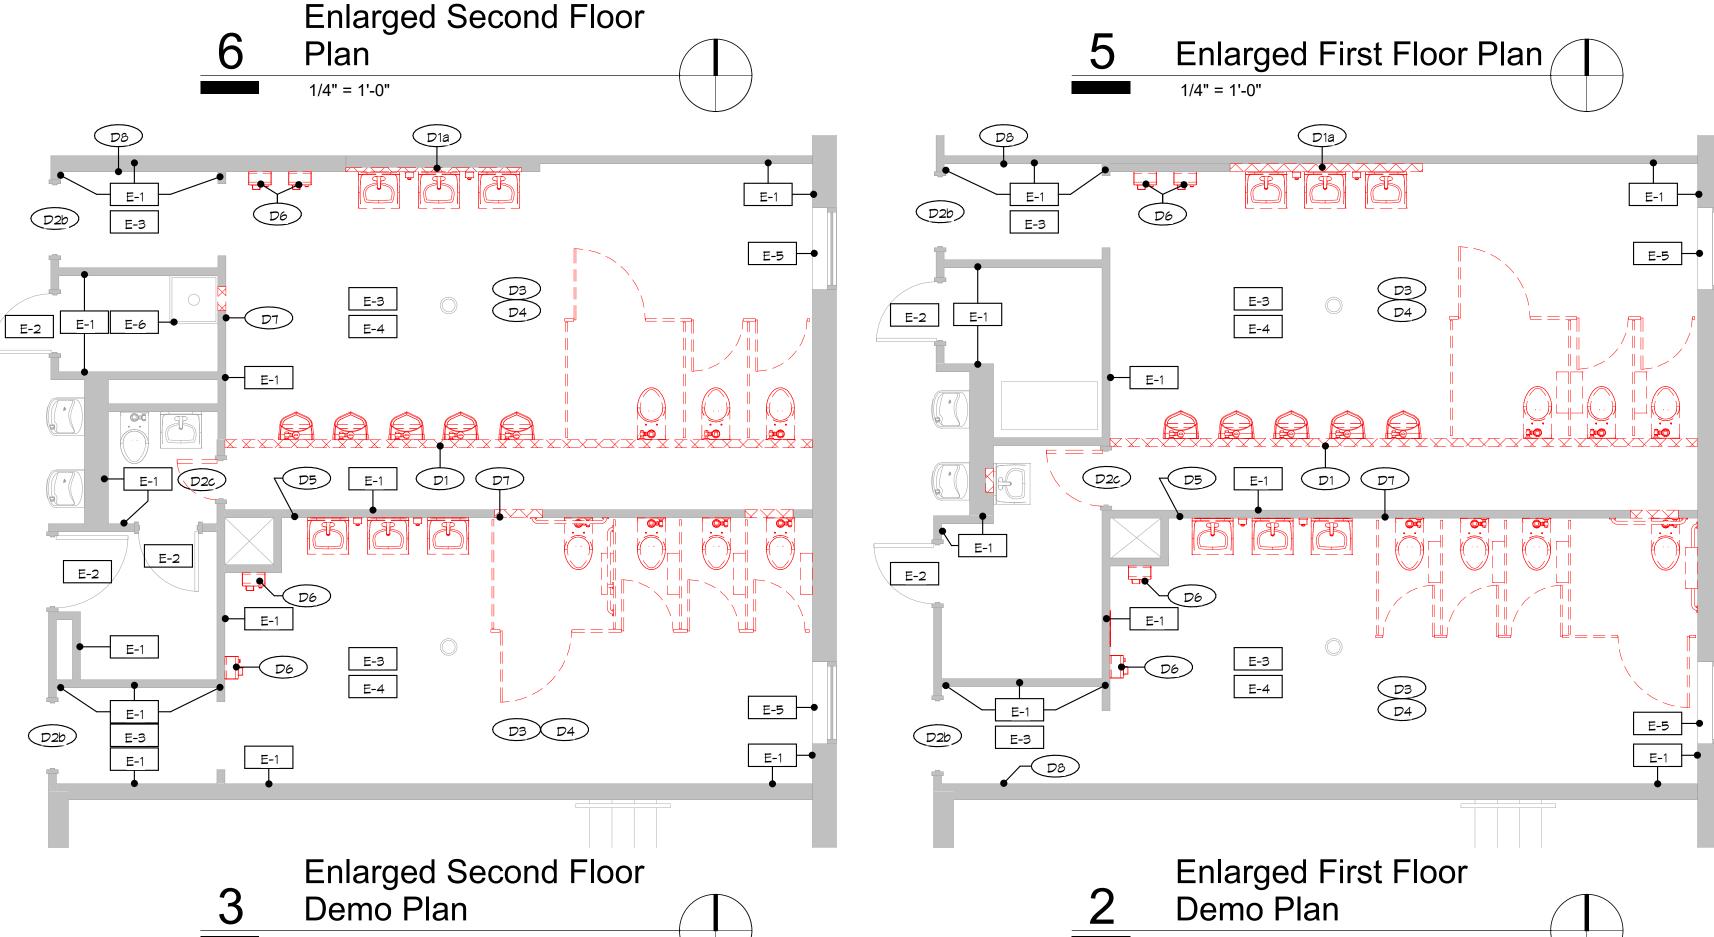

SCALE: 1/8" = 1'-0

SCALE: 3/32" = 1'-0

SCALE: 1/4" = 1'-0

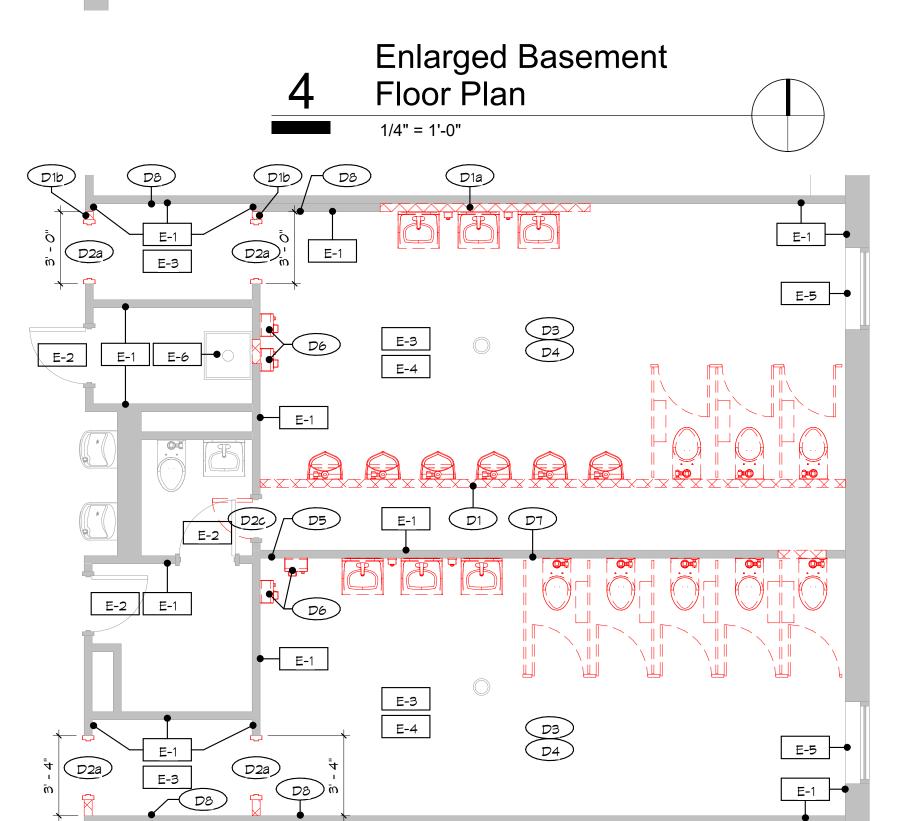

SCALE: 3/4" = 1'-0"

SCALE: 1/2" = 1'-0

Enlarged Basement
Demo Plan

1/4" = 1'-0"

GENERAL PATCHING NOTES

CONTRACTOR TO FILL ALL VOIDS IN CONCRETE FLOOR SLABS (WITH CONCRETE) AS REQUIRED DUE TO REMOVAL OF FLOOR DRAINS, TRENCHES, PITS, MASNORY WALLS, DUCTWORK, ETC. TO MATCH EXISTING ADJACENT FLOOR FINISH ELEVATION. IF REQUIRED, CONTRACTOR SHALL PROVIDE AND INSTALL NEW METAL FLOOR DECKING AND NECESSARY STRUCTURAL SUPPORT TO ACCOMMODATE

THE CONCRETE.

VOIDS IN CMU LESS THAN 1" SHALL BE GROUTED FULL AND PAINTED. VOIDS IN CMU GREATER THAN 1" SHALL BE SOAPED IN W/ FULL MASONRY SOAP UNITS. BLOCK FILL, PRIME AND PAINT TO MATCH

THAN 1 SHALL BE SOAPED IN W/ FULL MASONRY SOAP UNITS. BLOCK FILL, PRIME AND PAINT TO MATCH EXISTING.

WALL SURFACES THAT ARE GYP. BD. OR PLASTER AND DISTURBED DUE TO DEMOLITION / NEW CONSTRUCTION SHALL BE PATCHED BACK WITH LIKE ADJACENT MATERIALS TO CREATE A SMOOTH FLUSH SURFACE. PRIME AND PAINT TO MATCH EXISTING.

CEILING SURFACES SHALL BE PATCHED BACK WITH LIKE ADJACENT MATERIALS TO CREATE A

Specific Floor Plan Notes

SMOOTH FLUSH SURFACE. PRIME AND PAINT TO MATCH EXISTING IF APPLICABLE. PROVIDE

ALIGN NEW WALL CONSTRUCTION W/ EXIST. WALL.

- 2 INFILL EXISTING OPENINGS, ANCHOR HOLES, PLUMBING FIXTURE ATTACHMENT POINTS WITH LIKE ADJACENT MATERIAL IN ACCORDANCE WITH GENERAL PATCHING NOTES. TOOTH IN ALL MASONRY, TYPICAL. PATCH & REPAIR OF TERRAZZO BASE BY OWNER CONTRACTOR.
- 3 PATCH & REPAIR OF EXISTING TERRAZZO FLOOR & BASE TO BE BY OWNER CONTRACTOR.
- 4 PROVIDE BULLNOSE BLOCK AT OUTSIDE CORNERS.

MATCHING GRID AND CEILING TILE, TYPICAL.

- COORDINATE LAVATORY & WATER CLOSET HEIGHTS WITH MEP DWGS.
- COORDINATE LAVATORY & WATER CLOSET HEIGHTS WITH MEP DWGS.
- 4' WIDE, 18 GAUGE TYPE 304 STAINLESS STEEL PANEL W/ #4 FINISH. LASER CUT EASED EDGE W/ 1/2" BEVEL. PANEL TO BE ADHERED TO WALL FROM FINISHED UNDERSIDE OF HAND DRYER TO TOP OF BASE. EDGES SHALL BE SEALED WITH CLEAR SILICONE CAULKING.
- 7 CONTRACTOR SHALL POUR NEW CONCRETE FLOOR FLUSH WITH ADJACENT FINISH FLOOR AND LEVEL TO A TOLERANCE OF 1:48. EXISTING SLAB DEPRESSION IS +/- 4".

 CONTRACTOR SHALL F.V. SCOPE OF WORK.
- 8 GC SHALL PATCH CEILING GRID AT FORMER SURFACE RACEWAY LOCATION. MATCH
 EXISTING ADJACENT GRID COLOR AND PROFILE. REMOVE GRID AND REPLACE TO
 NEAREST INSIDE CORNER FOR A "ONE SEAM" FINISHED APPEARANCE.

GENERAL DEMOLITION NOTES:

1. <u>ALL MATERIALS INDICATED AS DASHED AND HATCHED ARE TO BE DEMOLISHED.</u> THIS INCLUDES ALL MATERIALS AND FINISHES NOT SPECIFICALLY CALLED OUT BUT PERTAINING TO THE INTENDED

- SCOPE.

 2. THE OWNER SHALL REMOVE ALL FURNISHINGS, AND LOOSE EQUIPMENT TO REMAIN THE OWNERS.

 ALL REMAINING ITEMS SHALL BE DEMOLISHED. UNLESS NOTED OTHERWISE.
- 3. THE CONTRACTOR SHALL REMOVE AND/OR DEMOLISH ITEMS INDICATED. DEMOLISHED ITEMS SHALL BE REMOVED FROM THE SITE IMMEDIATELY BY THE GENERAL CONTRACTOR UNLESS NOTED OTHERWISE. ALL ITEMS TO REMAIN PROPERTY OF THE OWNER SHALL BE STORED ON SITE AS INDICATED BY THE OWNER.
- AS INDICATED BY THE OWNER.

 4. IF HAZARDOUS MATERIALS ARE UNCOVERED CONTACT THE ARCHITECT/ ENGINEER. ALL
 HAZARDOUS MATERIALS SHALL BE REMOVED BY THE OWNER SEPARATE FROM THIS CONTRACT
 ALLOW TIME FOR ABATEMENT IN SCHEDULE.
- 5. THE CONTRACTOR SHALL BE RESPONSIBLE FOR VISITING THE SITE TO BECOME FAMILIAR WITH THE EXISTING CONDITIONS. THESE DEMOLITION SHEETS SHALL SERVE TO AID THE CONTRACTOR IN HIS EVALUATION OF THE EXTENT OF DEMOLITION, BUT SHALL NOT BE HELD TO BE ALL INCLUSIVE.
- 5. THE CONTRACTOR SHALL FIELD VERIFY ALL EXISTING WALL, FLOOR, AND CEILING/ROOF CONSTRUCTION TO DETERMINE EXTENT AND METHODS OF DEMOLITION TO ALLOW FOR NEW CONSTRUCTION.
- CONSTRUCTION TO DETERMINE EXTENT AND METHODS OF DEMOLITION TO ALLOW FOR NEW CONSTRUCTION.

 I. FOR FURTHER INFORMATION WITH REGARD TO THE EXACT EXTENT OF DEMOLITION, SEE THE
- CONSTRUCTION PLANS WHICH ILLUSTRATE THE NEW CONSTRUCTION.

 8. THE CONTRACTOR SHALL BE RESPONSIBLE FOR ALL DEMOLITION REQUIRED FOR THE INSTALLATION OF NEW WORK, WHETHER OR NOT IT IS SPECIFICALLY SHOWN OR NOTED IN THESE
- INSTALLATION OF NEW WORK, WHETHER OR NOT IT IS SPECIFICALLY SHOWN OR NOTED IN THESE DOCUMENTS.

 9. THE CONTRACTOR SHALL FIELD INSPECT ALL DEMOLITION WORK, PRIOR TO REMOVAL, TO VERIFY ALL EXISTING STRUCTURAL BEARING CONDITIONS AND TO INSURE SUCH REMOVAL DOES NOT IMPAIR STRUCTURAL INTEGRITY OF EXISTING BUILDING, IF FIELD INSPECTION INDICATES
- NOT IMPAIR STRUCTURAL INTEGRITY OF EXISTING BUILDING. IF FIELD INSPECTION INDICATES STRUCTURAL INTEGRITY MAY BE IMPAIRED, NOTIFY ARCHITECT/ENGINEER IMMEDIATELY. CONTRACTOR IS RESPONSIBLE TO SHORE THE EXISTING STRUCTURE AS REQUIRED TO ALLOW FOR DEMOLITION AND/OR NEW WORK.
- 10. IF EXISTING BUILDINGS, STRUCTURES, ETC. ARE NOT SHOWN AS DETAILED, CONTACT THE ARCHITECT/ENGINEER.
 11. THE CONTRACTOR SHALL REMOVE ALL DEBRIS, LOOSE PAINT, ETC., FROM ALL NEWLY EXPOSED
- SURFACES.

 12. ALL AREAS TO REMAIN THAT ARE AFFECTED BY DEMOLITION & NEW WORK SHALL BE PATCHED TO MATCH EXISTING ADJACENT CONSTRUCTION AND FINISH.
- 3. UNLESS NOTED OTHERWISE, ALL FLOOR, CEILING AND DECK PENETRATIONS SHALL BE PATCHED AND FIRESTOPPED TO MATCH EXISTING. PATCHES SHALL NOT ALLOW LIQUID TO PENETRATE AND SHALL CONFORM TO EQUAL FIRE RATING OF SURROUNDING MATERIAL.
- 4. CONTRACTOR TO FILL ALL VOIDS IN CONCRETE FLOOR SLABS (WITH CONCRETE) AS REQUIRED DUE TO REMOVAL OF FLOOR DRAINS, TRENCHES, PITS, MASONRY WALLS, DUCTWORK, ETC. TO MATCH EXISTING ADJACENT FLOOR FINISH ELEVATION. IF REQUIRED, CONTRACTOR SHALL PROVIDE AND INSTALL NEW METAL FLOOR DECKING AND NECESSARY STRUCTURAL SUPPORT TO ACCOMMODATE THE CONCRETE.
- 15. FOR ADDITIONAL DEMO. INFORMATION, SEE DEMOLITION WALL SECTIONS IN THE A6 SERIES.

 16. CONTRACTOR TO REMOVE DOOR LEAFS & TEMPORARILY STORE TO ALLOW FOR DEMOLITION & NEW WORK, ONCE WORK COMMENCES IN THIS AREA. FURTHERMORE, GENERAL CONTRACTOR TO TEMPORARILY SUPPORT THE EXISTING DOOR FRAMES AND PROVIDE NEW JAMB ANCHORS TO
- RECONNECT DOOR FRAME TO THE NEW CMU. GROUT SIDE JAMBS FULL.

 17. CONTRACTOR TO REMOVE CEILING SYSTEM ADJACENT DEMOLISHED CMU AS REQUIRED TO ALLOW FOR NEW WORK. SEE THE REFLECTED CEILING PLANS FOR MORE INFORMATION.

 18. CONTRACTOR TO PROTECT TERRAZZO DURING DEMOLITION WITH PLYWOOD AND REMOVE PROTECTION FOR OWNER SEPARATE CONTRACT TO PATCH & REFINISH TERRAZZO PRIOR TO NEW WORK. PROTECT REFINISHED TERRAZZO WITH RAMBOARD DURING CONSTRUCTION OF NEW

MORK. ALLOW TIME IN SCHEDULE FOR PATCHING & REFINISHING OF EACH FLOOR.

SPECIFIC DEMOLITION PLAN NOTES

- CONTRACTOR TO REMOVE AND DISPOSE OF EXISTING WALL TO MORTAR LINE ABOVE TERRAZZO BASE TO ALLOW FOR NEW CONSTRUCTION, INCLUDING, BUT NOT LIMITED TO, ELECTRICAL DEVICES, AND APPLIED FINISHES. SHORE REMAINING WALL AS REQUIRED THROUGHOUT DURATION OF CONSTRUCTION. CONTRACTOR SHALL F.Y. SCOPE OF WORK. COORDINATE WITH NEW WORK SHEETS.
- D1a CONTRACTOR TO SELECTIVELY REMOVE AND DISPOSE OF EXISTING WALL TO MORTAR LINE ABOVE TERRAZZO BASE TO ALLOW FOR NEW LAVATORY INSTALLATION, INCLUDING, BUT NOT LIMITED TO, ELECTRICAL DEVICES, AND APPLIED FINISHES. SHORE REMAINING WALL AS REQUIRED THROUGHOUT DURATION OF CONSTRUCTION. CONTRACTOR SHALL F.V. SCOPE OF WORK. COORDINATE WITH NEW WORK SHEETS.
- (D1b) CONTRACTOR TO SELECTIVELY REMOVE AND DISPOSE OF EXISTING WALL AS REQUIRED TO ALLOW FOR NEW CONSTRUCTION, INCLUDING, BUT NOT LIMITED TO, ELECTRICAL DEVICES, AND APPLIED FINISHES. CONTRACTOR SHALL F.V. SCOPE OF WORK. COORDINATE WITH NEW WORK SHEETS.
- D2a CONTRACTOR SHALL REMOVE AND DISPOSE OF EXISTING DOOR FRAME AND ALL RELATED HARDWARE. PATCH AND REPLACE MASONRY WITH FULL UNITS WITH BULLNOSE OUTSIDE CORNERS AS APPLICABLE. CONTRACTOR SHALL F.V. SCOPE OF WORK.
- D2b) CONTRACTOR SHALL REMOVE AND DISPOSE OF EXISTING DOOR HARDWARE. PATCH & REPAIR DOOR FRAME WITH FILLER PLATES, PREP FOR NEW PAINT. CONTRACTOR SHALL EVISCOPE OF WORK
- D2C CONTRACTOR SHALL REMOVE AND DISPOSE OF EXISTING DOOR LEAF AND ALL RELATED HARDWARE. CONTRACTOR SHALL PREP EXISTING DOOR FRAME TO RECEIVE NEW DOOR LEAF & HARDWARE CONTRACTOR SHALL F.V. SCOPE OF WORK.
- CONTRACTOR SHALL REMOVE & DISPOSE OF EXISTING TOILET PARTITIONS & ACCESSORIES IN THEIR ENTIRETY, INCLUDING BUT NOT LIMITED TO, BRACKETS, WALL ANCHORS. CONTRACTOR TO FIELD VERIFY THE SCOPE OF WORK. TOILET PAPER & SOAP DISPENSERS TO BE SALVAGED & TURNED OVER TO OWNER. WALLS TO BE PATCHED WITH LIKE ADJACENT MATERIAL. TERRAZZO FLOOR PATCH BY OWNER SEPARATE CONTRACT.
- D4 CONTRACTOR TO COORDINATE PLUMBING FIXTURE DEMOLITION WITH MEP DWG'S. PATCH WALLS WITH LIKE ADJACENT MATERIAL AFTER REMOVAL. TERRAZZO FLOOR PATCH BY OWNER SEPARATE CONTRACT.
- D5 CONTRACTOR SHALL REMOVE & DISPOSE OF EXISTING WATER SPIGOT. SEE PLUMBING DWG'S FOR MORE INFO. PATCH & REPAIR CMU WALL AS REQUIRED PER GENERAL PATCHING NOTES.
- D6) CONTRACTOR SHALL REMOVE & DISPOSE OF EXISTING HAND DRYERS & STAINLESS STEEL PLATES IN THEIR ENTIRETY. REMOVE ALL ADHESIVE FROM WALL & PREP FOR NEW PAINT.

 D7) CONTRACTOR SHALL REMOVE & DISPOSE OF EXISTING METAL COVER FROM WALL. INFILL
- CMU IN ACCORDANCE WITH GENERAL PATCHING NOTES.


 D8 CONTRACTOR SHALL REMOVE & DISPOSE OF EXISTING DOOR BUMPER FROM WALL. PATCH CMU WALL IN ACCORDANCE WITH GENERAL PATCHING NOTES.

EXISTING TO REMAIN NOTES

- E-1 EXISTING WALL TO REMAIN.
- E-2 EXISTING DOOR, FRAME, & HARDWARE TO REMAIN. PREP FRAME FOR NEW PAINT.
- E-3 EXISTING TERRAZZO FLOORING TO REMAIN. PROTECT THROUGHOUT CONSTRUCTION. PATCH & REPAIR BY OWNER CONTRACTOR.
- E-4 EXISTING SUSPENDED CEILING SYSTEM TO REMAIN. COORDINATE WITH MEP DWG'S FOR
- WORK ABOVE CEILING.

 E-5 EXISTING TERRAZZO WINDOW SILL TO REMAIN. PROTECT THROUGHOUT CONSTRUCTION.
- E-6 EXISTING MOP SINK TO REMAIN. PROTECT THROUGHOUT CONSTRUCTION.



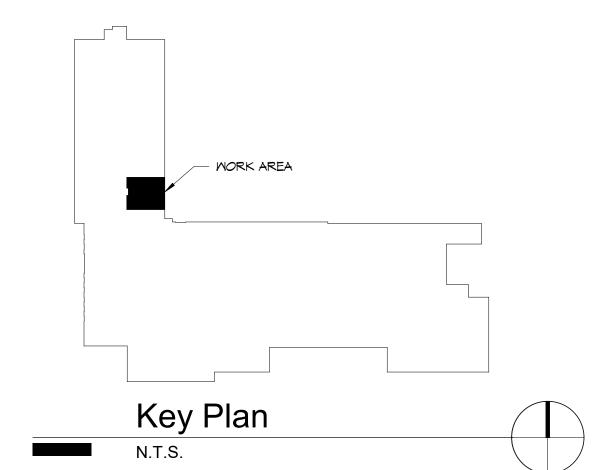

MOAKE PARK GROU ARCHITECTURE INTERIORS PLANNIN 7223 Engle Rd. Suite 200, Fort Wayne, IN 46804 260-424-6516

The concepts, ideas, plans, and details as shown on this document are the sole property of Moake Park Group, Inc and were created, developed, and presented for the use on this specific project. None of the concepts, ideas, designs, plans and details shall be used by any person, firm, or corporation for any purpose whatsoever without expressed written consent of Moake Park Group, Inc.. The Owner shall be permitted to retain copies fo information and reference in connection with this project.

description

1-3-25 Addendum 2

F W C S
WE ARE YOUR SCHOOLS

mark

RAYNE COMMUNITY SCHO

Fairfield Elementary School

Restroom Renovation 2025

CERTIFICATION:



DATE: 12/09/2024 COMM: 111028

SCHOOL: Fairfield Elementary School 2825 Fairfield Ave

Fort Wayne Indiana 46807

**LE:

**Rement_First Floor_ & Comment_First Floor_ & Comment_Fir

Basement, First Floor, & Second Floor Demolition & Floor Plans

SHEET:

A2.0

FINISH LEGEND						
FLOOR	MALL	CEILINGS				
EXT = EXISTING	PT = PAINT COLOR	ACP = ACOUSTICAL CEILING SYSTEM				
EXT1 - TO REMAIN	PT1 - PPG TYPE: ENAMEL	ACP1 - USG (FOR PANEL REPLACEMENT AS NEEDED) STYLE: SHEETROCK BRAND LAY-IN GYPSUM CEILING PANELS NUMBER: 3260 SIZE: 24X24 COLOR: WHITE EDGE: SQUARE GRID: 15/16" HEAVY DUTY WHITE EXT = EXISTING				
TZ = TERRAZZO TZ1 - THIN SET TERRAZZO FOR PATCHING	FINISH: GLOSS					
BY OWNER SEPARATE CONTRACT	COLOR: FMCS SPECIAL UMBER NUMBER: PITT-TECH PLUS					
BASE	PT2 - PPG (HMDF) TYPE: ENAMEL					
TZB = TERRAZZO TZB1 - THIN SET TERRAZZO FOR PATCHING BY OWNER UNDER SEPARATE CONTRACT	FINISH: GLOSS COLOR: KNIGHTS ARMOR					
EXISTING	NUMBER: PPG1001-6	EXT1 - EXISTING TO REMAIN EXT2 - EXISTING PRIMED & PAINTED				
EXT1 - TO REMAIN	EXT1 - EXISTING TO REMAIN	FINISH: FLAT COLOR: PT1				

GENERAL FLOORING REMARKS

- a. ONLY A STRAIGHT EDGE METAL SCHLUTER STRIP SHALL BE USED BETWEEN TWO DIFFERENT MATERIALS TO PROTECT THE EDGES. A SLOPE PROFILE METAL SCHLUTER IS NOT ACCEPTABLE. DOOR TRANSITIONS BETWEEN ROOMS TO OCCUR AT FINISH FACE OF DOOR SLAB IF PRESENT OR CENTERLINE OF OPENING UNLESS OTHERWISE NOTED. SEE FLOOR TRANSITION DETAIL.
- CONTRACTOR TO PROVIDE UP TO 1/8" OF FLOOR LEVELING WHEREVER A NEW FLOOR FINISH IS TO BE INSTALLED. ALL FLOORS TO BE LEVEL TO A TOLERANCE OF 1:48.

			Roo	om Finis	sh Sche	dule			
Room		Floor Finish	Base Finish	Walls				Ceiling	
Number				North	South	East	West		Comments
009	Vestibule	TZ1	TZB1	PT1	PT1	PT1	PT1	EXT2	
010	Girls Restroom	TZ1	TZB1	PT1	PT1	PT1	PT1	EXT1	
<i>O</i> 11	Vestibule	TZ1	TZB1	PT1	PT1	PT1	PT1	EXT2	
012	Boys Restroom	TZ1	TZB1	PT1	PT1	PT1	PT1	EXT1	
013	Janitors Closet	EXT1	EXT1	EXT1	EXT1	EXT1	EXT1	EXT1	
014	Staff Restroom	EXT1	EXT1	EXT1	EXT1	EXT1	EXT1	EXT1	
015	Storage	EXT1	EXT1	EXT1	EXT1	EXT1	EXT1	EXT1	
109	Vestibule	TZ1	TZB1	PT1	PT1	PT1	PT1	EXT2	
110	Girls Restroom	TZ1	TZB1	PT1	PT1	PT1	PT1	EXT1	
111	Vestibule	TZ1	TZB1	PT1	PT1	PT1	PT1	EXT2	
112	Boys Restroom	TZ1	TZB1	PT1	PT1	PT1	PT1	EXT1	
113	Storage	EXT1	EXT1	EXT1	EXT1	EXT1	EXT1	EXT1	
115	Janitors Closet	EXT1	EXT1	EXT1	EXT1	EXT1	EXT1	EXT1	
209	Vestibule	TZ1	TZB1	PT1	PT1	PT1	PT1	EXT2	
210	Girls Restroom	TZ1	TZB1	PT1	PT1	PT1	PT1	EXT1	
211	Vestibule	TZ1	TZB1	PT1	PT1	PT1	PT1	EXT2	
212	Boys Restroom	TZ1	TZB1	PT1	PT1	PT1	PT1	EXT1	
213	Janitors Closet	EXT1	EXT1	EXT1	EXT1	EXT1	EXT1	EXT1	
214	Staff Restroom	EXT1	EXT1	EXT1	EXT1	EXT1	EXT1	EXT1	
215	Storage	EXT1	EXT1	EXT1	EXT1	EXT1	EXT1	EXT1	

GENERAL PAINT/WALL FINISH REMARKS

- PAINT ALL NEW HOLLOW METAL DOOR FRAMES, SIDE LIGHT FRAMES AND WINDOW FRAMES PT2 U.N.O. PAINT FACE AND UNDERSIDE OF GYP. BD. BULKHEADS TO MATCH ADJ. WALL, UNO.
- ALL STAINED WOOD IN BUILDING SHALL BE STAINED TO MATCH PROJECT DOORS. OBTAIN APPROVED ACTUAL DOOR SAMPLE FROM G.C.
- WALL FINISHES FOR ANY GIVEN WALL SHALL CONTINUE INTO MAJOR AND MINOR OFFSETS INCLUDING, BUT NOT LIMITED TO GYP. BD. WINDOW HEAD AND JAMBS.

Accessory Schedule								
Type								
Mark	Description	Manufacturer	Model	Supplier	Installer	Comments		
T-1	Grab Bar - 36"	American Specialties, Inc.	3800 X 42"	GC	GC			
T-2	Grab Bar - 18"	American Specialties, Inc.	3800 X 42"	GC	GC			
T-3	Grab Bar - 42"	American Specialties, Inc.	3800 X 42"	GC	GC			
T-4	Toilet Tissue Dispenser	Merfin	529002	Salvage	GC	Salvage existing for reinstall.		
T-5	Sanitary Napkin Disposal - Surface Mount	Rubbermaid	#6140	Salvage	GC	Salvage existing for reinstall.		
T-6	American Dryer ExtremeAir EXT	American Dryer	EXT	GC	GC	Steel Black Graphite; no substitutions. Set to lowest airflow setting.		
T-7	24" x 36" Mirror	Bobrick	B-290 2436	GC	GC			
T-8	Soap Dispenser	Ecolab	92021204	Salvage	GC	Salvage existing for reinstall.		
T-9	Coat Hook	Bobrick	B212	GC	GC			
T-10	Access Door - 24" x 24"	Babcock-Davis	BNPC	GC	GC	Keyed for Stanley BEST 7-Pin Core		
T-10 T-11	Access Door - 12" x 12"	Babcock-Davis	BNPC	GC	GC	Keyed for Stanley BEST 7-Pin Core		
GENERAL TO	OILET ACCESSORY NOTES:							


GENERAL TOILET ACCESSORY NOTES:


- A. MANUFACTURERS AND MODEL NUMBERS ARE USED FOR QUALITY CONTROL ONLY. THEY ARE NOT INTENDED TO LIMIT TO ONE MANUFACTURER. SUBMIT ALTERNATE PRODUCT INFORMATION AS PER THE PROVISIONS OF THE BID
- B. PROVIDE BLOCKING FOR ALL GRAB BARS, TOWEL BARS, AND ALL ACCESSORIES.
- C. SEE FLOOR PLANS, ENLARGED PLANS, AND FINISH PLANS FOR ADDITIONAL TOILET ACCESSORY NOTATION.
- D. CONTRACTOR TO LOCATE CHASE ACCESS DOORS IN HANDICAP TOILET STALLS ABOVE THE GRAB BARS UNLESS NOTED OTHERWISE. E. CONTRACTOR TO COORDINATE & ADJUST HORIZONTAL MOUNTING LOCATIONS WITH ADJACENT ACCESSORIES TO MAINTAIN CLEARANCE WITHIN THE STALL & TO COMPLY WITH ADA ACCESSIBILITY REQUIREMENTS.
- SEE REFLECTED CEILING PLANS FOR CEILING MOUNTED SHOWER CURTAIN TRACKS AND CURTAINS.
- G. CONTRACTOR TO VERIFY AND INSTALL ACCESSORIES TO COMPLY WITH CURRENT ADA CODE. SEE SHEET A2.20 FOR MOUNTING HEIGHT DIAGRAMS.
- H. ALL SINKS TO HAVE T-8 SOAP DISPENSER UNLESS NOTED OTHERWISE. J. ALL J.C.'S TO HAVE MOP AND BROOM HOLDER, TYP.

SPECIFIC TOILET ACCESSORY REMARKS:


- THIS ITEM ALSO APPEARS ON THE EQUIPMENT SCHEDULE. SEE FLOOR FINISH PLANS FOR OTHER LOCATIONS/NOTATIONS.
- 2. COORDINATE EXACT MOUNTING LOCATION W/ OWNER PRIOR TO INSTALLATION. LOCATIONS MUST COMPLY WITH ADA REQUIREMENTS
- 3. VERIFY MANUFACTURERS HEIGHT INSTALLATION REQUIREMENTS.

4. SEE SPECS. FOR MORE INFO.

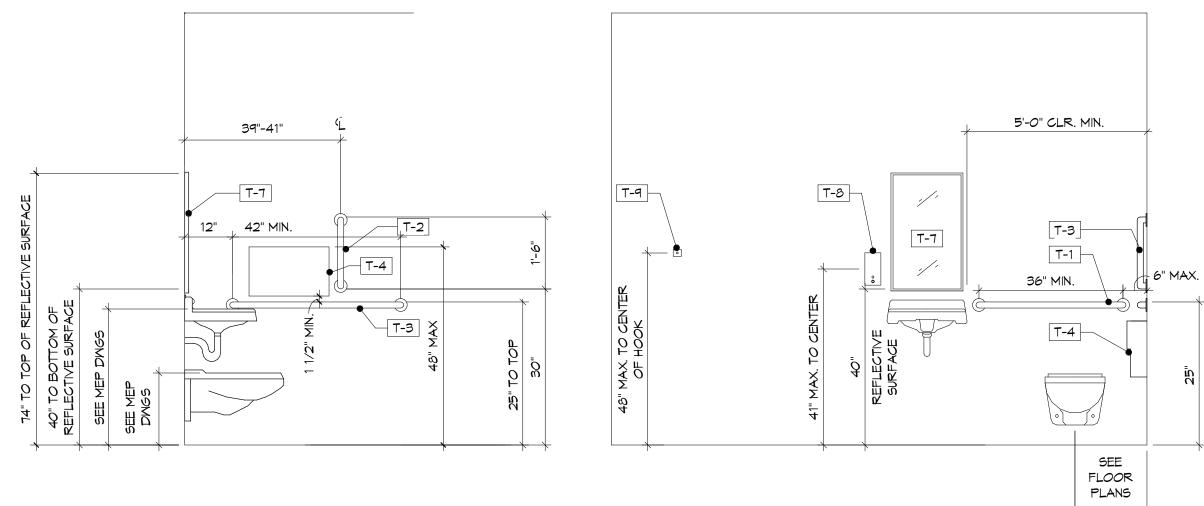

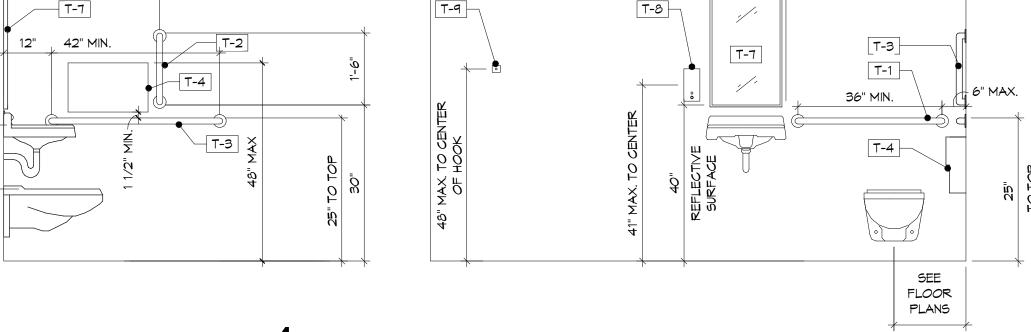




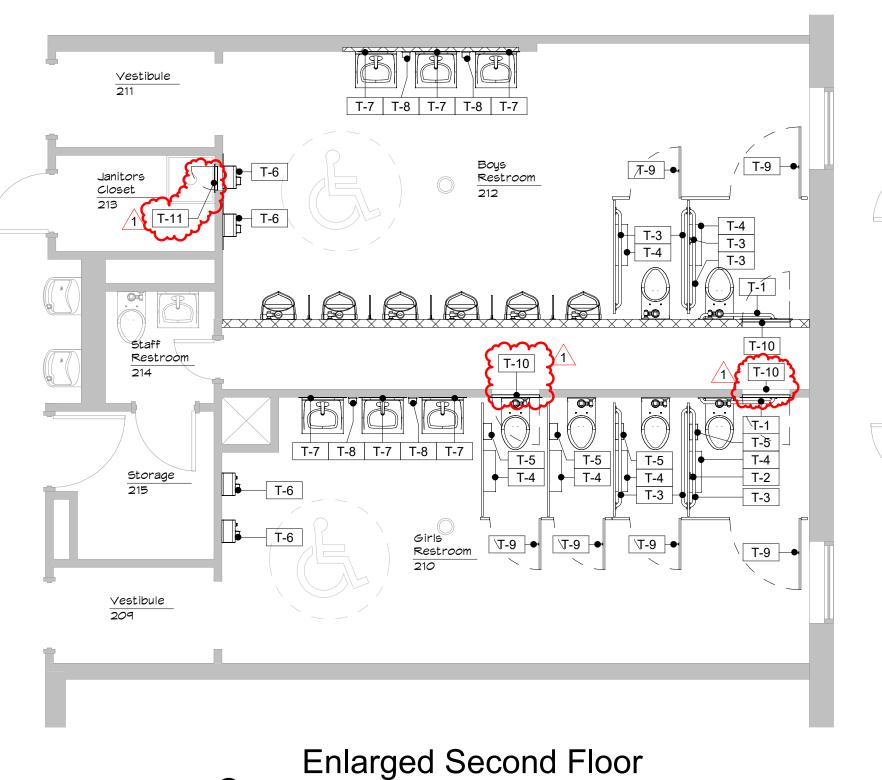

Finish Plan

SCALE: 3/32" = 1'-0"

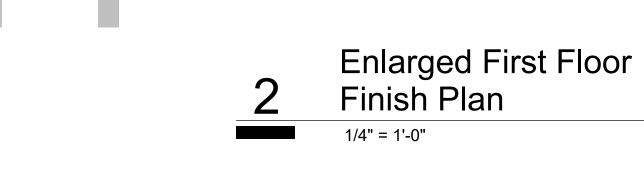

√estibule 111

Janitors Closet 115

Vestibule 109

SCALE: 1/4" = 1'-0

SCALE: 1/8" = 1'-0'

T-7 | T-8 | T-7 | T-8 | T-7

SCALE: 1/2" = 1'-0"


Girls


Restroom


110

____**T-9**


SCALE: 3/4" = 1'-0"

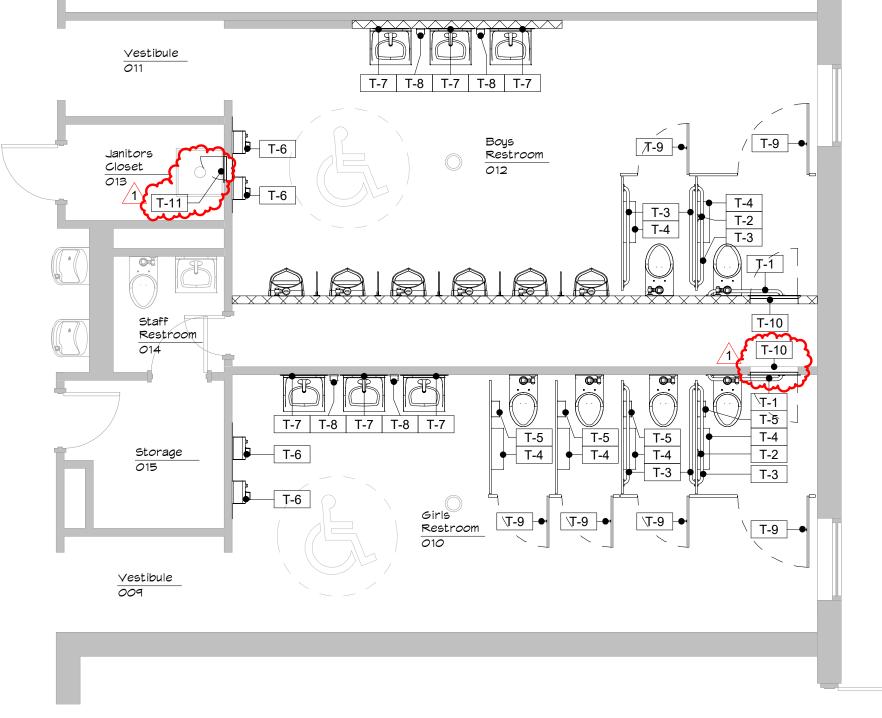

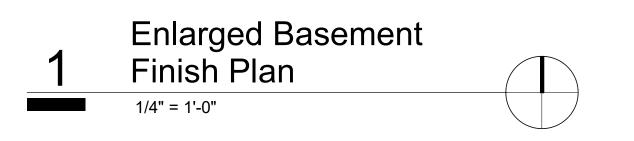

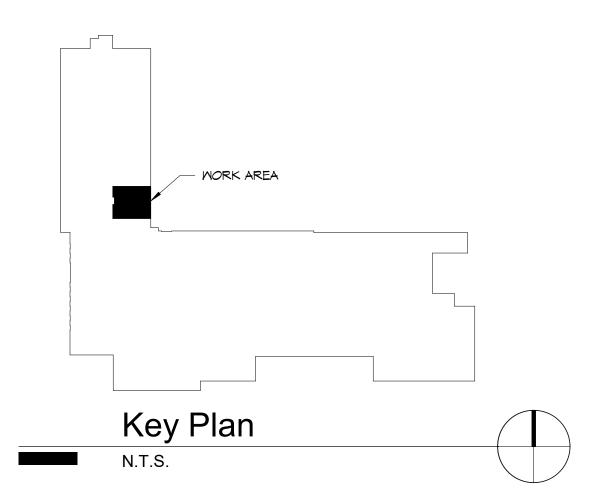

7223 Engle Rd. Suite 200. Fort Wayne. IN 46804 260-424-6516 www.moakepark.com The concepts, ideas, plans, and details as shown on this document are the sole property of Moake Park Group, Inc and were created, developed, and presented for the use on this specific project. None of the concepts, ideas, designs, plans and details shall be used by any person, firm, or corporation for any purpose whatsoever without expressed written consent of Moake Park Group, Inc.. The Owner shall be permitted to retain copies for information and reference in connection with this project.

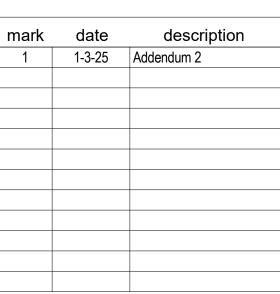



SCHOOL / School 2025 COMMUNITY Fairfield Restro **FORT WAYNE**

CERTIFICATION: No. AR10900079

STATEOF

SCHOOL: Fairfield Elementary School 2825 Fairfield Ave Fort Wayne Indiana 46807

Room Finish Schedule, Legends, Finish & **Equipment Plans**

SHEET:

A7.0


GENERAL PLUMBING NOTES ALL WORK SHALL COMPLY WITH ALL LOCAL/STATE CODES AND ORDINANCES. PIPING LAYOUTS ARE SCHEMATIC IN NATURE. ADDITIONAL ELBOWS, OFFSETS, AND FITTINGS SHALL BE ADDED AS REQUIRED TO COORDINATE WITH OBSTRUCTIONS AND OTHER TRADES. COORDINATE ALL WORK WITH OTHERS TRADES AND EXISTING WORK TO PERMIT ACCESS AND SERVICE CLEARANCES TO ALL SYSTEMS. COORDINATE DUCT WITH ELECTRICAL J-BOXES TO PREVENT OBSTRUCTIONS. I. DO NOT SCALE DRAWINGS FOR DIMENSIONS. REFER TO DIMENSIONED DRAWINGS. ALL DOMESTIC PIPING BELOW SLAB SHALL BE TYPE K SOFT COPPER WITH NO FITTINGS WITHIN OR BELOW SLAB. REFER TO DETAIL SHEETS FOR ADDITIONAL INFORMATION ON INSTALLATION METHODS. DEVIATIONS FROM BASIS OF DESIGN THAT AFFECT OTHER TRADES ARE THE RESPONSIBILITY OF THIS CONTRACTOR. ADDITIONAL COSTS TO PROVIDE LARGER ELECTRICAL CIRCUITS, MORE FLOOR SPACE, ADDITIONAL SUPPORTS, ADDITIONAL MATERIALS, ETC. SHALL BE BORNE BY THIS CONTRACTOR. COORDINATE WITH OTHER TRADES. . ALL VALVE HANDLES SHALL BE INSTALLED TO ALLOW A FULL RANGE OF MOTION. INSTALL ALL ACCESSIBLE FIXTURES ACCORDING TO ADA STANDARDS AND LOCAL REQUIREMENTS.


10. ALL PVC DRAIN/VENT PIPE LOCATED IN A PLENUM OR ABOVE CEILING SHALL BE COVERED WITH 1/2" ELASTOMERIC FOAM

WC-1 AMERICAN STANDARD

WC-1H AMERICAN STANDARD

INSULATION.

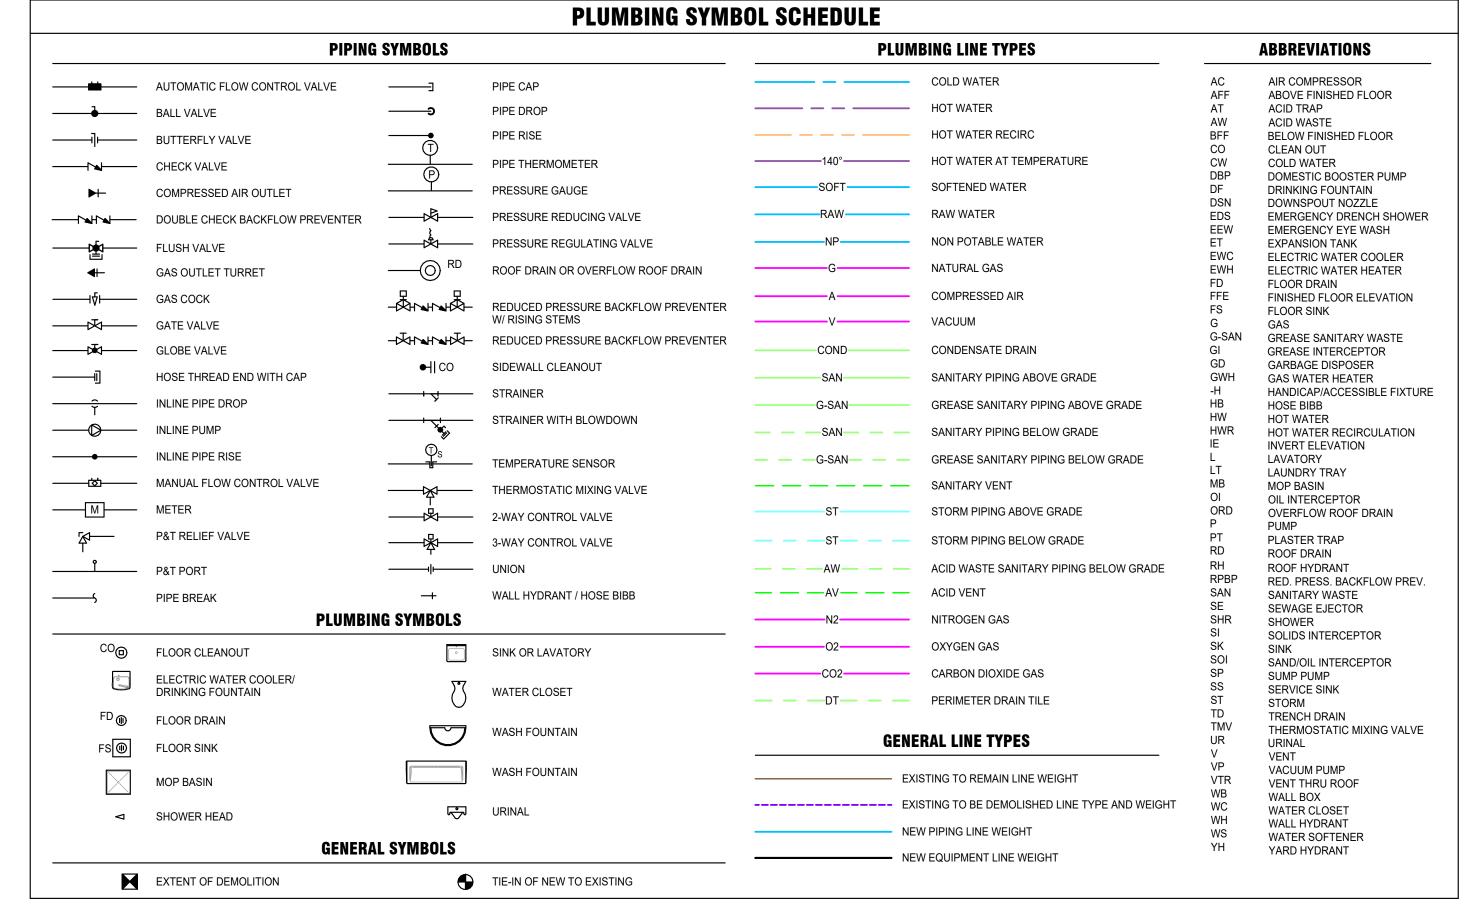

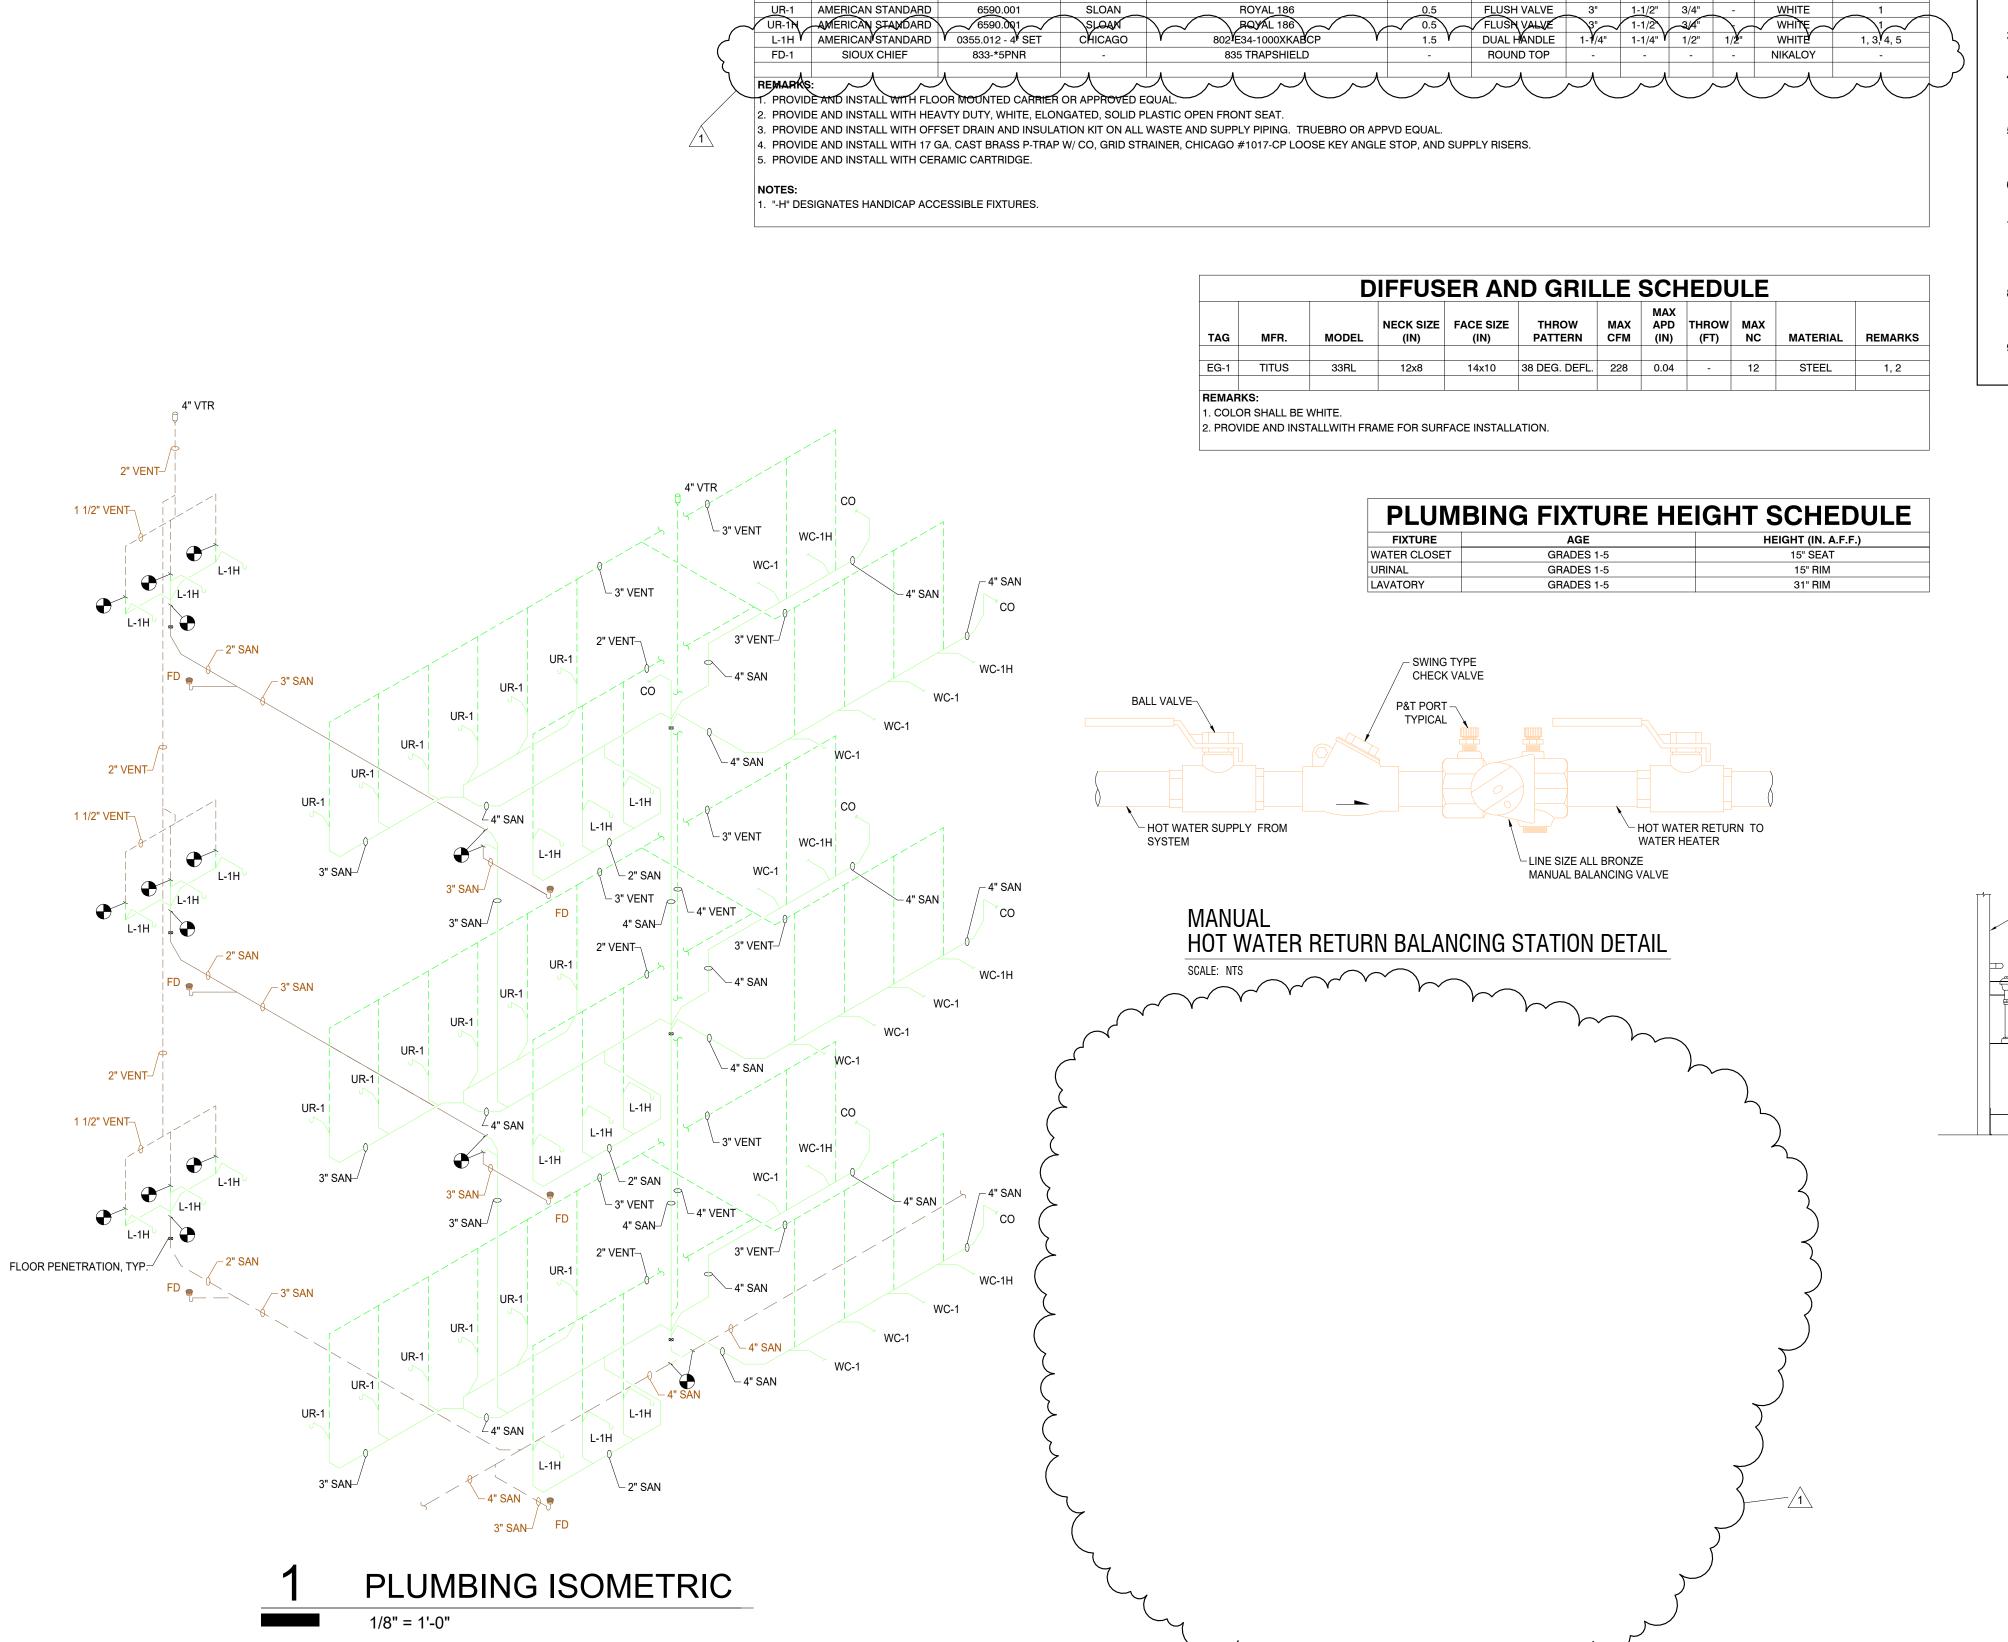

PLUMBING FIXTURE SCHEDULE

ROYAL 111

(GPF OR GPM)

FLUSH VALVE

FLUSH VALVE

WASTE VENT CW HW

COLOR

WHITE

REMARKS

TRIM MFR.

SLOAN

FWCS OWNER SPECIFIC GENERAL NOTES

- ALL HVAC EQUIPMENT SHALL HAVE CUSTOM METAL FILTER FRAMES SUPPLIED WITH EQUIPMENT. FRAMES SHALL BE FABRICATEDBY HOMETOWN FILTER OF FORT WAYNE. CONTRACTOR SHALL BE RESPONSIBLE TO REMOVE PAPER/CARDBOARD TEMPORARY FILTERS AND INSTALL METAL FILTER FRAME WITH FILTER MEDIA AT THE COMPLETION OF THE WORK.
- ANY ELECTRICAL CIRCUIT THAT IS MODIFIED, ADDED, MOVED AS PART OF THIS PROJECT SHALL HAVE ALL J-BOXES, DEVICES, AND CIRCUIT PANEL DIRECTORIES UPDATED AND LABELED WITH PANEL AND CIRCUIT NUMBERS.
- B. IF ANY WORK IS DONE WITHIN AN EXISTING ELECTRICAL PANEL, THE ELECTRICAL CONTRACTOR SHALL TRACE ALL EXISTING CIRCUITS AND UPDATE THE CIRCUIT DIRECTORY.
- WHEN TIEING INTO ANY EXISTING SANITARY DRAIN OR FLOOR DRAIN FOR DRAINAGE, THE CONTRACTOR SHALL VERIFY THAT THE DRAIN IS CLEAR OF DEBRIS AND FLOWS FREELY BY TESTING WITH FULL GARDEN HOSE FLOW FOR A MINIMUM OF 15 MINUTES. IF
- AN OBSTRUCTION IS FOUND, REPORT TO OWNER AND ENGINEER. ALL ROOF CURBS THAT ARE ABANDONED AS PART OF THIS PROJECT SHALL BE CAPPED WITH 16 GAUGE GALVANIZED STEEL
- WELDED SHEET METAL CAP WITH CROSS BREAKS AND SEALED AIR AND WATER TIGHT, INSULATE BELOW CAP WITH 4' RIGID INSULATION AND MARK TOP OF ROOF CAP"N.I.S." (NOT IN SERVICE), UNLESS NOTED OTHERWISE TO REMOVE AND PATCH ROOF.
- 6. CONTRACTOR SHALL RECLAIM ALL EXISTING REFRIGERANT INTO OWNER'S CONTAINER AND PROVIDE TO OWNER, UNLESS CONTRACTOR AND/OR SUBCONTRACTORS SHALL NOT STAGE AND/OR STORE MATERIALS ON EXISTING ROOF SYSTEMS THAT
- MATERIAL STORAGE OR TRAFFICKING OVER THEN THE CONTRACTOR MUST PROVIDE PROTECTION BOARD (1/2" PLYWOOD OVER 2" XPS) OVER STAGING OR TRAFFICKING AREA. 3. ITEMS NOTED TO BE SALVAGED AND DELIVERED TO OWNER SHALL BE DELIVERED TO FWCS FACILITIES AT 1519 CATALPA ST.

ARE NOT PART OF THIS WORK. AS NOTED ON ROOF PLANS. IF A N.I.C. ROOF AREA IS APPROVED BY OWNER/AE FOR USE IN

- FORT WAYNE, UNLESS NOTED OTHERWISE. COORDINATE WITH OWNER AND PROVIDE TRANSMITTAL TO OWNER TO CONFIRM DELIVERY AND RECEIPT BY OWNER.
- 9. COORDINATE WITH OWNER FOR EXACT MATCH TO EXISTING FINISHES INCLUDING, BUT NOT LIMITED TO PAINT, VINYL AND CARPET FLOOR TILE, AND ACOUSTICAL CEILING TILE.


CUTTING AND PATCHING NOTES

- ALL PENETRATIONS INTO EXISTING SURFACES WHERE EXISTING EQUIPMENT, FIXTURES, DUCTWORK, PIPING, CONDUIT, WIRING, WIRE MOLE, ETC, IS TO BE REMOVED SHALL BE PATCHED BY PROPER TRADES USING MATERIALS THAT ARE IDENTICAL TO EXISTING. REFER TO CUTTING AND PATCHING SPECIFICATION SECTION 017329 FOR MORE INFORMATION. CONTRACTOR SHALL FIELD VERIFY ALL
- PATCHING OF EXISTING PAINTED SURFACES SHALL INCLUDE PAINTING TO MATCH EXISTING PAINT COLOR AND SHEEN. EXISTING PENETRATIONS OF CMU BLOCK AND BRICK WALLS LARGER THAN 2" DIA. SHALL BE
- GROUT. PENETRATIONS 2" DIA. AND SMALLER SHALL BE PATCHED WITH COLOR MATCHING GROUT PROVIDE PHYSICAL SAMPLES OF COLOR MATCHING GROUT FOR APPROVAL BY OWNER AT EACH

PATCHED WITH FULL TOOTHED-IN MATCHING CMU BLOCK OR BRICK UNITS WITH COLOR MATCHING

- EXISTING PENETRATIONS OF GLAZED BLOCK AND BRICK WALLS 2" DIA. AND SMALLER SHALL BE PATCHED WITH STAINLESS STEEL COVER PLATES.
- EXISTING PENETRATIONS OF PLASTER OR GYPSUM SURFACES SHALL BE PATCHED WITH (2) LAYERS 5/8" USG AQUA-TOUGH DRYWALL FRAMED WITH 20 GAUGE STEEL STUDS AT 16" O.C. AND FINISHED
- AND PAINTED TO MATCH EXISTING. EXISTING PENETRATIONS OF CARPET FLOOR TILE AND VINYL FLOOR TILE SHALL BE PATCHED BY
- REMOVING AND REPLACING FULL TILES TO MATCH EXISTING. EXISTING PENETRATIONS OF TERRAZZO SURFACES SHALL BE PATCHED WITH GROUT. TERRAZZO

REPAIR BY OWNER. COORDINATE WITH OWNER.

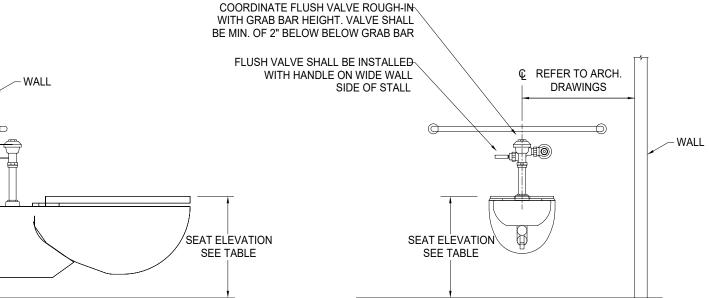

WATER CLOSET DETAIL

SCALE: NTS

ALL WASTE TRAPS, SUPPLY RISERS, AND ANGLE STOPS SHALL BE INSULATED WITH WHITE VINYL INSULATION PER SPECIFICATIONS FOR ADA INSTALLATION RIM ELEVATION SEE TABLE RIM ELEVATION OFFSET TRAP AS REQUIRED FOR ADA SEE TABLE FINISHED FLOOR FINISHED FLOOR

> URINAL DETAIL SCALE: NTS

LAVATORY DETAIL SCALE: NTS

- FINISHED FLOOR



WE

7223 Engle Rd. Suite 200, Fort Wayne, IN

46804 260-424-6516 www.moakepark.com

PRIMARY

All concepts, ideas, plans, and details as shown on

this document are the sole property of Primary

Engineering, Inc., and shall not be used for any

consent. The project owner shall be permitted to

purposes. 2024 © Primary Engineering, Inc.

1/3/25 | ADDENDUM #1

other purpose without their expressed written

retain copies for information and reference

date

info@primary-eng.com

ENGINEERING INC

www.primary-eng.com

description


DATE: 12/9/2024 COMM: 24661

SCHOOL: Fairfield Elementary School 2825 Fairfield Ave Fort Wayne Indiana 46807

Plumbing Information

Sheet



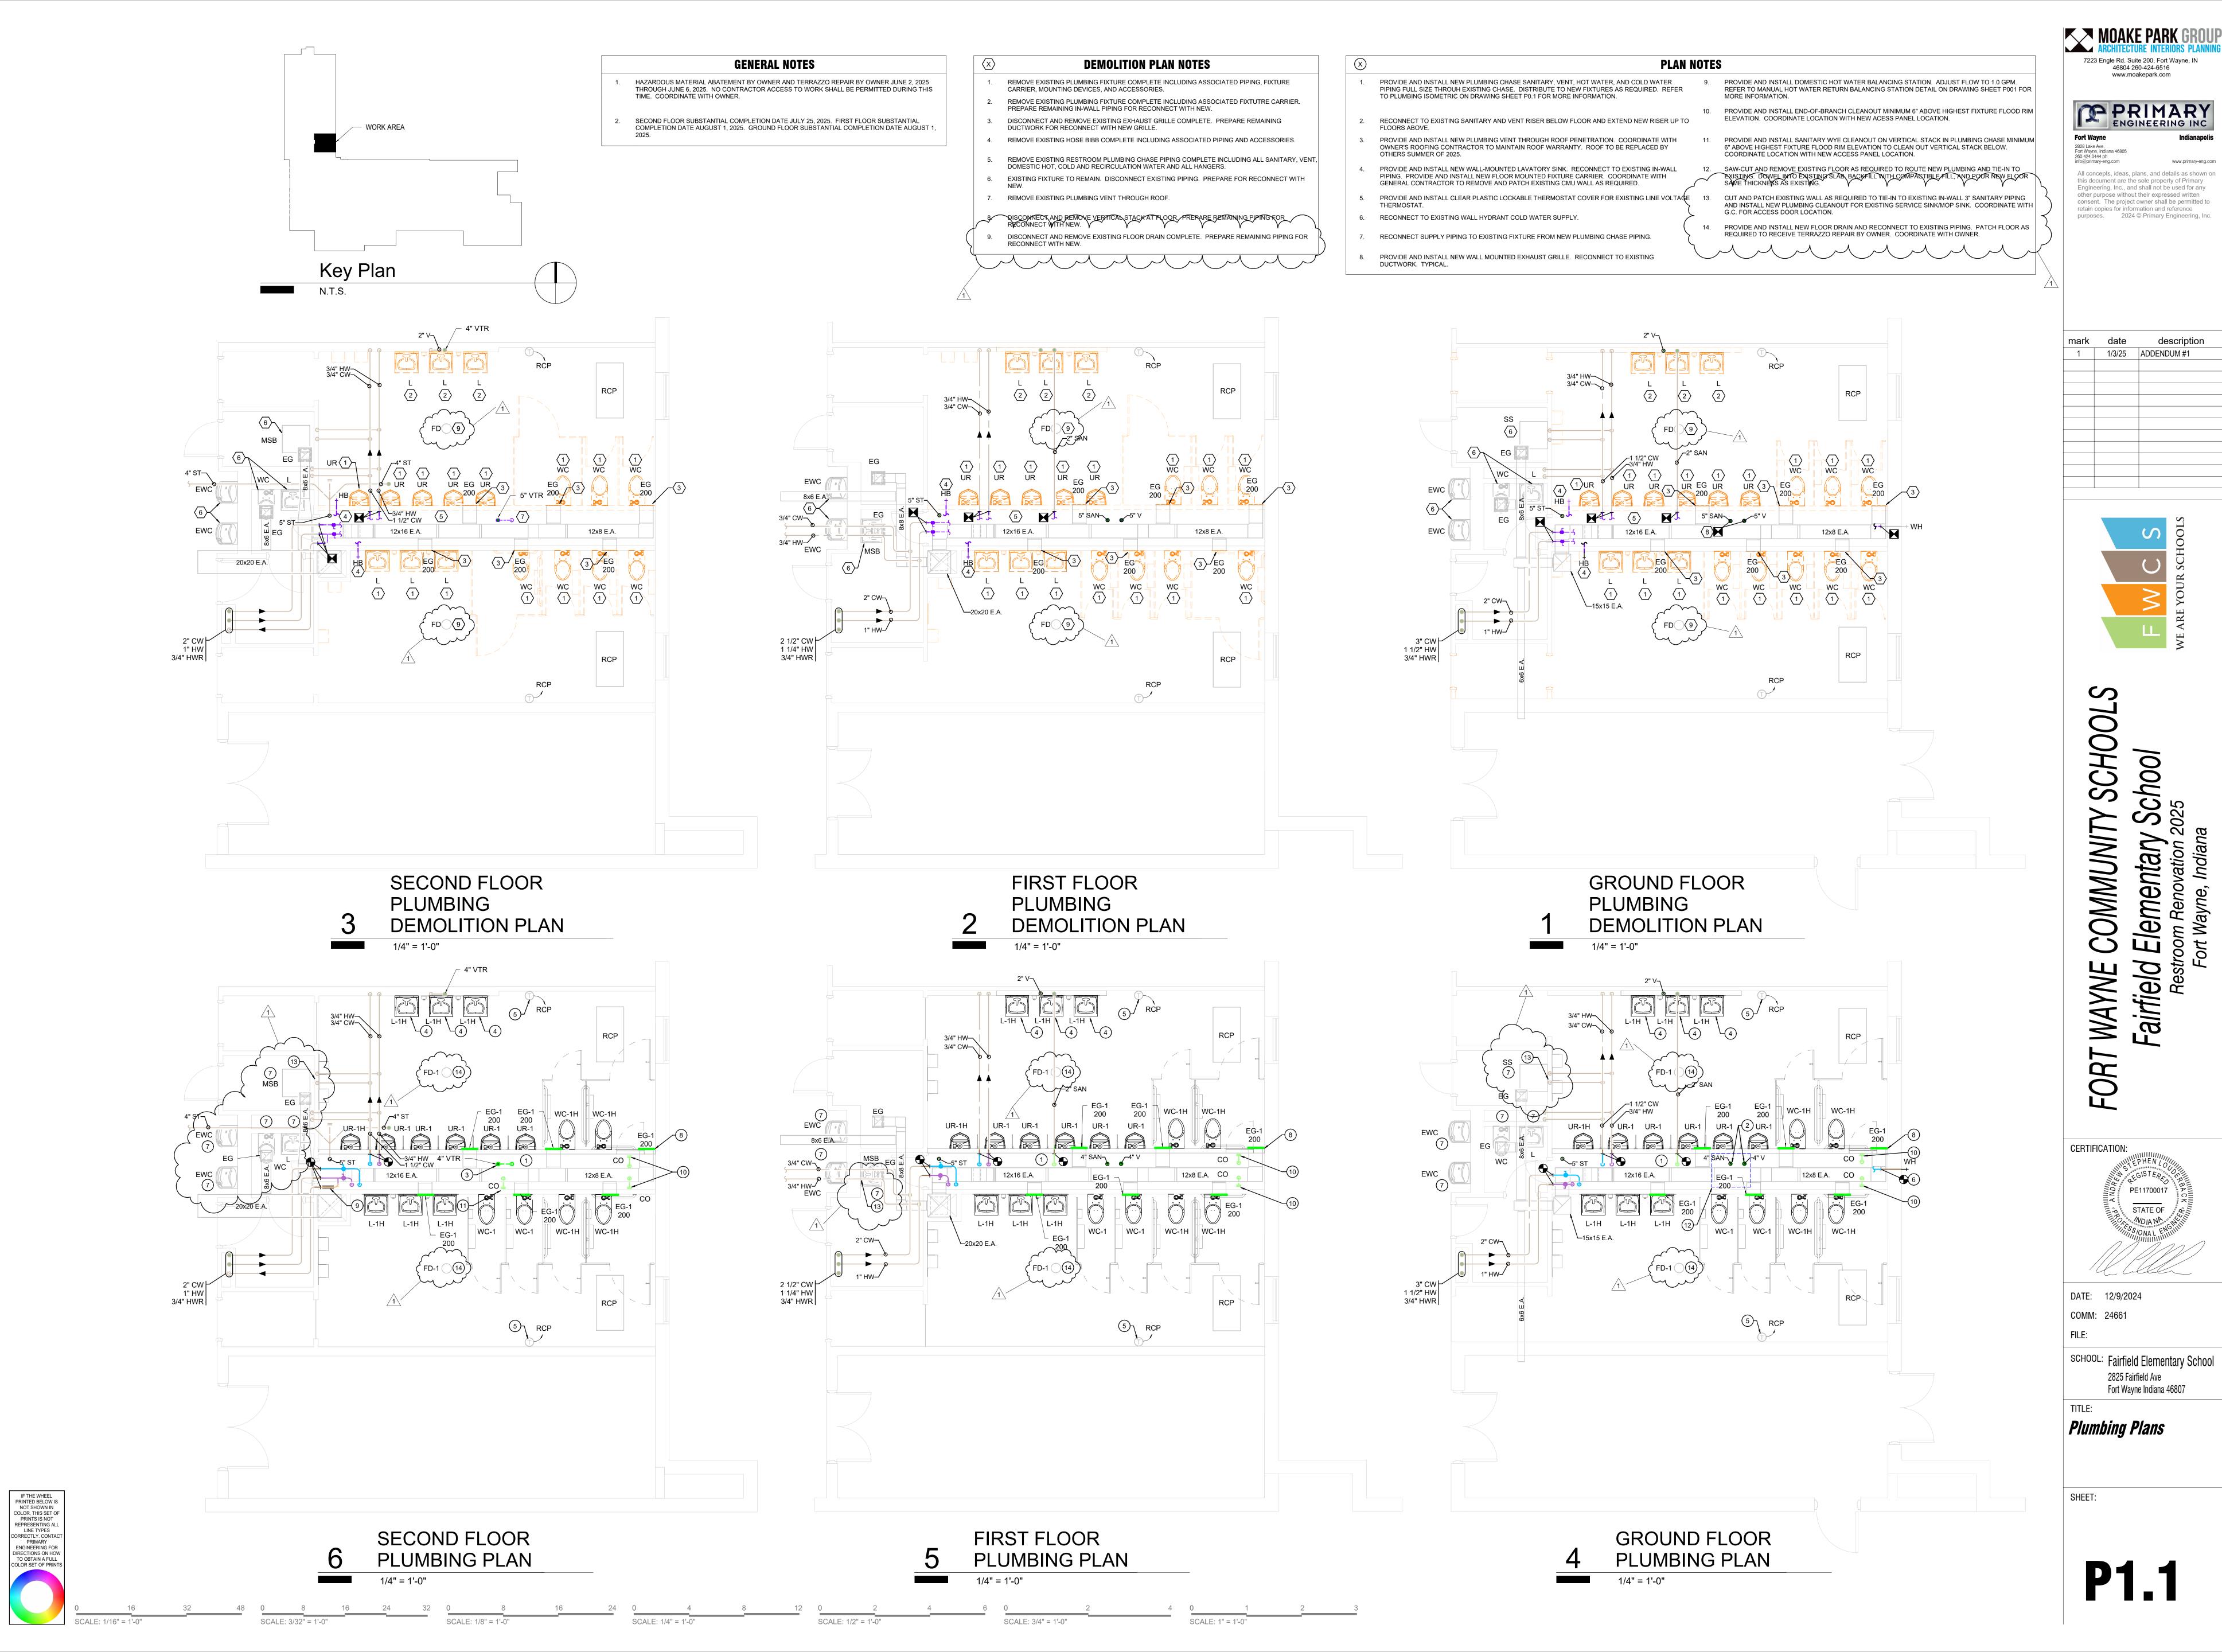



SECTION 011000 - SUMMARY OF WORK

PART 1 - GENERAL

1.1 RELATED DOCUMENTS

A. Drawings and General Provisions of the Contract, including General and Supplementary Conditions and other Division 01 Specification Sections, apply to Work of this Section.

1.2 SUMMARY

- A. Section Includes:
 - 1. Project information.
 - 2. Work covered by Contract Documents.
 - 3. Phased construction.
 - 4. Work by Owner.
 - 5. Work under separate contracts.
 - 6. Future work.
 - 7. Owner-furnished products.
 - 8. Contractor-furnished, Owner-installed products.
 - 9. Access to site.
 - 10. Coordination with occupants.
 - 11. Work restrictions.
 - 12. Specification and drawings conventions.
 - 13. Miscellaneous provisions.
- B. Related Requirements:
 - 1. Section 015000 "Temporary Facilities and Controls" for limitations and procedures governing temporary use of Owner's facilities.

1.3 PROJECT SUMMARY

A. Project Identification: Fairfield Elementary School.



- 1. Project Location: 2825 Fairfield Avenue, Fort Wayne, IN 46807.
- B. Owner: Fort Wayne Community Schools
 - 1. Owner's Representative: Jayde Steffen
- C. Lead Design Consultant: Primary Engineering, Inc.
- D. Consultants: Primary Engineering, Inc. has retained the following design professionals who have prepared designated portions of the contract documents:
 - 1. Moake Park Group, Inc.
- E. The Owner maintains tax exempt status and all work shall be tax free. Owner shall provide tax exempt documentation to Contractor.
- F. All permits and fees associated with the construction are the responsibility of the Contractor to pay.
- G. All work performed by the Contractor shall comply with local and state codes/regulations.
- H. Web-Based Project Software: Project software administered by Owner will be used for purposes of managing communication and documents during the construction phase.
 - 1. See Section 0113100 "Project Management and Coordination" for requirements for using web-based Project software.

1.4 WORK COVERED BY CONTRACT DOCUMENTS

- A. The work of the Project is defined by the Contract Documents and consists of the following:
 - 1. Base Bid: The Project Base Bid consists of restroom renovations at Fairfield Elementary.
- B. Type of Contract:
 - 1. Project will be constructed under a single prime contract.
 - a. Temperature controls work and any required asbestos abatement shall be separate contracts direct to Owner.

1.5 WORK BY OWNER

A. General: Cooperate fully with Owner so work may be carried out smoothly, without interfering with or delaying work under this Contract or by Owner. Coordinate the Work of this Contract with work performed by Owner.

1.6 WORK UNDER SEPARATE CONTRACTS

A. General: Cooperate fully with separate contractors so work on those contracts may be carried out smoothly, without interfering with or delaying Work under this Contract or other



contracts. Coordinate the Work of this Contract with work performed under separate contracts.

- 1. Asbestos abatement shall be provided under separate contract. All contractors must coordinate schedules and it is the responsibility of the General Contractor to incorporate the work schedule of the abatement contractors into the master project schedule with allocated time for removal and air testing.
- 2. Temperature controls work shall be provided under separate contract with Automated Logic Controls. All contractors must coordinate schedules and it is the responsibility of the General Contractor to incorporate the work schedule of the controls contractor into the master project schedule with allocated time for installation of controls following mechanical/electrical equipment with adequate time at the completion of each phase for check-out and verification.

1.7 ACCESS TO SITE

- A. Bidding: Each contractor and sub-contractor shall be responsible to visit the project site to verify existing conditions prior to the bidding date and be aware of the conditions of the existing building. The Owner will make the building available for inspection as follows:
 - 1. Monday through Friday, when school is in session, before 8:50am and after 3:30pm. Check in at the main office.
- B. General: Each Contractor shall have limited use of Project site for construction operations as indicated on Drawings by the Contract limits and as indicate by requirements of this section.
- C. Use of Site: Limit use of Project site to Work in areas indicated. Do not disturb portions of Project site beyond areas in which the Work is indicated.
 - 1. Driveways, Walkways and Entrances: Keep driveways, loading areas and entrances serving premises clear and available to Owner, Owner's employees and emergency vehicles at all times. Do not use these areas for parking or for storage of materials.
 - a. Schedule deliveries to minimize use of driveways and entrance by construction operations.
 - b. Schedule deliveries to minimize space and time requirements for storage of material and equipment on site.
- D. Condition of Existing Building: Maintain portions of existing building affected by construction operations in a weathertight condition throughout construction period. Repair damage caused by construction operations.
 - 1. Protect staff and students from dangerous conditions that might result from construction activities.



- E. Condition of Existing Grounds: Maintain portions of existing grounds, landscaping and hardscaping affected by construction operations throughout construction period. Repair damage caused by construction operations.
- F. Each Contractor shall limit the use of the premises for work and storage to allow work by other Contractors and Owner occupancy. Storage of materials for construction activities in existing buildings is permissible only upon approval by the assigned Owner Project Coordinator.
 - 1. Each Contractor shall assume complete responsibility for the protection and safekeeping of products under his contract, stored at the site.
 - 2. Each Contractor shall move his stored products that interfere with the operation of the Owner or other Contractors.

1.8 COORDINATION WITH OCCUPANTS

- A. Full Owner Occupancy: Owner will occupy site and existing building(s) during entire construction period. Cooperate with Owner during construction operations to minimize conflicts and facilitate Owner usage. Perform the work so as not to interfere with Owner's day-to-day operations. Maintain existing exits unless otherwise indicated.
 - 1. Maintain access to existing walkways, corridors and other adjacent occupied or used facilities. Do not close or obstruct walkways, corridors or other occupied or used facilities without written permission from Owner and approval of authorities having jurisdiction.
 - 2. Notify Owner not less than 72 hours in advance of activities that will affect Owner's operations.
 - 3. Note that the primary functions of this school facility must continue and can not be interrupted by the construction activities. Special considerations for noise/dust/odor control must be provided to prevent disruption of the academic environment.
 - 4. Contractors shall maintain an atmosphere of professionalism while on school grounds.
 - a. Use of profane or lewd language by workers will not be tolerated.
 - b. Any worker wearing clothing containing vulgar or inappropriate content will be asked to leave the premises immediately.
 - c. Use of radios/cell phones to play loud music will not be permitted.

1.9 WORK RESTRICTIONS

- A. Work Restrictions, General: Comply with restrictions on construction operations.
 - 1. Comply with limitations on use of public streets and with other requirements of authorities having jurisdiction.



- B. On-Site Work Hours: Limit work in the existing building to normal business working hours of 6:00 a.m. to 10:00 p.m., Monday through Friday, unless otherwise indicated.
 - School Year Hours: NONE of the phased work occurring during the school year will take
 place while school is in session. Typical shift work during the school year will be 3:30 p.m.
 to 11:00 p.m. Shiftwork after 11:00 p.m. will be on an as needed basis and coordinated
 with the Owner.
 - Weekend Hours: With Owner's prior approval, weekend hours may be permitted.
 Notification of need for weekend hours must be submitted no later than the Monday preceding weekend needed for work.
 - 3. Hours for Utility Shutdowns: Power shutdowns must occur when the building is not occupied and must be scheduled with the Owner in advance. Extended shutdowns lasting more than 4 hours must occur on a weekend and utilize overnight periods to be scheduled with the Owner.
- C. Existing Utility Interruptions: Do not interrupt utilities serving facilities occupied by Owner or others unless permitted under the following conditions and then only after providing temporary utility services according to the requirements indicated:
 - 1. Notify Owner not less than seven (7) days in advance of proposed utility interruptions.
 - 2. Obtain Owner's written permission before proceeding with utility interruptions.
- D. Noise, Vibration and Odors: Coordinate operations that may result in high levels of noise and vibration, odors or other disruption to Owner occupancy with Owner.
 - 1. Notify Owner not less than seven (7) days in advance of proposed disruptive operations.
 - 2. Obtain Owner's written permission before proceeding with disruptive operations.
 - 3. Each Contractor and Sub-contractor shall take reasonable measures to limit activities which cause undue noise during 2nd shift work which may affect neighboring residents.
 - a. Refrain from using telescoping forklifts to dump trash after 9:00 pm.
 - b. Take special care in closing storage containers at the end of the work shift (do not slam container doors).
 - c. Schedule material and equipment deliveries during late afternoon hours only.
- E. I-LEARN/Achievement Testing: Testing will occur in the spring and fall of each school year. Contractor shall verify exact dates with Owner. NO work shall be permitted in the building during the school day during testing without prior written approval. The Owner reserves the right to allow specific trades and activities in limited areas depending on the potential for noise and disturbance during these times.
 - 1. Any inspection work occurring during testing periods must be completed either before or after school is in session.



- F. Restricted Substances: Use of tobacco products, e-cigarettes (vaping) and other controlled substances on Project site is not permitted on Fort Wayne Community Schools property.
- G. Employee Identification: Provide identification in the form of clothing or hard hats with company logos for all Contractor and Sub-contractor personnel working on Project site. Require personnel to wear identification at all times.
- H. Owner will allow shutdown and commencement of work in 2nd floor restrooms starting March 31, 2025. 1st shift work will be allowed from March 31, 2025 through April 4, 2025 (Spring Break). If contractor elects to begin work at this time, work shall continue during the remainder of the school year on 2nd shift. 1st shift work shall not be permitted during Spring Break if 2nd shift work does not continue during the remainder of the school year.

1.10 SPECIFICATION AND DRAWING CONVENTIONS

- A. Specification Content: The Specifications use certain conventions for the style of language and the intended meaning of certain terms, words and phrases when used in particular situations. These conventions are as follows:
 - 1. Imperative mood and streamlined language are generally used in the Specifications. The words "shall", "shall be" or "shall comply with", depending on the context, are implied where a colon (;) is used within a sentence or phrase.
 - 2. Specification requirements are to be performed by Contractor unless specifically stated otherwise.
- B. Division 01 General Requirements: Requirements of Sections in Division 01 apply to the Work of all Sections in the Specifications.
- C. Drawing Coordination: Requirements for materials and products identified on Drawings are described in detail in the Specifications. One or more of the following are used on Drawings to identify materials and products:
 - 1. Terminology: materials and products are identified by the typical generic terms used in the individual Specifications Sections.
 - 2. Abbreviations: Materials and products are identified by the typical generaic terms as part of the U.S. National CAD Standard and scheduled on Drawings.
 - 3. Keynoting: Materials and products are identified by reference keynotes referencing Specification Section numbers found in this Project Manual.

1.11 MISCELLANEOUS PROVISIONS

- A. Asbestos Containing Materials (ACM)
 - 1. Any ACM shall be removed by the Owner prior to the start of work schedule by the Contractor.



- 2. If any other suspect ACM is discovered during the course of work, Contractor shall promptly notify the Owner. Owner shall perform testing and, if determined to be regulated asbestos containing building materials, Category I or Category II non-friable asbestos containing materials, the Owner will be responsible to remove materials in compliance with regulatory standards.
- 3. Contact FWCS designated Project Manager at (260) 467-2075.

B. Existing Conditions

- 1. Each Contractor is responsible to field verify existing conditions and dimensions. The Contractor requiring said verification for the construction or fabrication of his material shall be the Contractor responsible for procurement of the field information.
- 2. Notify the design architect/engineer promptly if existing field conditions differ from those indicated on the bid documents. Do not remove or alter structural components without prior written approval.
- C. Each Contractor shall be responsible for securing his work and equipment at the close of each work day.
- D. Fire alarms: If the work requires repair, modifications or replacement of fire alarm systems or components, the Contractors shall provide notification to the Owner a minimum of 72 hours before a fire alarm is rendered inactive.
 - 1. If a fire alarm device is fouled with construction debris/duct/dirt and activates the alarm system, the Contractor shall be solely responsible for all costs associated with false fire truck dispatch and shall replace the soiled device with a new device matching the device that initiated the alarm. Cleaning a triggering device is not acceptable.

PART 2 - PRODUCTS (Not Applicable)

PART 3 - EXECUTION (Not Applicable)

END OF SECTION