

**Project** 25017 – HCCSC Parking & Tennis Improvements Multiple Schools, Huntington County Indiana

#### **ADDENDUM No. 1**

March, 6, 2025

This addendum and MEP addendum hereby becomes part of the Contract Documents. Each bidder shall acknowledge receipt of this addendum by number on the Bid Form.

It is each Prime Contactor's responsibility to notify all subcontractors of this addendum and provide copies for all sets of plans in their possession.

#### Item Description

#### 1. General Clarifications:

- a. Prebid Sign in: See attached sign in sheet from the Prebid Meeting held on site on the morning of 02.27.2025.
- b. The projects names includes Tennis improvements although the scope of work in the final bid documents no longer incudes tennis improvements as the owner has deferred that work to a future project.
- c. The requirements for Limited Criminal Background checks for employees working on site referenced in section 007300 section 2.13.A.4 shall be removed from the project complete.
- d. This project is not a prevailing wage or Davis Bacon Wages scale job, however all bidders shall comply with the Indiana's Common Construction Wage Act as outlines in specification section 007375.
- e. Bidders shall remove any requirements for density testing on new asphalt surface as listed in project specifications.
- f. Prior to conducting on site investigation at any school. Contractors are required to notify specific school front desk when on site, when the school is occupied. Recommend wearing company identification while on site and/or truck identification.
- g. "Rap" shall be acceptable in all asphalt surfacing supplied on the project. Virgin mix as referenced in the project specification is not requiered.
- h. Asphalt binder liquid specification shall be revised 58S-28 liquid.

#### 2. Specification 004110 - Bid Form

a. Addition: See attached Specification attached in its entirety with alternate #4 added, clarifications to Unit cost #1 and the addition of unit cost #2.

#### 3. Specification 004393 - Bid Checklist

a. Clarification: See attached revised specification attached in its entirety with clarification to the bidders checklist items.

#### 4. Specification 012100\_Allowance



**a.** Addition: See attached revised Specification attached in its entirety with a revised dollar value to construction contingency allowance.

#### 5. Specification 012300\_Alternates

a. Addition: See attached revised Specification attached in its entirety, with the addition of alternate #4.

#### 6. Drawing Sheet: C-101

**a.** Clarification: See attached revised sheet for the addition of Alternate #4.

#### 7. Drawing Sheet: C-401

a. Clarification: See attached revised sheet for .revision to plan note #24.

#### 8. Drawing Sheet: C-402

a. Clarification: See attached revised sheet for .revision to plan note #24.

#### 9. Drawing Sheet: C-403

a. Clarification: See attached revised sheet for .revised plan note 26 & 27 location.

#### 10. Drawing Sheet: C-500

a. Clarification: See attached revised sheet for .revision to detail # 20 & 25.

End of Addendum

Sincerely,

MKM architecture + design

Jordan Owens, Senior Associate.

Document11

# Huntington County Community School Corporation Parking & Tennis Improvements PRE-BID MEETING SIGN-IN

February 27, 2025 at 11:00 PM

NAME		REPRESEN <sup>*</sup>	TING		- 11
				Email	trathane in kinderon. (Om
1 1	all.			phone	260-422-6783
Dode	attman	MKM are	elitecture.	tderan	
			4-1	Email	DAILC WAYDERSPART-LOW
Ī. a		1 2		phone	260-747-7531
DAIE W	ESTROPP	WAINE HS	PHALT		
		1			elgrafte brooks 1st. con
D 1	- :	Brooks	A 1 1	phone	200-478-1990
Eric 6	roft	Drooks	Construct		
					sknill ogandapt
Samk	min hot	(5 a	unt & Sex	Ann	266-56)-182/
				Email	That telohersc 142 M. US
01	111	1/22		phone	260 366-3052
Rich 1	Hertel	11-605			
7				Email	
				phone	Q
				Email	
				phone	
				Email phone	( <del></del>
				prione	·
-				Email	
				phone	
				phone	3
				Email	
				phone	
				•	
-				Email	-
				phone	
				Email	
				phone	
-					
				phone	
) <del>-</del>					
				Email	
				pnone	
					3

### SECTION 004110 - THE BID FORM

THE PROJECT	` AND T	ΉE	PA	RT	IES
-------------	---------	----	----	----	-----

1	.1	l TO	•
		10	

A. Owner
Huntington County Community School Corporation
1415 Flaxmill Road
Huntington , Indiana 46750

1.2 FOR:

D.

E.

the Bid Sum.

**HCCSC Parking & Tennis Improvements** 

1.3	DATE:	(Bidder to enter date)
1.4	SUBMI	TTED BY: (Bidder to enter name and address)
	A.	Bidder's Full Name
		Address
		City, State, Zip
1.5	OFFER	(BASE BID)
	A.	Base Bid work shall include all Asphalt and concrete work at Crestview Middle School, Riverview Middle School, Salamonie Elementary School that is not defined as an add alternate below.
	В.	Having examined the Place of The Work and all matters referred to in the Instructions to Bidders and the Contract Documents prepared by MKM Architecture + Design for the above-mentioned project, we, the undersigned, hereby offer to enter into a Contract to perform the Work for the Sum of:  1. Base Bid (3 Schools Asphalt Work) \$  Base Bid (3 Schools Concrete Work) \$
		Base Bid ( 3 Schools Stone Sub Base replacement 225 cu yd's) \$
		Base Bid ( Contingency Allowance) \$ 60,000
		Base Bid Total \$
	C.	Project is Tax Exempt.

THE BID FORM 004110 - 1

All Cash and Contingency Allowances described in Section 012100 are to be included in

All Bonds described in Section 002213 are to be included in the Bid.

#### 1.6 ALTERNATES

A. Having examined the Work and all matters referred to in the Instructions to Bidders and the Contract Documents prepared by MKM Architecture + Design for the abovementioned project, we, the undersigned, hereby offer to include pricing to perform the Work for the Add Alternates listed below (in order):

#### Alternate No. 1A: Lincon Elementary Asphalt & Concrete

Base Bid: Contract shall not include any cost for work at Lincon Elementary in the Base Bid.

Additive Alternate: Contractor to provide Additive alternate cost to provide all work associated with the existing Asphalt and Concrete area shown on contract drawings at Lincon Elementary.

Alternate 1A: ( Lincon Elementary Asphalt)	Add	\$
Alternate 1A: (Lincon Elementary Concrete)	Add	\$

#### Alternate No. 1B: Lincon Elementary Playground Resurfacing

Base Bid: Contract shall not include any cost for work at Lincon Elementary in the Base Bid. Additive Alternate: Contractor to provide Additive alternate cost to provide all work associated with the resurfacing of (2) existing playground areas as indicated on the contract drawings at Lincon Elementary.

Alternate 1B:	(Lincon Elementar	y Playground Resurfacing)	Add	\$
---------------	-------------------	---------------------------	-----	----

#### Alternate No. 1C: Lincon Priority "B" Pavement Patching

Base Bid: Contract shall not include any cost for work related to asphalt patching in areas identified as Priority B asphalt patching areas on the contract Drawings at Lincon Elementary.

Additive Alternate: Contractor to provide Additive alternate cost to for all asphalt patching in areas identified as Priority B asphalt patching areas on the contract Drawings at Lincon Elementary

Alternate 1C: Lincon Priorit	y "B" Pavement Patching	Add	

#### **Alternate No. 1D: Lincon Expanded Staff Parking Lot**

Base Bid: Contract shall not include any cost for work related to the areas on the contract Drawings at Lincon Elementary.

Additive Alternate: Contractor to provide Additive alternate cost for the Expanded Staff Parking Lot as noted on the contract Drawings at Lincon Elementary

Alternate 1D: Lincon Expanded Staff Parking Lot	Add	<b>\$</b>
---	-----	-----------

#### Alternate No. 2: Riverview Middle School Widen Bus Lane

Base Bid: Contract shall not include any cost for work realted to any work associated with the widening of the bus lane as shown on Contract Drawings at Riverview Middle School.

Additive Alternate: Contractor to provide Additive alternate cost to provide all work associated with the widening of the bus lane as shown on Contract Drawings at Riverview Middle School.

Alternate 2: Riverview Middle School Widen Bus Lane Add \$\_\_\_\_\_

#### Alternate No. 3: Priority "B" Pavement Patching

Base Bid: Contract shall not include any cost for work realted to asphalt patching in areas identified as Priority B asphalt patching areas on the contract Drawings at Crestview Middle School, Riverview Middle School & Salamonie Elementary School.

Additive Alternate: Contractor to provide Additive alternate cost to for all asphalt patching in areas identified as Priority B asphalt patching areas on the contract Drawings at Crestview Middle School, Riverview Middle School & Salamonie Elementary School.

Alternate 3: Crestview Priority "B" Pavement Patching
Riverview Priority "B" Pavement Patching
Salamonie Priority "B" Pavement Patching
Add \$\_\_\_\_\_\_\_
Add \$\_\_\_\_\_\_

#### Alternate No. 4: Crestview Drop Off Lane Modifications.

Base Bid: Contract shall not include any cost for work related to modification of existing curb islands and striping modifications in the drop off lane at Crestview Middle School.

Additive Alternate: Contractor to provide Additive alternate cost for all work associated with curb island modifications and additional striping in the drop off lane area at Crestview middle school as shown in Alternate #4 plan issued as part of Addedum#1.

Alternate 4: Crestview Drop Off Lane Modifications Add \$\_\_\_\_\_

#### 1.7 UNIT COSTS

- A. The undersigned Bidder proposes the amounts below be added to or deducted from the Contract Sum on performance and measurement of the individual items of Work[ and for adjustment of the quantity given in the Unit-Price Allowance for the actual measurement of individual items of the Work].
  - 1. Unit-Price No. 1: Asphalt replacement: Contractor to provide a unit cost value to cost remove/ mill and replace a 200 sf section of asphalt pavement down to existing base and replace with new medium duty asphalt section as detailed on plans. During construction contractor will be asked to consult with owner and architect if areas of existing pavement are found that are seen to be failing in a way that dictate removal/ milling and replacement that are not called to be replaced on the bid documents. Extent of additional asphalt patching shall be

	dollars (\$	) per unit.
Unit-Price No. 2: Stone Subg to remove 225 cubic yards or aggregate sub base in the Pr plans. Contractor to provide replacement of subgrade with have damaged or failing sub sub grade removal and repla confirmed on site by owner/ require use of this unit cost.	f existing subgrade and pro iority A pavement patching a unit cost per cubic yard oth new compacted # 53 agg base under existing pavem cement shall be identified l	vide new compactor areas identified or f additional remover regate in areas fou ent. Extent of addition
	dollars (\$	) per unit.

identified by contractor and confirmed on site by owner/ architect prior to

#### 1.8 ACCEPTANCE

- A. This offer shall be open to acceptance and is irrevocable for ninety days from the bid closing date.
- B. If this bid is accepted by Owner within the time period stated above, we will:
  - 1. Execute the Agreement within seven days of receipt of Notice of Award.
  - 2. Furnish the required bonds within seven days of receipt of Notice of Award.
  - 3. Commence work within seven days after written Notice to Proceed of this bid.

#### 1.9 CONTRACT TIME

- A. Upon approval of contract work is assumed to begin as soon as: Monday, May 24, 2025
- B. If this Bid is accepted, work shall be completed no later than the following:
- C. Substantial Completion by: Friday, August 1, 2025
- D. Should the Contractor wish to expedite the Contract they may do so by submitting a proposed schedule for review, consideration and comment with their sealed bid.

#### 1.10 CHANGES TO THE WORK

- A. When Architect establishes that the method of valuation for Changes in the Work will be net cost plus a percentage fee in accordance with General Conditions, our percentage fee will be:
  - 1. 5% percent overhead and profit on the net cost of our own Work;
  - 2. <u>5%</u> percent on the cost of work done by any Subcontractor.
- B. On work deleted from the Contract, our credit to Owner shall be Architect-approved

net cost plus 5% of the overhead and profit percentage noted above.

ADDEN	IDA					
A.		llowing Addenda nents noted belov				in the Bid
	1. 2. 3.			Dated Dated Dated	 	
BID FO	RM SIG	NATURE(S)				
The Co	rporate	Seal of				
(Biddei	r - print	the full name of y	our firn	n)		
was he	reunto	affixed in the pres	sence o	f:		
(Autho	rized si	gning officer, Title	)			
(Seal)						
(Autho	rized siį	gning officer, Title	)			

END OF SECTION 004110

If the Bid is a joint venture or partnership, add additional forms of execution for each member of the

joint venture in the appropriate form or forms as above.

#### **SECTION 012100 - ALLOWANCES**

#### PART 1 - GENERAL

#### 1.1 RELATED DOCUMENTS

A. Drawings and general provisions of the Contract, including General and Supplementary Conditions and other Division 01 Specification Sections, apply to this Section.

#### 1.2 SUMMARY

- A. Section includes administrative and procedural requirements governing allowances.
  - 1. Certain items are specified in the Contract Documents by allowances. Allowances have been established in lieu of additional requirements and to defer selection of actual materials and equipment to a later date when direction will be provided to Contractor. If necessary, additional requirements will be issued by Change Order.
- B. Types of allowances include the following:
  - 1. Contingency allowances..

#### 1.3 SELECTION AND PURCHASE

- A. At the earliest practical date after award of the Contract, advise Architect of the date when final selection and purchase of each product or system described by an allowance must be completed to avoid delaying the Work.
- B. At Architect's request, obtain proposals for each allowance for use in making final selections. Include recommendations that are relevant to performing the Work.
- C. Purchase products and systems selected by Architect from the designated supplier.

#### 1.4 ACTION SUBMITTALS

A. Submit proposals for purchase of products or systems included in allowances, in the form specified for Change Orders.

#### 1.5 INFORMATIONAL SUBMITTALS

- A. Submit invoices or delivery slips to show actual quantities of materials delivered to the site for use in fulfillment of each allowance.
- B. Submit time sheets and other documentation to show labor time and cost for installation of allowance items that include installation as part of the allowance.

ALLOWANCES 012100 - 1

C. Coordinate and process submittals for allowance items in same manner as for other portions of the Work.

#### 1.6 COORDINATION

A. Coordinate allowance items with other portions of the Work. Furnish templates as required to coordinate installation.

#### 1.7 CONTINGENCY ALLOWANCES

- A. Use the contingency allowance only as directed by Owner and Architect for Owner's purposes and only
- B. Contractor Allowances are defined in the AIA general Conditions section 9.8 Allowances of the
  - 1. AIA Document A295-2008 as amended, General Conditions of the contract for Integrated project Delivery.
- C. At Project closeout, credit unused amounts remaining in the contingency allowance to Owner by Change Order.

#### 1.8 ADJUSTMENT OF ALLOWANCES

- A. Allowance Adjustment: To adjust allowance amounts, prepare a Change Order proposal based on the difference between purchase amount and the allowance, multiplied by final measurement of work-in-place where applicable. If applicable, include reasonable allowances for cutting losses, tolerances, mixing wastes, normal product imperfections, and similar margins.
  - 1. Include installation costs in purchase amount only where indicated as part of the allowance.
  - 2. If requested, prepare explanation and documentation to substantiate distribution of overhead costs and other margins claimed.
  - 3. Submit substantiation of a change in scope of work, if any, claimed in Change Orders related to unit-cost allowances.
  - 4. Owner reserves the right to establish the quantity of work-in-place by independent quantity survey, measure, or count.
- B. Submit claims for increased costs because of a change in scope or nature of the allowance described in the Contract Documents, whether for the purchase order amount or Contractor's handling, labor, installation, overhead, and profit.
  - 1. Do not include Contractor's or subcontractor's indirect expense in the Change Order cost amount unless it is clearly shown that the nature or extent of work has changed from what could have been foreseen from information in the Contract Documents.
  - 2. No change to Contractor's indirect expense is permitted for selection of higher- or lower-priced materials or systems of the same scope and nature as originally indicated.

ALLOWANCES 012100 - 2

PART 2 - PRODUCTS (Not Used)

PART 3 - EXECUTION

#### 3.1 EXAMINATION

A. Examine products covered by an allowance promptly on delivery for damage or defects. Return damaged or defective products to manufacturer for replacement.

#### 3.2 PREPARATION

A. Coordinate materials and their installation for each allowance with related materials and installations to ensure that each allowance item is completely integrated and interfaced with related work.

#### 3.3 SCHEDULE OF ALLOWANCES

Allowance No. 1: Construction Contingency Allowance: Include a contingency allowance of **Sixty-Thousand (\$60,000)** of the total construction value to be included in the contract as contractor contingency to be used as approved by owner/ architect and as described in "the agreement"

END OF SECTION 012100

ALLOWANCES 012100 - 3

#### **SECTION 012300 - ALTERNATES**

PART 1 - GENERAL

#### 1.1 SUMMARY

A. Section includes administrative and procedural requirements for alternates.

#### 1.2 DEFINITIONS

- A. Alternate: An amount proposed by bidders and stated on the Bid Form for certain work defined in the bidding requirements that may be added to or deducted from the base bid amount if the Owner decides to accept a corresponding change either in the amount of construction to be completed or in the products, materials, equipment, systems, or installation methods described in the Contract Documents.
  - 1. Alternates described in this Section are part of the Work only if enumerated in the Agreement.
  - 2. The cost or credit for each alternate is the net addition to or deduction from the Contract Sum to incorporate alternates into the Work. No other adjustments are made to the Contract Sum.

#### 1.3 PROCEDURES

- A. Coordination: Revise or adjust affected adjacent work as necessary to completely integrate work of the alternate into Project.
  - 1. Include as part of each alternate, miscellaneous devices, accessory objects, and similar items incidental to or required for a complete installation whether or not indicated as part of alternate.
- B. Execute accepted alternates under the same conditions as other work of the Contract.
- C. Schedule: A schedule of alternates is included at the end of this Section. Specification Sections referenced in schedule contain requirements for materials necessary to achieve the work described under each alternate.

ALTERNATES 012300 - 1

#### PART 2 - PRODUCTS (Not Used)

#### PART 3 - EXECUTION

#### 3.1 SCHEDULE OF ALTERNATES


- A. Alternate No. 1A: Lincon Elementary Asphalt & Concrete
  - 1. Base Bid: Contract shall not include any cost for work at Lincon Elementary in the Base Bid.
  - 2. Additive Alternate: Contractor to provide Additive alternate cost to provide all work associated with the existing Asphalt and Concrete areas shown on contract drawings at Lincon Elementary.
- B. Alternate No. 1B: Lincon Elementary Playground Resurfacing
  - 1. Base Bid: Contract shall not include any cost for work at Lincon Elementary in the Base Bid.
  - 2. Additive Alternate: Contractor to provide Additive alternate cost to provide all work associated with the resurfacing or (2) existing playground areas as indicated on the contract drawings at Lincon Elementary.
- C. Alternate No. 1C: Lincon Elementary Priority "B" Pavement Patching.
  - 1. Base Bid: Contract shall not include any cost for work at Lincon Elementary in the Base Bid.
  - 2. Additive Alternate: Contractor to provide Additive alternate cost to for all asphalt patching in areas identified as Priority B asphalt patching areas on the contract Drawings at Lincon Elementary.
- D. Alternate No. 1D: Lincon Elementary Expanded Staff Parking Lot.
  - 1. Base Bid: Contract shall not include any cost for work at Lincon Elementary in the Base Bid.
  - 2. *Additive Alternate*: Contractor to provide Additive alternate cost for the Expanded Staff Asphalt Parking Lot as noted on the contract Drawings at Lincon Elementary.
- E. Alternate No. 2: Riverview Middle School Widen Bus Lane
  - 1. Base Bid: Contract shall not include any cost for work realted to any work associated with the widening of the bus lane as shown on Contract Drawings at Riverview Middle School.
  - 2. Additive Alternate: Contractor to provide Additive alternate cost to provide all work associated with the widening of the bus lane as shown on Contract Drawings at Riverview Middle School.
- F. Alternate No. 3: Priority "B" Pavement Patching


ALTERNATES 012300 - 2

- 1. Base Bid: Contract shall not include any cost for work related to asphalt patching in areas identified as Priority B asphalt patching areas on the contract Drawings at Crestview Middle School, Riverview Middle School & Salamonie Elementary School.
- 2. Additive Alternate: Contractor to provide Additive alternate cost to for all asphalt patching in areas identified as Priority B asphalt patching areas on the contract Drawings at Crestview Middle School, Riverview Middle School & Salamonie Elementary School.
- G. Alternate No. 4: Crestview Drop Off Lane Modifications.
  - 1. Base Bid: Contract shall not include any cost for work related to modification of existing curb islands and striping modifications in the drop off lane at Crestview Middle School.
  - 2. Additive Alternate: Contractor to provide Additive alternate cost for all work associated with curb island modifications and additional striping in the drop off lane area at Crestview middle school as shown in Alternate #4 plan issued as part of Addedum#1.

**END OF SECTION 012300** 

ALTERNATES 012300 - 3

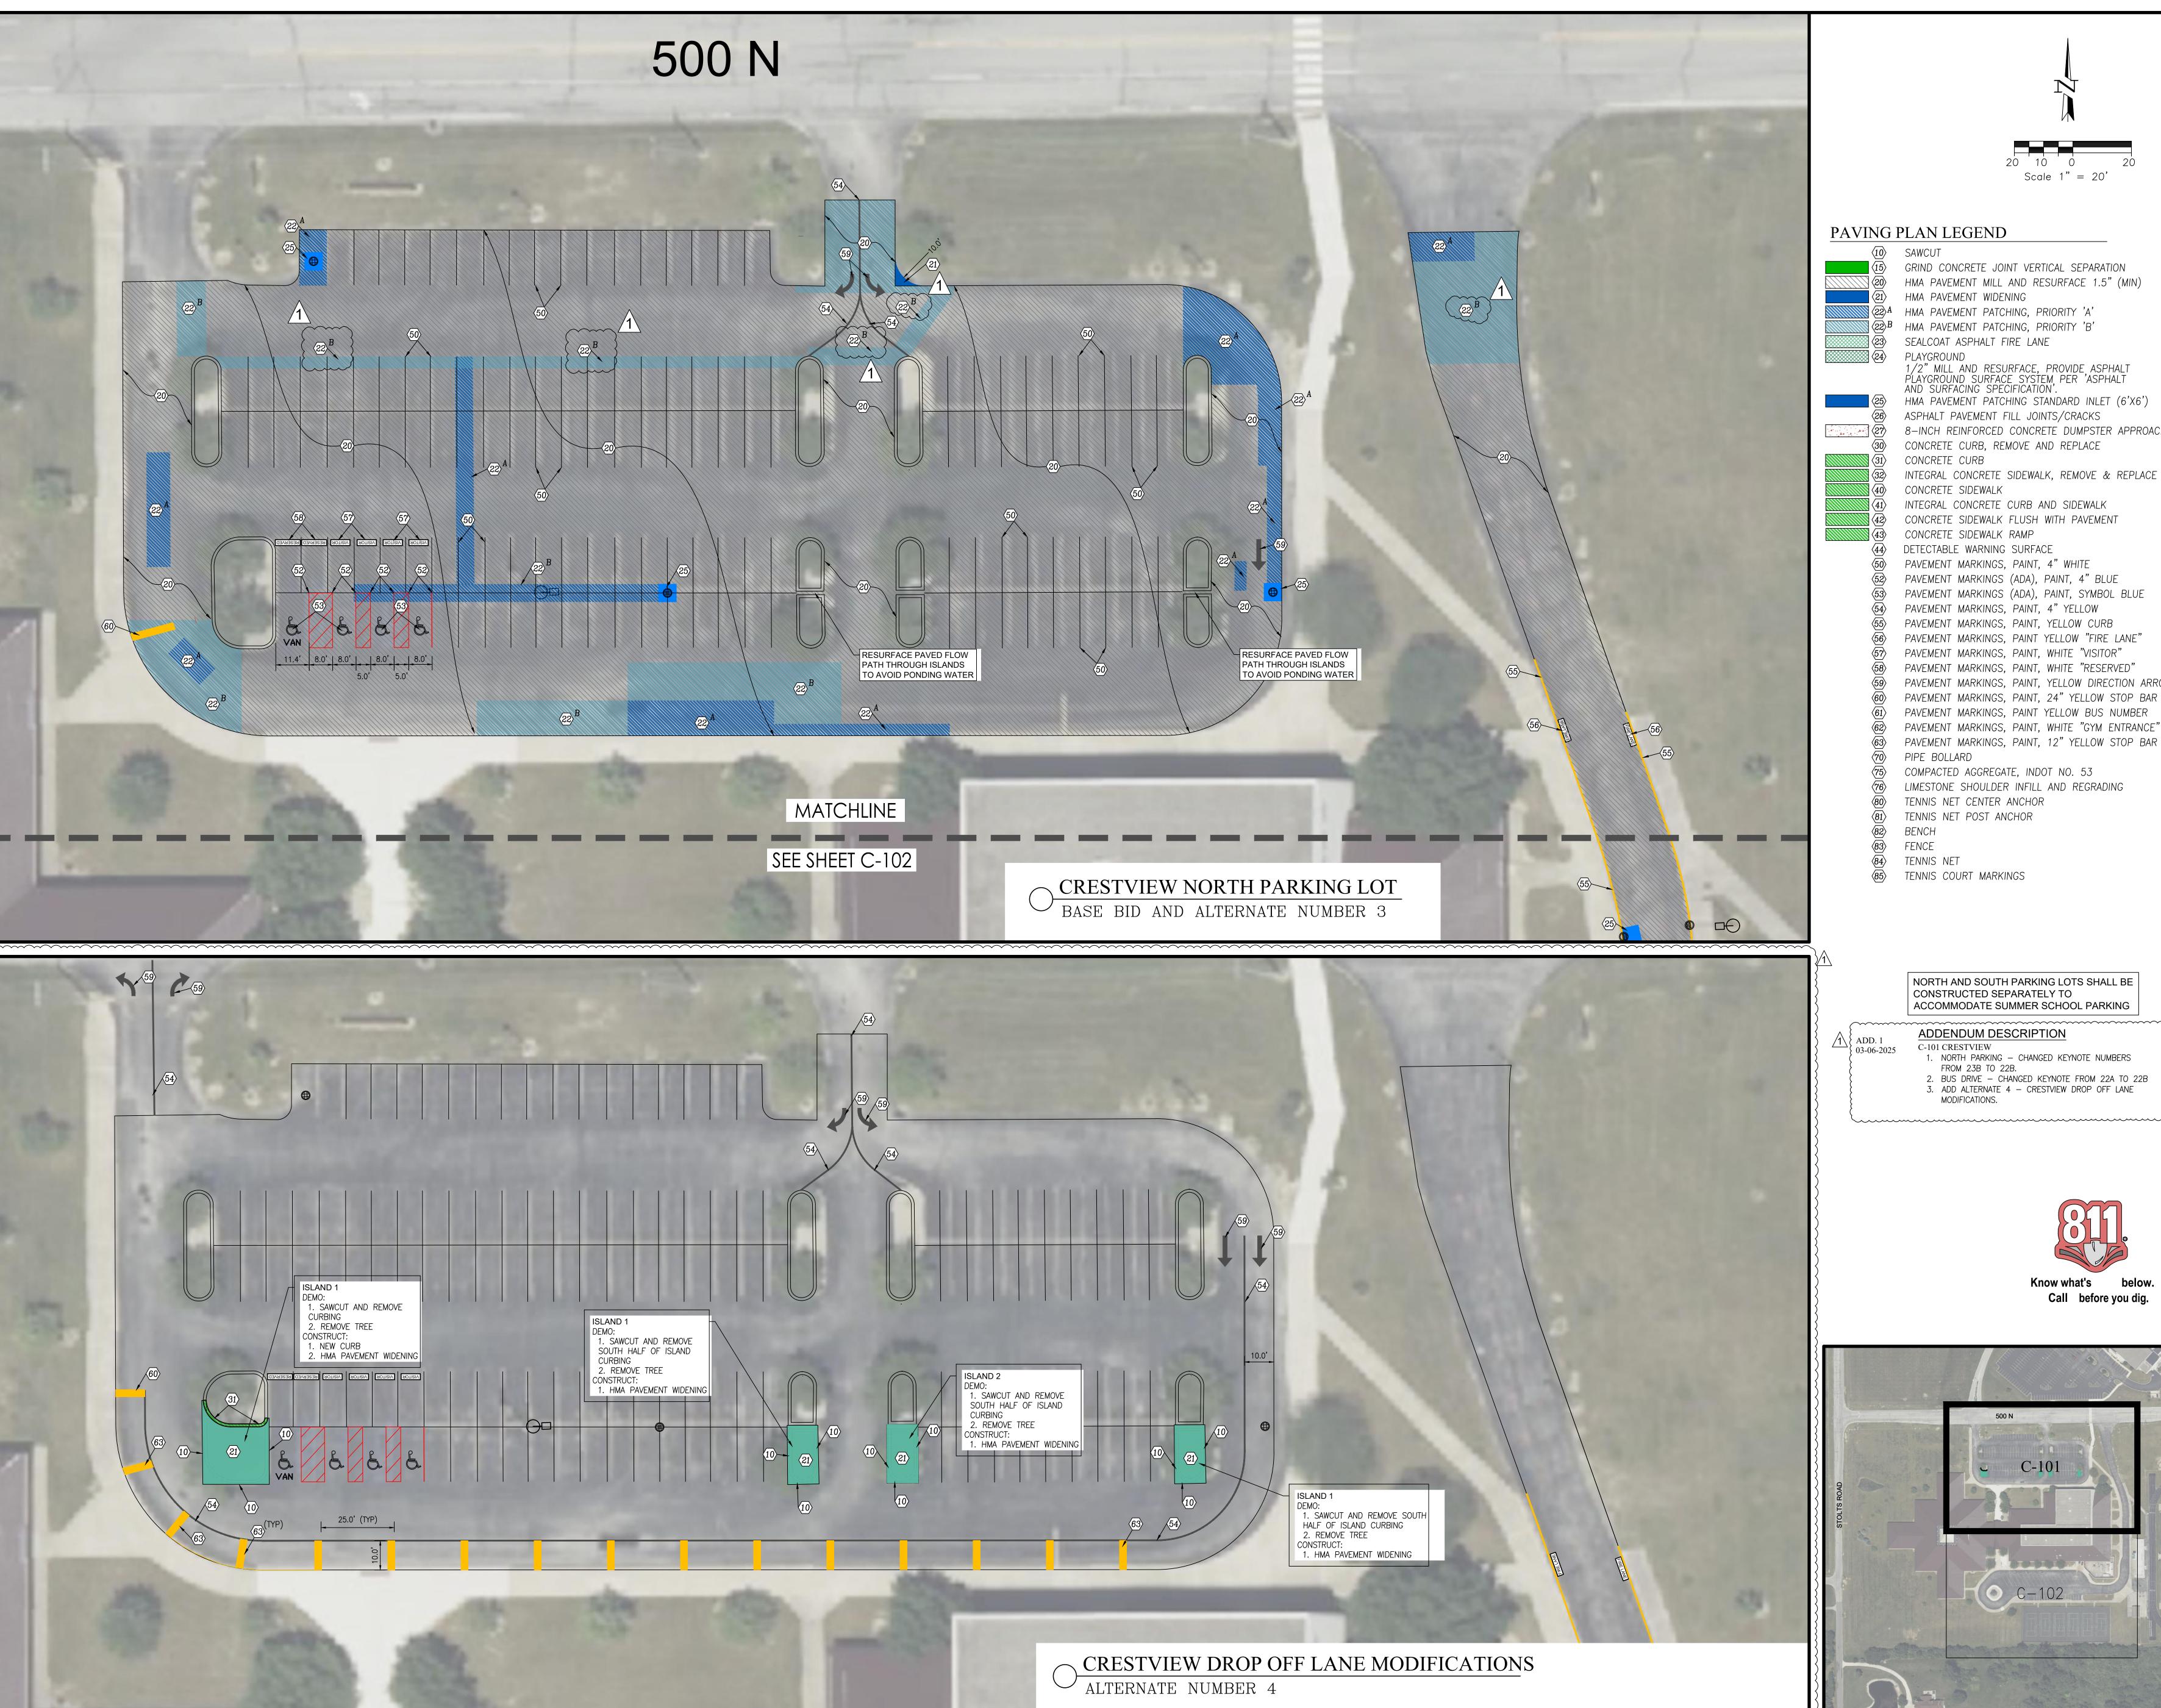

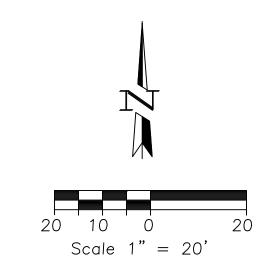

architecture + design

425 E Brackenridge Street Fort Wayne, Indiana 46802

p 260.422.0783 www.MKMdesign.com

consultant Logo:

Gensic

Engineering Inc
Civil Engineers
407 Airport North Office Park
Fort Wayne, IN 46825
Phone - (260) 489-7643

ALL IDEAS, DESIGNS, ARRANGEMENTS AND PLANS INDICATED BY THIS DRAWING ARE OWNED BY, AND THE PROPERTY OF MKM ARCHITECTURE + DESIGN, AND WERE CREATED AND DEVELOPED FOR USE ON, AND IN CONNECTION WITH THIS SPECIFIC PROJECT.

AND IN CONNECTION WITH THIS SPECIFIC PROJECT.

NONE OF THE IDEAS, DESIGNS, ARRANGEMENTS OR

PLANS SHALL BE USED BY OR DISCLOSED TO ANY

PERSON, FIRM OR CORPORATION FOR ANY

PURPOSE WHATSOEVER WITHOUT THE WRITTEN

PERMISSION OF MKM ARCHITECTURE + DESIGN.

THE OWNER SHALL BE PERMITTED TO RETAIN

COPIES FOR INFORMATION AND REFERENCE IN

CONNECTION WITH THIS PROJECT.

COPIES FOR INFORMATION AND REFERENCE IN CONNECTION WITH THIS PROJECT. WRITTEN DIMENSIONS ON THESE DRAWINGS SHALL HAVE PRECEDENCE OVER SCALE DIMENSIONS. CONTRACTORS SHALL VERIFY AND BE RESPONSIBLE FOR ALL DIMENSIONS AND CONDITIONS ON THE JOB AND THIS OFFICE MUST BE NOTIFIED OF ANY VARIATION FROM THE DIMENSIONS AND CONDITIONS SHOWN BY THESE DRAWINGS SHOUPD DRAWINGS MIST BE SUBMITTED.

DIMENSIONS AND CONDITIONS SHOWN BY THESE DRAWINGS. SHOP DRAWINGS MUST BE SUBMITTED TO THIS OFFICE FOR REVIEW BEFORE PROCEEDING WITH FABRICATION AND/OR INSTALLATION. THE WORK SHOWN ON THIS DOCUMENT, AND THE CORRESPONDING SPECIFICATIONS, INTERFACES WITH WORK SHOWN ON OTHER DOCUMENTS INCLUDING WORK TO BE PERFORMED BY OTHER CONTRACTORS OR SUBCONTRACTORS. EACH CONTRACTOR OR SUBCONTRACTORS. EACH CONTRACTOR OR SUBCONTRACTORS, WHETHER OR NOT SHOWN ON THIS DOCUMENT, WHICH IMPACTS THE WORK SHOWN HEREIN AND SHALL COORDINATE SUCH WORK SO AS TO BE IN COMPLIANCE WITH THE INTENT OF ALL THE PROJECT DOCUMENTS.

HUNTINGTON CC COMMUNITY SC CORPORATION PARKING LOT & TE IMPROVEMENTS P

## PAVING PLAN LEGEND

GRIND CONCRETE JOINT VERTICAL SEPARATION HMA PAVEMENT MILL AND RESURFACE 1.5" (MIN) HMA PAVEMENT WIDENING HMA PAVEMENT PATCHING, PRIORITY 'A' HMA PAVEMENT PATCHING, PRIORITY 'B'

SEALCOAT ASPHALT FIRE LANE 1/2" MILL AND RESURFACE, PROVIDE ASPHALT PLAYGROUND SURFACE SYSTEM PER 'ASPHALT AND SURFACING SPECIFICATION'.

HMA PAVEMENT PATCHING STANDARD INLET (6'X6') ASPHALT PAVEMENT FILL JOINTS/CRACKS 8-INCH REINFORCED CONCRETE DUMPSTER APPROACH CONCRETE CURB, REMOVE AND REPLACE

CONCRETE CURB INTEGRAL CONCRETE SIDEWALK, REMOVE & REPLACE CONCRETE SIDEWALK

INTEGRAL CONCRETE CURB AND SIDEWALK CONCRETE SIDEWALK FLUSH WITH PAVEMENT CONCRETE SIDEWALK RAMP

DETECTABLE WARNING SURFACE PAVEMENT MARKINGS, PAINT, 4" WHITE PAVEMENT MARKINGS (ADA), PAINT, 4" BLUE PAVEMENT MARKINGS (ADA), PAINT, SYMBOL BLUE PAVEMENT MARKINGS, PAINT, 4" YELLOW

PAVEMENT MARKINGS, PAINT, YELLOW CURB PAVEMENT MARKINGS, PAINT YELLOW "FIRE LANE" PAVEMENT MARKINGS, PAINT, WHITE "VISITOR" PAVEMENT MARKINGS, PAINT, WHITE "RESERVED" PAVEMENT MARKINGS, PAINT, YELLOW DIRECTION ARROW PAVEMENT MARKINGS, PAINT, 24" YELLOW STOP BAR

PAVEMENT MARKINGS, PAINT, 12" YELLOW STOP BAR PIPE BOLLARD COMPACTED AGGREGATE, INDOT NO. 53

TENNIS NET CENTER ANCHOR TENNIS NET POST ANCHOR

> TENNIS NET TENNIS COURT MARKINGS


> > NORTH AND SOUTH PARKING LOTS SHALL BE CONSTRUCTED SEPARATELY TO ACCOMMODATE SUMMER SCHOOL PARKING

### ADDENDUM DESCRIPTION

C-101 CRESTVIEW 1. NORTH PARKING - CHANGED KEYNOTE NUMBERS FROM 23B TO 22B. 2. BUS DRIVE — CHANGED KEYNOTE FROM 22A TO 22B
3. ADD ALTERNATE 4 — CRESTVIEW DROP OFF LANE

Know what's below.




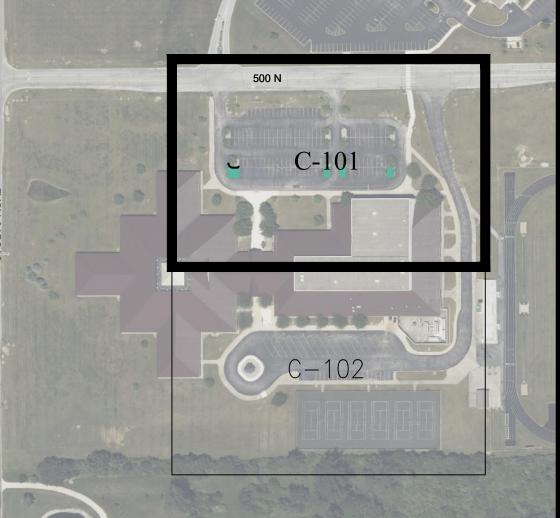


DRAWING CONTENTS: PAVING PLAN -NORTH PARKING LOT ISSUE DATE: PROJECT NO. 02.25.2025

DRAWING NO.

C-101

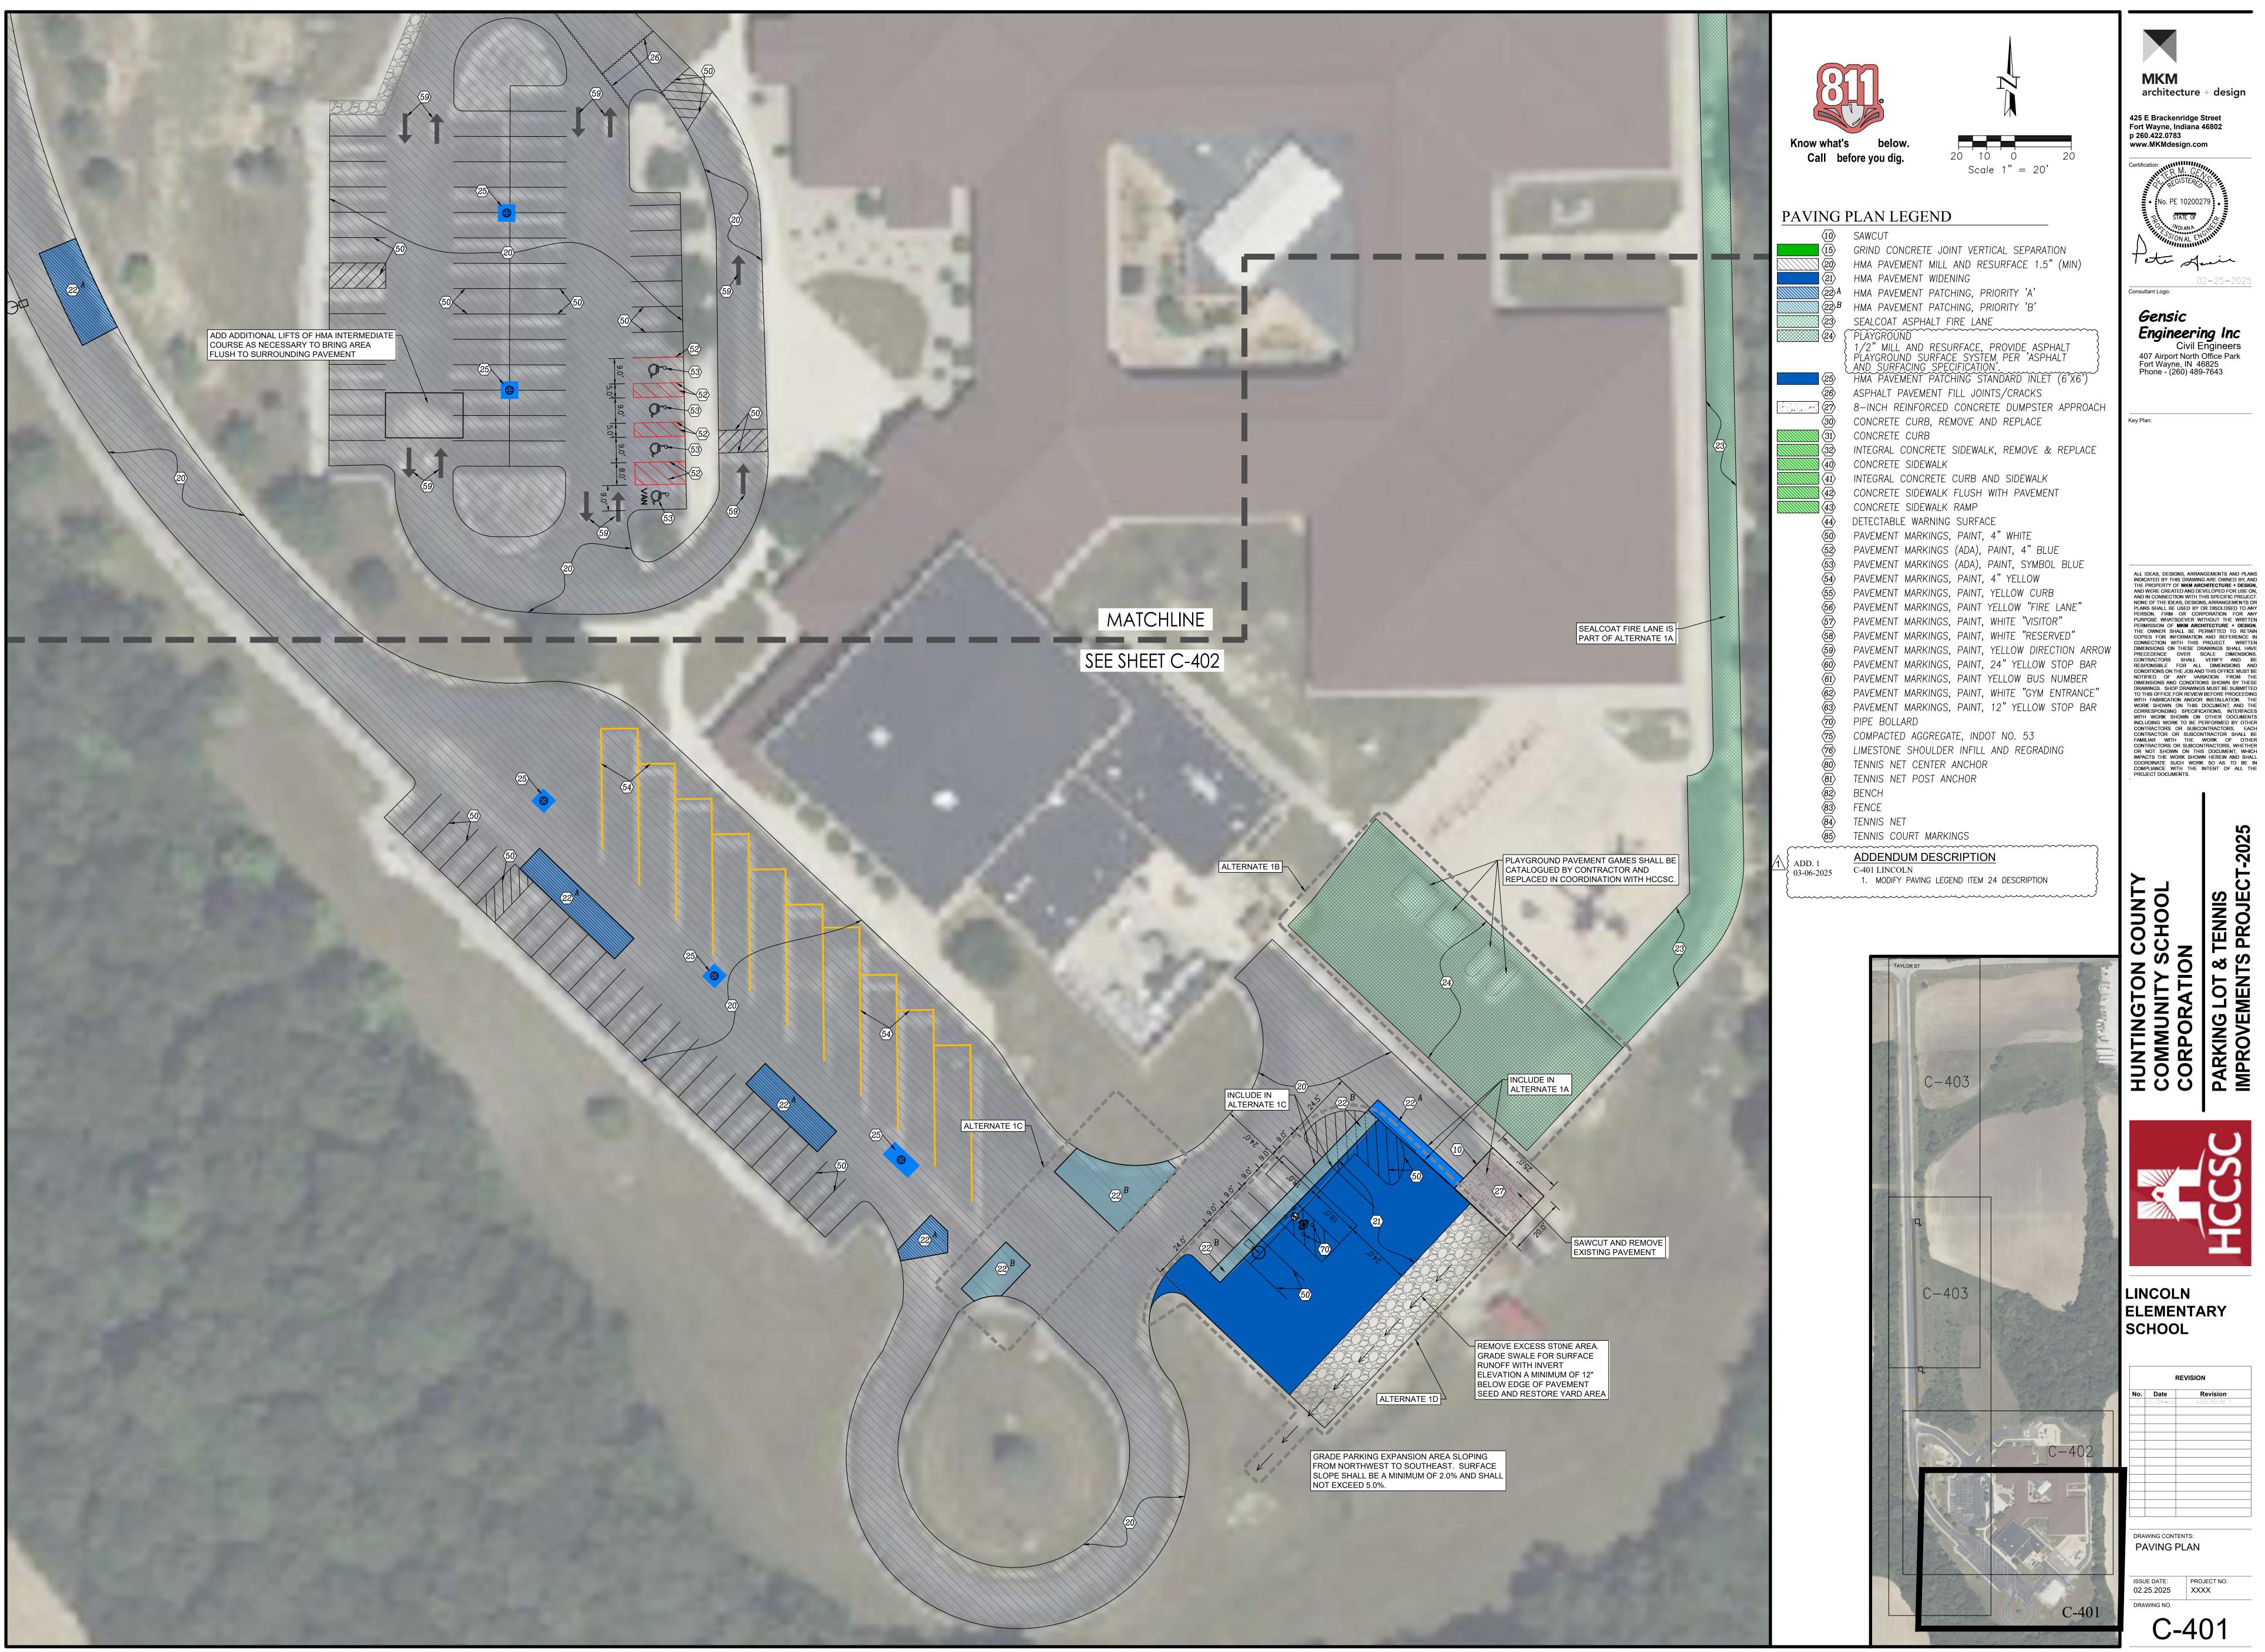



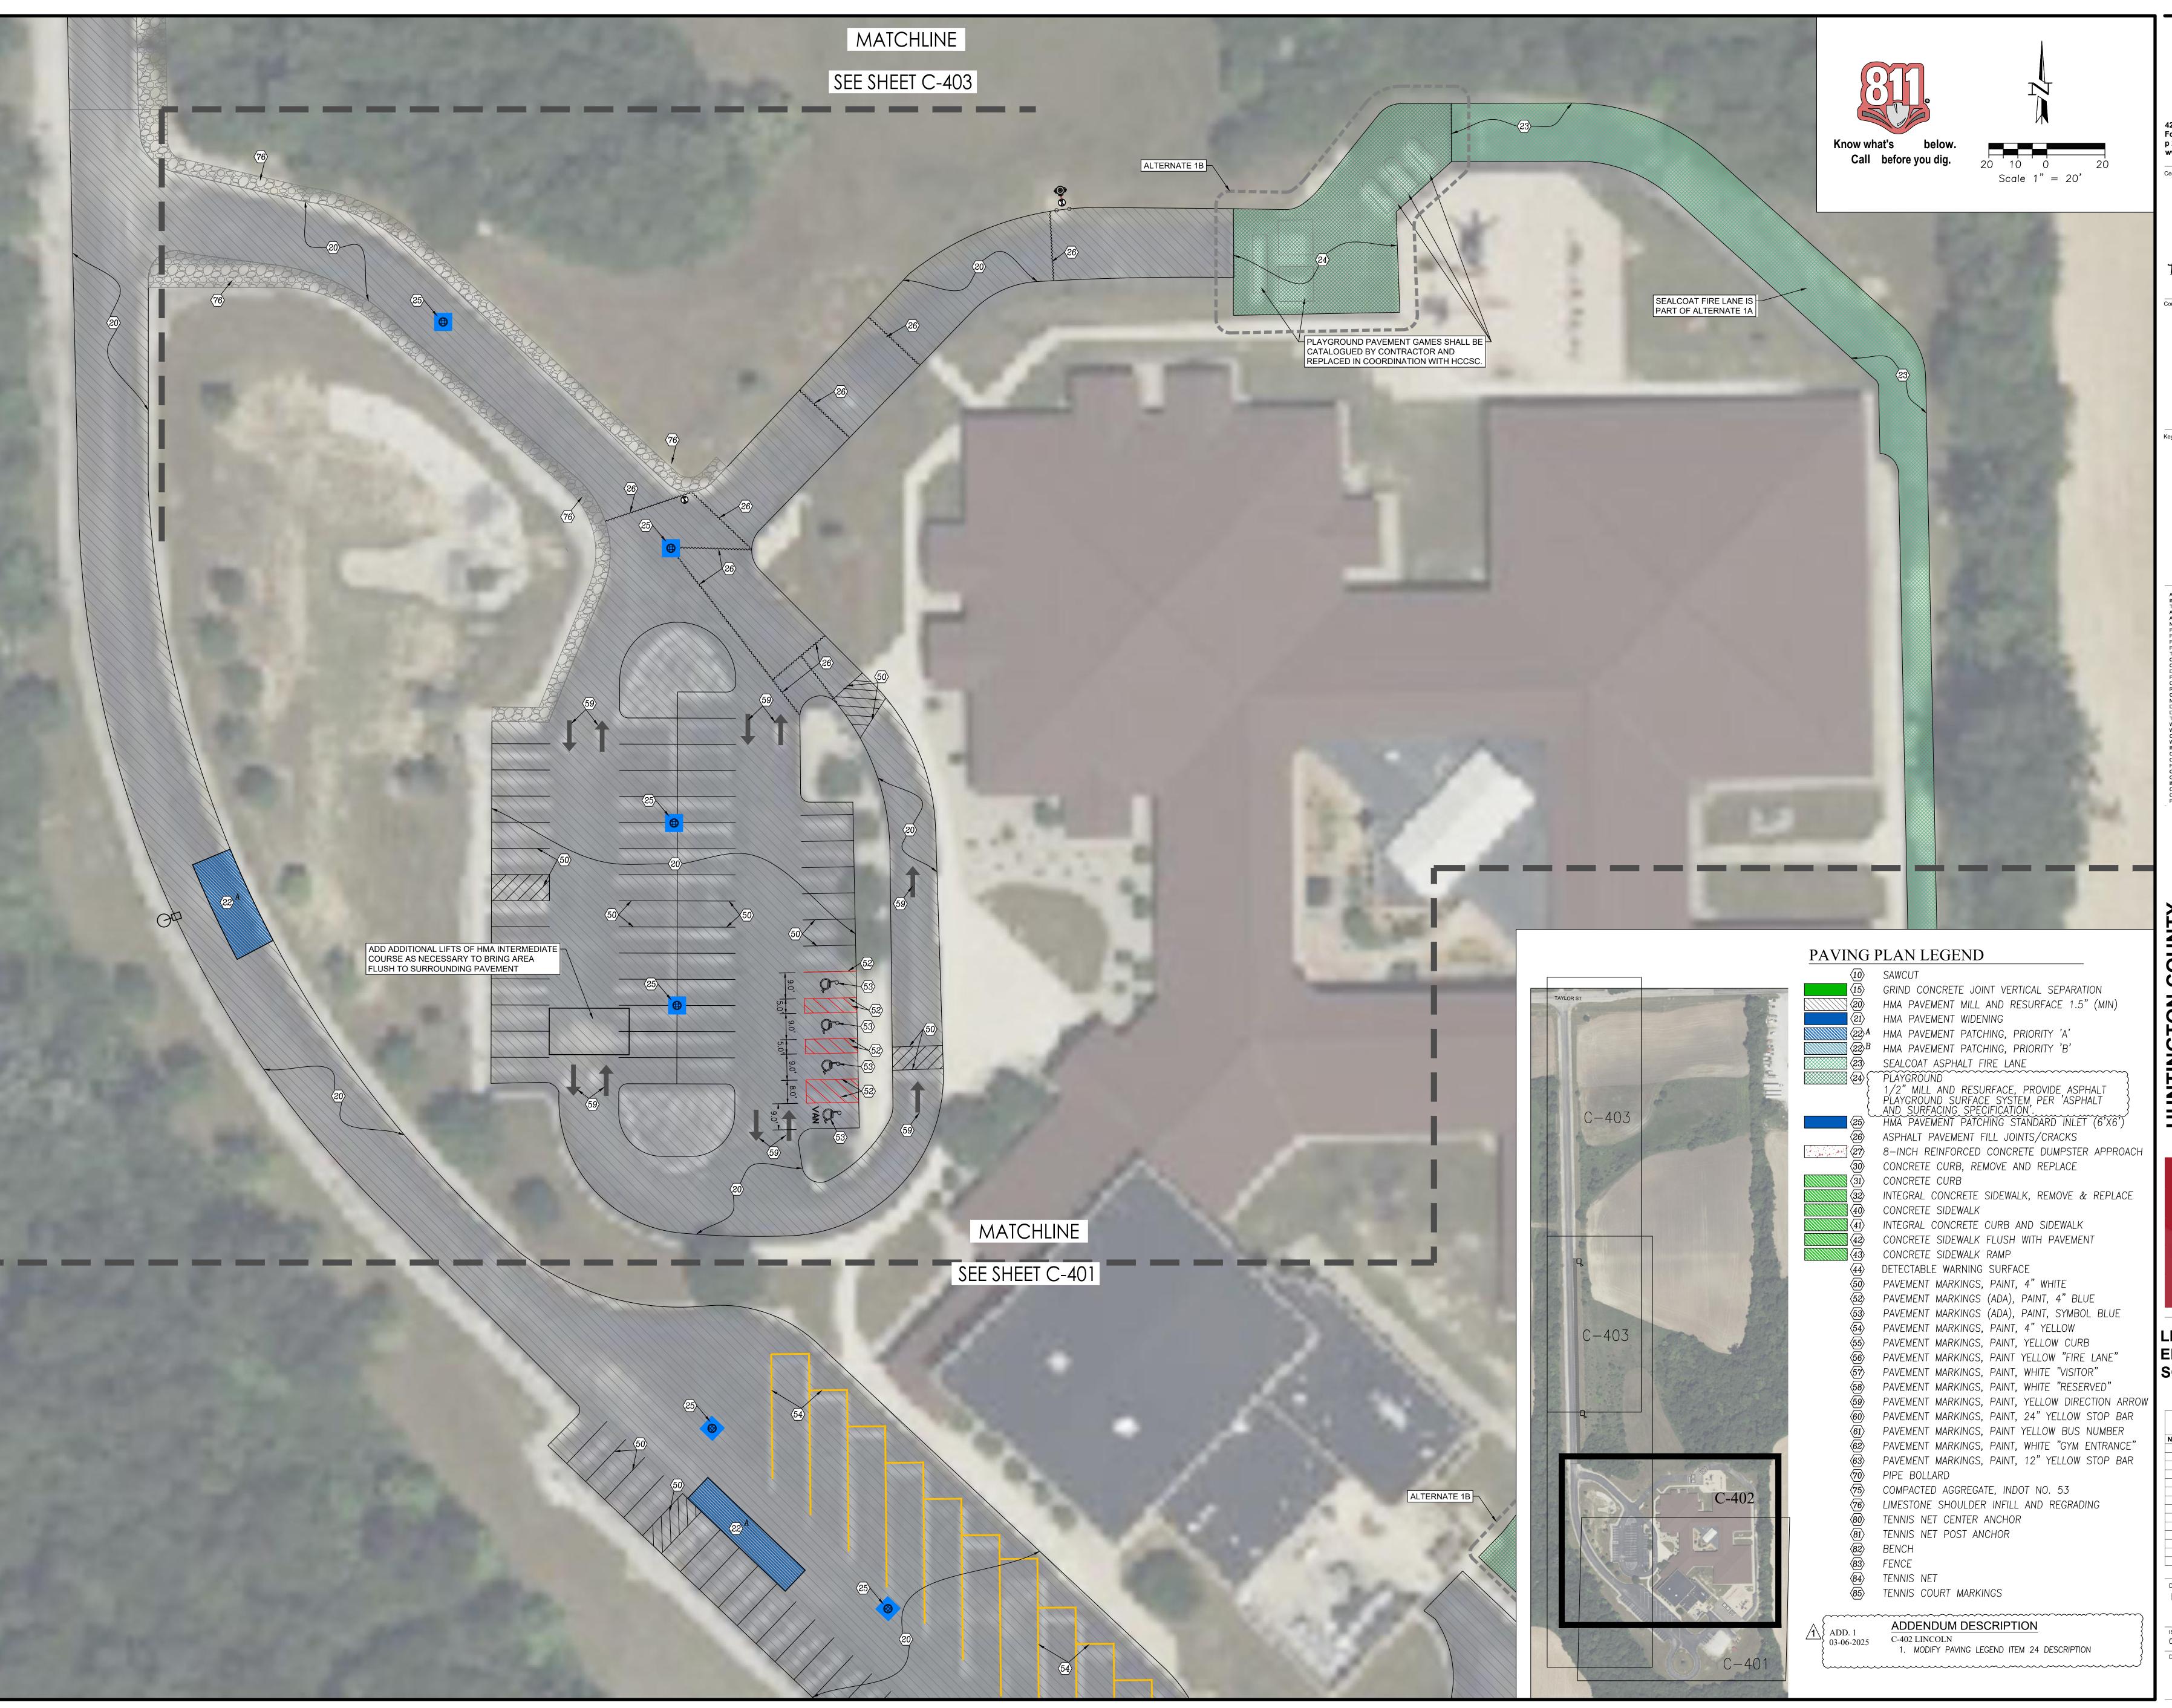

architecture + design

425 E Brackenridge Street Fort Wayne, Indiana 46802 p 260.422.0783

www.MKMdesign.com

Consultant Logo:

Engineering Inc Civil Engineers 407 Airport North Office Park Fort Wayne, IN 46825 Phone - (260) 489-7643

Key Plan:

ALL IDEAS, DESIGNS, ARRANGEMENTS AND PLANS INDICATED BY THIS DRAWING ARE OWNED BY, AND THE PROPERTY OF MKM ARCHITECTURE + DESIGN, AND WERE CREATED AND DEVELOPED FOR USE ON, AND IN CONNECTION WITH THIS SPECIFIC PROJECT. NONE OF THE IDEAS, DESIGNS, ARRANGEMENTS OR PLANS SHALL BE USED BY OR DISCLOSED TO ANY PERSON, FIRM OR CORPORATION FOR ANY PURPOSE WHATSOEVER WITHOUT THE WRITTEN PERMISSION OF MKM ARCHITECTURE + DESIGN. THE OWNER SHALL BE PERMITTED TO RETAIN COPIES FOR INFORMATION AND REFERENCE IN CONNECTION WITH THIS PROJECT. WRITTEN DIMENSIONS ON THESE DRAWINGS SHALL HAVE PRECEDENCE OVER SCALE DIMENSIONS. CONTRACTORS SHALL VERIFY AND BE RESPONSIBLE FOR ALL DIMENSIONS AND CONDITIONS ON THE JOB AND THIS OFFICE MUST BE NOTIFIED OF ANY VARIATION FROM THE DIMENSIONS AND CONDITIONS SHOWN BY THESE DRAWINGS. SHOP DRAWINGS MUST BE SUBMITTED

DIMENSIONS AND CONDITIONS SHOWN BY THESE DRAWINGS. SHOP DRAWINGS MUST BE SUBMITTED TO THIS OFFICE FOR REVIEW BEFORE PROCEEDING WITH FABRICATION AND/OR INSTALLATION. THE WORK SHOWN ON THIS DOCUMENT, AND THE CORRESPONDING SPECIFICATIONS, INTERFACES WITH WORK SHOWN ON OTHER DOCUMENTS INCLUDING WORK TO BE PERFORMED BY OTHER CONTRACTORS OR SUBCONTRACTORS. EACH CONTRACTOR OR SUBCONTRACTORS. EACH CONTRACTOR OR SUBCONTRACTORS, WHETHER CONTRACTORS OR SUBCONTRACTORS, WHETHER OR NOT SHOWN ON THIS DOCUMENT, WHICH IMPACTS THE WORK SHOWN HEREIN AND SHALL COORDINATE SUCH WORK SO AS TO BE IN COMPLIANCE WITH THE INTENT OF ALL THE PROJECT DOCUMENTS.


HUNTINGTON COUNTY COMMUNITY SCHOOL CORPORATION PARKING LOT & TENNIS IMPROVEMENTS PROJECT

LINCOLN ELEMENTARY SCHOOL

RE	EVISION
No. Date	Revision
1 03-06-25	ADDENDUM 1

02.25.2025 XXXX

C-402

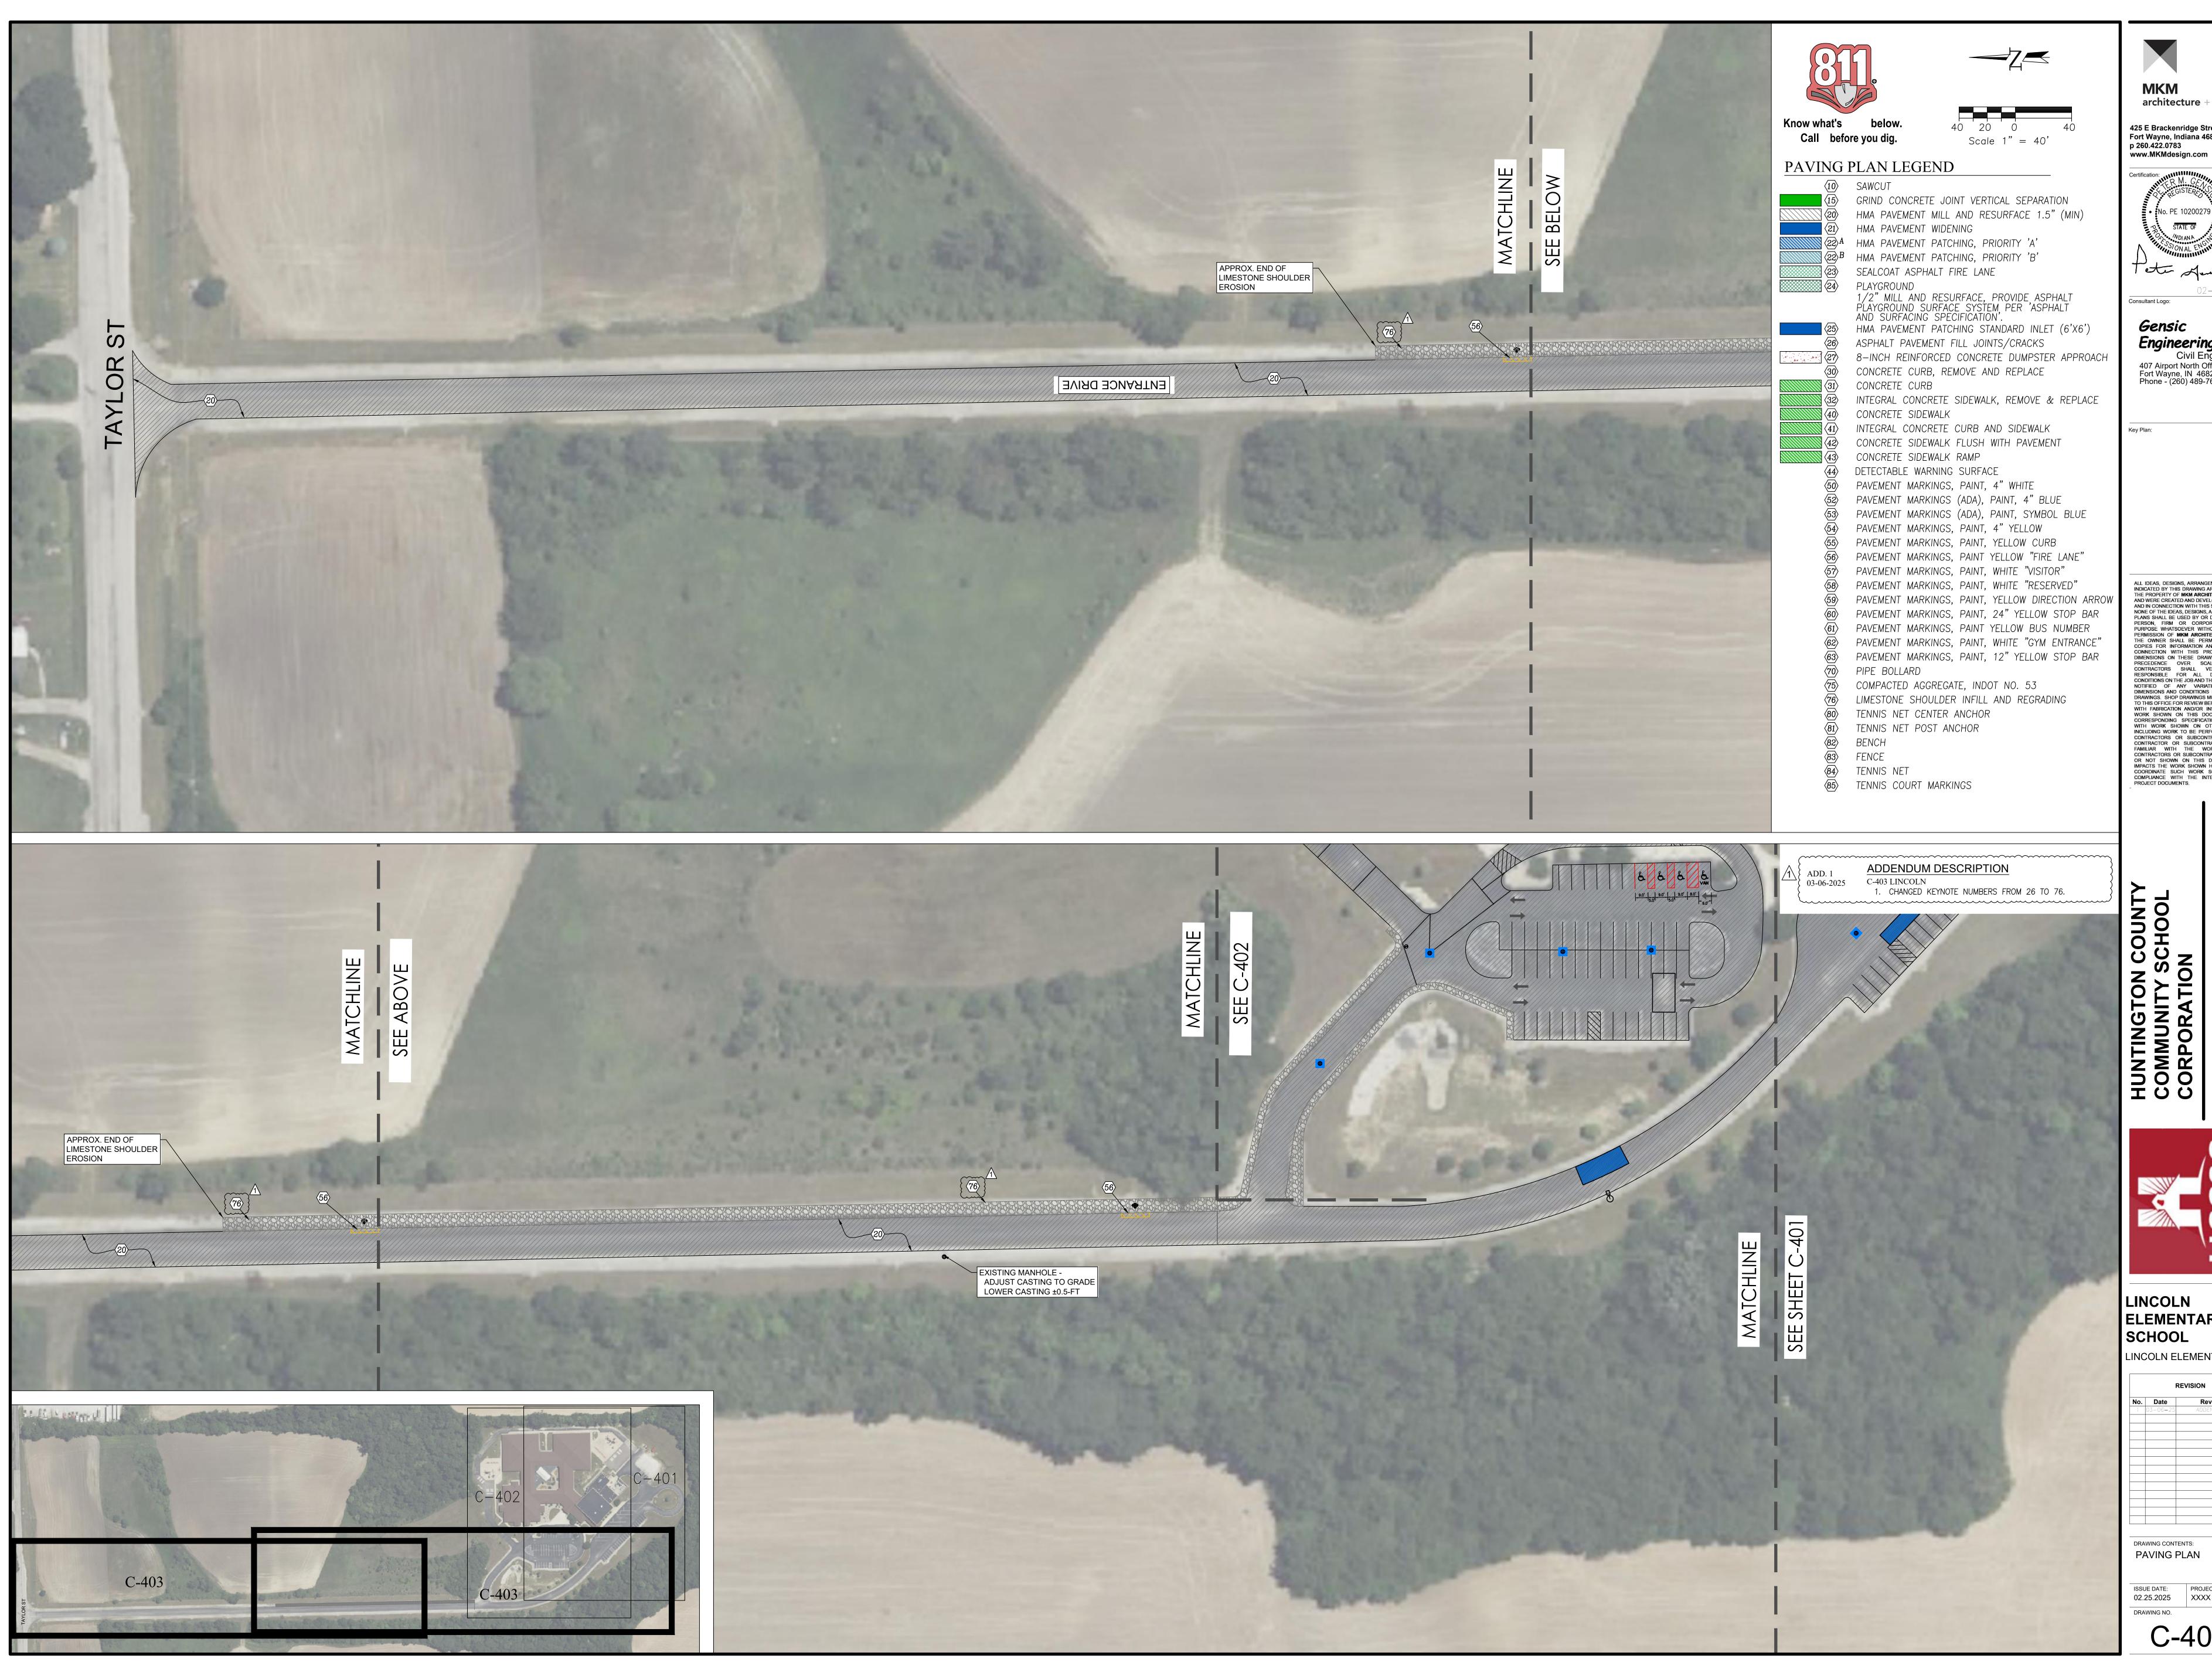

architecture + design

425 E Brackenridge Street Fort Wayne, Indiana 46802

STATE OF

Engineering Inc Civil Engineers 407 Airport North Office Park Fort Wayne, IN 46825 Phone - (260) 489-7643

ALL IDEAS, DESIGNS, ARRANGEMENTS AND PLANS INDICATED BY THIS DRAWING ARE OWNED BY, AND THE PROPERTY OF MKM ARCHITECTURE + DESIGN, AND WERE CREATED AND DEVELOPED FOR USE ON, AND IN CONNECTION WITH THIS SPECIFIC PROJECT. NONE OF THE IDEAS, DESIGNS, ARRANGEMENTS OR PLANS SHALL BE USED BY OR DISCLOSED TO ANY PERSON, FIRM OR CORPORATION FOR ANY PURPOSE WHATSOEVER WITHOUT THE WRITTEN PERMISSION OF MKM ARCHITECTURE + DESIGN. THE OWNER SHALL BE PERMITTED TO RETAIN COPIES FOR INFORMATION AND REFERENCE IN CONNECTION WITH THIS PROJECT. WRITTEN DIMENSIONS ON THESE DRAWINGS SHALL HAVE PRECEDENCE OVER SCALE DIMENSIONS. CONTRACTORS SHALL VERIFY AND BE RESPONSIBLE FOR ALL DIMENSIONS AND CONDITIONS ON THE JOB AND THIS OFFICE MUST BE NOTIFIED OF ANY VARIATION FROM THE DIMENSIONS AND CONDITIONS SHOWN BY THESE DRAWINGS. SHOP DRAWINGS MUST BE SUBMITTED DIMENSIONS AND CONDITIONS SHOWN BY THESE DRAWINGS. SHOP DRAWINGS MUST BE SUBMITTED TO THIS OFFICE FOR REVIEW BEFORE PROCEEDING WITH FABRICATION AND/OR INSTALLATION. THE WORK SHOWN ON THIS DOCUMENT, AND THE CORRESPONDING SPECIFICATIONS, INTERFACES WITH WORK SHOWN ON OTHER DOCUMENTS INCLUDING WORK TO BE PERFORMED BY OTHER CONTRACTORS OR SUBCONTRACTORS. EACH CONTRACTOR OR SUBCONTRACTORS. EACH CONTRACTOR OR SUBCONTRACTORS, WHETHER CONTRACTORS OR SUBCONTRACTORS, WHETHER OR NOT SHOWN ON THIS DOCUMENT, WHICH IMPACTS THE WORK SHOWN HEREIN AND SHALL COORDINATE SUCH WORK SO AS TO BE IN COMPLIANCE WITH THE INTENT OF ALL THE PROJECT DOCUMENTS.




ELEMENTARY

LINCOLN ELEMENTARY SCHOOL

No. Date	Revision
1 03-06-2	25 ADDENDUM 1
DRAWING CO	MITEMITO

C-403

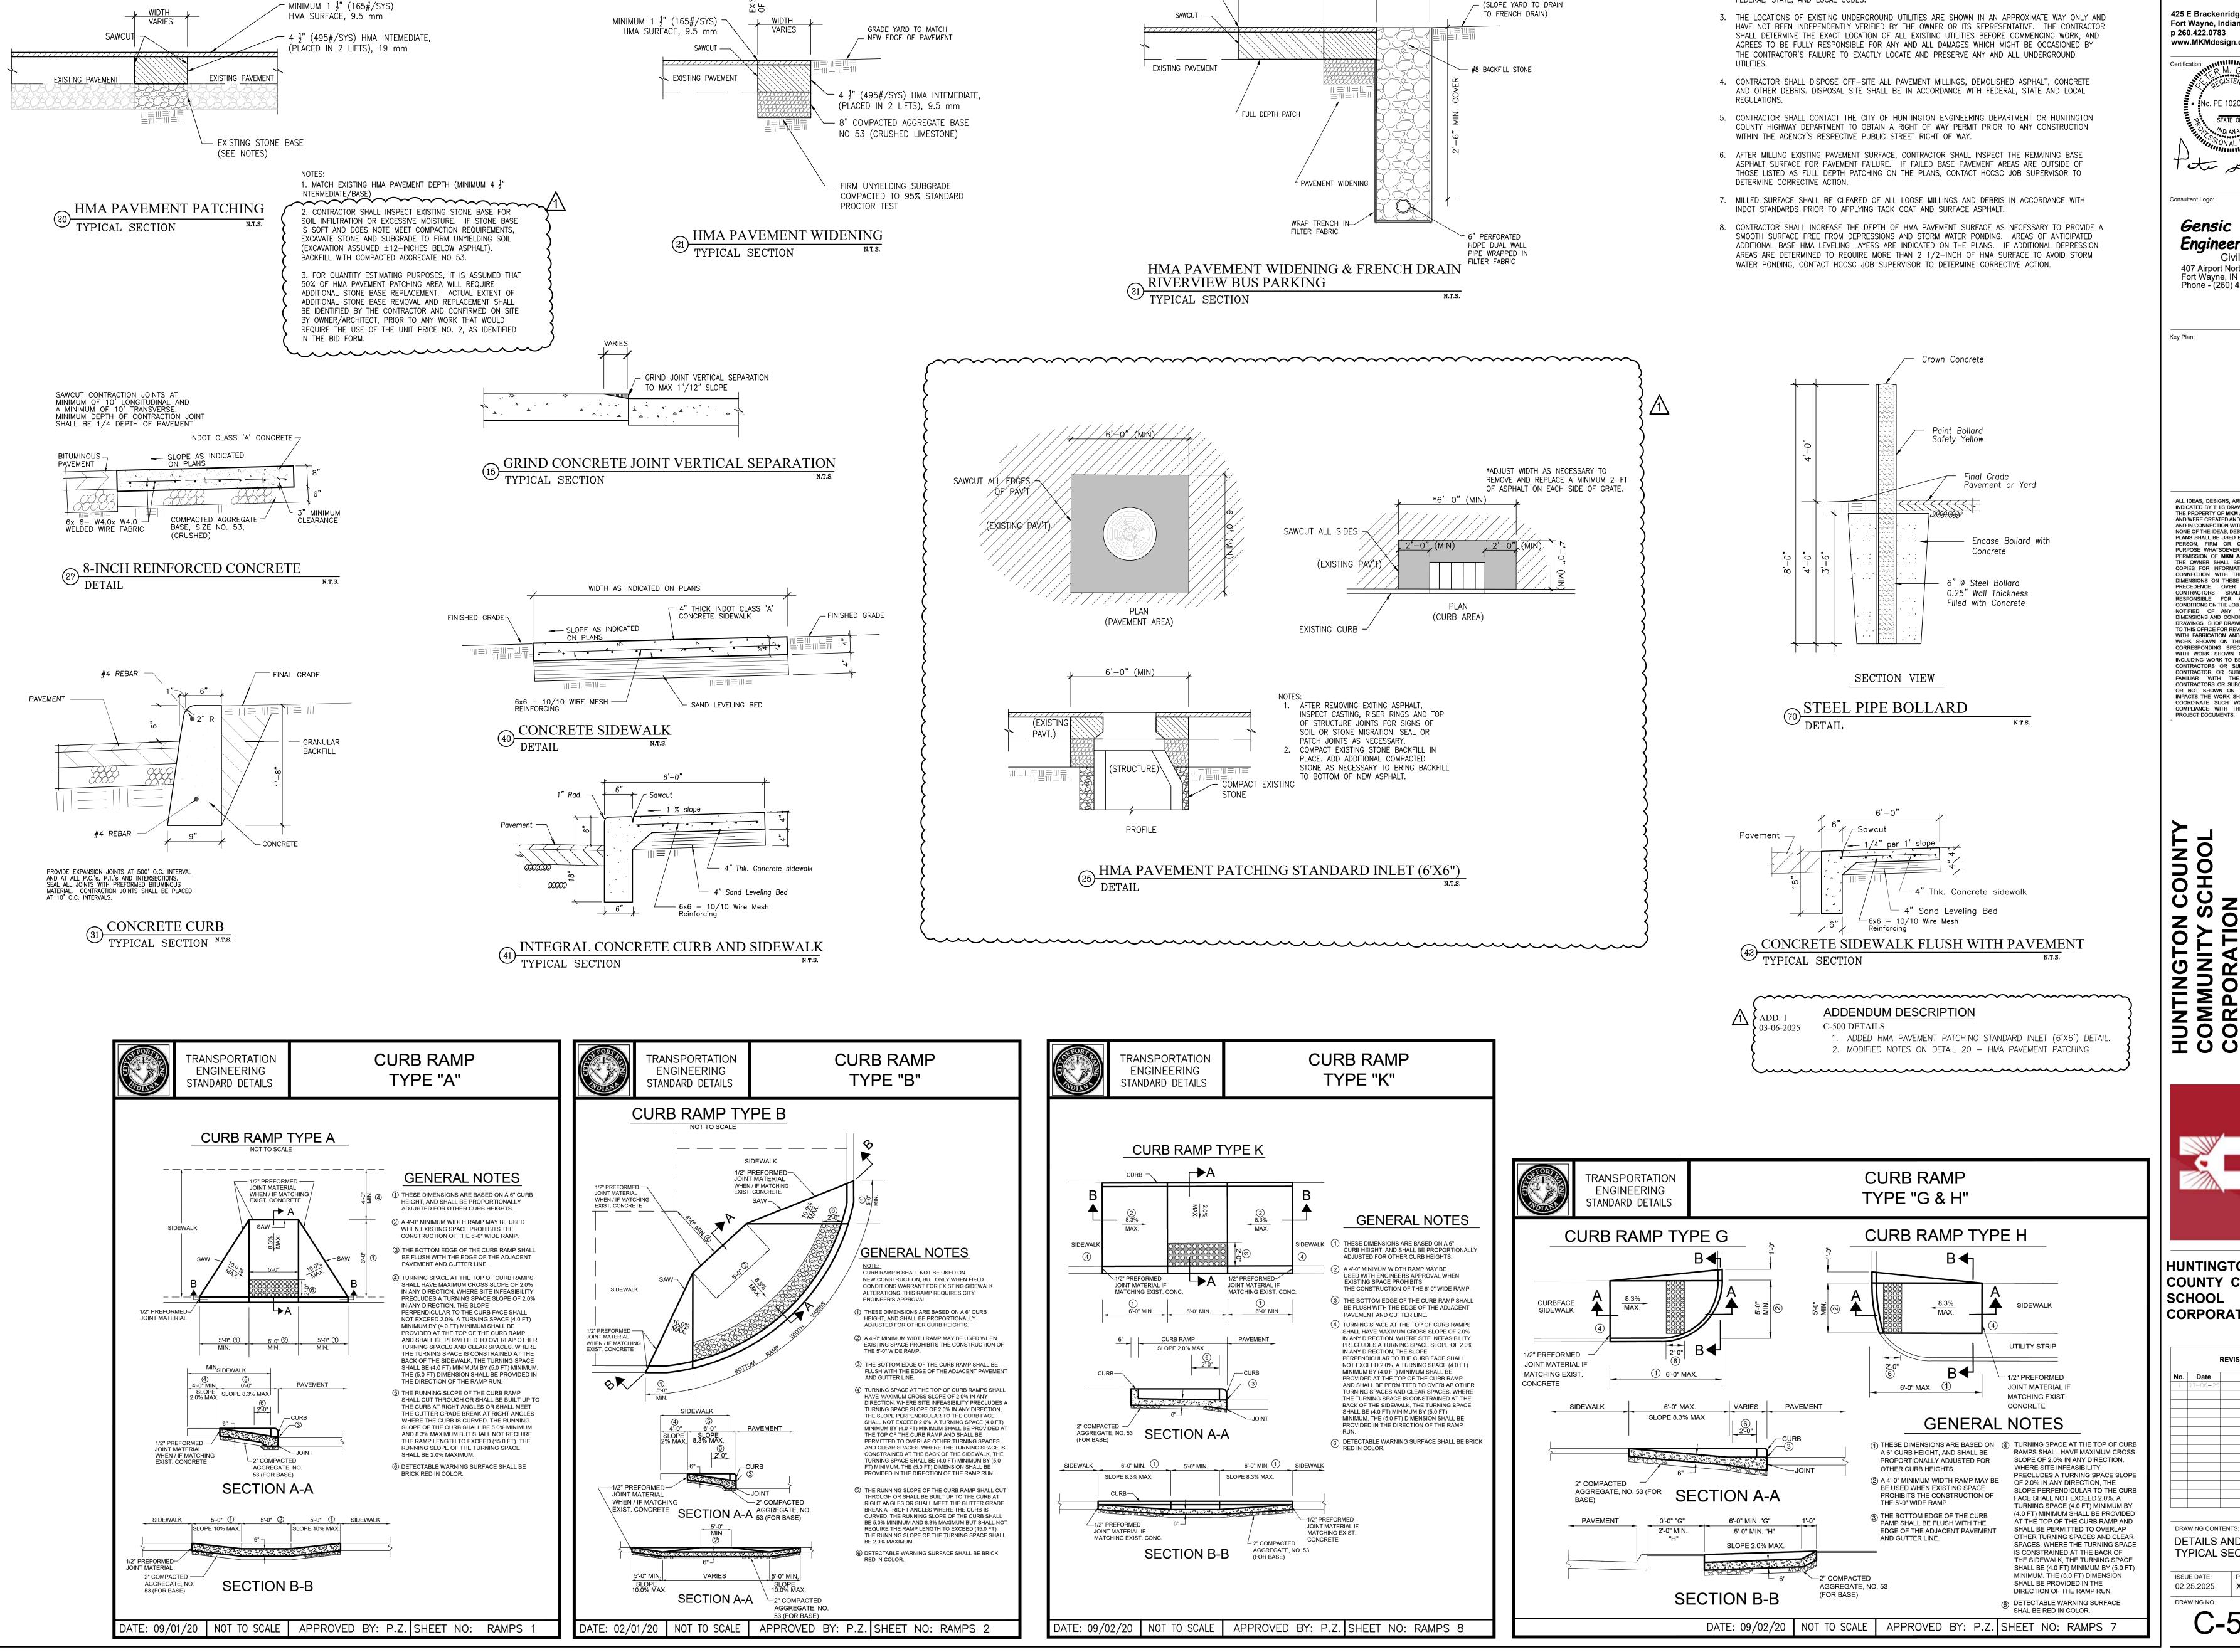

MINIMUM 1  $\frac{1}{2}$ " (165#/SYS)

HMA SURFACE, 9.5 mm

**GENERAL NOTES** 

LATEST EDITION.

FEDERAL, STATE, AND LOCAL CODES.

FINISH GRADE

1. ALL MATERIALS AND WORKMANSHIP SHALL COMPLY WITH INDOT STANDARDS AND SPECIFICATIONS,

2. CONTRACTOR IS RESPONSIBLE FOR CONSTRUCTION PRACTICES AND JOBSITE SAFETY COMPLYING WITH

architecture + design

425 E Brackenridge Street Fort Wayne, Indiana 46802 p 260.422.0783 www.MKMdesign.com

Certification: . STATE OF

Consultant Logo: Gensic

Engineering Inc Civil Engineers 407 Airport North Office Park Fort Wayne, IN 46825 Phone - (260) 489-7643


Key Plan:

ALL IDEAS, DESIGNS, ARRANGEMENTS AND PLANS INDICATED BY THIS DRAWING ARE OWNED BY, AND THE PROPERTY OF MKM ARCHITECTURE + DESIGN, AND WERE CREATED AND DEVELOPED FOR USE ON, AND IN CONNECTION WITH THIS SPECIFIC PROJECT. NONE OF THE IDEAS, DESIGNS, ARRANGEMENTS OR PLANS SHALL BE USED BY OR DISCLOSED TO ANY PERSON. FIRM OR CORPORATION FOR ANY PERSON, FIRM OR CORPORATION FOR ANY PURPOSE WHATSOEVER WITHOUT THE WRITTEN PERMISSION OF MKM ARCHITECTURE + DESIGN. THE OWNER SHALL BE PERMITTED TO RETAIN COPIES FOR INFORMATION AND REFERENCE IN CONNECTION WITH THIS PROJECT. WRITTEN DIMENSIONS ON THESE DRAWINGS SHALL HAVE PRECEDENCE OVER SCALE DIMENSIONS. CONTRACTORS SHALL VERIFY AND BE RESPONSIBLE FOR ALL DIMENSIONS AND CONDITIONS ON THE JOB AND THIS OFFICE MUST BE NOTIFIED OF ANY VARIATION FROM THE DIMENSIONS AND CONDITIONS SHOWN BY THESE TO THIS OFFICE FOR REVIEW BEFORE PROCEFDING WORK SHOWN ON THIS DOCUMENT, AND TH CORRESPONDING SPECIFICATIONS, INTERFACES WITH WORK SHOWN ON OTHER DOCUMENTS INCLUDING WORK TO BE PERFORMED BY OTHER CONTRACTORS OR SUBCONTRACTORS. EACH CONTRACTORS OR SUBCONTRACTORS. EACH
CONTRACTOR OR SUBCONTRACTORS SHALL BE
FAMILIAR WITH THE WORK OF OTHER
CONTRACTORS OR SUBCONTRACTORS, WHETHER
OR NOT SHOWN ON THIS DOCUMENT, WHICH
IMPACTS THE WORK SHOWN HEREIN AND SHALL COORDINATE SUCH WORK SO AS TO BE IN COMPLIANCE WITH THE INTENT OF ALL THE

HUNTINGTON CO COMMUNITY SCH CORPORATION LOT

PARKING IMPROVEN

HUNTINGTON COUNTY COMMUNITY SCHOOL CORPORATION

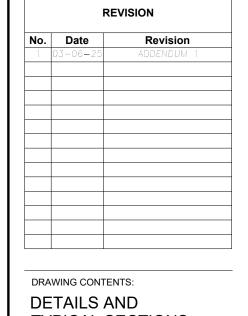

TYPICAL SECTIONS ISSUE DATE: PROJECT NO.

02.25.2025 XXXX DRAWING NO.