



## **HCCSC - HNHS Floor Restoration**

**Project #** 2025.0001

April 18, 2025

## **ADDENDUM NO. A-3**

This addendum is issued as a supplement to the plans and specifications and shall be considered an integral part of the same. Acknowledgement of receipt of this addendum is required on the Bid Form.

Item: A-3.1

**Location:** Drawing Sheets A12.03 and A12.04

**Description:** CLARIFICATION – Add Rubber Wall Base (RB-1) to existing walls bounding polished concrete

floor areas with floor graphics of UNITS H, J, and K, including the mid-landings of the stair is the

four corners of the arena in UNIT H.

Item: A-3.2


Location: Drawing Sheet A12.02


Description: CLARIFICATION - Provide Rubber Wall Base (RB—1) in the entry vestibules of UNIT J as noted

on Sheet A12.02.


## **EXHIBITS**


Sheet A12.03 Sheet A12.04

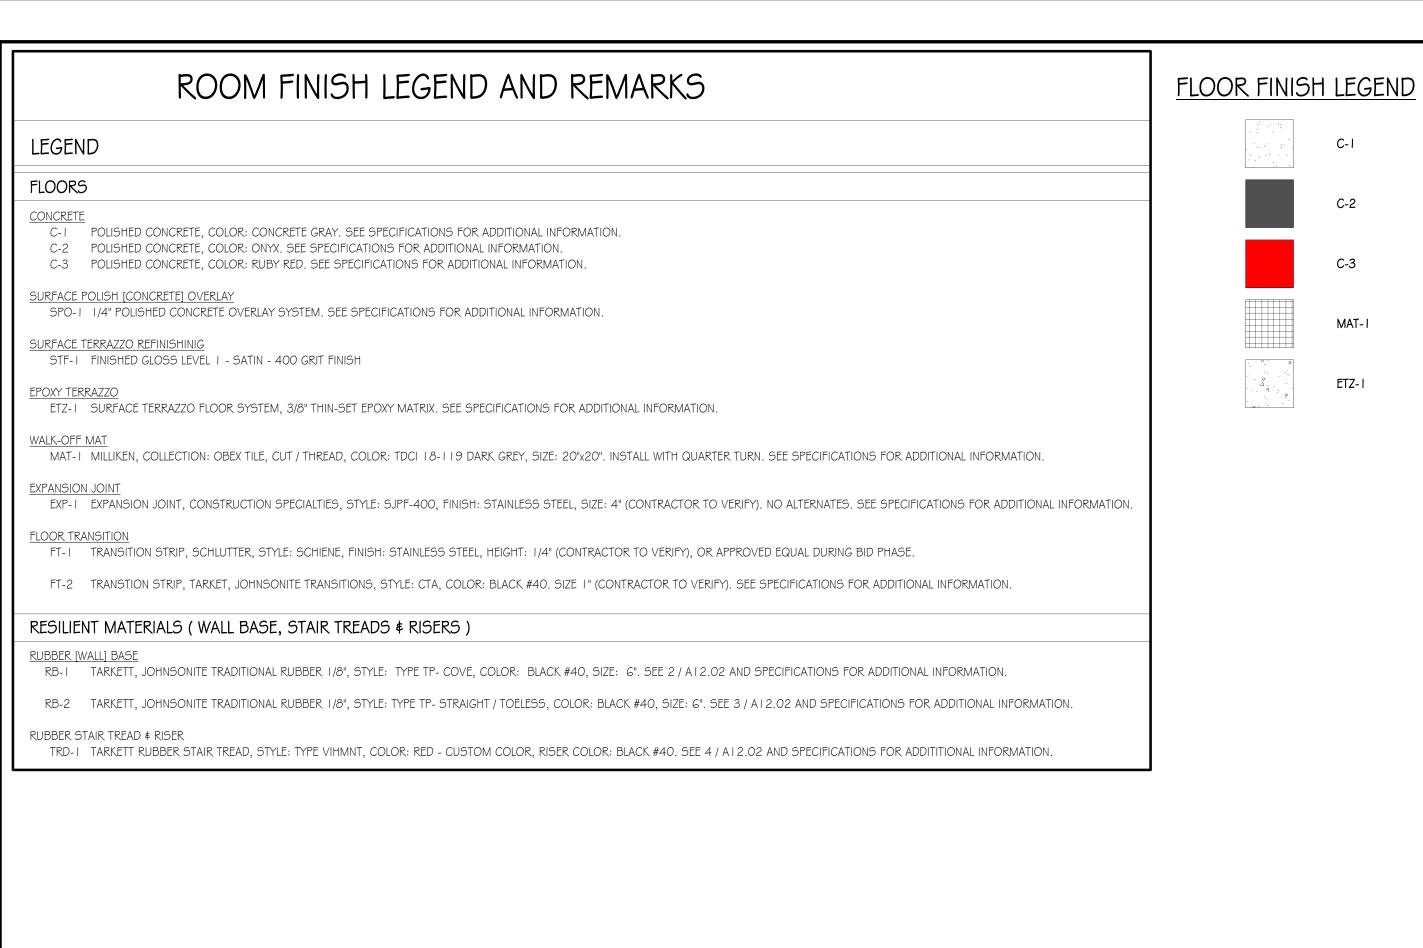

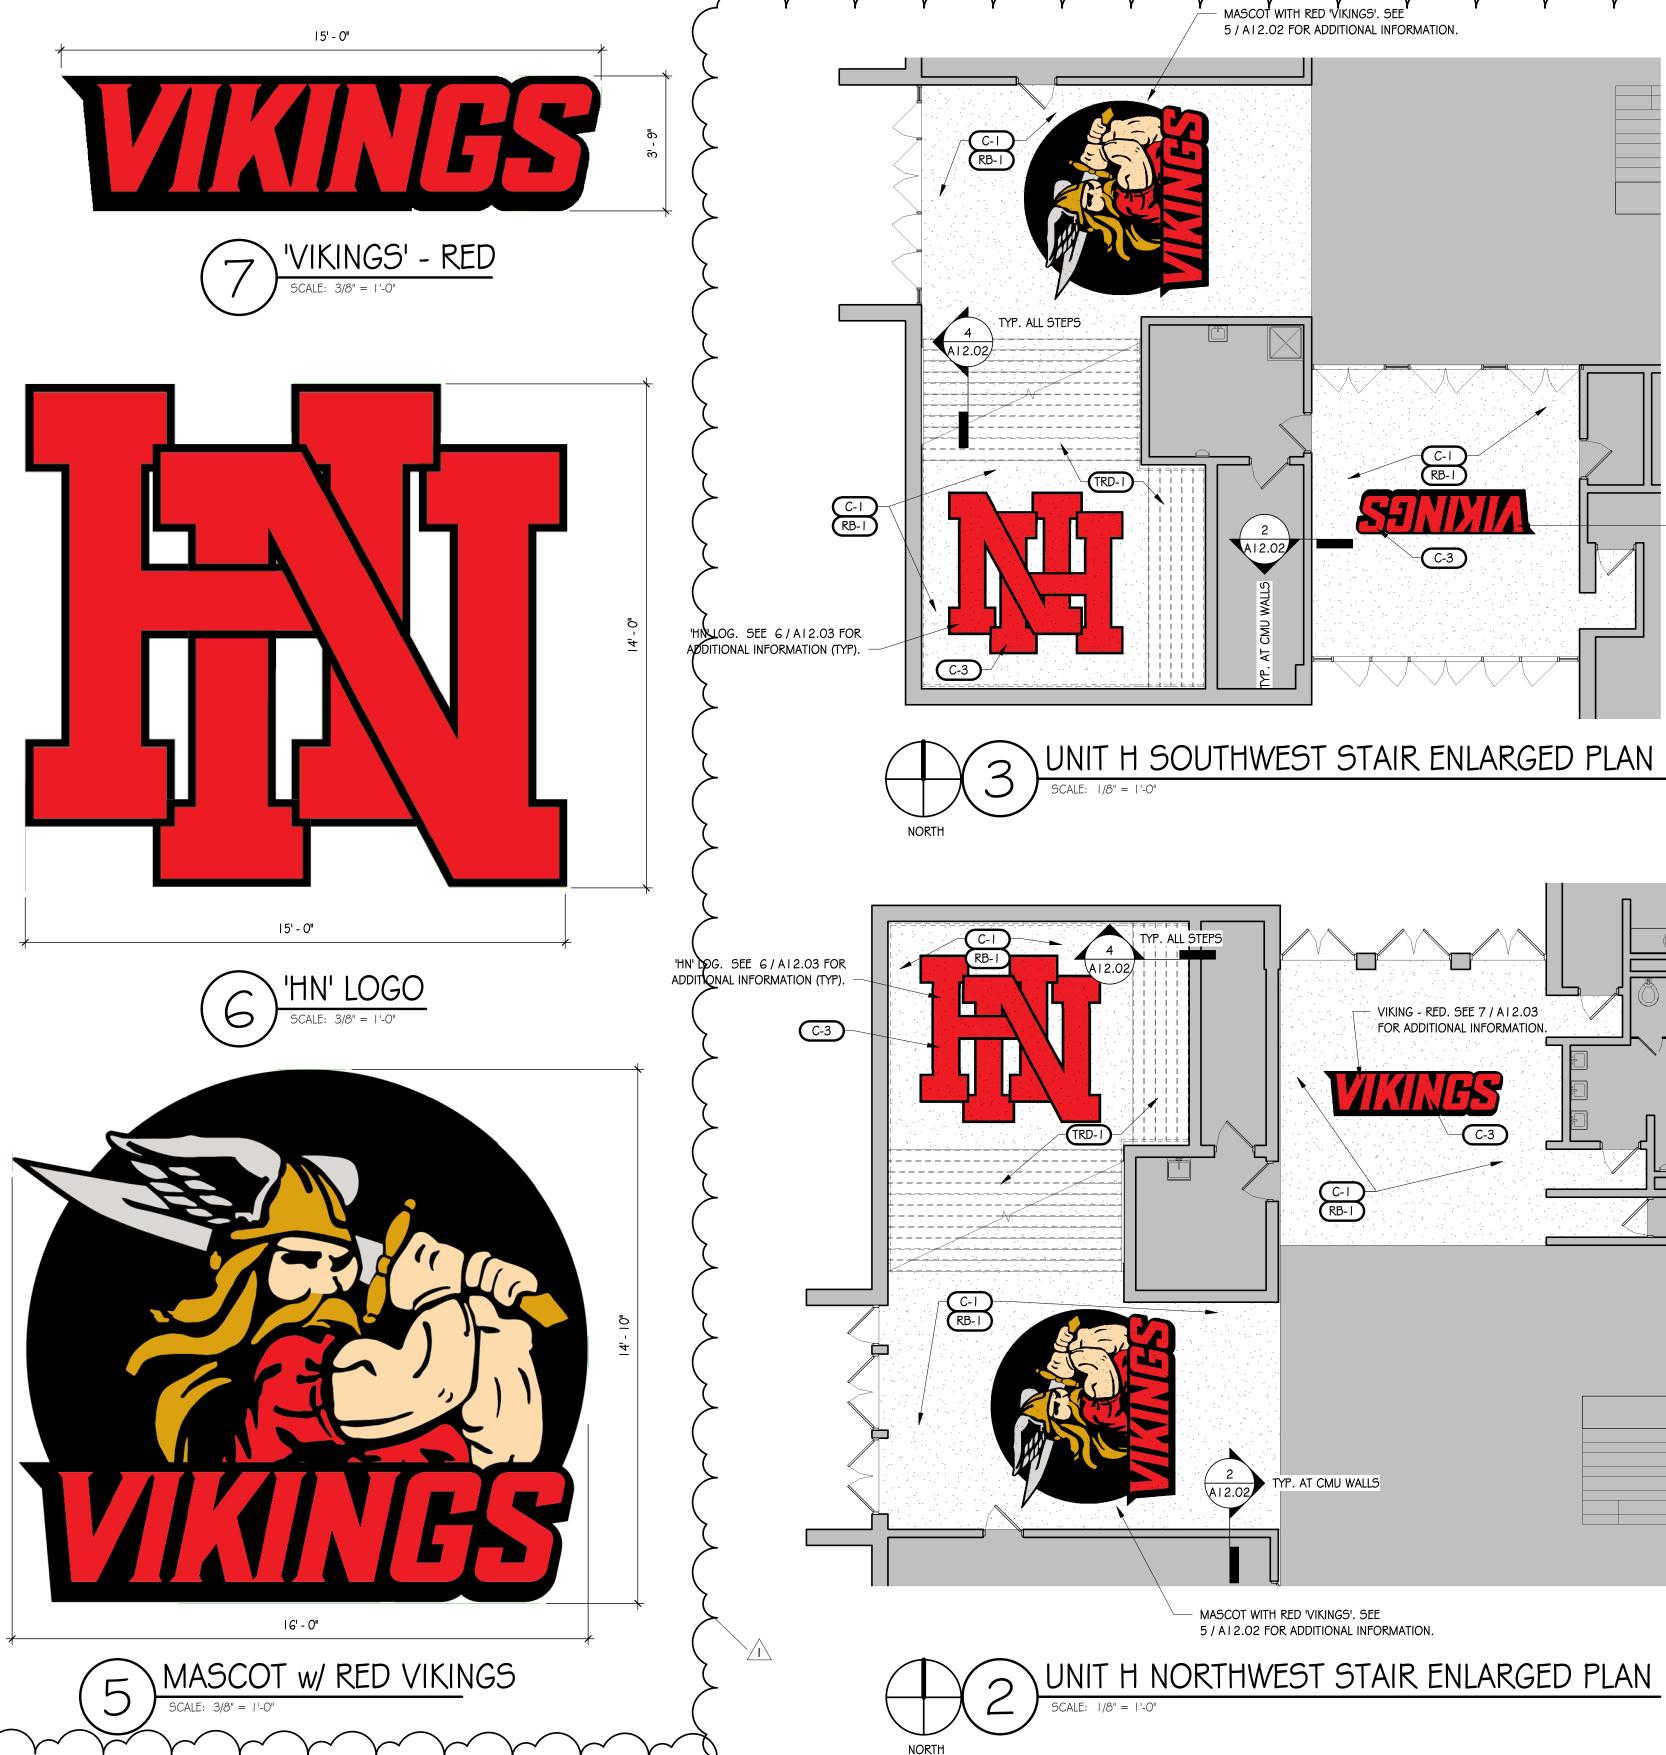



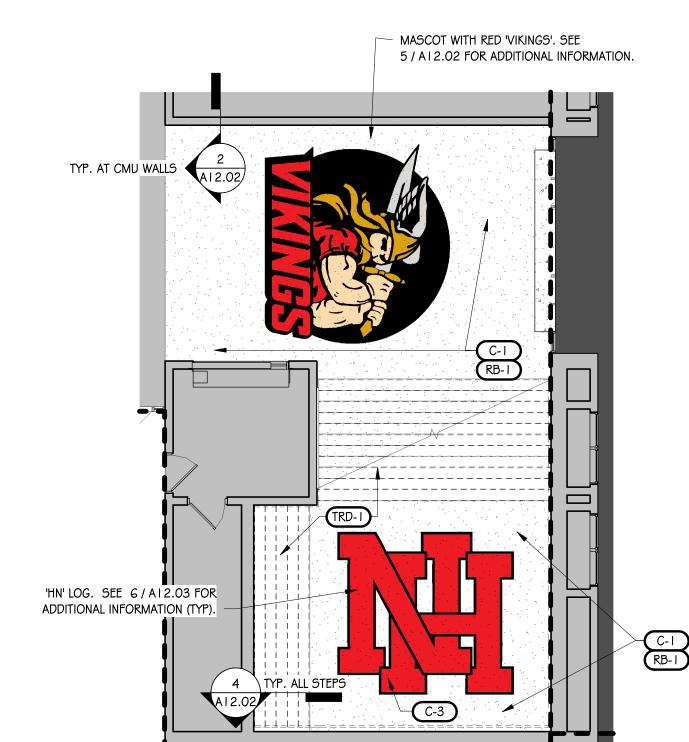

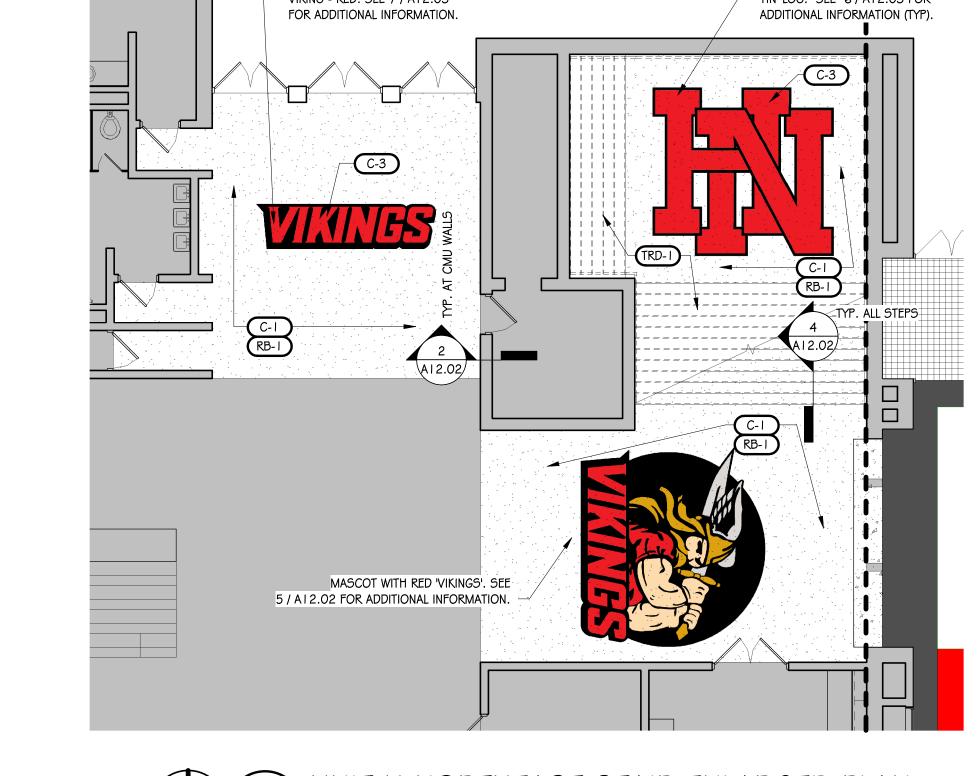

- 'HN' LOG. SEE 6/A12.03 FOR ADDITIONAL INFORMATION (TYP). VIKING - RED. SEE 7 / A I 2.03 FOR ADDITIONAL INFORMATION.

UNIT H NORTHEAST STAIR ENLARGED PLAN




6435 West Jefferson Boulevard

Fort Wayne, Indiana 46804 PH: 260.450.7299 www.viridian-design.net

CERTIFICATION

- VIKING - RED. SEE 7 / A I 2 03 FOR ADDITIONAL INFORMATION

VIKING - RED. SEE 7 / A I 2.03 FOR ADDITIONAL INFORMATION.

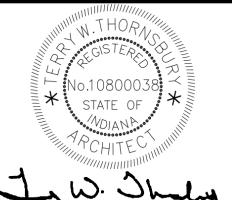

on this document are the sole property of Viridian Architectural Design, Inc. and shall not be used for any purpose without prior expressed written consent. The Owner shall be permitted to retain copies for information and reference.


REVISION DATE DESCRIPTION 04/1*8*/2025 ADD RB-1

PROJECT 04/04/2025 2025.0001

UNIT H ENLARGED PLANS

A12.03



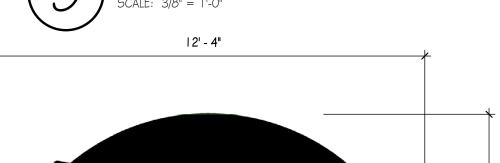


8 MASCOT w/o TEXT

SCALE: 3/8" = 1'-0"

CONTRACTOR TO COORDINATE ALL FONT STYLES WITH ARCHTECT PRIOR TO SHOP DRAWINGS / SUBMITTAL PROCESS.

UNIT H SOUTHEAST STAIR ENLARGED PLAN

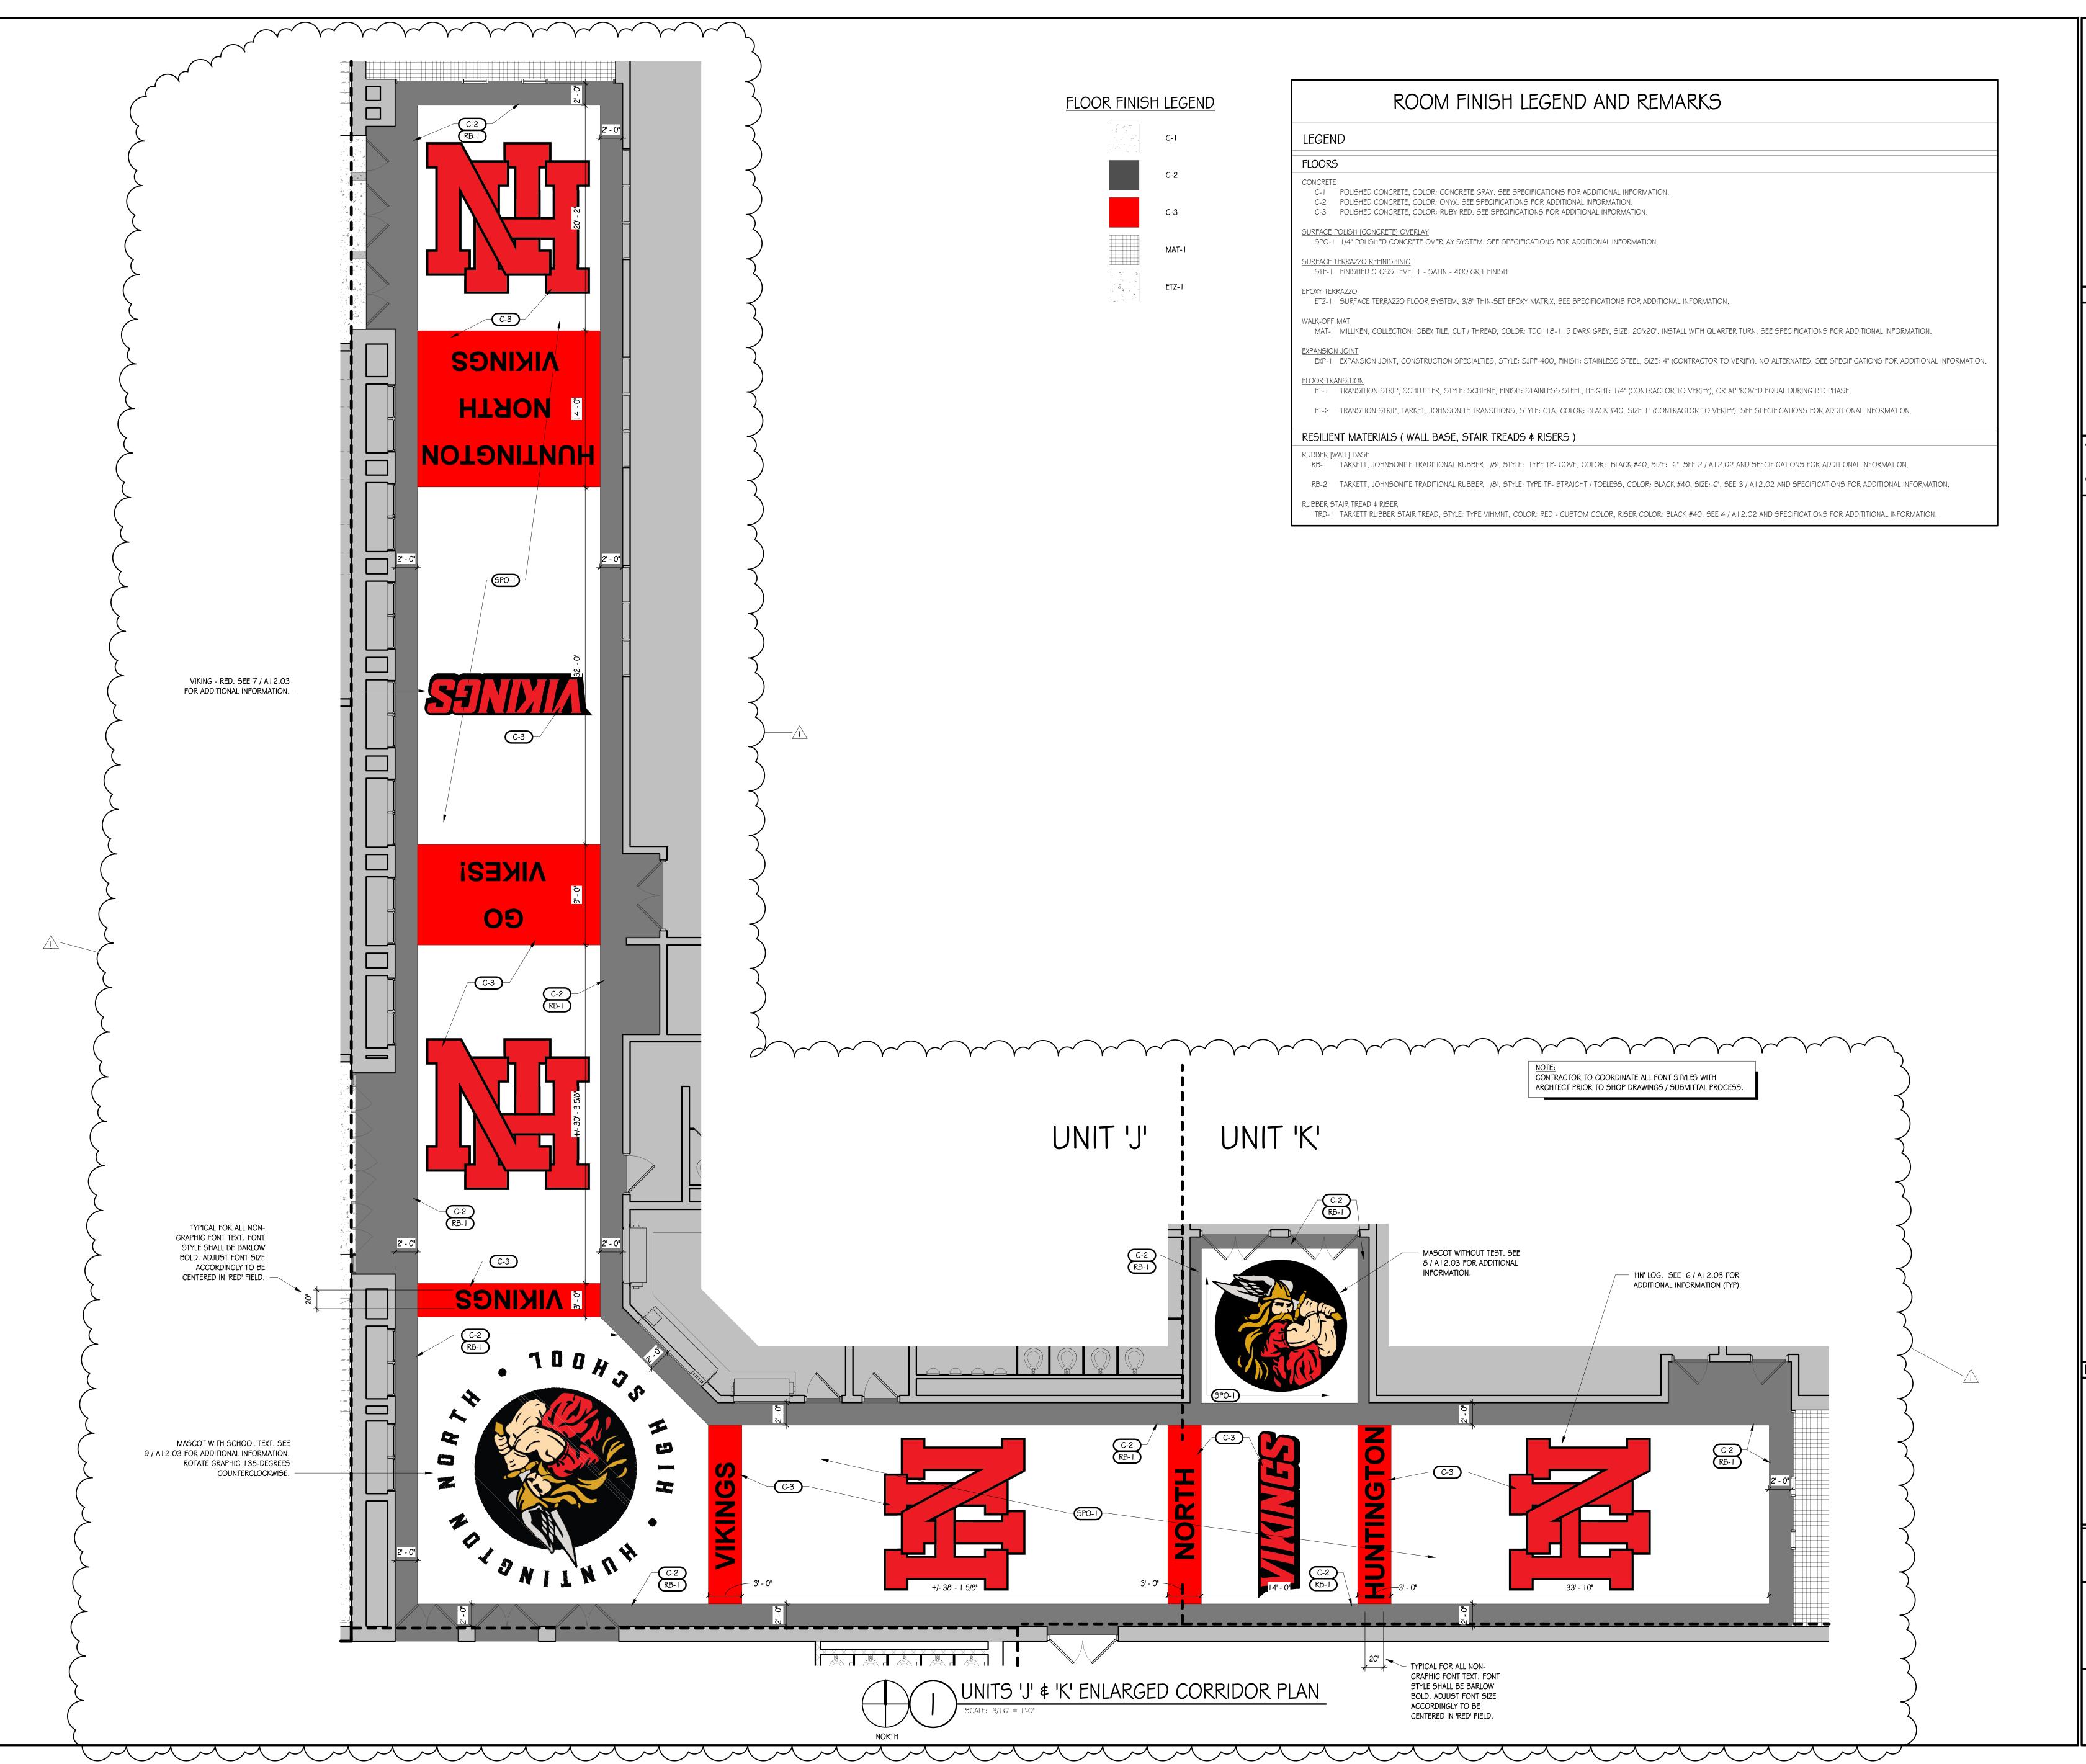



6435 West Jefferson Boulevard

Fort Wayne, Indiana 46804 PH: 260.450.7299 www.viridian-design.net

CERTIFICATION



In W. Shely

on this document are the sole property of Viridian Architectural Design, Inc. and shall not be used for any purpose without prior expressed written consent. The Owner shall be permitted to retain copies for information and reference.

## HNHS - FLOORING RESTORATION

REVISION DATE DESCRIPTION

1 04/18/2025 ADD RB-1

DATE

04/04/2025

2025 2025.0001

PROJECT

UNITS J & K CORRIDOR ENLARGED PLAN

— SHEET —

A12.04