

### June 5, 2025

# ADDENDUM 2

TO THE DRAWINGS, SPECIFICATIONS AND CONTRACT DOCUMENTS FOR:

## Falmouth Head Start Center

## 67 KLEE WAY, FALMOUTH, KY 41040

### Comm. No. 2023108.01

### TO ALL BIDDERS:

This Addendum supplements, amends and takes precedence over the original Drawings and Specifications, and shall be taken into account when preparing proposals, and shall become part of the Contract Documents. Receipt of this Addendum must be entered on the bidder's Bid Form. Bidder is cautioned to read the entire addendum and to check that all pages of the Addendum have been included in the Bidder's copy of the Addendum.

### **DRAWINGS**

### <u> ITEM 1 – S101:</u>

Footing elevations have been modified to accommodate civil grading plan.


### ITEM 2 - S201:

Additional header designations have been added for windows not specified in permit issuance. Corrections made to skylight coordination note.

#### ITEM 3 - S301:

Anchorage for "TYPICAL SHEAR WALL DETAIL" has been modified to be 5/8" threaded rods cast into masonry stem walls. Truss hold downs have been modified to "Simpson H10A" instead of "Simpson H3".

### End of Addendum 2 items – See attachments.

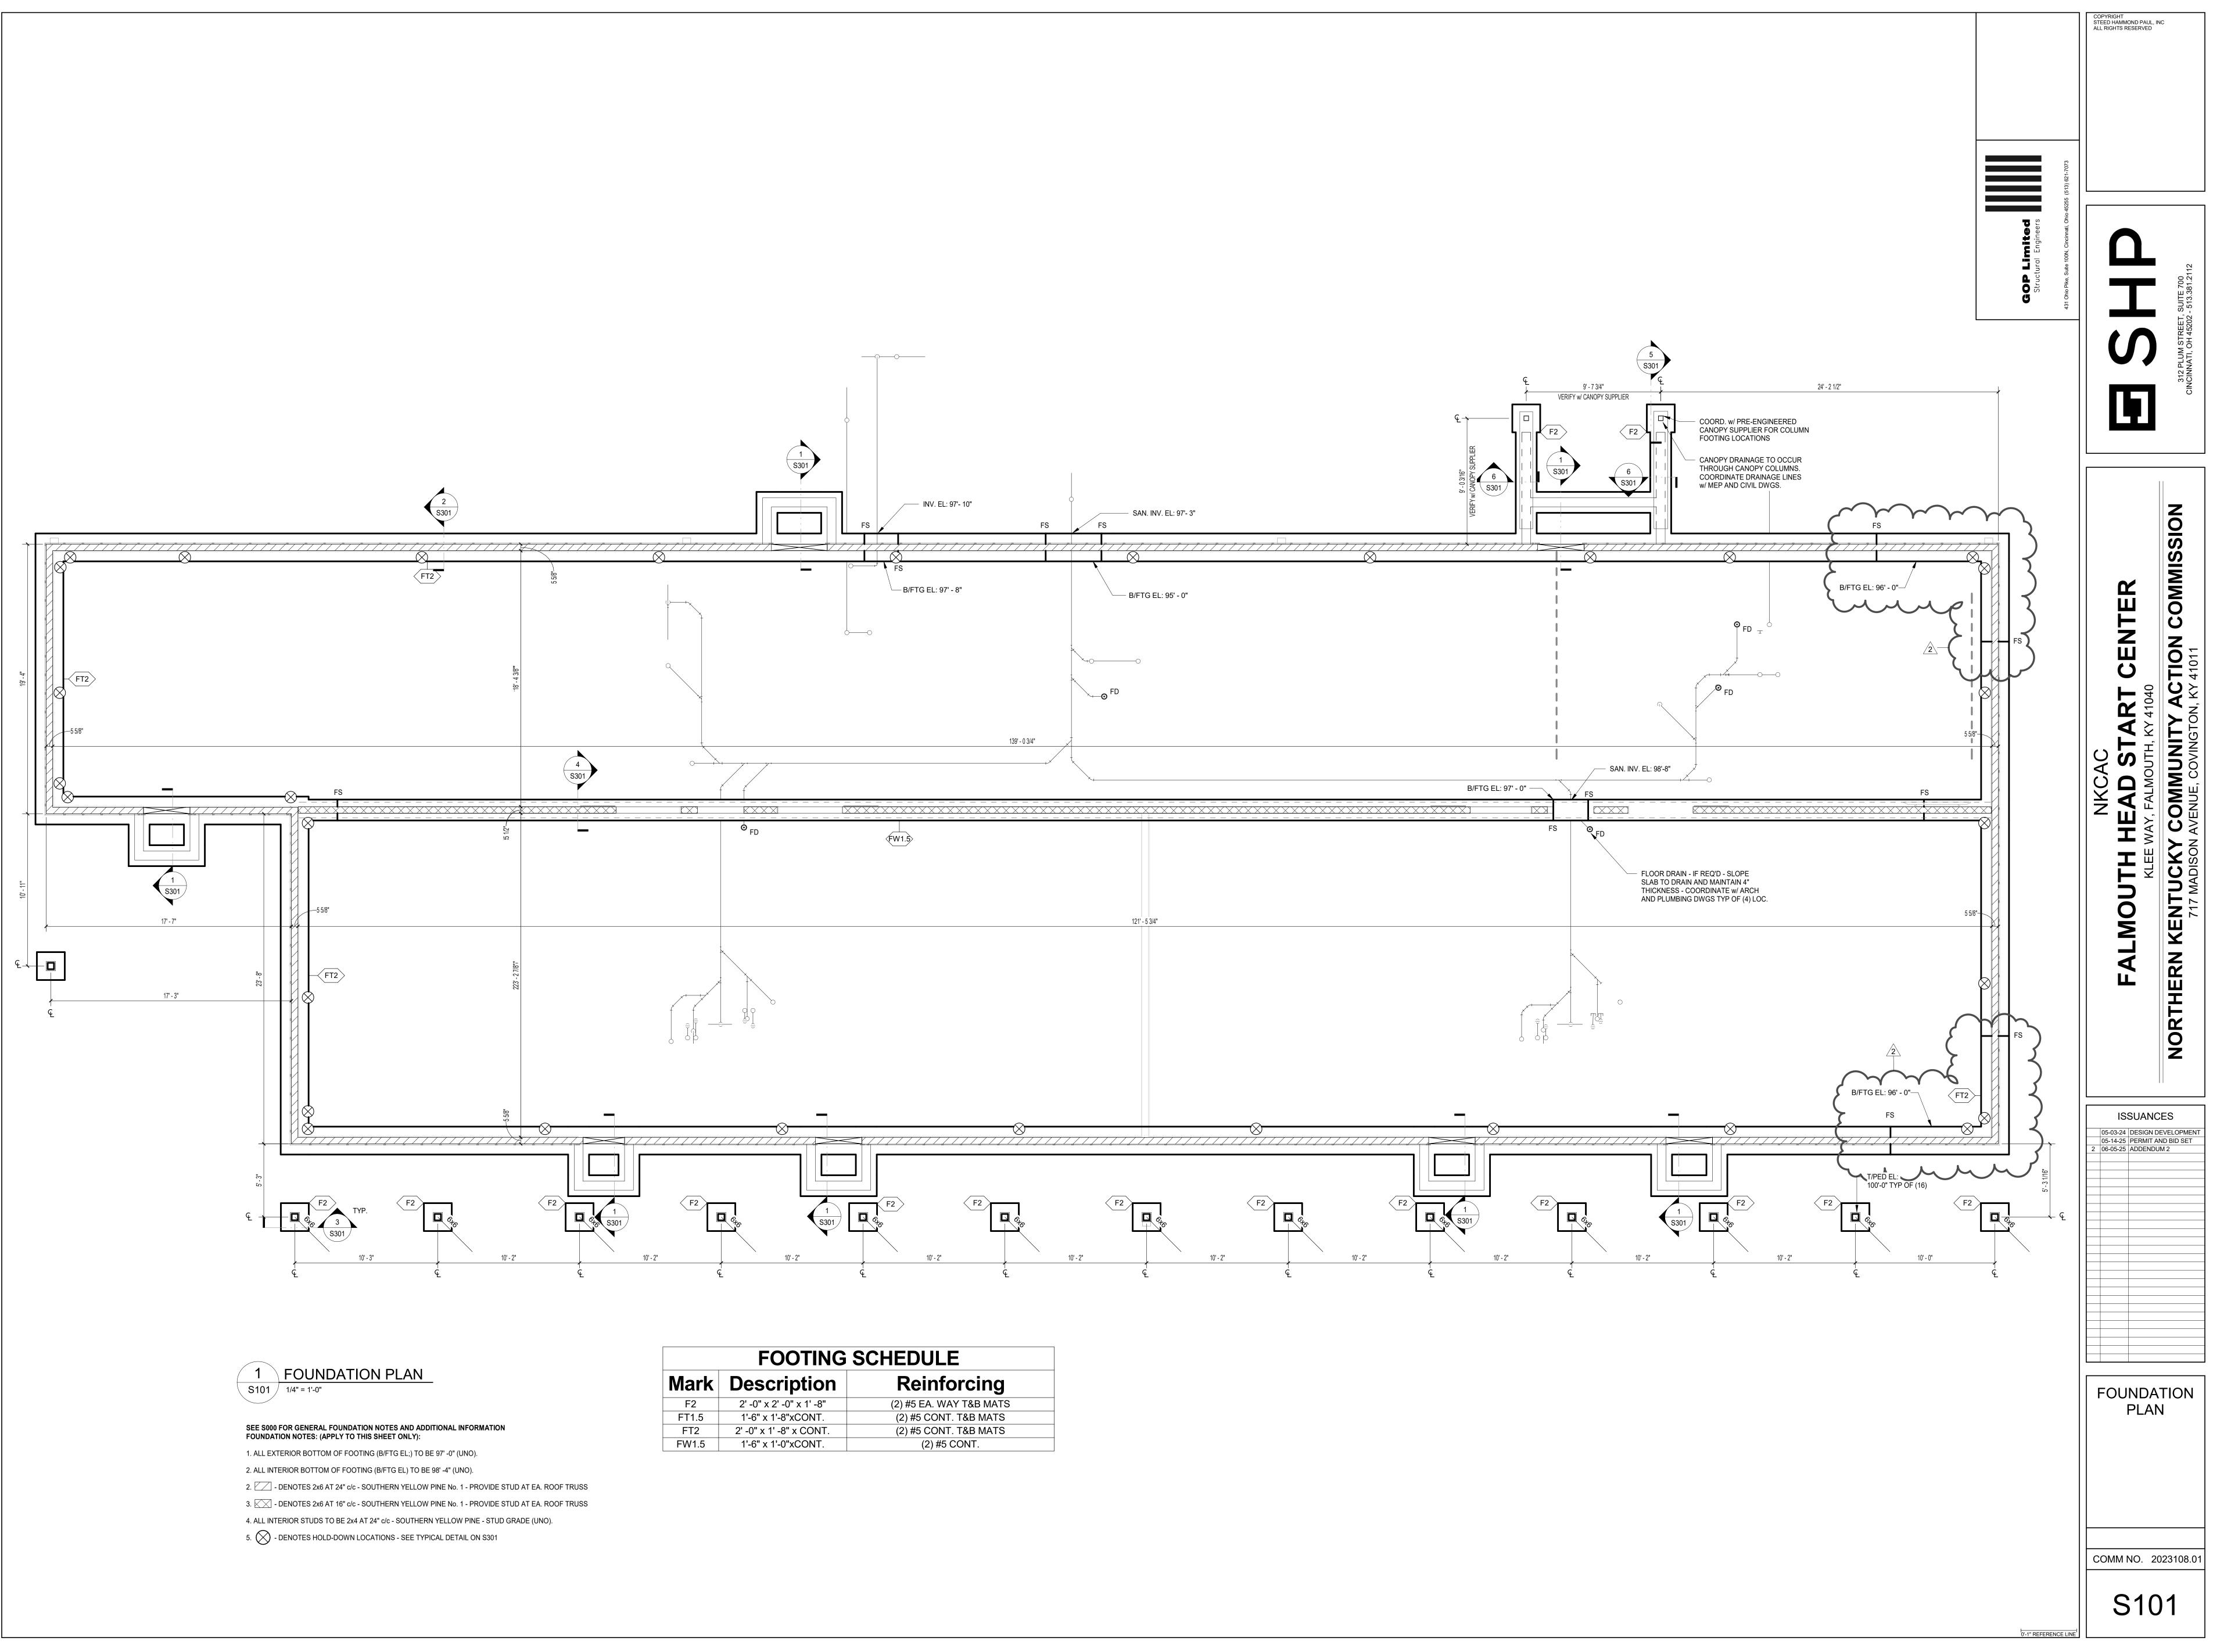

wark	Description	Reinforcing
F2	2' -0" x 2' -0" x 1' -8"	(2) #5 EA. WAY T&B MATS
FT1.5	1'-6" x 1'-8"xCONT.	(2) #5 CONT. T&B MATS
FT2	2' -0" x 1' -8" x CONT.	(2) #5 CONT. T&B MATS
FW1.5	1'-6" x 1'-0"xCONT.	(2) #5 CONT.

