

SECTION 009111 - ADDENDUM NUMBER 3

PARTICULARS

- 1.1 **DATE: FEBRUARY 5, 2026**
- 1.2 **PROJECT: SHERIDAN PUBLIC LIBRARY BUILDING ADDITION, RENOVATIONS & SITE IMPROVEMENTS:**
- 1.3 **PROJECT NUMBER: 25050**
- 1.4 **OWNER: SHERIDAN PUBLIC LIBRARY, 103 W 1ST STREET, SHERIDAN, IN 46069**
- 1.5 **ARCHITECT: ODLE MCGUIRE SHOOK MATTHEW R. MAYOL #IN19900090**



Matthew R. Mayol

TO: PROSPECTIVE BIDDERS:

- 2.1 **THIS ADDENDUM FORMS A PART OF THE CONTRACT DOCUMENTS AND MODIFIES THE ORIGINAL PROCUREMENT DOCUMENTS DATED JANUARY 15, 2026, WITH AMENDMENTS AND ADDITIONS NOTED BELOW.**
- 2.2 **ACKNOWLEDGE RECEIPT OF THIS ADDENDUM IN THE SPACE PROVIDED IN THE BID FORM. FAILURE TO DO SO MAY DISQUALIFY THE BIDDER.**
- 2.3 **THIS ADDENDUM CONSISTS OF 3 PAGES AND THE FOLLOWING DRAWINGS: G001, G005, ADD3-L1-L101, NEW PERGOLA ADD-3, A002, A101, A103, A202, A401, A501 AND AI101, INTERIOR SIGNAGE SCHEDULE, MOVE PHASING PLANS A, B1, B2, C, D & E.**
- 2.4 **GENERAL:**
 - A. Bidder Questions:
 1. Q: Can Unit Price No. 1: Level five (5) finish on existing drywall where previous wall surface was removed be provided per square foot?
 - a. A: Delete this Unit Price in it's entirety as per this Addendum. Any costs associated with this type of work will be handled by Allowance No. 2.
 2. Q: Please confirm the scale is correct on the Dumpster Pad Detail?
 - a. A: Please see Drawing ADD1-L1
 3. Q: What size if the roof of the Pergola Alternate?
 - a. A: See attached drawing PERGOLA ADD-3 shows roof basis of design to intended to be 8'-0" square.

4. Q: Can you provide more detail about the Owner Provided Movers?
 - a. A: See attached Sheridan Move Phasing Drawings. Note: These Drawings are based upon the G005 PHASING PLAN but will be finalized once the General Contractor submits a Project Construction Schedule at the Pre-Construction Meeting.
5. Q: Can you provide a interior sign schedule and more detail on the Dedication Plaque?
 - a. A: Yes, see Interior Sign Schedule in the Addendum and a Dedication Plaque Detail has been added.

3.1 CHANGES TO PRIOR ADDENDA: NONE

CHANGES TO THE PROJECT MANUAL - SPECIFICATIONS:

4.1 SECTION 004113 - CONTRACTORS BID FOR PUBLIC WORKS

- A. Replace this document in it's entirety which deletes Unit Price No. 1

CHANGES TO DRAWINGS:

5.1 G001 CODE SUMMARY & LIFE SAFETY PLAN

- A. Vestibule 109
 1. Removed Occupant Load Sign (OLS)
 2. Changed location of Exit Sign
- B. Vestibule 100 - Changed location of exit sign
- C. Reception 102 - Added Exit Sign
- D. Main Street 110 - added exist sign

5.2 G005 PHASING PLAN & CONSTRUCTION SIGN

- A. Added Detail 5, Construction Job

5.3 L101 SITE DETAILS

- A. Detail 1 - Change scale of drawing from 1/8" = 1'-0" to 1/4" = 1'-0" per attached Drawing ADD3.L1

5.4 A002 GENERAL INFORMATION

- A. Drawing 1, Room Signage Details – Added sign type “P” and “Q”
- B. Added Occupant Load Signage Drawing to sheet
- C. Added Tactile Exit Signage Drawing to sheet
- D. Added Dedication Plaque Drawing to sheet

5.5 A101 FIRST FLOOR PLAN

- A. Study 131 – Change ‘SF-1’ tag to ‘BL1’

5.6 A103 ROOF PLAN & DETAILS

- A. Drawing 6, Elev. New Roof – Change 4” gutters to 6” gutters
- B. Drawing 7, Soffit Detail – Change 4” gutter to 6” gutter

5.7 A202 INTERIOR ELEVATIONS, ENLARGED PLAN, APPILANCE SCHEDULE & DETAILS

- A. Drawing 9, Pocket Door Elevation – Added note: “Match existing door pull and hardware finish”
- B. Drawing 4, Elev. Study Window – Changed tag from “SF1” to “BL1”

5.8 A401 WALL SECTIONS

- A. Drawing 1, Wall Section – Change Note: “12” CMU Foundation wall” to “Ref. ‘E’ series Dwgs”
- B. Drawing 3, Wall Section – Add “Ref ” series Dwgs” to note that reads: “18”w x 36”d grade beam w/ 2 #5 bars top and bottom. 1 course 9” I block w/ vert. ties @48” o.c.”

5.9 A501 OPENING SCHEDULES, ELEVATIONS & DETAILS


- A. Drawing 1
 - 1. Changed drawing name from ‘SF1” to “BL1”
 - 2. Changed Storefront System to Hollow Metal
- B. Changed Storefront System to Hollow Metal
- C. H5 – Changed detail to Hollow MetalJ5 – Changed detail to Hollow Metal
- D. J5 – Changed detail to Hollow Metal

5.10 AI101 FIRST FLOOR FINISH PLAN

- A. T. 117 – Change LVT-2 to ETR on floor transition.

END OF SECTION


OCCUPANCY LOAD SIGNAGE

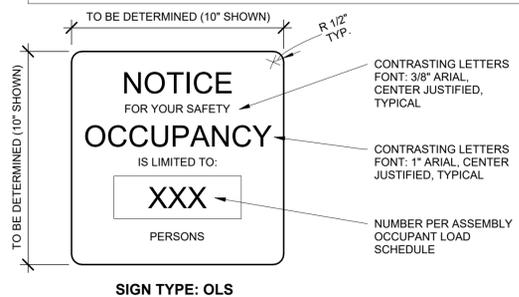

SIGN TYPE: OLS

- NOTES**
1. PROVIDE "OCCUPANCY" SIGNAGE AS INDICATED ABOVE IN EACH ASSEMBLY OCCUPANCY WITHIN THE BUILDING.
 2. COORDINATE LOCATION, SIZE, AND QUANTITY OF SIGNS WITH LOCAL BUILDING / FIRE OFFICIALS.
 3. COORDINATE SIGN MATERIAL W/ OWNER.


TACTILE EXIT SIGNAGE

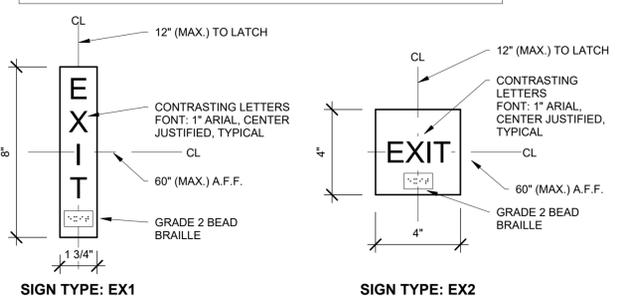

SIGN TYPE: EX1

SIGN TYPE: EX2

- NOTES**
1. TACTILE EXIT SIGNAGE REQUIRED BY IBC SEC. 1011.4 AND COMPLY W/ ICC A117.1. UTILIZING EITHER STYLE OF SIGN AS SHOWN ABOVE.
 2. POST SIGN ADJACENT TO EACH DOOR TO AN EGRESS STAIRWAY, AN EXIT PASSAGEWAY AND THE EXIT DISCHARGE, MOUNTED 60" A.F.F. (MAX) TO CENTERLINE OF SIGN; AND 12" (MAX.) FROM LATCH TO CENTERLINE OF SIGN.
 3. COORDINATE LOCATION OF SIGNS W/ OWNER.

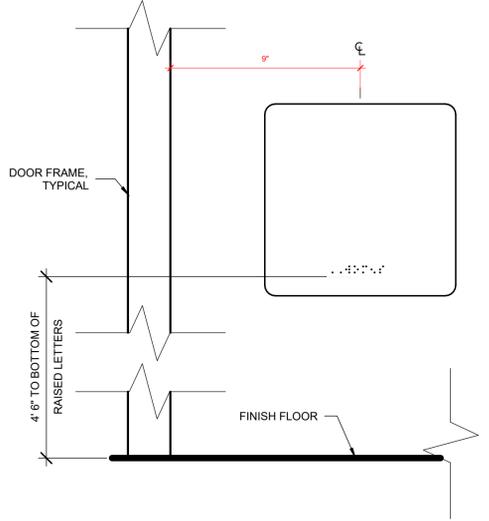

LIFE SAFETY LEGEND

- OCCUPANCY TYPE A-3 (LIBRARY)
- FIRE AREA 1
- FIRE AREA 2
- EXIT PATH ORIGIN
- EXIT ACCESS TRAVEL DISTANCE (IBC TABLE 1016.2)
- COMMON PATH EGRESS TRAVEL DISTANCE (IBC 1014.3)
- EXIT DISCHARGE
- 1-HR FIRE RATED CONSTRUCTION
- 2-HR FIRE RATED CONSTRUCTION
- F.E. INDICATES WALL HUNG PORTABLE FIRE EXTINGUISHER TO COMPLY WITH NFPA 10. MAX 75' TRAVEL DISTANCE. MULTIPURPOSE DRY CHEMICAL TYPE 2-A: 10LB IN ENAMELED STEEL CONTAINER U.N.O. J.L INDUSTRIES OR APPROVED EQUAL.
- F.E.C. INDICATES FULLY RECESSED FIRE EXTINGUISHER CABINET U.L. AND LABELED TO MEET ASTM E814 FOR FIRE RESISTANCE RATING OF WALL WHERE INSTALLED. GLAZING: TEMPERED BREAK GLASS ASTM C1048. PROVIDE MFG STD. DOOR OPERATING HARDWARE WITH LOCK. PROVIDE BRACKETS AND DRY CHEMICAL TYPE 2-A: 10LB U.N.O. VINYL LETTERS, RED, TO READ: "FIRE EXTINGUISHER" APPLIED TO DOOR. STEEL FINISH: MFG STD COLORS U.N.O. J.L. INDUSTRIES, INC OR APPROVED EQUAL.
- TACTILE EXIT SIGN
- OCCUPANT LOAD SIGN

NAME OF PROJECT: SHERIDAN PUBLIC LIBRARY BUILDING ADDITION, RENOVATIONS AND SITE IMPROVEMENTS.				
PROJECT ADDRESS: 103 WEST 1ST STREET, SHERIDAN, INDIANA 46069				
APPLICABLE CODES:				
2014 INDIANA BUILDING CODE (2012 INTL BUILDING CODE W/ AMENDMENTS)				
2014 INDIANA FIRE CODE (2012 INTL FIRE CODE W/ AMENDMENTS)				
2012 INDIANA PLUMBING CODE (2006 INTL PLUMBING CODE W/ AMENDMENTS)				
2014 INDIANA MECHANICAL CODE (2012 INTL MECHANICAL CODE W/ AMENDMENTS)				
2014 INDIANA FUEL GAS CODE				
2009 INDIANA ELECTRICAL CODE (2008 NATIONAL ELECTRICAL CODE W/ AMENDMENTS)				
2010 INDIANA ENERGY CONSERVATION CODE (ASHRAE 90.1-2007 W/ AMENDMENTS)				
2014 INDIANA HANICAP ACCESSIBILITY CODE (2012 INTL BUILDING CODE, CHAPTER 11, W/ AMENDMENTS AND ICCIANSI A117.1-2009) IN ADDITION TO THE ADA ACCESSIBILITY GUIDELINES FOR BUILDINGS AND FACILITIES				
PROJECT DESCRIPTION: ONE STORY STORAGE ROOM ADDITION, LIBRARY RENOVATION AND SITE IMPROVEMENTS. ADDITIONS AND ALTERATIONS ARE PERMITTED TO AN EXISTING BUILDING WITHOUT REQUIRING THE ENTIRE EXISTING BUILDING OR PORTIONS OF THE EXISTING BUILDING UNAFFECTED BY THE PROPOSED SCOPE OF RENOVATION TO BE BROUGHT INTO COMPLIANCE WITH CURRENT CODES. [RULE 4, SECTION 12, GAR]				
OCCUPANCY, CHAPTERS 3 & 5				
CLASSIFICATION (IBC 303-312)	A-3 (LIBRARY), 'S' STORAGE			
ACCESSORY OCCUPANCIES (IBC 508.2)	NONE			
NONSEPARATED OCCUPANCIES (IBC 508.3)	NONE			
SPECIAL DETAILED REQUIREMENTS BASED ON USE AND OCCUPANCY, CHAPTER 4				
SECTION USED FOR DETAILED REQUIREMENTS OR SPECIAL USES (IBC 401.1)	GENERAL SECTION USED N/A	SUB SECTION USED N/A		
ALLOWABLE BUILDING AREA, CHAPTER 5				
TABULAR AREA (FT ²) (IBC TABLE 503)	ASSEMBLY A-3 (LIBRARY)			
ACTUAL BUILDING AREAS (FT ²)	EXISTING: 15,020	1 STORY		
	NEW: 607			
	REMODEL: 15,627			
	NEW CANOPY: 52			
	TOTAL BUILDING: 15,679 SF	20,125 ALLOWED		
ALLOWABLE BUILDING HEIGHT, CHAPTER 5				
TABULAR HEIGHT (IBC TABLE 503)	A-3; (2 STORIES AND 50 FEET ALLOWED); 1 STORY ACTUAL			
HEIGHT MODIFICATION (IBC 504.2)	EXIST			
SPRINKLER SYSTEM INCREASE	EXIST			
TOTAL BUILDING HEIGHT ALLOWED	EXIST			
ACTUAL BUILDING HEIGHT	30' - 0" EXIST; 1 STORY ACTUAL.			
CONSTRUCTION, CHAPTER 6				
CLASSIFICATION (IBC 602.1)	TYPE: V-A EXISTING			
CONSTRUCTION RESTRICTIONS, CHAPTER 6				
FIRE RATING REQUIREMENTS FOR BUILDING ELEMENTS (IBC TABLE 601 & TABLE 602)	BEARING WALLS, FLOORS, AND ROOF ARE REQUIRED TO BE A MINIMUM OF 1-HR COMBUSTIBLE CONSTRUCTION.			
	NONBEARING EXTERIOR WALLS PERMITTED TO BE NON-RATED BASED UPON HAVING A FIRE SEPARATION DISTANCE OF 30 FEET OR MORE.			
FIRE-RESISTANCE-RATED CONSTRUCTION, CHAPTER 7				
RATED EXTERIOR WALL CONSTRUCTION (IBC SECTION 705.5 & TABLES 701 & 702)	RATING PER CONSTRUCTION TYPE: EXIST			
	FIRE SEPARATION DISTANCE: EXIST			
	EXTERIOR FIRE SEPARATION RATING: EXIST			
ALLOWABLE AREA OF UNPROTECTED OPENINGS (IBC TABLE 705.8)				
INTERIOR FINISHES, CHAPTER 8				
INTERIOR WALL AND CEILING FINISH REQUIREMENTS (IBC TABLE 803.9)	SEE ROOM FINISH SCHEDULE FOR FLAME SPREAD CLASSES			
FIRE PROTECTION SYSTEMS, CHAPTER 9				
PORTABLE FIRE EXTINGUISHERS (IBC SECTION 906 & IFC TABLE 906.1)	REQUIRED (REF. LIFE SAFETY PLAN)			
AUTOMATIC SPRINKLER SYSTEM, CHAPTER 9				
SPRINKLER SYSTEM REQ. (IBC 903)	NO, NFPA 13 ELECTRICALLY SUPERVISED FIRE ALARM SYSTEM			
SPRINKLER SYSTEM PROVIDED (IBC 907.2.1)	NO, NFPA 13 ELECTRICALLY SUPERVISED FIRE ALARM SYSTEM.			
	A FIRE ALARM SYSTEM NOT REQUIRED FOR ASSEMBLY BUILDINGS HAVING AN OCCUPANT LOAD OF LESS THAN 300.			
	SMOKE DETECTORS ARE REQUIRED FOR SHUTDOWN OF NEW HVAC SYSTEMS DELIVERING IN EXCESS OF 2,000 CFM; PROVIDED [606, IMC]			
BUILDING OCCUPANT LOAD, CHAPTER 10				
OCCUPANT LOAD FACTOR (IBC TABLE 1004.1.2)	LIBRARY 100 SF GROSS/OCCUPANT			
	ASSEMBLY 15 SF GROSS/OCCUPANT			
	STORAGE 300 SF GROSS/OCCUPANT			
DESIGN OCCUPANT LOAD (IBC 1004.1)	LIBRARY 13,975 SF / 100 = 141			
	ASSEMBLY 1,148 SF / 15 = 77			
	STORAGE 607 SF / 300 = 3			
	TOTAL BUILDING: 221			
BUILDING EGRESS, CHAPTER 10				
MINIMUM EGRESS WIDTH FACTORS NON-SPRINKLERED	0.2' PER OCCUPANT			
MINIMUM BUILDING EGRESS WIDTH	TOTAL BUILDING: MIN. EXIT WIDTH 221 x 0.2 = 44.2"			
	MIN. NO. EXITS 44.2' / 32' = 1.38 = 2 EXITS			
NUMBER OF BUILDING EXITS BASED ON WIDTH (IBC 1005.3) (MIN. DOOR CLEAR WIDTH = 32") (IBC 1005.3)	TOTAL BUILDING: 44.2' / 32' = 1.38 = 2 EXITS			
ALLOWABLE EXIT ACCESS TRAVEL DISTANCE (IBC TABLE 1016.2) (IBC 1005.3)	A-3 LIBRARY 200' MAX	EXIST		
MINIMUM NUMBER OF BUILDING EXITS BASED ON OCCUPANT LOAD	TOTAL BUILDING: EXIST			
BUILDING EGRESS WIDTH & NUMBER OF BUILDING EXITS PROVIDED (MIN. DOOR CLEAR WIDTH = 32") (IBC 1021)	TOTAL BUILDING: NO. EXITS 2 EXITS @ 72"	EGRESS WIDTH 144" COMPLIES		
SPACE EGRESS, CHAPTER 10				
ROOMS REQUIRING MORE THAN ONE EXIT BASED ON OCCUPANT LOAD (IBC TABLE 1015.1, & SECTION 1021)	ALL SPACES REQUIRE ONE EXIT EXCEPT.			
	ROOM NUMBERS: COMMUNITY MEETING ROOM 126	OCCUPANCY A-3		
		NO. OCCUPANTS 77		
		2 EXITS EXIST.		
CORRIDOR CONSTRUCTION (IBC TABLE 1018.1)	EXIST.			
MINIMUM CORRIDOR WIDTH (IBC TABLE 1018.2)	36" (OCCUPANCY CAPACITY OF 50 OR LESS)	NO. EXITS 2		
MAXIMUM DEAD END CORRIDOR LENGTH (IBC TABLE 1018.4)	200' MAX. (A-3 OCCUPANCY, NON-SPRINKLERED) (TYPE V-A CONSTRUCTION)			
PLUMBING SYSTEMS, CHAPTER 29				
PLUMBING FIXTURE REQUIREMENTS (IBC 2902.1)				
CLASSIFICATION & CALCULATION: LIBRARY (A-3) OCCUPANTS x 50% = MEN & WOMEN				
FIXTURE	TYPE	REQ. (ROUND UP)	CALCULATION	PROPOSED
WATER CLOSETS / URINALS	MALE	EXIST	EXIST	NA
	FEMALE	EXIST	EXIST	NA
	FAMILY	-	-	NA
	MALE	EXIST	EXIST	NA
	FEMALE	EXIST	EXIST	NA
	FAMILY	-	-	NA
DRINKING FOUNTAINS	FAMILY	EXIST	EXIST	NA
OTHER	-	-	-	NA
NOTES:				
1.	THE EXISTING FIRE ALARM SYSTEM COMPLIES WITH THE APPLICABLE REQUIREMENTS OF NFPA 13.			
2.	THE SEPARATION OF THE DOORS IN COMMUNITY MEETING ROOM 126 EXCEEDS ONE-THIRD OF THE LENGTH OF THE MAX OVERALL DIMENSION.			
3.	REF. ROOF PLAN FOR MINIMUM ROOF UPLIFT REQUIREMENTS.			

Odle McGuire Shook
ARCHITECTURE INTERIOR DESIGN
LANDSCAPE ARCHITECTURE ENGINEERING
"A history of forward thinking..."

www.omscorp.net

7222 N Shadeland Avenue
Suite 100
Indianapolis, Indiana 46250
317.842.0000
Fax 317.917.0616
oms@omscorp.net

100% CONSTRUCTION DOCUMENTS

Matthew R. Mayol

CERTIFIED

No.	Description	Date
3	ADD-3	02/05/2026

REVISIONS

SHERIDAN PUBLIC LIBRARY BUILDING ADDITION, RENOVATIONS AND SITE IMPROVEMENTS


103 W 1ST ST, SHERIDAN, IN 46069, HAMILTON COUNTY

© Copyright 2026
by OGLE MCGUIRE SHOOK
Copyright includes architectural work, building design, plans or drawings, and specifications. Architectural work is the overall form as well as the arrangement and composition of spaces and elements in the design. Reproduction without written permission is prohibited.

Project number 25050
Date 01.15.26
Drawn by AA
Checked by MRM
Designed by MRM

G001

CODE SUMMARY & LIFE SAFETY PLAN

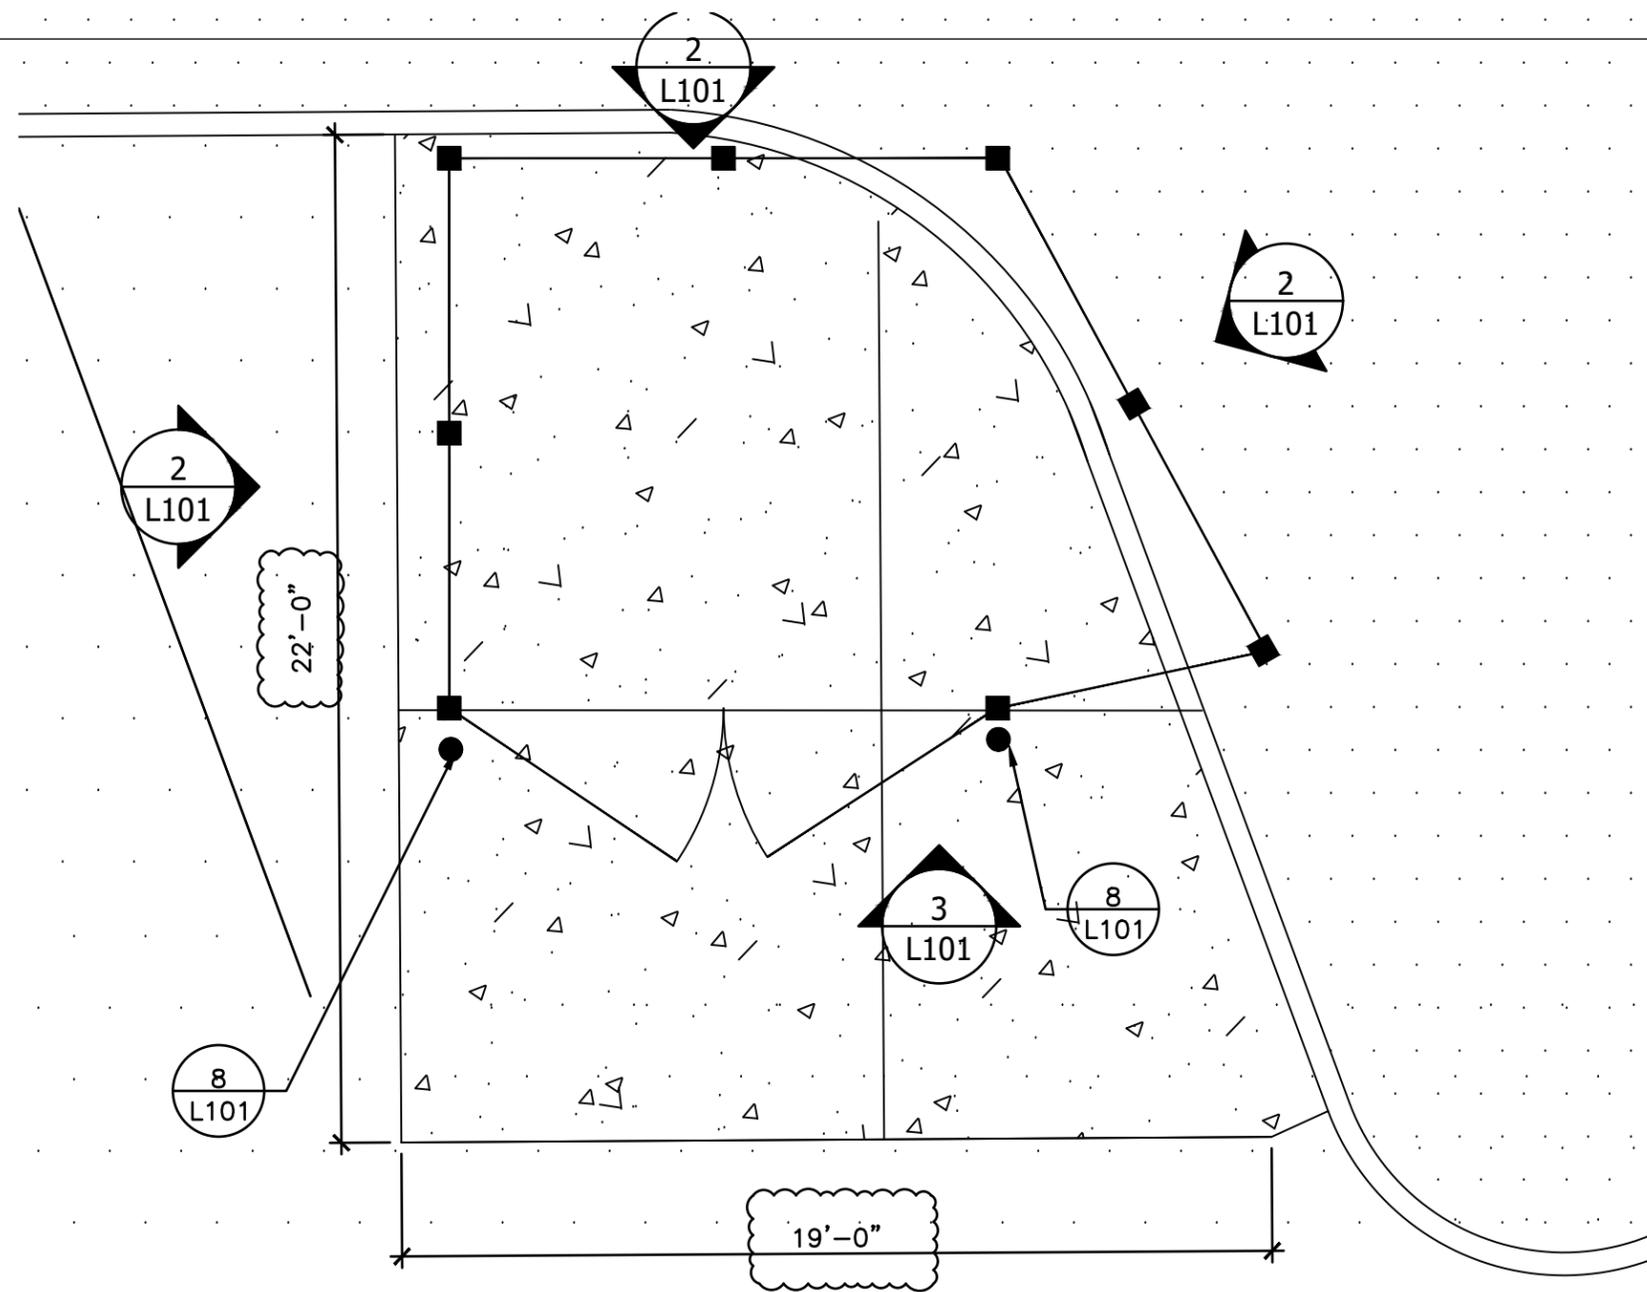

DUMPSTER ENCLOSURE ENLARGEMENT	1
SCALE: 1/4" = 1'-0"	

PROJECT: Sheridan Public Library Addition & Renovation

PROJECT NO: 25050

DATE: February 5, 2026

DRAWING NO.: ADD3-L1

REFER TO DWG: L101 - Site Details

DRAWN BY: BWR



Odle McGuire Shook
 7222 N Shadeland Ave
 Suite 100
 Indianapolis, Indiana 46250
 317.842.0000
 Fax 317.917.0616
 www.omscorp.net

© Copyright 2026

DOWNSPOUT BOOT
NOT DISTURB

8' ±
VARIES BY
MANUFACTURER

EDGE OF EX.
PAVEMENT


BENCH, DO NOT
DISTURB

8' ±


OUTSIDE EDGE OF PERGOLA

CENTER PERGOLA ON BENCH


SHERIDAN PUBLIC LIBRARY NEW PERGOLA ADD-3

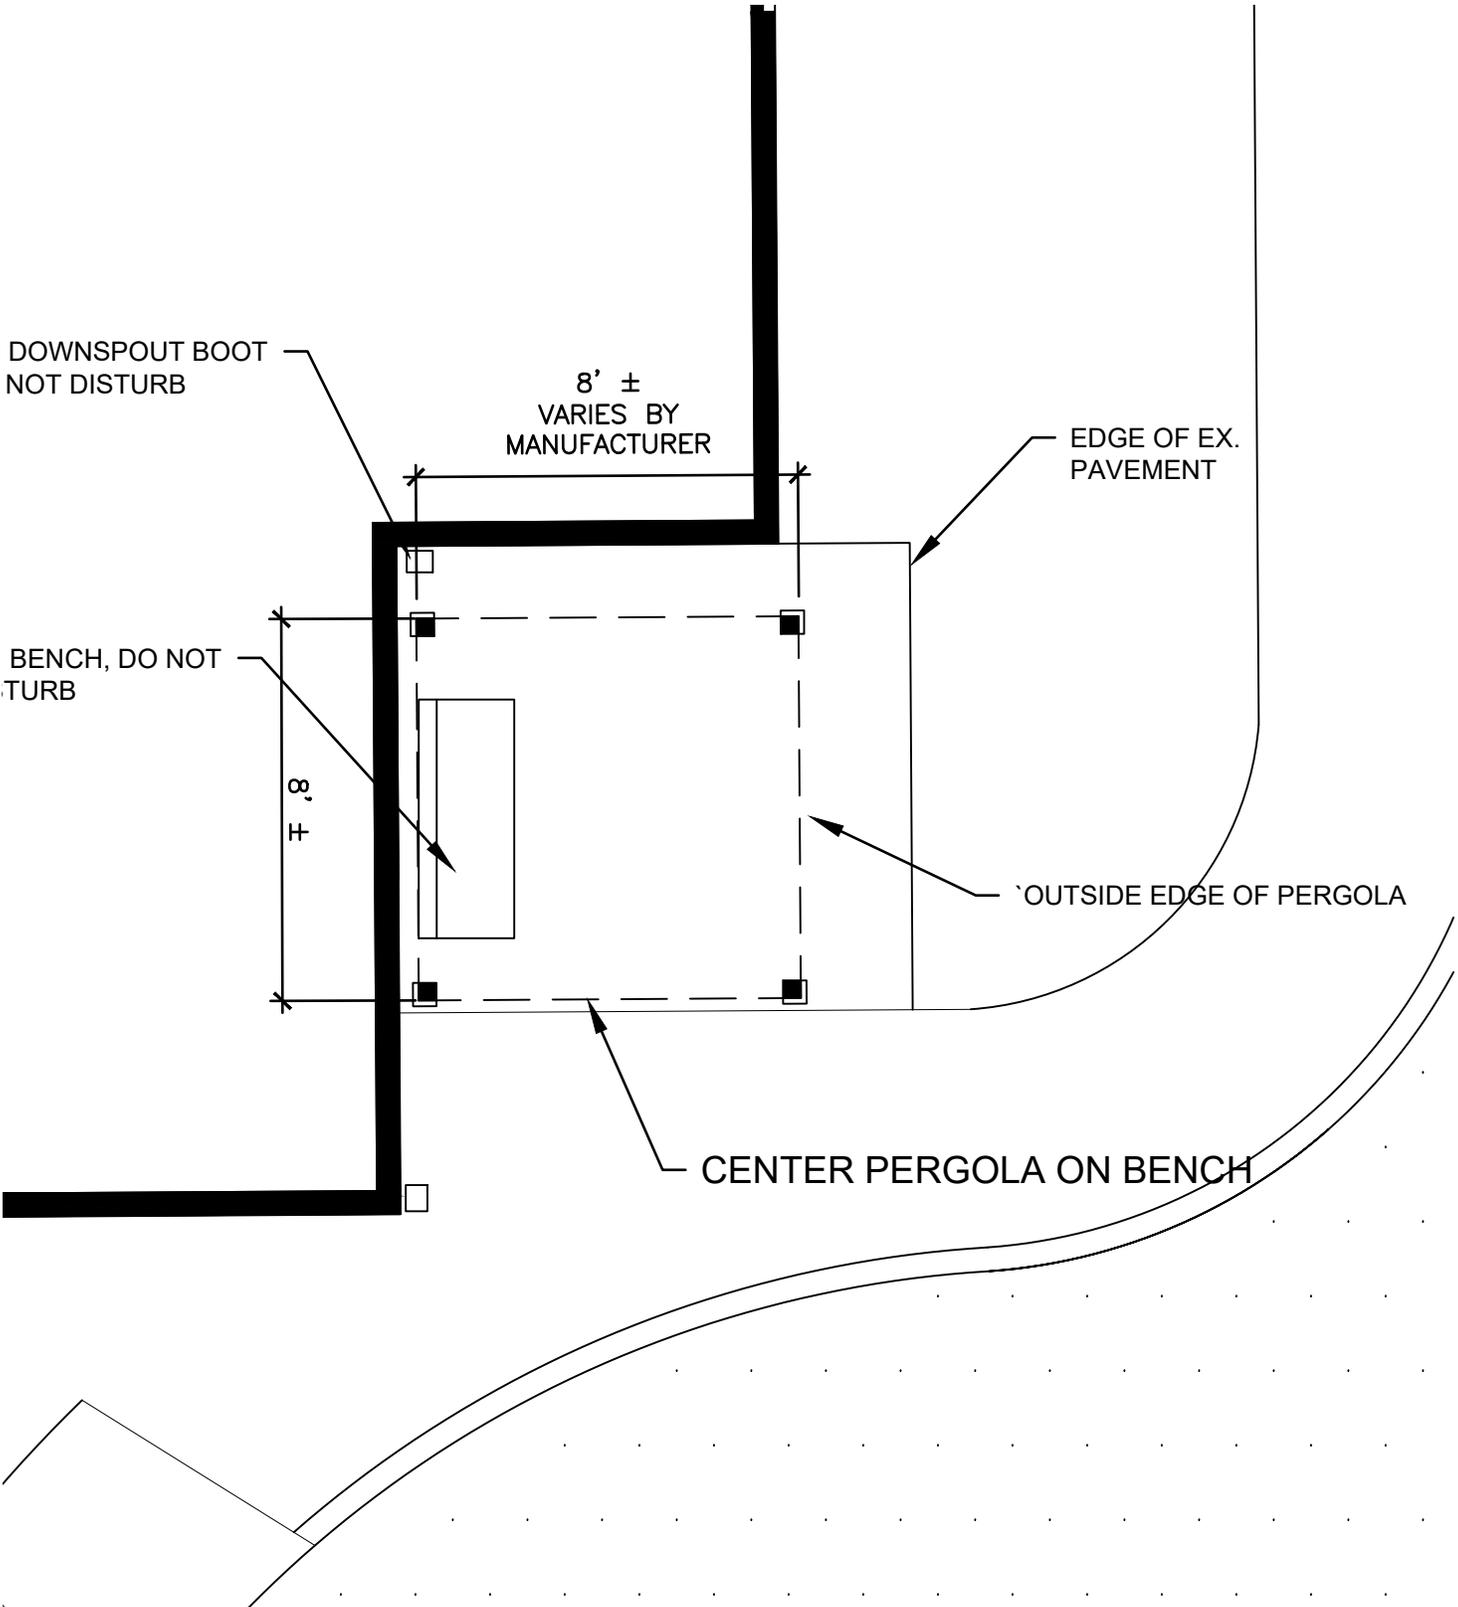

OCCUPANCY LOAD SIGNAGE

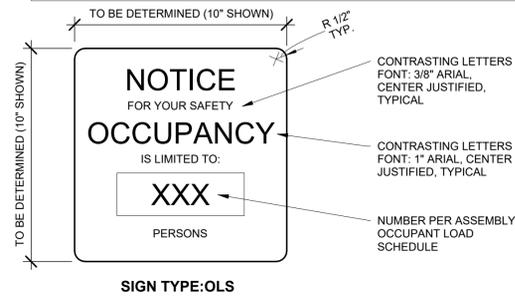


TACTILE EXIT SIGNAGE

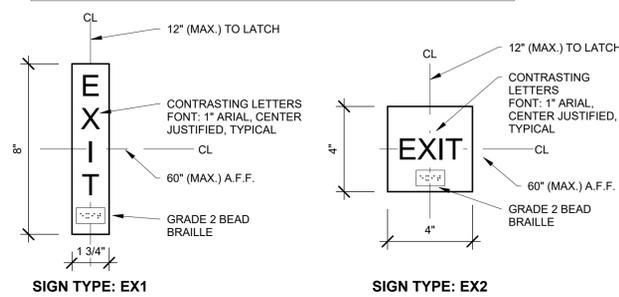

- NOTES**
1. PROVIDE "OCCUPANCY" SIGNAGE AS INDICATED ABOVE IN EACH ASSEMBLY OCCUPANCY WITHIN THE BUILDING.
 2. COORDINATE LOCATION, SIZE, AND QUANTITY OF SIGNS WITH LOCAL BUILDING / FIRE OFFICIALS.
 3. COORDINATE SIGN MATERIAL W/ OWNER.

- NOTES**
1. TACTILE EXIT SIGNAGE REQUIRED BY IBC SEC. 1011.4 AND COMPLY W/ ICC A117.1. UTILIZING EITHER STYLE OF SIGN AS SHOWN ABOVE.
 2. POST SIGN ADJACENT TO EACH DOOR TO AN EGRESS STAIRWAY, AN EXIT PASSAGEWAY AND THE EXIT DISCHARGE, MOUNTED 60" A.F.F. (MAX) TO CENTERLINE OF SIGN; AND 12" (MAX.) FROM LATCH TO CENTERLINE OF SIGN.
 3. COORDINATE LOCATION OF SIGNS W/ OWNER.

DEDICATION PLAQUE

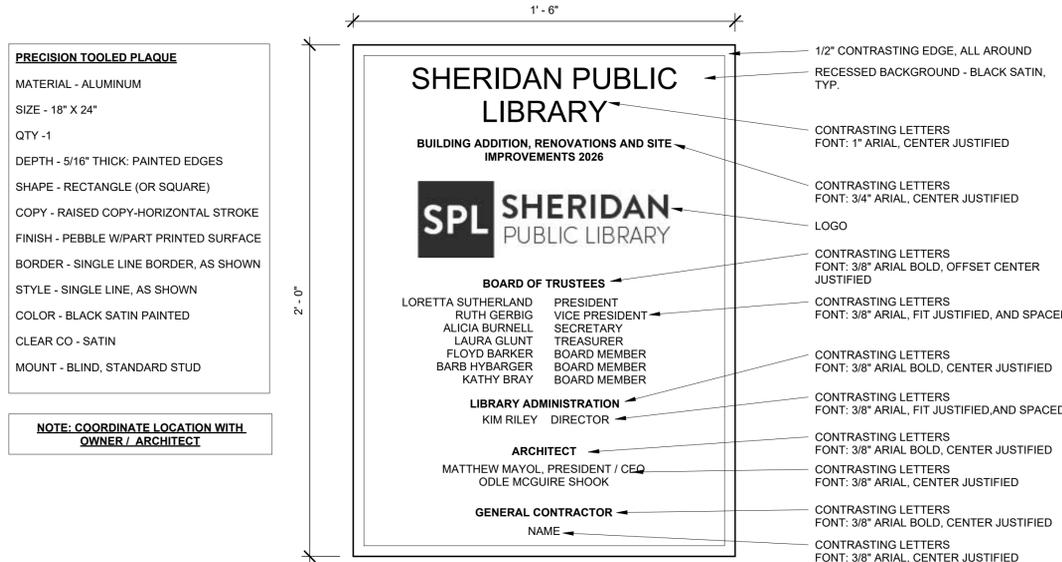

PRECISION TOOLED PLAQUE

MATERIAL - ALUMINUM

SIZE - 18" X 24"

QTY - 1

DEPTH - 5/16" THICK. PAINTED EDGES

SHAPE - RECTANGLE (OR SQUARE)

COPY - RAISED COPY-HORIZONTAL STROKE

FINISH - PEBBLE W/PART PRINTED SURFACE

BORDER - SINGLE LINE BORDER, AS SHOWN

STYLE - SINGLE LINE, AS SHOWN

COLOR - BLACK SATIN PAINTED

CLEAR CO - SATIN



MOUNT - BLIND, STANDARD STUD

NOTE: COORDINATE LOCATION WITH OWNER / ARCHITECT

TYPICAL WALL TYPES

- NOTES:**
1. ALL NEW INTERIOR PARTITIONS ARE A UNLESS NOTED OTHERWISE. INSTALL WATER RESISTANT GYP. BD. OR FIBER REINFORCED GYP. BD. AT ALL WET WALLS BEHIND SINKS, MOP SINKS, DRINKING FOUNTAINS, TOILETS, AND OTHER SIM. WET AREAS.
 2. SEE PLAN LOCATION FOR INSULATED WALLS. INSULATION IN WALL SHALL BE FULL THICKNESS.
 3. MOISTURE AND MOLD RESISTANT TILE BACKER BASIS OF DESIGN IS: NATIONAL GYPSUM, GOLD BOND 6XP TILE BACKER, ASTM D3273

WOOD STUD CONSTRUCTION: (TYPE, NOM. THICKNESS)

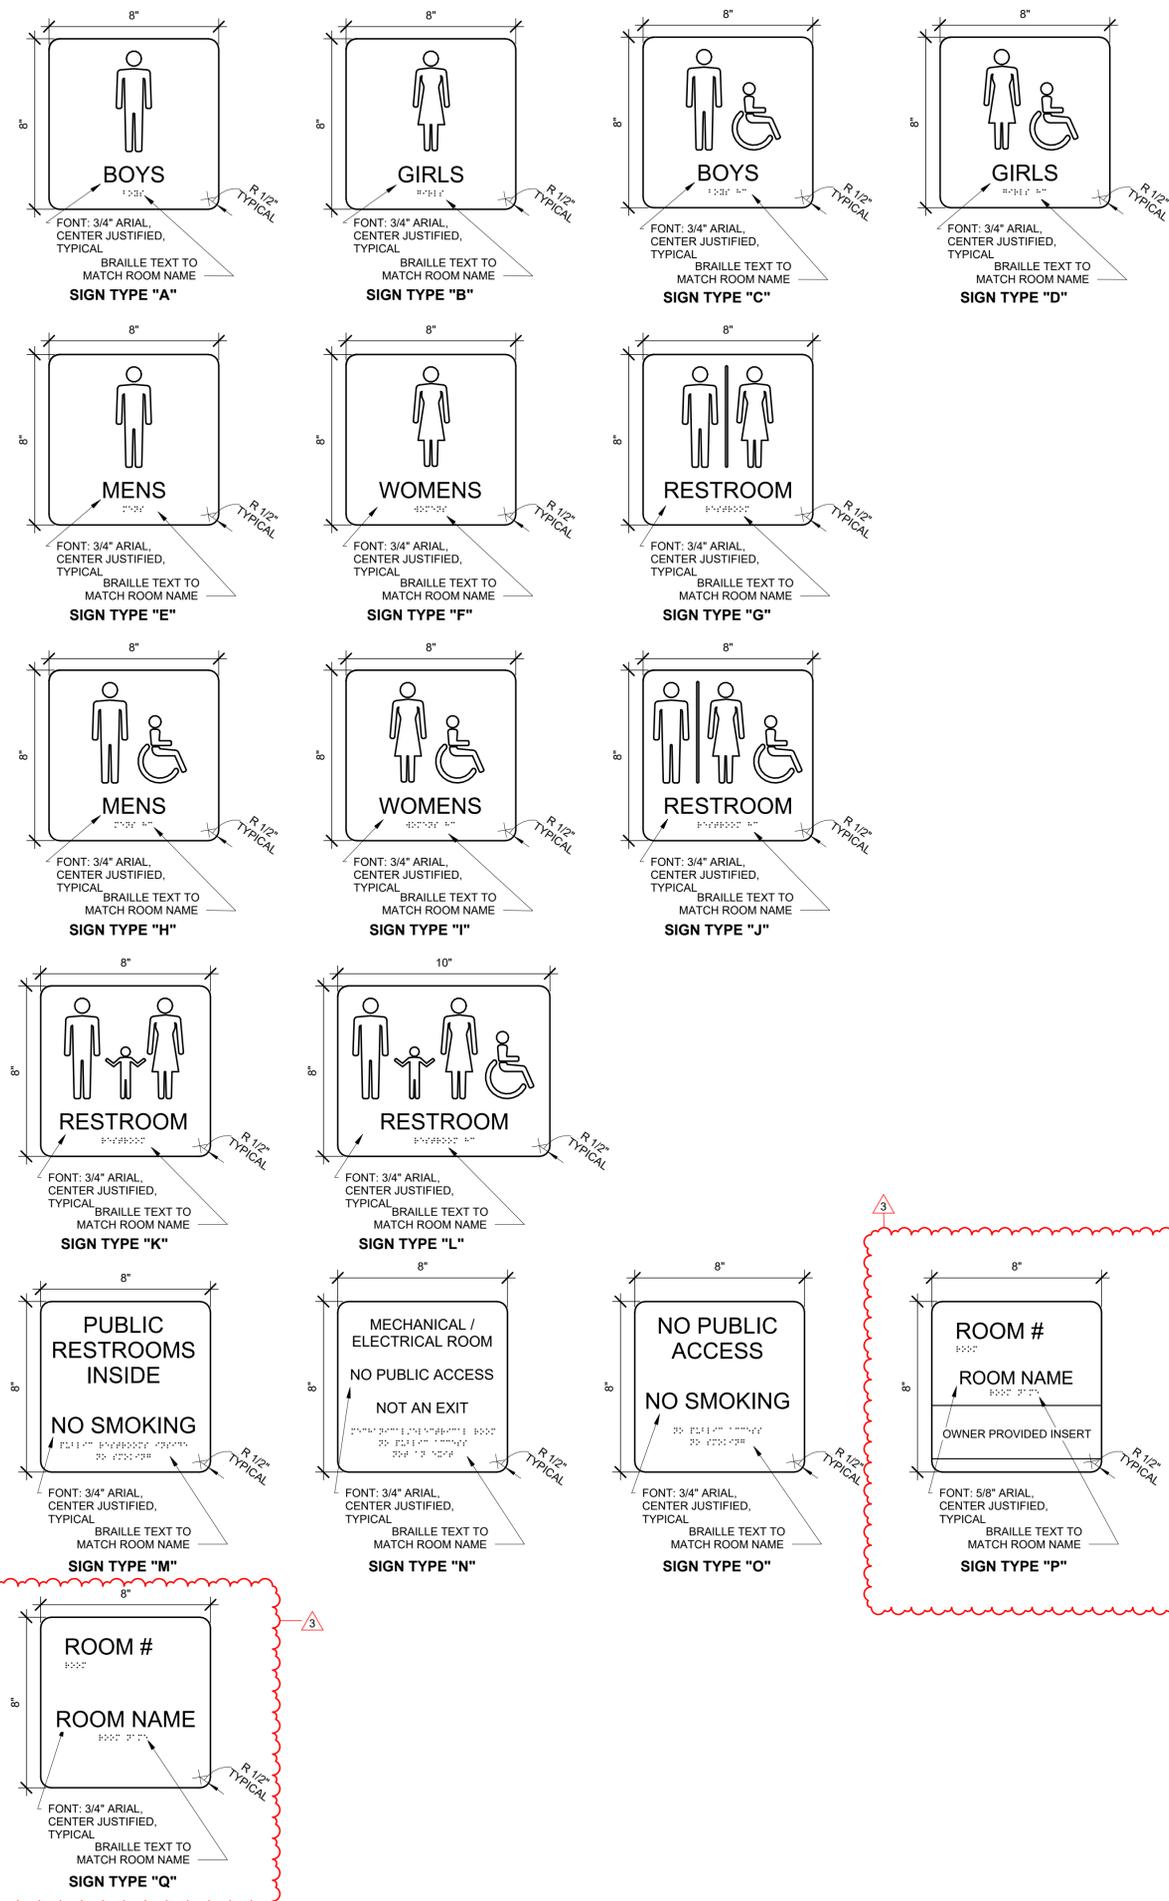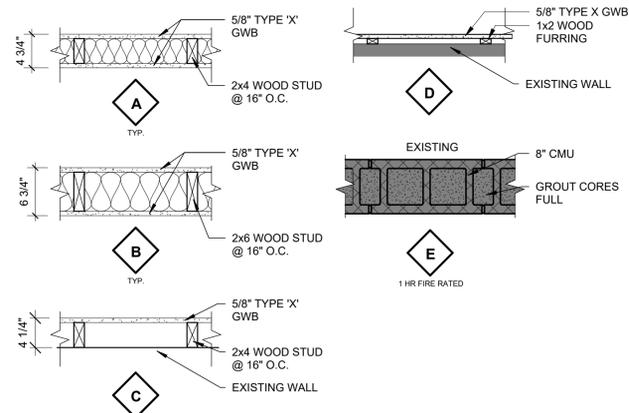

ROOM SIGNAGE DETAILS

SCALE: 3" = 1'-0"



Odle McGuire Shook
ARCHITECTURE INTERIOR DESIGN
LANDSCAPE ARCHITECTURE ENGINEERING
"A history of forward thinking..."

www.omscorp.net

7222 N Shadeland Avenue
Suite 100
Indianapolis, Indiana 46250
317.842.0000
Fax 317.917.0616
oms@omscorp.net

100%
CONSTRUCTION
DOCUMENTS



Matthew R. Mayol

CERTIFIED

No.	Description	Date
3	ADD-3	02/05/2026

REVISIONS

SHERIDAN PUBLIC LIBRARY BUILDING ADDITION, RENOVATIONS AND SITE IMPROVEMENTS

© Copyright 2026

by ODLLE MCGUIRE SHOOK
Copyright includes architectural work, building design, plans or drawings, and specifications. Architectural work is the overall form as well as the arrangement and composition of spaces and elements in the design. Reproduction without written permission is prohibited.

Project number 25050
Date 01.15.26
Drawn by AA
Checked by MRM
Designed by MRM

A002
GENERAL INFORMATION

103 W 1ST ST, SHERIDAN, IN 46069, HAMILTON COUNTY



Odle McGuire Shook
ARCHITECTURE INTERIOR DESIGN
LANDSCAPE ARCHITECTURE ENGINEERING
"A history of forward thinking..."
www.omscorp.net

7222 N Shadeland Avenue
Suite 100
Indianapolis, Indiana 46250
317.842.0000
Fax 317.917.0616
oms@omscorp.net

100%
CONSTRUCTION
DOCUMENTS



Matthew R. Mayol
CERTIFIED

No.	Description	Date
1	ADD-1	01/29/2026
2	ADD-2	02/02/2026
3	ADD-3	02/05/2026

REVISIONS

**SHERIDAN PUBLIC LIBRARY BUILDING
ADDITION, RENOVATIONS AND SITE
IMPROVEMENTS**

103 W 1ST ST, SHERIDAN, IN 46069, HAMILTON COUNTY

© Copyright 2026
by ODLE MCGUIRE SHOOK
Copyright includes architectural work, building
design, plans or drawings, and specifications.
Architectural work is the overall form as well as
the arrangement and composition of spaces and
elements in the design. Reproduction without
written permission is prohibited.

Project number 25050
Date 01.15.26
Drawn by AA
Checked by MRM
Designed by MRM

A101
FIRST FLOOR PLAN &
MEZZANINE FLOOR PLAN



GENERAL NOTES

- FIELD VERIFY ALL DIMENSIONS, EXISTING CONDITIONS AND LOCATIONS PRIOR TO STARTING ANY WORK. REPORT ANY DISCREPANCIES TO ARCHITECT.
- DIMENSIONS SHOWN ARE FROM FACE OF FINISHED WALL OR CENTERLINE OF STRUCTURE. DIMENSIONS ARE NOMINAL. REFER TO STRUCTURAL FOR LINTEL SCHEDULE. REFER TO MECHANICAL, PLUMBING AND ELECTRICAL DRAWINGS FOR SIZE AND LOCATION OF REQUIRED OPENINGS; PROVIDE LINTELS AS REQUIRED.
- REFERENCE ROOM FINISH SCHEDULE FOR FINISHES.
- REFERENCE REFLECTED CEILING PLANS FOR WALLS TO DECK, FIRE-RATED WALLS AND CEILING HEIGHTS.
- CONTRACTOR TO COORDINATE WORK WITH OTHER TRADES PRIOR TO STARTING ANY CONSTRUCTION.
- APPLIANCES ARE OWNER PROVIDED, CONTRACTOR INSTALLED. COORDINATE PRIOR TO INSTALLATION. REF APPLIANCE SCHEDULE AND "P" SERIES SHEETS FOR APPLIANCE SPECIFICATIONS.


PLAN NOTES

- NO WORK THIS AREA
- RETROFIT ALUM DOORS / FRAMES W/ NEW HANDICAPPED ACCESSIBLE PUSH BUTTONS THIS LOCATION. COLOR: DARK BRONZE.
- NOT USED.
- HIGH LOW DRINKING FOUNTAIN W/ BOTTLE FILLER. REF "P" SERIES DWGS.
- WOOD POST COLUMN W/ ALUM. CLADDING TO MATCH GUTTERS.
- INSTALL OWNER PROVIDED ATTIC STOCK CERAMIC WALL TILE 12" A.F.F. W/ SCHLUTER TRIM WTT-1.
- NEW GATE REF. DTLS.
- PATCH AND REPAIR WOOD FLOOR THIS LOCATION. USE WOOD FLOORING FROM OWNER PROVIDED SURPLUS LOCATED IN MEZZANINE 200.
- NEW FLOOR POWER & DATA. REF. "E" SERIES DWGS.
- INFILL CONC. SLAB THIS LOCATION. REF "E" SERIES DWGS. PREP FOR NEW FLOOR FINISH.
- PATCH & REPAIR FLOOR, WALL & CEILING THIS LOCATION.
- REPLACE CERAMIC FLOOR TILE THIS AREA WITH OWNER PROVIDED MATCHING ATTIC STOCK. REF "AI" DWGS.
- NEW PERGOLA / SHADE STRUCTURE. REF "S" SPEC. PROTECT EXISTING MEMORIAL BENCH DURING CONSTRUCTION.
- NEW DOWNSPOUT. CONTRACTOR OPTION TO TIE INTO EXISTING UNDERGROUND SYSTEM OR DAYLIGHT TO THE WEST.
- PATCH, REPAIR & PAINT DRYWALL THIS LOCATION DUE TO STRUCTURAL SILL PLATE VERIFICATION.
- PATCH, REPAIR & PAINT DRYWALL THIS LOCATION DUE TO REMOVAL OF WALL SOUNE.
- NEW REFRIGERATOR.
- NEW BULKHEAD. REF. DTLS. 8/A003.
- PATCH / REPAIR / CLEAN CONCRETE THIS LOCATION.
- REINSTALL BOOKSHELF FROM INDIANA HISTORY 107. CONNECT POWER IN SHELF BASE. REF "E" SERIES DWGS.

PLAN LEGEND

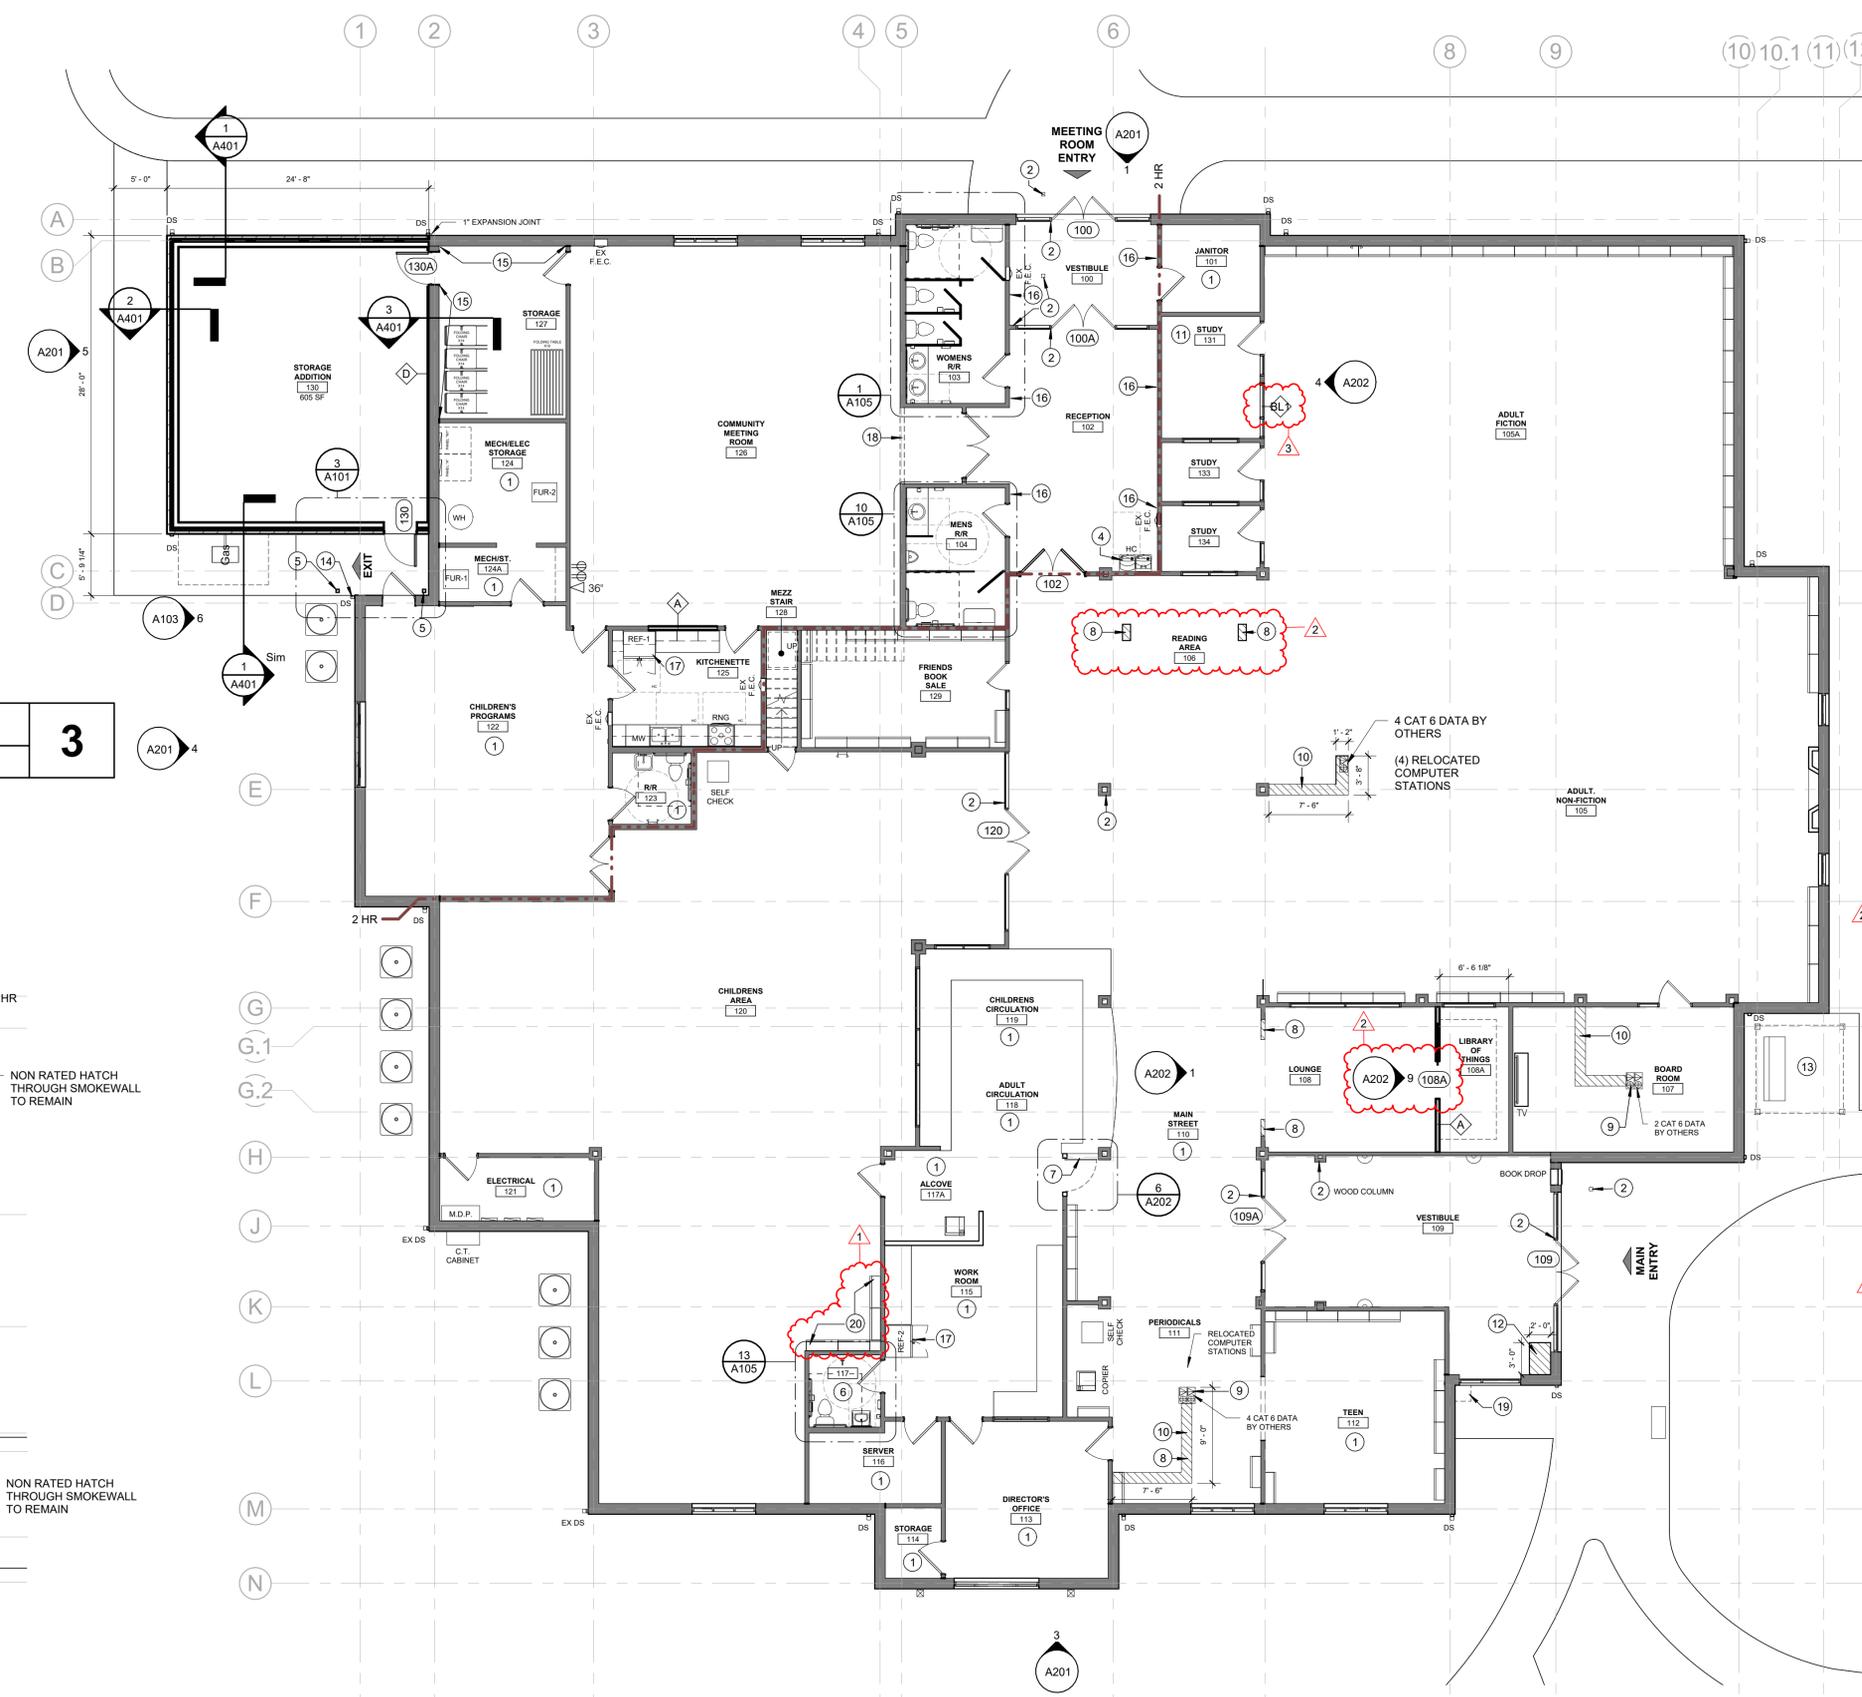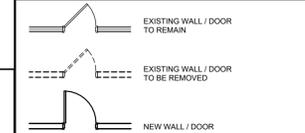


ENLARGED PLAN DETAIL
SCALE: 1/4" = 1'-0"
3

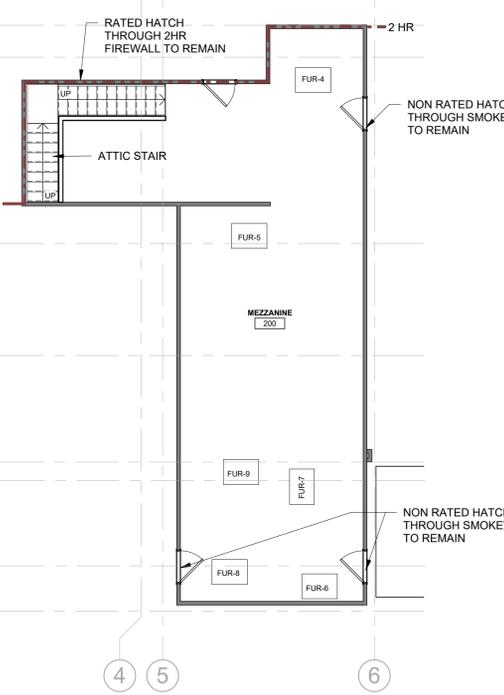

MEZZANINE PLAN
SCALE: 1/8" = 1'-0"
2

FIRST FLOOR PLAN
SCALE: 1/8" = 1'-0"
1

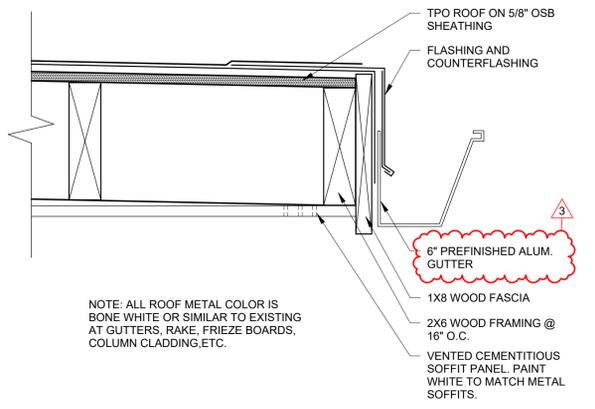

SOFFIT DETAIL

SCALE: 3" = 1'-0"

7

ELEV. NEW ROOF

SCALE: 1/4" = 1'-0"

6

NEW ROOF 3D VIEW

SCALE:

5



ENLARGED ROOF PLAN

SCALE: 1/4" = 1'-0"

4

ROOF PLAN GENERAL NOTES

- A. REFER TO WALL SECTION DRAWINGS FOR ADDITIONAL INFORMATION.
- B. REFER TO 'P' AND 'M' SERIES DRAWINGS FOR ADDITIONAL INFORMATION ASSOCIATED TO MECHANICAL EQUIPMENT ROOF PENETRATIONS.
- C. FIELD VERIFY ALL DIMENSIONS, CONDITIONS AND LOCATIONS OF ROOF PENETRATIONS WHETHER NEW OR EXISTING.
- D. MAINTAIN WATER TIGHTNESS OF ALL ITEMS ON THE ROOF INCLUDING BUT NOT LIMITED TO MECHANICAL UNITS AND OTHER ROOF PENETRATIONS.
- E. PROVIDE POSITIVE DRAINAGE OF ALL ROOF AREAS WHETHER SHOWN OR NOT.
- F. PROVIDE FLASHING, PITCH POCKETS AND ALL OTHER DETAILING REQUIRED BY ROOFING MANUFACTURER; REMOVE ANY UNUSED ITEMS.
- G. ALL WOOD BLOCKING, NAILERS, ETC. USED IN ROOF CONSTRUCTION TO BE TREATED WOOD.
- H. STORING AND/OR STOCKPILING OF MATERIALS ON EXISTING ROOF AREAS IS PROHIBITED.
- I. DOWNSPOUTS ARE 5"x4" U.N.O.
- J. VERIFY MATERIAL OF EXISTING ROOF BEFORE BEGINNING WHERE FLASHING INTO EXISTING ROOF MATERIALS. FOLLOW RECOMMENDATIONS ESTABLISHED BY THE NRCA ROOFING MANUAL.

ROOF PLAN NOTES



1. HIGH D.S. TO REMAIN.
2. MEMBRANE ROOF SYSTEM.
3. OUTLINE OF ROOF BELOW.
4. PREFINISHED ALUM. DOWNSPOUT BELOW
5. PREFINISHED ALUM GUTTER TO MATCH EXISTING.



REFERENCE IMAGE 1

SCALE: N.T.S.

3

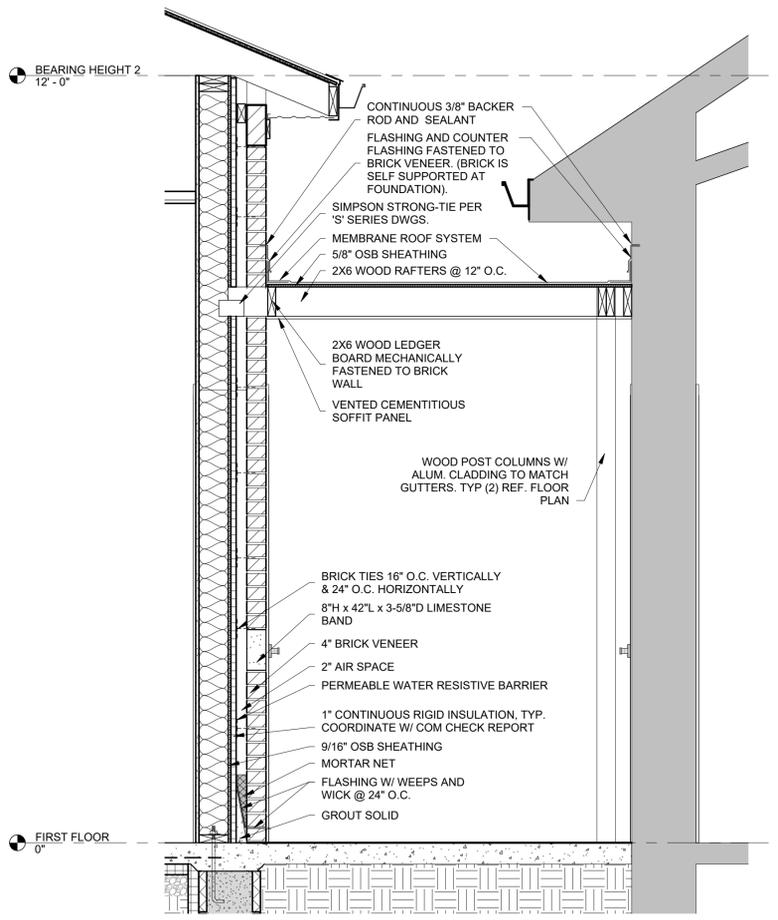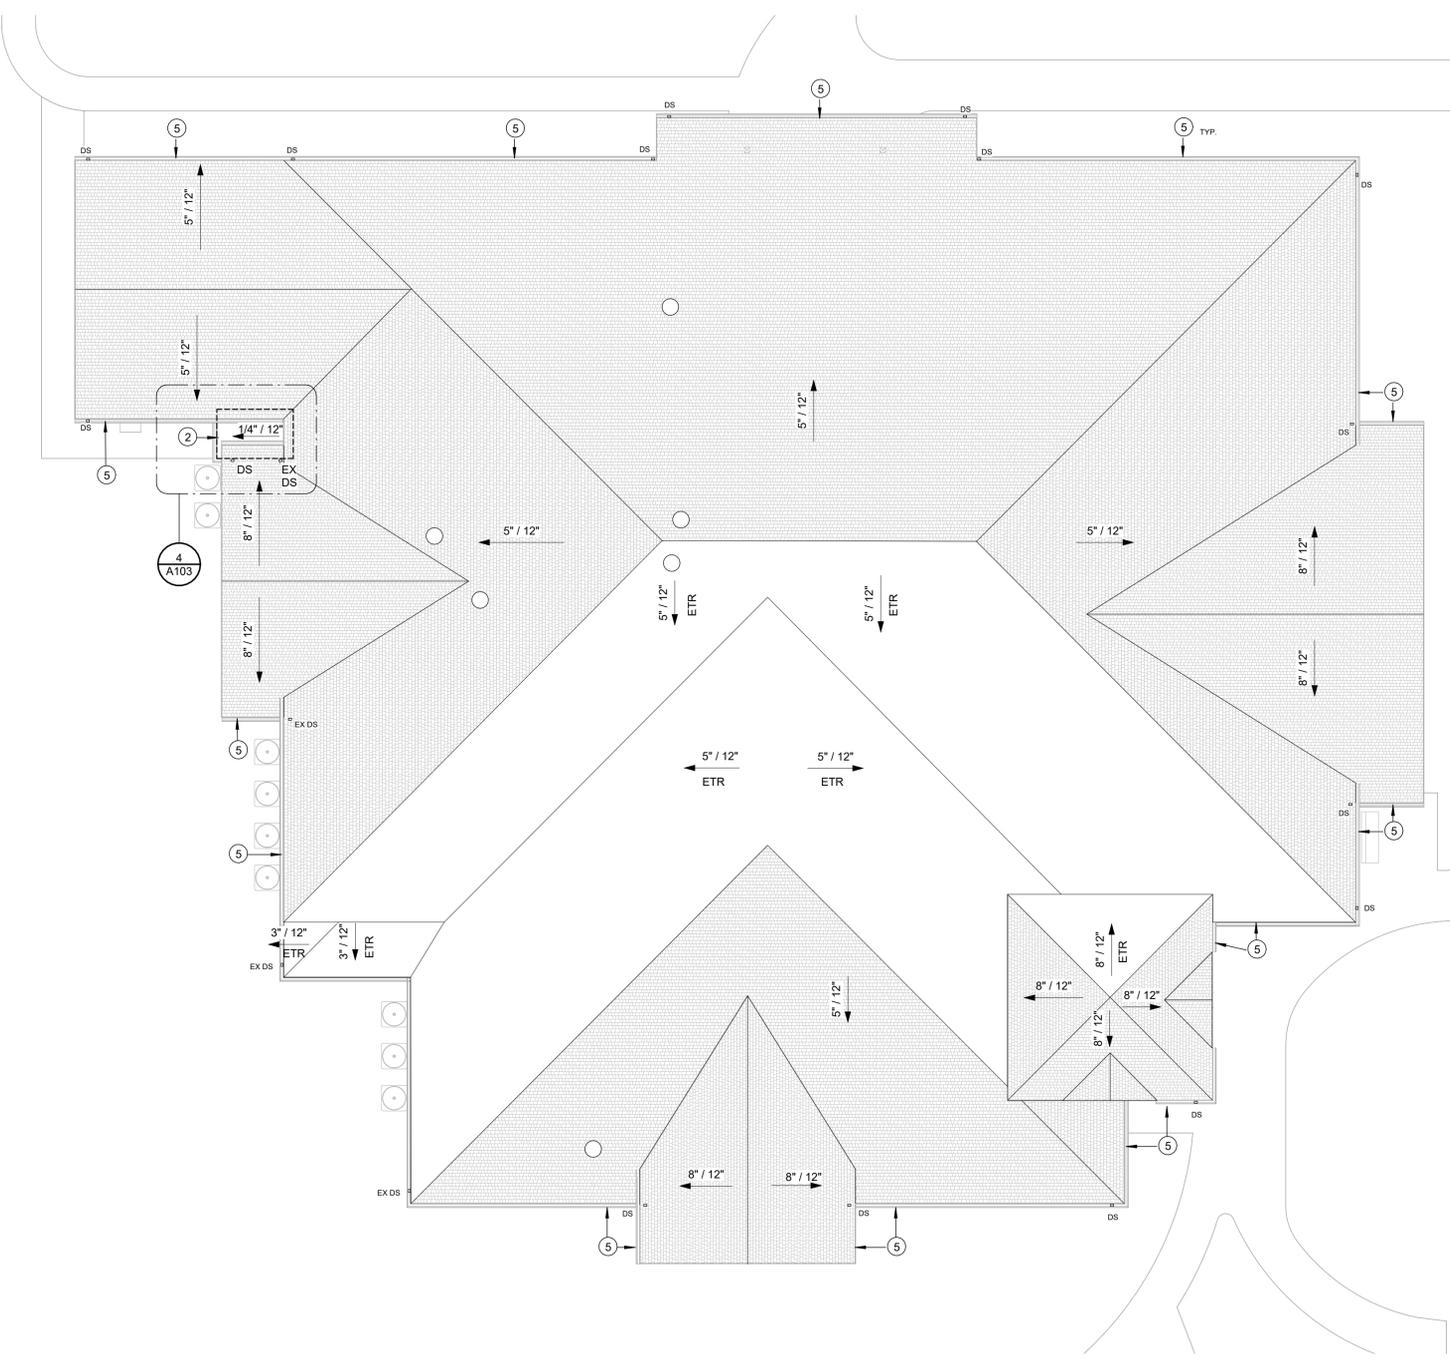

ROOF SECTION

SCALE: 3/4" = 1'-0"

2



ROOF PLAN

SCALE: 1" = 10'-0"

1

ROOF LEGEND

- DENOTES ROOF REPORTEDLY REPLACED IN 2021 BY INSURANCE CLAIM. 39 1/4" SHINGLE WIDTH 5 1/2" EXPOSURE
- DENOTES NEW ROOF 39 1/4" SHINGLE WIDTH 5 1/2" EXPOSURE
- MECHANICAL EQUIPMENT
- EXHAUST FAN
- VENT
- D.S. DOWNSPOUT. TIE INTO U.G. STORM.
- DIRECTION OF ROOF SLOPE



Odle McGuire Shook
ARCHITECTURE INTERIOR DESIGN
LANDSCAPE ARCHITECTURE ENGINEERING
"A history of forward thinking..."
www.omscorp.net
7222 N Shadeland Avenue
Suite 100
Indianapolis, Indiana 46250
317.842.0000
Fax 317.917.0616
oms@omscorp.net

100%
CONSTRUCTION
DOCUMENTS



Matthew R. Mayzel
CERTIFIED

No.	Description	Date
3	ADD-3	02/05/2026

REVISIONS

**SHERIDAN PUBLIC LIBRARY BUILDING
ADDITION, RENOVATIONS AND SITE
IMPROVEMENTS**

© Copyright 2026
by ODLE MCGUIRE SHOOK
Copyright includes architectural work, building design, plans or drawings, and specifications. Architectural work is the overall form as well as the arrangement and composition of spaces and elements in the design. Reproduction without written permission is prohibited.
Project number 25050
Date 01.15.26
Drawn by AA
Checked by MRM
Designed by MRM

A103
ROOF PLAN & DETAILS

103 W 1ST ST, SHERIDAN, IN 46069, HAMILTON COUNTY

2/5/2026 3:28:06 PM

APPLIANCE SCHEDULE

MARK	TYPE	ADA	DESCRIPTION	MFGR	FINISH	MODEL NO.	WIDTH	DEPTH	HEIGHT	EPA STAR
RNG	RANGE / OVEN W/ VENTLESS HOOD	YES	SLIDE-IN ELECTRICAL RANGE WITH OVEN W/ ADA HANDICAP ACCESSIBLE DESIGN W/ FRONT CONTROLS / INDICATOR LIGHTS / HOOD WALL SWITCH.	G.E. 30" OR ARCHITECT APPROVED EQUAL	SS	JS6455LSS-ADA	MFGR.	MFGR.	MFGR.	Y
MW	MICROWAVE	YES	2.2 CU FT COUNTERTOP MICROWAVE OVEN	G.E. 30" OR ARCHITECT APPROVED EQUAL	SS	GCSH22UIWSS	MFGR.	MFGR.	MFGR.	Y
REF-1	REFRIGERATOR	YES	PROFESSIONAL 32 CU. FT. COUNTER-DEPTH FRENCH DOOR REFRIGERATOR W/ FREEZER DRAWER - DO NOT CONNECT ICE MAKER	SAMSUNG	SS	RF32CG5100SRAA	35 3/4"	36 1/4"	70"	Y
REF-2	REFRIGERATOR	YES	PROFESSIONAL 32 CU. FT. COUNTER-DEPTH FRENCH DOOR REFRIGERATOR W/ FREEZER DRAWER - CONNECT ICE MAKER	SAMSUNG	SS	RF32CG5100SRAA	35 3/4"	36 1/4"	70"	Y

- NOTES:
1. APPLIANCES ARE CONTRACTOR PROVIDED OR FURNISHED AND INSTALLED. U.N.O.
 2. APPLIANCES ARE REQUIRED TO BE EPA "ENERGY STAR" RATED AND TO MEET ADA REQUIREMENTS.
 3. APPLIANCES ARE BASIS OF DESIGN AND ARE SUBJECT TO AVAILABILITY. ARCHITECT APPROVED EQUALS ARE ENCOURAGED.
 4. VERIFY AVAILABLE LxWxH OF PRODUCTS PRIOR TO PURCHASE AND INSTALLATION.



Odle McGuire Shook
ARCHITECTURE INTERIOR DESIGN
LANDSCAPE ARCHITECTURE ENGINEERING
"A history of forward thinking..."

www.omscorp.net

7222 N Shadeland Avenue
Suite 100
Indianapolis, Indiana 46250
317.842.0000
Fax 317.917.0616
oms@omscorp.net

100%
CONSTRUCTION
DOCUMENTS



Matthew R. Mayol

CERTIFIED

No.	Description	Date
1	ADD-1	01/29/2026
2	ADD-2	02/02/2026
3	ADD-3	02/05/2026

REVISIONS

SHERIDAN PUBLIC LIBRARY BUILDING
ADDITION, RENOVATIONS AND SITE
IMPROVEMENTS

103 W 1ST ST, SHERIDAN, IN 46069, HAMILTON COUNTY

© Copyright 2026

by ODLE MCGUIRE SHOOK
Copyright includes architectural work, building design, plans or drawings, and specifications. Architectural work is the overall form as well as the arrangement and composition of spaces and elements in the design. Reproduction without written permission is prohibited.

Project number 25050
Date 01.15.26
Drawn by AA
Checked by MRM
Designed by MRM

A202

INTERIOR ELEVATIONS,
ENLARGED PLAN,
APPLIANCE SCHEDULE &
DETAILS

POCKET DOOR ELEV.
SCALE: 1/4" = 1'-0"

CASING DETAIL
SCALE: 1 1/2" = 1'-0"

ELEV. GATE
SCALE: 1/4" = 1'-0"

ENLARGED GATE PLAN
SCALE: 1/2" = 1'-0"

CASING DETAIL
SCALE: 1 1/2" = 1'-0"

ELEV. STUDY WINDOW
SCALE: 1/4" = 1'-0"

ELEV. KITCHEN SOUTH
SCALE: 1/4" = 1'-0"

ELEV. KITCHEN NORTH
SCALE: 1/4" = 1'-0"

ELEV. LOUNGE 108
SCALE: 1/4" = 1'-0"



NORTH



Odle McGuire Shook
 ARCHITECTURE INTERIOR DESIGN
 LANDSCAPE ARCHITECTURE ENGINEERING
 "A history of forward thinking..."

www.omscorp.net

7222 N Shadeland Avenue
 Suite 100
 Indianapolis, Indiana 46250
 317.842.0000
 Fax 317.917.0616
 oms@omscorp.net

100%
 CONSTRUCTION
 DOCUMENTS



Matthew R. Mayol

CERTIFIED

No.	Description	Date
1	ADD-1	01/29/2026
3	ADD-3	02/05/2026

REVISIONS

**SHERIDAN PUBLIC LIBRARY BUILDING
 ADDITION, RENOVATIONS AND SITE
 IMPROVEMENTS**

103 W 1ST ST, SHERIDAN, IN 46069, HAMILTON COUNTY


© Copyright 2026

by ODLE MCGUIRE SHOOK
 Copyright includes architectural work, building
 design, plans or drawings, and specifications.
 Architectural work is the overall form as well as
 the arrangement and composition of spaces and
 elements in the design. Reproduction without
 written permission is prohibited.

Project number 25050
 Date 01.15.26
 Drawn by AA
 Checked by MRM
 Designed by MRM

A401

WALL SECTIONS

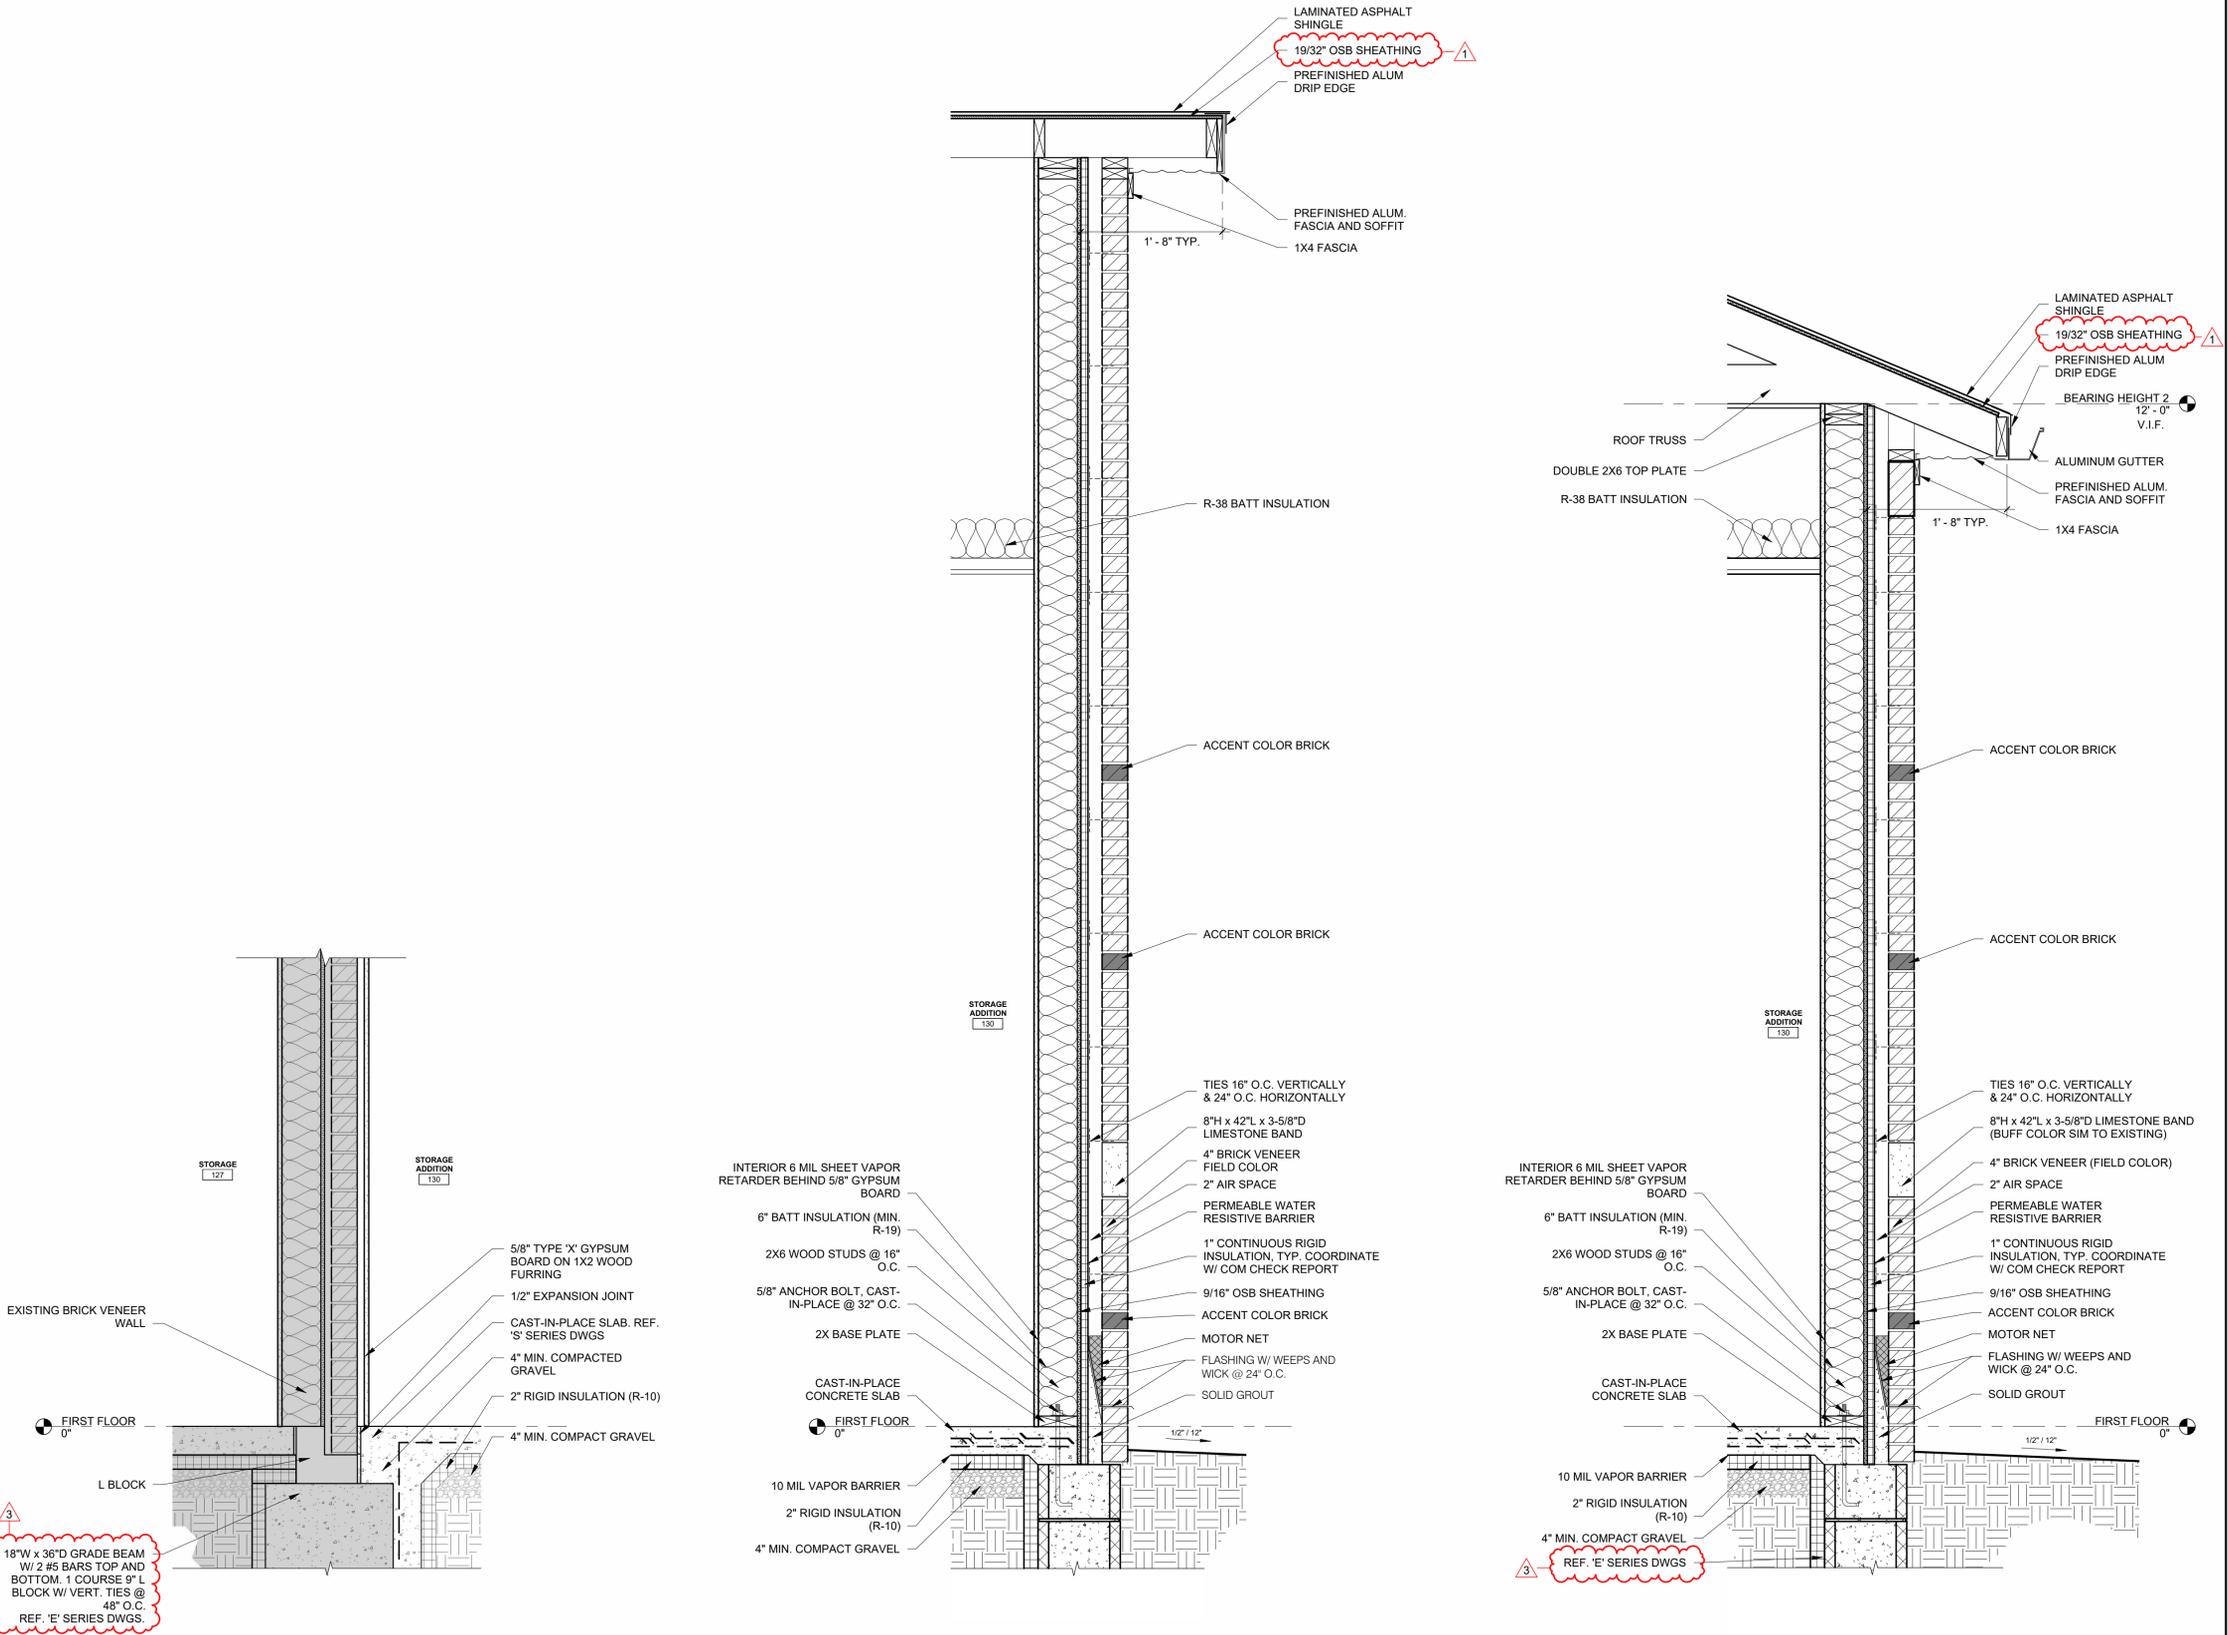

WALL SECTION 3
 SCALE: 1" = 1'-0"

3 WALL SECTION 2
 SCALE: 1" = 1'-0"

2 WALL SECTION 1
 SCALE: 1" = 1'-0"

1



DOOR 120 CHILD SIDE

11

DOOR 120 ADULT SIDE

10


SCALE: 1/4" = 1'-0" FOR REFERENCE ONLY

SCALE: 1/4" = 1'-0" FOR REFERENCE ONLY

HEAD DETAIL

H5

SCALE: 1 1/2" = 1'-0"

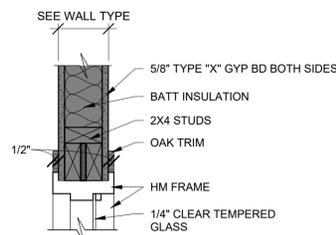

DOOR #	DOOR			FRAME			HEAD	JAMB	SILL	HDWR	FIRE RATING	COMMENTS	
	W.	H.	T.	TYPE	MATERIAL	TYPE							MATERIAL
FIRST FLOOR													
100	EX	(PR)	3'-0"	7'-0"	1 3/4"	B	EX AL GL	SF1	EX AL	EX	EX	EX	1, 2, REF 4/A501
100A	EX	(PR)	3'-0"	7'-0"	1 3/4"	B	EX AL GL	SF1	EX AL	EX	EX	EX	1, 2, REF 5/A501
102			3'-0"	7'-0"	1 3/4"	A	WD	1	HM	H1	J1	-	1, 2
108A			3'-6"	7'-0"	1 1/2"	A	WD	1	WD	H2	J2	-	POCKET DOOR
109	EX	(PR)	3'-0"	7'-0"	1 3/4"	B	EX AL GL	SF4	EX AL	EX	EX	EX	1, 2, REF 6 & 7/501
109A	EX	(PR)	3'-0"	7'-0"	1 3/4"	B	EX AL GL	SF3	EX AL	EX	EX	EX	1, 2, REF 8 & 9/A501
120	EX	(PR)	3'-0"	7'-0"	1 3/4"	B	EX AL GL	SF2	EX AL	EX	EX	EX	1, 2, REF 10 & 11/A501
130			3'-0"	7'-0"	1 3/4"	A	HM	1	HM	H3	-	S1	5
130A			3'-0"	7'-0"	1 3/4"	A	WD	1	HM	H1	J1	-	4

- NOTES:
1. PROVIDE NEW PUSH BUTTON HC ACCESSIBLE HARDWARE. LOCATION PER PLAN.
 2. FINAL ADJUST FOR PROPER CLOSURE AND HC OPERATION.
 3. NOT USED
 4. PROVIDE SIMILAR DOOR STAIN COLOR FROM MINWAX FULL COLOR RANGE. REF AI DWGS.
 5. PAINT DOOR/FRAME SIM TO ADJACENT EXIT DOOR FROM PROGRAMS ROOM 122.

WINDOW SCHEDULE

TAG	FRAME SIZE		FRAME			FIRE RATING	GLAZING	REMARKS
	HEIGHT	WIDTH	MATL.	ELEV.	DETAIL			
◇	2'-0"	2'-0"	AL - BRONZE	A	H4	-	S2	-

HARDWARE NOTES

1. VERIFY ALL LOCK FUNCTIONS AND KEYING WITH OWNER.
2. ALL HARDWARE SETS WITH CLOSERS TO HAVE BALL BEARING HINGES.
3. ALL DOORS W/CLOSERS TO HAVE KICKPLATES ON PUSH SIDE OF DOOR. SIZE TO BE 10" HIGH X 2" LESS WIDTH OF DOOR.
4. ALL PASSAGE AND LOCKSETS TO BE LEVER TYPE, COMPLYING TO ALL APPLICABLE ADA REQUIREMENTS.
5. ALL HARDWARE FINISHES TO BE US26D OR 626 STAIN CHROMIUM PLATED OR APPROVED EQUAL.
6. INTERIOR DOOR OPENING FORCE NOT TO EXCEED 5 LBS.
7. THRESHOLDS AND FLOORING MATERIAL TRANSITIONS TO COMPLY WITH ALL APPLICABLE ADA REQUIREMENTS.
8. VERIFY OWNER EQUIPMENT WIDTHS PRIOR TO DOOR INSTALLATIONS.
9. FIRE RATED DOORS TO HAVE CLOSERS AND UL LISTED HARDWARE IF AS REQ'D.
10. ALL EXTERIOR DOORS SHALL BE INSULATED.
11. AIR LEAKAGE FOR DOORS AND WINDOWS SHALL BE DETERMINED IN ACCORDANCE WITH NFRC 400. AIR LEAKAGE SHALL BE DETERMINED BY A LABORATORY ACCREDITED BY A NATIONALLY RECOGNIZED ACCREDITATION ORGANIZATION LIKE NFRC. AIR LEAKAGE AS LABELED BY THE MANUFACTURER SHALL NOT EXCEED 1.0 CFM/SQFT FOR GLAZED DOORS AND 40 CFM/SQFT FOR ALL OTHER DOOR AND WINDOW PRODUCTS.
12. ALL EXISTING DOORS AND FRAMES INDICATED BY ("X000") ARE EXISTING TO REMAIN. PAINT HOLLOW METAL DOORS AND FRAMES. CLEAN & RESTORE WOOD DOORS TO LIKE NEW CONDITION AND STAIN. COORDINATE WITH ARCHITECT IF DOOR DAMAGE REQUIRES PAINT. IF STAIN WOULD NOT BE AN ACCEPTABLE FINISH.

GLAZING NOTES

- A. PROVIDE 1" CLEAR INSULATED TEMPERED GLAZING AT EXTERIOR OPENINGS U.N.O.
- B. PROVIDE 1/4" CLEAR TEMPERED GLAZING AT INTERIOR OPENINGS U.N.O.
- C. PROVIDE FIRE RATED GLAZING WHERE INDICATED ON PLAN/DOOR SCHED.

HARDWARE SETS

1. INTERIOR STORAGE
3. HINGES
1. STORAGE SET (ANSF66)
1. STOP
3. SILENCERS
2. EXTERIOR ENTRANCE
1. ENTRANCE SET (ANSF 109)
1. CLOSER
1. THRESHOLD
1. WEATHER-STRIP
1. DOOR BOTTOM SWEEP
1. STOP
1. DRIP
3. INTERIOR ENTRANCE (PAIR)
3. HINGES
2. ENTRANCE SET (ANSI F 109)
2. STOP
6. SILENCERS



DOOR 109A INTERIOR

9

DOOR 109A EXTERIOR

8



SCALE: 1/4" = 1'-0" FOR REFERENCE ONLY

SCALE: 1/4" = 1'-0" FOR REFERENCE ONLY

JAMB DETAIL

J5


SCALE: 1 1/2" = 1'-0"

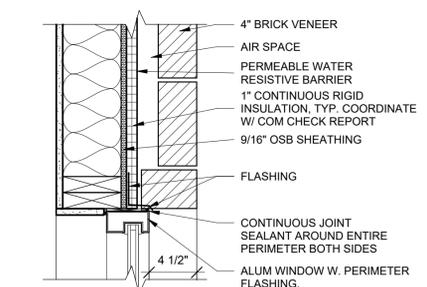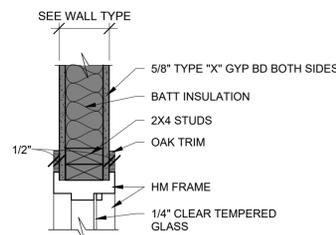

JAMB DETAIL

J4

SCALE: 1 1/2" = 1'-0"

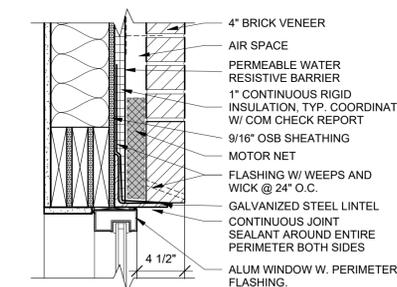

HEAD DETAIL

H4

SCALE: 1 1/2" = 1'-0"



DOOR 109 INTERIOR

7

DOOR 109 EXTERIOR

6


SCALE: 1/4" = 1'-0" FOR REFERENCE ONLY

SCALE: 1/4" = 1'-0" FOR REFERENCE ONLY

SILL DETAIL

S4

SCALE: 1 1/2" = 1'-0"

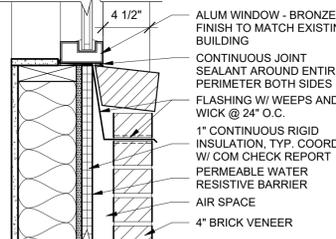

DOOR 100A INTERIOR

5

DOOR 100 EXTERIOR

4



SCALE: 1/4" = 1'-0" FOR REFERENCE ONLY

SCALE: 1/4" = 1'-0" FOR REFERENCE ONLY

HEAD DETAIL

H3


SCALE: 1 1/2" = 1'-0"

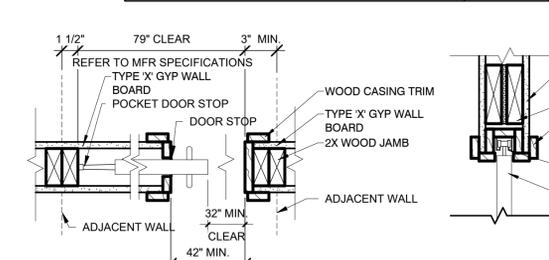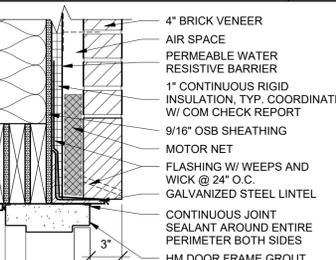

JAMB DETAIL

J2

SCALE: 1 1/2" = 1'-0"

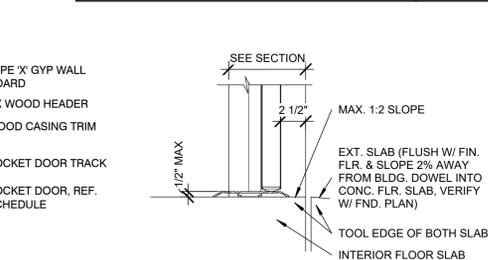

HEAD DETAIL


H2

SCALE: 1 1/2" = 1'-0"

SILL DETAIL

S1


SCALE: 1 1/2" = 1'-0"

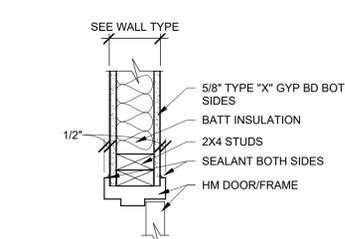

JAMB DETAIL

J1


SCALE: 1 1/2" = 1'-0"

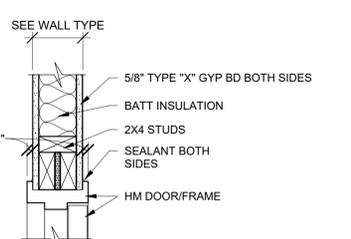

HEAD DETAIL

H1


SCALE: 1 1/2" = 1'-0"

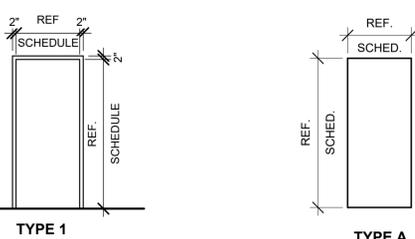

FRAME TYPES

3


SCALE: 1/4" = 1'-0"

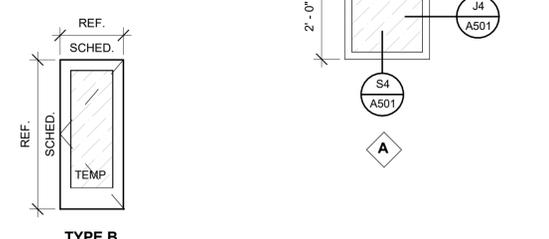

DOOR TYPES

2

SCALE: 1/4" = 1'-0"

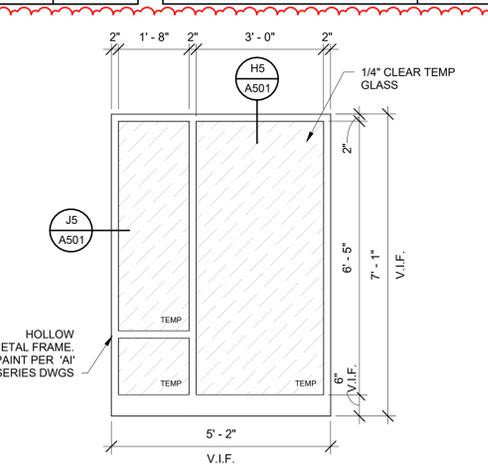

WINDOW TYPES

1.1

SCALE: 1/2" = 1'-0"

BL1

1

SCALE: 1/2" = 1'-0"



Odle McGuire Shook
ARCHITECTURE INTERIOR DESIGN
LANDSCAPE ARCHITECTURE ENGINEERING
"A history of forward thinking..."

www.omscorp.net
7222 N Shadeland Avenue
Suite 100
Indianapolis, Indiana 46250
317.842.0000
Fax 317.917.0616
oms@omscorp.net

100%
CONSTRUCTION
DOCUMENTS



Matthew R. Mayzel
CERTIFIED

No.	Description	Date
2	ADD-2	02/02/2026
3	ADD-3	02/05/2026

REVISIONS

**SHERIDAN PUBLIC LIBRARY BUILDING
ADDITION, RENOVATIONS AND SITE
IMPROVEMENTS**


103 W 1ST ST, SHERIDAN, IN 46069, HAMILTON COUNTY

© Copyright 2026
by ODLE MCGUIRE SHOOK
Copyright includes architectural work, building design, plans or drawings, and specifications. Architectural work is the overall form as well as the arrangement and composition of spaces and elements in the design. Reproduction without written permission is prohibited.


Project number 25050
Date 01.15.26
Drawn by AA
Checked by MRM
Designed by MRM

A501
OPENING SCHEDULES,
ELEVATIONS & DETAILS

SHERIDAN LIBRARY SIGNAGE SCHEDULE				
PROJECT ROOM #	PROJECT ROOM NAME	SIGN TYPE	QUANTITY	NOTES
OCCPANCY	WHERE INDICATED ON DWG G001	OLS	1	
EXIT	WHERE INDICATED ON DWG G001	EX1	4	
EXIT	WHERE INDICATED ON DWG G001	EX2	3	
101	JANITOR	Q	1	
103	WOMENS	I	1	
104	MENS	H	1	
107	BOARD ROOM	Q	1	
112	TEEN	Q	1	
113	DIRECTOR'S OFFICE	P	2	
114	STORAGE	Q	1	
116	SERVER/TECH	Q	1	
117	STAFF	J	1	
120	CHILDRENS AREA	Q	1	*1
121	ELECTRICAL	N	1	
122	CHILDREN'S PROGRAMS	Q	2	
123	FAMILY	L	1	
124A	MECH/ELEC STORAGE	N	1	
125	KITCHENETTE	Q	2	
126	COMMUNITY MEETING ROOM	Q	1	
127	STORAGE	Q	1	
128	MEZZ STAIR	Q	1	
129	FRIENDS BOOK SALE	Q	1	
130	STORAGE	Q	1	
131	STUDY	Q	1	*1
133	STUDY	Q	1	*1
134	STUDY	Q	1	*1
*NOTES: GLASS MOUNT W/ BLANK BACKER				

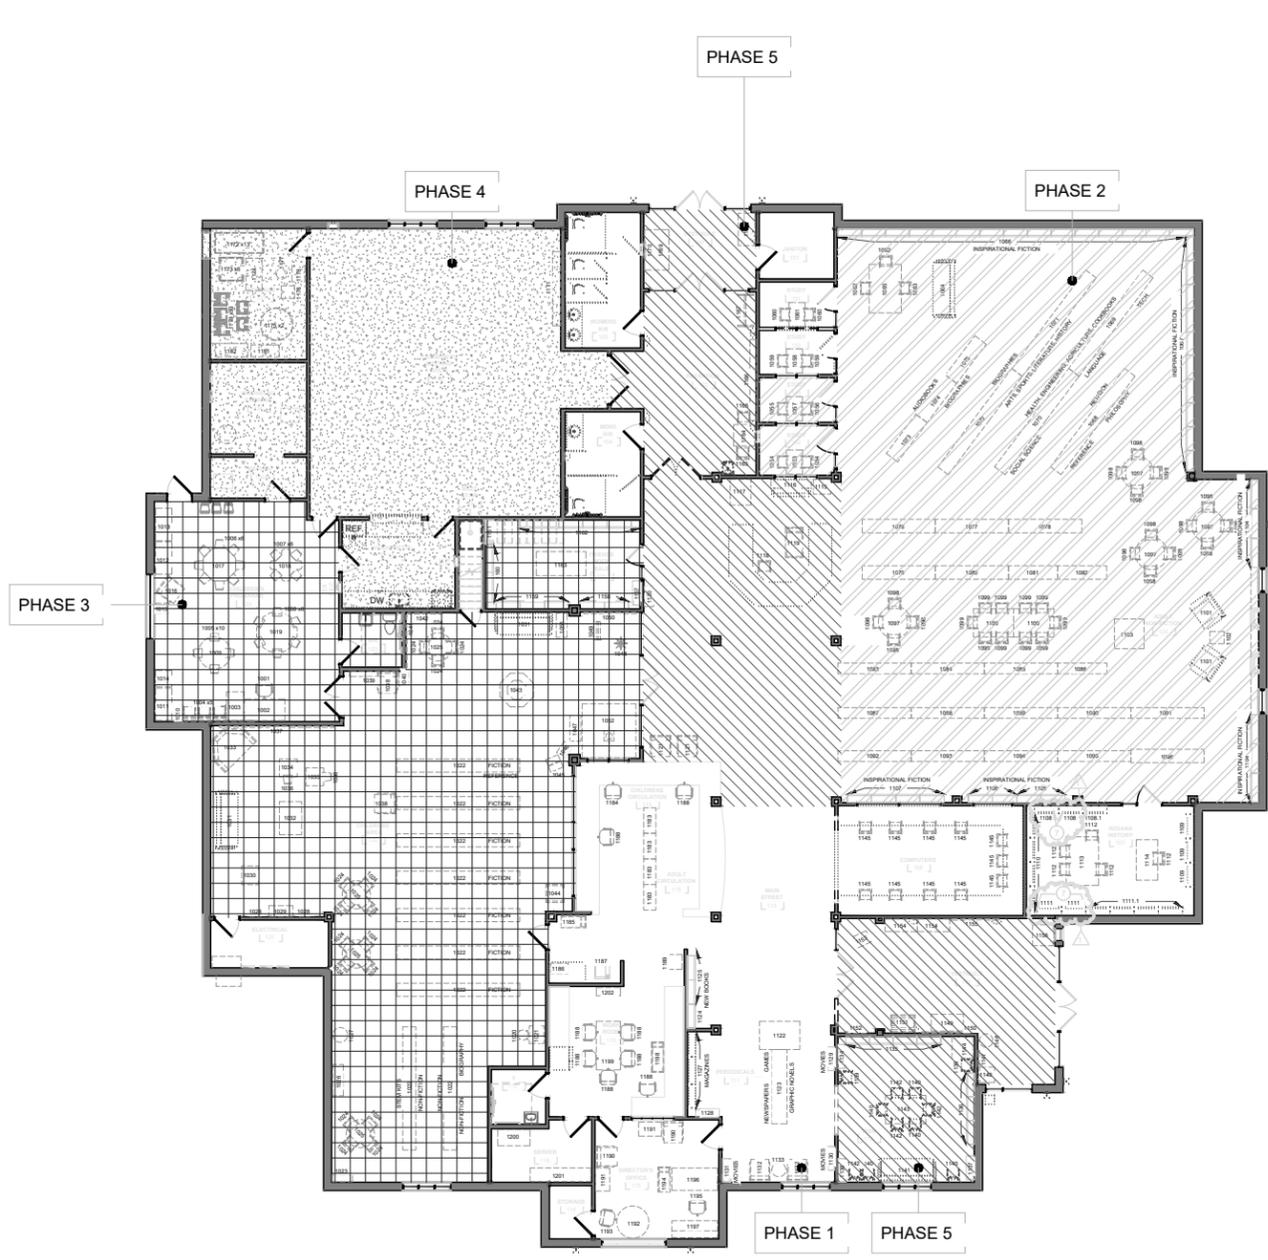

MOVE A - EXISTING

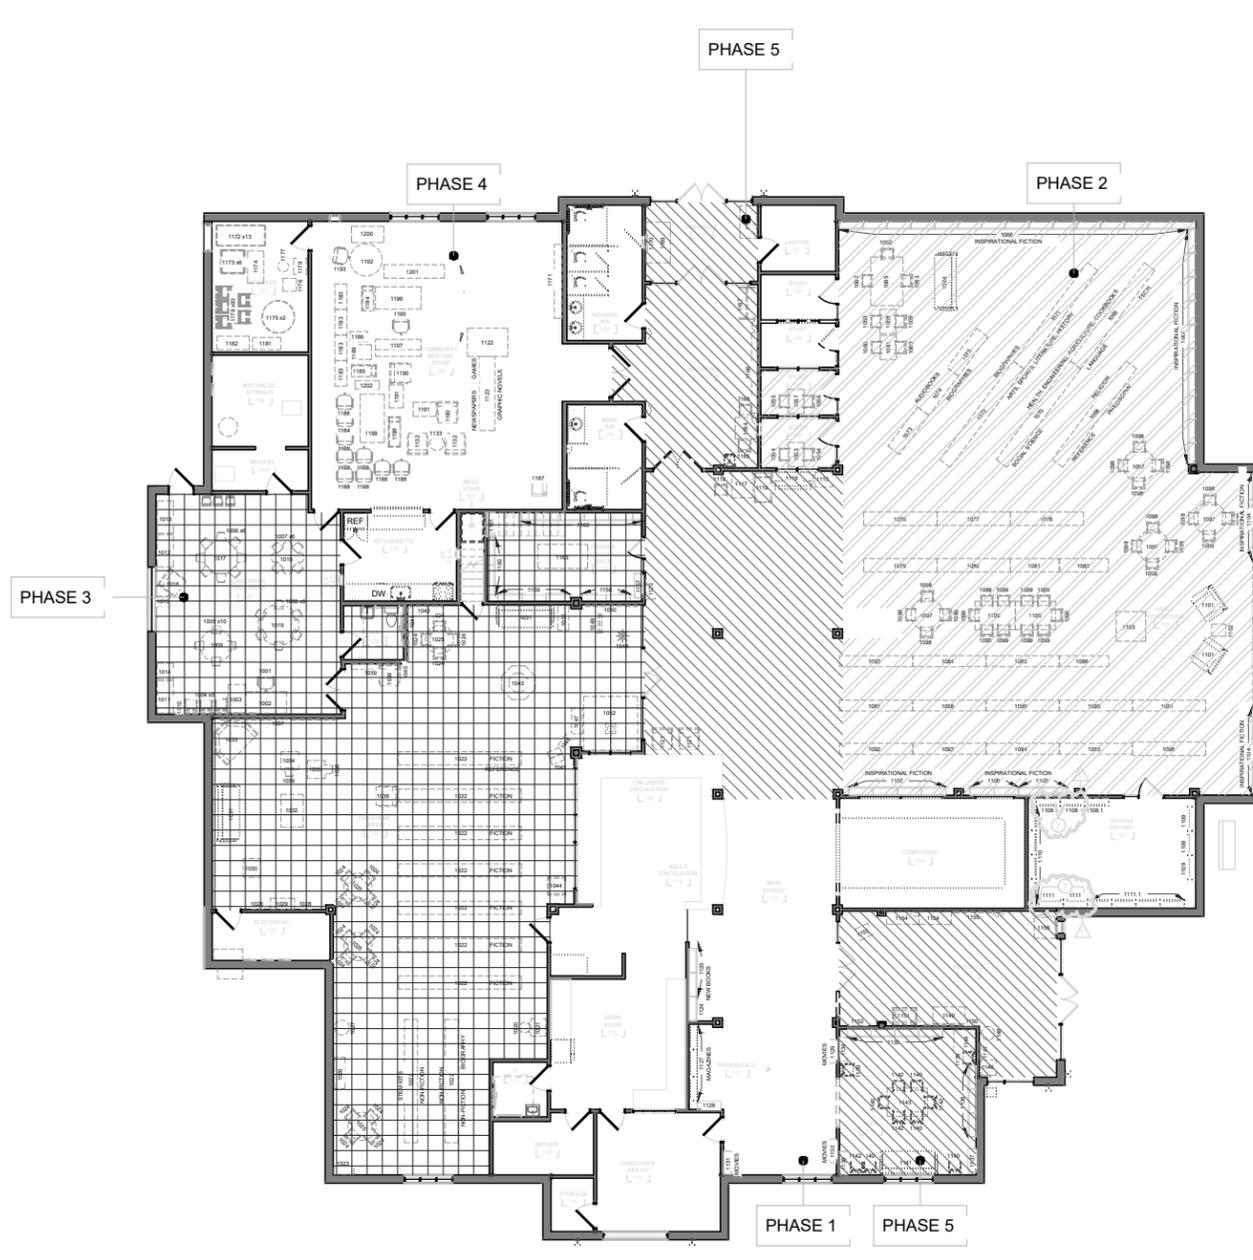

MOVE A - COMPLETE

START CONSTRUCTION PHASE 1

NOTES:

- LIBRARY CLOSED FOR 3 WEEKS
- NEW FURNITURE DELIVERY DATE TBD - INSTALLED BY OTHERS
- THE LIBRARY IS SELLING MOST OF THE OLD FURNITURE CALLED OUT FOR DISPOSAL IN THE INVENTORY LIST, THERE MAY BE LESS TO MOVE ON THE MOVE DATE

MOVER AGENDA:

1. STAGE ALL FURNITURE IN THE WAY OF CONSTRUCTION PHASE 1 IN COMMUNITY ROOM
 - 1.1. CHAIRS FROM THE COMPUTER LAB HAVE BEEN SOLD, STAGE IN COMMUNITY ROOM WITH MATCHING CHAIRS TO BE PICKED UP AT A LATER DATE
 - 1.2. NO FURNITURE TO MOVE FROM INDIANA HISTORY ROOM, LOOSE FURNITURE HAS BEEN SOLD, WALL SHELVES TO BE MOVED/DISPOSED OF BY THE GC
2. MOVE 2 TABLES AND 4 CHAIRS OUT OF STUDY RMS 131 + 132 AND STAGE IN ADULT NON-FICTION

SCALE: 3/32" = 1'-0"

DRAWN BY: GRB

DATE: 02/02/2026

REVISIONS


R1: 2/4/26	R6: ...
R2: ...	R7: ...
R3: ...	R8: ...
R4: ...	R9: ...
R5: ...	R10: ...

HAVING REVIEWED AND NOTING ALL REQUIRED CHANGES ON THIS DOCUMENT, THE CLIENT GIVES APPROVAL TO PROCEED AND ACKNOWLEDGES ADDITIONAL CHANGES COULD DELAY THE PROJECT COMPLETION DATE AND MAY INCUR ADDITIONAL SERVICE FEES. IN THE EVENT THE BUILDING SHELL IS SUPPLIED BY OTHERS, ITS ACCURACY REMAINS THE RESPONSIBILITY OF THAT SOURCE. THIS DOCUMENT IS THE PROPERTY OF RELOCATION STRATEGIES. ALTERATION AND/OR DUPLICATION IS PROHIBITED WITHOUT THE WRITTEN CONSENT.


CLIENT APPROVAL:

APPROVAL DATE:



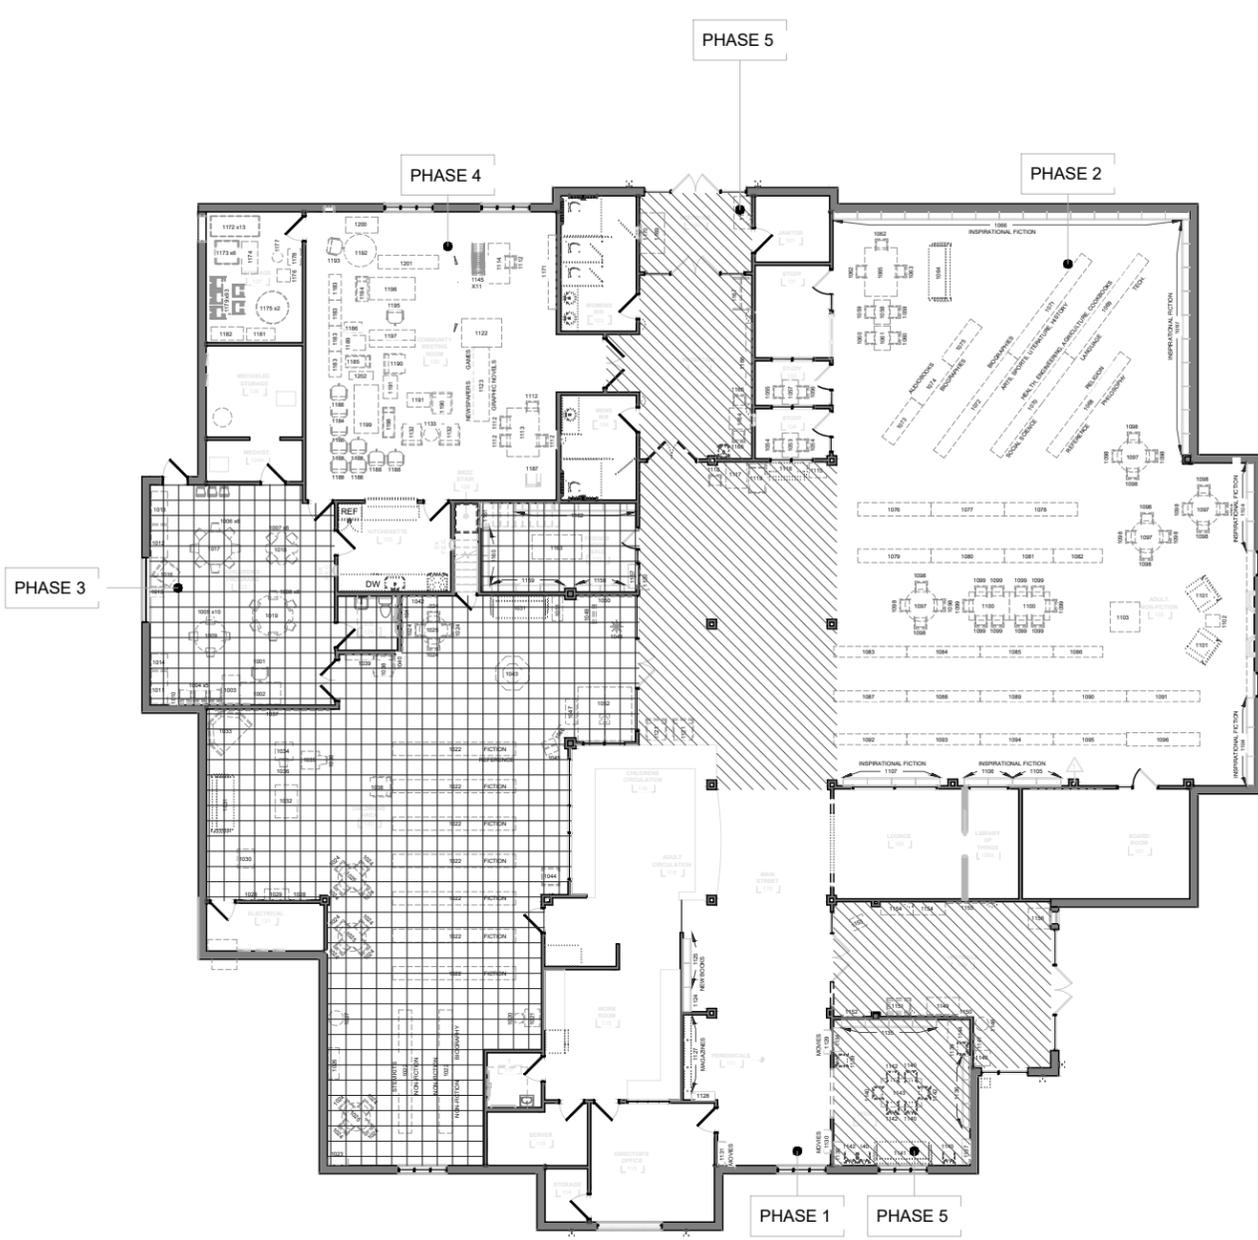

MOVE B1 - EXISTING

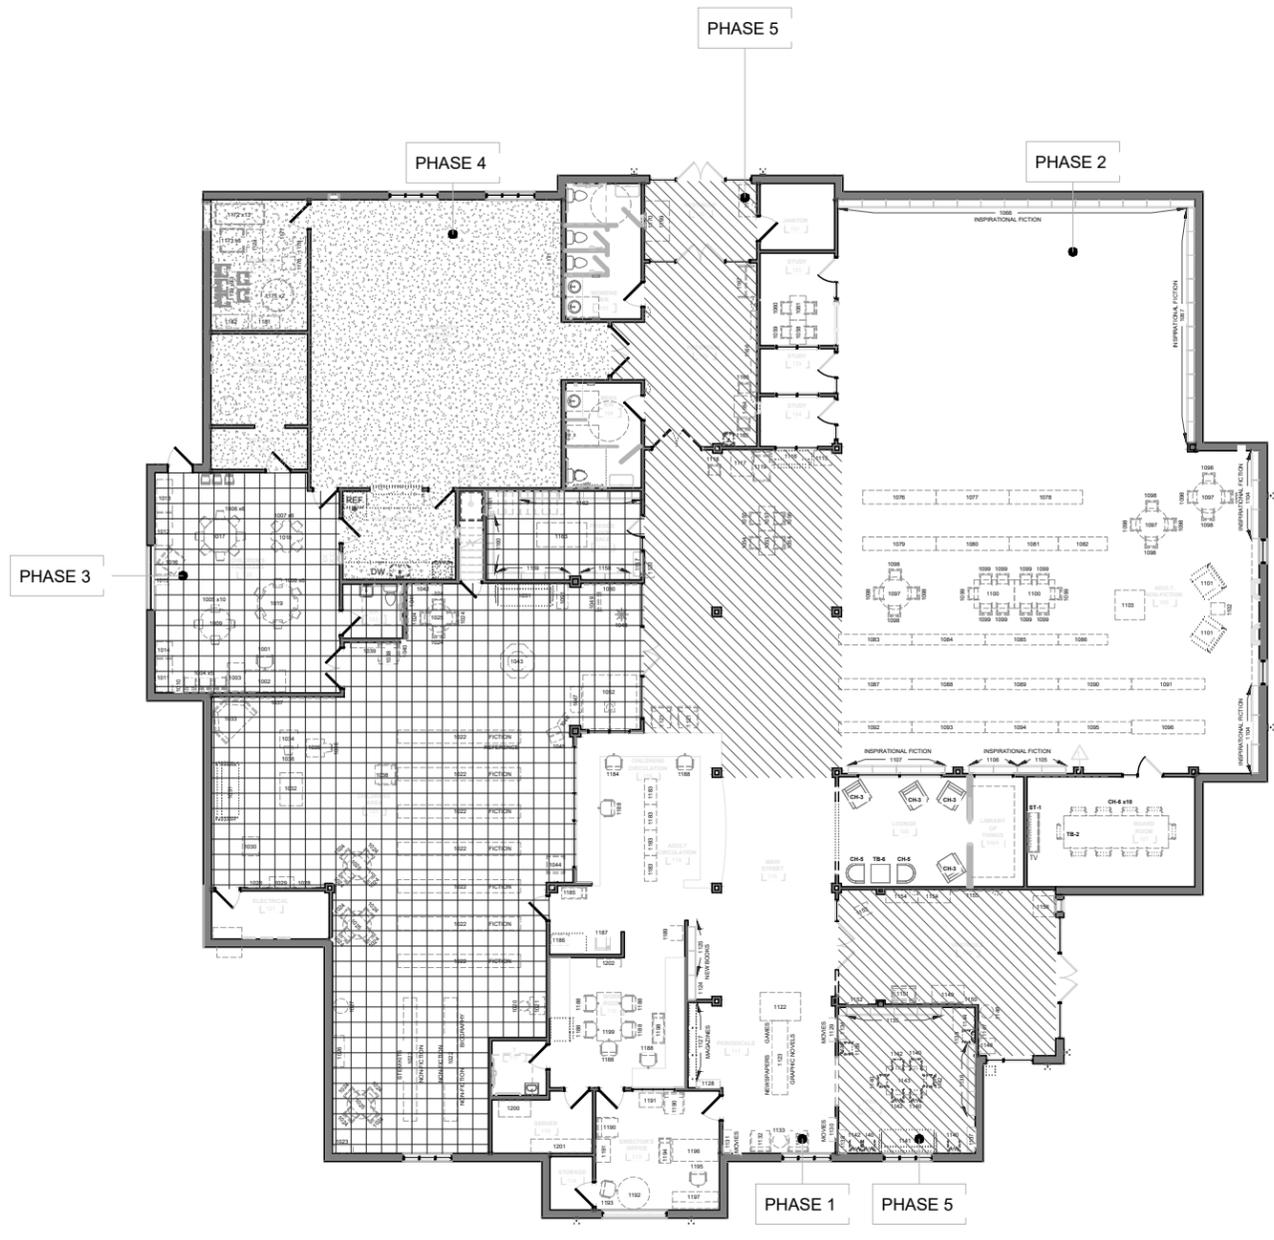

MOVE B1 - COMPLETE

PHASE 1 CONSTRUCTION COMPLETE, START PHASE 2

- NOTES:
- LIBRARY TO REMAIN OPEN
 - NEW FURNITURE DELIVERY DATE TBD - INSTALLED BY OTHERS
 - THE LIBRARY IS SELLING MOST OF THE OLD FURNITURE CALLED OUT FOR DISPOSAL IN THE INVENTORY LIST, THERE MAY BE LESS TO MOVE ON THE MOVE DATE

- MOVER AGENDA:
1. MOVE ALL PHASE 1 FURNITURE BACK IN PLACE PER PLAN
 2. MOVER TO SUPPLY LIBRARY WITH CARTS (APPROX. 1400 LINEAR FT WORTH OF CARTS NEEDED), LIBRARY STAFF TO LOAD BOOKSTORE BOOKS, MOVER TO WRAP CARTS AND MOVE TO OFF-SITE, TEMP. CONTROLLED STORAGE
 3. ALL ADULT NON-FICTION BOOKS AND SHELVING TO MOVE TO OFF-SITE, TEMP. CONTROLLED STORAGE (MOVER TO WRAP BOOKCASES WITH COLLECTION INTACT)
 4. IF NOT SOLD, DISPOSE OF SOFA AND OLD TABLE AND CHAIRS FROM THE NORTH END OF ADULT FICTION/NON-FICTION
 5. LIBRARY TO USE RM 129 FOR INSPIRATIONAL FICTION, STAFF WILL MOVE COLLECTION ON THEIR OWN
 6. MOVE STUDY RMS FURNITURE 133 AND 134 TO MAIN STREET OR STAGE IN BOARD ROOM 107



7222 N. SHADELAND SUITE 170 | INDIANAPOLIS, IN
(317)202.0000 | WWW.RELOCATIONSTRATEGIES.COM

SHERIDAN PUBLIC LIBRARY
103 WEST FIRST STREET
SHERIDAN, IN

MOVE B1 - PHASING PLANS

SCALE: 3/32" = 1'-0"
DRAWN BY: GRB
DATE: 02/02/2026

REVISIONS	
R1: 2/4/26	R6: ...
R2: ...	R7: ...
R3: ...	R8: ...
R4: ...	R9: ...
R5: ...	R10: ...

HAVING REVIEWED AND NOTING ALL REQUIRED CHANGES ON THIS DOCUMENT, THE CLIENT GIVES APPROVAL TO PROCEED AND ACKNOWLEDGES ADDITIONAL CHANGES COULD DELAY THE PROJECT COMPLETION DATE AND MAY INCUR ADDITIONAL SERVICE FEES. IN THE EVENT THE BUILDING SHELL IS SUPPLIED BY OTHERS, ITS ACCURACY REMAINS THE RESPONSIBILITY OF THAT SOURCE. THIS DOCUMENT IS THE PROPERTY OF RELOCATION STRATEGIES. ALTERATION AND/OR DUPLICATION IS PROHIBITED WITHOUT THE WRITTEN CONSENT.

CLIENT APPROVAL:
APPROVAL DATE:





MOVE B2 - EXISTING



MOVE B2 - COMPLETE

CONTINUE PHASE 2

- NOTES:
- LIBRARY TO REMAIN OPEN
 - NEW FURNITURE DELIVERY DATE TBD
 - THE LIBRARY IS SELLING MOST OF THE OLD FURNITURE CALLED OUT FOR DISPOSAL IN THE INVENTORY LIST, THERE MAY BE LESS TO MOVE ON THE MOVE DATE

MOVER AGENDA:

- LIBRARY STAFF TO SWAP INSPIRATIONAL FICTION COLLECTIONS, MOVE ORIGINAL COLLECTION FROM RM 129 BACK TO NORTH PERIMETER SHELVING, MOVE SOUTHERN COLLECTION TO RM 129
- MOVE STUDY ROOM FURNITURE BACK TO RMS 133 AND 134
- MOVE ADULT FICTION COLLECTION FROM SOUTHERN HALF OF RM 105 TO NORTHERN HALF
- EXISTING LOUNGE CHAIRS AND TABLES FROM RM 105 ARE EXPECTED TO BE SOLD, IF STILL ON SITE, DISPOSE
 - TEN (10) CHAIRS ARE TO BE MOVED AND REUSED IN TEEN 112



7222 N. SHADELAND SUITE 170 | INDIANAPOLIS, IN
(317)202.0000 | WWW.RELOCATIONSTRATEGIES.COM

SHERIDAN PUBLIC LIBRARY
103 WEST FIRST STREET
SHERIDAN, IN

MOVE B2 - PHASING PLANS

SCALE: 3/32" = 1'-0"
DRAWN BY: GRB
DATE: 02/02/2026

REVISIONS	
R1: 2/4/26	R6: ...
R2: ...	R7: ...
R3: ...	R8: ...
R4: ...	R9: ...
R5: ...	R10: ...

HAVING REVIEWED AND NOTING ALL REQUIRED CHANGES ON THIS DOCUMENT, THE CLIENT GIVES APPROVAL TO PROCEED AND ACKNOWLEDGES ADDITIONAL CHANGES COULD DELAY THE PROJECT COMPLETION DATE AND MAY INCUR ADDITIONAL SERVICE FEES. IN THE EVENT THE BUILDING SHELL IS SUPPLIED BY OTHERS, ITS ACCURACY REMAINS THE RESPONSIBILITY OF THAT SOURCE. THIS DOCUMENT IS THE PROPERTY OF RELOCATION STRATEGIES. ALTERATION AND/OR DUPLICATION IS PROHIBITED WITHOUT THE WRITTEN CONSENT.


CLIENT APPROVAL:

APPROVAL DATE:





MOVE C - EXISTING

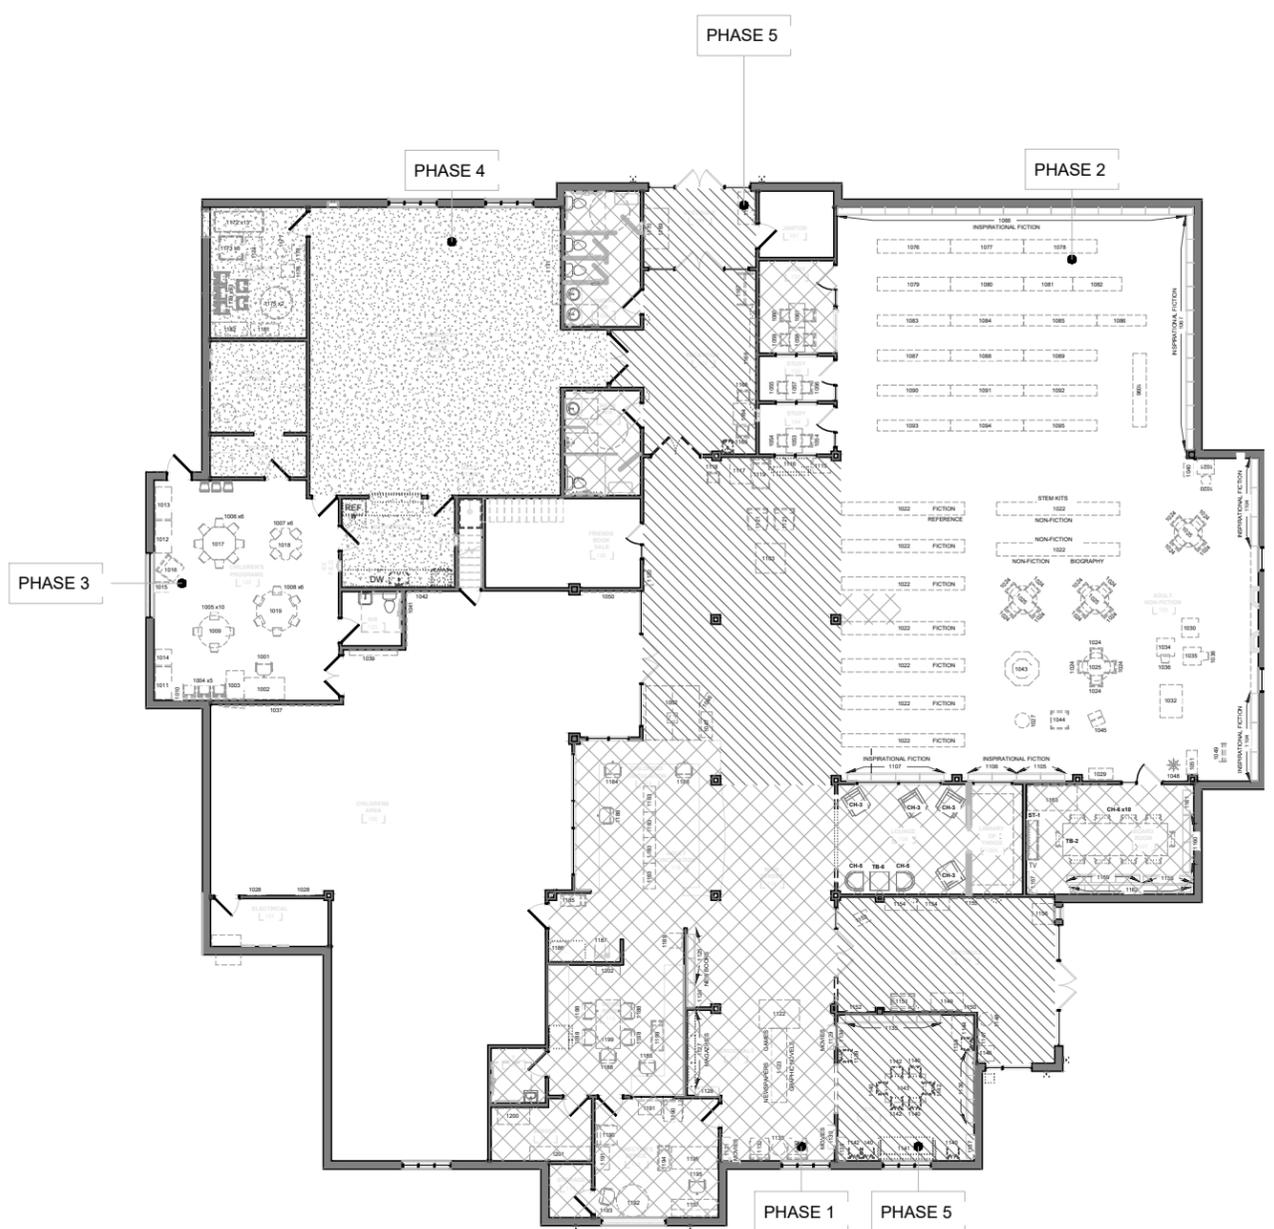

MOVE C - COMPLETE



7222 N. SHADELAND SUITE 170 | INDIANAPOLIS, IN
(317)202.0000 | WWW.RELOCATIONSTRATEGIES.COM

SHERIDAN PUBLIC LIBRARY
103 WEST FIRST STREET
SHERIDAN, IN

MOVE C - PHASING PLANS

SCALE: 3/32" = 1'-0"
DRAWN BY: GRB
DATE: 02/02/2026

REVISIONS	
R1: 2/4/26	R6: ...
R2: ...	R7: ...
R3: ...	R8: ...
R4: ...	R9: ...
R5: ...	R10: ...

HAVING REVIEWED AND NOTING ALL REQUIRED CHANGES ON THIS DOCUMENT, THE CLIENT GIVES APPROVAL TO PROCEED AND ACKNOWLEDGES ADDITIONAL CHANGES COULD DELAY THE PROJECT COMPLETION DATE AND MAY INCUR ADDITIONAL SERVICE FEES. IN THE EVENT THE BUILDING SHELL IS SUPPLIED BY OTHERS, ITS ACCURACY REMAINS THE RESPONSIBILITY OF THAT SOURCE. THIS DOCUMENT IS THE PROPERTY OF RELOCATION STRATEGIES. ALTERATION AND/OR DUPLICATION IS PROHIBITED WITHOUT THE WRITTEN CONSENT.

CLIENT APPROVAL:
APPROVAL DATE:




PHASE 2 CONSTRUCTION COMPLETE, BEGIN PHASE 3
NOTES:


- LIBRARY TO REMAIN OPEN
- NEW FURNITURE DELIVERY DATE TBD - INSTALLED BY OTHERS
- THE LIBRARY IS SELLING MOST OF THE OLD FURNITURE CALLED OUT FOR DISPOSAL IN THE INVENTORY LIST, THERE MAY BE LESS TO MOVE ON THE MOVE DATE

MOVER AGENDA:

1. MOVE FURNITURE FROM CHILDREN'S TO RM 105
 - 1.1. IF NOT SOLD, DISPOSE OF SOFAS, CHAIRS AND BOOKCASES THAT WILL NOT BE REUSED
 - 1.2. LOG CABIN TO BE MOVED BY CIRC DESK
2. MOVE AND STAGE ALL FRIENDS BOOKSTORE FURNITURE IN RM 107
3. FURNITURE IN PROGRAMS 122 TO REMAIN

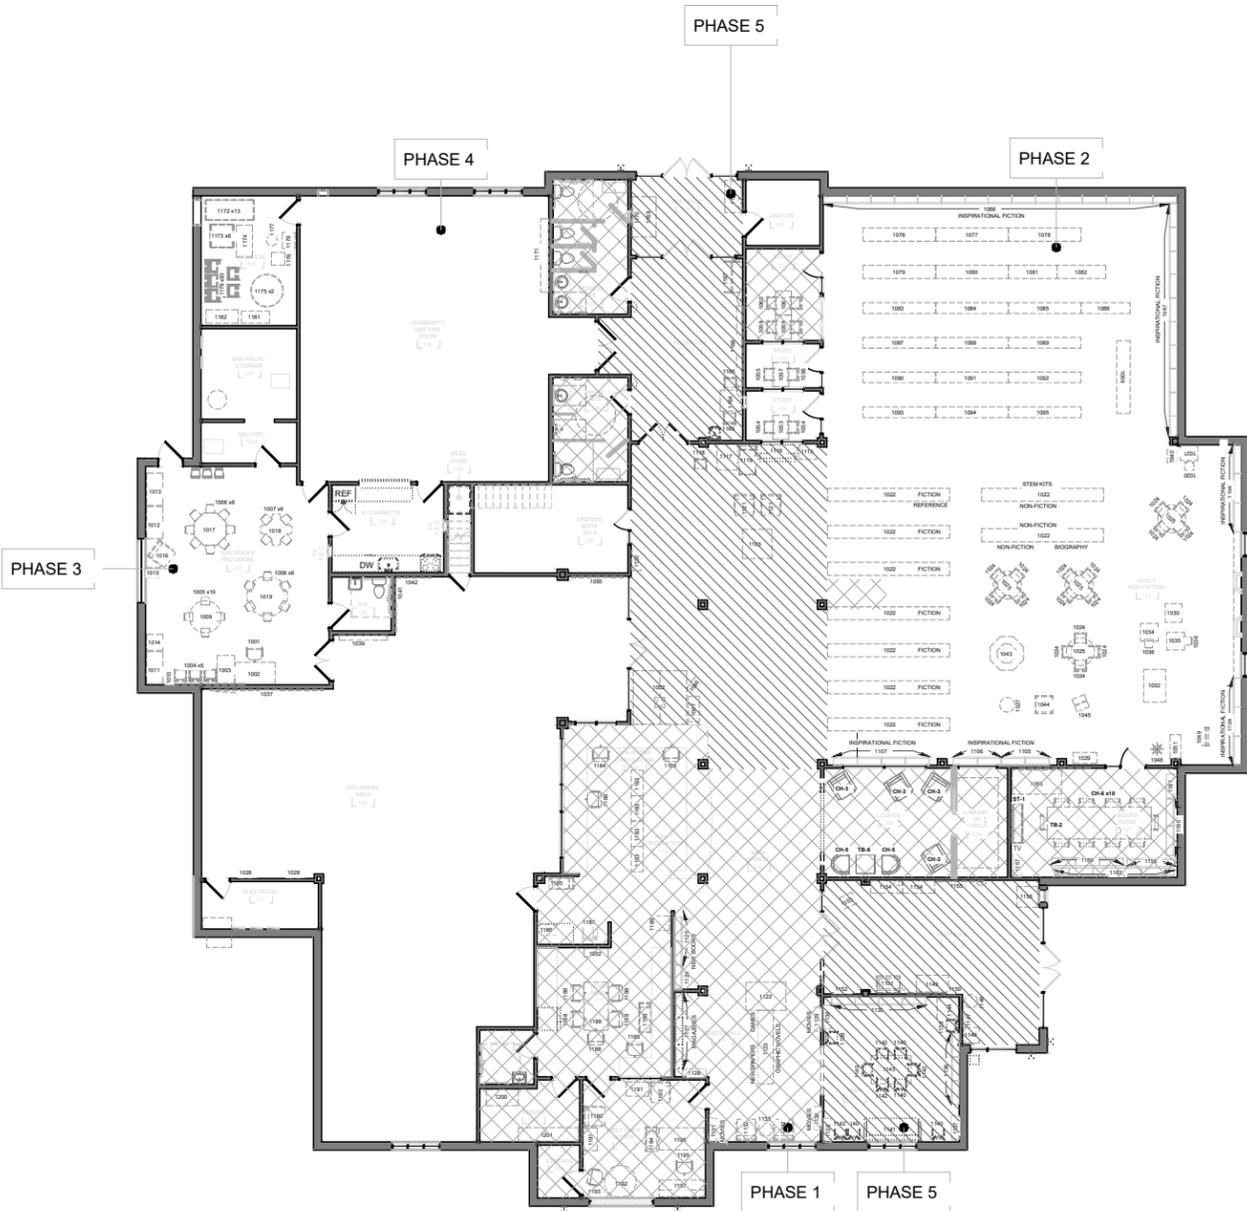

MOVE D - EXISTING

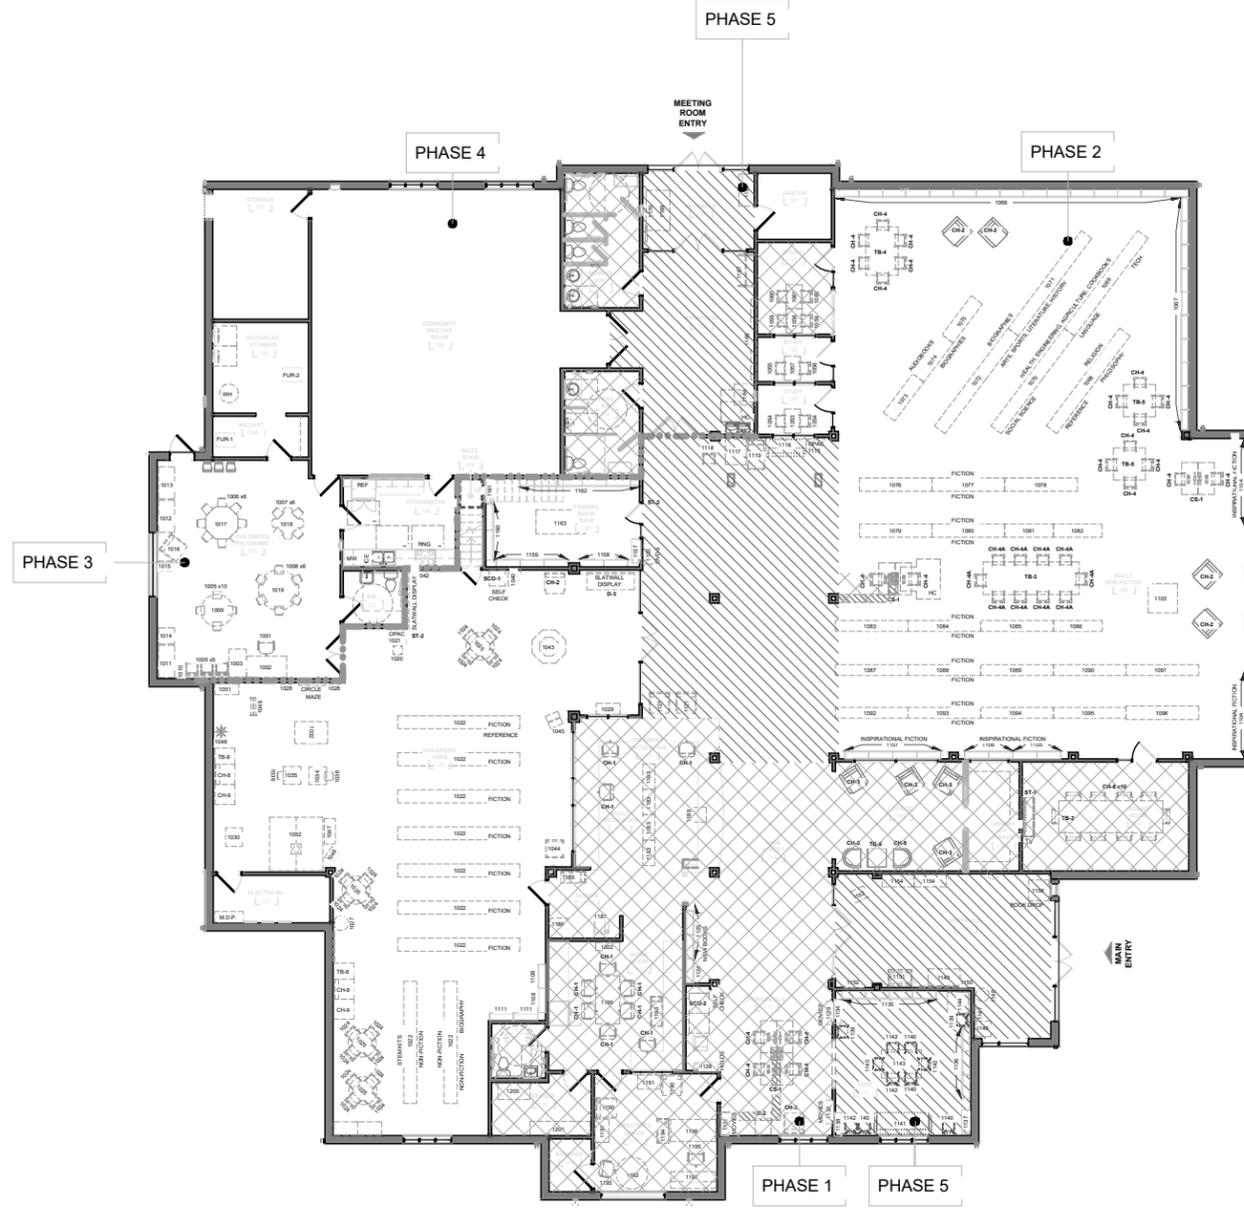

MOVE D - COMPLETE

PHASE 3 CONSTRUCTION COMPLETE, BEGIN PHASE 4

NOTES:

- LIBRARY TO REMAIN OPEN
- NEW FURNITURE DELIVERY DATE TBD - INSTALLED BY OTHERS
- THE LIBRARY IS SELLING MOST OF THE OLD FURNITURE CALLED OUT FOR DISPOSAL IN THE INVENTORY LIST, THERE MAY BE LESS TO MOVE ON THE MOVE DATE

MOVER AGENDA:

1. PUT ALL EXISTING FURNITURE BACK INTO CHILDREN'S AND FRIENDS BOOKSTORE
 - 1.1. MOVERS TO MOVE BACK THE BOOKSTORE COLLECTION, LIBRARY STAFF TO UNLOAD FROM CARTS BACK ONTO SHELVES
2. MOVE ADULT FICTION BACK INTO PLACE IN SOUTHERN HALF OF RM 105
 - 2.1. MOVE BACK THE ADULT NON-FICTION COLLECTION FROM TEMP. STORAGE
3. IF NOT SOLD, DISPOSE OF ANY REMAINING OLD COMMUNITY ROOM TABLES AND CHAIRS

SCALE: 3/32" = 1'-0"

DRAWN BY: GRB

DATE: 02/02/2026

REVISIONS

R1: 2/4/26	R6: ...
R2: ...	R7: ...
R3: ...	R8: ...
R4: ...	R9: ...
R5: ...	R10: ...

HAVING REVIEWED AND NOTING ALL REQUIRED CHANGES ON THIS DOCUMENT, THE CLIENT GIVES APPROVAL TO PROCEED AND ACKNOWLEDGES ADDITIONAL CHANGES COULD DELAY THE PROJECT COMPLETION DATE AND MAY INCUR ADDITIONAL SERVICE FEES. IN THE EVENT THE BUILDING SHELL IS SUPPLIED BY OTHERS, ITS ACCURACY REMAINS THE RESPONSIBILITY OF THAT SOURCE. THIS DOCUMENT IS THE PROPERTY OF RELOCATION STRATEGIES. ALTERATION AND/OR DUPLICATION IS PROHIBITED WITHOUT THE WRITTEN CONSENT.


CLIENT APPROVAL:

APPROVAL DATE:





MOVE E - EXISTING

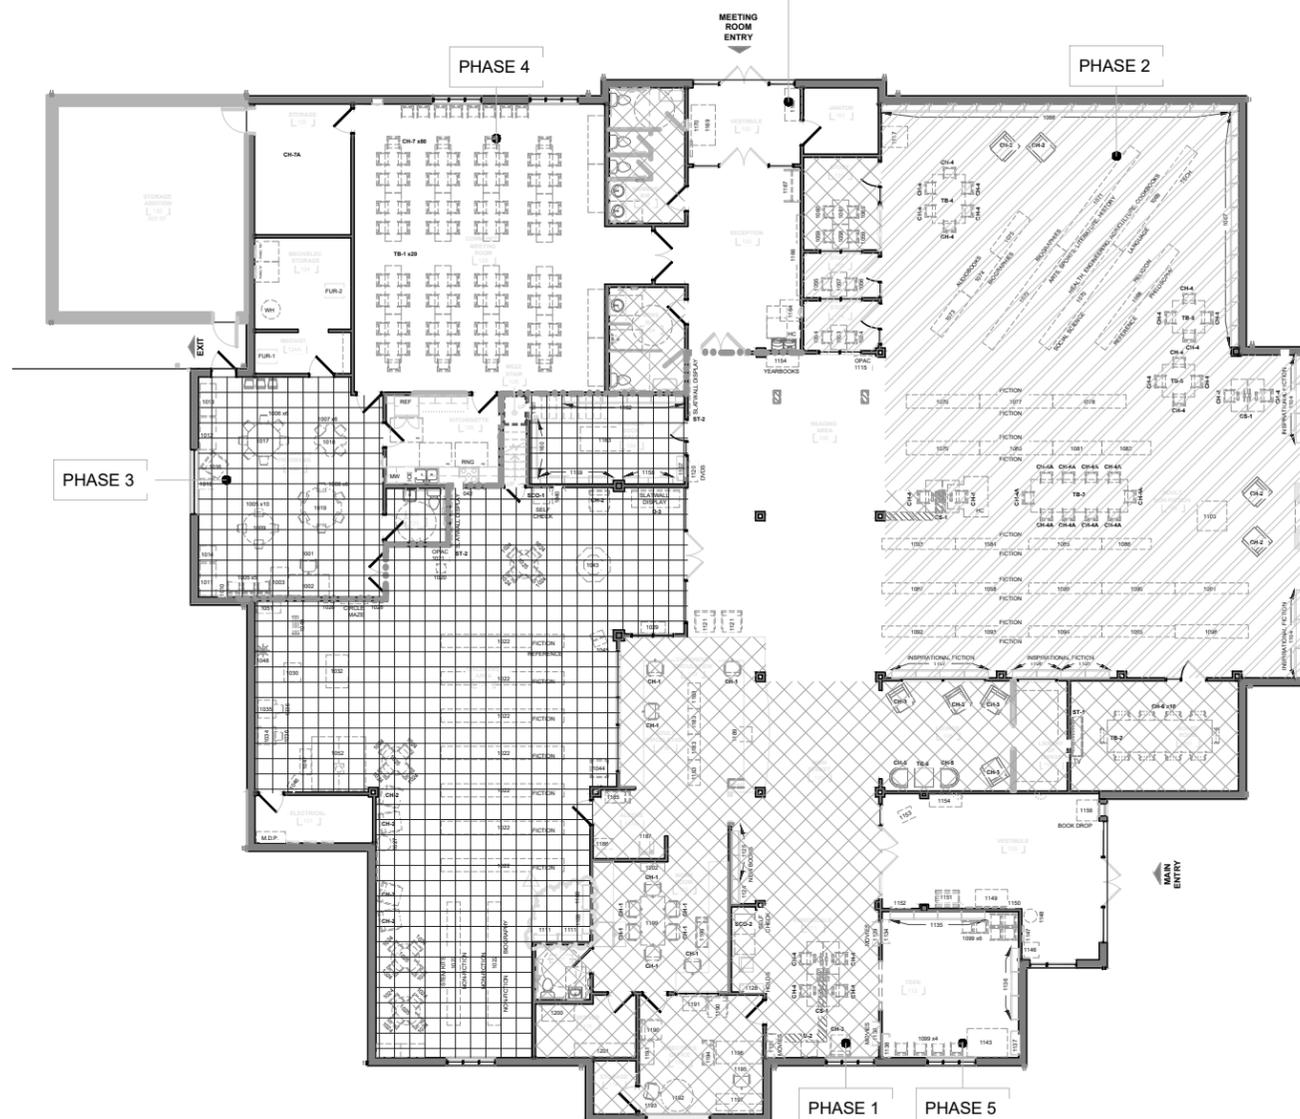

MOVE E - COMPLETE

PHASE 4 CONSTRUCTION COMPLETE, BEGIN PHASE 5

NOTES:

- LIBRARY TO REMAIN OPEN
- NEW FURNITURE DELIVERY DATE TBD - INSTALLED BY OTHERS
- THE LIBRARY IS SELLING MOST OF THE OLD FURNITURE CALLED OUT FOR DISPOSAL IN THE INVENTORY LIST, THERE MAY BE LESS TO MOVE ON THE MOVE DATE

MOVER AGENDA

1. DISPOSE OF ANY OLD TEEN FURNITURE NOT SOLD, SHIFT TABLE AND 10 CHAIRS TO THE PERIMETER OF THE ROOM FOR RUG INSTALL (BY GC)
2. MOVE TROPHY CASE FROM 109 TO READING AREA 106
3. MOVE MODEL DISPLAY FROM READING AREA 106 TO NORTH WEST CORNER OF 105
4. MOVE/DISPOSE ANY OTHER EXISTING FURNITURE IF/AS NEEDED

NO OTHER EXISTING FURNITURE MOVES ANTICIPATED UPON COMPLETION OF PHASE 5

SCALE: 3/32" = 1'-0"

DRAWN BY: GRB

DATE: 02/02/2026

REVISIONS

R1: 2/4/26	R6: ...
R2: ...	R7: ...
R3: ...	R8: ...
R4: ...	R9: ...
R5: ...	R10: ...

HAVING REVIEWED AND NOTING ALL REQUIRED CHANGES ON THIS DOCUMENT, THE CLIENT GIVES APPROVAL TO PROCEED AND ACKNOWLEDGES ADDITIONAL CHANGES COULD DELAY THE PROJECT COMPLETION DATE AND MAY INCUR ADDITIONAL SERVICE FEES. IN THE EVENT THE BUILDING SHELL IS SUPPLIED BY OTHERS, ITS ACCURACY REMAINS THE RESPONSIBILITY OF THAT SOURCE. THIS DOCUMENT IS THE PROPERTY OF RELOCATION STRATEGIES. ALTERATION AND/OR DUPLICATION IS PROHIBITED WITHOUT THE WRITTEN CONSENT.

CLIENT APPROVAL:

APPROVAL DATE:

