

# ADDENDUM TWO

Fort Wayne Community Schools

**MARTINRILEY** architects/engineers  
221 West Baker Street  
Fort Wayne, Indiana 46802  
260-422-7994

Commission No.: F25081

Addendum Date: February 16, 2026

**Conditions:** The following clarifications, amendments, additions, deletions, revisions and modifications are a part of the contract documents and change the original documents only in the manner and to the extent stated.

Copies of the Addendum shall be made part of the contract sets of drawings and specifications.

## CHANGES TO DRAWINGS:


Sheet SS C214B, **REPLACE** with the attached revised sheet SS C214B.

Sheet C801, **REPLACE** with the attached revised sheet C801.

## ATTACHMENTS:

Sheet NS C211 Door 1 Detail Callouts  
Sheet C801 Site Details


**END OF ADDENDUM NUMBER TWO**

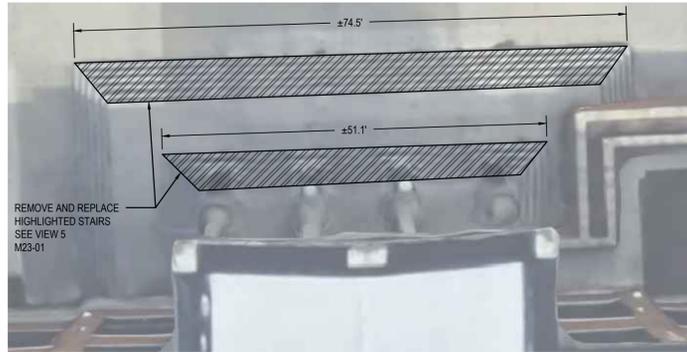


**4** Partial Site Plan - Door 1 Stair  
NTS




**5** Partial Site Plan - Door 1 STAIR Repair  
NTS

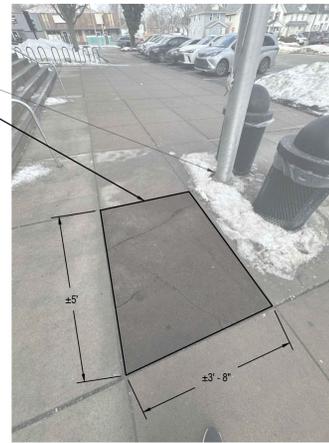


**6** Partial Site Plan - Door 1 Pavement Repair  
NTS

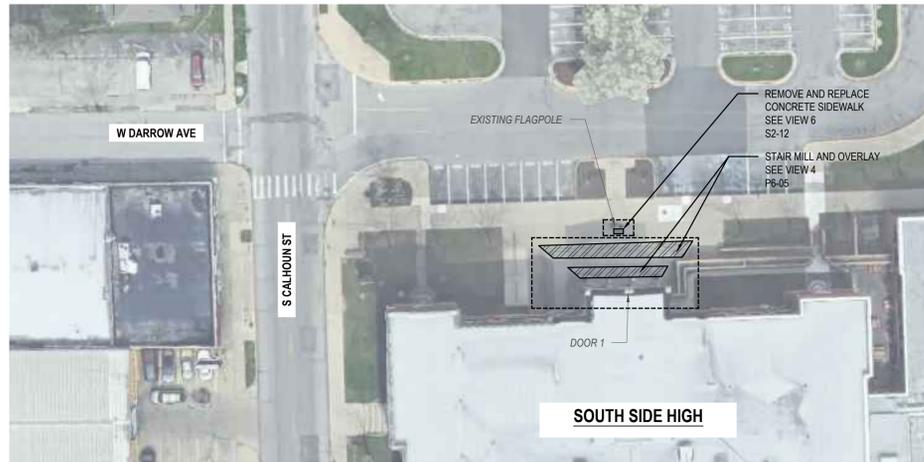

**3** Partial Site Context Map - Door 1  
NTS

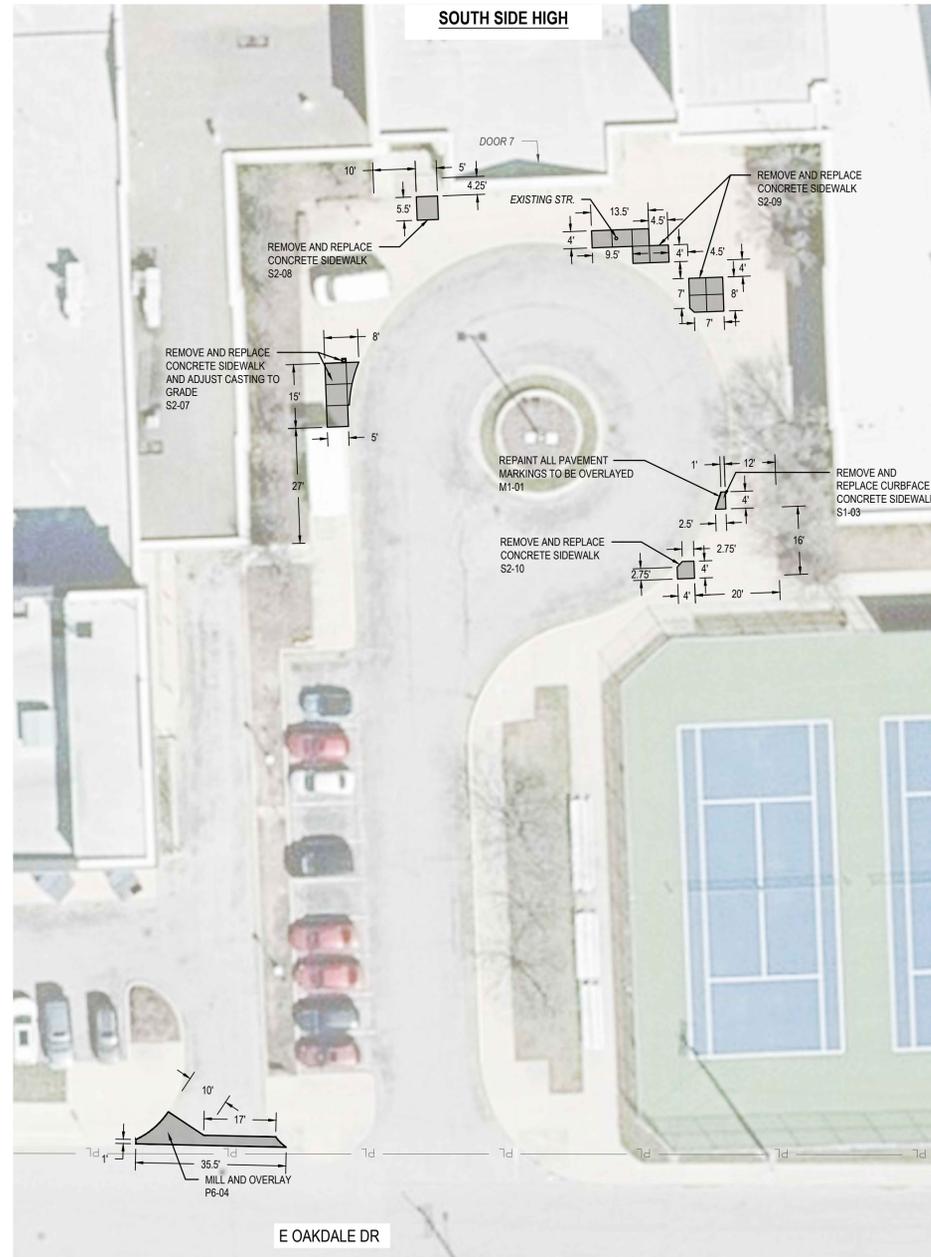

**1** Partial Site Plan  
1" = 20'

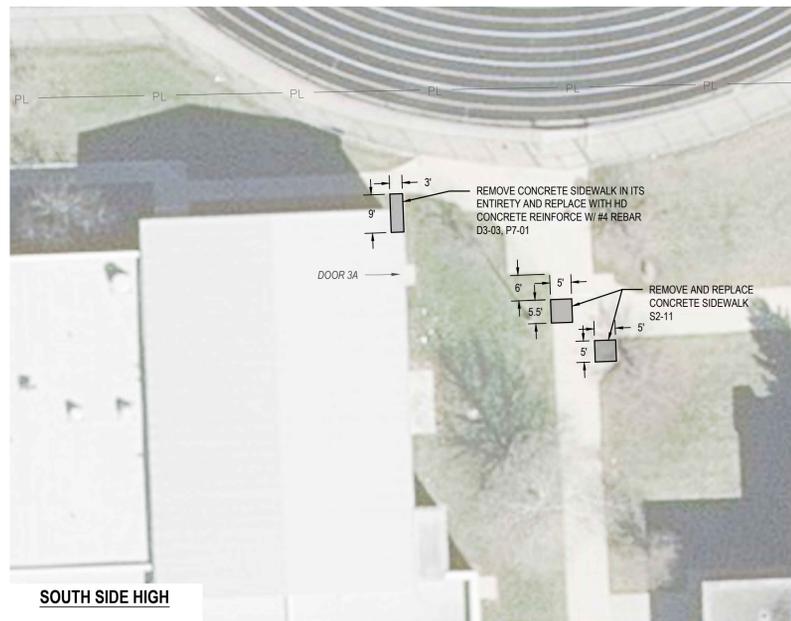

**2** Partial Site Plan - Door 3A  
1" = 20'

- GENERAL CONSTRUCTION NOTES
1. QUANTITY TABLES PROVIDED FOR GENERAL USE AND REFERENCE ONLY. CONTRACTOR SHALL FIELD VERIFY ALL REMOVAL OR REPLACEMENT AREAS, QUANTITIES AND LIMITS OF CONSTRUCTION PRIOR TO THE START OF OPERATIONS AT EACH SITE.
  2. CONTRACTOR SHALL USE WHATEVER MEANS NECESSARY TO PROTECT ALL PAVEMENT, PAVEMENT MARKINGS, WALKS, GRASS AREAS, BUILDINGS, ETC. DURING CONSTRUCTION. ALL DAMAGED PROPERTY CAUSED BY CONSTRUCTION ACTIVITIES SHALL BE REPAIRED/REPLACED BY THE CONTRACTOR AT NO ADDITIONAL COST TO THE OWNER.
  3. PRIOR TO THE START OF DEMOLITION, CONTRACTOR SHALL PLACE APPROPRIATE EROSION CONTROL MEASURES TO ENSURE NO SEDIMENT LEAVES SITE OR ENTERS EXISTING ON-SITE OR PUBLIC STORM SYSTEM.
  4. CONTRACTOR SHALL PROVIDE CONCRETE WASHOUT FACILITIES OF ADEQUATE CAPACITY IN ACCORDANCE WITH PROJECT REQUIREMENTS. THE CONCRETE WASHOUT SHALL BE LOCATED AS FAR FROM SURFACE WATERS AS PRACTICAL, AND SHALL BE ABLE TO CONTAIN ALL LIQUID AND SOLID MATERIAL FROM CONCRETE TRUCK OR MIXER WASHING OPERATIONS WITHOUT CONTACTING OR CONTAMINATING THE GROUND.
  5. ALL AFFECTED PAVEMENT MARKINGS SHALL BE RESTORED UPON COMPLETION OF CONSTRUCTION ACTIVITIES. PRIOR TO THE START OF CONSTRUCTION, CONTRACTOR SHALL DOCUMENT TYPE, LOCATION AND FUNCTION OF EXISTING PAVEMENT MARKINGS (TRAFFIC, PEDESTRIAN, PLAYGROUND, ETC) WITHIN CONSTRUCTION LIMITS UNLESS SPECIFICALLY NOTED ON THE DRAWINGS. IF PAVEMENT MARKINGS AT START OF CONSTRUCTION DIFFER FROM PLANS NOTIFY ENGINEER AND OBTAIN OWNER APPROVAL PRIOR TO PLACEMENT.
  6. UNLESS SPECIFICALLY CALLED OUT AS SALVAGE MATERIALS FOR RE-USE OR RETURN TO OWNER, ALL CONSTRUCTION DEBRIS BECOMES PROPERTY OF THE CONTRACTOR. REMOVE ALL DEMOLISHED AND WASTE MATERIALS, AND LEGALLY DISPOSE OF THEM OFF THE OWNER'S PROPERTY.
  7. CONTRACTOR TO MATCH NEW CONSTRUCTION TO EXISTING GRADES AND PROVIDE POSITIVE DRAINAGE TO INLETS OR OTHER INTENDED OUTLET.
  8. CONTRACTOR SHALL RESTORE ALL DISTURBED GRASS AREAS BY PLACING TOPSOIL, IF REQUIRED, GRADING TO RE-ESTABLISH POSITIVE DRAINAGE, SEEDING AND MULCH.
  9. ALL ASPHALT AND CONCRETE REMOVAL AREAS SHALL BE SAW-CUT IN CLEAN STRAIGHT LINES.
  10. WHEN REPLACING/PLACING NEW CONCRETE ADJACENT TO EXISTING CONCRETE, THE CONTRACTOR SHALL USE #4 SMOOTH GREASED DOWELS AT 24" O.C. PLACED AT THE MIDPOINT OF EXISTING CONCRETE THICKNESS BETWEEN THE TWO AREAS.
  11. CONTRACTOR SHALL PROVIDE 3" EXPANSION JOINT BETWEEN ALL EXISTING AND NEW POURS, AT BEGINNING AND END OF EACH DAY'S POUR, AND A MINIMUM OF 1" EXPANSION JOINT PER SOFT MAXIMUM OF CONTINUOUS SIDEWALK.
  12. CONTRACTOR SHALL PROVIDE 3" EXPANSION JOINTS BETWEEN ALL EXISTING STRUCTURES/BUILDINGS AND NEW CONCRETE CONSTRUCTION. ALL JOINTS AT SCHOOL BUILDING SHALL BE CAULKED WITH WATER TIGHT MATERIAL.
  13. CONTRACTOR SHALL ADJUST ALL CASTINGS TO GRADE WITHIN OR ADJACENT TO ALL REPLACEMENT OR REPAIR AREAS (CB) PROVIDE POSITIVE DRAINAGE TO INLETS.
  14. FORT WAYNE COMMUNITY SCHOOLS WILL PROVIDE ALL STENCILS AND PAINT FOR PAVEMENT STRIPING.
  15. SEE REFERENCED DETAILS PER SHEET AND TYPICAL DETAILS FOR ADDITIONAL CONSTRUCTION NOTES.
  16. CONTRACTOR TO COORDINATE STAGING WITH OTHER CONTRACTORS/CONSTRUCTION IN THE AREA.

QUANTITY SUMMARY  
(FOR INFORMATION PURPOSES ONLY)

LEGEND

Site Code	SS	South Side High School	Repair Code	Repair Quantity	Unit	Repair Description
SSD1-01	D1	2	LF			Concrete Curb Removal
SSD3-01	D3	7	SY			Concrete Pavement Removal
SSD3-02	D3	25	SY			Concrete Pavement Removal
SSD3-03	D3	3	SY			Concrete Pavement Removal
SSD16-01	D16	8	CY			6" Topsoil Removal
SSE1-01	E1	9	CY			Grading/Earthwork
SSE1-02	E1	6	CY			Grading/Earthwork
SSM1-01	M1	1	LS			Pavement Striping
SSM20-01	M20	1	LS			Concrete Ramp w/ handrails
SSM20-02	M20	1	LS			Concrete Ramp w/ handrails
SSP6-01	P6	455	SY			2" Mill and Overlay
SSP6-02	P6	267	SY			2" Mill and Overlay
SSP6-03	P6	572	SY			2" Mill and Overlay
SSP6-04	P6	13	SY			2" Mill and Overlay
SSP7-01	P7	3	SY			New Concrete Section with Compacted Stone Base and Grade
SSS1-01	S1	4	SY			Remove and Replace Curbside Walk
SSS1-02	S1	3	SY			Remove and Replace Curbside Walk
SSS1-03	S1	1	SY			Remove and Replace Curbside Walk
SSS2-01	S2	32	SY			Remove and Replace Sidewalk
SSS2-02	S2	5	SY			Remove and Replace Sidewalk
SSS2-03	S2	7	SY			Remove and Replace Sidewalk
SSS2-04	S2	3	SY			Remove and Replace Sidewalk
SSS2-05	S2	9	SY			Remove and Replace Sidewalk
SSS2-06	S2	9	SY			Remove and Replace Sidewalk
SSS2-07	S2	10	SY			Remove and Replace Sidewalk
SSS2-08	S2	3	SY			Remove and Replace Sidewalk
SSS2-09	S2	17	SY			Remove and Replace Sidewalk
SSS2-10	S2	2	SY			Remove and Replace Sidewalk
SSS2-11	S2	6	SY			Remove and Replace Sidewalk
SSS2-12	S2	3	SY			Remove and Replace Sidewalk
SSS5-01	S5	2	LF			Concrete Curb
SSM23-01	M23	642	LF			Concrete Stair Repair



221 West Baker Street  
Fort Wayne, Indiana 46802

TEL. 260.422.7994  
FAX. 260.426.2067

ALL DESIGN, DESIGN, ARRANGEMENT AND PLANS INDICATED OR REPRESENTED BY THIS DRAWING ARE OWNED BY AND THE PROPERTY OF MARTIN RILEY, INC. AND SHALL REMAIN THE PROPERTY OF MARTIN RILEY, INC. AND SHALL NOT BE REPRODUCED OR TRANSMITTED IN ANY FORM OR BY ANY MEANS, ELECTRONIC OR MECHANICAL, INCLUDING PHOTOCOPYING, RECORDING, OR BY ANY INFORMATION STORAGE AND RETRIEVAL SYSTEM, WITHOUT THE WRITTEN PERMISSION OF MARTIN RILEY, INC. THE USER OF THIS DRAWING SHALL BE RESPONSIBLE FOR OBTAINING ALL NECESSARY PERMITS AND APPROVALS FROM THE APPROPRIATE AGENCIES AND AUTHORITIES. THE USER SHALL BE RESPONSIBLE FOR OBTAINING ALL NECESSARY PERMITS AND APPROVALS FROM THE APPROPRIATE AGENCIES AND AUTHORITIES. THE USER SHALL BE RESPONSIBLE FOR OBTAINING ALL NECESSARY PERMITS AND APPROVALS FROM THE APPROPRIATE AGENCIES AND AUTHORITIES. THE USER SHALL BE RESPONSIBLE FOR OBTAINING ALL NECESSARY PERMITS AND APPROVALS FROM THE APPROPRIATE AGENCIES AND AUTHORITIES.

REVISION	DATE
ADDENDUM TWO	2026-02-16

DRAWN BY: CAS/JNT  
COMMISSION NUMBER: F25081

REVIEWED BY: JLB  
DATE: 2026-01-29

**SS C214B**

SOUTH SIDE HIGH SCHOOL  
3601 CALHOUN ST

A New Construction Project For :

**FWCS 2026 SITE AND TRAFFIC PPI**

1200 S. Clinton Street  
Fort Wayne, IN 46802

A New Construction Project For :

**FWCS 2026 SITE AND TRAFFIC PPI**


1200 S. Clinton Street  
Fort Wayne, IN 46802




221 West Baker Street  
Fort Wayne, Indiana 46802

TEL. 260.422.7994  
FAX. 260.426.2067


ALL DESIGN, DESIGN ARRANGEMENT AND PLANS INDICATED OR REPRESENTED BY THIS DRAWING ARE CONSIDERED TO BE THE PROPERTY OF MARTIN RILEY, INC. AND SHALL BE LOANED TO THE CLIENT FOR THE PROJECT ONLY. NO PART OF THIS DRAWING SHALL BE REPRODUCED OR TRANSMITTED IN ANY FORM OR BY ANY MEANS, ELECTRONIC OR MECHANICAL, INCLUDING PHOTOCOPYING, RECORDING, OR BY ANY INFORMATION STORAGE AND RETRIEVAL SYSTEM, WITHOUT THE WRITTEN PERMISSION OF MARTIN RILEY, INC. THE CLIENT AND CONTRACTOR SHALL BE RESPONSIBLE FOR OBTAINING ALL NECESSARY PERMITS AND APPROVALS FROM ALL APPLICABLE AGENCIES. THE CLIENT AND CONTRACTOR SHALL BE RESPONSIBLE FOR OBTAINING ALL NECESSARY PERMITS AND APPROVALS FROM ALL APPLICABLE AGENCIES. THE CLIENT AND CONTRACTOR SHALL BE RESPONSIBLE FOR OBTAINING ALL NECESSARY PERMITS AND APPROVALS FROM ALL APPLICABLE AGENCIES. THE CLIENT AND CONTRACTOR SHALL BE RESPONSIBLE FOR OBTAINING ALL NECESSARY PERMITS AND APPROVALS FROM ALL APPLICABLE AGENCIES.

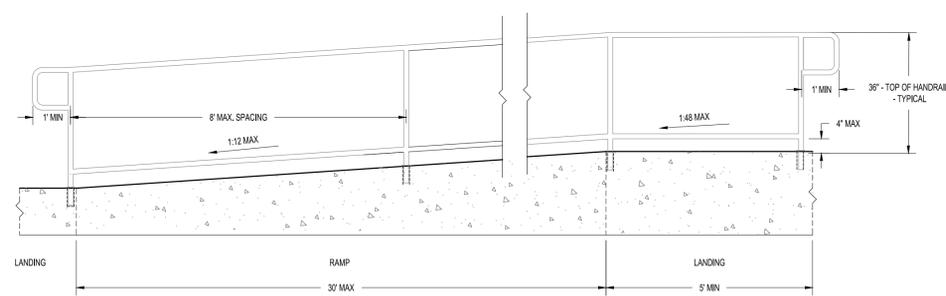

**2** Typ. Ramp and Landing With Rails  
NTS

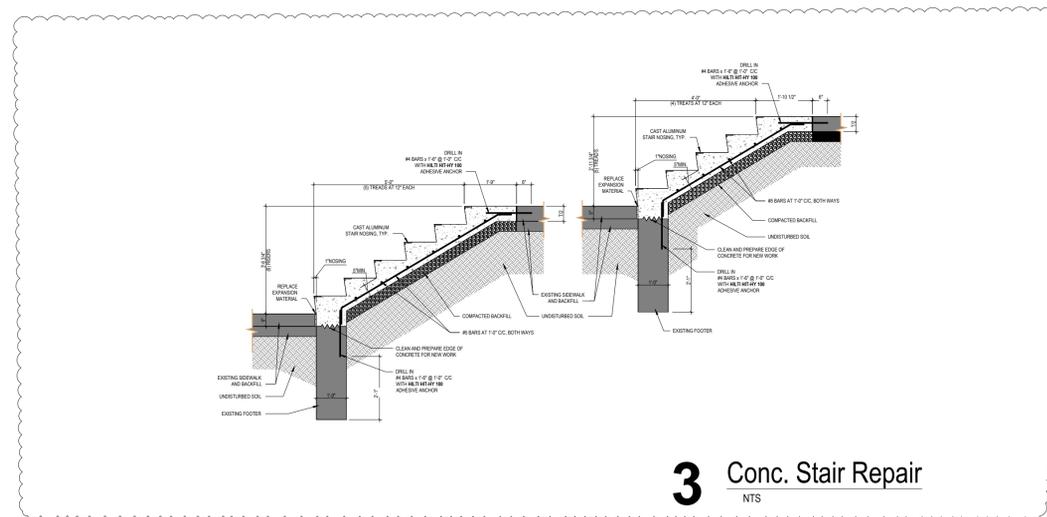

**3** Conc. Stair Repair  
NTS

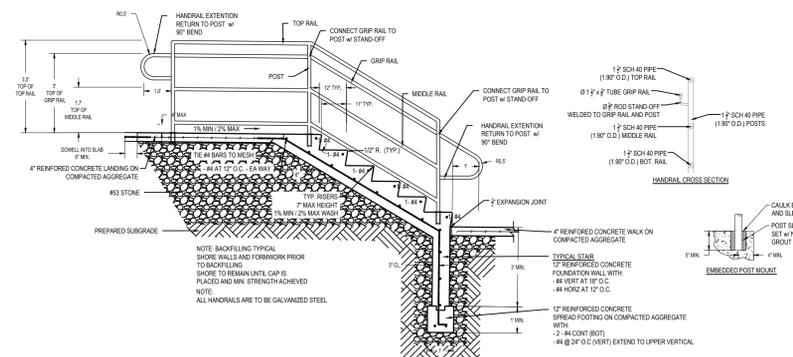

**1** Typ. Landing and Stair With Rails  
NTS

REVISION	DATE
ADDENDUM TWO	2026-02-16

DRAWN BY:	CAS/UNT	REVIEWED BY:	JLB
COMMISSION NUMBER:	F25081	DATE:	2026-01-29

**C801**

SITE DETAILS