

ADDENDUM NO. 3  
To the Contract Document and Project Specifications for the

**South Side Athletic Annex Baseball and Locker Improvements  
Fort Wayne, Indiana  
April 6, 2026**

To: All holders of the contract documents for the above project.

The items in this addendum are to become a part of the original documents as if included therein. The remainder of the original contract document is to remain in its entirety. This Addendum modifies the Contract Documents and Specifications as follows:

- Part 1 – General Clarifications
- Part 2 – Specifications
- Part 3 – Construction Drawings/Details
- Part 4 – Questions

**PART 1 – GENERAL CLARIFICATIONS**


1. This addendum includes plan and specification updates listed below.

**PART 2 – SPECIFICATIONS (Replace - See Attached)**


1. SECTION 322113 – CHAIN LINK FENCES AND GATES  
**REVISED:** Section 3.1.E - Line posts spacing revised from 96 inches o.c. to 120 inches o.c.

**PART 3 – CONSTRUCTION DRAWING / DETAILS (Replace - See Attached)**

1. Plan Sheet C1.3 – Site Demolition Sheet  
**REVISED:** Keynote #20 updated to clarify that FWCS will be responsible for tree removal. The Contractor shall remove the remaining root ball, backfill, and restore the area.

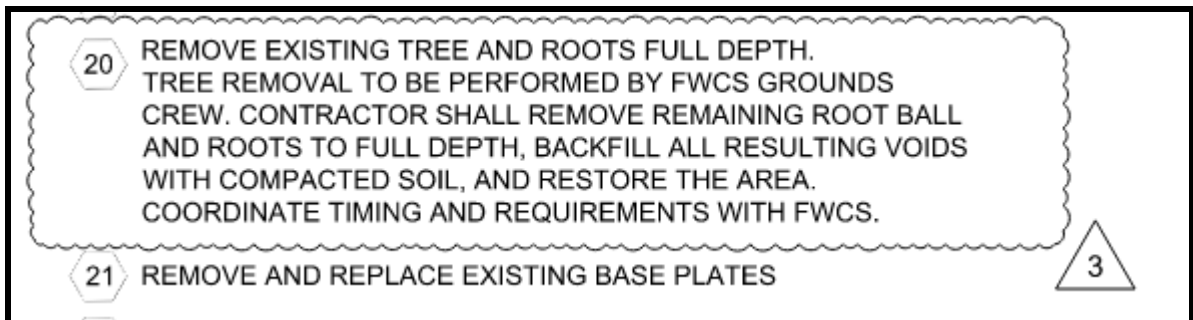


2. Plan Sheet C2.1 – Site Dimensional and Landscape Plan  
**ADDED:** Viewport and callout indicating replacement of the existing standard latch at the double gate adjacent to the locker room and restroom building with a new strong-arm gate latch.

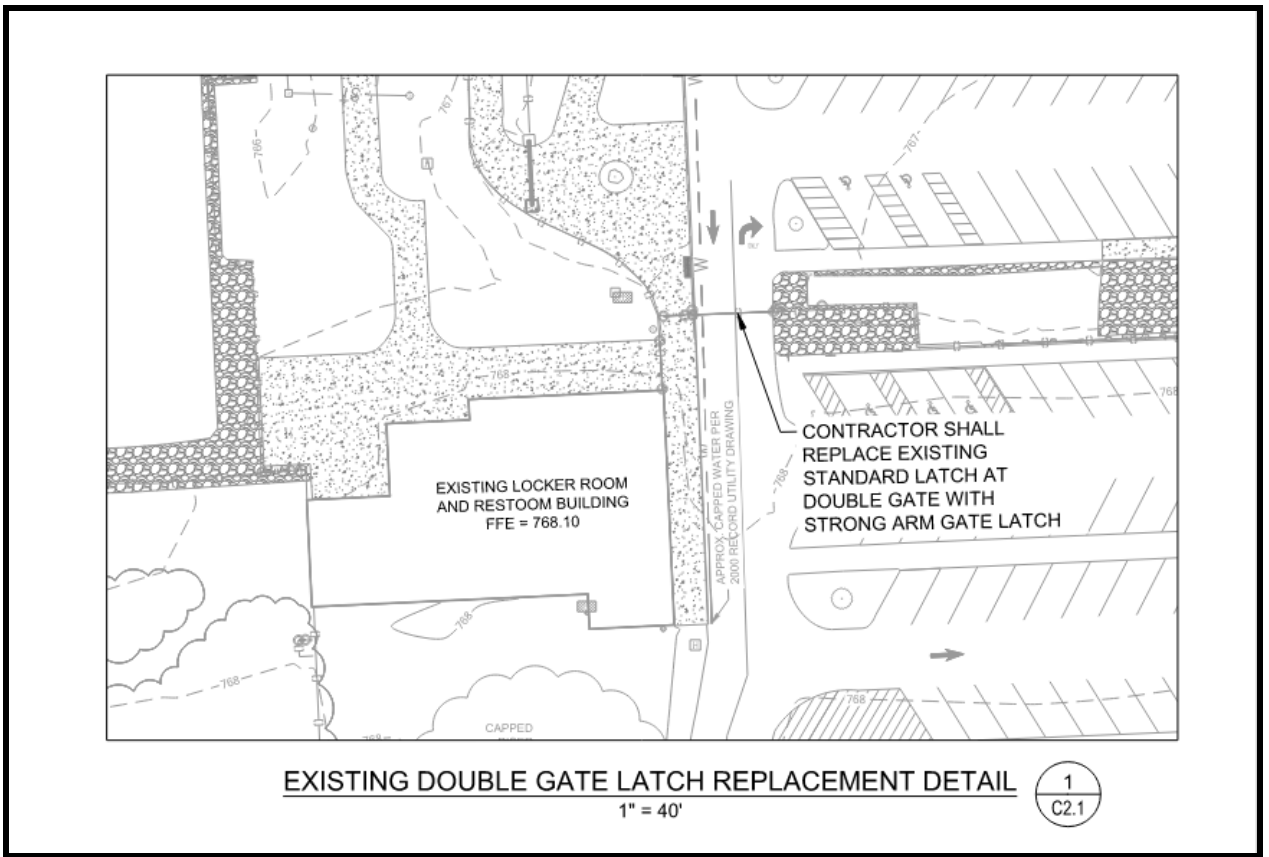

3. Plan Sheet C7.2 – Site Details Sheet II

**REVISED:** Intermediate post callout on the 6’ galvanized fence detail (Detail 1) updated to specify 1-7/8” O.D. post size.

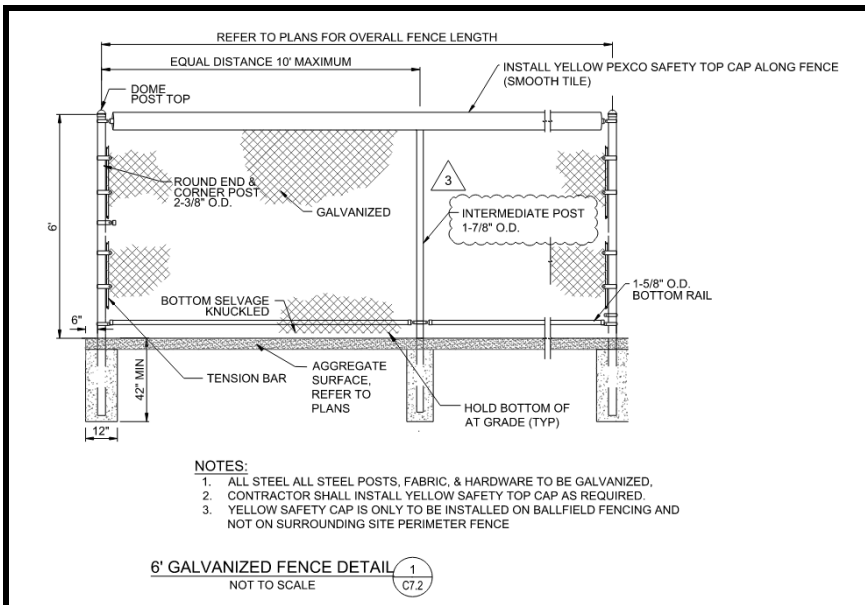

**PART 4 – QUESTIONS**

1. *What height are the foul poles?*
  - a. Foul poles shall be 20' in height, as specified in Detail 8 on Sheet C7.2.

J:\Projects\2025 Projects\2025-01713 SSAA Baseball and Locker Improvements\14\_Bidding\Addenda\Addendum 3\Addendum #3 - FWCS  
SSAA\_2026-04-06.doc