

ADDENDUM No. 01

February 02, 2012

2012 Roofing & Roof Related Work at Various Locations

Metropolitan School District of Wayne Township

Construction Documents dated January 18, 2012

NOTICE TO ALL BIDDERS:

All bidders are instructed to read and to note the following described changes, corrections, clarifications, omissions, deletions, approvals and statements pertinent to the Contract Bid and Construction Documents

This Addendum No. 01 is issued in accordance with the provisions of "The General Conditions of the Contract for Construction", Article 1, "Construction Documents" and becomes a part of the Contract Documents as provided therein. This Addendum includes:

Clarifications and General Information:

- Item 1.1** Pre-Bid Sign-in sheet is attached to the end of this Addendum.
- Item 1.2** Question was asked at the Pre-bid regarding the liquidated Damages and if this amount is per project or site. The answer is per site.
- Item 1.3** Question was asked what is the correct spelling for Robey Elementary School because it varies in the spec's and drawings. The answer is – the correct spelling is Robey.
- Item 1.4** Question was asked regarding the new roof drains that were called out on the drawings – they are specified on the drawings and are to be the Zurn 100 roof drain, with a cast iron strainer and 4" pipe. The new drain line can be either 4" PVC or Cast Iron pipe. Regardless of which pipe all new drain lines are specified to be insulated.

CORPORATE OFFICE

7172 N. Keystone Ave.
Suite G
Indianapolis, Indiana
46240

317.466.9520 Phone
317.536.3930 Fax

Northern Indiana OFFICE

407 Broadway Street
New Haven, Indiana
46774

260.748.0591 Phone
317.536.3930 Fax

etica...

*"the way we do
business"*

Changes to Drawings:

Item 1.5 Sheet A110 – Taper Insulation Plan Westlake Elementary School

1. **ADD**, new taper insulation layout for Roof Area 5 to taper insulation Roof Plan. See and use layout appended to the end of this addendum.

Changes to Specifications:

Item 1.6 Section SIB – Supplementary Instruction to Bidders

1. Article 9; Time and Liquidated Damages, 9.2.1.2, **CHANGE** to read “Liquidated Damage amount will be \$1,000 per calendar day per site.”

Item 1.7 Section 07311 – Asphalt Shingles

1. Section 1.9, paragraph A, subparagraph 1, **CHANGE** to read:

“1. Asphalt Shingles: 8 sqs of unbroken bundles.”

Item 1.8 Section 07550 - Modified Bituminous Membrane Roofing

1. Section 2.5, paragraph E, subparagraph 1, sub-subparagraph a, **CHANGE** to read:

“a. Performance; Perflash”.

Sign In Sheet

Project Name: MSD Wayne Township 2012 Roof Work at Various Locations
Owner: MSD Wayne Township
Project No.: 1133
Meeting: Pre-Bid meeting
Meeting Date: 1/25/2012



ADDITION
 FEB 2, 2012

Name	Company/Association	Phone/Cell	E-mail
CHRIS BAYNE	ETICA GROUP	260-748-0591	CBAYNE@ETICAGROUP.COM
JR KUZMA	McGUFF ROOFING	765-289-2145	mcguff4kris@hotmail.com
Nick Miller	Hinshaw Roofing	765-242-6375	nmiller@hinshawroofing.com
CHRIS E. PAVONE	MSD OF WAYNE	317-988-6360	chris.pavone@msd.wy.gov
JOE CRAIG	Nu-Tec RF	317-255-4864	JCRIG@NU-TEC-ROOFING.COM
NATE ELLENBERGER	FORT WAYNE ROOFING	260-422-9529	nellenberger@fortwayneroofing.com
T.S. Redington	South Central Roofing	317-777-8951	SRROOF-TS@Comcast.net
KEITH ROMINE	SMITHER ROOFING	317-545-1304	KROMINE@SMITHERROOFING.COM
MIKE MILLER	SMITHSON ROOFING	317-5451304 407-3992	MMILLER@SMITHSONROOFING.COM
JOSEPH WOLFORD	R. ADAMS ROOFING, INC.	317-545-7663 / 716-5072	JOSEPH-W@RADAMSROOFING.COM
BRANDON BAIN	B. BACHMAYER & BACHMAYER BFG	317-263-0707 / 223-4042	BBAIN@BACHMAYERBACHMAYER.COM
CHASE SAUGHTEER	GLENROY CONST.	317-359-9001 / 960-2755	CHASE@GLENROYCONSTRUCTION.COM

MSD OF WAYNE TOWNSHIP
 2012 ROOFING AND ROOF RELATED WORK
 VARIOUS LOCATIONS

ADDENDUM ONE




PROJECT NUMBER: 1133

DATE OF ADDENDUM: 02/02/2011

**PROJECT ONE - BASE WORK
 ROOF AREA 5**

ELEVATION	20' +/-
AREA	210 sf +/-

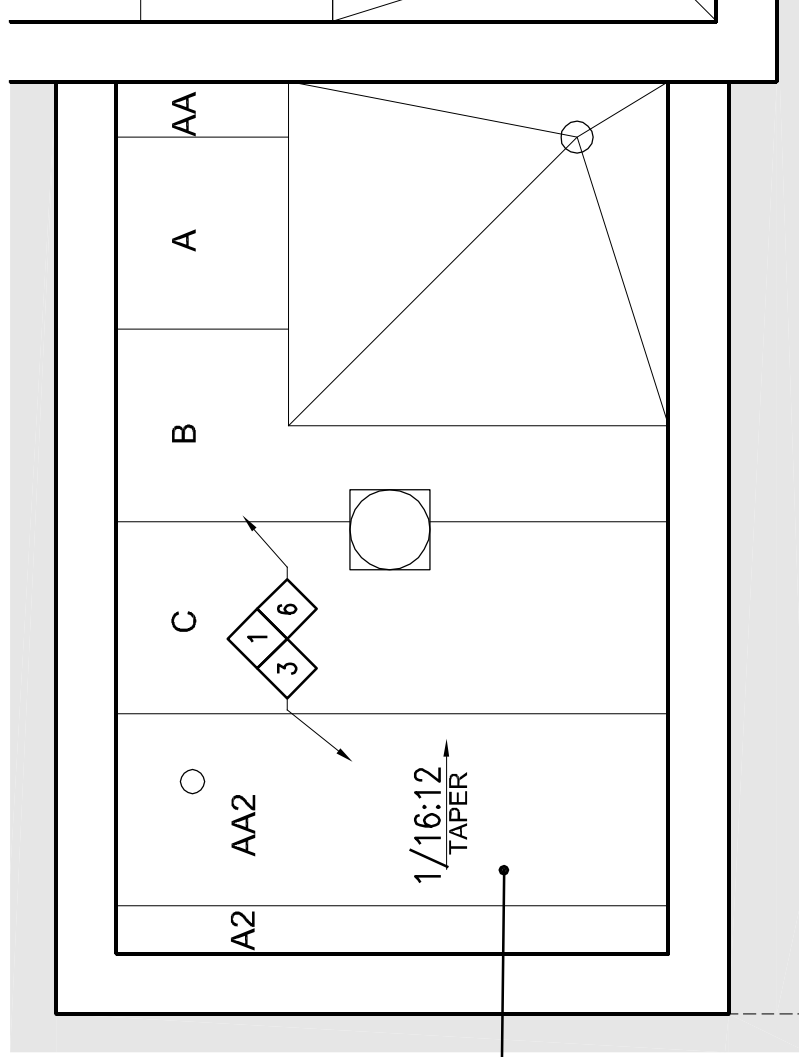

ROOF AREA 5 TAPER PLAN
 WESTLAKE ELEMENTARY

SCALE: 1/4"=1'-0"

