



Lillian Schmitt Elementary – Bid Package #2

Addendum #2

March 15, 2024

This addendum is hereby made a part of the Drawings and Specifications on the subject work as though originally included therein. The following amendments, additions, and/or corrections shall govern this package.

General

- 1)** All substitution requests and questions must be submitted to nwerner@maxwellbuilds.com by 12:00 PM on Monday, March 18, 2024. This will be the cut-off for the final Addendum that will be issued Wednesday, March 20, 2024.
- 2)** Revised Alternates, Unit Prices, and Allowances Forms that reflect the changes made on Addendums will be issued via Addendum 3 on Wednesday 3/20/24. Updated forms to be included within bid envelope.
- 3)** All BC's are responsible for protecting finished surfaces. When working over top of finished casework or flooring the finished material must first be protected with RAM Board or a similar protectant. Joints must be taped and maintained. If temporary floor protection (RAM Board or equivalent with taped joints) gets damaged, the BC that causes the damage shall fix the temporary protection immediately.
- 4)** CM/Owner will pay for all material testing on this project. Testing to be coordinated by Bid Category requiring the testing.
- 5)** Please disregard the "Schedule of Alternates (Section 3.01)" listed in Specification Section 01 23 00. All other spec section verbiage to remain. Please refer to the Alternates added in addendums and "Specification Section 00 43 23 Alternates Form" located in DIV 00-01 specifications.
- 6)** Updated bid forms including revised Alternates Form, Unit Prices Form, and Allowances Form will be issued in the last addendum.
- 7) Bid Category #1 General Trades**
 - a. It is the responsibility of BC-6, Flooring and Tiling, to demo wall tile at all walls that are existing to remain. It is the responsibility of BC-1, General Trades, to demo wall tile at all walls that are to be removed complete.
 - b. Spec Section 06 42 16 Flush Wood Paneling has hereby been removed from this BC's scope of work.
 - c. All toilet accessories are to be installed by BC-1, General Trades.
 - d. BC-1 to include **\$2,500 per thousand brick Allowance**. Allowance includes furnishing face brick. Material allowance and installation is included in this Section and is part of Contract Sum/Price.
- 8) Bid Category #3 Concrete**
 - a. BC-3 is responsible for caulking exterior construction and expansion joints.

9) Bid Category #6 Flooring/Tiling

- a. The flooring contractor, BC-6, is responsible for all required thresholds/transitions.
- b. It is the responsibility of BC-6, Flooring and Tiling, to demo wall tile at all walls that are existing to remain. It is the responsibility of BC-1, General Trades, to demo wall tile at all walls that are to be removed complete.
- c. Areas that require self-leveler, must be prepped properly before installation of self-leveler. Floors will not be accepted where self-leveler is applied over existing adhesive.
- d. It is the responsibility of this BC to seal LVT to adjacent walls with approved joint sealant.

10) Bid Category #8 Plumbing/HVAC

- a. It is the responsibility of BC-8 to provide and install all plumbing fixtures and equipment. This was NOT pre-purchased by the owner. See attached updated 22 40 00 specification.

11) Bid Category #10 Painting and Coatings

- a. The Painting and Coatings Contractor, BC-10, is responsible for painting electrical/technology conduits/pathways, sprinkler piping, and MEP Equipment/piping as indicated on drawings and specifications. BC-10 to check painting requirements in each pertinent MEP item specification.

Questions and Answers

- 1)** In spec section 011200 for Bid Category #8 – Plumbing/Heating, Ventilation, and Air Conditioning (1.6 – N – #105.) calls for “BC-9” to be responsible for required roofing demo and repair at LSE to allow for all scope of work to be completed. Please confirm which BC is responsible for this.
 - a. CM Response: BC-8 is responsible for required roofing demo and repair at LSE to allow for all scope of work to be completed.
- 2)** On drawing AD201D is calls out for Cafeteria 196 stage to get demo. Transition between LVT 2 and Existing Hardwood Gym Flooring. Who is responsible for the aluminum threshold between the new LVT floor and the Existing Wood?
 - a. CM Response: The flooring contractor, BC-6, is responsible for all required thresholds/transitions.
- 3)** Who is responsible for painting electrical/technology conduits/pathways, sprinkler piping, and MEP Equipment/piping?
 - a. CM Response: The Painting and Coatings Contractor, BC-10, is responsible for painting electrical/technology conduits/pathways, sprinkler piping, and MEP Equipment/piping as indicated on drawings and specifications. BC-10 to check painting requirements in each pertinent MEP item specification.
- 4)** In the Multiple Contract Summary, Section 064000 appears to be assigned to both BP1 and BP4. Can you confirm all millwork will be by BP4?
 - a. CM Response: This is confirmed. All new Millwork to be by BC-4.
- 5)** Who is responsible for wall tile demo?
 - a. CM Response: It is the responsibility of BC-6, Flooring and Tiling, to demo wall tile at all walls that are existing to remain. It is the responsibility of BC-1, General Trades, to demo wall tile at all walls that are to be removed complete.
- 6)** Which BC is responsible for caulking exterior construction and expansion joints?
 - a. CM Response: BC-3 is responsible for caulking exterior construction and expansion joints.

- 7) It appears that there aren't any toilet accessories called out at sinks in areas located outside of toilet rooms. Are these to be provided and installed by owner? Please advise.
 - a. Response Per CSO's Attached Narrative: Toilet accessories at sinks located outside of toilet rooms are to be provided by owner and installed by contractor. Paper towel and soap dispensers are to be provided at every sink.
 - b. CM Response: All toilet accessories are to be installed by BC-1, General Trades.
- 8) Please clarify where self-leveling underlayment is to be installed?
 - a. CM Response: Please refer to drawings and specifications. Self-leveling underlayment to be installed in areas indicated by Note F9.
- 9) Is there any existing casework being reused? It appears the elevations don't reflect all the casework in the plan views. Please advise.
 - a. Response Per CSO's Attached Narrative: All elevations are to be in accordance with the casework elevation tags on the A900 series equipment plans. Tags noted as "Sim" or "Opp" are referring to "similar" casework elevations, and the classroom number listed in the elevation title can be disregarded.
- 10) Please advise how data/intercom cable should be routed within the tunnel. Should all cabling be installed in conduit or are j-hooks acceptable?
 - a. Response Per CSO's Attached Narrative: Cabling shall be supported using standards compliant products and methods as specified in Section 27 05 28 – Pathways for Communications Systems.

Updated Specifications:

- 1) Refer to Addendum #2 Document Attached from CSO Noting Changes.
- 2) Please disregard the "Schedule of Alternates (Section 3.01)" listed in Specification Section 01 23 00. All other spec section verbiage to remain. Please refer to the Alternates added in addendums and "Specification Section 00 43 23 Alternates Form" located in DIV 00-01 specifications.
- 3) Refer to attached specs which have been **removed**. Refer to sections above to see which bid categories specs were removed from.
 - a. REMOVE spec section 06 42 16 Flush Wood Paneling

Updated Drawings:

- 1) Refer to Addendum #2 Document Attached from CSO Noting Changes
 - a. Lillian Schmitt Elementary School – C000, C101, C300, C301, C302, C400, C401, C500, C501, C800, C801, C900, C901, C903, L101, L102, L201, L202, L301, L400, L601, A402, A404, A606, A608, A611, A900, P201D, P202C, P601, MD220, MD302, M201A, M201B, M201C, M202C, M302, M304, M310, M401, ED201D, E001, E201A, E201B, E201C, E201D, E202C, E210, E211A, E211B, E211C, E211D, E212C, E220, E231D, E302, E401, E601, E611, E612, E613

Allowances (updated Allowances form will be issued in final addendum):

- 1) **Bid Category #1 – General Trades**
 - a. Include **\$2,500 per thousand brick Allowance**. Allowance includes furnishing face brick. Material allowance and installation is included in this Section and is part of Contract Sum/Price.

Alternates (updated Alternates form will be issued in final addendum):

- 1) **Alternate #1 – Remove and Replace Bleachers Complete with Hussey (BC-1, BC-9)**
 - a. Alternate #1 Description:

- i. "Base bid to include existing bleachers to remain. Alternate #1 to include ADD to remove existing bleachers complete and replace with new.
- ii. "Base bid to include existing conditions for bleachers. Alternate #1 to include ADD to supply and install necessary power requirements to new bleachers.
- iii. Manufacturer: Hussey

2) Alternate #1A - Remove and Replace Bleachers Complete with Alternate Approved Manufacturer (BC-1, BC-9)

a. Alternate #1A Description:

- i. "Base bid to include existing bleachers to remain. Alternate #1A to include ADD to remove existing bleachers complete and replace with new.
- ii. "Base bid to include existing conditions for bleachers. Alternate #1A to include ADD to supply and install necessary power requirements to new bleachers.
- iii. Manufacturer: Alternate Approved Manufacturer per Specification 12 66 00

3) Alternate #7 – Roofing Manufacturers - Carlisle

- b. Alternate #7 Description: "Base bid is to include Sika Sarnifil as roofing manufacturer in accordance with Division 7 specifications. Alternate #7 to include a deduct for Carlisle as roofing manufacturer in accordance with Division 7 specifications.

4) Alternate #7A – Roofing Manufacturers - Fibertite

- a. Alternate #7A Description: "Base bid is to include Sika Sarnifil as roofing manufacturer in accordance with Division 7 specifications. Alternate #7A to include a deduct for Fibertite as roofing manufacturer in accordance with Division 7 specifications

ADDENDUM

ADDENDUM NO: 2

BID PACKAGE NO: 2

PROJECT: BCSC L.C. Schmitt Elementary Renovations

PROJECT NO: 2021049

DATE: 03/15/2024

BY: Lauren Maloney



This Addendum is issued in accordance with the provisions of "The General Conditions of the Contract for Construction," Article 1, "Contract Documents" and becomes a part of the Contract Documents as provided therein. This Addendum includes:

Addendum Pages: ADD1-1-ADD1-9

Attachments: Specifications: 22 40 00 Plumbing Fixtures, 32 31 19 Decorative Metal Fences and Gates
Revised Sheets: C000, C101, C300, C301, C302, C400, C401, C500, C501, C800, C801, C900, C901, C903, L101, L102, L201, L202, L301, L400, L601, A606, A608, A611, P201D, P202C, P601, MD220, MD302, M201A, M201B, M201C, M202C, M302, M304, M310, M401, ED201D, E001, E201A, E201B, E201C, E201D, E202C, E210, E211A, E211B, E211C, E211D, E212C, E220, E231D, E302, E401, E601, E611, E612, E613

PART 1 - BIDDING AND CONTRACT REQUIREMENTS

1.01 NOT USED

PART 2 - SPECIFICATIONS

2.01 TABLE OF CONTENTS

A. DIVISION 06 – WOOD, PLASTICS, AND COMPOSITES

1. Remove 06 42 16 Flush Wood Paneling.

2.02 SECTION 04 20 00 – UNIT MASONRY

A. Add the following paragraph **1.09** as follows:

1.09 ALLOWANCES

A. **Allowances: Include allowance stated under provisions of Section 01 20 00 - Allowances. Allowance includes furnishing face brick. Material allowance and installation is included in this Section and is part of Contract Sum/Price.**

1. **Brick allowance: \$2,500 per thousand brick.**

2.03 087100 – DOOR INDEX

A. Add the following doors to the door index:

1. **DOOR# OD102-1 HS# 38**
2. **DOOR# OD102-2 HS# 39**

2.04 SECTION 09 77 23 – FABRIC-WRAPPED PANELS

A. Add item 2.02.A.6 as follows:

6. AVL Systems

2.05 SECTION 12 32 16 – MANUFACTURED PLASTIC-LAMINATE-FACED CASEWORK

A. Add item 2.01.A.5 as follows:

5. Kramer Furniture and Cabinet Makers, Inc.

2.06 SECTION 22 40 00 – PLUMBING FIXTURES

- A. This section is to be reissued in its entirety.
- B. Remove all verbiage of pre-purchase package.

2.07 SECTION 32 31 19 – DECORATIVE METAL FENCES AND GATES

A. Insert missing section 32 31 19 – DECORATIVE METAL FENCES AND GATES.

PART 3 - DRAWINGS

CIVL

3.01 C000 – TITLE SHEET

A. Modify drawing index to identify the revised sheets & dates under this addendum.

3.02 C101 – DEMOLITION PLAN

- B. Modify extents of sawcut lines and demolition of existing pavement & curb to correspond with west courtyard.
- C. Modify extents of sawcut lines and demolition of existing pavement for new sidewalk ADA curb ramps along Home Avenue at bus parking drive.

3.03 C300 – GRADING PLAN

D. Modify grading of parking lots to add additional inlet in east bus parking lot.

3.04 C301 – FLOOD ROUTING PLAN

E. Modify flood hatches on east parking, per City drainage comments.

3.05 C302 – GRADING PLAN SOUTH ALTERNATE

- F. Add grade elevations for light poles around south drive widening.

3.06 C400 – DRAINAGE PLAN

- G. Add inlet 402A and 82 LF of pipe.
- H. Add note for existing structure rim adjustment near ADA parking.
- I. Modify location of STR 400.
- J. Modify lengths of pavement underdrains to 20 LF.
- K. Modify casting types at STR 402.
- L. Modify pipe lengths leaving STR 403 per City drainage comment. Modified location of STR 403.
- M. Modify size & note for roof drains at west courtyard.

3.07 C401 – DRAINAGE PROFILE

- N. Add profile for STR 402 – 402A (newly added inlet).

3.08 C500 – UTILITY PLAN

- O. Modify location of electric conduit around new location for storm STR 400. Refer to E series of sheets for all specifics on lighting design information.

3.09 C501 – UTILITY PLAN SOUTH ALTERNATE

- P. Add sheet to show light pole locations corresponding with site lighting plan. Refer to E series of sheets for all specifics on lighting design information.

3.010 C800 – PLAN DETAILS

- Q. Modify Detail 411 per City drainage comment.
- R. Add general note to reference City of Columbus Standard Details.

3.011 C801 – PLAN DETAILS

- S. Modify name of the sheet.
- T. Add detail for Nyloplast structures and typical roof drain connection per City drainage comment.
- U. Add general note to reference City of Columbus Standard Details.

3.012 C900 – STORMWATER POLLUTION PREVENTION PLAN

- V. Modify disturbance limits along California St at west courtyard.

W. Add inlet protection for additional inlet.

3.013 C901 – STORMWATER POLLUTION PREVENTION NOTES

X. Modify Item B11, per City drainage comment.

3.014 C903 – STORMWATER POLLUTION PREVENTION DETAILS

Y. Add general note to reference City of Columbus Standard Details.

LANDSCAPE

3.015 L101 – MATERIALS PLAN

- A. Move ADA parking spaces closer to the main entrance per request from the City.
- B. Add pavement replacement near proposed addition.
- C. Add Single Wing curb ramp along Home Ave.
- D. Replace post curb along the north side of parking lot.
- E. Add post curb along the walkway that runs through the center island.

3.016 L102 – MATERIALS PLAN

- A. Add pavement replacement near proposed addition.

3.017 L201 – LAYOUT PLAN

- A. Update dimensions based on site base changes.

3.018 L202 – LAYOUT PLAN

- A. Update dimensions based on site base changes.

3.019 L301 – PLANTING PLAN

- A. Update parking interior planting based on comments from the City.
- B. Update planting near the proposed addition due to concrete changes in the area.

3.020 L400 - PLANTING DETAILS & SCHEDULE

- A. Adjust plant quantities based on planting plan changes.

3.021 L601 – SITE DETAILS

- A. Add detail has for single wing curb ramp as shown on the attached sheet.

ARCHITECTURAL

3.022 KEYNOTE LEGEND

- A. Add keynote "06 40 00-W PLASTIC LAMINATE ON ¾" PARTICLEBOARD".
- B. Add keynote "09 65 13-A RESILIENT BASE".

3.023 A402 – WALL SECTIONS

- A. Revise insulation keynote tag on 9/A402 - WALL SECTION – TOILET 112A from ~~07-21-00-N MINERAL WOOL BATT INSUALTION~~ to **09 29 00-B SOUND ATTENUATION INSULATION.**

3.024 A404 – ENLARGED PLAN DETAILS

- A. Revise insulation keynote tags on 1/A404 – PLAN DETAIL, 4/A404 - PLAN DETAIL and 10/A404 – PLAN DETAIL from ~~07-21-00-N MINERAL WOOL BATT INSUALTION~~ to **09 29 00-B SOUND ATTENUATION INSULATION.**

3.025 A606 – CASEWORK ELEVATIONS

- A. Add filler panels above tall and wall casework as noted on the attached sheets.

3.026 A608 – CASEWORK ELEVATIONS

- A. Add filler panels above tall and wall casework as noted on the attached sheets.

3.027 A611 – ENLARGED MILLWORK, PLANS, SECTIONS AND DETAILS

- A. Revise corridor panel drawings to reflect plastic laminate finish instead of wood and as shown on the attached sheet.
- B. Add additional keynotes and dimensions to 9/A611 – ENLARGED MILLWORK SECTION and 8/A611 – ENLARGED MILLWORK SECTION for clarity.

3.028 A900 – EQUIPMENT SCHEDULE

- A. Remove "~~PROVIDE BLEACHER BLOCKS AS REQUIRED BY FLOORING MANUFACTURER~~" from the remarks for "GM1".

PLUMBING

3.029 P201D - FIRST FLOOR PLAN - UNIT D - PLUMBING DEMOLITION

- A. This drawing is to be reissued in its entirety.

3.030 P202C – SECOND FLOOR PLAN - UNIT C - PLUMBING

- A. This drawing is to be reissued in its entirety.

3.031 P601 – SCHEDULES - PLUMBING

- A. This drawing is to be reissued in its entirety.

MECHANICAL

3.032 MD220 – ROOF PLAN – MECHANICAL DEMOLITION

A. This drawing is to be reissued in its entirety.

3.033 MD302 – ENLARGED MEZZANINE LEVEL PLAN – MECHANICAL DEMOLITION

A. This drawing is to be reissued in its entirety.

3.034 M201A – FIRST FLOOR PLAN – UNIT A – MECHANICAL

A. This drawing is to be reissued in its entirety.

3.035 M201B – FIRST FLOOR PLAN – UNIT B - MECHANICAL

A. This drawing is to be reissued in its entirety.

3.036 M201C – FIRST FLOOR PLAN – UNIT C – MECHANICAL

A. This drawing is to be reissued in its entirety.

3.037 M202C – SECOND FLOOR PLAN – UNIT C – MECHANICAL

A. This drawing is to be reissued in its entirety.

3.038 M302 – ENLARGED MEZZANINE LEVEL PLAN – MECHANICAL

A. This drawing is to be reissued in its entirety.

3.039 M304 – ENLARGED PLANS – MECHANICAL

A. This drawing is to be reissued in its entirety.

3.040 M310 – SECTIONS – MECHANICAL

A. This drawing is to be reissued in its entirety.

3.041 M401 – DETAILS – AIR DISTRIBUTION

A. This drawing is to be reissued in its entirety.

ELECTRICAL

3.042 ED201D - FIRST FLOOR PLAN - UNIT D - ELECTRICAL DEMOLITION

A. This drawing is to be reissued in its entirety.

3.043 E001 - SYMBOLS, ABBREVIATIONS, & GENERAL NOTES – ELECTRICAL

A. This drawing is to be reissued in its entirety.

- 3.044 E201A - FIRST FLOOR PLAN - UNIT A – LIGHTING
A. This drawing is to be reissued in its entirety.
- 3.045 E201B - FIRST FLOOR PLAN - UNIT B – LIGHTING
A. This drawing is to be reissued in its entirety.
- 3.046 E201C - FIRST FLOOR PLAN - UNIT C – LIGHTING
A. This drawing is to be reissued in its entirety.
- 3.047 E201D - FIRST FLOOR PLAN - UNIT D – LIGHTING
A. This drawing is to be reissued in its entirety.
- 3.048 E202C - SECOND FLOOR PLAN - UNIT C – LIGHTING
A. This drawing is to be reissued in its entirety.
- 3.049 E210 - TUNNEL PLAN – POWER
A. This drawing is to be reissued in its entirety.
- 3.050 E211A - FIRST FLOOR PLAN - UNIT A – POWER
A. This drawing is to be reissued in its entirety.
- 3.051 E211B - FIRST FLOOR PLAN - UNIT B – POWER
A. This drawing is to be reissued in its entirety.
- 3.052 E211C - FIRST FLOOR PLAN - UNIT C – POWER
A. This drawing is to be reissued in its entirety.
- 3.053 E211D - FIRST FLOOR PLAN - UNIT D – POWER
A. This drawing is to be reissued in its entirety.
- 3.054 E212C - SECOND FLOOR PLAN - UNIT C – POWER
A. This drawing is to be reissued in its entirety.
- 3.055 E220 - ROOF PLAN – ELECTRICAL
A. This drawing is to be reissued in its entirety.
- 3.056 E231D - FIRST FLOOR PLAN - UNIT D - FIRE ALARM
A. This drawing is to be reissued in its entirety.

3.057 E302 - ENLARGED MEZZANINE LEVEL PLAN – ELECTRICAL

A. This drawing is to be reissued in its entirety.

3.058 E401 - DETAILS – ELECTRICAL

A. This drawing is to be reissued in its entirety.

3.059 E601 - SCHEDULES – ELECTRICAL

A. This drawing is to be reissued in its entirety.

3.060 E611 - SCHEDULES – PANELBOARDS

A. This drawing is to be reissued in its entirety.

3.061 E612 - SCHEDULES – PANELBOARDS

A. This drawing is to be reissued in its entirety.

3.062 E613 - SCHEDULES - PANELBOARDS

A. This drawing is to be reissued in its entirety.

PART 4 - OTHER ITEMS

4.01 NOT USED

PART 5 - QUESTION AND ANSWER

5.01 It appears that there aren't any toilet accessories called out at sinks in areas located outside of toilet rooms. Are these to be provided and installed by owner? Please advise.

A. Response: Toilet accessories at sinks located outside of toilet rooms are to be provided by owner and installed by contractor. Paper towel and soap dispensers are to be provided at every sink.

5.03 Is there any existing casework being reused? It appears the elevations don't reflect all the casework in the plan views. Please advise.

A. Response: All elevations are to be in accordance with the casework elevation tags on the A900 series equipment plans. Tags noted as "Sim" or "Opp" are referring to "similar" casework elevations, and the classroom number listed in the elevation title can be disregarded.

5.04 Please advise how data/intercom cable should be routed within the tunnel. Should all cabling be installed in conduit or are j-hooks acceptable?

- A. Response: Cabling shall be supported using standards compliant products and methods as specified in Section 27 05 28 – Pathways for Communications Systems.

END OF ADDENDUM

SECTION 22 40 00 – PLUMBING FIXTURES

PART 1 - GENERAL

1.1 SUMMARY

A. This Section includes the following:

1. Faucets.
2. Flushometers.
3. Toilet seats.
4. Water closets.
5. Urinals.
6. Lavatories.
7. 2-User Lavatories.
8. Protective shielding guards.
9. Fixture supports.
10. Sinks.

B. Related Sections include the following:

1. Division 22 Section "Drinking Fountains and Water Coolers."

1.2 SUBMITTALS

- A. Product Data: For each type of product indicated.
- B. Shop Drawings: Diagram power, signal, and control wiring.
- C. Operation and maintenance data.

1.3 QUALITY ASSURANCE

- A. Electrical Components, Devices, and Accessories: Listed and labeled as defined in NFPA 70, Article 100, by a testing agency acceptable to authorities having jurisdiction, and marked for intended use.
- B. Regulatory Requirements: Comply with requirements in ICC A117.1, "Accessible and Usable Buildings and Facilities"; Public Law 90-480, "Architectural Barriers Act"; and Public Law 101-336, "Americans with Disabilities Act"; for plumbing fixtures for people with disabilities.
- C. Regulatory Requirements: Comply with requirements in Public Law 102-486, "Energy Policy Act," about water flow and consumption rates for plumbing fixtures.
- D. NSF Standard: Comply with the latest adopted version of NSF 61, "Drinking Water System Components--Health Effects," for fixture materials that will be in contact with potable water.

- E. Select combinations of fixtures and trim, faucets, fittings, and other components that are compatible.
- F. Comply with the following applicable standards and other requirements specified for plumbing fixtures:
 - 1. Enameled, Cast-Iron Fixtures: ASME A112.19.1M.
 - 2. Porcelain-Enameled, Formed-Steel Fixtures: ASME A112.19.4M.
 - 3. Stainless-Steel Sinks: ASME A112.19.3.
 - 4. Vitreous-China Fixtures: ASME A112.19.2M.
 - 5. Water-Closet, Flush Valve Trim: ASME A112.19.5.
- G. Comply with the following applicable standards and other requirements specified for lavatory/sink faucets:
 - 1. Faucets: ASME A112.18.1.
 - 2. Integral, Atmospheric Vacuum Breakers: ASSE 1001.
 - 3. NSF Potable-Water Materials: NSF 61.
 - 4. Sensor-Actuated Faucets and Electrical Devices: UL 1951.
- H. Comply with the following applicable standards and other requirements specified for miscellaneous fittings:
 - 1. Atmospheric Vacuum Breakers: ASSE 1001.
 - 2. Brass and Copper Supplies: ASME A112.18.1.
 - 3. Brass Waste Fittings: ASME A112.18.2.
 - 4. Plastic Tubular Fittings: ASTM F 409.
 - 5. Sensor-Operation Flushometers: ASSE 1037 and UL 1951.
 - 6. Supply Fittings: ASME A112.18.1.
- I. Comply with the following applicable standards and other requirements specified for miscellaneous components:
 - 1. Disposers: ASSE 1008 and UL 430.
 - 2. Flexible Water Connectors: ASME A112.18.6.
 - 3. Grab Bars: ASTM F 446.
 - 4. Hose-Coupling Threads: ASME B1.20.7.
 - 5. Off-Floor Fixture Supports: ASME A112.6.1M.
 - 6. Pipe Threads: ASME B1.20.1.
 - 7. Plastic Toilet Seats: ANSI Z124.5.
 - 8. Supply and Drain Protective Shielding Guards: ICC A117.1.

PART 2 - PRODUCTS

2.1 FLUSH VALVE WATER CLOSETS

- A. Water Closets; WC-1,2,3,4:
 - 1. Basis-of-Design Product: Subject to compliance with requirements, provide American Standard "Afwall FloWise" 2257.001, or a comparable by the following:

- a. Kohler Co.
 - b. Sloan.
 - c. Zurn Plumbing Products Group.
2. Description: Wall-mounting, back-outlet, vitreous-china fixture designed for flushometer valve operation.
- a. Style: Flushometer valve.
 - b. Bowl Type: Elongated with siphon-jet design.
 - c. Height: Refer to the plumbing fixture schedule on the Drawings.
 - d. Design Consumption: 1.28 gal./flush.
 - e. Color: White.

2.2 WATER CLOSET FLUSHOMETERS

A. Water Closet; WC-1,2,3:

1. Basis-of-Design Product: Subject to compliance with requirements, provide Sloan Regal 111-SFSM or a comparable by the following:
 - a. Zurn Plumbing Products Group; Commercial Brass Operation.
2. Description: Flushometer for water-closet type fixture. Include brass body with corrosion and chlorine resistant internal components, dual-filtered bypass, synthetic rubber diaphragm assembly, control stop with check valve, vacuum breaker, copper or brass tubing, and polished chrome-plated finish on exposed parts.
 - a. Internal Design: Diaphragm operation.
 - b. Style: Exposed.
 - c. Inlet Size: NPS 1.
 - d. Trip Mechanism: Battery powered, infrared sensor actuator.
 - e. Consumption: 1.28 gal./flush.
 - f. Tailpiece Size: NPS 1-1/2 and standard length to top of bowl.

2.3 TOILET SEATS

A. Toilet Seats; WC-1,2,3,4:

1. Manufacturers: Subject to compliance with requirements, provide products by one of the following:
 - a. Bemis Manufacturing Company.
 - b. Church Seats.
 - c. Olsonite Corp.
2. Description: Toilet seat for water-closet-type fixture.
 - a. Material: Molded, solid plastic.
 - b. Configuration: Open front less cover.
 - c. Size: Elongated.
 - d. Hinge Type: Stainless steel, self-sustaining check hinge.

- e. Class: Extra heavy-duty, commercial.
- f. Color: White.

2.4 FIXTURE SUPPORTS

- A. Manufacturers: Subject to compliance with requirements, provide products by one of the following:
 - 1. Josam Company.
 - 2. Smith, Jay R. Mfg. Co.
 - 3. Tyler Pipe; Wade Div.
 - 4. Watts Drainage Products Inc.; a div. of Watts Industries, Inc.
 - 5. Zurn Plumbing Products Group; Specification Drainage Operation.
- B. Water-Closet Supports; WC-1,2,3,4:
 - 1. Description: Combination carrier designed for accessible and standard mounting height of wall-mounting, water-closet-type fixture. Include single or double, vertical or horizontal, hub-less waste fitting as required for piping arrangement; faceplates; couplings with gaskets; feet; and fixture bolts and hardware matching fixture. Include additional extension coupling, faceplate, and feet for installation in wide pipe space.

2.5 URINALS

- A. Urinals; UR-1,2:
 - 1. Basis-of-Design Product: Subject to compliance with requirements, provide American Standard "Washbrook FloWise" 6590.001 or a comparable product by one of the following:
 - a. Kohler Co.
 - b. Sloan.
 - c. Zurn Plumbing Products Group.
 - 2. Description: Wall-mounting, back-outlet, vitreous-china fixture designed for flushometer valve operation.
 - a. Type: Washout.
 - b. Strainer or Trapway: Stainless steel strainer with integral trap.
 - c. Design Consumption: 0.5 gal./flush.
 - d. Color: White.
 - e. Supply Spud Size: NPS 3/4.
 - f. Outlet Size: NPS 2.

2.6 FIXTURE SUPPORTS

- A. Manufacturers: Subject to compliance with requirements, provide products by one of the following:
 - 1. Josam Company.
 - 2. Smith, Jay R. Mfg. Co.

3. Tyler Pipe; Wade Div.
4. Watts Drainage Products Inc.; a div. of Watts Industries, Inc.
5. Zurn Plumbing Products Group; Specification Drainage Operation.

B. Urinal Supports; UR-1,2:

1. Description: Type I, urinal carrier with fixture support plates and coupling with seal and fixture bolts and hardware matching fixture for wall-mounting, urinal-type fixture. Include steel uprights with feet.

2.7 LAVATORIES

A. Lavatories; L-1,2:

1. Basis-of-Design Product: Subject to compliance with requirements, provide American Standard "Lucerne" 0355.012 or a comparable product by one of the following:
 - a. Kohler Co.
 - b. Sloan.
 - c. Zurn Plumbing Products Group.
2. Description: Accessible, wall-mounting, vitreous-china fixture.
 - a. Size: 21-1/4 by 18-1/4 inches rectangular.
 - b. Faucet Hole Punching: 4" center, three hole.
 - c. Color: White.
 - d. Overflow: Front.
 - e. Construction: Self-draining deck area with contoured back and side splash shields.

2.8 LAVATORY FAUCETS

A. Lavatory Faucets; L-1,2:

1. Basis-of-Design Product: Subject to compliance with requirements, provide Sloan SF-2350 or an approved equal:
2. Description: Sensor-control mixing valve. Coordinate faucet inlets with supplies and fixture holes; coordinate outlet with spout and fixture receptor.
 - a. Body Material: Commercial, solid brass.
 - b. Finish: Polished chrome plate.
 - c. Maximum Flow Rate: 0.5 gpm.
 - d. Centers: Three holes with 4-inch deck plate.
 - e. Mounting: Deck, exposed.
 - f. Inlet(s): NPS 3/8 tubing, with NPS 1/2 male adaptor.
 - g. Spout Outlet: Aerator.
 - h. Power Source: Battery wall pack.
 - i. Temperature Control: Control box mixer.
 - j. Warranty: 3-year limited.

2.9 2-USER LAVATORIES

A. 2-User Lavatories; L-3:

1. Basis-of-Design Product: Subject to compliance with requirements, provide Bradley SS-2N-IRP-TMA or a comparable by one of the following:
 - a. Acorn.
 - b. Willoughby.
2. Description: Solid surface two-station wash fountain.
3. Construction: Bowl and pedestal panels constructed of molded cast polymer densified solid surface material composed of polyester/acrylic resin, UV stabilizer, aluminum trihydrate and mineral fillers. Exposed trim surfaces shall be stainless steel polished to satin finish.
4. Vandal Resistance: Valves, water supplies, and waste connections are concealed within the pedestal. The pedestal panels shall be removable and secured with vandal resistant security screws.
5. Accessories: Wash fountain shall include all water and waste supplies (shipped loose for field installation), wall mounting bracket.
6. Color: Color to be selected by Architect from the standard color pallet.
7. Faucets: Integral infrared faucets.

2.10 PROTECTIVE SHIELDING GUARDS

A. Protective Shielding Pipe Covers; L-1,2:

1. Basis-of-Design Product: Subject to compliance with requirements, provide Truebro 103 E-Z or a comparable product by one of the following:
 - a. Insul-Tect Products Co.; a Subsidiary of MVG Molded Products.
 - b. Plumberex Specialty Products Inc.
2. Description: Manufactured plastic wraps for covering plumbing fixture hot and cold water supplies and trap and drain piping. Comply with Americans with Disabilities Act (ADA) requirements.
 - a. Material: Molded vinyl.
 - b. Nominal Thickness: 1/8" constant wall.
 - c. UV Protection: Required.
 - d. Fasteners: Internal, reusable fasteners.
 - e. Color: White.

2.11 FIXTURE SUPPORTS

- A. Manufacturers: Subject to compliance with requirements, provide products by one of the following:
1. Josam Company.

2. Smith, Jay R. Mfg. Co.
3. Tyler Pipe; Wade Div.
4. Watts Drainage Products Inc.; a div. of Watts Industries, Inc.
5. Zurn Plumbing Products Group; Specification Drainage Operation.

B. Lavatory Supports; L-1,2,3:

1. Description: Type II, lavatory carrier with concealed arms and tie rod for wall-mounting, lavatory-type fixture. Include steel uprights with feet.

2.12 CLASSROOM SINKS

A. Classroom Sinks; SK- 1:

1. Basis-of-Design Product: Subject to compliance with requirements, provide Elkay LRAD-221950 or a comparable product by one of the following:
 - a. Just Manufacturing Company.
 - b. Franke Group.
2. Description: One-bowl, counter-mounting, stainless-steel kitchenette type sink.
 - a. Overall Dimensions: 22 by 19-1/2 by 5 inches.
 - b. Metal Thickness: 18 gauge type 304 (18-8) stainless steel.
 - c. Faucet Hole Punching: Three holes, 4-inch centers.
 - d. Bowl Dimensions: 18 by 14 by 4-7/8 inches.
 - e. Drain: 3-1/2-inch stainless steel crumb cup with offset waste; Elkay LKAD35.
 - 1) Location: Rear back of bowl.
3. Subject to compliance with requirements, provide trim products by one of the following:
 - a. McGuire Manufacturing Company.
 - b. Engineered Brass Company.
 - c. Keeney Manufacturing Company.
4. Sink Trim
 - a. Supplies: Chrome-plated copper with 1/2" NPT x 3/8" OD loose key stops.
 - b. Drain Piping: NPS 1-1/2 chrome-plated cast-brass P-trap with cleanout; NPS 1-1/2 17 gauge tubular brass waste to wall; and wall escutcheon.
5. Faucet: Basis-of-Design Product: Subject to compliance with requirements, provide Chicago 201-AE35ABCP or a comparable product by one of the following:
 - a. T & S Brass and Bronze Works, Inc.
 - b. Zurn Plumbing Products Group; Commercial Brass Operation.
6. Description: Sink faucet without spray. Coordinate faucet inlets with supplies and fixture holes; coordinate outlet with spout and fixture receptor.
 - a. Body Material: Commercial, solid brass.

- b. Finish: Polished chrome plate.
- c. Maximum Flow Rate: 2.2 gpm.
- d. Mixing Valve: 2 3/8 blade handle
- e. Centers: 8 inches.
- f. Mounting: Deck, concealed.
- g. Handle(s): Lever with color coded index button.
- h. Inlet(s): NPS 1/2 male shank.
- i. Spout Type: 6 1/4" swing, solid brass.
- j. Spout Outlet: Aerator.
- k. Operation: Quarter-turn, renewable compression, manual.

B. Activity Commons Sink; SK-2:

1. Basis-of-Design Product: Subject to compliance with requirements, provide Elkay LR-3322 or a comparable product by one of the following:
 - a. Just Manufacturing Company.
 - b. Franke Group.
2. Description: Two-bowl, counter-mounting, stainless-steel kitchen type sink.
 - a. Overall Dimensions: 33 by 22 by 8-1/8 inches.
 - b. Metal Thickness: 18 gauge type 302 (18-8) stainless steel.
 - c. Faucet Hole Punching: Four holes, 4-inch centers.
 - d. Left Bowl Dimensions: 13-1/2 by 16 by 8-1/8 inches.
 - e. Drain: 3-1/2-inch stainless steel crumb cup; Elkay LK35.
 - 1) Location: Center of bowl.
 - f. Right Bowl Dimensions: 13-1/2 by 16 by 8-1/8 inches.
 - g. Drain: 3-1/2-inch stainless steel crumb cup; Elkay LK35.
 - 1) Location: Center of bowl.
3. Subject to compliance with requirements, provide trim products by one of the following:
 - a. McGuire Manufacturing Company.
 - b. Engineered Brass Company.
 - c. Keeney Manufacturing Company.
4. Sink Trim
 - a. Supplies: Chrome-plated copper with 1/2" NPT x 3/8" OD loose key stops.
 - b. Continuous Waste Connection: NPS 1-1/2 chrome-plated cast brass tubing and tailpiece with center outlet.
 - c. Drain Piping: NPS 1-1/2 chrome-plated cast-brass P-trap with cleanout; NPS 1-1/2 17 gauge tubular brass waste to wall; and wall escutcheon.
5. Faucet: Basis-of-Design Product: Subject to compliance with requirements, provide Chicago 201-AE35ABCP or a comparable product by one of the following:
 - a. T & S Brass and Bronze Works, Inc.
 - b. Zurn Plumbing Products Group; Commercial Brass Operation.

6. Description: Sink faucet without spray. Coordinate faucet inlets with supplies and fixture holes; coordinate outlet with spout and fixture receptor.
 - a. Body Material: Commercial, solid brass.
 - b. Finish: Polished chrome plate.
 - c. Maximum Flow Rate: 2.2 gpm.
 - d. Mixing Valve: 2 3/8 blade handle
 - e. Centers: 8 inches.
 - f. Mounting: Deck, concealed.
 - g. Handle(s): Lever with color coded index button.
 - h. Inlet(s): NPS 1/2 male shank.
 - i. Spout Type: 6 1/4" swing, solid brass.
 - j. Spout Outlet: Aerator.
 - k. Operation: Quarter-turn, renewable compression, manual.

2.13 CLINIC SINKS

A. Clinic Sink; SK-3:

1. Basis-of-Design Product: Subject to compliance with requirements, provide Elkay LRAD-221950 or a comparable product by one of the following:
 - a. Just Manufacturing Company.
 - b. Franke Group.
2. Description: One-bowl, counter-mounting, stainless-steel kitchenette type sink.
 - a. Overall Dimensions: 22 by 19-1/2 by 5 inches.
 - b. Metal Thickness: 18 gauge type 304 (18-8) stainless steel.
 - c. Faucet Hole Punching: Three holes, 4-inch centers.
 - d. Bowl Dimensions: 18 by 14 by 4-7/8 inches.
 - e. Drain: 3-1/2-inch stainless steel crumb cup with offset waste; Elkay LKAD35.
 - 1) Location: Rear back of bowl.
3. Subject to compliance with requirements, provide trim products by one of the following:
 - a. McGuire Manufacturing Company.
 - b. Engineered Brass Company.
 - c. Keeney Manufacturing Company.
4. Sink Trim
 - a. Supplies: Chrome-plated copper with 1/2" NPT x 3/8" OD loose key stops.
 - b. Drain Piping: NPS 1-1/2 chrome-plated cast-brass P-trap with cleanout; NPS 1-1/2 17 gauge tubular brass waste to wall; and wall escutcheon.
5. Faucet: Basis-of-Design Product: Subject to compliance with requirements, provide Chicago 201-AE35ABCP or a comparable product by one of the following:
 - a. T & S Brass and Bronze Works, Inc.
 - b. Zurn Plumbing Products Group; Commercial Brass Operation.

6. Description: Sink faucet without spray. Coordinate faucet inlets with supplies and fixture holes; coordinate outlet with spout and fixture receptor.
 - a. Body Material: Commercial, solid brass.
 - b. Finish: Polished chrome plate.
 - c. Maximum Flow Rate: 2.2 gpm.
 - d. Mixing Valve: 2 3/8 blade handle
 - e. Centers: 8 inches.
 - f. Mounting: Deck, concealed.
 - g. Handle(s): Lever with color coded index button.
 - h. Inlet(s): NPS 1/2 male shank.
 - i. Spout Type: 6 1/4" swing, solid brass.
 - j. Spout Outlet: Aerator.
 - k. Operation: Quarter-turn, renewable compression, manual.

2.14 MOTHERS ROOM SINKS

A. Mothers Room Sink; SK-4:

1. Basis-of-Design Product: Subject to compliance with requirements, provide Elkay LRAD-221950 or a comparable product by one of the following:
 - a. Just Manufacturing Company.
 - b. Franke Group.
2. Description: One-bowl, counter-mounting, stainless-steel kitchenette type sink.
 - a. Overall Dimensions: 22 by 19-1/2 by 5 inches.
 - b. Metal Thickness: 18 gauge type 304 (18-8) stainless steel.
 - c. Faucet Hole Punching: Three holes, 4-inch centers.
 - d. Bowl Dimensions: 18 by 14 by 4-7/8 inches.
 - e. Drain: 3-1/2-inch stainless steel crumb cup with offset waste; Elkay LKAD35.
 - 1) Location: Rear back of bowl.
3. Subject to compliance with requirements, provide trim products by one of the following:
 - a. McGuire Manufacturing Company.
 - b. Engineered Brass Company.
 - c. Keeney Manufacturing Company.
4. Sink Trim
 - a. Supplies: Chrome-plated copper with 1/2" NPT x 3/8" OD loose key stops.
 - b. Drain Piping: NPS 1-1/2 chrome-plated cast-brass P-trap with cleanout; NPS 1-1/2 17 gauge tubular brass waste to wall; and wall escutcheon.
5. Faucet: Basis-of-Design Product: Subject to compliance with requirements, provide Chicago 201-AE35ABCP or a comparable product by one of the following:
 - a. T & S Brass and Bronze Works, Inc.
 - b. Zurn Plumbing Products Group; Commercial Brass Operation.

6. Description: Sink faucet without spray. Coordinate faucet inlets with supplies and fixture holes; coordinate outlet with spout and fixture receptor.
 - a. Body Material: Commercial, solid brass.
 - b. Finish: Polished chrome plate.
 - c. Maximum Flow Rate: 2.2 gpm.
 - d. Mixing Valve: 2 3/8 blade handle
 - e. Centers: 8 inches.
 - f. Mounting: Deck, concealed.
 - g. Handle(s): Lever with color coded index button.
 - h. Inlet(s): NPS 1/2 male shank.
 - i. Spout Type: 6 1/4" swing, solid brass.
 - j. Spout Outlet: Aerator.
 - k. Operation: Quarter-turn, renewable compression, manual.

2.15 STAFF DINING SINKS

A. Staff Dining Sink; SK-5:

1. Basis-of-Design Product: Subject to compliance with requirements, provide Elkay LRAD-221955 or a comparable product by one of the following:
 - a. Just Manufacturing Company.
 - b. Franke Group.
2. Description: One-bowl, counter-mounting, stainless-steel kitchenette type sink.
 - a. Overall Dimensions: 22 by 19-1/2 by 5-1/2 inches.
 - b. Metal Thickness: 18 gauge type 304 (18-8) stainless steel.
 - c. Faucet Hole Punching: Three holes, 4-inch centers.
 - d. Bowl Dimensions: 18 by 14 by 5-1/2 inches.
 - e. Drain: 3-1/2-inch stainless steel crumb cup with offset waste; Elkay LKAD35.
 - 1) Location: Rear back of bowl.
3. Subject to compliance with requirements, provide trim products by one of the following:
 - a. McGuire Manufacturing Company.
 - b. Engineered Brass Company.
 - c. Keeney Manufacturing Company.
4. Sink Trim
 - a. Supplies: Chrome-plated copper with 1/2" NPT x 3/8" OD loose key stops.
 - b. Drain Piping: NPS 1-1/2 chrome-plated cast-brass P-trap with cleanout; NPS 1-1/2 17 gauge tubular brass waste to wall; and wall escutcheon.
5. Faucet: Basis-of-Design Product: Subject to compliance with requirements, provide Chicago 201-AE35ABCP or a comparable product by one of the following:
 - a. T & S Brass and Bronze Works, Inc.
 - b. Zurn Plumbing Products Group; Commercial Brass Operation.

6. Description: Sink faucet without spray. Coordinate faucet inlets with supplies and fixture holes; coordinate outlet with spout and fixture receptor.
 - a. Body Material: Commercial, solid brass.
 - b. Finish: Polished chrome plate.
 - c. Maximum Flow Rate: 2.2 gpm.
 - d. Mixing Valve: 2 3/8 blade handle
 - e. Centers: 8 inches.
 - f. Mounting: Deck, concealed.
 - g. Handle(s): Lever with color coded index button.
 - h. Inlet(s): NPS 1/2 male shank.
 - i. Spout Type: 6 1/4" swing, solid brass.
 - j. Spout Outlet: Aerator.
 - k. Operation: Quarter-turn, renewable compression, manual.

2.16 ART ROOM/STEM LAB SINKS

A. Free Standing Sinks; SK-6,8:

1. Basis-of-Design Product: Subject to compliance with requirements, provide Elkay 1C18X18-0X or a comparable product by one of the following:
 - a. Swan.
 - b. Fiat.
 - c. Just
 - d. Franke
 - e. Stern-Williams.
2. Description: One-bowl, Free standing, stainless steel utility tub.
 - a. Overall Dimensions: 23 by 23-13/16 by 44-3/4 inches.
 - b. Bowl Dimensions: 18 by 18 by 12 inches.
 - c. Faucet Hole Punching: Two holes, 8-inch centers.
3. Subject to compliance with requirements, provide trim products by one of the following:
 - a. McGuire Manufacturing Company.
 - b. Engineered Brass Company.
 - c. Keeney Manufacturing Company.
4. Sink Trim
 - a. Drain: Chrome plated brass tray plug with rubber stopper and chain.
 - b. Supplies: Chrome-plated copper with 1/2" NPT x 3/8" OD loose key stops.
 - c. Drain Piping SK-6: Provide Solids Interceptor (SI-A), Zurn Z1180 or equivalent and NPS 1-1/2 17 gauge tubular brass waste to wall; and wall escutcheon(s).
 - d. Drain Piping SK-8: NPS 1-1/2 chrome-plated cast-brass P-trap with cleanout; NPS 1-1/2 17 gauge tubular brass waste to wall; and wall escutcheon(s).
5. Faucet: Basis-of-Design Product: Subject to compliance with requirements, provide Elkay LK940GN05T4H or a comparable product by one of the following:

- a. Chicago
 - b. T & S Brass and Bronze Works, Inc.
 - c. Zurn Plumbing Products Group; Commercial Brass Operation.

6. Description: Manual-control mixing valve with double bend spout. Coordinate faucet inlets with supplies and fixture holes; coordinate outlet with spout and fixture receptor.
 - a. Body Material: Commercial, solid brass.
 - b. Finish: Polished chrome plate.
 - c. Mixing Valve: Two-handle.
 - d. Centers: 8 inches.
 - e. Mounting: Backsplash, exposed.
 - f. Handle(s): 4" wristblade handle with color coded index button.
 - g. Inlet(s): NPS 1/2 male shank.
 - h. Spout Type: Swing, gooseneck, solid brass.
 - i. Spout Outlet: Full flow.
 - j. Operation: Quarter-turn, renewable compression, manual.

- B. Countertop Sink ADA; SK-7,9:
 1. Sink: Basis-of-Design Product: Subject to compliance with requirements, provide Elkay LRAD252165PD manufacturing Company.
 2. Description: Single Compartment, drop in, stainless-steel type sink.
 - a. Overall Dimensions: 25 by 21-1/4 by 6-1/2 inches.
 - b. Metal Thickness: 18 gauge type 304 (18) stainless steel.
 - c. Faucet Hole Punching: Three holes, 4-inch centers.
 - d. Bowl Dimensions: 21 by 15-3/4 by 6-3/8 inches.
 - e. Drain: 3-3/8-inch; Elkay LKPD1 Perfect Drain and Strainer.
 - 1) Location: Rear Center of bowl.
 3. Subject to compliance with requirements, provide trim products by one of the following:
 - a. McGuire Manufacturing Company.
 - b. Engineered Brass Company.
 - c. Keeney Manufacturing Company.
 4. Sink Trim
 - a. Supplies: Chrome-plated copper with 1/2" NPT x 3/8" OD loose key stops.
 - b. Drain Piping SK-7: Provide Solids Interceptor (SI-A), Zurn Z1180 or equivalent, Installed in cabinet next to sink. NPS 1-1/2 17 gauge tubular brass waste to wall; and wall escutcheon(s).
 - c. Drain Piping SK-9: NPS 1-1/2 chrome-plated cast-brass P-trap with cleanout; NPS 1-1/2 17 gauge tubular brass waste to wall; and wall escutcheon(s).
 5. Faucet: Basis-of-Design Product: Subject to compliance with requirements, provide Chicago 201-AGN8AE35ABCP or a comparable product by one of the following:
 - a. T & S Brass and Bronze Works, Inc.
 - b. Zurn Plumbing Products Group; Commercial Brass Operation.

6. Description: Manual-control mixing valve with gooseneck spout. Coordinate faucet inlets with supplies and fixture holes; coordinate outlet with spout and fixture receptor.
 - a. Body Material: Commercial, solid brass.
 - b. Finish: Polished chrome plate.
 - c. Maximum Flow Rate: 1.5 gpm.
 - d. Mixing Valve: Two-handle.
 - e. Centers: 8 inches.
 - f. Mounting: Deck, concealed.
 - g. Handle(s): Lever with color coded index button.
 - h. Inlet(s): NPS 1/2 male shank.
 - i. Spout Type: 8" gooseneck, swing, solid brass.
 - j. Spout Outlet: Aerator.
 - k. Operation: Quarter-turn, renewable compression, manual

2.17 MOP SINKS

A. Mop Sinks; MS-1:

1. Basis-of-Design Product: Subject to compliance with requirements, provide Fiat MSB-2424 or a comparable product by one of the following:
 - a. Swan.
 - b. Stern-Williams.
2. Description: One-bowl, floor-mounting, molded stone utility sink.
 - a. Overall Dimensions: 24 by 24 by 10 inches.
 - b. Drain: 3-inch I.P.S. cast brass with 16 gauge stainless steel dome strainer and lint basket.
 - c. Accessories:
 - 1) Hose and Bracket: Stainless steel hose bracket, spring-loaded rubber grip, 30" long heavy duty 5/8-inch rubber hose; Fiat 832 AA.
 - 2) Mop Hanger: Stainless steel mop hanger bracket, 24 by 3 inches, 3-spring loaded rubber grips; Fiat 889 CC.
 - 3) Stainless steel wall guards: Heavy gauge stainless steel, two/three panels as required; Fiat MSG 2424.

2.18 MOP SINK FAUCETS

A. Mop Sink Faucets; MS-1:

1. Basis-of-Design Product: Subject to compliance with requirements, provide Chicago 897-RFC or a comparable product by one of the following:
 - a. T & S Brass and Bronze Works, Inc.
 - b. Zurn Plumbing Products Group; Commercial Brass Operation.
2. Description: Service sink faucet with check stops in shanks, vacuum breaker, hose-thread outlet, and pail hook.

- a. Body Material: Commercial, solid brass.
- b. Finish: Rough chrome plate.
- c. Mixing Valve: Two-handle.
- d. Centers: Adjustable.
- e. Mounting: Back/wall, exposed.
- f. Handle(s): Lever with color coded index button.
- g. Inlet(s): NPS 1/2 male shank, with integral check stops.
- h. Spout Type: Rigid, solid brass with wall brace.
- i. Spout Outlet: Hose thread.
- j. Vacuum Breaker: Integral with spout.
- k. Operation: Quarter-turn compression, renewable, manual.

PART 3 - EXECUTION

3.1 INSTALLATION

- A. Assemble plumbing fixtures, trim, fittings, and other components according to manufacturers' written instructions.
- B. Install off-floor supports, affixed to building substrate, for wall-mounting fixtures.
 - 1. Use carrier supports with waste fitting and seal for back-outlet fixtures.
 - 2. Use carrier supports without waste fitting for fixtures with tubular waste piping.
- C. Install back-outlet, wall-mounting fixtures onto waste fitting seals and attach to supports.
- D. Install floor-mounting fixtures on closet flanges or other attachments to piping or building substrate.
- E. Install wall-mounting fixtures with tubular waste piping attached to supports.
- F. Install fixtures level and plumb according to roughing-in drawings.
- G. Install water-supply piping with stop on each supply to each fixture to be connected to water distribution piping. Attach supplies to supports or substrate within pipe spaces behind fixtures. Install stops in locations where they can be easily reached for operation.
- H. Install trap and tubular waste piping on drain outlet of each fixture to be directly connected to sanitary drainage system.
- I. Install tubular waste piping on drain outlet of each fixture to be indirectly connected to drainage system.
- J. Install flushometer valves for accessible water closets and urinals with handle mounted on wide side of compartment. Install other actuators in locations that are easy for people with disabilities to reach.
- K. Install toilet seats on water closets.
- L. Install traps on fixture outlets.

1. Exception: Omit trap on fixtures with integral traps.
2. Exception: Omit trap on indirect wastes, unless otherwise indicated.

- M. Connect drain outlet hose from dishwasher to drain connection on disposer.
- N. Install escutcheons at piping wall and ceiling penetrations in exposed, finished locations and within cabinets and millwork. Use deep-pattern escutcheons if required to conceal protruding fittings. Escutcheons are specified in Division 20 Section "Common Work Materials and Methods for Fire Suppression, Plumbing, and HVAC."
- O. Set mop sinks in leveling bed of cement grout. Grout is specified in Division 20 Section "Common Work Materials and Methods for Fire Suppression, Plumbing, and HVAC."
- P. Seal joints between fixtures and walls, floors, and countertops using sanitary-type, one-part, mildew-resistant silicone sealant. Match sealant color to fixture color. Sealants are specified in Division 07 Section "Joint Sealants."

3.2 CONNECTIONS

- A. Piping installation requirements are specified in other Division 20 Sections. Drawings indicate general arrangement of piping, fittings, and specialties.
- B. Connect fixtures with water supplies, stops, and risers, and with traps, soil, waste, and vent piping. Use size fittings required to match fixtures.

3.3 FIELD QUALITY CONTROL

- A. Verify that installed plumbing fixtures are categories and types specified for locations where installed.
- B. Check that plumbing fixtures are complete with trim, faucets, fittings, and other specified components.
- C. Inspect installed plumbing fixtures for damage. Replace damaged fixtures and components.
- D. Test installed fixtures after water systems are pressurized for proper operation. Replace malfunctioning fixtures and components, then retest. Repeat procedure until units operate properly.
- E. Install fresh batteries in sensor-operated mechanisms.

3.4 PROTECTION

- A. Provide protective covering for installed fixtures and fittings.
- B. Do not allow use of plumbing fixtures for temporary facilities unless approved in writing by Owner.

END OF SECTION

SECTION 32 31 19 - DECORATIVE METAL FENCES AND GATES

PART 1 - GENERAL

1.01 RELATED DOCUMENTS

- A. Drawings and general provisions of the Contract, including General and Supplementary Conditions and Division 01 Specification Sections, apply to this Section.

1.02 SUMMARY

- A. Section Includes:
 - 1. Decorative aluminum fences.
 - 2. Swing gates.

1.03 ACTION SUBMITTALS

- A. Product Data: For each type of product.
- B. Shop Drawings: For fencing and gates.
 - 1. Include plans, elevations, sections, gate locations, post spacing, and mounting attachment details.
- C. Samples: For each fence material and for each color specified.
 - 1. Provide Samples 12 inches (300 mm) in length for linear materials.
 - 2. Provide Samples 12 inches (300 mm) square for sheet or plate materials.
- D. Delegated-Design Submittal: For installed products indicated to comply with performance requirements and design criteria, including analysis data signed and sealed by the qualified professional engineer responsible for their preparation.

1.04 CLOSEOUT SUBMITTALS

- A. Maintenance Data: For gate operators to include in maintenance manuals.

1.05 QUALITY ASSURANCE

- A. Installer Qualifications: Fabricator of products.

PART 2 - PRODUCTS

2.01 PERFORMANCE REQUIREMENTS

- A. Delegated Design: Design aluminum fence and gate system, including comprehensive engineering analysis by a qualified professional engineer, licensed in the State the project is located, using performance requirements and design criteria indicated.
- B. Wind Loading:

1. Wind Exposure Category: B.
2. Design Wind Speed: 120 mph (193 kph).

2.02 DECORATIVE ALUMINUM FENCES

- A. Decorative Aluminum Fences: Fences made from aluminum extrusions.
1. Basis-of-Design Product: Subject to compliance with requirements, provide Knot-wood; a brand of OmniMax International or comparable product by one of the following:
 - a. Superior Aluminum Products, Inc.
 - b. Ultra Aluminum Mfg., Inc.
 - c. Virginia Railing and Gates, LLC.
- B. Posts and Rails: Square extruded aluminum tubes and channels.
1. Line Posts: 2-1/2 by 2-1/2 inches (64 by 64 mm) with 0.125-inch (3.18-mm) wall thickness.
 2. End and Corner Posts: 2-1/2 by 2-1/2 inches (64 by 64 mm) with 0.125-inch (3.18-mm) wall thickness.
 3. Swing Gate Posts: 4 by 4 inches (102 by 102 mm) with 0.250-inch (6.35-mm) wall thickness.
- C. Post Caps: Aluminum extrusions that cover entire top of posts and infill.
- D. Infill Slats: Extruded-aluminum tubing; nominal 6 by 5/8 inch (150 by 16 mm) rectangular slats, oriented horizontally as indicated on Drawings.
1. Infill Spacing: None.
- E. Fasteners: Manufacturer's standard tamperproof, corrosion-resistant, color-coated fasteners matching fence components with resilient polymer washers.
- F. Finish exposed welds to comply with NOMMA Guideline 1, Finish #2 - completely sanded joint, some undercutting and pinholes okay.
- G. Finish: Manufacturer's standard powder coating.
- H. Color: White.

2.03 SWING GATES

- A. Gate Configuration: As indicated on drawings.
- B. Gate Frame Height: As indicated to match height of fence.
- C. Gate Opening Width: As indicated on drawings.
- D. Aluminum Frames and Bracing: Fabricate members from square extruded-aluminum tubes size and wall thickness as required to confirm to performance requirements..
- E. Additional Rails: Provide as indicated, complying with requirements for fence rails.

- F. Infill: Comply with requirements for adjacent fence.
- G. Hardware: Reference Section 08 71 00 Door Hardware.
- H. Finish exposed welds to comply with NOMMA Guideline 1, Finish #2 - completely sanded joint, some undercutting and pinholes okay.
- I. Galvanizing: For items other than hardware that are indicated to be galvanized, hot-dip galvanize to comply with ASTM A 123/A 123M. For hardware items, hot-dip galvanize to comply with ASTM A 153/A 153M.
- J. Finish: Manufacturer's standard powder coating.

2.04 ALUMINUM

- A. Aluminum, General: Provide alloys and tempers with not less than the strength and durability properties of alloy and temper designated in paragraphs below for each aluminum form required.
- B. Extrusions: ASTM B 221 (ASTM B 221M), Alloy 6063-T5.
- C. Tubing: ASTM B 429/B 429M, Alloy 6063-T6.
- D. Plate and Sheet: ASTM B 209 (ASTM B 209M), Alloy 6061-T6.
- E. Die and Hand Forgings: ASTM B 247 (ASTM B 247M), Alloy 6061-T6.
- F. Castings: ASTM B 26/B 26M, Alloy A356.0-T6.

2.05 MISCELLANEOUS MATERIALS

- A. Concrete: Normal-weight, air-entrained, ready-mix concrete complying with requirements in Section 033000 "Cast-in-Place Concrete" with a minimum 28-day compressive strength of 3000 psi (20 MPa), 3-inch (75-mm) slump, and 1-inch (25-mm) maximum aggregate size.
- B. Non-shrink Grout: Factory-packaged, non-staining, noncorrosive, nongaseous grout complying with ASTM C 1107/C 1107M and specifically recommended by manufacturer for exterior applications.

2.06 ALUMINUM FINISHES

- A. Baked-Enamel or Powder-Coat Finish: AAMA 2603 except with a minimum dry film thickness of 2 mils (0.05 mm). Comply with coating manufacturer's written instructions for cleaning, conversion coating, and applying and baking finish.
 - 1. Color and Gloss: As selected by Architect from manufacturer's full range.

PART 3 - EXECUTION

3.01 EXAMINATION

- A. Examine areas and conditions, with Installer present, for compliance with requirements for site clearing, earthwork, pavement work, construction layout, and other conditions affecting performance of the Work.
- B. Do not begin installation before final grading is completed unless otherwise permitted by Architect.
- C. Proceed with installation only after unsatisfactory conditions have been corrected.

3.02 PREPARATION

- A. Stake locations of fence lines, gates, and terminal posts. Do not exceed intervals of 500 feet (152.5 m) or line of sight between stakes. Indicate locations of utilities, lawn sprinkler system, underground structures, benchmarks, and property monuments. Verify field measurements, surfaces, substrates and conditions are as required and ready to receive Work.

3.03 DECORATIVE FENCE INSTALLATION

- A. Install fences according to manufacturer's written instructions.
- B. Contractor shall consult with local jurisdictional authorities regarding specific utility locate requirements. Contractor shall arrange for local underground utility locate service to identify and locate potential below-grade utility hazards such as electric, gas, water, sewer, telecommunications and similar infrastructure prior to commencing clearing, digging, excavating or fence installation work.
- C. Contractor shall install fencing in accordance with Manufacturer Installation Instructions and approved shop drawings. Fence posts shall be located and spaced in accordance with Manufacturer drawings. Posts shall be set in suitable concrete footers designed and constructed for structural integrity in specific application.
 - 1. Setting of fence posts by other methods (e.g. base plate mounting, grouted core-drilled footers) is permissible only as determined by Architect.
 - 2. Should contractor elect to substitute foundation design, contractor shall make sure design and construction of alternate foundation design will be sufficient for intended application.
- D. Post Excavation: Drill or hand-excavate holes for posts in firm, undisturbed soil. Excavate holes to a diameter of not less than 4 times post size and a depth of not less than 24 inches (600 mm) plus 3 inches (75 mm) for each foot (300 mm) or fraction of a foot (300 mm) that fence height exceeds 4 feet (1.2 m).
- E. Post Setting: Set posts in concrete with mechanical anchors at indicated spacing into firm, undisturbed soil.
 - 1. Verify that posts are set plumb, aligned, and at correct height and spacing, and hold in position during setting with concrete or mechanical devices.
 - 2. Concrete Fill: Place concrete around posts and sleeves and vibrate or tamp for consolidation. Protect aboveground portion of posts from concrete splatter.

- a. Exposed Concrete: Extend 2 inches (51 mm) above grade. Finish and slope top surface to drain water away from post.
 - b. Concealed Concrete: Top 2 inches (51 mm) below grade to allow covering with surface material. Slope top surface of concrete to drain water away from post.
3. Posts Set in Concrete: Extend post to within 6 inches (150 mm) of specified excavation depth, but not closer than 3 inches (75 mm) to bottom of concrete.
 4. Posts Set into Concrete in Sleeves: Use galvanized-steel pipe sleeves with inside diameter at least 3/4 inch (20 mm) larger than outside diagonal dimension of post, preset and anchored into concrete for installing posts.
 - a. Extend posts at least 5 inches (125 mm) into sleeve.
 - b. After posts have been inserted into sleeves, fill annular space between post and sleeve with non-shrink grout, mixed and placed to comply with grout manufacturer's written instructions; shape and smooth to shed water. Finish and slope top surface of grout to drain water away from post.
 5. Posts Set into Voids in Concrete: Form or core drill holes not less than 3/4 inch (20 mm) larger than outside diagonal dimension of post.
 - a. Extend posts at least 5 inches (125 mm) into concrete.
 - b. Clean holes of loose material, insert posts, and fill annular space between post and concrete with non-shrink grout, mixed and placed to comply with grout manufacturer's written instructions. Finish and slope top surface of grout to drain water away from post.
 6. Fence installation may require limited cutting or drilling to accommodate slight variations in field measurements and normal construction tolerances. Contractor shall take reasonable precautions to make sure exposed metal surfaces are properly sealed from environment, as described below.
 - a. Carefully inspect fence and metal components during installation.
 - b. Remove metal shavings from drilling or cutting of posts or metal fence components.
 - c. Where drilling or cutting was determined to be necessary, clean metal surfaces and apply two (2) coats of zinc-rich metal primer to thoroughly cover each cut edge or hole drilled during installation processes. Allow each coat to dry thoroughly.
 - d. Apply two (2) thin coats of Manufacturer-supplied custom touch-up paint to such locations. Allow each coat to dry thoroughly.
 - e. Inspect work and verify each drilled or cut metal surface was properly treated, as described above
 - f. NOTE: Failure to properly clean, prime and finish paint exposed surfaces as described in steps listed above shall void Manufacturer Warranty

3.04 GATE INSTALLATION

- A. Install gates according to manufacturer's written instructions, level, plumb, and secure for full opening without interference. Attach hardware using tamper-resistant or concealed means. Install ground-set items in concrete for anchorage. Adjust hardware for smooth operation and lubricate where necessary.

3.05 ADJUSTING

- A. Gates: Adjust gates to operate smoothly, easily, and quietly, free of binding, warp, excessive deflection, distortion, nonalignment, misplacement, disruption, or malfunction, throughout entire operational range. Confirm that latches and locks engage accurately and securely without forcing or binding.
- B. Lubricate hardware and other moving parts.

END OF SECTION




LILLIAN SCHMITT ELEMENTARY SCHOOL

RENOVATIONS

2675 CALIFORNIA STREET
COLUMBUS, INDIANA 47201

100% CIVIL PLANS
FEBRUARY 16, 2024

ADDENDUM #1: MARCH 8, 2024
ADDENDUM #2: MARCH 15, 2024

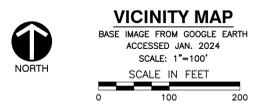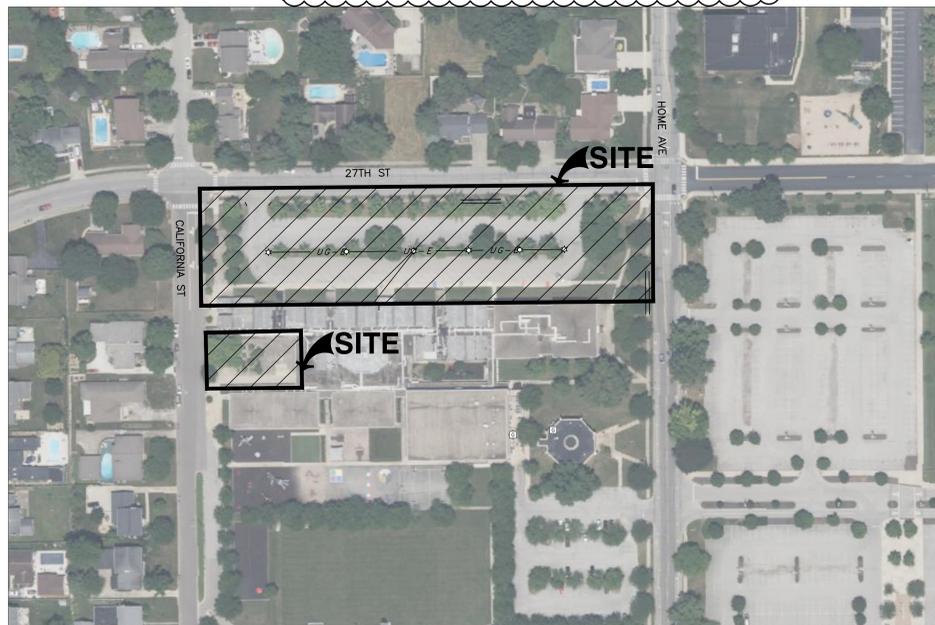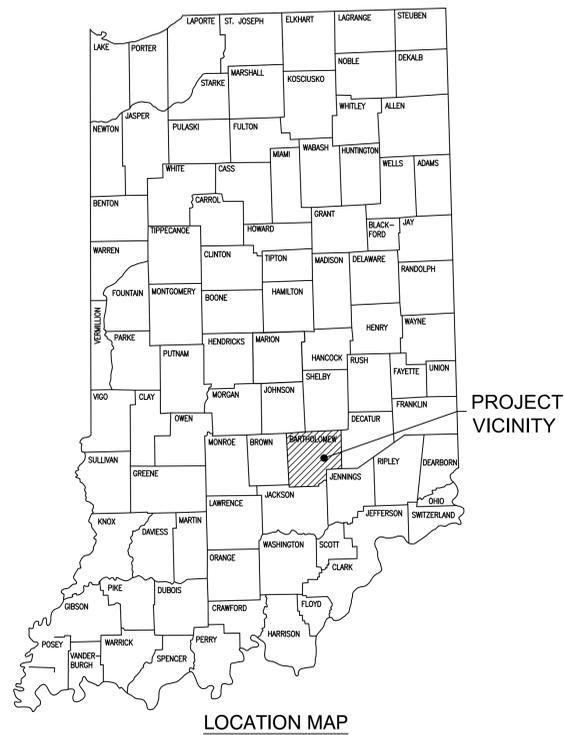

Sheet Number	Sheet Title	Drawing No.
01	TITLE SHEET	C000
02	BOUNDARY RETRACEMENT SURVEY	BNDY
03	BOUNDARY RETRACEMENT SURVEY	BNDY
04	TOPOGRAPHIC SURVEY	TOPO
05	TOPOGRAPHIC SURVEY	TOPO
06	DEMOLITION PLAN	C101
07	GRADING PLAN	C300
08	FLOOD ROUTING PLAN	C301
09	GRADING PLAN - SOUTH ALTERNATE	C302
10	DRAINAGE PLAN	C400
11	DRAINAGE PROFILE	C401
12	UTILITY PLAN	C500
13	UTILITY PLAN SOUTH ALTERNATE	C501
13	PLAN DETAILS	C800
14	PLAN DETAILS	C801
15	STORMWATER POLLUTION PREVENTION PLAN	C900
16	STORMWATER POLLUTION PREVENTION NOTES	C901
17	STORMWATER POLLUTION PREVENTION PLAN - ALTERNATE	C902
18	STORMWATER POLLUTION PREVENTION DETAILS	C903
	CITY OF COLUMBUS STANDARD DETAILS	

PROJECT TEAM:

**LANDSCAPE ARCHITECT
CONTEXT DESIGN**
5825 LAWTON LOOP E DR
INDIANAPOLIS, IN 46216
PH: (317) 485-6900
CONTACT: FRED PRAZEAU
EMAIL: fprazeau@context-design.com

**CIVIL ENGINEER
CIVIL & ENVIRONMENTAL
CONSULTANTS, INC.**
530 E. OHIO ST., STE. G
INDIANAPOLIS, IN 46204
PH: (317) 655-7777
CONTACT: JONATHAN PASYK
EMAIL: jpasyk@cecinc.com

**SURVEYOR
CIVIL & ENVIRONMENTAL
CONSULTANTS, INC.**
530 E. OHIO ST., STE. G
INDIANAPOLIS, IN 46204
PH: (317) 655-7777
CONTACT: ANTHONY SYERS
EMAIL: asyers@cecinc.com

**ARCHITECT
CSO ARCHITECTS**
8831 KEYSTONE CROSSING
INDIANAPOLIS, IN 46240
PH: (317) 848-7800
CONTACT: JIM FUNK
EMAIL: JFunk@CSOinc.net

UTILITIES:

GAS VECTREN 4324 MIDDLE RD COLUMBUS, IN 47203	ELECTRIC DUKE ENERGY 2727 CENTRAL AVE COLUMBUS, IN 47201	SANITARY SEWER COLUMBUS CITY UTILITIES 1111 MCCLURE RD COLUMBUS, IN 47201 (812)372-8861 ATTN: SCOTT DOMPKE
STORM SEWER COLUMBUS ENGINEERING 123 WASHINGTON ST. COLUMBUS, IN 47201 (812)376-2540 ATTN: ANDREW BECKORT	WATER COLUMBUS CITY UTILITIES 1111 MCCLURE RD COLUMBUS, IN 47201 (812)372-8861 ATTN: SCOTT DOMPKE	FIRE DEPARTMENT COLUMBUS FIRE DEPARTMENT 1101 JACKSON ST. COLUMBUS, IN 47201 (812)376-2583 ATTN: TROY TODD

**PLANNING DEPARTMENT
COLUMBUS PLANNING DEPARTMENT**
123 WASHINGTON ST.
COLUMBUS, IN 47201
(812)376-2550
ATTN: JEFF BERGMAN

FLOOD NOTE:
THE PARCEL DESCRIBED AND SHOWN HEREIN LIES WITHIN ZONE "X" (UN-SHADED) AS SAID PARCEL PLOTS ON MAP NUMBER 18005C0131E (DATED DECEMBER 9, 2014) OF THE FLOOD INSURANCE RATE MAPS FOR THE CITY OF COLUMBUS, BARTHOLOMEW COUNTY, INDIANA. THE ACCURACY OF THIS FLOOD HAZARD STATEMENT IS SUBJECT TO MAP SCALE UNCERTAINTY AND TO ANY OTHER UNCERTAINTY IN LOCATION OR ELEVATION ON THE REFERENCED FLOOD INSURANCE RATE MAP.

BENCHMARKS:
UNLESS OTHERWISE NOTED, ELEVATIONS SHOWN HEREON ARE BASED UPON AN ORIPUS SOLUTION AND ARE ON THE 1988 NORTH AMERICAN VERTICAL DATUM (NAVD88) (GEOID 18). IT IS MY OPINION THAT THE UNCERTAINTY IN THE ELEVATION OF THE PROJECT BENCHMARK DOES NOT EXCEED 0.10 FOOT.

TBM#1: SET MAGNAIL ON TOP OF A LIGHT BASE LOCATED APPROXIMATELY 140 FEET SOUTH OF THE SOUTHWEST CORNER OF THE SITE. ELEV. = 639.79

TBM#2: NORTHEAST BOLT ON TOP OF A FIRE HYDRANT LOCATED IN THE SOUTHWEST QUADRANT OF THE INTERSECTION OF CALIFORNIA ST. AND 27TH ST. ELEV. = 639.31

TBM#3: SOUTHWEST BOLT ON TOP OF A FIRE HYDRANT LOCATED IN THE NORTHWEST QUADRANT OF THE INTERSECTION OF HOME AVE. AND 27TH ST. ELEV. = 636.88

TBM#4: NORTHEAST BOLT ON TOP OF A FIRE HYDRANT LOCATED AT THE SOUTHEAST CORNER OF THE SITE. ELEV. = 636.48

UTILITY NOTE:
THE UNDERGROUND UTILITIES SHOWN HAVE BEEN LOCATED FROM FIELD SURVEY INFORMATION AND EXISTING DRAWINGS. THE SURVEYOR MAKES NO GUARANTEES THAT THE UNDERGROUND UTILITIES COMPRISE ALL SUCH UTILITIES IN THE AREA, EITHER IN-SERVICE OR ABANDONED. THE SURVEYOR FURTHER DOES NOT WARRANT THAT THE UNDERGROUND UTILITIES SHOWN ARE IN THE EXACT LOCATION INDICATED ALTHOUGH THE SURVEYOR DOES CERTIFY THAT THEY ARE LOCATED AS ACCURATELY AS POSSIBLE FROM INFORMATION AVAILABLE. THE SURVEYOR HAS NOT PHYSICALLY LOCATED THE UNDERGROUND UTILITIES. INDIANA 911 ONE-CALL PUBLIC UTILITY LOCATE SERVICE TICKET NUMBER 2310171909 WAS ISSUED FOR THIS SITE. AMERICAN LOCATING SERVICES, A PRIVATE SUBSURFACE UTILITY LOCATING SERVICE, WAS CONTRACTED TO PERFORM THE PRIVATE UTILITY LOCATIONS FOR THE SUBJECT SITE. THE PRIVATE UTILITIES LOCATED AND DEPICTED HEREIN WERE EITHER OBSERVED FROM MARKINGS ON THE GROUND OR USING EXISTING PLANS PROVIDED BY THE SCHOOL.

PRIOR TO ANY EXCAVATION FOR UNDERGROUND UTILITIES, THE CONTRACTOR SHALL EXPOSE AND VERIFY LOCATIONS (HORIZONTAL AND VERTICAL) OF ALL EXISTING UTILITIES INCLUDING, BUT NOT LIMITED TO, GAS, WATER, AND SANITARY SEWER. ANY CONFLICTS SHALL BE REPORTED IMMEDIATELY TO THE ENGINEER AND THE APPROPRIATE AUTHORITIES.



Civil & Environmental Consultants, Inc.
530 E. Ohio Street, Suite G - Indianapolis, IN 46204
317-655-7777 - 817-746-0749
www.cecinc.com

PROJECT:
**BARTHOLOMEW CONSOLIDATED
SCHOOL CORPORATION
RENOVATIONS TO
L. C. SCHMITT ELEMENTARY**
2675 CALIFORNIA STREET, COLUMBUS, IN 47201

SCOPE DRAWINGS:
These drawings indicate the general scope of the project in terms of architectural design concept, the development of structural, mechanical and electrical systems.
The drawings do not necessarily indicate or describe all work required for the performance and completion of the project.
On the basis of the general scope indicated or described, the contractor shall furnish all items required for the proper execution and completion of the work.

REVISIONS:
03/08/2024 - ADDENDUM #01
03/15/2024 - ADDENDUM #02

ISSUE DATE	DRAWN BY	CHECKED BY
02/16/2024	RT	JP


DRAWING TITLE:
TITLE SHEET



DRAWING NUMBER
C000

PROJECT NUMBER
2021049



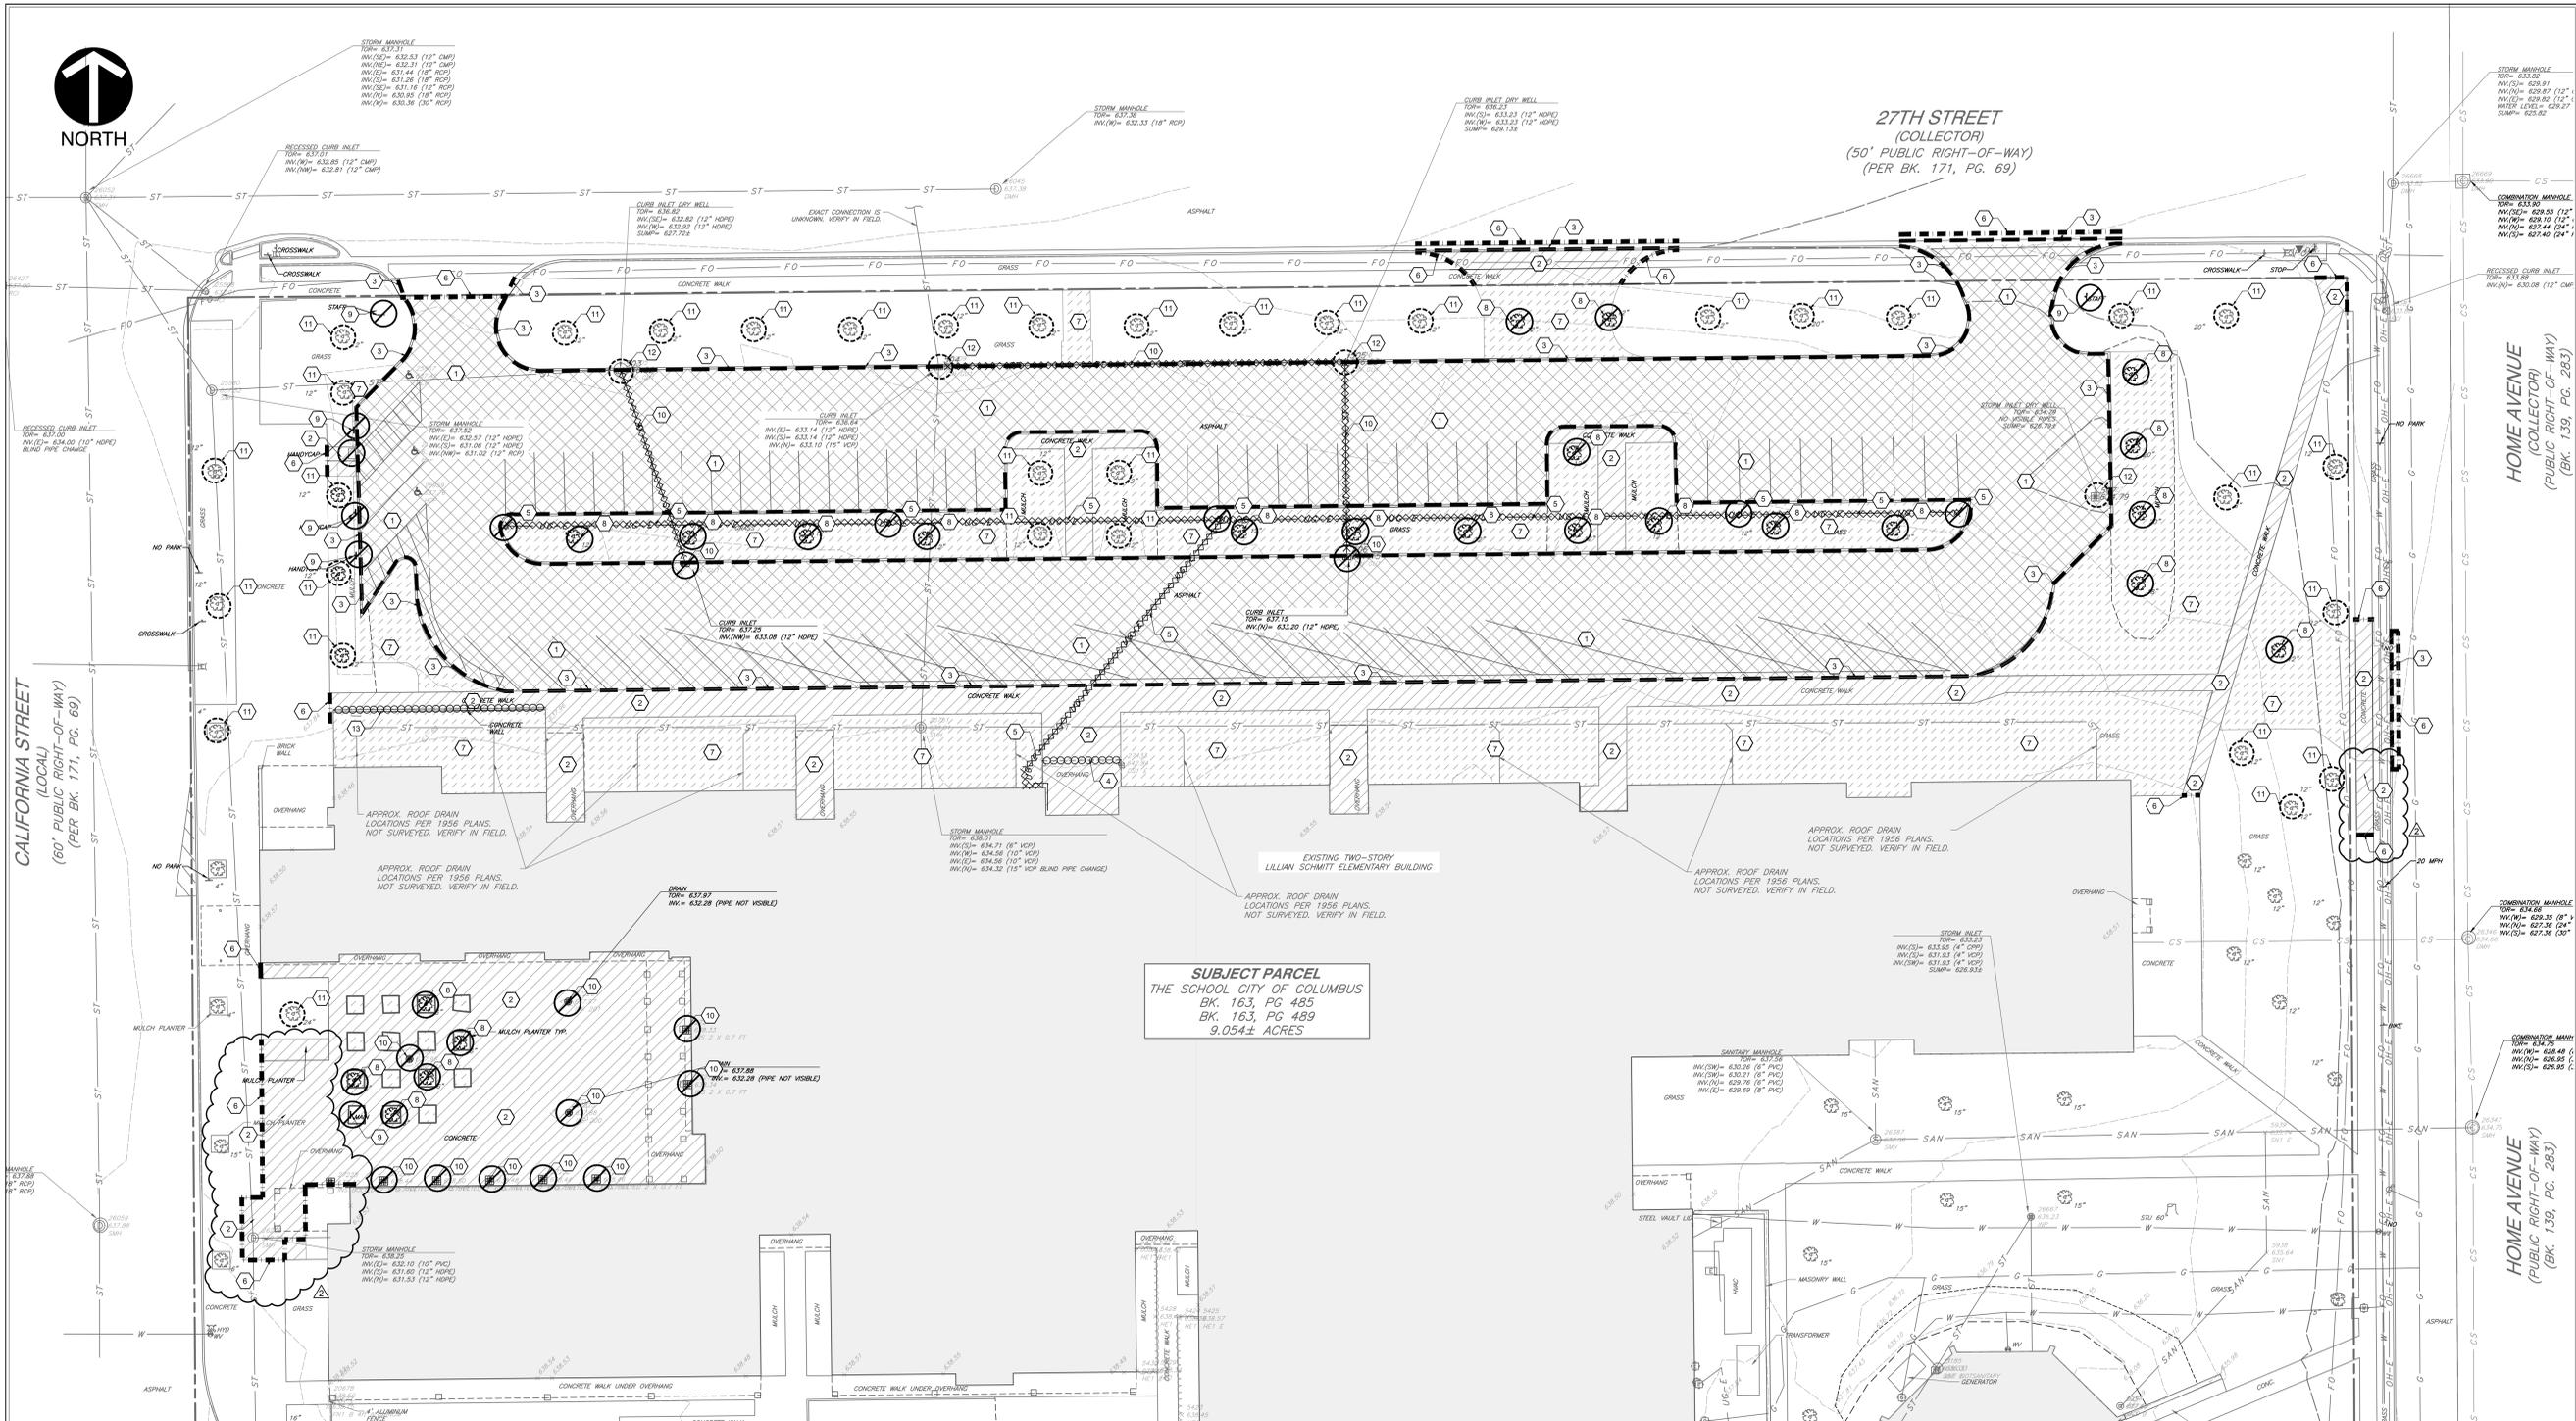

SUBJECT PARCEL
 THE SCHOOL CITY OF COLUMBUS
 BK. 163, PG. 485
 BK. 163, PG. 489
 9.054± ACRES

27TH STREET
 (COLLECTOR)
 (50' PUBLIC RIGHT-OF-WAY)
 (PER BK. 171, PG. 69)

HOME AVENUE
 (COLLECTOR)
 (PUBLIC RIGHT-OF-WAY)
 (BK. 139, PG. 283)

CALIFORNIA STREET
 (LOCAL)
 (60' PUBLIC RIGHT-OF-WAY)
 (PER BK. 171, PG. 69)

HOME AVENUE
 (PUBLIC RIGHT-OF-WAY)
 (BK. 139, PG. 283)



DEMOLITION NOTES:

- THE CONTRACTOR SHALL BE RESPONSIBLE FOR REMOVAL AND DISPOSAL OFF-SITE OF ALL ITEMS SHOWN ON THE DEMOLITION PLAN INCLUDING ITEMS ENCOUNTERED DURING EXCAVATION OF BUILDING FOUNDATIONS AND UTILITY PLACEMENT.
- PRIOR TO STARTING DEMOLITION, IT IS THE RESPONSIBILITY OF THE CONTRACTOR TO OBTAIN ALL PERMITS REQUIRED BY LOCAL GOVERNMENTAL AGENCIES.
- THE CONTRACTOR SHALL COORDINATE WITH THE LOCAL UTILITY COMPANIES FOR THE DISCONNECTION AND REMOVAL OF SERVICES TO EXISTING STRUCTURES.
- ITEMS SHOWN ON THE DEMOLITION PLAN TO BE SALVAGED SHALL BE TRANSPORTED TO LOCATION SPECIFIED BY THE OWNER OR HIS/HER REPRESENTATIVE.
- ITEMS OF SALVAGEABLE VALUE TO THE CONTRACTOR MAY BE REMOVED WITH THE OWNER OR HIS/HER REPRESENTATIVE'S PERMISSION. THE CONTRACTOR SHALL NOT STORE THESE ITEMS ON SITE.
- THE CONTRACTOR MAY NOT USE EXPLOSIVES OR BURN DEBRIS.
- CONDUCT DEMOLITION OPERATIONS TO ENSURE MINIMAL INTERFERENCE WITH ROADS, SIDEWALKS AND ANY OTHER ADJACENT OCCUPIED FACILITIES.
- DO NOT CLOSE OR OBSTRUCT ROADS, SIDEWALKS OR ANY OTHER OCCUPIED FACILITIES WITHOUT PERMISSION FROM THE LOCAL AUTHORITY HAVING JURISDICTION AND/OR PROPERTY OWNERS.
- THE CONTRACTOR SHALL ENSURE SAFE PASSAGE OF PERSON TRAVELING THROUGH OR AROUND THE CONSTRUCTION SITE.
- THE CONTRACTOR SHALL PROTECT FROM DAMAGE, SURROUNDING STRUCTURES, UTILITIES AND OTHER FACILITIES DURING DEMOLITION AND REMOVAL OPERATIONS.
- BUILDING STRUCTURES INCLUDING FOUNDATIONS OR BASEMENTS SHALL BE REMOVED AND BACKFILLED WITH APPROVED BACKFILL MATERIAL. BACKFILL MATERIAL SHALL BE PLACED IN MAXIMUM EIGHT INCH LIFTS AND COMPACTED IN ACCORDANCE WITH THE GEOTECHNICAL REPORT OR A MINIMUM OF 95% OF A STANDARD PROCTOR.
- UTILITIES SHALL BE REMOVED AND BACKFILLED WITH APPROVED BACKFILL MATERIAL. BACKFILL MATERIAL SHALL BE PLACED IN MAXIMUM EIGHT INCH LIFTS AND COMPACTED IN ACCORDANCE WITH THE GEOTECHNICAL REPORT OR A MINIMUM OF 95% OF A STANDARD PROCTOR.
- THE CONTRACTOR SHALL BE RESPONSIBLE FOR ENSURING THE CONSTRUCTION SITE AND SURROUNDING AREAS ARE FREE OF ACCUMULATED DEBRIS.

FLOOD NOTE:

THE PARCEL DESCRIBED AND SHOWN HEREIN LIES WITHIN ZONE "X" (UN-SHADOWED) AS SAID PARCEL PLOTS ON MAP NUMBER 1800500131E (DATED DECEMBER 9, 2014) OF THE FLOOD INSURANCE RATE MAPS FOR THE CITY OF COLUMBUS, BARTHOLOMEW COUNTY, INDIANA. THE ACCURACY OF THIS FLOOD HAZARD STATEMENT IS SUBJECT TO MAP SCALE UNCERTAINTY AND TO ANY OTHER UNCERTAINTY IN LOCATION OR ELEVATION ON THE REFERENCED FLOOD INSURANCE RATE MAP.

BENCHMARKS:

- UNLESS OTHERWISE NOTED, ELEVATIONS SHOWN HEREON ARE BASED UPON AN OPUS SOLUTION AND ARE ON THE 1988 NORTH AMERICAN VERTICAL DATUM (NAVD83) (GEOID 18). IT IS MY OPINION THAT THE UNCERTAINTY IN THE ELEVATION OF THE PROJECT BENCHMARK DOES NOT EXCEED 0.10 FOOT.
- BM#1: SET MAGNAIL ON TOP OF A LIGHT BASE LOCATED APPROXIMATELY 140 FEET SOUTH OF THE SOUTHWEST CORNER OF THE SITE. ELEV. = 639.79
 - BM#2: NORTHEAST BOLT ON TOP OF A FIRE HYDRANT LOCATED IN THE SOUTHWEST QUADRANT OF THE INTERSECTION OF CALIFORNIA ST. AND 27TH ST. ELEV. = 639.31
 - BM#3: SOUTHWEST BOLT ON TOP OF A FIRE HYDRANT LOCATED IN THE NORTHWEST QUADRANT OF THE INTERSECTION OF HOME AVE. AND 27TH ST. ELEV. = 636.88
 - BM#4: NORTHEAST BOLT ON TOP OF A FIRE HYDRANT LOCATED AT THE SOUTHEAST CORNER OF THE SITE. ELEV. = 636.48

UTILITY NOTE:

THE UNDERGROUND UTILITIES SHOWN HAVE BEEN LOCATED FROM FIELD SURVEY INFORMATION AND EXISTING DRAWINGS. THE SURVEYOR MAKES NO GUARANTEES THAT THE UNDERGROUND UTILITIES COMPRISE ALL SUCH UTILITIES IN THE AREA, EITHER IN-SERVICE OR ABANDONED. THE SURVEYOR FURTHER DOES NOT WARRANT THAT THE UNDERGROUND UTILITIES SHOWN ARE IN THE EXACT LOCATION INDICATED ALTHOUGH THE SURVEYOR DOES CERTIFY THAT THEY ARE LOCATED AS ACCURATELY AS POSSIBLE FROM INFORMATION AVAILABLE. THE SURVEYOR HAS NOT PHYSICALLY LOCATED THE UNDERGROUND UTILITIES. INDIANA 811 ONE-CALL PUBLIC UTILITY LOCATE SERVICE TICKET NUMBER 2310171909 WAS ISSUED FOR THIS SITE. AMERICAN LOCATING SERVICES, A PRIVATE SUBSURFACE UTILITY LOCATING SERVICE, WAS CONTRACTED TO PERFORM THE PRIVATE UTILITY LOCATIONS FOR THE SUBJECT SITE. THE PRIVATE UTILITIES LOCATED AND DEPICTED HEREIN WERE EITHER OBSERVED FROM MARKINGS ON THE GROUND OR USING EXISTING PLANS PROVIDED BY THE SCHOOL.

PRIOR TO ANY EXCAVATION FOR UNDERGROUND UTILITIES, THE CONTRACTOR SHALL EXPOSE AND VERIFY LOCATIONS (HORIZONTAL AND VERTICAL) OF ALL EXISTING UTILITIES INCLUDING BUT NOT LIMITED TO GAS, WATER, AND SANITARY SEWER. ANY CONFLICTS SHALL BE REPORTED IMMEDIATELY TO THE ENGINEER AND THE APPROPRIATE AUTHORITIES.

DEMOLITION ITEMS:

- REMOVE EXISTING ASPHALT & BASE COMPLETE; DISPOSE OF OFF SITE.
- REMOVE EXISTING CONCRETE COMPLETE; DISPOSE OF OFF SITE.
- REMOVE EXISTING CONCRETE CURB COMPLETE; DISPOSE OF OFF SITE.
- REMOVE EXISTING BIKE RACKS; COORDINATE REUSE/RELOCATION/DISPOSAL WITH OWNER.
- REMOVE EXISTING ELECTRICAL LINE, LIGHT POLE, AND CONCRETE BASE COMPLETE; COORDINATE WITH SITE LIGHTING PLANS.
- FULL DEPTH SAWCUT CUT CONCRETE AT JOINT LINES WHEN POSSIBLE.
- EXISTING SITE LANDSCAPING/LAWN/VEGETATION TO BE REMOVED COMPLETE; COORDINATE WITH LANDSCAPING PLANS.
- REMOVE EXISTING TREE/SHRUB COMPLETE; DISPOSE OF OFF SITE.
- REMOVE EXISTING SIGN. COORDINATE REUSE/RELOCATION/DISPOSAL WITH OWNER/CITY. DISPOSE OF DISCARDED ITEMS OFF SITE.
- REMOVE EXISTING STORM SEWER INFRASTRUCTURES AND STORM SEWER COMPLETE; DISPOSE OF OFF SITE.
- TREE PROTECTION.
- EXISTING STORM STRUCTURE TO REMAIN, REMOVE AND REPLACE EXISTING CASTING, ADD RISER RINGS OR PRECAST MONOLITHIC SECTION WHEN EXCEEDING 12" OF RISE, REHABILITATE STRUCTURE, REFER TO SHEET C400.
- REMOVE EXISTING CONCRETE WALL; DISPOSE OF OFF SITE.

DEMOLITION LEGEND:

- ASPHALT TO BE REMOVED
- CONCRETE TO BE REMOVED
- EXISTING TREES/LANDSCAPING/LAWN/TRASH TO BE REMOVED
- CONCRETE CURB TO BE REMOVED
- SAWCUT EXISTING PAVEMENT
- EXISTING UTILITY TO BE REMOVED
- MISC. ITEM TO BE REMOVED
- MISC. ITEM TO BE REMOVED
- PROTECT EXISTING ITEM



Civil & Environmental Consultants, Inc.
 530 E. Ohio Street, Suite G - Indianapolis, IN 46204
 317-455-7777 • 877-746-6749
 www.ceconline.com

BARTHOLOMEW CONSOLIDATED SCHOOL CORPORATIONS TO RENOVATIONS TO L. C. SCHMITT ELEMENTARY
 2875 CALIFORNIA STREET, COLUMBUS, IN 47201

SCOPE DRAWINGS:
 These drawings include the general scope of the project in terms of architectural design concept, the development of structural, mechanical and electrical systems. The design is not necessarily inclusive or exclusive of work required for the general scope indicated or described in the Contract.

REVISIONS:
 03/08/2024 - ADDENDUM #01
 03/15/2024 - ADDENDUM #02


ISSUE DATE DRAWN BY CHECKED BY
 02/16/2024 RT JP

DRAWING TITLE:
DEMOLITION PLAN

CERTIFIED BY:
 IOWAN M. PATEY
 REGISTERED PROFESSIONAL ENGINEER
 No. PE12100829
 STATE OF INDIANA
 02/16/24

DRAWING NUMBER
C101
 PROJECT NUMBER
 2021049



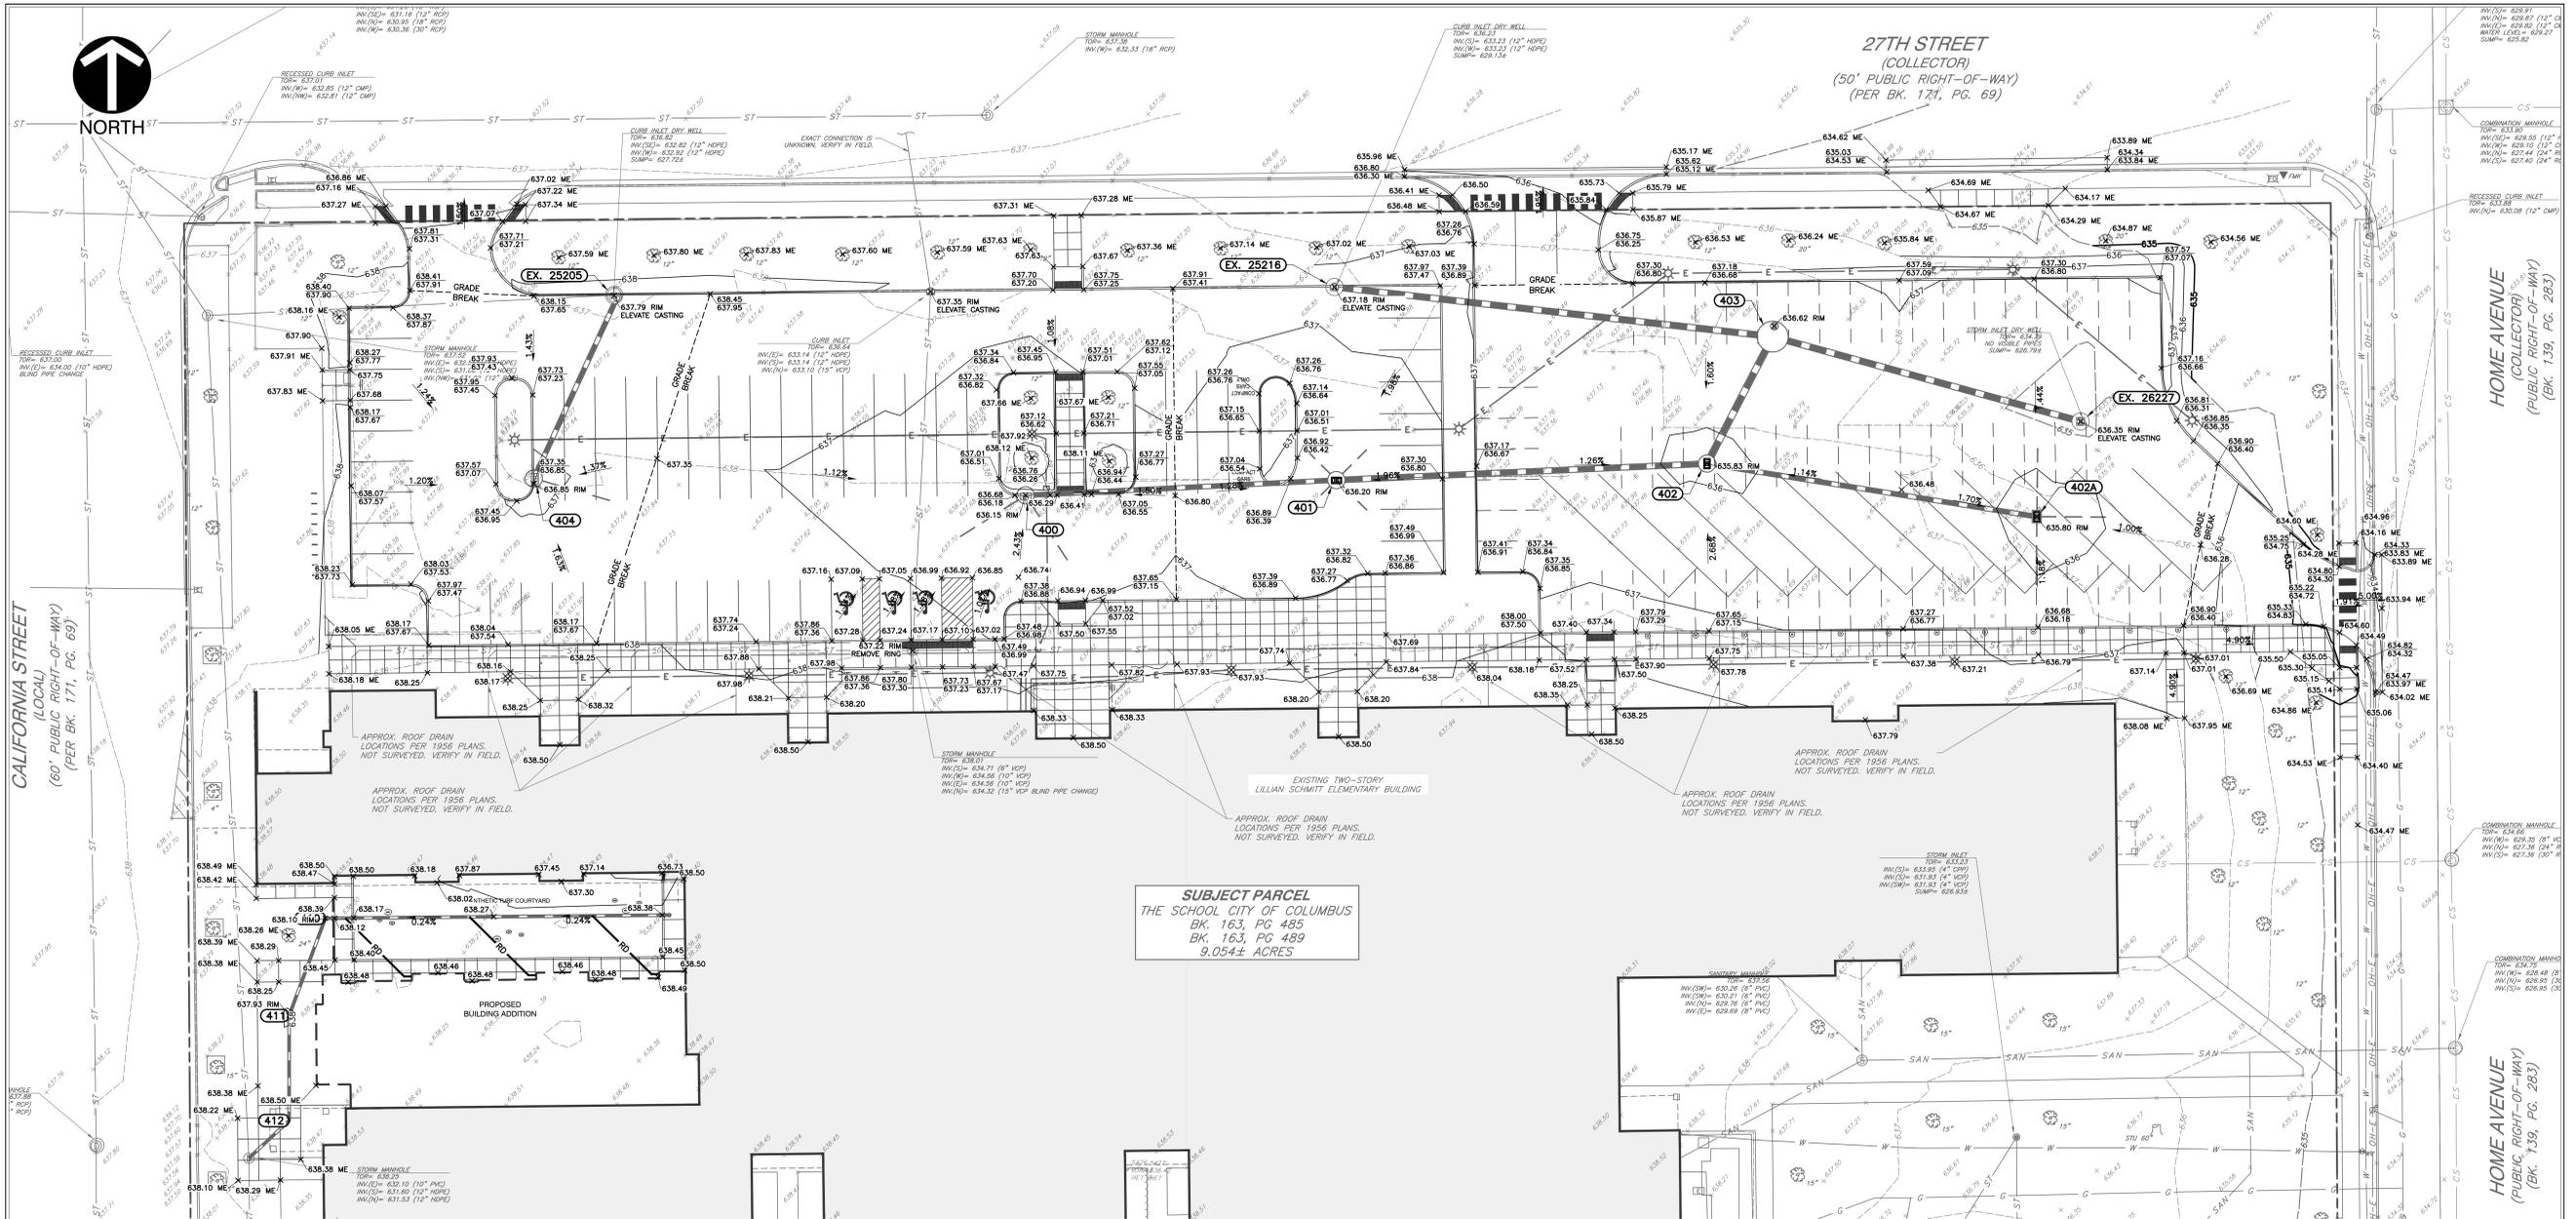

SUBJECT PARCEL
 THE SCHOOL CITY OF COLUMBUS
 BK. 163, PG. 485
 BK. 163, PG. 489
 9.054± ACRES

- GENERAL GRADING NOTES:**
- CONTRACTOR SHALL STRICTLY ADHERE TO THE EROSION CONTROL MEASURES PREPARED FOR THIS PROJECT.
 - EARTHWORK SHALL INCLUDE CLEARING AND GRUBBING, STRIPING AND STOCKPILING TOPSOIL, MASS GRADING, EXCAVATION, FILLING, UNDER CUT AND REPLACEMENT, IF REQUIRED, AND COMPACTION.
 - CONTRACTOR TO REFILL UNDERCUT AREAS WITH SUITABLE MATERIAL AND COMPACT AS RECOMMENDED BY THE GEOTECHNICAL ENGINEER.
 - PLACE TOPSOIL OVER THE SUBGRADE OF UNPAVED, DISTURBED AREAS TO A DEPTH INDICATED ON THE LANDSCAPE PLANS (6" MINIMUM). PAVEMENT SLOPES ACROSS ACCESSIBLE PARKING STALLS AND ADJOINING ACCESS AISLES SHALL BE MAXIMUM 2%.
 - ALL SLOPES SHALL BE 3:1 (HORIZONTAL:VERTICAL) MAXIMUM UNLESS NOTED OTHERWISE.
 - ALL AREAS NOT PAVED SHALL BE STABILIZED IN ACCORDANCE WITH THE EROSION CONTROL PLAN, UNLESS NOTED OTHERWISE.
 - ALL EXCESS SOIL MATERIALS SHALL BECOME THE PROPERTY OF THE CONTRACTOR UNLESS OTHERWISE DESIGNATED. SHALL BE REMOVED BY THE CONTRACTOR AND DISPOSED OF OFFSITE AT NO ADDITIONAL COST TO THE OWNER IN ACCORDANCE WITH ALL LOCAL AND STATE CODES AND PERMIT REQUIREMENTS.
 - DRAINAGE SYSTEMS SHALL BE INSPECTED DURING CONSTRUCTION BY A REGISTERED PROFESSIONAL ENGINEER OR LAND SURVEYOR. WITHIN 30 DAYS AFTER COMPLETION OF ON AND OFF-SITE DRAINAGE FACILITIES, THE REGISTERED PROFESSIONAL SHALL CERTIFY IN WRITING THE COMPLIANCE OF THE DRAINAGE FACILITIES PER LOCAL REQUIREMENTS.
 - CONTRACTOR SHALL PERPETUATE ALL DRAINS AND TILES ENCOUNTERED DURING CONSTRUCTION. COORDINATE WITH ENGINEER OF RECORD REGARDING THE CONNECTION TO THE PROPOSED STORM SEWER SYSTEM.
 - STORM STRUCTURES RECEIVING SUB-SURFACE DRAINS (SSD) SHALL HAVE BOTH CONNECTIONS CORE DRILLED. T OR Y BLIND CONNECTIONS ARE NOT ALLOWED.
 - REFER TO AND FOLLOW THE RECOMMENDATIONS OF THE GEOTECHNICAL REPORT.

BENCHMARKS:

UNLESS OTHERWISE NOTED, ELEVATIONS SHOWN HEREON ARE BASED UPON AN OPUS SOLUTION AND ARE ON THE 1988 NORTH AMERICAN VERTICAL DATUM (NAVD88) (GEOID 18). IT IS MY OPINION THAT THE UNCERTAINTY IN THE ELEVATION OF THE PROJECT BENCHMARK DOES NOT EXCEED 0.10 FOOT.

BM#1: SET MAGNOLIA ON TOP OF A LIGHT BASE LOCATED APPROXIMATELY 140 FEET SOUTH OF THE SOUTHWEST CORNER OF THE SITE. ELEV. = 639.79

BM#2: NORTHEAST BOLT ON TOP OF A FIRE HYDRANT LOCATED IN THE SOUTHWEST QUADRANT OF THE INTERSECTION OF CALIFORNIA ST. AND 27TH ST. ELEV. = 639.31

BM#3: SOUTHWEST BOLT ON TOP OF A FIRE HYDRANT LOCATED IN THE NORTHWEST QUADRANT OF THE INTERSECTION OF HOME AVE. AND 27TH ST. ELEV. = 636.88

BM#4: NORTHEAST BOLT ON TOP OF A FIRE HYDRANT LOCATED AT THE SOUTHWEST CORNER OF THE SITE. ELEV. = 636.48

UTILITY NOTE:

THE UNDERGROUND UTILITIES SHOWN HAVE BEEN LOCATED FROM FIELD SURVEY INFORMATION AND EXISTING DRAWINGS. THE SURVEYOR MAKES NO GUARANTEE THAT THE UNDERGROUND UTILITIES COMPRISE ALL SUCH UTILITIES IN THE AREA, EITHER IN-SERVICE OR ABANDONED. THE SURVEYOR FURTHER DOES NOT WARRANT THAT THE UNDERGROUND UTILITIES SHOWN ARE IN THE EXACT LOCATION INDICATED ALTHOUGH THE SURVEYOR DOES CERTIFY THAT THEY ARE LOCATED AS ACCURATELY AS POSSIBLE FROM INFORMATION AVAILABLE. THE SURVEYOR HAS NOT PHYSICALLY LOCATED THE UNDERGROUND UTILITIES. INDIANA 811 ONE-CALL PUBLIC UTILITY LOCATE SERVICE TICKET NUMBER 231071908 WAS ISSUED FOR THIS SITE. AMERICAN LOCATING SERVICES, A PRIVATE SUBSURFACE UTILITY LOCATING SERVICE, WAS CONTRACTED TO PERFORM THE PRIVATE UTILITY LOCATIONS FOR THE SUBJECT SITE. THE PRIVATE UTILITIES LOCATED AND DEPICTED HEREIN WERE EITHER OBSERVED FROM MARKINGS ON THE GROUND OR USING EXISTING PLANS PROVIDED BY THE SCHOOL.

PRIOR TO ANY EXCAVATION FOR UNDERGROUND UTILITIES, THE CONTRACTOR SHALL EXPOSE AND VERIFY LOCATIONS (HORIZONTAL AND VERTICAL) OF ALL EXISTING UTILITIES INCLUDING BUT NOT LIMITED TO GAS, WATER, AND SANITARY SEWER. ANY CONFLICTS SHALL BE REPORTED IMMEDIATELY TO THE ENGINEER AND THE APPROPRIATE AUTHORITIES.

GRADING LEGEND:

800	PROPOSED INDEX CONTOUR
798	PROPOSED INTERMEDIATE CONTOUR
---	PROPOSED DRAINAGE SWALE
- - -	PROPOSED GRADE BREAK
---	PROPOSED STORM SEWER LINE
---	PROPOSED UNDERDRAIN
x	PROPOSED SPOT ELEVATION
o	PROPOSED CURB SPOT ELEVATION; TOP OF CURB ON TOP, GUTTER ELEVATION ON BOTTOM
o	PROPOSED ROLL CURB SPOT; TOP OF CURB ON TOP, EDGE OF CURB ALONG PAVEMENT; SEE DETAIL ON SHEET L501

ABBREVIATIONS:

TC = TOP OF CURB
 BC = BOTTOM OF CURB
 TW = TOP OF WALL
 BW = BOTTOM OF WALL
 TR = TOP OF RAMP
 BR = BOTTOM OF RAMP
 ME = MATCH EXISTING



Civil & Environmental Consultants, Inc.
 530 E. Ohio Street, Suite G - Indianapolis, IN 46204
 317-465-7777 • 317-746-0749
 www.ceconline.com

BARTHOLOMEW CONSOLIDATED SCHOOL CORPORATION RENOVATIONS TO L. C. SCHMITT ELEMENTARY
 2875 CALIFORNIA STREET, COLUMBUS, IN 47201

SCOPE DRAWINGS:

These drawings include the general scope of the project in terms of architectural design concept, the development of structural, mechanical and electrical systems. The design team has not necessarily indicated or described all work necessary for the performance and completion of the project. On the basis of the general scope indicated or described, the team contractor shall furnish all items required for the proper execution and completion of the work.

REVISIONS:

03/15/2024 - ADDENDUM #02

ISSUE DATE	DRAWN BY	CHECKED BY
02/16/2024	RT	JP

DRAWING TITLE:

GRADING PLAN

CERTIFIED BY:

Don M. Pasy
 REGISTERED PROFESSIONAL ENGINEER
 No. PE12100829
 STATE OF INDIANA
 02/16/24

DRAWING NUMBER:

C300

PROJECT NUMBER:

2021049





27TH STREET
(COLLECTOR)
(50' PUBLIC RIGHT-OF-WAY)
(PER BK. 171, PG. 69)



8831 Keystone Crossing, Indianapolis, IN 46240
317.846.7800 | csoinc.net



Civil & Environmental Consultants, Inc.
530 E. Ohio Street, Suite G - Indianapolis, IN 46204
317.465.7777 | 317.476.4749
www.ceeinc.com

PROJECT:
BARTHOLOMEW CONSOLIDATED
SCHOOL CORPORATION
RENOVATIONS TO
L. C. SCHMITT ELEMENTARY
2875 CALIFORNIA STREET, COLUMBUS, IN 47201

SCOPE DRAWINGS:
These drawings indicate the general scope of the project in terms of architectural design concept, the dimensions of structural, mechanical and electrical systems. The drawings are not necessarily complete or detailed as work required for the performance and completion of the project. On the basis of the general scope indicated on these drawings, the contractor shall furnish all items required for the proper installation and completion of the work.

REVISIONS:
03/15/2024 - ADDENDUM #02

ISSUE DATE DRAWN BY CHECKED BY
02/16/2024 RT JP

DRAWING TITLE:

FLOOD ROUTING PLAN

CERTIFIED BY:




DRAWING NUMBER

C301

PROJECT NUMBER

2021049

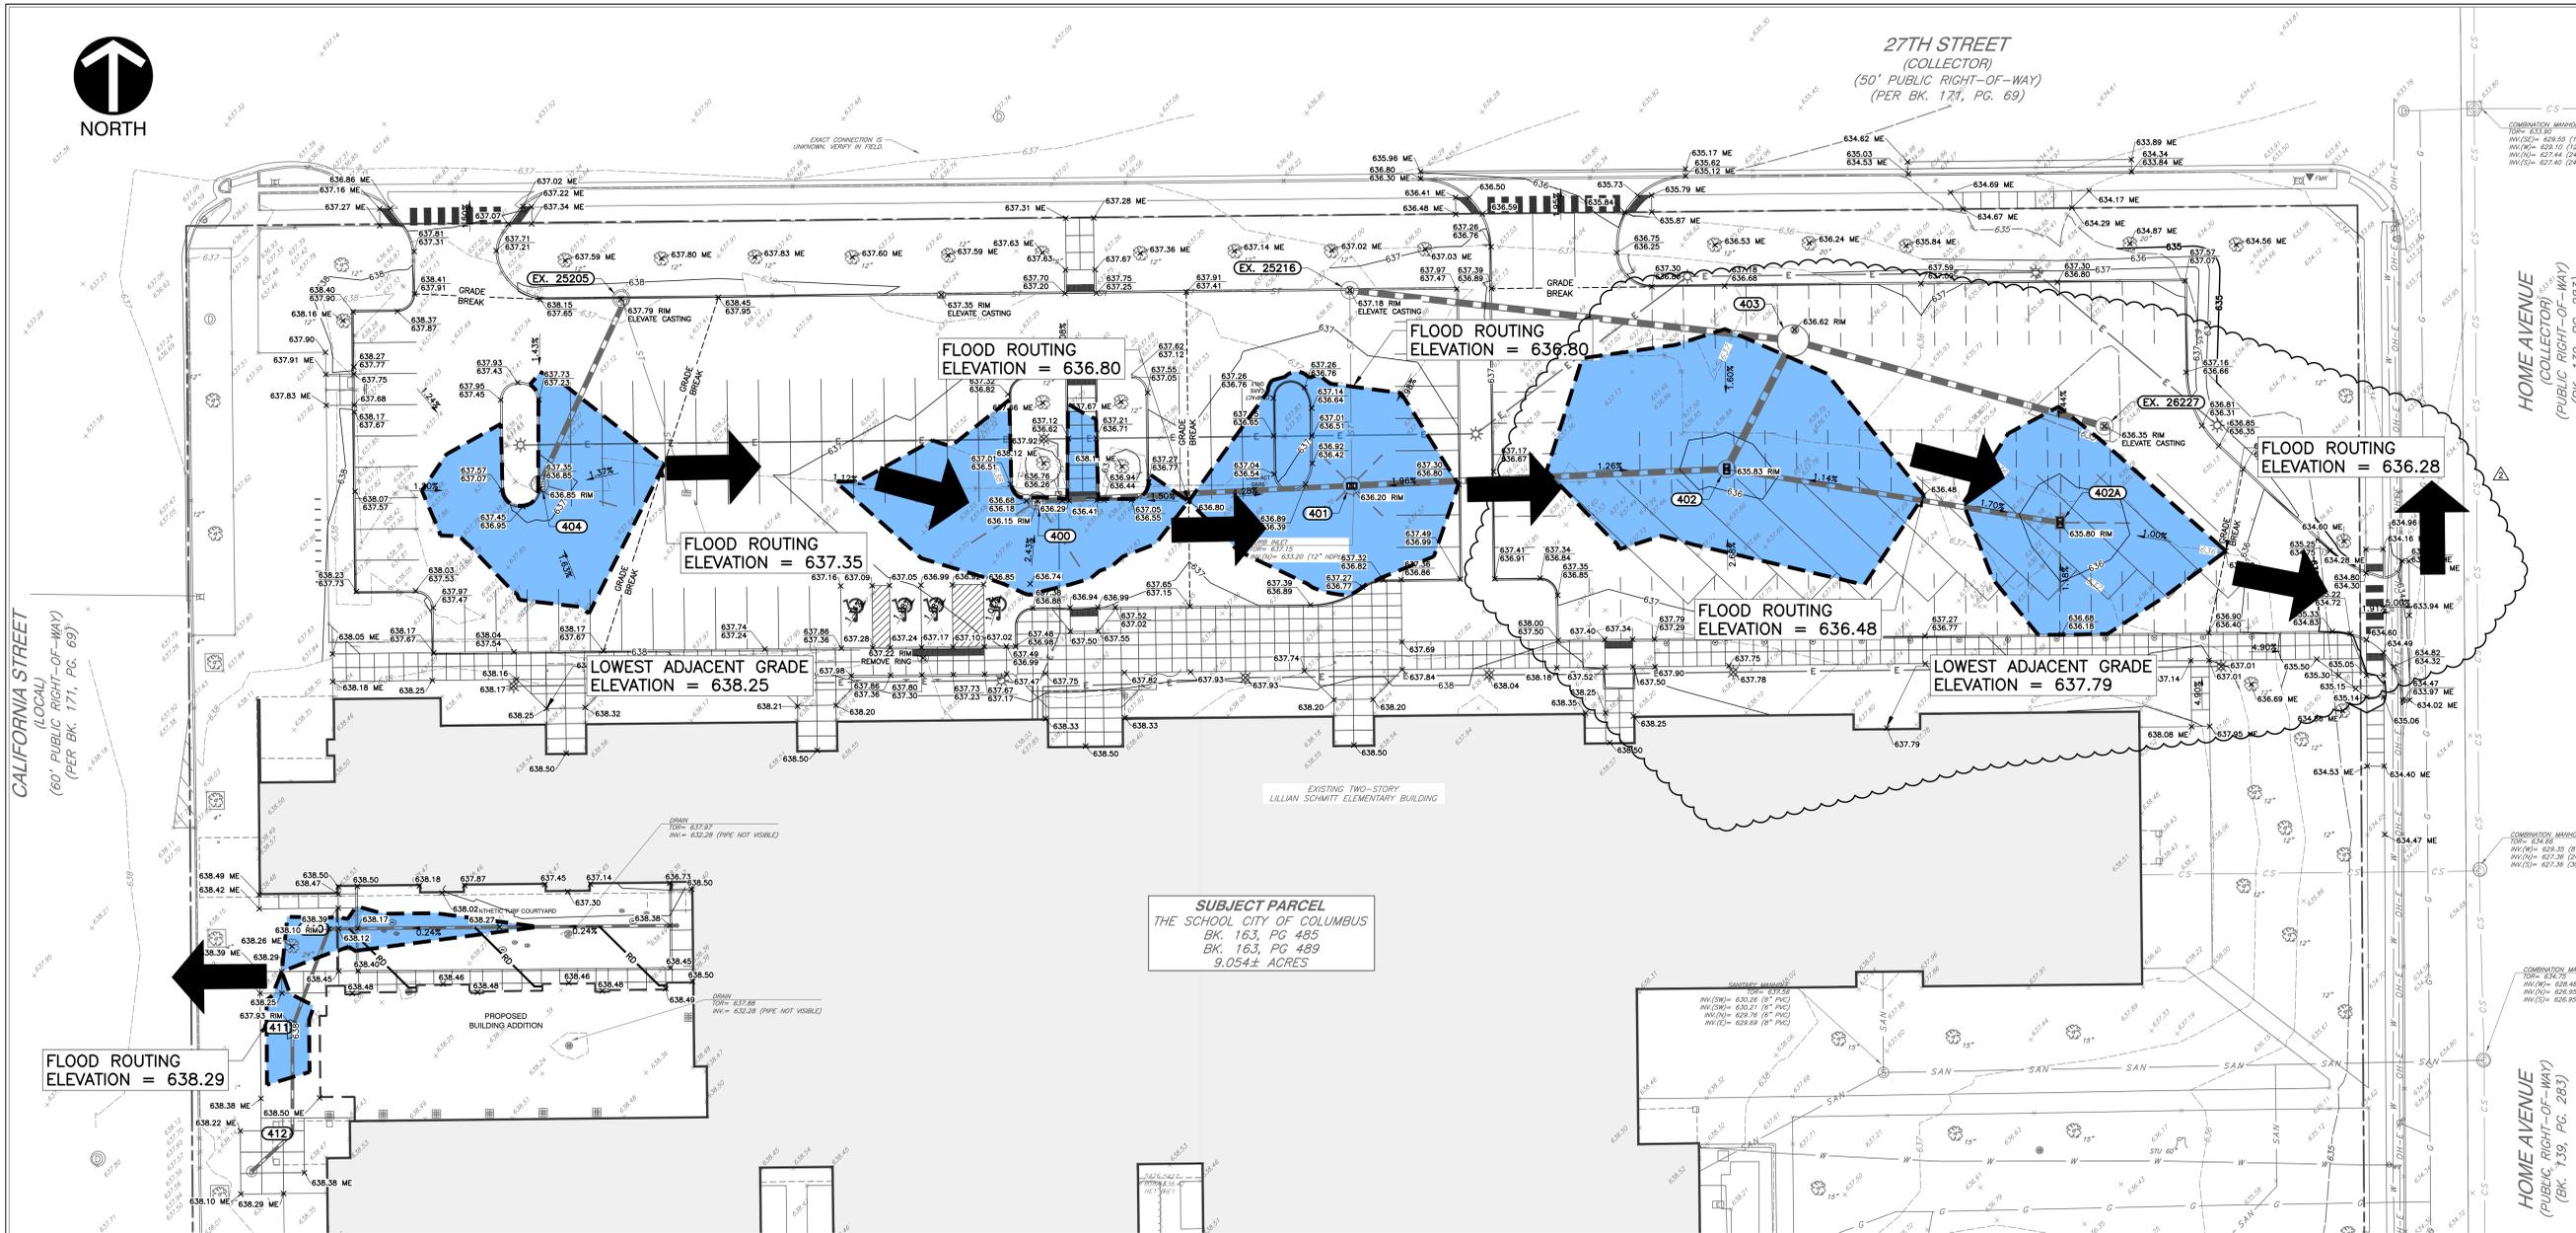

SUBJECT PARCEL
THE SCHOOL CITY OF COLUMBUS
BK. 163, PG. 485
BK. 163, PG. 489
9.054± ACRES

GENERAL GRADING NOTES:

- CONTRACTOR SHALL STRICTLY ADHERE TO THE EROSION CONTROL MEASURES PREPARED FOR THIS PROJECT.
- EARTHWORK SHALL INCLUDE CLEARING AND GRUBBING, STRIPING AND STOCKPILING TOPSOIL, MASS GRADING, EXCAVATION, FILLING, UNDER CUT AND REPLACEMENT, IF REQUIRED, AND COMPACTION.
- CONTRACTOR TO REFILL UNDERCUT AREAS WITH SUITABLE MATERIAL AND COMPACT AS RECOMMENDED BY THE GEOTECHNICAL ENGINEER.
- PLACE TOPSOIL OVER THE SUBGRADE OF UNPAVED, DISTURBED AREAS TO A DEPTH INDICATED ON THE LANDSCAPE PLANS (6" MINIMUM). PAVEMENT SLOPES ACROSS ACCESSIBLE PARKING STALLS AND ADJOINING ACCESS AISLES SHALL BE MAXIMUM 2%.
- ALL SLOPES SHALL BE 3:1 (HORIZONTAL:VERTICAL) MAXIMUM UNLESS NOTED OTHERWISE.
- ALL AREAS NOT PAVED SHALL BE STABILIZED IN ACCORDANCE WITH THE EROSION CONTROL PLAN, UNLESS NOTED OTHERWISE.
- ALL EXCESS SOIL MATERIALS SHALL BECOME THE PROPERTY OF THE CONTRACTOR UNLESS OTHERWISE DESIGNATED. SHALL BE REMOVED BY THE CONTRACTOR AND DISPOSED OF OFFSITE AT NO ADDITIONAL COST TO THE OWNER IN ACCORDANCE WITH ALL LOCAL AND STATE CODES AND PERMIT REQUIREMENTS.
- DRAINAGE SYSTEMS SHALL BE INSPECTED DURING CONSTRUCTION BY A REGISTERED PROFESSIONAL ENGINEER OR LAND SURVEYOR, WITHIN 30 DAYS AFTER COMPLETION OF ON AND OFF-SITE DRAINAGE FACILITIES. THE REGISTERED PROFESSIONAL SHALL CERTIFY IN WRITING THE COMPLIANCE OF THE DRAINAGE FACILITIES PER LOCAL REQUIREMENTS.
- CONTRACTOR SHALL PERPETUATE ALL DRAINS AND TILES ENCOUNTERED DURING CONSTRUCTION. COORDINATE WITH ENGINEER OF RECORD REGARDING THE CONNECTION TO THE PROPOSED STORM SEWER SYSTEM.
- STORM STRUCTURES RECEIVING SUB-SURFACE DRAINS (SSD) SHALL HAVE BOTH CONNECTIONS CORE DRILLED. T OR Y BLIND CONNECTIONS ARE NOT ALLOWED.
- REFER TO AND FOLLOW THE RECOMMENDATIONS OF THE GEOTECHNICAL REPORT.


BENCHMARKS:

- UNLESS OTHERWISE NOTED, ELEVATIONS SHOWN HEREON ARE BASED UPON AN OPUS SOLUTION AND ARE ON THE 1988 NORTH AMERICAN VERTICAL DATUM (NAVD88) (GEOID 18). IT IS MY OPINION THAT THE UNCERTAINTY IN THE ELEVATION OF THE PROJECT BENCHMARK DOES NOT EXCEED 0.10 FOOT.
- BM#1: SET MAGNOLIA ON TOP OF A LIGHT BASE LOCATED APPROXIMATELY 140 FEET SOUTH OF THE SOUTHWEST CORNER OF THE SITE. ELEV. = 639.79
- BM#2: NORTHEAST BOLT ON TOP OF A FIRE HYDRANT LOCATED IN THE SOUTHWEST QUADRANT OF THE INTERSECTION OF CALIFORNIA ST. AND 27TH ST. ELEV. = 639.51
- BM#3: SOUTHWEST BOLT ON TOP OF A FIRE HYDRANT LOCATED IN THE NORTHWEST QUADRANT OF THE INTERSECTION OF HOME AVE. AND 27TH ST. ELEV. = 636.88
- BM#4: NORTHEAST BOLT ON TOP OF A FIRE HYDRANT LOCATED AT THE SOUTHWEST CORNER OF THE SITE. ELEV. = 636.48

UTILITY NOTE:

THE UNDERGROUND UTILITIES SHOWN HAVE BEEN LOCATED FROM FIELD SURVEY INFORMATION AND EXISTING DRAWINGS. THE SURVEYOR MAKES NO GUARANTEE THAT THE UNDERGROUND UTILITIES COMPRISE ALL SUCH UTILITIES IN THE AREA, EITHER IN-SERVICE OR ABANDONED. THE SURVEYOR FURTHER DOES NOT WARRANT THAT THE UNDERGROUND UTILITIES SHOWN ARE IN THE EXACT LOCATION INDICATED ALTHOUGH THE SURVEYOR DOES CERTIFY THAT THEY ARE LOCATED AS ACCURATELY AS POSSIBLE FROM INFORMATION AVAILABLE. THE SURVEYOR HAS NOT PHYSICALLY LOCATED THE UNDERGROUND UTILITIES. INDIANA 811 ONE-CALL PUBLIC UTILITY LOCATE SERVICE TICKET NUMBER 231071808 WAS ISSUED FOR THIS SITE. AMERICAN LOCATING SERVICES, A PRIVATE SUBSURFACE UTILITY LOCATING SERVICE, WAS CONTRACTED TO PERFORM THE PRIVATE UTILITY LOCATIONS FOR THE SUBJECT SITE. THE PRIVATE UTILITIES LOCATED AND DEPICTED HEREIN WERE EITHER OBSERVED FROM MARKINGS ON THE GROUND OR USING EXISTING PLANS PROVIDED BY THE SCHOOL.

PRIOR TO ANY EXCAVATION FOR UNDERGROUND UTILITIES, THE CONTRACTOR SHALL EXPOSE AND VERIFY LOCATIONS (HORIZONTAL AND VERTICAL) OF ALL EXISTING UTILITIES INCLUDING BUT NOT LIMITED TO GAS, WATER, AND SANITARY SEWER. ANY CONFLICTS SHALL BE REPORTED IMMEDIATELY TO THE ENGINEER AND THE APPROPRIATE AUTHORITIES.

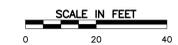



GRADING LEGEND:

- 800 PROPOSED INDEX CONTOUR
- 798 PROPOSED INTERMEDIATE CONTOUR
- PROPOSED DRAINAGE SWALE
- PROPOSED GRADE BREAK
- PROPOSED STORM SEWER LINE
- PROPOSED UNDERDRAIN
- 798.50 PROPOSED SPOT ELEVATION
- 798.50 PROPOSED CURB SPOT ELEVATION; TOP OF CURB ON TOP, GUTTER ELEVATION ON BOTTOM
- 798.00 PROPOSED ROLL CURB SPOT; TOP OF CURB ON TOP, EDGE OF CURB ALONG PAVEMENT; SEE DETAIL ON SHEET L501

ABBREVIATIONS:

- TC = TOP OF CURB
- BC = BOTTOM OF CURB
- TW = TOP OF WALL
- BW = BOTTOM OF WALL
- TR = TOP OF RAMP
- BR = BOTTOM OF RAMP
- ME = MATCH EXISTING

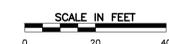

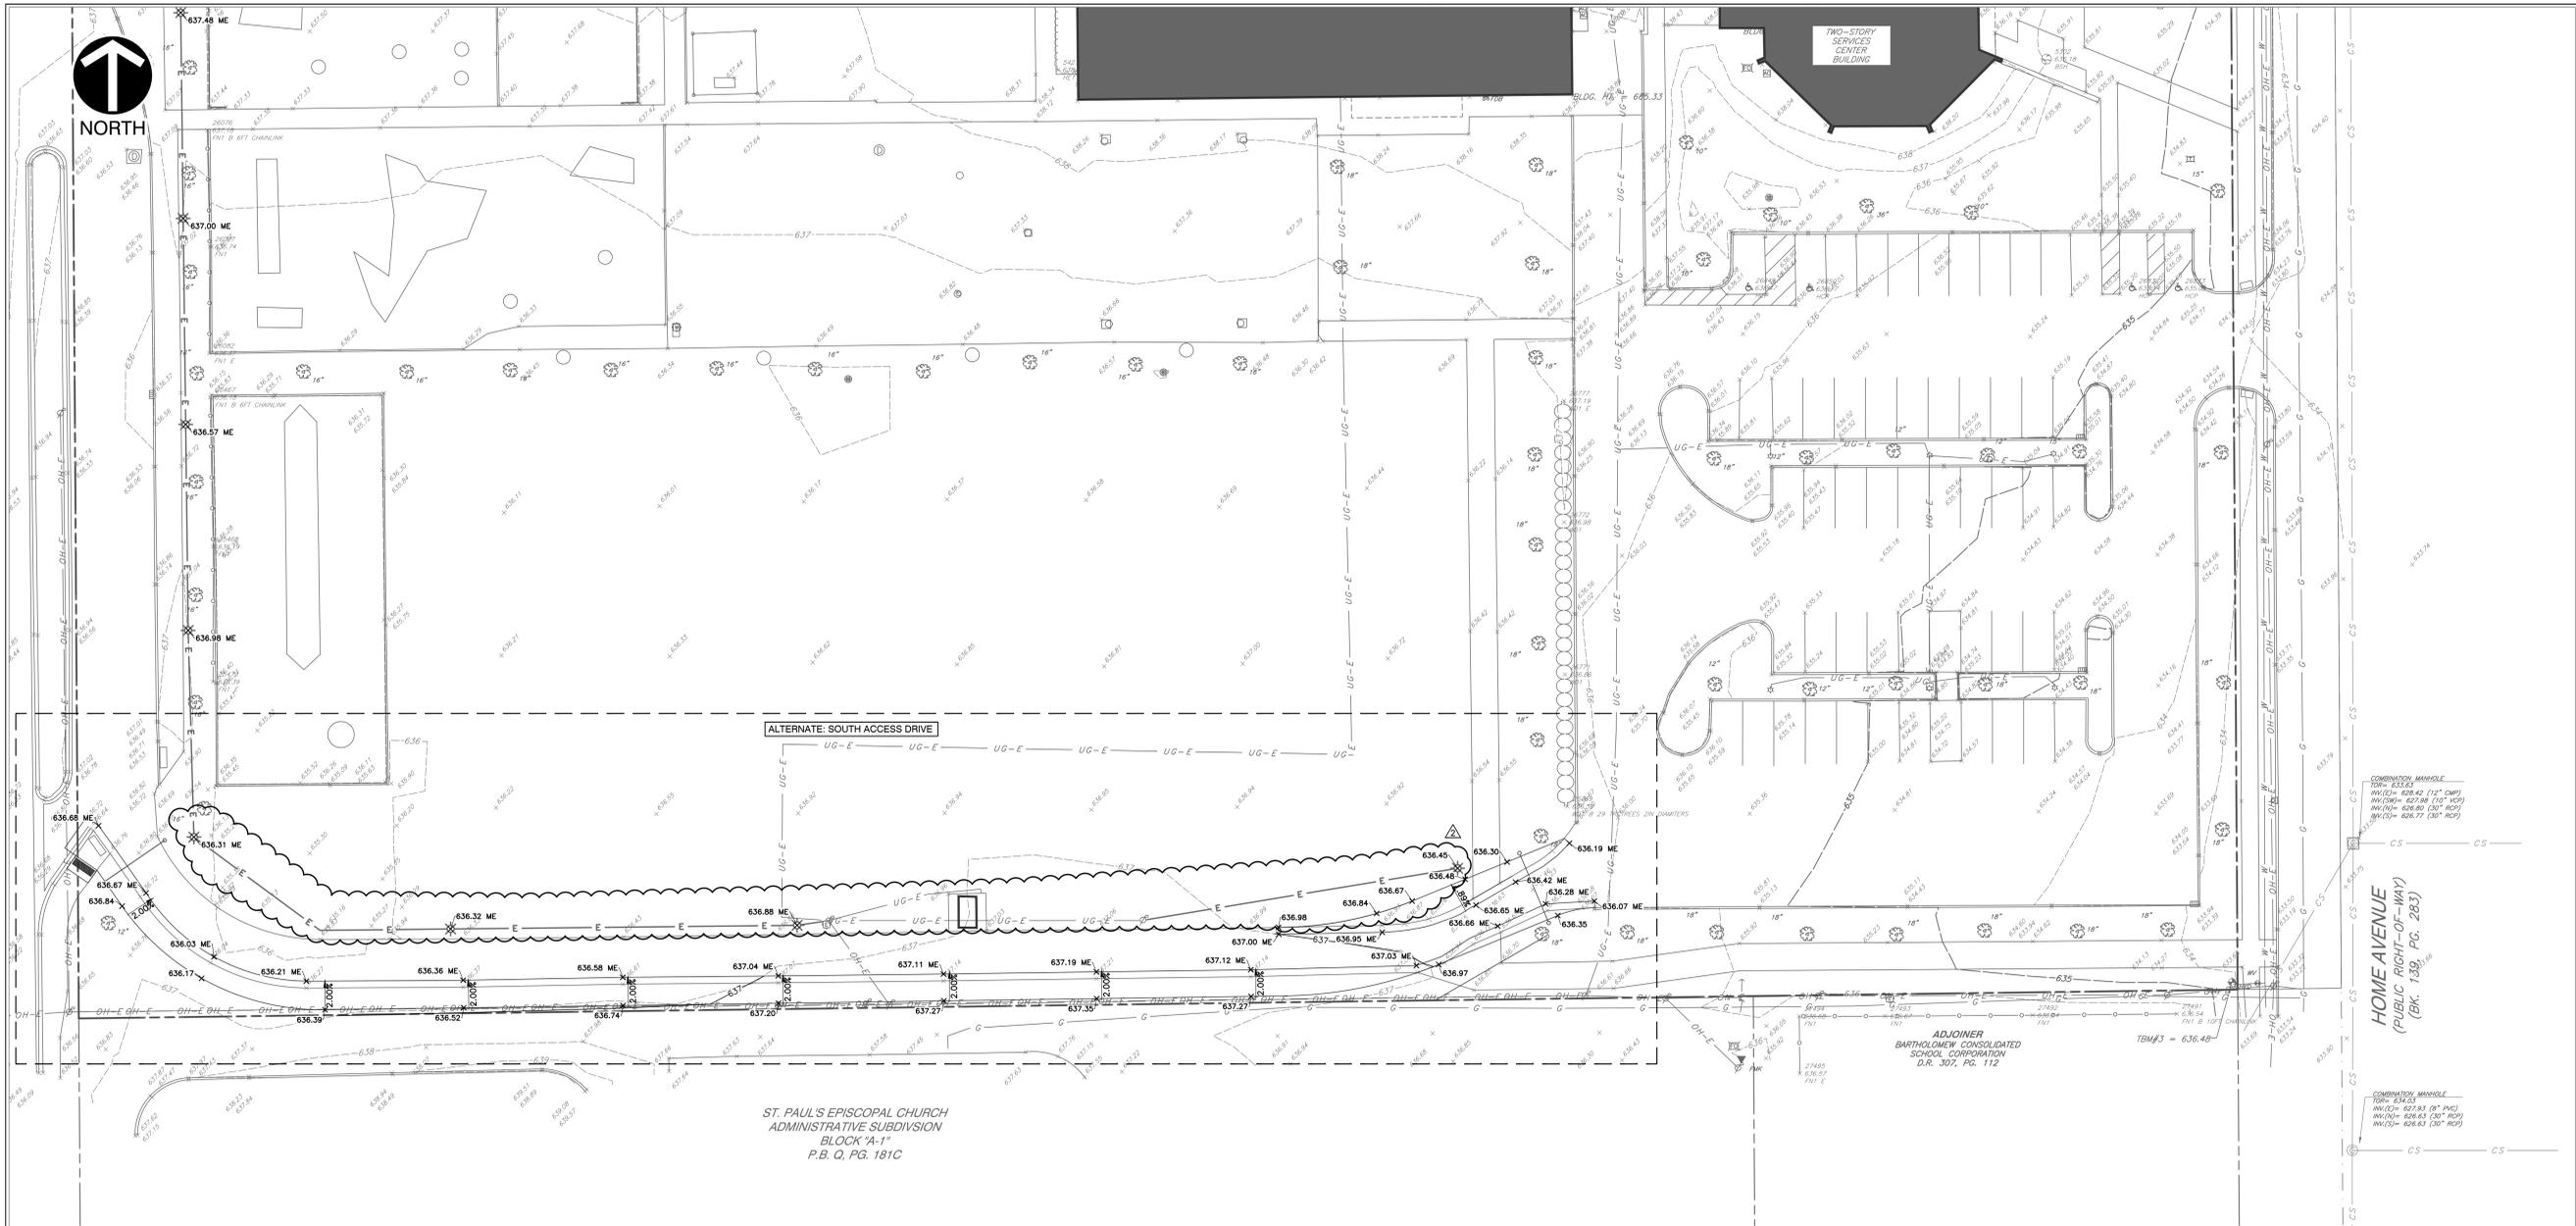

ST. PAUL'S EPISCOPAL CHURCH
ADMINISTRATIVE SUBDIVISION
BLOCK 'A'-1
P.B. G, PG. 181C

ADJOINER
BARTHOLOMEW CONSOLIDATED
SCHOOL CORPORATION
D.R. 307, PG. 112

COMBINATION MANHOLE
TOP = 633.63
INVERT = 628.42 (12" DWP)
INVERT = 627.98 (15" VCP)
INVERT = 626.80 (20" RCP)
INVERT = 626.77 (20" RCP)

COMBINATION MANHOLE
TOP = 634.03
INVERT = 627.83 (8" PVC)
INVERT = 626.63 (20" RCP)
INVERT = 626.63 (20" RCP)

HOME AVENUE
(PUBLIC RIGHT-OF-WAY)
(BK. 139, PG. 283)

GENERAL GRADING NOTES:

- CONTRACTOR SHALL STRICTLY ADHERE TO THE EROSION CONTROL MEASURES PREPARED FOR THIS PROJECT.
- EARTHWORK SHALL INCLUDE CLEARING AND GRUBBING, STRIPING AND STOCKPIILING TOPSOIL, MASS GRADING, EXCAVATION, FILLING, UNDER CUT AND REPLACEMENT, IF REQUIRED, AND COMPACTION.
- CONTRACTOR TO REFILL UNDERCUT AREAS WITH SUITABLE MATERIAL AND COMPACT AS RECOMMENDED BY THE GEOTECHNICAL ENGINEER.
- PLACE TOPSOIL OVER THE SUBGRADE OF UNPAVED, DISTURBED AREAS TO A DEPTH INDICATED ON THE LANDSCAPE PLANS (6" MINIMUM). PAVEMENT SLOPES ACROSS ACCESSIBLE PARKING STALLS AND ADJOINING ACCESS AISLES SHALL BE MAXIMUM 2%.
- ALL SLOPES SHALL BE 3:1 (HORIZONTAL:VERTICAL) MAXIMUM UNLESS NOTED OTHERWISE.
- ALL AREAS NOT PAVED SHALL BE STABILIZED IN ACCORDANCE WITH THE EROSION CONTROL PLAN, UNLESS NOTED OTHERWISE.
- ALL EXCESS SOIL MATERIALS SHALL BECOME THE PROPERTY OF THE CONTRACTOR UNLESS OTHERWISE DESIGNATED. SHALL BE REMOVED BY THE CONTRACTOR AND DISPOSED OF OFFSITE AT NO ADDITIONAL COST TO THE OWNER IN ACCORDANCE WITH ALL LOCAL AND STATE CODES AND PERMIT REQUIREMENTS.
- DRAINAGE SYSTEMS SHALL BE INSPECTED DURING CONSTRUCTION BY A REGISTERED PROFESSIONAL ENGINEER OR LAND SURVEYOR. WITHIN 30 DAYS AFTER COMPLETION OF ON AND OFF-SITE DRAINAGE FACILITIES, THE REGISTERED PROFESSIONAL SHALL CERTIFY IN WRITING THE COMPLIANCE OF THE DRAINAGE FACILITIES PER LOCAL REQUIREMENTS.
- CONTRACTOR SHALL PERPETUATE ALL DRAINS AND TILES ENCOUNTERED DURING CONSTRUCTION. COORDINATE WITH ENGINEER OF RECORD REGARDING THE CONNECTION TO THE PROPOSED STORM SEWER SYSTEM.
- STORM STRUCTURES RECEIVING SUB-SURFACE DRAINS (SSD) SHALL HAVE BOTH CONNECTIONS CORE DRILLED. T OR Y BLIND CONNECTIONS ARE NOT ALLOWED.
- REFER TO AND FOLLOW THE RECOMMENDATIONS OF THE GEOTECHNICAL REPORT.

BENCHMARKS:

- UNLESS OTHERWISE NOTED, ELEVATIONS SHOWN HEREON ARE BASED UPON AN OPUS SOLUTION AND ARE ON THE 1988 NORTH AMERICAN VERTICAL DATUM (NAVD88) (GEOID 18). IT IS MY OPINION THAT THE UNCERTAINTY IN THE ELEVATION OF THE PROJECT BENCHMARK DOES NOT EXCEED 0.10 FOOT.
- TBM#1: SET MAGNAIL ON TOP OF A LIGHT BASE LOCATED APPROXIMATELY 140 FEET SOUTH OF THE SOUTHWEST CORNER OF THE SITE. ELEV. = 639.79
 - TBM#2: NORTHEAST BOLT ON TOP OF A FIRE HYDRANT LOCATED IN THE SOUTHWEST QUADRANT OF THE INTERSECTION OF CALIFORNIA ST. AND 27TH ST. ELEV. = 639.31
 - TBM#3: SOUTHWEST BOLT ON TOP OF A FIRE HYDRANT LOCATED IN THE NORTHWEST QUADRANT OF THE INTERSECTION OF HOME AVE. AND 27TH ST. ELEV. = 636.88
 - TBM#4: NORTHEAST BOLT ON TOP OF A FIRE HYDRANT LOCATED AT THE SOUTHWEST CORNER OF THE SITE. ELEV. = 636.48

UTILITY NOTE:

THE UNDERGROUND UTILITIES SHOWN HAVE BEEN LOCATED FROM FIELD SURVEY INFORMATION AND EXISTING DRAWINGS. THE SURVEYOR MAKES NO GUARANTEE THAT THE UNDERGROUND UTILITIES COMPRISE ALL SUCH UTILITIES IN THE AREA, EITHER IN-SERVICE OR ABANDONED. THE SURVEYOR FURTHER DOES NOT WARRANT THAT THE UNDERGROUND UTILITIES SHOWN ARE IN THE EXACT LOCATION INDICATED ALTHOUGH THE SURVEYOR DOES CERTIFY THAT THEY ARE LOCATED AS ACCURATELY AS POSSIBLE FROM INFORMATION AVAILABLE. THE SURVEYOR HAS NOT PHYSICALLY LOCATED THE UNDERGROUND UTILITIES. INDIANA 811 ONE-CALL PUBLIC UTILITY LOCATE SERVICE TICKET NUMBER 231271908 WAS ISSUED FOR THIS SITE. AMERICAN LOCATING SERVICES, A PRIVATE SUBSURFACE UTILITY LOCATING SERVICE, WAS CONTRACTED TO PERFORM THE PRIVATE UTILITY LOCATIONS FOR THE SUBJECT SITE. THE PRIVATE UTILITIES LOCATED AND DEPICTED HEREIN WERE EITHER OBSERVED FROM MARKINGS ON THE GROUND OR USING EXISTING PLANS PROVIDED BY THE SCHOOL.


PRIOR TO ANY EXCAVATION FOR UNDERGROUND UTILITIES, THE CONTRACTOR SHALL EXPOSE AND VERIFY LOCATIONS (HORIZONTAL AND VERTICAL) OF ALL EXISTING UTILITIES INCLUDING BUT NOT LIMITED TO GAS, WATER, AND SANITARY SEWER. ANY CONFLICTS SHALL BE REPORTED IMMEDIATELY TO THE ENGINEER AND THE APPROPRIATE AUTHORITIES.



GRADING LEGEND:

- 800 PROPOSED INDEX CONTOUR
- 798 PROPOSED INTERMEDIATE CONTOUR
- PROPOSED DRAINAGE SWALE
- PROPOSED GRADE BREAK
- PROPOSED STORM SEWER LINE
- PROPOSED UNDERDRAIN
- 798.50 PROPOSED SPOT ELEVATION
- 798.50 PROPOSED CURB SPOT ELEVATION; TOP OF CURB ON TOP, GUTTER ELEVATION ON BOTTOM
- 798.00 PROPOSED ROLL CURB SPOT; TOP OF CURB ON TOP, EDGE OF CURB ALONG PAVEMENT; SEE DETAIL ON SHEET L501

ABBREVIATIONS:
 TC = TOP OF CURB
 BC = BOTTOM OF CURB
 TW = TOP OF WALL
 BW = BOTTOM OF WALL
 TR = TOP OF RAMP
 BR = BOTTOM OF RAMP
 ME = MATCH EXISTING

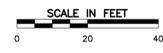

CSO
 8831 Keystone Crossing, Indianapolis, IN 46240
 317.846.7800 | csocinc.net

CEE
 Civil & Environmental Consultants, Inc.
 530 E. Ohio Street, Suite G - Indianapolis, IN 46204
 317.465.7777 | 317.746.0749
 www.ceecinc.com

BARTHOLOMEW CONSOLIDATED SCHOOL CORPORATION RENOVATIONS TO L. C. SCHMITT ELEMENTARY
 2875 CALIFORNIA STREET, COLUMBUS, IN 47201

SCOPE DRAWINGS:
 These drawings indicate the general scope of the project in terms of professional design content. The development of structural, mechanical and electrical systems, and the design of the site and landscape are not included in the scope of work provided for the performance and completion of the drawings. On the basis of the general scope indicated on these drawings, the team contractor shall furnish all items required for the proper installation and completion of the work.

REVISIONS:
 03/15/2024 - ADDENDUM #02

ISSUE DATE	DRAWN BY	CHECKED BY
02/16/2024	RT	JP

DRAWING TITLE:
 GRADING PLAN SOUTH ALTERNATE


CERTIFIED BY:
 JOHN THOMAS M. PAVLY
 REGISTERED PROFESSIONAL ENGINEER
 No. PE12100829
 STATE OF INDIANA
 02/16/24

DRAWING NUMBER:
 C302

PROJECT NUMBER:
 2021049



NORTH

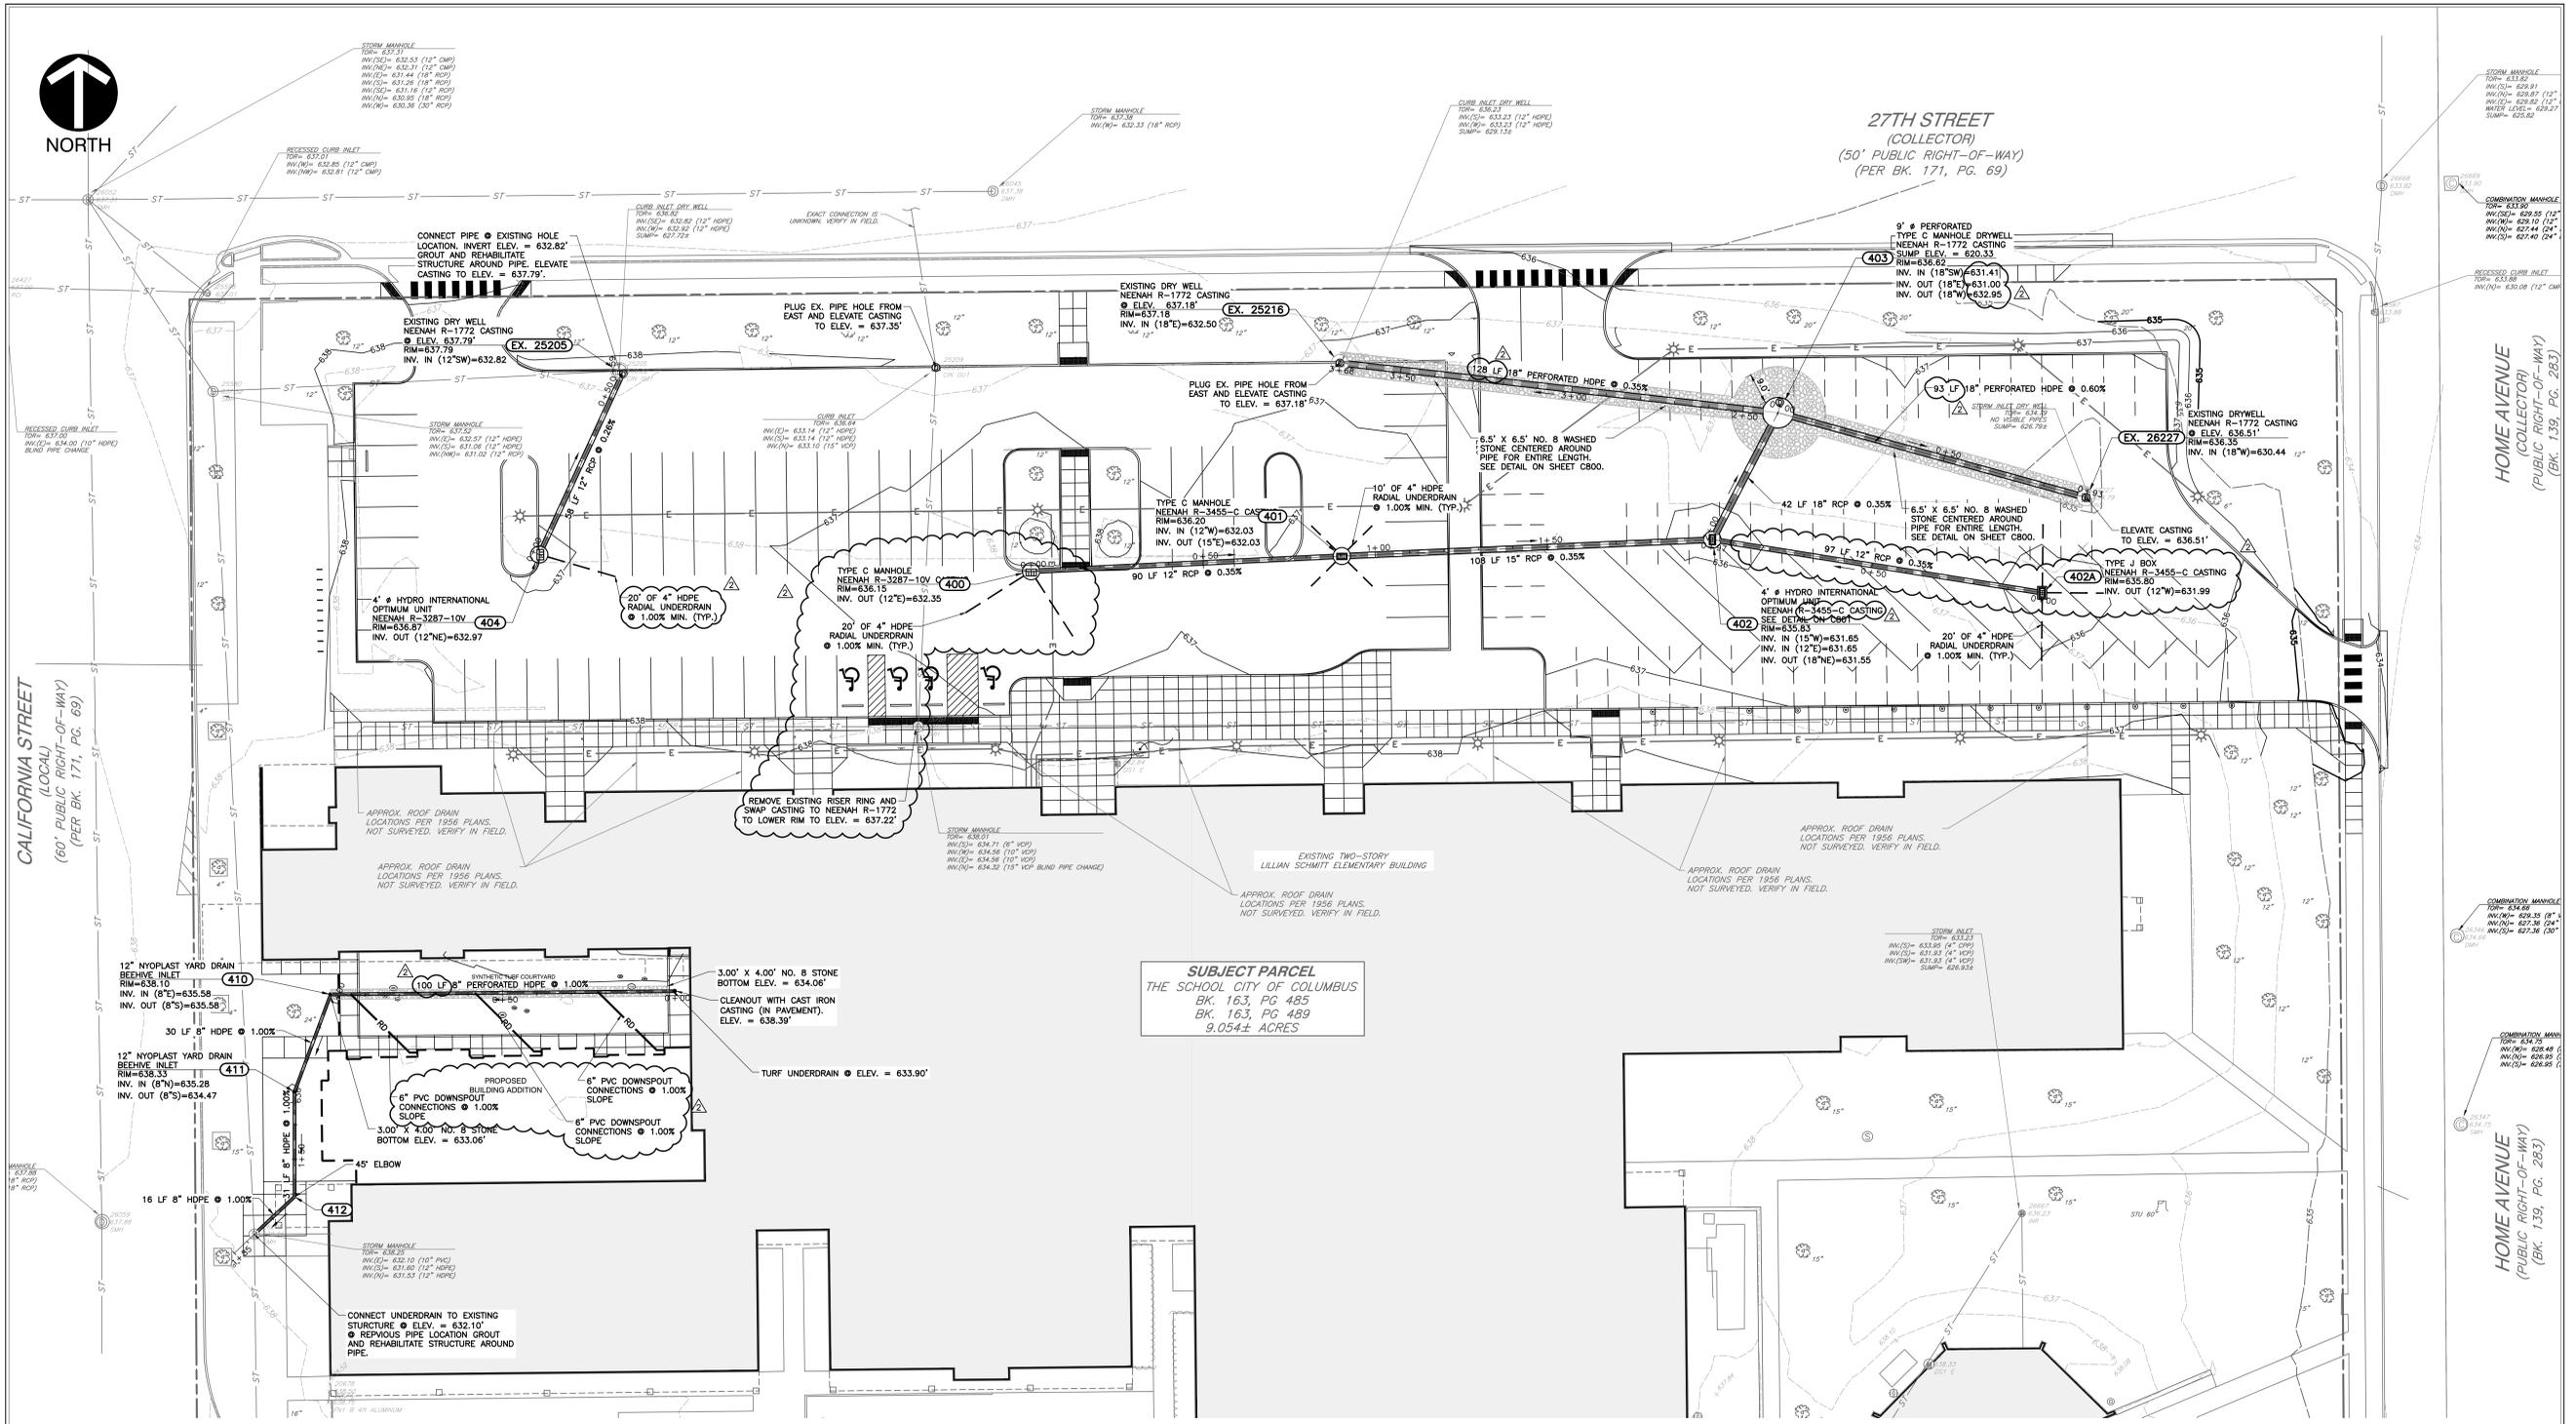

SUBJECT PARCEL
THE SCHOOL CITY OF COLUMBUS
BK. 163, PG 485
BK. 163, PG 489
9.054± ACRES

FLOOD NOTE:
THE PARCEL DESCRIBED AND SHOWN HEREIN LIES WITHIN ZONE "X" (UN-SHADED) AS SAID PARCEL PLOTS ON MAP NUMBER 18005C0131E (DATED DECEMBER 9, 2014) OF THE FLOOD INSURANCE RATE MAPS FOR THE CITY OF COLUMBUS, BARTHOLOMEW COUNTY, INDIANA. THE ACCURACY OF THIS FLOOD HAZARD STATEMENT IS SUBJECT TO MAP SCALE UNCERTAINTY AND TO ANY OTHER UNCERTAINTY IN LOCATION OR ELEVATION ON THE REFERENCED FLOOD INSURANCE RATE MAP.

GENERAL DRAINAGE NOTES:

1. DISTANCES SHOWN ON PIPING ARE HORIZONTAL DISTANCES FROM CENTER OF STRUCTURE TO CENTER OF STRUCTURE, UNLESS OTHERWISE NOTED.
2. THE CONTRACTOR SHALL BE RESPONSIBLE FOR ALL COSTS ASSOCIATED WITH THE INSTALLATION, INSPECTION, TESTING AND FINAL ACCEPTANCE OF ALL NEW STORMWATER MANAGEMENT FACILITIES CONSTRUCTION. CONTRACTOR SHALL COORDINATE WITH ALL APPLICABLE REGULATING AGENCIES CONCERNING INSTALLATION, INSPECTION AND APPROVAL OF THE STORM DRAINAGE SYSTEM CONSTRUCTION.
3. ALL STORMWATER MANAGEMENT FACILITIES, INCLUDING COLLECTION AND CONVEYANCE STRUCTURES SHALL BE INSTALLED IN ACCORDANCE WITH ALL APPLICABLE LOCAL AND STATE CODES AND REGULATIONS.
4. ANY WORK PERFORMED IN THE LOCAL OR STATE RIGHT OF WAYS SHALL BE IN ACCORDANCE WITH THE APPLICABLE LOCAL OR STATE REQUIREMENTS. IT SHALL BE THE CONTRACTOR'S RESPONSIBILITY TO OBTAIN THE NECESSARY PERMITS FOR THE WORK, SCHEDULE NECESSARY INSPECTIONS, AND PROVIDE THE NECESSARY TRAFFIC CONTROL MEASURES AND DEVICES, ETC., FOR WORK PERFORMED IN THE RIGHT OF WAYS.
5. ALL PROPOSED STORM SEWER AND DRAINAGE APPURTENANCES SHALL BE IN CONFORMANCE WITH THE CITY OF COLUMBUS STORMWATER TECHNICAL STANDARDS MANUAL, LATEST EDITION. DISCREPANCIES BETWEEN THE PLANS AND THE MANUAL SHALL NOT ALLEVIATE THE CONTRACTOR FROM ADHERING TO THE REQUIREMENTS AS SET FORTH IN THE MANUAL.

BENCHMARKS:

UNLESS OTHERWISE NOTED, ELEVATIONS SHOWN HEREON ARE BASED UPON AN OPUS SOLUTION AND ARE ON THE 1988 NORTH AMERICAN VERTICAL DATUM (NAVD83) (GEOID 18). IT IS MY OPINION THAT THE UNCERTAINTY IN THE ELEVATION OF THE PROJECT BENCHMARK DOES NOT EXCEED 0.10 FOOT.

TM#1: SET MAGNOL ON TOP OF A LIGHT BASE LOCATED APPROXIMATELY 140 FEET SOUTH OF THE SOUTHWEST CORNER OF THE SITE. ELEV. = 639.79

TM#2: NORTHEAST BOLT ON TOP OF A FIRE HYDRANT LOCATED IN THE SOUTHWEST QUADRANT OF THE INTERSECTION OF CALIFORNIA ST. AND 27TH ST. ELEV. = 639.31

TM#3: SOUTHWEST BOLT ON TOP OF A FIRE HYDRANT LOCATED IN THE NORTHEAST QUADRANT OF THE INTERSECTION OF HOME AVE. AND 27TH ST. ELEV. = 636.88

TM#4: NORTHEAST BOLT ON TOP OF A FIRE HYDRANT LOCATED AT THE SOUTHWEST CORNER OF THE SITE. ELEV. = 636.48

DRAINAGE LEGEND:

- 800 PROPOSED INDEX CONTOUR
- 798 PROPOSED INTERMEDIATE CONTOUR
- PROPOSED DRAINAGE SWALE
- PROPOSED GRADE BREAK
- PROPOSED STORM SEWER LINE
- PROPOSED UNDERDRAIN
- RD PROPOSED ROOF DRAIN
- PROPOSED STORM MANHOLE, INLET
- PROPOSED BEEHIVE INLET SQUARE
- PROPOSED CURB INLET
- PROPOSED INLET (CIRCULAR)

Structure Table			
Structure Name	RM E	INVERT IN	INVERT OUT
400	636.15	400 = 632.30	400 = 632.30
401	636.20	401 = 632.03	401 = 632.03
402	635.83	402 = 631.65	402 = 631.65
403	636.82	403 = 631.41	403 = 631.00
404	636.87	404 = 632.87	404 = 632.87
410	638.10	410A = 635.58	410B = 635.58
411	638.33	410B = 635.28	411 = 634.47
412	634.84	411 = 634.16	412 = 634.16

Pipe Table			
Pipe Name	Size (in)	Length (ft)	Slope
400	12	86.3	0.30%
401	15	107.7	0.30%
402	18	41.8	0.30%
403A	18	82.8	0.80%
403B	18	128.0	0.30%
404	12	57.8	0.28%
410A	8	99.8	1.00%
410B	8	30.4	1.00%
411	8	30.7	1.00%
412	8	16.1	1.00%

BCSC
TOGETHER WE LEARN

CSO

Civil & Environmental Consultants, Inc.
530 E. Ohio Street, Suite G - Indianapolis, IN 46204
317-465-7777 | 817-746-9749
www.ceconline.com

BARTHOLOMEW CONSOLIDATED SCHOOL CORPORATION
RENOVATIONS TO
L. C. SCHMITT ELEMENTARY
2875 CALIFORNIA STREET, COLUMBUS, IN 47201

SCOPE DRAWINGS:
These drawings include the general scope of the project in terms of professional design services. The responsibility of structural, mechanical and electrical systems, and the design of the construction and completion of the work shown on the drawings is the responsibility of the contractor. On the part of the engineer, no warranty is made that the contractor shall furnish all items required for the proper installation and completion of the work.

REVISIONS:
03/08/2024 - ADDENDUM #01
03/15/2024 - ADDENDUM #02

ISSUE DATE: 02/16/2024 | DRAWN BY: RT | CHECKED BY: JP


DRAWING TITLE:
DRAINAGE PLAN

CERTIFIED BY:
LOW THAM M. PATE
REGISTERED PROFESSIONAL ENGINEER
No. PE12100229
STATE OF INDIANA
02/16/24


DRAWING NUMBER:
C400

PROJECT NUMBER:
2021049


Indiana 811
Know what's below. Call before you dig.

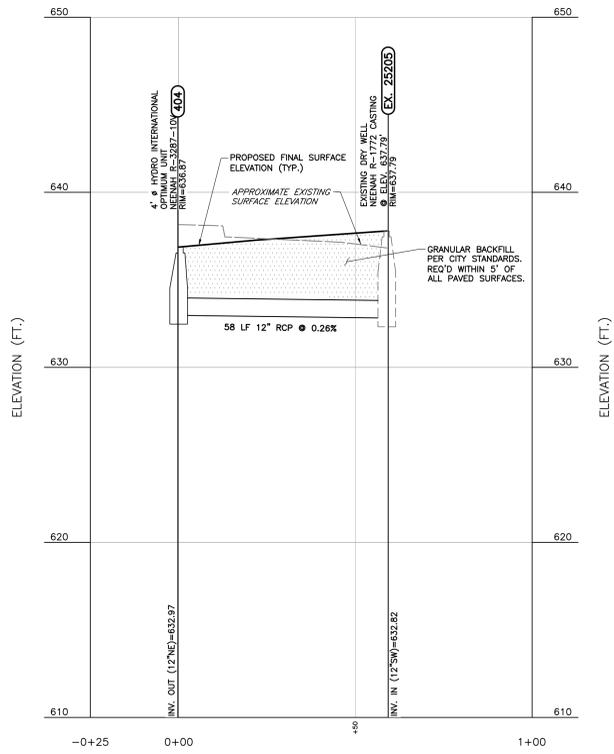


STR 404 - EX.25205 PROFILE
SCALE: H:1"=20'; V:1"=4'

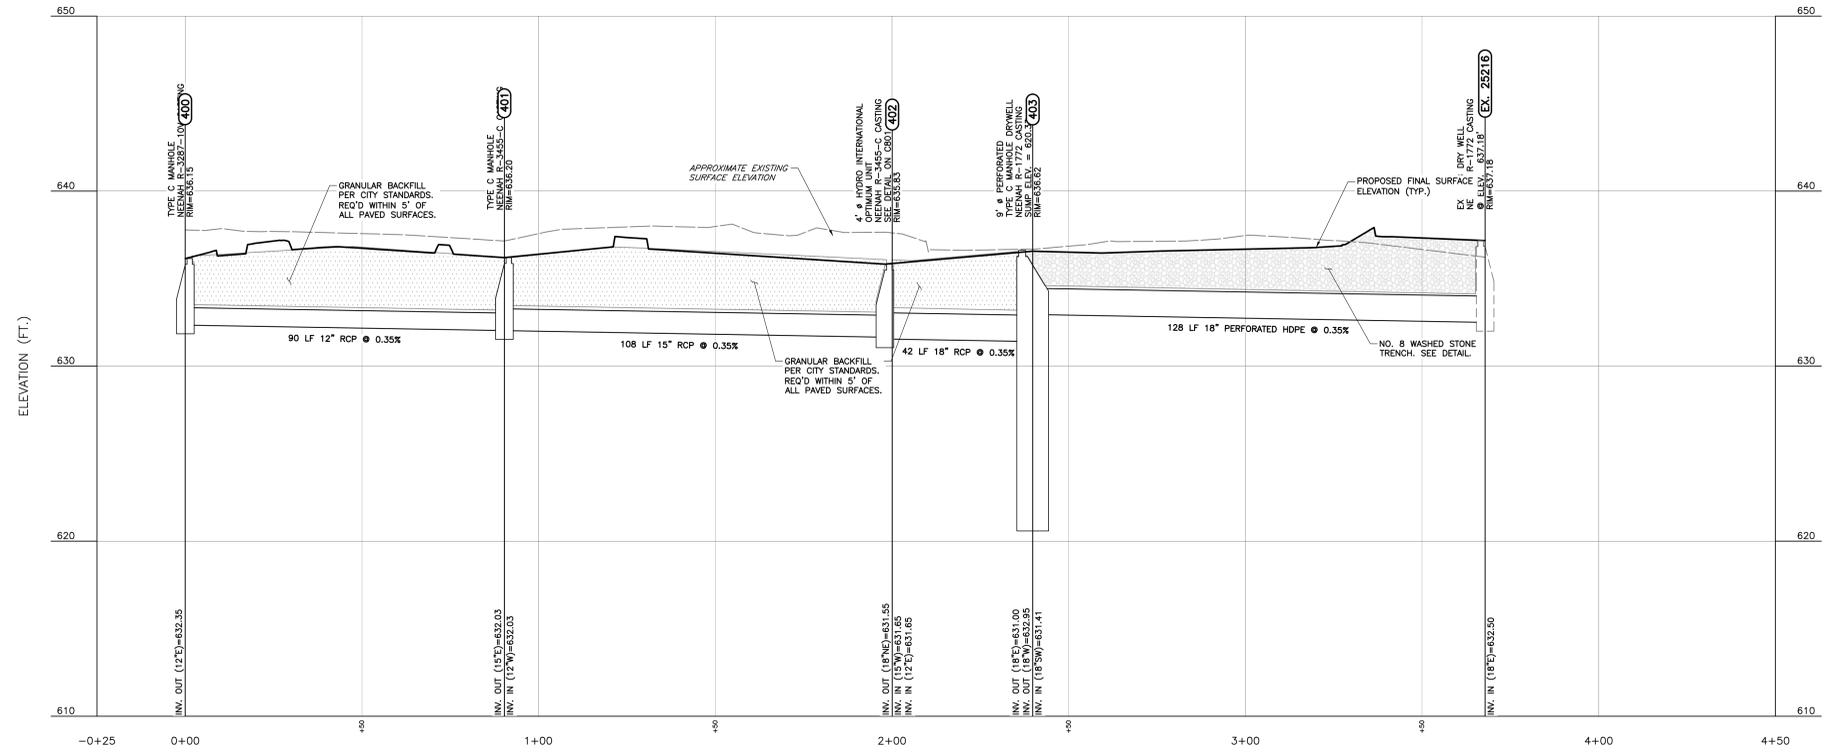


STR 400 - EX.25216 PROFILE
SCALE: H:1"=20'; V:1"=4'

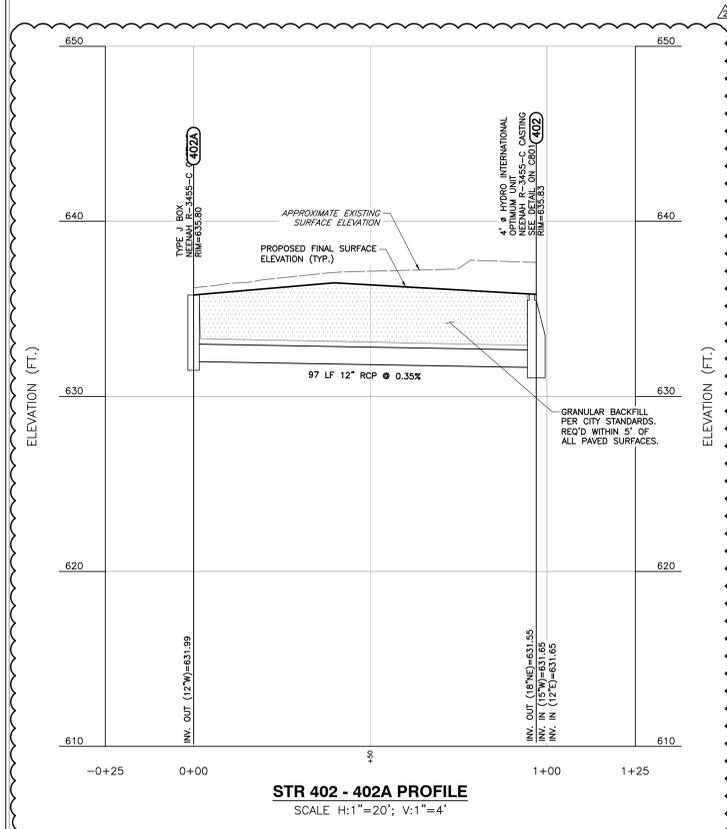


STR 402 - 402A PROFILE
SCALE: H:1"=20'; V:1"=4'

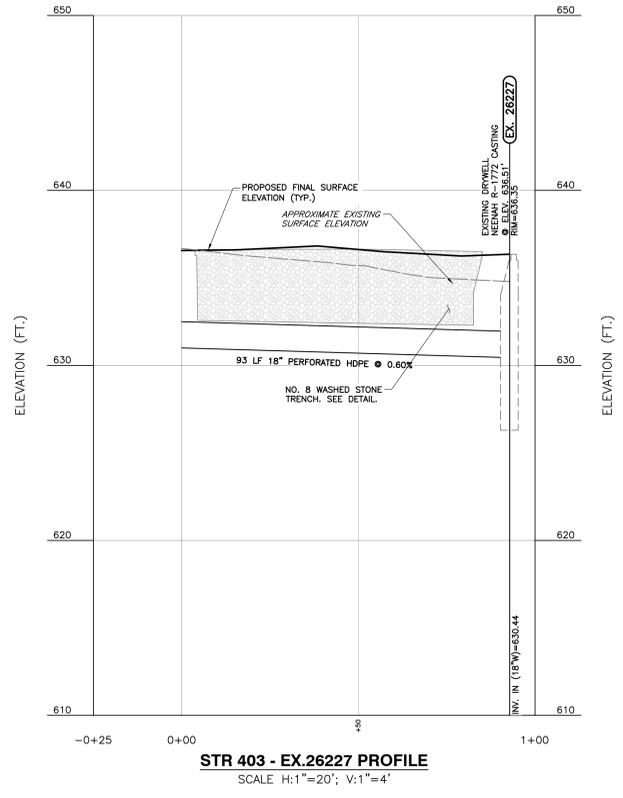

STR 403 - EX.26227 PROFILE
SCALE: H:1"=20'; V:1"=4'

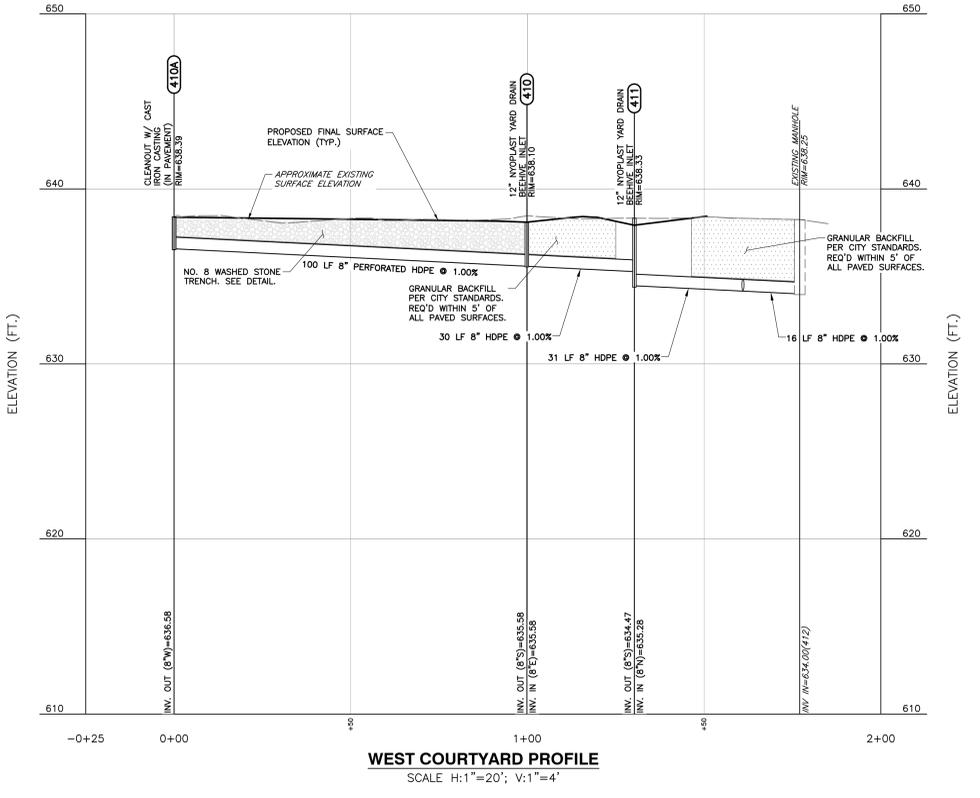


WEST COURTYARD PROFILE
SCALE: H:1"=20'; V:1"=4'

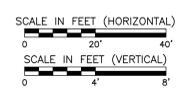



NORTH

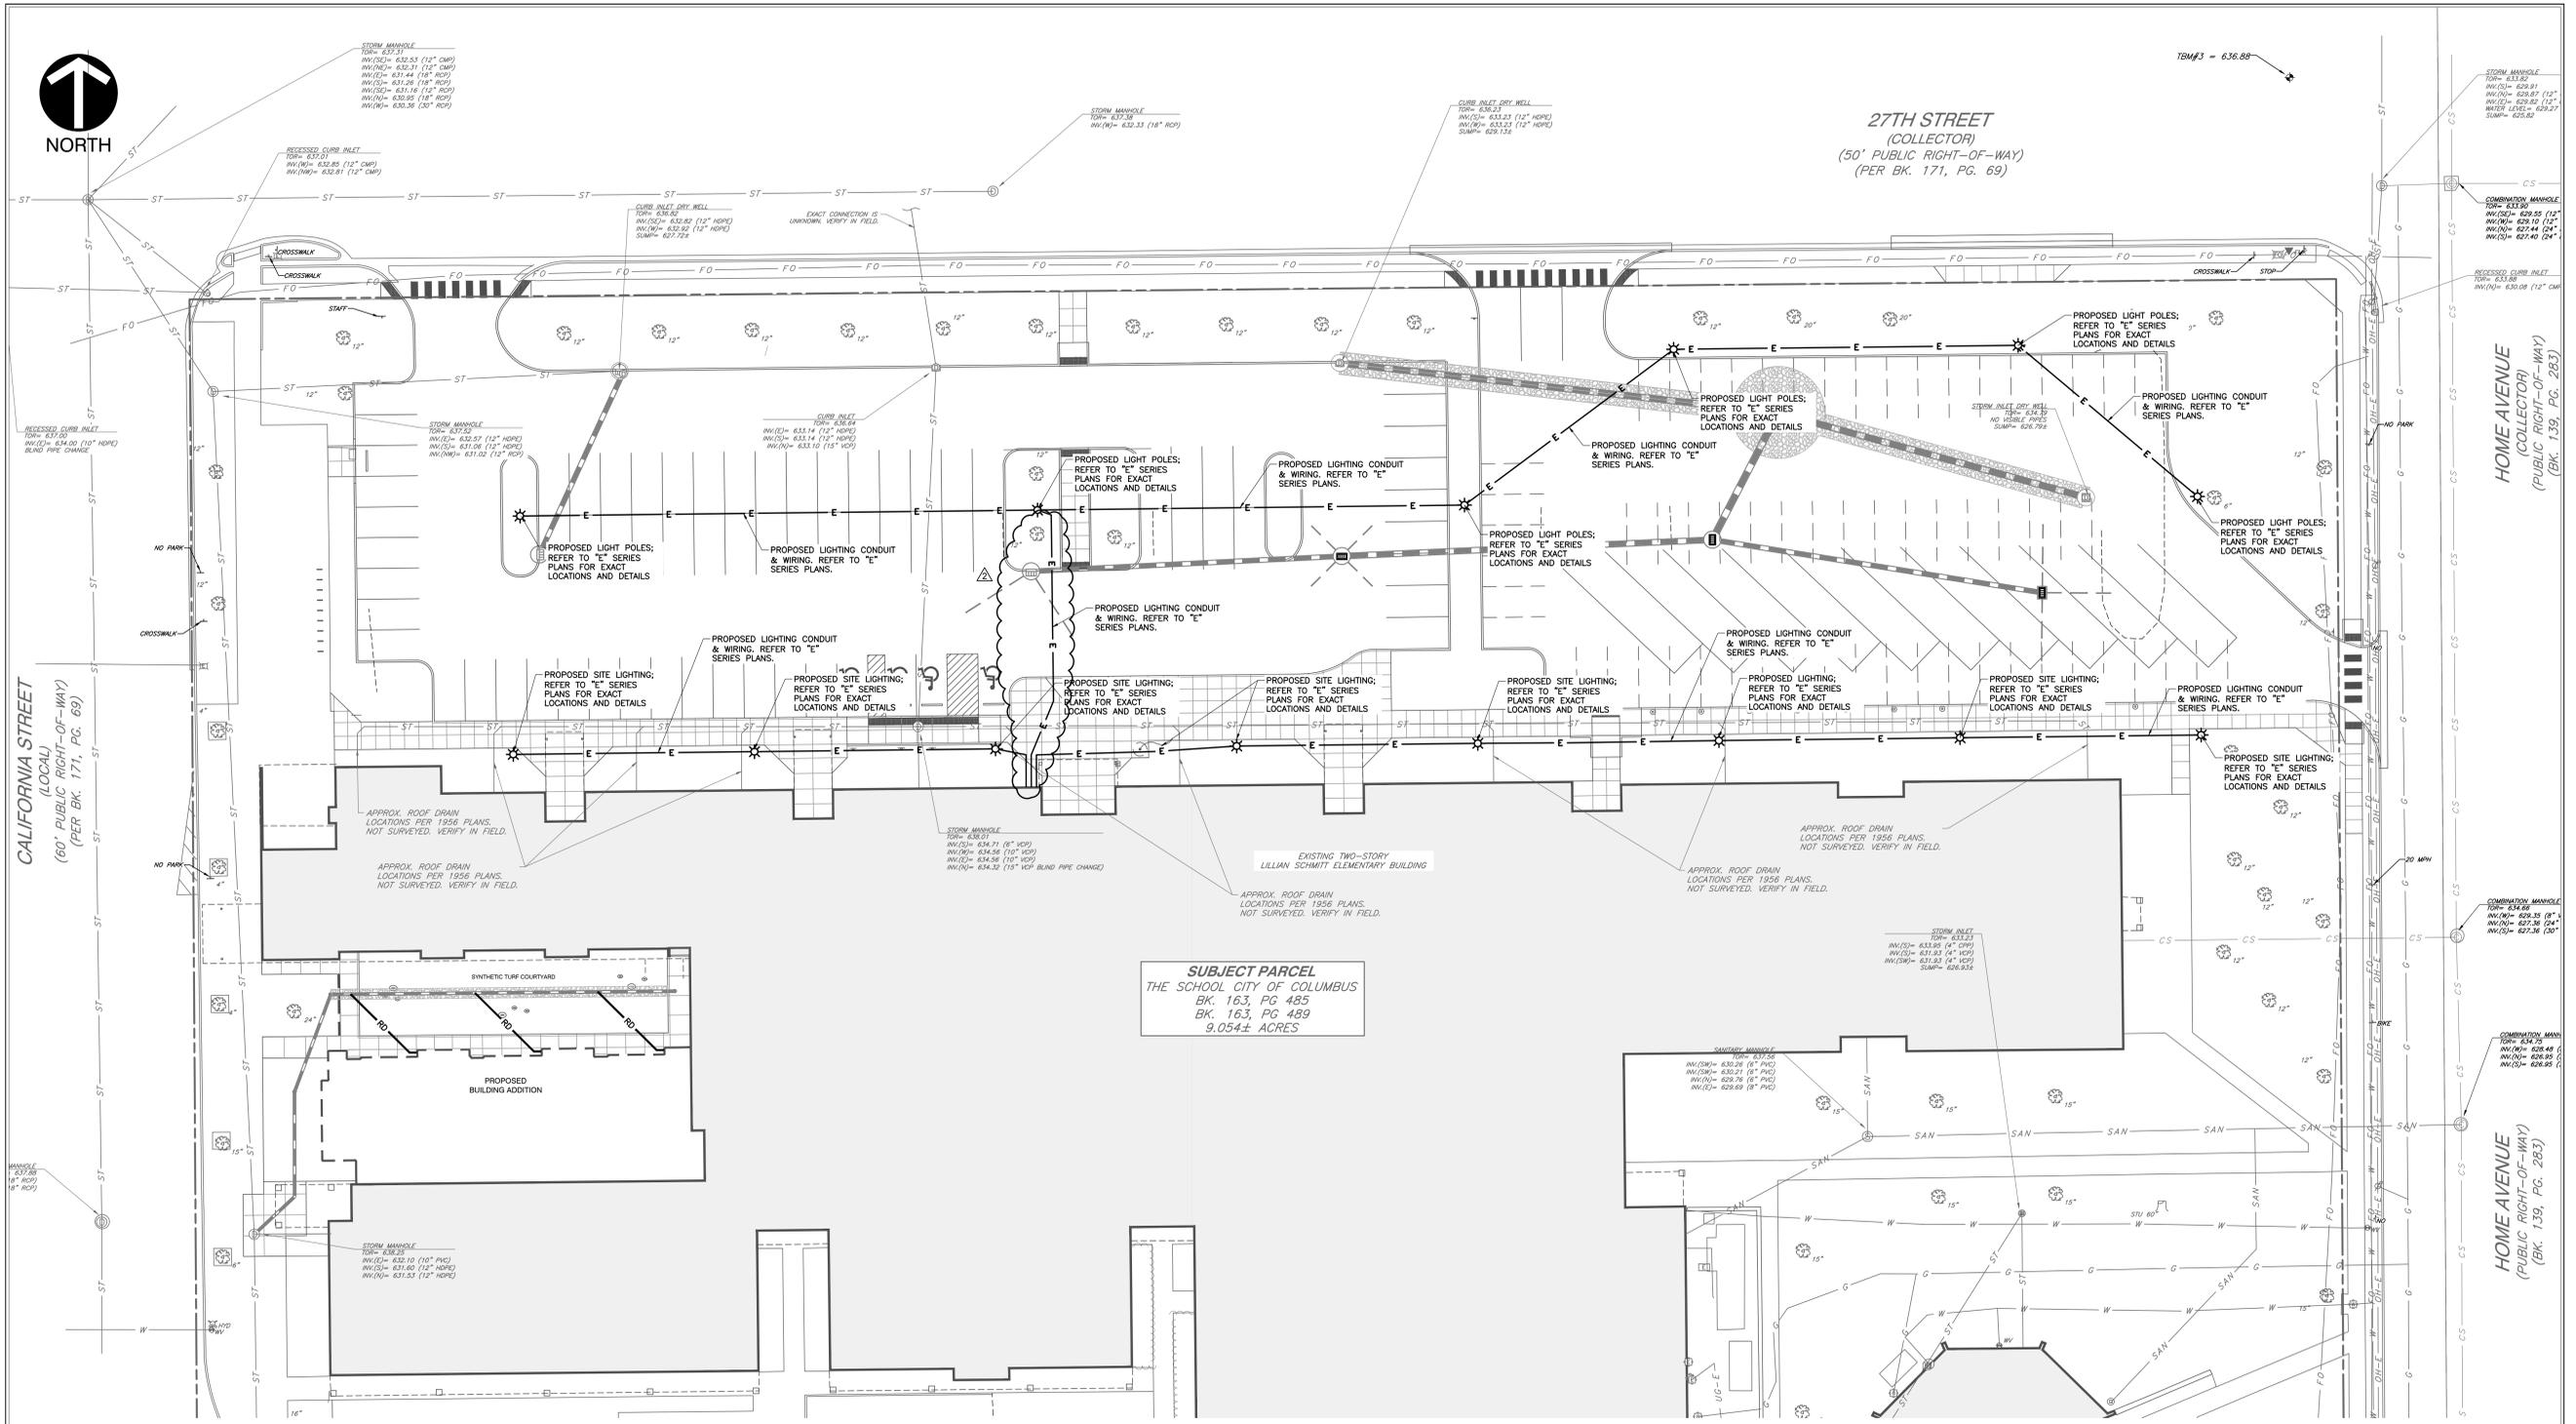

SUBJECT PARCEL
THE SCHOOL CITY OF COLUMBUS
BK. 163, PG 485
BK. 163, PG 489
9.054± ACRES

27TH STREET
(COLLECTOR)
(50' PUBLIC RIGHT-OF-WAY)
(PER BK. 171, PG. 69)

HOME AVENUE
(COLLECTOR)
(PUBLIC RIGHT-OF-WAY)
(BK. 139, PG. 283)

CALIFORNIA STREET
(LOCAL)
(60' PUBLIC RIGHT-OF-WAY)
(PER BK. 171, PG. 69)



CSO
8831 Keystone Crossing, Indianapolis, IN 46240
317.846.7800 | csoinc.net

CEE
Civil & Environmental Consultants, Inc.
530 E. Ohio Street, Suite G - Indianapolis, IN 46204
317.465.7777 | 877.746.6749
www.ceeinc.com

BARTHOLOMEW CONSOLIDATED SCHOOL CORPORATION
RENOVATIONS TO
L. C. SCHMITT ELEMENTARY
2875 CALIFORNIA STREET, COLUMBUS, IN 47201

SCOPE DRAWINGS:
These drawings indicate the general scope of the project in terms of architectural design concept. The delineation of structural, mechanical and electrical systems, and the design of the site and landscape are not necessarily included or described in the drawings. The contractor shall verify all utility locations and depths in the field prior to construction.

REVISIONS:
03/08/2024 - ADDENDUM #01
03/15/2024 - ADDENDUM #02

ISSUE DATE 02/16/2024
DRAWN BY RT
CHECKED BY JP

DRAWING TITLE:
UTILITY PLAN

CERTIFIED BY:
LOWTHAN M. PATE
REGISTERED PROFESSIONAL ENGINEER
No. PE12100829
STATE OF INDIANA
02/16/24

DRAWING NUMBER
C500

PROJECT NUMBER
2021049

- GENERAL UTILITY NOTES:**
1. THE UTILITIES INDICATED ON THESE PLANS AND ON THE SURVEY MAY NOT BE A COMPLETE INVENTORY OF ALL THE EXISTING UTILITIES PRESENT ON AND AROUND THE SITE. THE LOCATION AND SIZE OF THESE UTILITIES MAY BE APPROXIMATE. THE ENGINEER SHALL NOT BE HELD LIABLE FOR ANY INACCURATE UTILITY INFORMATION INDICATED, IMPLIED, OR NOT INDICATED ON THESE PLANS.
 2. IT SHALL BE THE CONTRACTOR'S RESPONSIBILITY TO LOCATE AND MAINTAIN IN SERVICE ALL EXISTING UTILITIES ENCOUNTERED DURING CONSTRUCTION UNLESS OTHERWISE INDICATED IN THE DRAWINGS. ANY PIPING WHICH CAN BE REMOVED DURING CONSTRUCTION WITHOUT UNDUE INTERRUPTION OF SERVICE MAY BE REMOVED AND REPLACED BY THE CONTRACTOR, AT HIS EXPENSE, WITH THE PERMISSION OF THE OWNER.
 3. BEFORE WORKING WITH OR AROUND EXISTING UTILITIES, THE APPLICABLE UTILITY COMPANY SHALL BE CONTACTED BY THE CONTRACTOR.
 4. WHEN CONNECTIONS ARE TO BE MADE TO EXISTING PIPING AND STRUCTURES OR WHERE CONSTRUCTION IS IN THE VICINITY OF EXISTING PIPING THE LOCATION AND ELEVATION OF THE EXISTING PIPING SHALL BE FIELD VERIFIED AND NOTIFICATION GIVEN TO THE OWNER IF THE EXISTING PIPING IS FOUND TO BE DIFFERENT THAN THAT SHOWN ON THE DRAWINGS.
 5. FOR CLARITY OF THESE DRAWINGS, PIPES MAY NOT BE DRAWN TO SCALE OR EXACTLY LOCATED.
 6. ALL NEW WATER LINES SHALL HAVE A MINIMUM OF 54 INCHES OF COVER.
 7. MINIMUM OF 18 INCHES OF VERTICAL CLEARANCE SHALL BE PROVIDED BETWEEN NEW WATER AND SANITARY SEWER LINES. IF 18 INCHES OF CLEARANCE IS NOT PROVIDED THEN THE SEWER MUST BE CONSTRUCTED OF WATER WORKS GRADE DUCTILE IRON PIPE WITH MECHANICAL JOINTS WITHIN TEN FEET OF THE WATER LINE.
 8. IT IS THE RESPONSIBILITY OF THE CONTRACTOR OR CONTRACTORS TO OBTAIN ALL FEDERAL, STATE, COUNTY, CITY OR LOCAL PERMITS FOR ANY AND ALL WORK REQUIRED UNLESS OTHERWISE NOTED. THE CONTRACTOR OR CONTRACTORS ARE RESPONSIBLE TO PAY FOR ALL REQUIRED PERMITS BY ANY OR ALL AGENCIES MENTIONED ABOVE UNLESS OTHERWISE NOTED IN THE CONTRACT OR SPECIFICATIONS. ALL ASSOCIATED BONDING REQUIREMENTS AND COSTS ARE INCIDENTAL TO THE CONTRACT.
 9. THE CONTRACTOR SHALL VERIFY ALL DIMENSIONS AND ELEVATIONS IN THE FIELD PRIOR TO THE START OF CONSTRUCTION. THE CONTRACTOR SHALL BE RESPONSIBLE FOR ALL FIELD DIMENSIONS AND ELEVATIONS DURING THE ENTIRE CONSTRUCTION SCHEDULE. IF ANY DISCREPANCIES ARE FOUND IN THESE ENGINEERING PLANS FROM ACTUAL FIELD DIMENSIONS, THE CONTRACTOR SHALL CONTACT THE ENGINEER IMMEDIATELY.
 10. ALL CONSTRUCTION METHODS AND MATERIALS MUST CONFORM TO CURRENT STANDARDS AND SPECIFICATIONS OF THE FEDERAL, STATE, COUNTY, CITY OR LOCAL REQUIREMENTS, WHICHEVER HAS JURISDICTION.
 11. CONTRACTOR IS RESPONSIBLE FOR ELECTRIC, TELEPHONE, AND CABLE CONDUITS AND TRENCHING. COORDINATE WITH THE LOCAL UTILITY PROVIDERS AND MECHANICAL, ELECTRICAL AND PLUMBING PLANS FOR SIZES AND QUANTITIES.

- BENCHMARKS:**
- UNLESS OTHERWISE NOTED, ELEVATIONS SHOWN HEREON ARE BASED UPON AN OPUS SOLUTION AND ARE ON THE 1988 NORTH AMERICAN VERTICAL DATUM (NAVD83) (GEOID 18). IT IS MY OPINION THAT THE UNCERTAINTY IN THE ELEVATION OF THE PROJECT BENCHMARK DOES NOT EXCEED 0.10 FOOT.
- TBM#1: SET MAGNOL ON TOP OF A LIGHT BASE LOCATED APPROXIMATELY 140 FEET SOUTH OF THE SOUTHWEST CORNER OF THE SITE. ELEV. = 639.79
- TBM#2: NORTHEAST BOLT ON TOP OF A FIRE HYDRANT LOCATED IN THE SOUTHWEST QUADRANT OF THE INTERSECTION OF CALIFORNIA ST. AND 27TH ST. ELEV. = 639.31
- TBM#3: SOUTHWEST BOLT ON TOP OF A FIRE HYDRANT LOCATED IN THE NORTHWEST QUADRANT OF THE INTERSECTION OF HOME AVE. AND 27TH ST. ELEV. = 636.88
- TBM#4: NORTHEAST BOLT ON TOP OF A FIRE HYDRANT LOCATED AT THE SOUTHEAST CORNER OF THE SITE. ELEV. = 636.48
- UTILITY NOTE:**
- THE UNDERGROUND UTILITIES SHOWN HAVE BEEN LOCATED FROM FIELD SURVEY INFORMATION AND EXISTING DRAWINGS. THE SURVEYOR MAKES NO GUARANTEES THAT THE UNDERGROUND UTILITIES COMPRISE ALL SUCH UTILITIES IN THE AREA, EITHER IN-SERVICE OR ABANDONED. THE SURVEYOR FURTHER DOES NOT WARRANT THAT THE UNDERGROUND UTILITIES SHOWN ARE IN THE EXACT LOCATION INDICATED ALTHOUGH THE SURVEYOR DOES CERTIFY THAT THEY ARE LOCATED AS ACCURATELY AS POSSIBLE FROM INFORMATION AVAILABLE. THE SURVEYOR HAS NOT PHYSICALLY LOCATED THE UNDERGROUND UTILITIES. INDIANA 811 ONE-CALL PUBLIC UTILITY LOCATE SERVICE TICKET NUMBER 2310171909 WAS ISSUED FOR THIS SITE. AMERICAN LOCATING SERVICES, A PRIVATE SUBSURFACE UTILITY LOCATING SERVICE, WAS CONTRACTED TO PERFORM THE PRIVATE UTILITY LOCATIONS FOR THE SUBJECT SITE. THE PRIVATE UTILITIES LOCATED AND DEPICTED HEREIN WERE EITHER OBSERVED FROM MARKINGS ON THE GROUND OR USING EXISTING PLANS PROVIDED BY THE SCHOOL.
- PRIOR TO ANY EXCAVATION FOR UNDERGROUND UTILITIES, THE CONTRACTOR SHALL EXPOSE AND VERIFY LOCATIONS (HORIZONTAL AND VERTICAL) OF ALL EXISTING UTILITIES INCLUDING BUT NOT LIMITED TO GAS, WATER, AND SANITARY SEWER. ANY CONFLICTS SHALL BE REPORTED IMMEDIATELY TO THE ENGINEER AND THE APPROPRIATE AUTHORITIES.

PROPOSED UTILITY LEGEND:


ST	PROPOSED STORM SEWER LINE
SAN	PROPOSED SANITARY LINE
E	PROPOSED ELECTRIC LINE
T	PROPOSED TELEPHONE LINE
G	PROPOSED GAS LINE
W	PROPOSED WATER LINE
FP	PROPOSED FIRE PROTECTION LINE
DW	PROPOSED DOMESTIC WATER LINE
---	PROPOSED CONDUIT
*	PROPOSED LIGHT POLE
⊕	PROPOSED FIRE DEPT. CONNECTION, HYDRANT, WALL PIV, WATER VALVE, THRUST BLOCK
⊙	PROPOSED SANITARY MANHOLE, CLEAN OUT
⊞	PROPOSED TELEPHONE PEDESTAL
⊠	PROPOSED ELECTRIC TRANSFORMER

SCALE IN FEET
0 20 40





NORTH

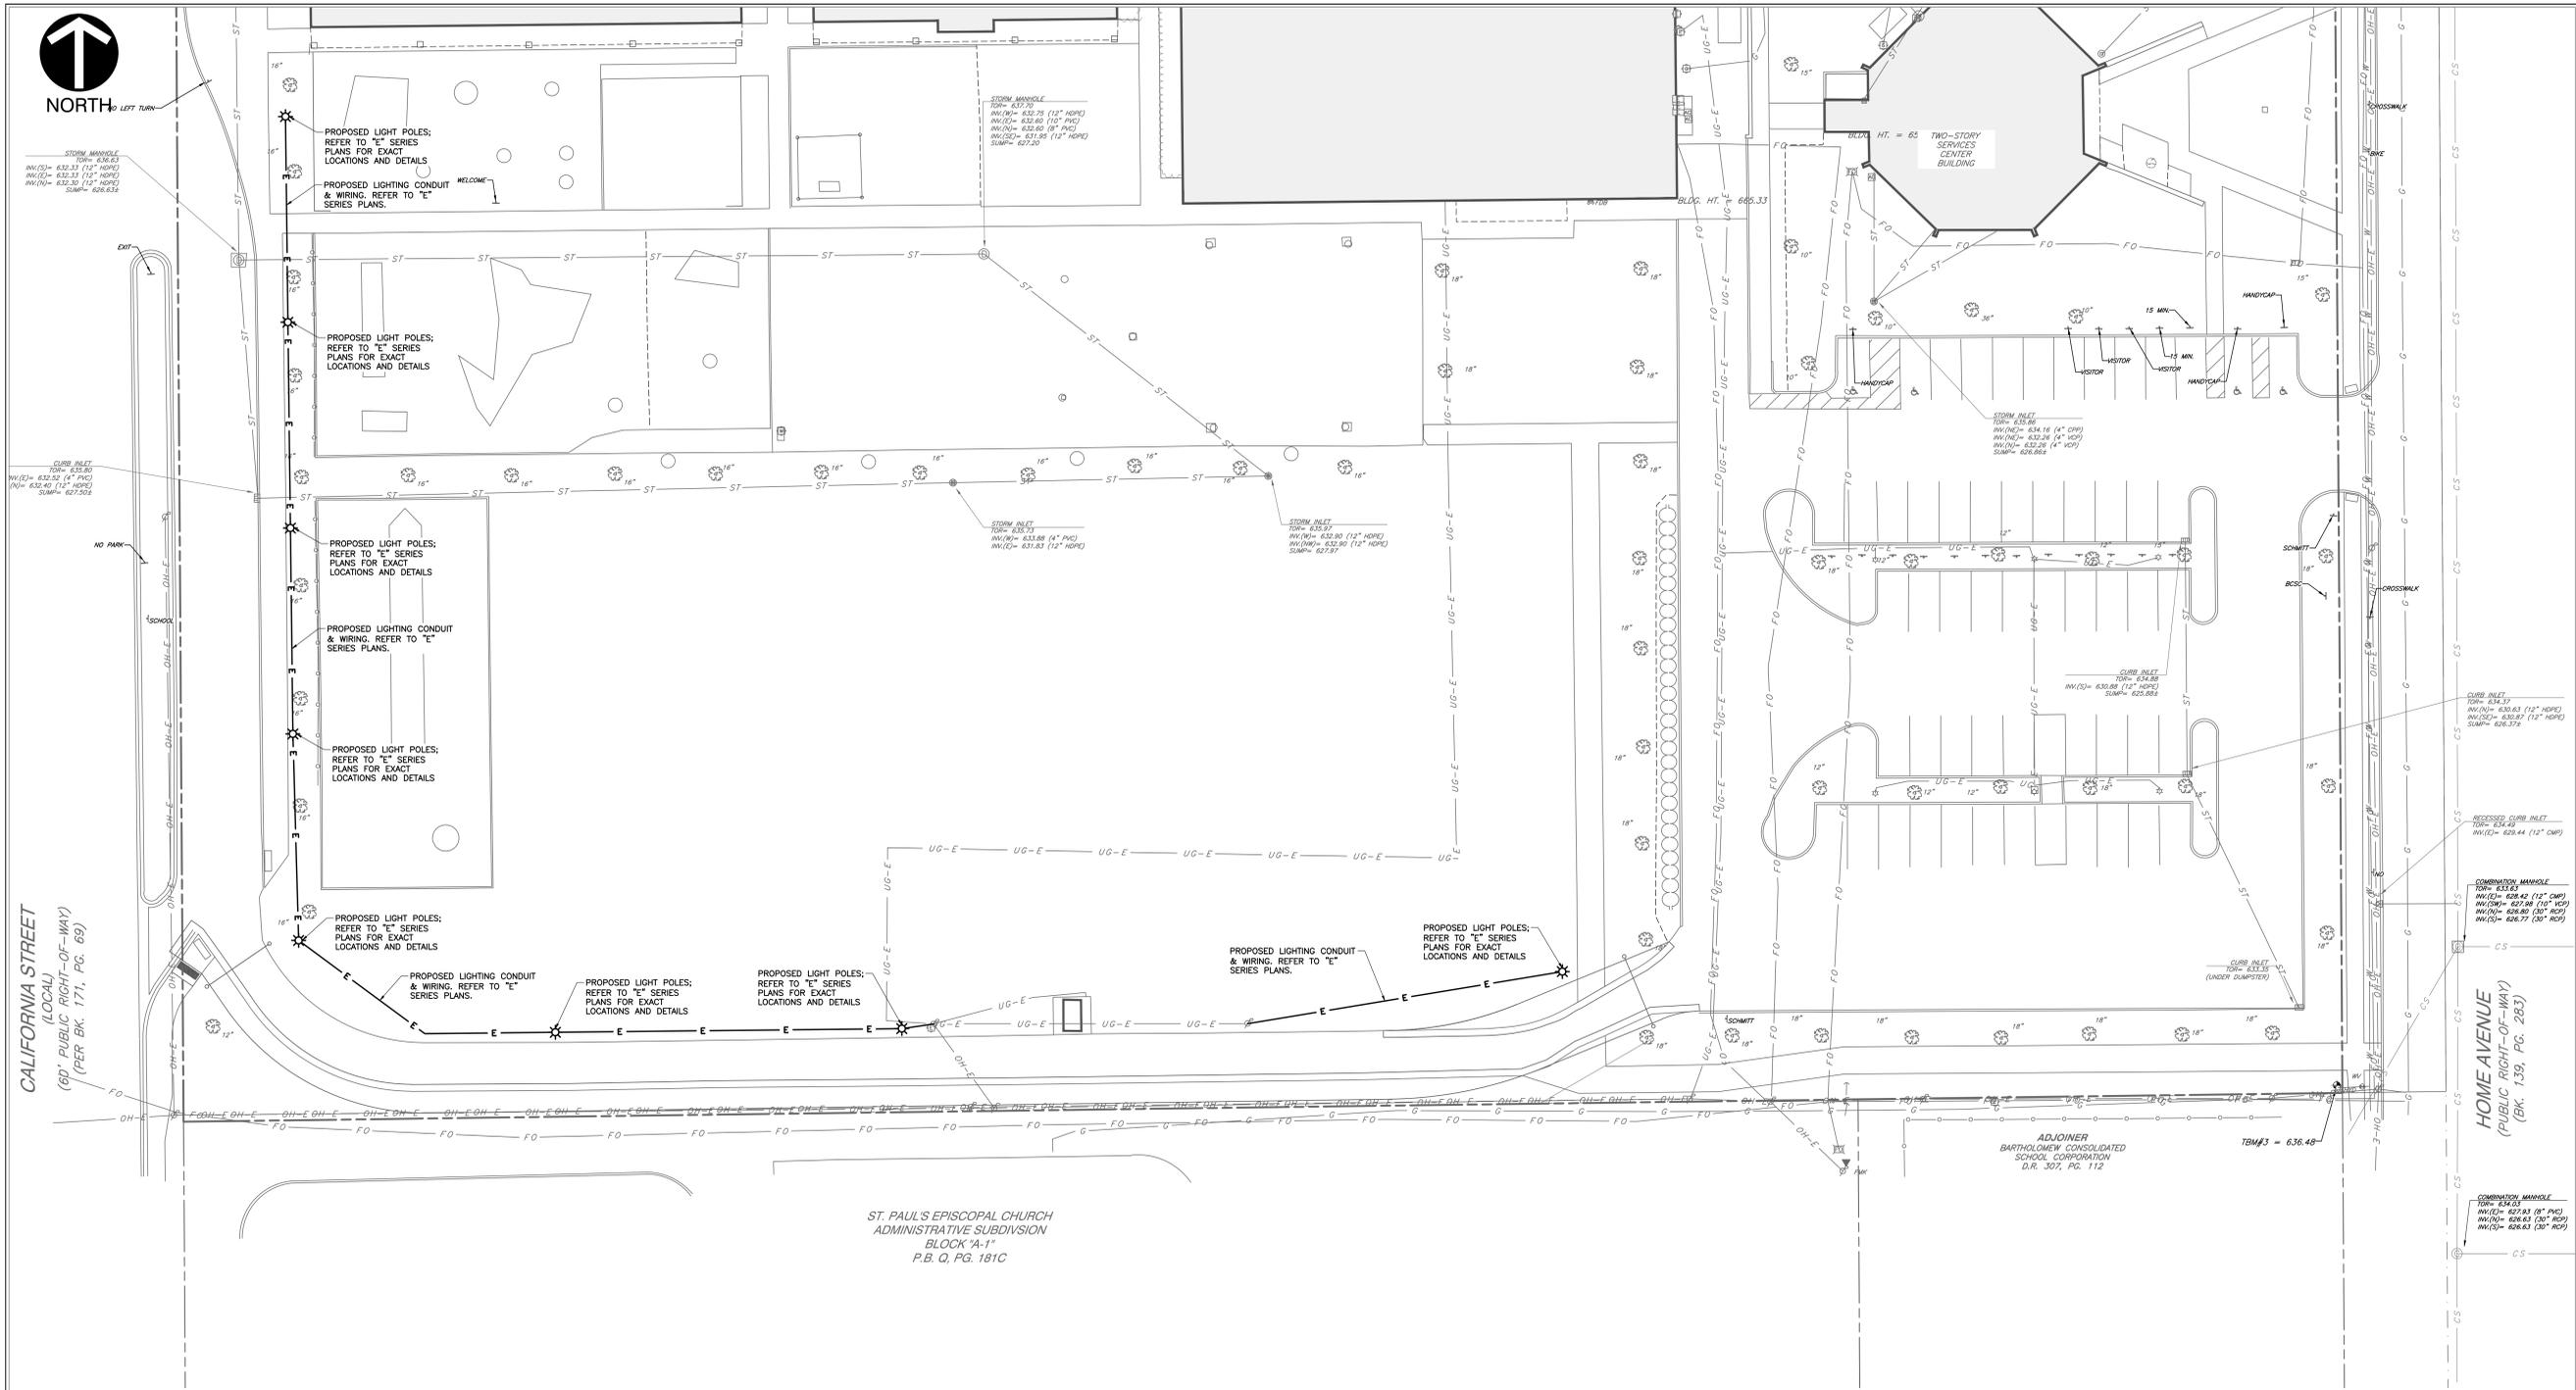

CALIFORNIA STREET
(LOCAL)
(60' PUBLIC RIGHT-OF-WAY)
(PER BK. 171, PG. 69)

HOME AVENUE
(PUBLIC RIGHT-OF-WAY)
(BK. 139, PG. 283)

ST. PAUL'S EPISCOPAL CHURCH
ADMINISTRATIVE SUBDIVISION
BLOCK "A-1"
P.B. Q, PG. 181C

ADJOINER
BARTHOLOMEW CONSOLIDATED
SCHOOL CORPORATION
D.R. 307, PG. 112

- GENERAL UTILITY NOTES:**
- THE UTILITIES INDICATED ON THESE PLANS AND ON THE SURVEY MAY NOT BE A COMPLETE INVENTORY OF ALL THE EXISTING UTILITIES PRESENT ON AND AROUND THE SITE. THE LOCATION AND SIZE OF THESE UTILITIES MAY BE APPROXIMATE. THE ENGINEER SHALL NOT BE HELD LIABLE FOR ANY INACCURATE UTILITY INFORMATION INDICATED, IMPLIED, OR NOT INDICATED ON THESE PLANS.
 - IT SHALL BE THE CONTRACTOR'S RESPONSIBILITY TO LOCATE AND MAINTAIN IN SERVICE ALL EXISTING UTILITIES ENCOUNTERED DURING CONSTRUCTION UNLESS OTHERWISE INDICATED IN THE DRAWINGS. ANY PIPING WHICH CAN BE REMOVED DURING CONSTRUCTION WITHOUT UNDUE INTERRUPTION OF SERVICE MAY BE REMOVED AND REPLACED BY THE CONTRACTOR, AT HIS EXPENSE, WITH THE PERMISSION OF THE OWNER.
 - BEFORE WORKING WITH OR AROUND EXISTING UTILITIES, THE APPLICABLE UTILITY COMPANY SHALL BE CONTACTED BY THE CONTRACTOR.
 - WHEN CONNECTIONS ARE TO BE MADE TO EXISTING PIPING AND STRUCTURES OR WHERE CONSTRUCTION IS IN THE VICINITY OF EXISTING PIPING THE LOCATION AND ELEVATION OF THE EXISTING PIPING SHALL BE FIELD VERIFIED AND NOTIFICATION GIVEN TO THE OWNER IF THE EXISTING PIPING IS FOUND TO BE DIFFERENT THAN THAT SHOWN ON THE DRAWINGS.
 - FOR CLARITY OF THESE DRAWINGS, PIPES MAY NOT BE DRAWN TO SCALE OR EXACTLY LOCATED.
 - ALL NEW WATER LINES SHALL HAVE A MINIMUM OF 54 INCHES OF COVER.
 - MINIMUM OF 18 INCHES OF VERTICAL CLEARANCE SHALL BE PROVIDED BETWEEN NEW WATER AND SANITARY SEWER LINES. IF 18 INCHES OF CLEARANCE IS NOT PROVIDED THEN THE SEWER MUST BE CONSTRUCTED OF WATER WORKS GRADE DUCTILE IRON PIPE WITH MECHANICAL JOINTS WITHIN TEN FEET OF THE WATER LINE.
 - IT IS THE RESPONSIBILITY OF THE CONTRACTOR OR CONTRACTORS TO OBTAIN ALL FEDERAL, STATE, COUNTY, CITY OR LOCAL PERMITS FOR ANY AND ALL WORK REQUIRED UNLESS OTHERWISE NOTED. THE CONTRACTOR OR CONTRACTORS ARE RESPONSIBLE TO PAY FOR ALL REQUIRED PERMITS BY ANY OR ALL AGENCIES MENTIONED ABOVE UNLESS OTHERWISE NOTED IN THE CONTRACT OR SPECIFICATIONS. ALL ASSOCIATED BONDING REQUIREMENTS AND COSTS ARE INCIDENTAL TO THE CONTRACT.
 - THE CONTRACTOR SHALL VERIFY ALL DIMENSIONS AND ELEVATIONS IN THE FIELD PRIOR TO THE START OF CONSTRUCTION. THE CONTRACTOR SHALL BE RESPONSIBLE FOR ALL FIELD DIMENSIONS AND ELEVATIONS DURING THE ENTIRE CONSTRUCTION SCHEDULE. IF ANY DISCREPANCIES ARE FOUND IN THESE ENGINEERING PLANS FROM ACTUAL FIELD DIMENSIONS, THE CONTRACTOR SHALL CONTACT THE ENGINEER IMMEDIATELY.
 - ALL CONSTRUCTION METHODS AND MATERIALS MUST CONFORM TO CURRENT STANDARDS AND SPECIFICATIONS OF THE FEDERAL, STATE, COUNTY, CITY OR LOCAL REQUIREMENTS, WHICHEVER HAS JURISDICTION.
 - CONTRACTOR IS RESPONSIBLE FOR ELECTRIC, TELEPHONE, AND CABLE CONDUITS AND TRENCHING. COORDINATE WITH THE LOCAL UTILITY PROVIDERS AND MECHANICAL, ELECTRICAL AND PLUMBING PLANS FOR SIZES AND QUANTITIES.

- BENCHMARKS:**
- UNLESS OTHERWISE NOTED, ELEVATIONS SHOWN HEREON ARE BASED UPON AN OPUS SOLUTION AND ARE ON THE 1988 NORTH AMERICAN VERTICAL DATUM (NAVD83) (GEOID 18). IT IS MY OPINION THAT THE UNCERTAINTY IN THE ELEVATION OF THE PROJECT BENCHMARK DOES NOT EXCEED 0.10 FOOT.
- TBM#1: SET MAGNOL ON TOP OF A LIGHT BASE LOCATED APPROXIMATELY 140 FEET SOUTH OF THE SOUTHWEST CORNER OF THE SITE. ELEV. = 639.79
- TBM#2: NORTHEAST BOLT ON TOP OF A FIRE HYDRANT LOCATED IN THE SOUTHWEST QUADRANT OF THE INTERSECTION OF CALIFORNIA ST. AND 27TH ST. ELEV. = 639.31
- TBM#3: SOUTHWEST BOLT ON TOP OF A FIRE HYDRANT LOCATED IN THE NORTHWEST QUADRANT OF THE INTERSECTION OF HOME AVE. AND 27TH ST. ELEV. = 636.88
- TBM#4: NORTHEAST BOLT ON TOP OF A FIRE HYDRANT LOCATED AT THE SOUTHEAST CORNER OF THE SITE. ELEV. = 636.48
- UTILITY NOTE:**
- THE UNDERGROUND UTILITIES SHOWN HAVE BEEN LOCATED FROM FIELD SURVEY INFORMATION AND EXISTING DRAWINGS. THE SURVEYOR MAKES NO GUARANTEES THAT THE UNDERGROUND UTILITIES COMPRISE ALL SUCH UTILITIES IN THE AREA, EITHER IN-SERVICE OR ABANDONED. THE SURVEYOR FURTHER DOES NOT WARRANT THAT THE UNDERGROUND UTILITIES SHOWN ARE IN THE EXACT LOCATION INDICATED ALTHOUGH THE SURVEYOR DOES CERTIFY THAT THEY ARE LOCATED AS ACCURATELY AS POSSIBLE FROM INFORMATION AVAILABLE. THE SURVEYOR HAS NOT PHYSICALLY LOCATED THE UNDERGROUND UTILITIES. INDIANA 811 ONE-CALL PUBLIC UTILITY LOCATE SERVICE TICKET NUMBER 2310171909 WAS ISSUED FOR THIS SITE. AMERICAN LOCATING SERVICES, A PRIVATE SUBSURFACE UTILITY LOCATING SERVICE, WAS CONTRACTED TO PERFORM THE PRIVATE UTILITY LOCATIONS FOR THE SUBJECT SITE. THE PRIVATE UTILITIES LOCATED AND DEPICTED HEREIN WERE EITHER OBSERVED FROM MARKINGS ON THE GROUND OR USING EXISTING PLANS PROVIDED BY THE SCHOOL.
- PRIOR TO ANY EXCAVATION FOR UNDERGROUND UTILITIES, THE CONTRACTOR SHALL EXPOSE AND VERIFY LOCATIONS (HORIZONTAL AND VERTICAL) OF ALL EXISTING UTILITIES INCLUDING BUT NOT LIMITED TO GAS, WATER, AND SANITARY SEWER. ANY CONFLICTS SHALL BE REPORTED IMMEDIATELY TO THE ENGINEER AND THE APPROPRIATE AUTHORITIES.

PROPOSED UTILITY LEGEND:

ST	PROPOSED STORM SEWER LINE
SAN	PROPOSED SANITARY LINE
E	PROPOSED ELECTRIC LINE
T	PROPOSED TELEPHONE LINE
G	PROPOSED GAS LINE
W	PROPOSED WATER LINE
FP	PROPOSED FIRE PROTECTION LINE
DW	PROPOSED DOMESTIC WATER LINE
---	PROPOSED CONDUIT
☼	PROPOSED LIGHT POLE
⊕	PROPOSED FIRE DEPT. CONNECTION, HYDRANT, WALL PIV, WATER VALVE, THRUST BLOCK
⊙	PROPOSED SANITARY MANHOLE, CLEAN OUT
⊠	PROPOSED TELEPHONE PEDESTAL
⊡	PROPOSED ELECTRIC TRANSFORMER



CSO
8831 Keystone Crossing, Indianapolis, IN 46240
317.846.7800 | csoinc.net

CEE
Civil & Environmental Consultants, Inc.
530 E. Ohio Street, Suite G - Indianapolis, IN 46204
317.465.7777 | 877.746.6749
www.ceecinc.com

BARTHOLOMEW CONSOLIDATED SCHOOL CORPORATION RENOVATIONS TO L. C. SCHMITT ELEMENTARY
2875 CALIFORNIA STREET, COLUMBUS, IN 47201

SCOPE DRAWINGS:
These drawings indicate the general scope of the project in terms of professional design services. The delineation of all structural, mechanical and electrical systems. The drawings do not necessarily indicate or describe all work required for the performance and completion of the project. On the basis of the general scope indicated on these drawings, the contractor shall furnish all items required for the proper installation and completion of the work.










REVISIONS:
▲ 03/15/2024 - ADDENDUM #02


ISSUE DATE	DRAWN BY	CHECKED BY
02/16/2024	RT	JP

DRAWING TITLE:
UTILITY PLAN SOUTH ALTERNATE


CERTIFIED BY:
DON THAM M. PAIVY
REGISTERED PROFESSIONAL ENGINEER
No. PE12100829
STATE OF INDIANA
02/16/24

DRAWING NUMBER
C501
PROJECT NUMBER
2021049

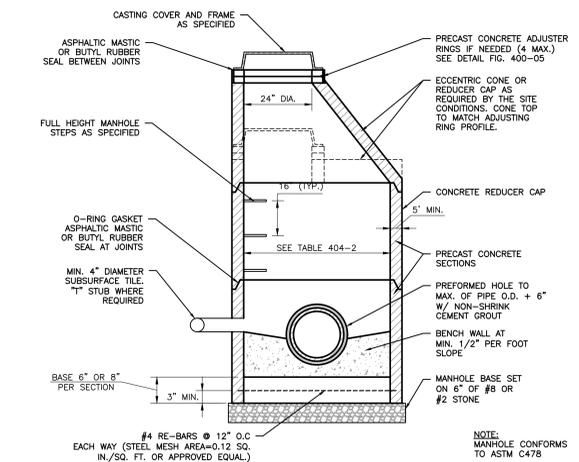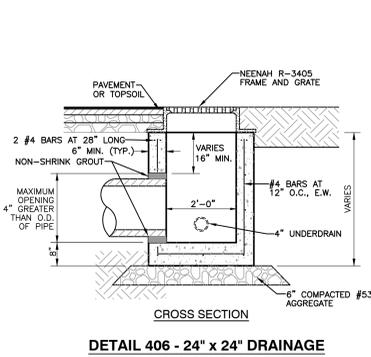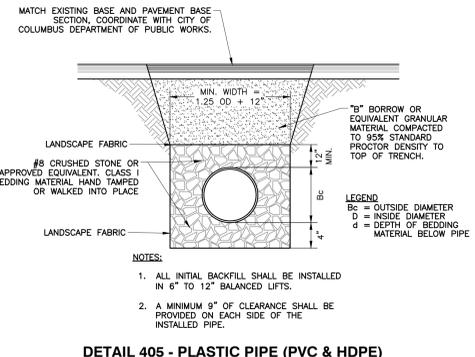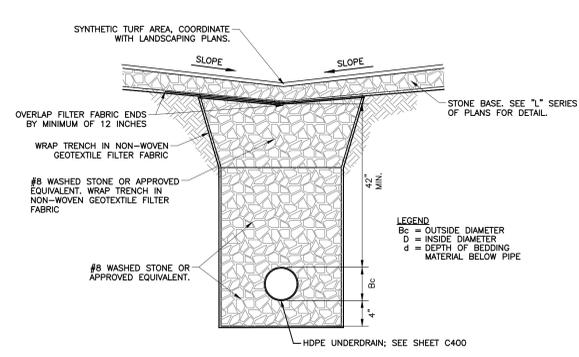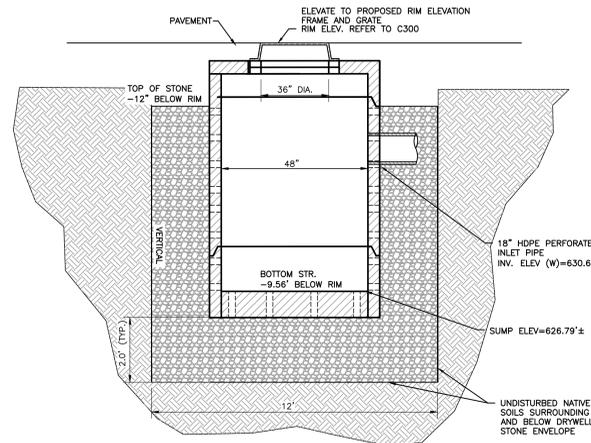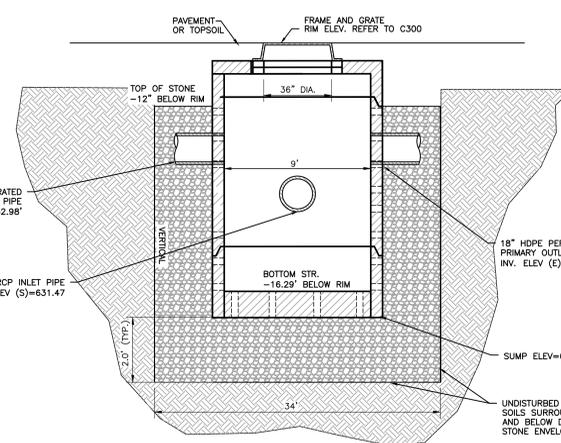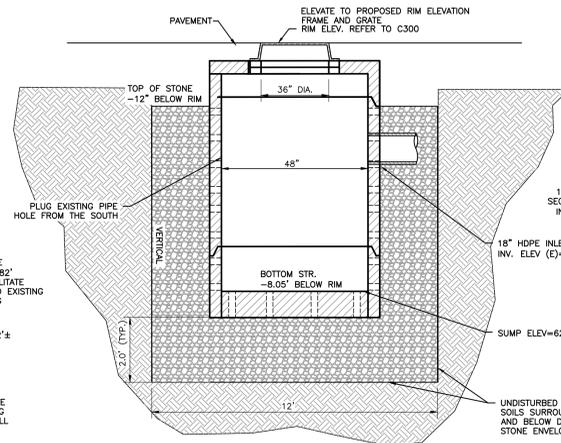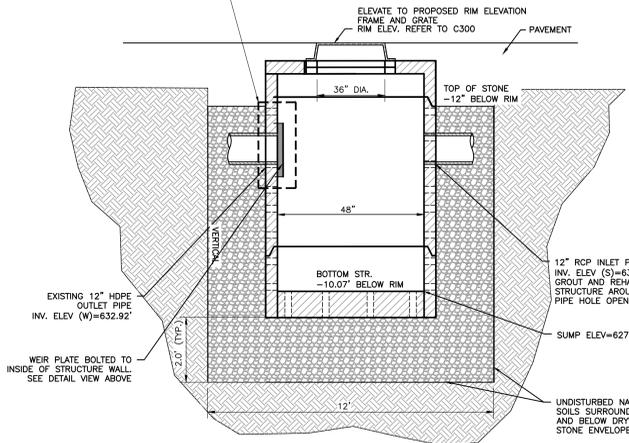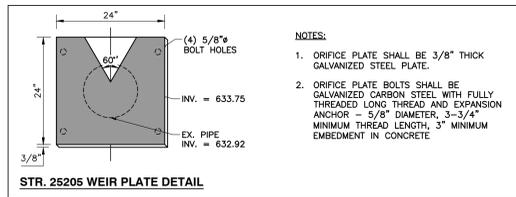


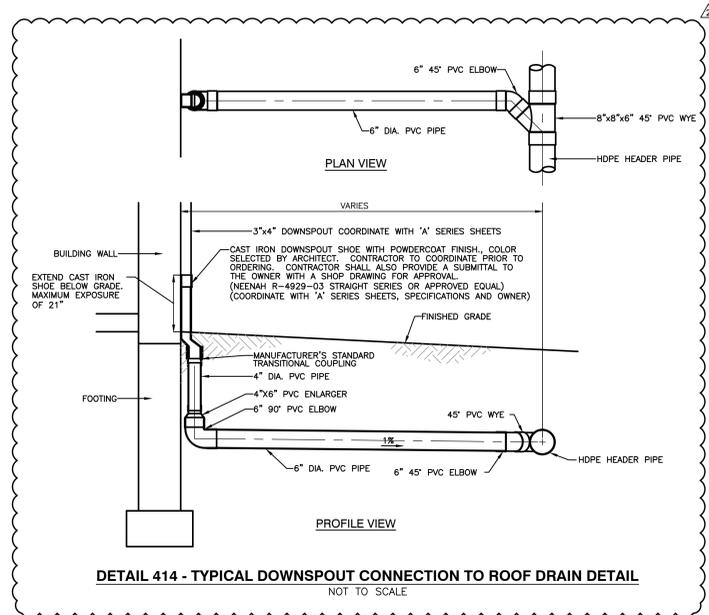

DETAIL 414 - TYPICAL DOWNSPOUT CONNECTION TO ROOF DRAIN DETAIL
NOT TO SCALE

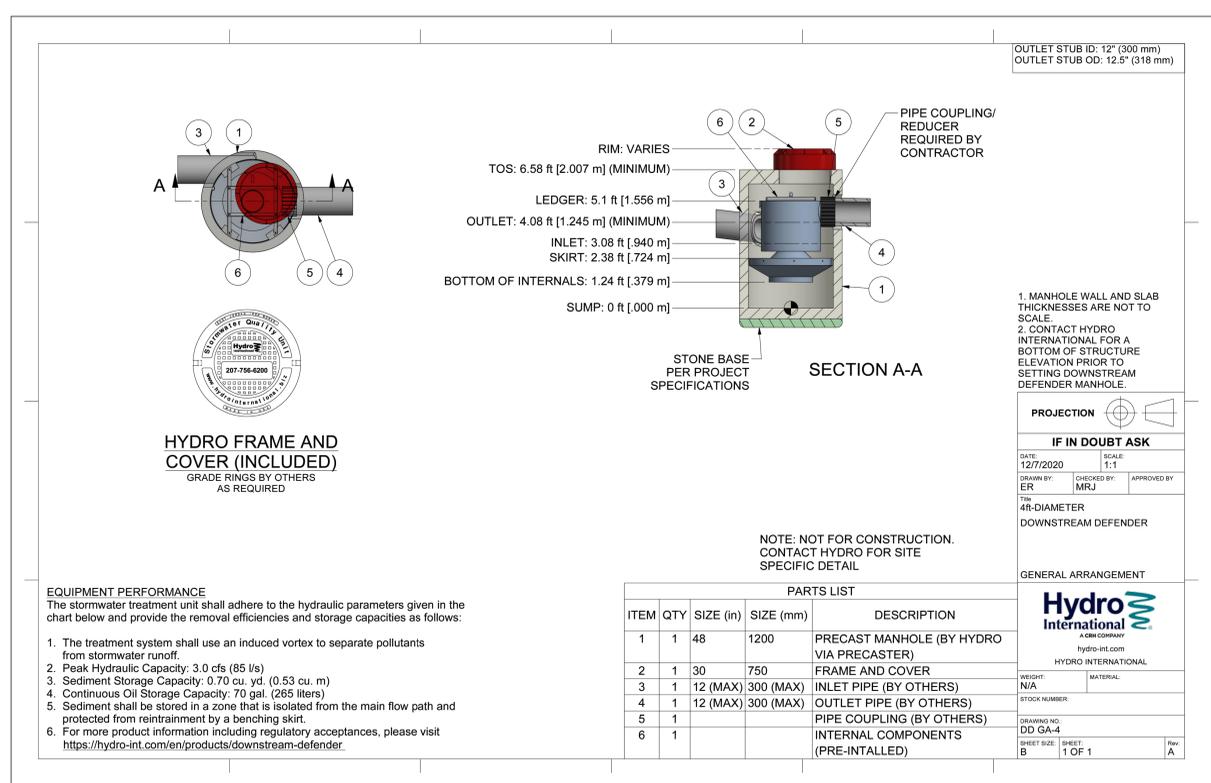

DETAIL 412 - WATER QUALITY UNITS - FIRST DEFENSE OPTIMUM
NOT TO SCALE

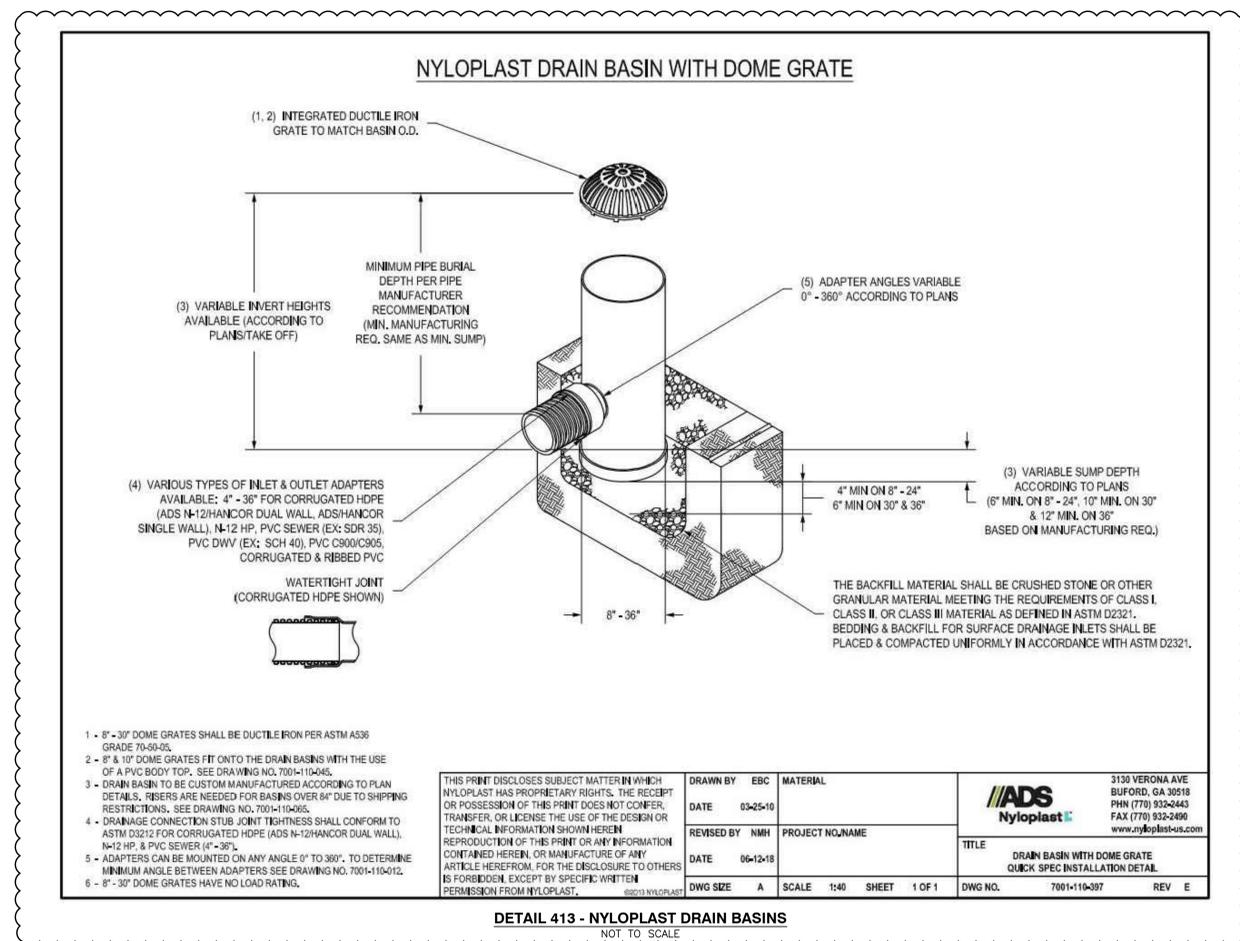

DETAIL 413 - NYLOPLAST DRAIN BASINS
NOT TO SCALE

NOTE:
CONTRACTOR SHALL REFER TO THE CITY OF COLUMBUS STANDARD DETAILS AND SPECIFICATIONS WITHIN THIS CONSTRUCTION SET FOR OTHER DETAILS AND PERTINENT INFORMATION. IT IS NOT THE ENGINEER'S INTENT THAT THE C800 SERIES OF DRAWINGS FULLY DEPICTS ALL SITE DETAILS ASSOCIATED WITH THE PROJECT. FOR ANY DISCREPANCIES BETWEEN DETAIL SETS, THE COLUMBUS STANDARD DETAILS SHALL SUPERSEDE OVER THE C800 SERIES OF DETAILS.



CSO
8831 Keystone Crossing, Indianapolis, IN 46240
317.846.7800 | csocinc.com

CEE
Civil & Environmental Consultants, Inc.
530 E. Ohio Street, Suite G - Indianapolis, IN 46204
317-465-7777 - 877-746-0749
www.ceeinc.com

BARTHOLOMEW CONSOLIDATED SCHOOL CORPORATIONS TO RENOVATIONS TO L. C. SCHMITT ELEMENTARY
2875 CALIFORNIA STREET, COLUMBUS, IN 47201

SCOPE DRAWINGS:
These drawings indicate the general scope of the project in terms of professional design services, the development of structural, mechanical and electrical systems. The drawings do not necessarily include or describe all work required for the performance and completion of the project. The contractor shall verify the scope indicated on drawings. The contractor shall furnish all items required for the proper installation and completion of the work.

REVISIONS:
03/08/2024 - ADDENDUM #01
03/15/2024 - ADDENDUM #02

ISSUE DATE	DRAWN BY	CHECKED BY
02/16/2024	RT	JP

DRAWING TITLE:
PLAN DETAILS


CERTIFIED BY:
LOW THAM M. PAUY
REGISTERED PROFESSIONAL ENGINEER
STATE OF INDIANA
02/16/24

DRAWING NUMBER
C801

PROJECT NUMBER
2021049



NORTH

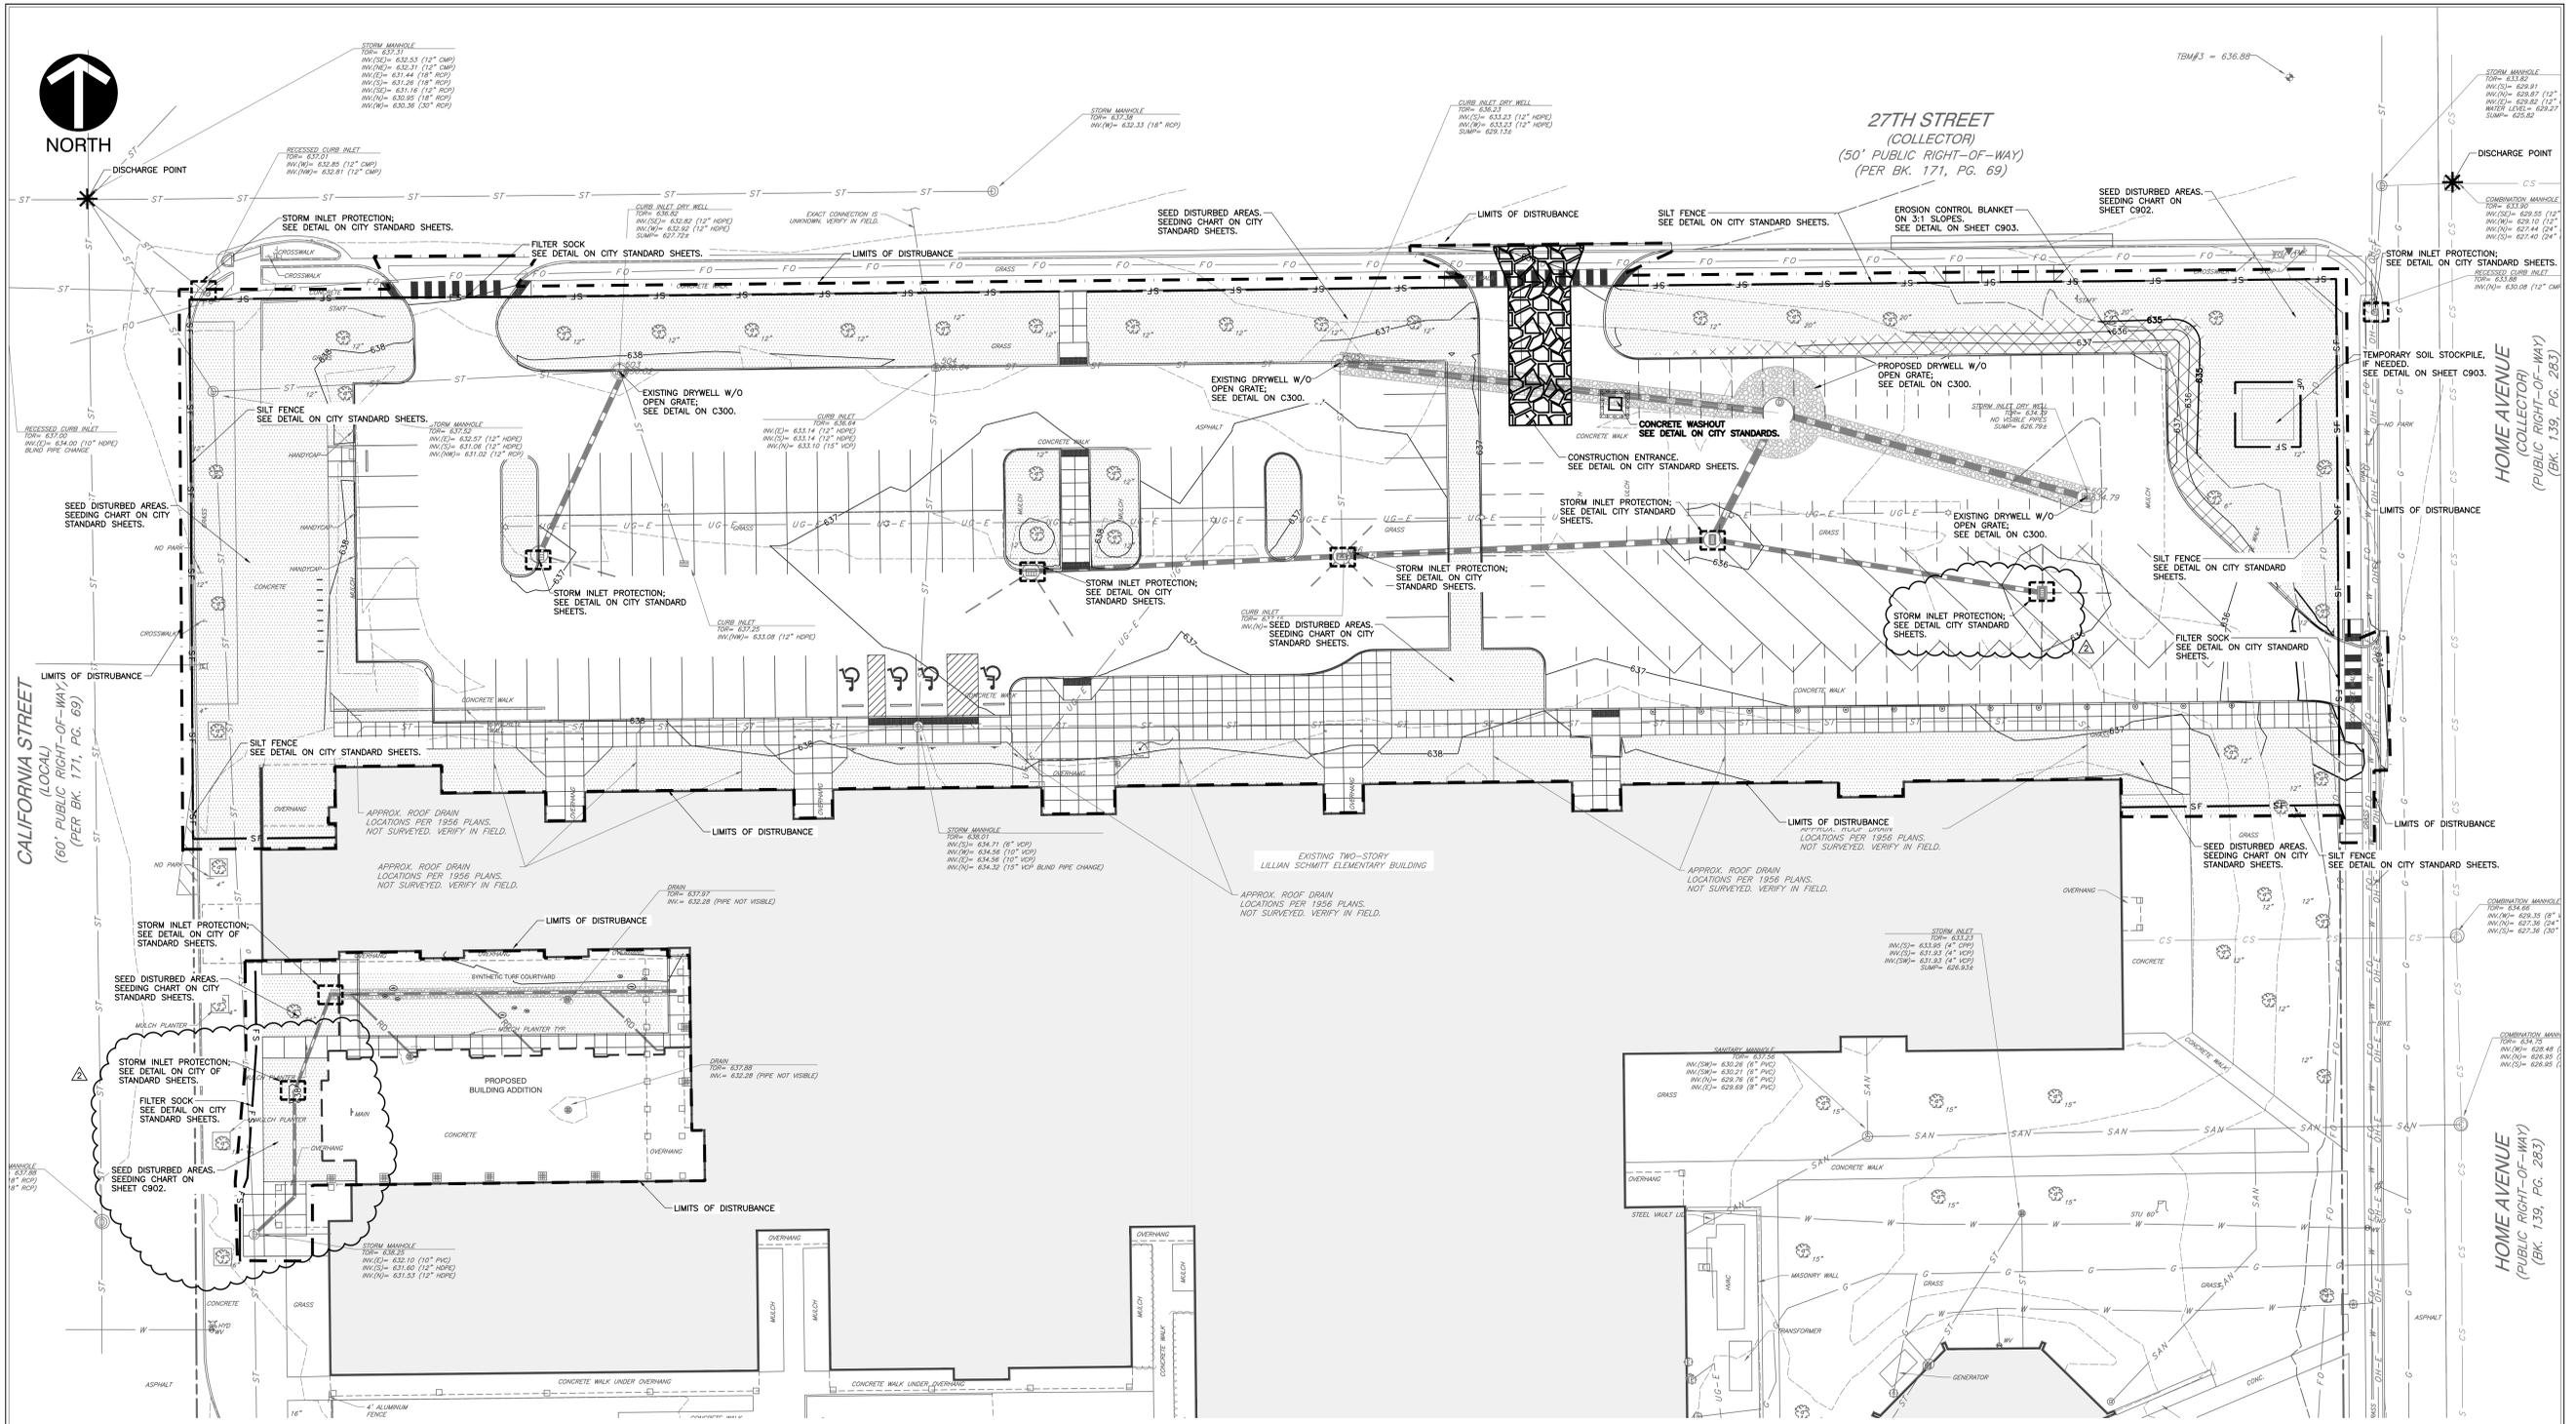

GENERAL EROSION CONTROL NOTES

- CONTRACTOR SHALL INSTALL ALL REQUIRED SILT FENCES, SILT TRAPS, TREE PROTECTION AND INLET PROTECTION FOR EXISTING INLETS PRIOR TO THE START OF ANY EARTH MOVING OR STRIPPING.
- CONTRACTOR SHALL INSTALL A STONE CONSTRUCTION ENTRANCE OR SOME OTHER DEVICE PRIOR TO THE START OF EARTHWORK AS NECESSARY TO PREVENT SOIL FROM BEING TRACKED OR WASHED INTO EXISTING ROADWAYS.
- LAND ALTERATIONS WHICH STRIP THE LAND OF VEGETATION, INCLUDING REGRADING, SHALL BE DONE IN A WAY THAT WILL MINIMIZE EROSION. WHENEVER FEASIBLE, NATURAL VEGETATION SHALL BE RETAINED AND PROTECTED. AS GRADING IS DONE, INSTALL SILT TRAPS, SILT FENCES, SLOPE DRAINS, TEMPORARY DIVERSIONS AND OTHER RUNOFF CONTROL MEASURES AT APPROPRIATE LOCATIONS TO KEEP SEDIMENT CONTAINED ON SITE.
- ALL DISTURBED AREAS SHALL BE SEEDED AND STRAW MULCHED AS SHOWN ON THE PLANS IMMEDIATELY AFTER COMPLETION OF GROUND ACTIVITY. FOR LARGE PROJECTS, THIS SEEDED SHOULD BE COMPLETED IN PHASES AS THE DIFFERENT AREAS OF THE SITE ARE COMPLETED.
- PERMANENT AND FINAL VEGETATION OR STRUCTURAL EROSION CONTROL DEVICES SHALL BE INSTALLED AS SOON AS PRACTICAL UNDER THE CIRCUMSTANCES.
- THE DURATION OF TIME WHICH AN AREA REMAINS EXPOSED SHALL BE KEPT TO A PRACTICAL MINIMUM DEPENDING UPON THE WEATHER. IF CONSTRUCTION ACTIVITY IS TO CEASE FOR MORE THAN 7 DAYS, THE DISTURBED AREAS SHALL BE TEMPORARILY SEEDED.
- ALL STORM SEWER INLET PROTECTION DEVICES SHALL BE PUT IN PLACE AT THE TIME EACH INLET IS CONSTRUCTED.
- THE CONTRACTOR SHALL MAINTAIN EROSION CONTROL MEASURES AND DEVICES DURING CONSTRUCTION AND UNTIL SILTATION OF THE STREETS AND STORM SEWERS WILL NO LONGER OCCUR.
- ONCE ON-SITE EROSION AND SILTATION OF THE STREETS AND STORM SEWERS WILL NO LONGER OCCUR, THE CONTRACTOR SHALL REMOVE AND DISPOSE OF THE TEMPORARY EROSION CONTROL DEVICES.
- THESE GENERAL PROCEDURES MAY NOT COVER ALL SITUATIONS. REFER TO EROSION CONTROL PLANS FOR SPECIFIC NOTES AND ADDITIONAL DETAILS.
- EROSION CONTROL TO COMPLY WITH IDEM CONSTRUCTION STORMWATER GENERAL PERMIT.
- ALL PROPOSED EROSION AND SEDIMENT CONTROL SHALL BE IN CONFORMANCE WITH THE CITY OF COLUMBUS TYPICAL CONSTRUCTION GUIDELINES. DISCREPANCIES BETWEEN THE PLANS AND THE MANUAL SHALL NOT ALLEVIATE THE CONTRACTOR FROM ADHERING TO THE REQUIREMENTS AS SET FORTH IN THE MANUAL.
- ADDITIONAL EROSION CONTROL MEASURES MAY BE REQUIRED IN THE FIELD BY THE INSPECTOR.
- A PRE-CONSTRUCTION MEETING IS REQUIRED PRIOR TO CONSTRUCTION. CONTACT THE CITY OF COLUMBUS ENGINEERING DEPARTMENT TO SCHEDULE. (812) 376-2540.

FLOOD NOTE:

THE PARCEL DESCRIBED AND SHOWN HEREIN LIES WITHIN ZONE "X" (UN-SHADED) AS SAID PARCEL PLOTS ON MAP NUMBER 18005C0131E (DATED DECEMBER 9, 2014) OF THE FLOOD INSURANCE RATE MAPS FOR THE CITY OF COLUMBUS, BARTHOLOMEW COUNTY, INDIANA. THE ACCURACY OF THIS FLOOD HAZARD STATEMENT IS SUBJECT TO MAP SCALE UNCERTAINTY AND TO ANY OTHER UNCERTAINTY IN LOCATION OR ELEVATION ON THE REFERENCED FLOOD INSURANCE RATE MAP.

BENCHMARKS:

- UNLESS OTHERWISE NOTED, ELEVATIONS SHOWN HEREON ARE BASED UPON AN OPUS SOLUTION AND ARE ON THE 1988 NORTH AMERICAN VERTICAL DATUM (NAVD88) (GEOD 18). IT IS MY OPINION THAT THE UNCERTAINTY IN THE ELEVATION OF THE PROJECT BENCHMARK DOES NOT EXCEED 0.10 FOOT.
- TM#1: SET MAGNOL ON TOP OF A LIGHT BASE LOCATED APPROXIMATELY 140 FEET SOUTH OF THE SOUTHWEST CORNER OF THE SITE. ELEV. = 639.79
 - TM#2: NORTHEAST BOLT ON TOP OF A FIRE HYDRANT LOCATED IN THE SOUTHWEST QUADRANT OF THE INTERSECTION OF CALIFORNIA ST. AND 27TH ST. ELEV. = 639.31
 - TM#3: SOUTHWEST BOLT ON TOP OF A FIRE HYDRANT LOCATED IN THE NORTHWEST QUADRANT OF THE INTERSECTION OF HOME AVE. AND 27TH ST. ELEV. = 636.88
 - TM#4: NORTHEAST BOLT ON TOP OF A FIRE HYDRANT LOCATED AT THE SOUTHEAST CORNER OF THE SITE. ELEV. = 636.48

UTILITY NOTE:

THE UNDERGROUND UTILITIES SHOWN HAVE BEEN LOCATED FROM FIELD SURVEY INFORMATION AND EXISTING DRAWINGS. THE SURVEYOR MAKES NO GUARANTEE THAT THE UNDERGROUND UTILITIES COMPRISE ALL SUCH UTILITIES IN THE AREA, EITHER IN-SERVICE OR ABANDONED. THE SURVEYOR FURTHER DOES NOT WARRANT THAT THE UNDERGROUND UTILITIES SHOWN ARE IN THE EXACT LOCATION INDICATED ALTHOUGH THE SURVEYOR DOES CERTIFY THAT THEY ARE LOCATED AS ACCURATELY AS POSSIBLE FROM INFORMATION AVAILABLE. THE SURVEYOR HAS NOT PHYSICALLY LOCATED THE UNDERGROUND UTILITIES. INDIANA 811 ONE-CALL PUBLIC UTILITY LOCATE SERVICE TICKET NUMBER 2310171909 WAS ISSUED FOR THIS SITE. AMERICAN LOCATING SERVICES, A PRIVATE SURFACE UTILITY LOCATING SERVICE, WAS CONTRACTED TO PERFORM THE PRIVATE UTILITY LOCATIONS FOR THE SUBJECT SITE. THE PRIVATE UTILITIES LOCATED AND DEPICTED HEREIN WERE EITHER OBSERVED FROM MARKINGS ON THE GROUND OR USING EXISTING PLANS PROVIDED BY THE SCHOOL.

PRIOR TO ANY EXCAVATION FOR UNDERGROUND UTILITIES, THE CONTRACTOR SHALL EXPOSE AND VERIFY LOCATIONS (HORIZONTAL AND VERTICAL) OF ALL EXISTING UTILITIES INCLUDING BUT NOT LIMITED TO GAS, WATER, AND SANITARY SEWER. ANY CONFLICTS SHALL BE REPORTED IMMEDIATELY TO THE ENGINEER AND THE APPROPRIATE AUTHORITIES.

PROPOSED LEGEND:

- PROPOSED GRAVEL CONSTRUCTION ENTRANCE
- PERMANENT/ TEMPORARY SEEDED AREAS
- EROSION CONTROL BLANKET W/ GRASS SEED
- PROPOSED LIMITS OF DISTURBANCE
- PROPOSED SILT FENCE
- PROPOSED FILTER SOCK
- PROPOSED INLET PROTECTION
- PROPOSED CONCRETE WASHOUT
- MAJOR STORMWATER DISCHARGE POINT



SOIL MAP

SOIL MAPS FROM THE UNITED STATES DEPARTMENT OF AGRICULTURE, SOIL CONSERVATION SERVICE

SOIL LEGEND

UtiqA - Urban land-Nineveh complex, 0 to 2 Percent Slopes; Well drained
 * IF CONSTRUCTION IS TAKING PLACE DURING WET SEASON, SOILS MAY REQUIRE LIME STABILIZATION

NOTE:

NO EARTH DISTURBING ACTIVITY MAY COMMENCE WITHOUT AN APPROVED STORMWATER MANAGEMENT PERMIT.



CSO
 8831 Keystone Crossing, Indianapolis, IN 46240
 317.846.7800 | csoinc.net

CEE
 Civil & Environmental Consultants, Inc.
 530 E. Ohio Street, Suite G - Indianapolis, IN 46204
 317.465.7777 - 877.746.0749
 www.ceeinc.com

BARTHOLOMEW CONSOLIDATED SCHOOL CORPORATION RENOVATIONS TO L. C. SCHMITT ELEMENTARY
 2875 CALIFORNIA STREET, COLUMBUS, IN 47201

SCOPE DRAWINGS:
 These drawings include the general scope of the project in terms of architectural design concept, the development of structural, mechanical and electrical systems. The drawings are not necessarily indicative or descriptive of work required for the performance and completion of the project. On the basis of the general scope indicated on these drawings, the contractor shall furnish all items required for the proper execution and completion of the work.

REVISIONS:
 03/08/2024 - ADDENDUM #01
 03/15/2024 - ADDENDUM #02


ISSUE DATE DRAWN BY CHECKED BY
 02/16/2024 RT JP

DRAWING TITLE:
STORMWATER POLLUTION PREVENTION PLAN

CERTIFIED BY:


DRAWING NUMBER
C900
 PROJECT NUMBER
 2021049



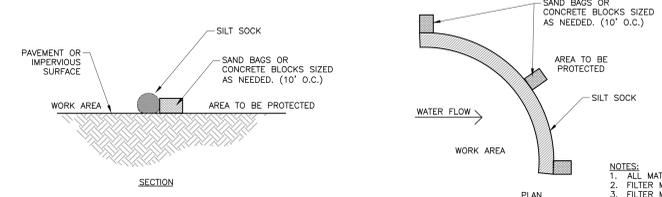


DETAIL 901 - SILT SOCK ON PAVEMENT
(SILT SOCK OR APPROVED EQUAL)
NOT TO SCALE

- NOTES:**
1. ALL MATERIAL TO MEET SPECIFICATIONS.
 2. FILTER MEDIA TO MEET APPLICATION REQUIREMENTS.
 3. FILTER MEDIA TO BE DISPERSED ON SITE, AS DETERMINED BY ENGINEER.

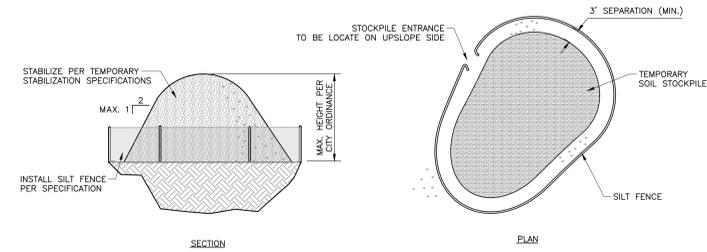

DETAIL 902 - TEMPORARY SOIL STOCKPILE DETAIL
NOT TO SCALE

- NOTES:**
1. ALL MATERIAL TO MEET SPECIFICATIONS.
 2. SEE PLAN VIEW FOR STOCKPILE LOCATION AND TYPE OF STOCKPILE PROTECTION.
 3. INSTALL SILT FENCE IN ACCORDANCE WITH DETAIL. SEE SILT FENCE DETAIL ON CITY STANDARD SHEETS.
 4. STABILIZE THE STOCKPILE SURFACE WITH SURFACE ROUGHING, TEMPORARY SEEDING AND MULCHING, EROSION CONTROL BLANKET OR SOIL BINDERS.

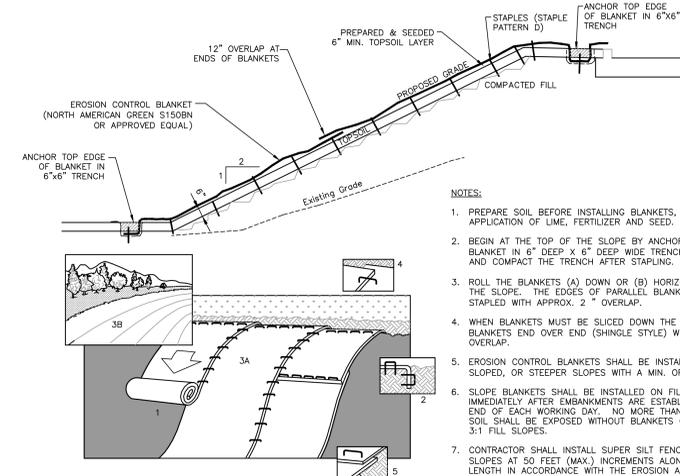


DETAIL 903 - SLOPE BLANKET INSTALLATION
NOT TO SCALE

- NOTES:**
1. PREPARE SOIL BEFORE INSTALLING BLANKETS, INCLUDING APPLICATION OF LIME, FERTILIZER AND SEED.
 2. BEGIN AT THE TOP OF THE SLOPE BY ANCHORING THE BLANKET IN 6\"/>

NOTE:
CONTRACTOR SHALL REFER TO THE CITY OF COLUMBUS STANDARD DETAILS AND SPECIFICATIONS WITHIN THIS CONSTRUCTION SET FOR OTHER SWPPP DETAILS AND PERTINENT INFORMATION. IT IS NOT THE ENGINEER'S INTENT THAT THE C903 DRAWING FULLY DEPICTS ALL SITE DETAILS ASSOCIATED WITH THE PROJECT. FOR ANY DISCREPANCIES BETWEEN DETAIL SETS, THE COLUMBUS STANDARD DETAILS SHALL SUPERSIDE OVER THE C900 SERIES OF DETAILS.



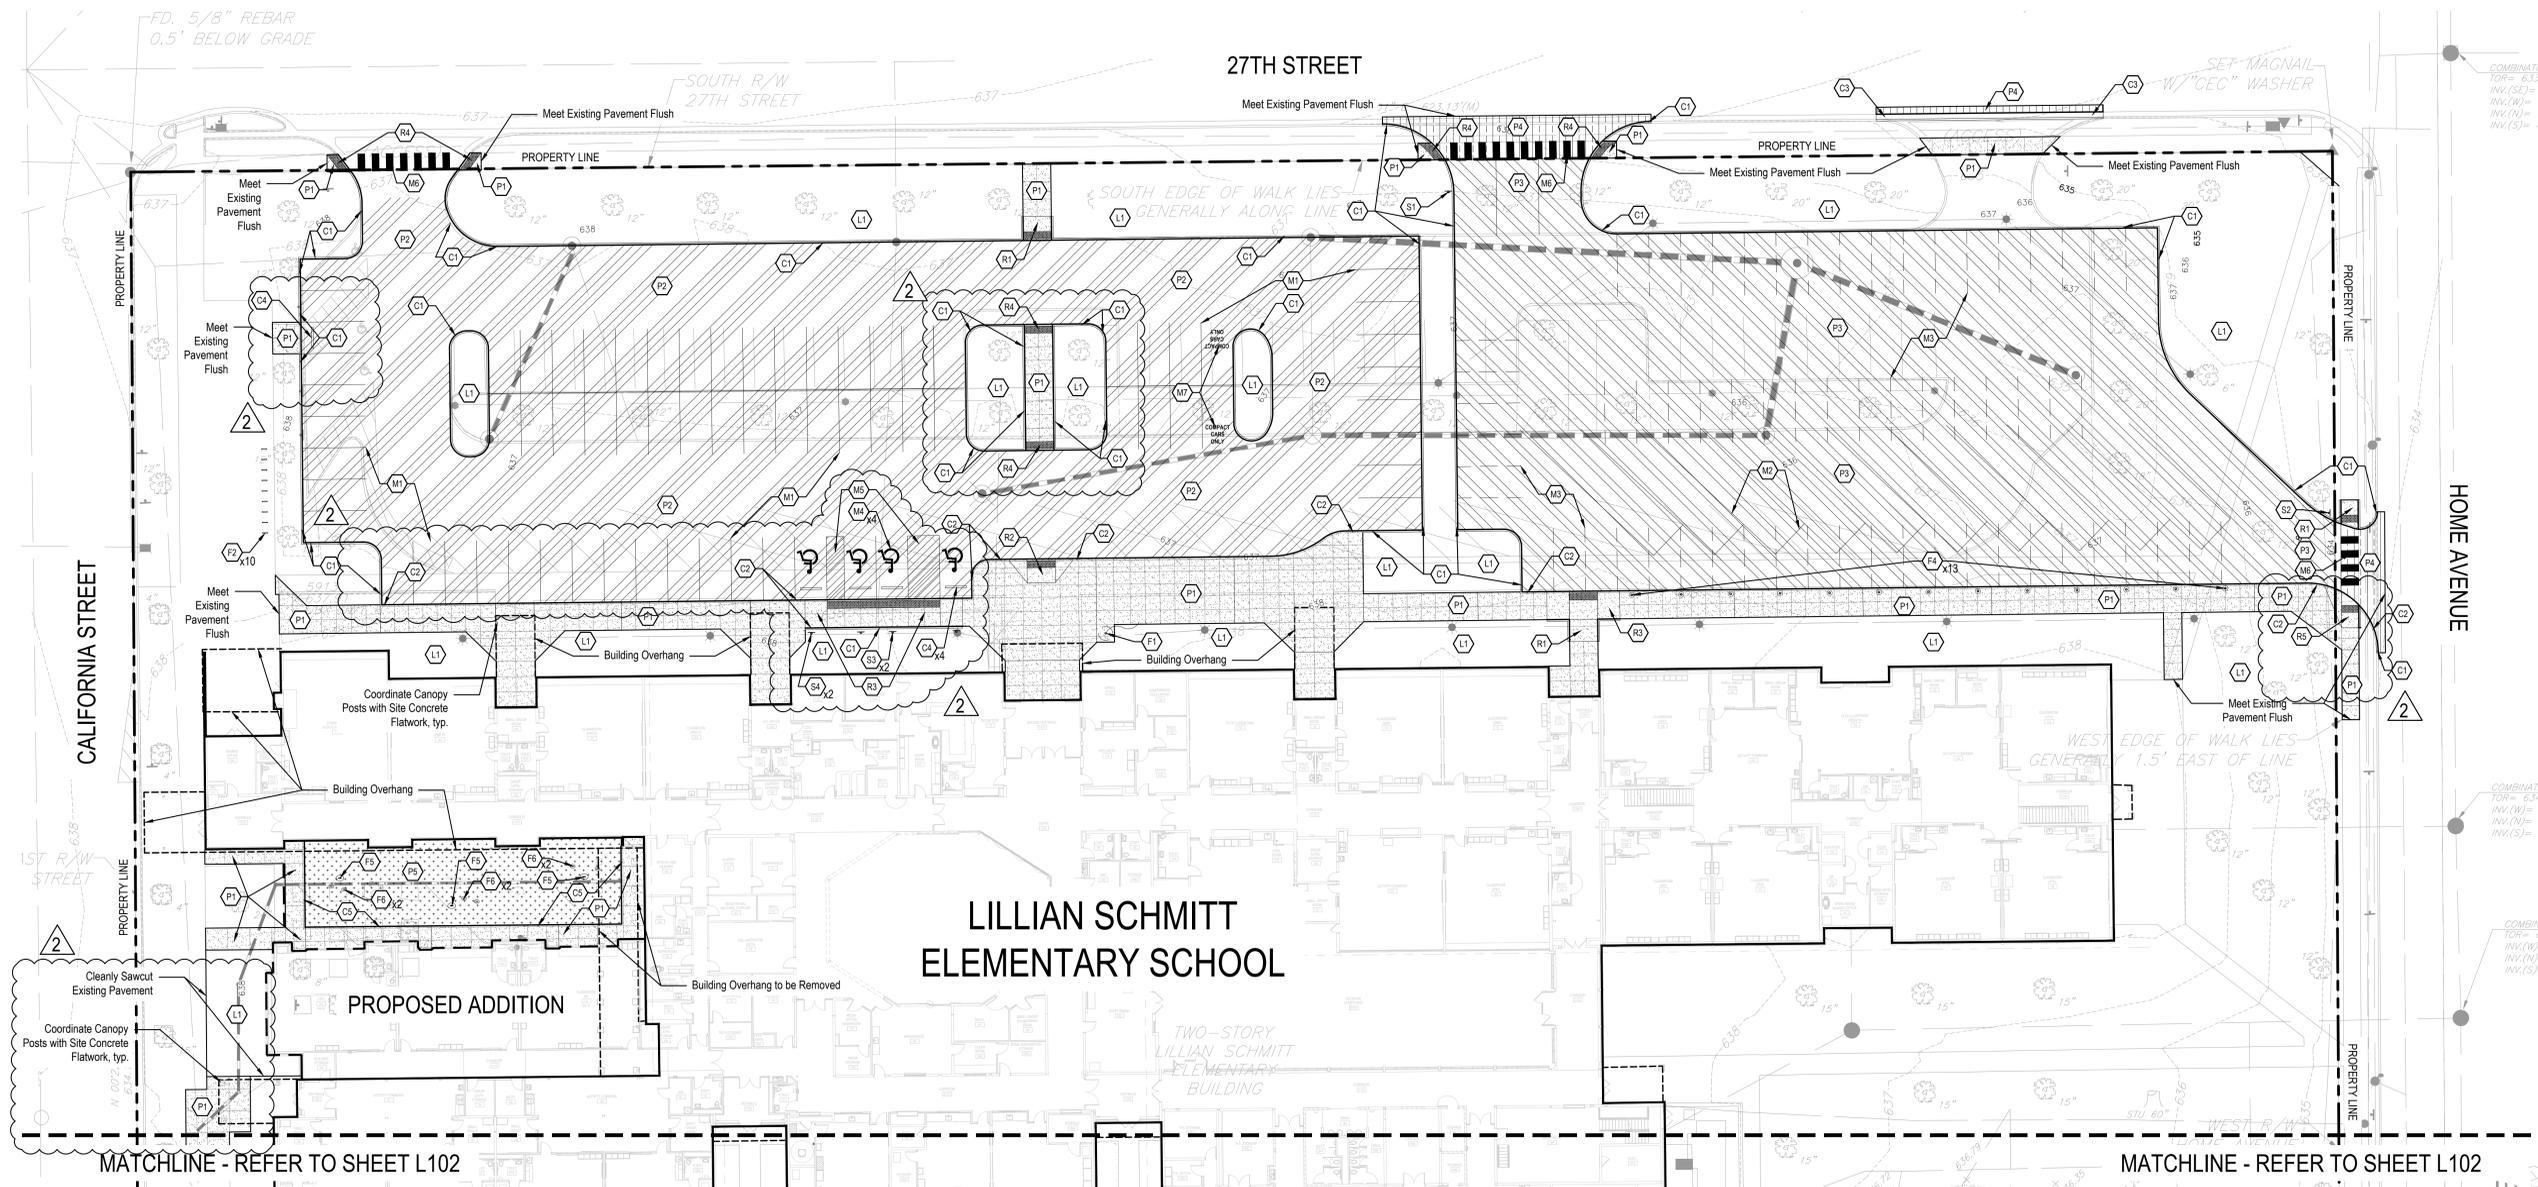

KEY	DESCRIPTION / REFERENCE
C1	POST CURB, REFER TO DETAIL 6/L600
C2	INTEGRAL CURB AND SIDEWALK, REFER TO DETAIL 7/L600
C3	CURB, ROLL, REFER TO DETAIL 16/L600
C4	WHEEL STOP, REFER TO DETAIL 8/L600
C5	INTEGRAL CURB AND SIDEWALK AT SYNTHETIC PLAYGROUND TURF, REFER TO DETAIL 7/L601

KEY	DESCRIPTION / REFERENCE
F1	FLAG POLE, REFER TO DETAIL 15/L600
F2	BICYCLE RACK, REFER TO DETAIL 5/L601
F3	BARRIER GATE, 22'-0" WIDTH, REFER TO SPECIFICATION 32 33 00
F4	STEEL PIPE BOLLARD, 6", REFER TO DETAIL 14/L600
F5	MAYA LIN LARGE STONE
F6	MAYA LIN SMALL STONE

KEY	DESCRIPTION / REFERENCE
L1	PLANTING AREA, REFER TO L300 SERIES SHEETS

KEY	DESCRIPTION / REFERENCE
P1	STANDARD DUTY CONCRETE, REFER TO DETAILS 1-2/L600

KEY	DESCRIPTION / REFERENCE
P2	STANDARD DUTY ASPHALT, REFER TO DETAIL 4/L600
P3	HEAVY DUTY ASPHALT, REFER TO DETAIL 5/L600
P4	RIGHT OF WAY ASPHALT, REFER TO CIVIL DRAWINGS


KEY	DESCRIPTION / REFERENCE
P5	SYNTHETIC PLAYGROUND TURF, REFER TO DETAIL 6/L601

KEY	DESCRIPTION / REFERENCE
R1	STRAIGHT RAMP, REFER TO DETAIL 2/L601
R2	DOUBLE WING RAMP, REFER TO DETAIL 1/L601
R3	PARALLEL CURB RAMP, REFER TO DETAIL 3/L601
R4	TRUNCATED DOME WARNING SURFACE, REFER TO DETAIL 4/L601
R5	SINGLE WING RAMP, REFER TO DETAIL 9/L601

R6	SINGLE WING RAMP, REFER TO DETAIL 9/L601
----	--

KEY	DESCRIPTION / REFERENCE
S1	SIGNAGE (COMPLY WITH MUTCD STANDARDS) VIF REGULATORY SIGNS WITH CITY REPRESENTATIVE
S2	BUS LOT EVENT PARKING ONLY, REFER TO DETAIL 11/L600
S3	DO NOT ENTER, REFER TO DETAIL 11/L600
S4	VAN ACCESSIBLE ADA PARKING, REFER TO DETAIL 10/L600
S5	ACCESSIBLE ADA PARKING, REFER TO DETAIL 10/L600

KEY	DESCRIPTION / REFERENCE
M1	VEHICULAR STRIPING, WHITE, REFER TO DETAIL 12/L600 AND SPECIFICATIONS
M2	BUS STRIPING, WHITE, REFER SPECIFICATIONS
M3	EVENT VEHICULAR STRIPING, DASHED WHITE, REFER TO DETAIL 12/L600 AND SPECIFICATIONS
M4	ADA PARKING SYMBOL, BLUE, REFER TO DETAIL 9/L600 AND SPECIFICATIONS
M5	ADA PARKING STRIPING, BLUE, REFER TO DETAIL 12/L600 AND SPECIFICATIONS
M6	CROSSWALK STRIPING, WHITE, REFER TO DETAIL 13/L600 AND SPECIFICATIONS

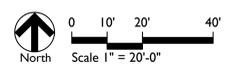

SCOPE DRAWINGS:
These drawings indicate the general scope of the project in terms of architectural design concepts, the structure of the building, mechanical and electrical systems.
The drawings do not necessarily indicate or describe all work required for the administration and completion of the project.
On the basis of the general scope included or described, the contractor shall furnish all items required for the proper execution and completion of the work.

REVISIONS:	ADDENDUM	DATE
▲	Addendum 01	03/08/2024
▲	Addendum 02	03/15/2024


ISSUE DATE	DRAWN BY	CHECKED BY
02/16/2024	MA	LM

DRAWING TITLE:
**MATERIALS
PLAN**

CERTIFIED BY:
ALYSSA P. PRAZUO
REGISTERED
No. 2020-0132
STATE OF INDIANA
LANDSCAPE ARCHITECT
EXPIRES 12-31-2025

DRAWING NUMBER
L102

PROJECT NUMBER
2021049

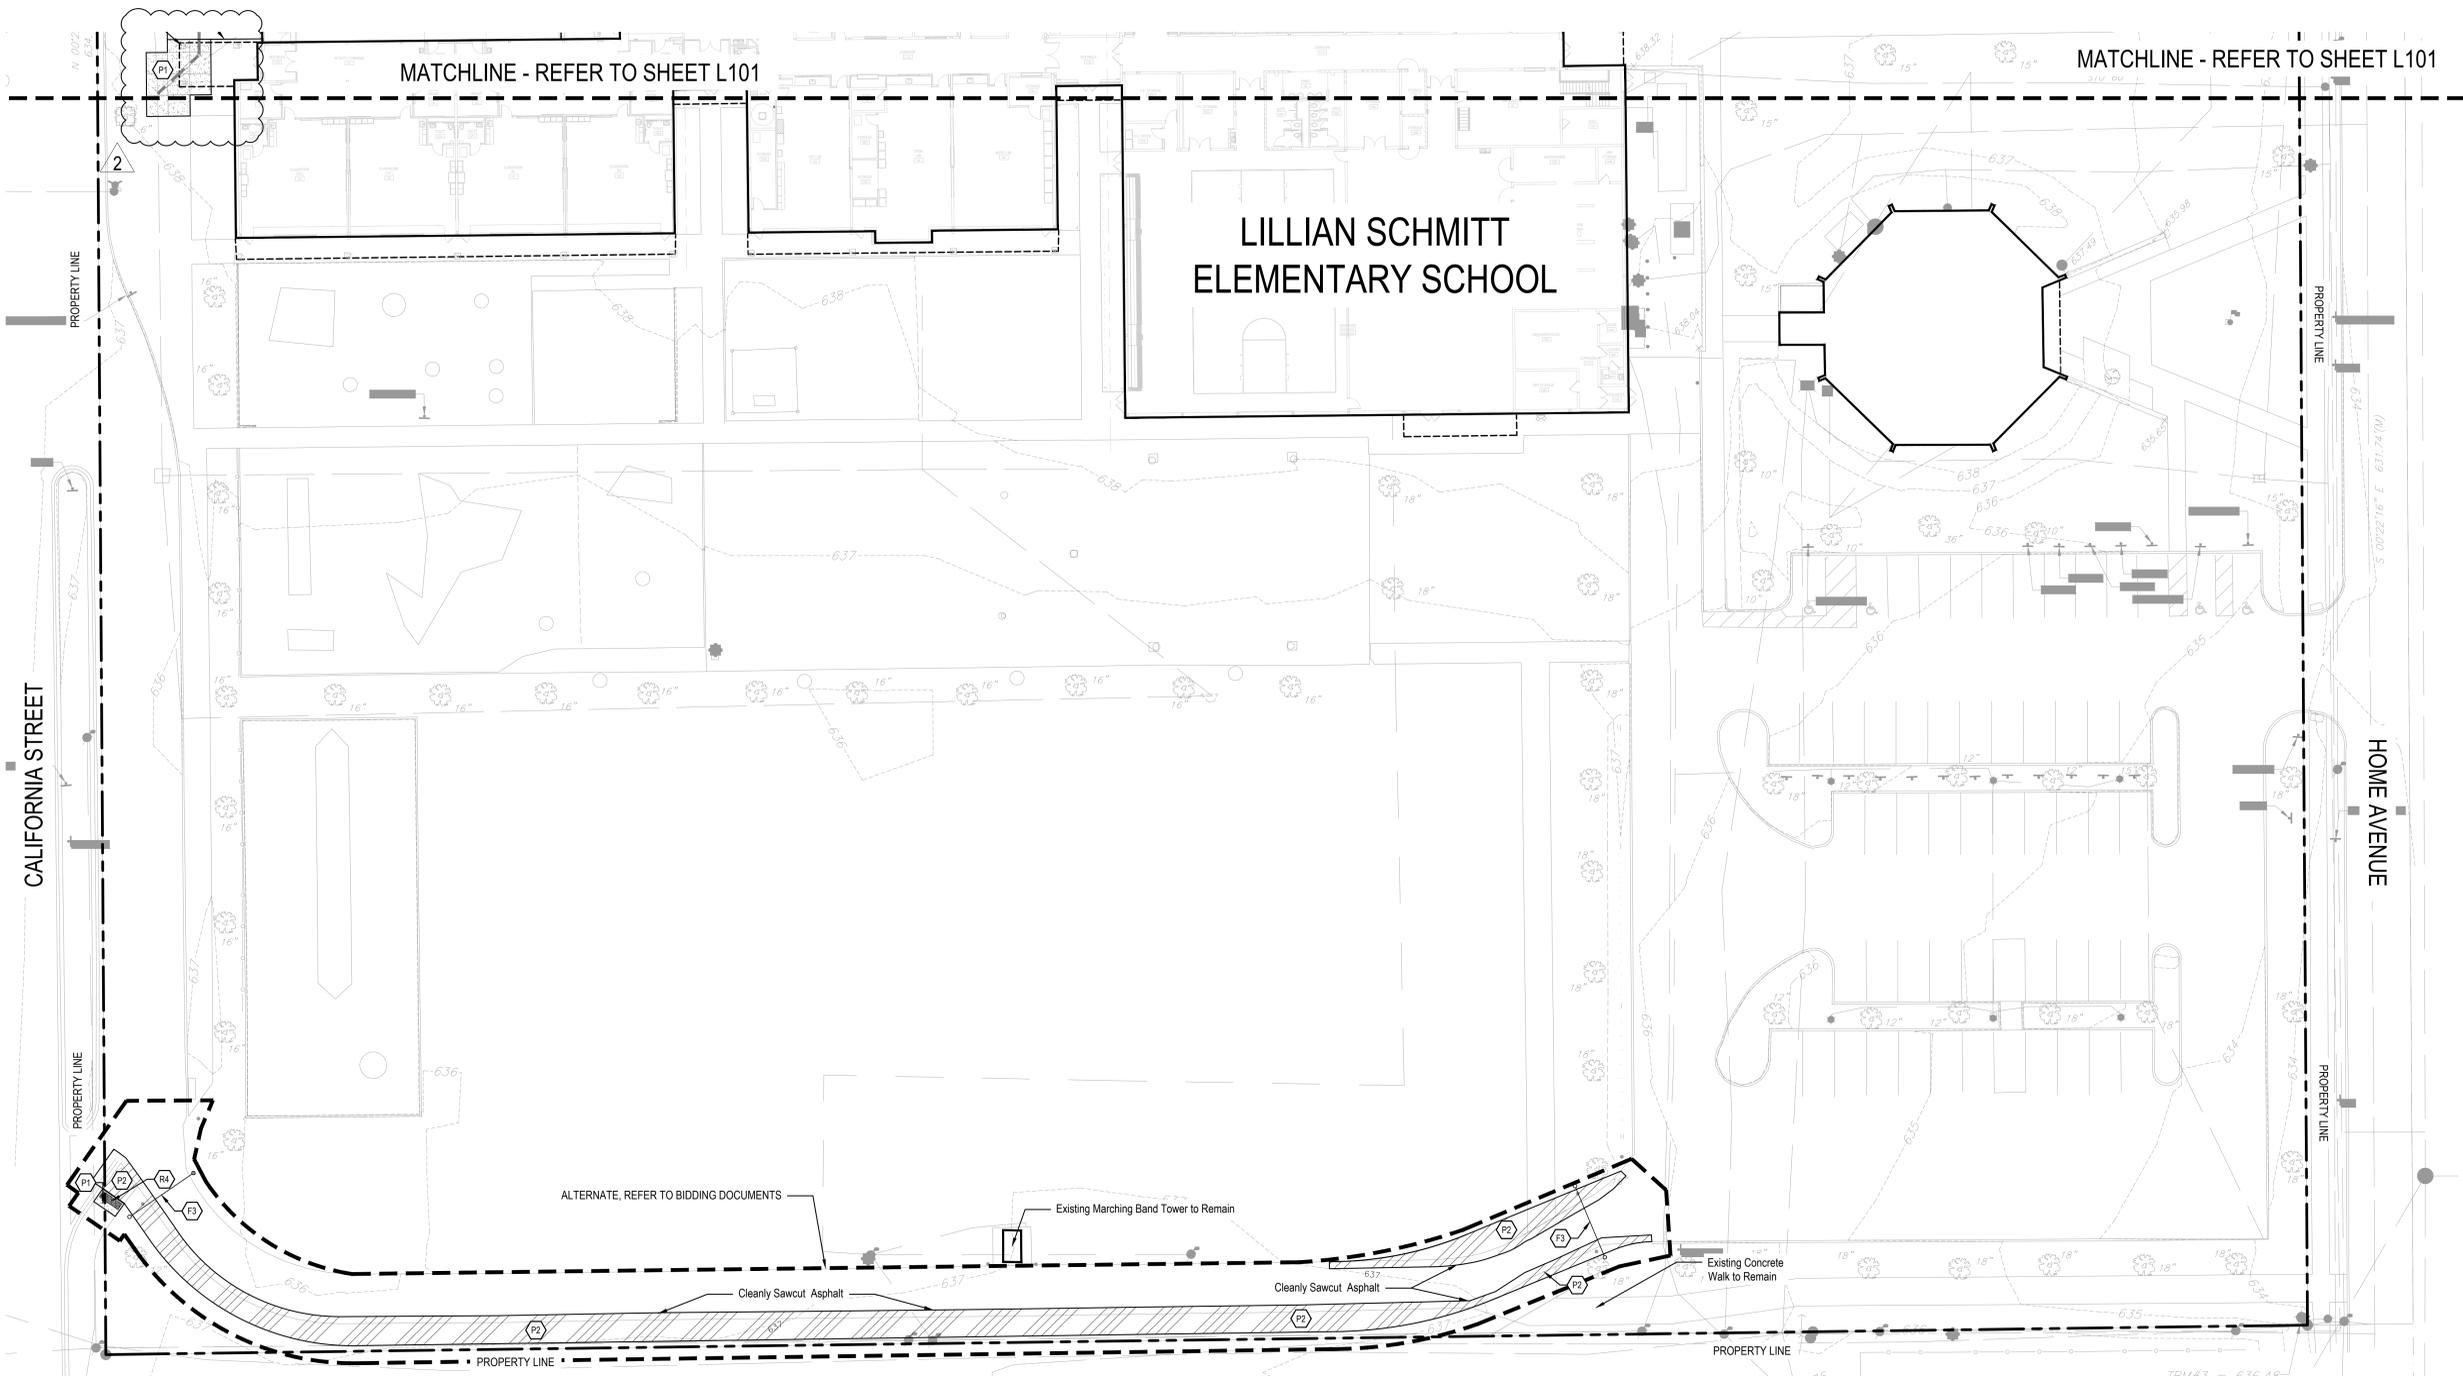



KEY	DESCRIPTION / REFERENCE
C1	POST CURB, REFER TO DETAIL 6/L600
C2	INTEGRAL CURB AND SIDEWALK, REFER TO DETAIL 7/L600
C3	CURB, ROLL, REFER TO DETAIL 16/L600
C4	WHEEL STOP, REFER TO DETAIL 8/L600
C5	INTEGRAL CURB AND SIDEWALK AT SYNTHETIC PLAYGROUND TURF, REFER TO DETAIL 7/L601
SITE FURNISHINGS	
KEY	DESCRIPTION / REFERENCE
F1	FLAG POLE, REFER TO DETAIL 15/L600
F2	BICYCLE RACK, REFER TO DETAIL 5/L601
F3	BARRIER GATE, 22'-0" WIDTH, REFER TO SPECIFICATION 32.33.00
F4	STEEL PIPE BOLLARD, 6", REFER TO DETAIL 14/L600
F5	MAYA LIN LARGE STONE
F6	MAYA LIN SMALL STONE

KEY	DESCRIPTION / REFERENCE
L1	PLANTING AREA, REFER TO L300 SERIES SHEETS
PAVEMENT, CONCRETE	
KEY	DESCRIPTION / REFERENCE
P1	STANDARD DUTY CONCRETE, REFER TO DETAILS 1-2/L600
PAVEMENT, ASPHALT	
KEY	DESCRIPTION / REFERENCE
P2	STANDARD DUTY ASPHALT, REFER TO DETAIL 4/L600
P3	HEAVY DUTY ASPHALT, REFER TO DETAIL 5/L600
P4	RIGHT OF WAY ASPHALT, REFER TO CIVIL DRAWINGS
PAVEMENT, SYNTHETIC TURF	
KEY	DESCRIPTION / REFERENCE
P5	SYNTHETIC PLAYGROUND TURF, REFER TO DETAIL 6/L601

KEY	DESCRIPTION / REFERENCE
R1	STRAIGHT RAMP, REFER TO DETAIL 2/L601
R2	DOUBLE WING RAMP, REFER TO DETAIL 1/L601
R3	PARALLEL CURB RAMP, REFER TO DETAIL 3/L601
R4	TRUNCATED DOME WARNING SURFACE, REFER TO DETAIL 4/L601
R5	SINGLE WING RAMP, REFER TO DETAIL 9/L601
SIGNAGE (COMPLY WITH MUTCD STANDARDS)(VIF REGULATORY SIGNS WITH CITY REPRESENTATIVE)	
KEY	DESCRIPTION / REFERENCE
S1	BUS LOT EVENT PARKING ONLY, REFER TO DETAIL 11/L600
S2	DO NOT ENTER, REFER TO DETAIL 11/L600
S3	VAN ACCESSIBLE ADA PARKING, REFER TO DETAIL 10/L600


KEY	DESCRIPTION / REFERENCE
M1	VEHICULAR STRIPING, WHITE, REFER TO DETAIL 12/L600 AND SPECIFICATIONS
M2	BUS STRIPING, WHITE, REFER SPECIFICATIONS
M3	EVENT VEHICULAR STRIPING, DASHED WHITE, REFER TO DETAIL 12/L600 AND SPECIFICATIONS
M4	ADA PARKING SYMBOL, BLUE, REFER TO DETAIL 9/L600 AND SPECIFICATIONS
M5	ADA PARKING STRIPING, BLUE, REFER TO DETAIL 12/L600 AND SPECIFICATIONS
M6	CROSSWALK STRIPING, WHITE, REFER TO DETAIL 13/L600 AND SPECIFICATIONS
M7	COMPACT SAND ONLY MARKING, WHITE, REFER TO DETAIL 13/L600 AND SPECIFICATIONS

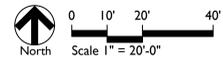


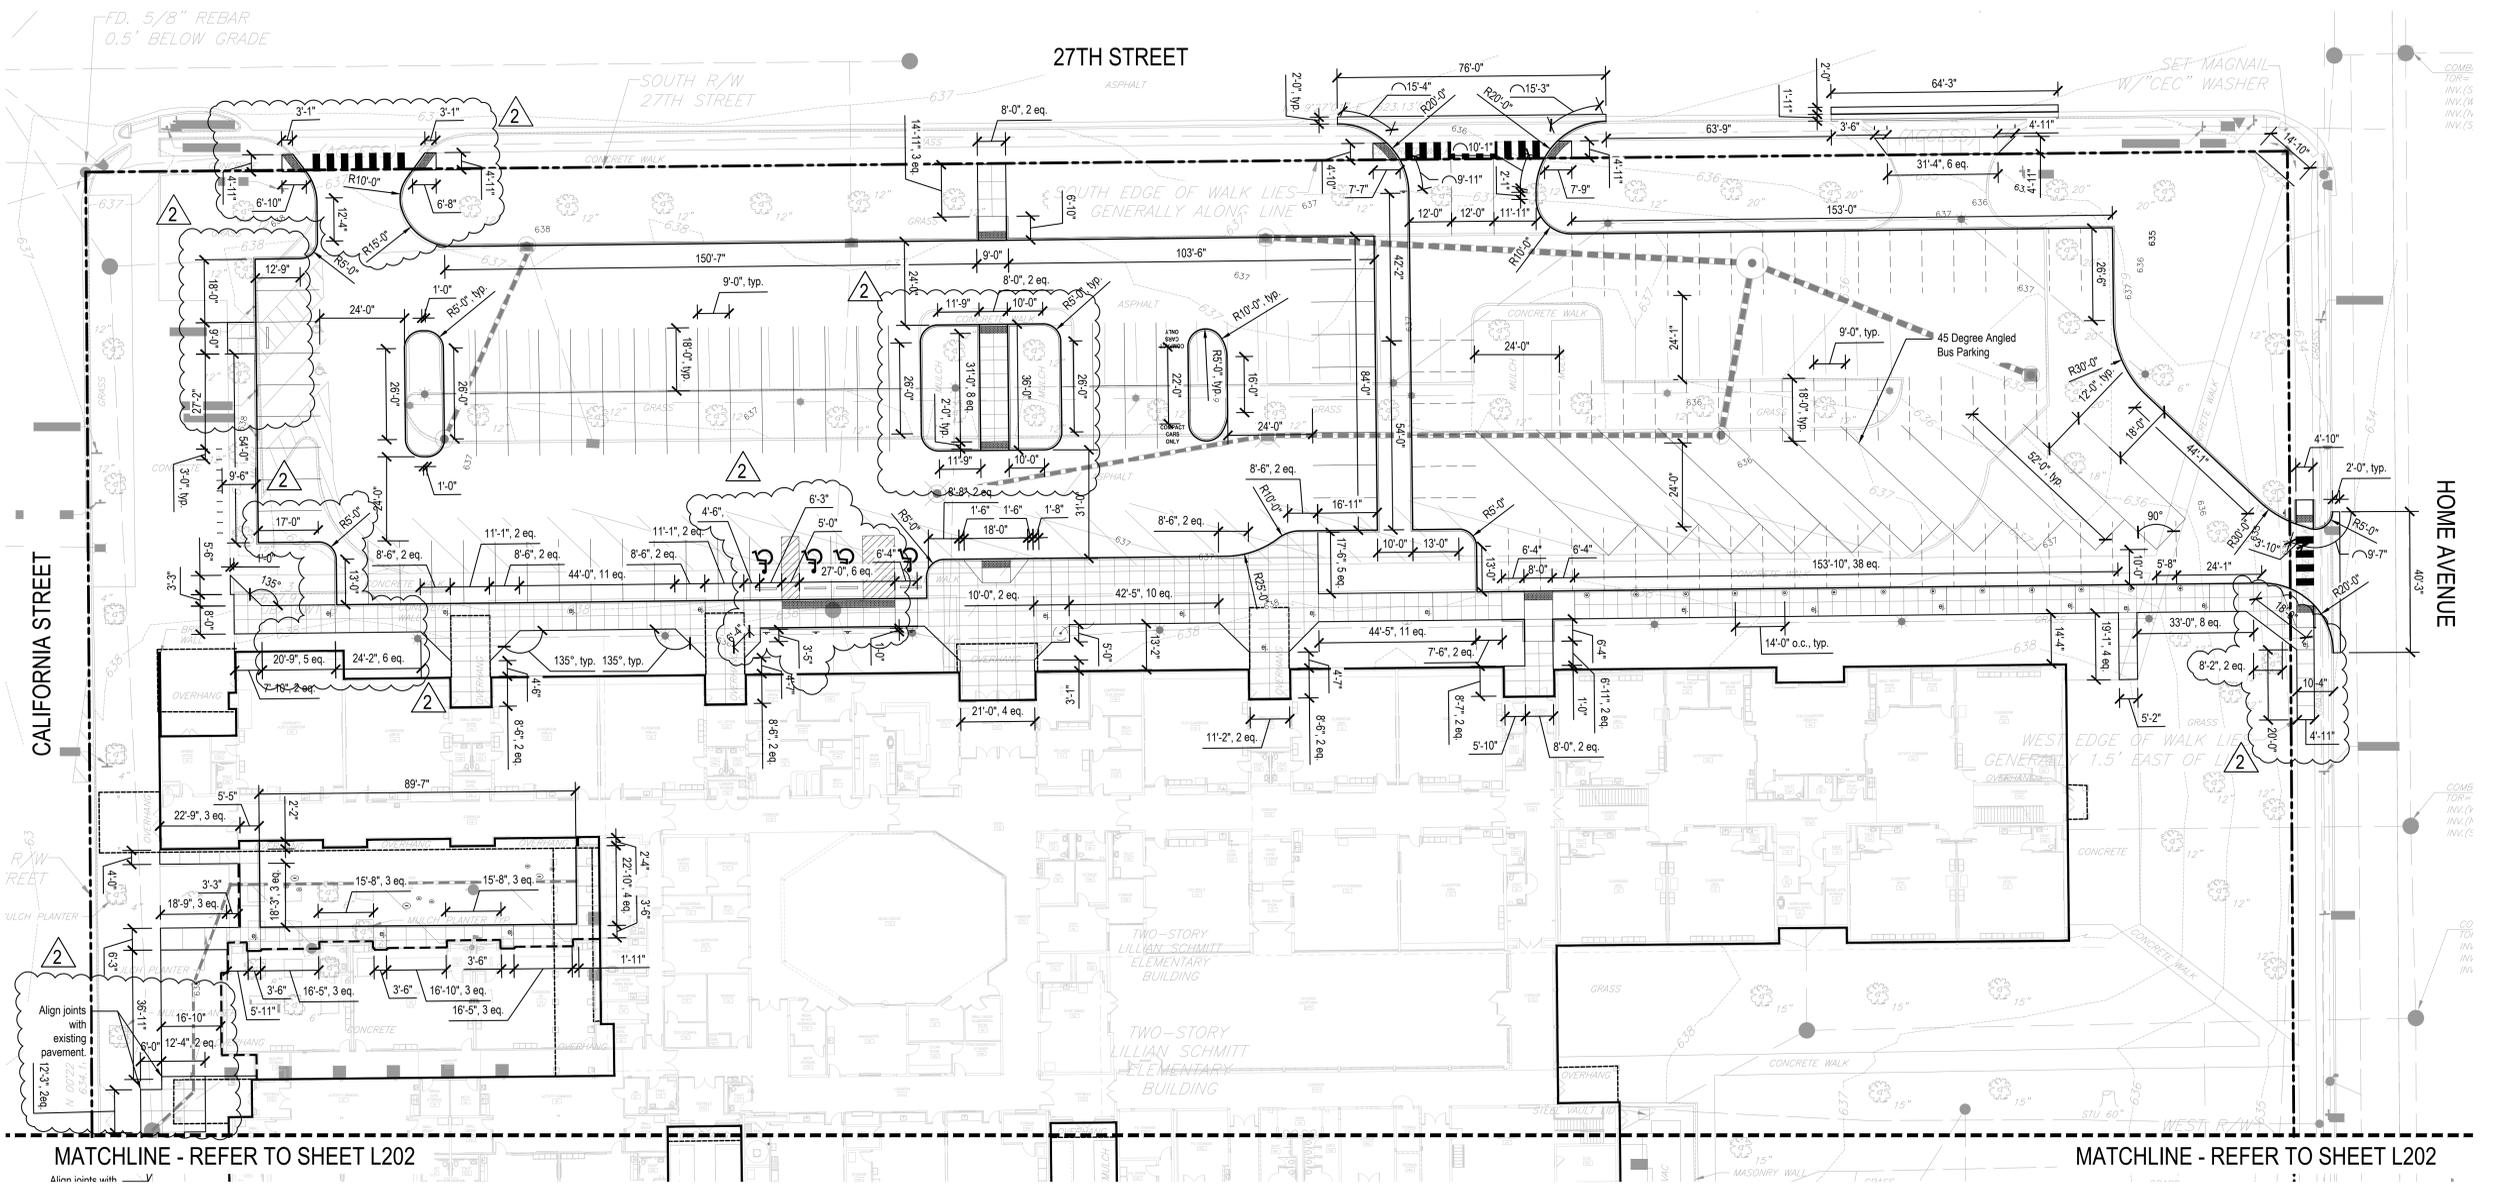

LAYOUT NOTES

- Dimensions are shown to Face of Curb unless otherwise noted.
- Contractor shall coordinate final joint locations in the field with the Landscape Architect. Align to existing conditions when practical, including at building and wall corners, connections to existing work, and to centerlines of doors.
- Space control joints evenly between all bands and expansion joints as shown, unless otherwise dimensioned. Space interim joints equally whenever possible.
- Digital AutoCAD files will be provided to the successful bidder as a courtesy to assist with field layout. The Contractor maintains all responsibility for the use, accuracy, and confirmation of such data.
- All pavement striping shown shall adhere to Specifications. The Contractor shall include in their bid any miscellaneous copy, striping, or curb painting that may be requested by the Fire Marshal.
- All disturbed areas not proposed to receive pavements shall be dressed with topsoil and seeded per Specifications.
- Contractor shall provide and install One (1) Accessible Parking Sign per accessible parking space indicated in plans. Coordinate final location in the field with Landscape Architect.

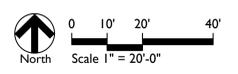

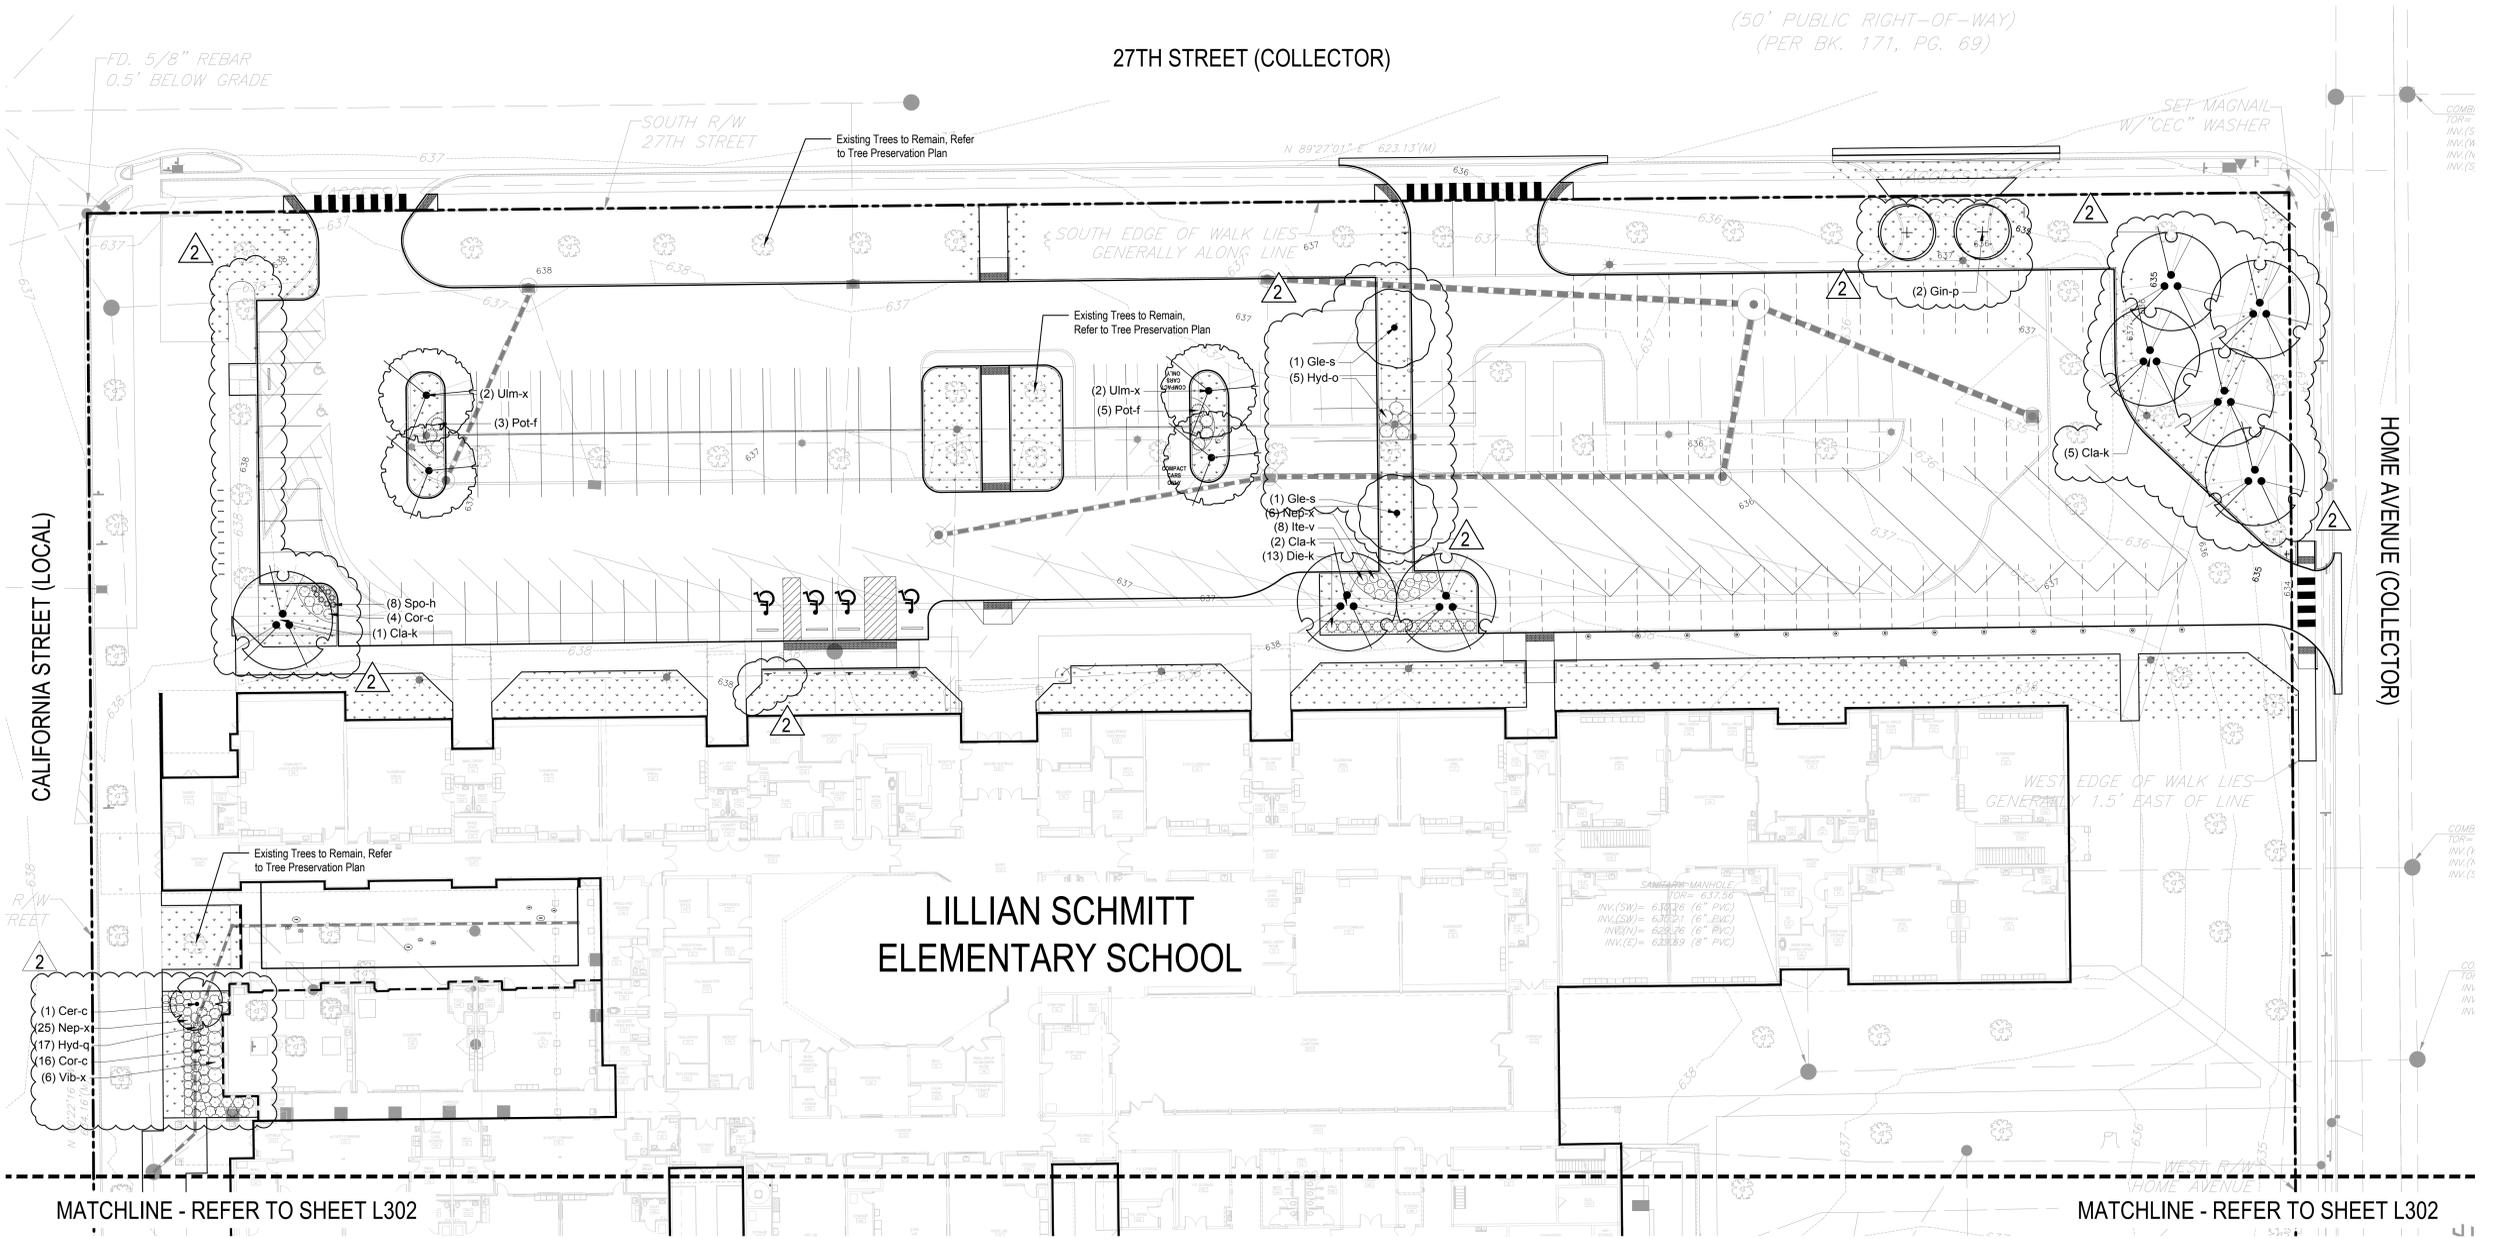

GENERAL LANDSCAPE AND PLANTING NOTES

- Refer to Project Manual for Planting Specifications and Topsoil requirements. Refer to Plant Schedule and Planting Details for additional information.
- All materials are subject to the approval of the Landscape Architect and Owner at any time. Landscape Architect to inspect all plant locations and plant bed conditions prior to installation. On-site adjustments may be required.
- Rootballs shall meet or exceed size standards as set forth in 'American Standards for Nursery Stock'. MAIN LEADERS OF ALL TREES SHALL REMAIN INTACT.
- Remove from the site any plant material that turns brown or defoliates within five (5) days after planting. Replace immediately with approved, specified material.
- Plant counts indicated on drawings are for Landscape Architect's use only. Contractor shall make own plant quantity takeoffs using drawings, specifications, and plant schedule requirements (i.e., spacing), unless otherwise directed by Landscape Architect. Contractor to verify bed measurements and install appropriate quantities as governed by plant spacing per schedule. Plant material quantities shown on plan are minimum quantities. Additional material may be needed to meet spacing requirements and field conditions.
- Seed all areas disturbed by construction activities that are not otherwise noted to receive pavement, planting bed, or sod treatment.
- The Contractor shall install and/or amend topsoil in all proposed bed areas to meet Specifications. Contractor shall coordinate quantity and placement of topsoil. Landscaper shall verify depth of topsoil prior to plant installation. (Refer to specifications for topsoil source and placement requirements)
- All tree locations shall be marked with 2x2 stakes prior to planting for review and approval by the Landscape Architect. Any plant material installed in an incorrect location, by the judgment of the Landscape Architect, shall be reinstalled at the Contractor's expense.
- All plant beds shall receive 3" minimum of shredded hardwood bark mulch (unless otherwise noted).
- Verify all utility locations in the field prior to beginning work. Repair all damaged utilities to Owner's satisfaction at additional cost.
- The Contractor shall maintain all plant material and lawns until the project is fully accepted by the Landscape Architect, unless otherwise noted.
- All workmanship and materials shall be guaranteed by the Contractor for a period of one calendar year after Final Acceptance.
- Install all plant material in accordance with all local codes and ordinances. Coordinate with the Owner to obtain any required permits necessary to complete work.
- Contractor shall test all tree pits for drainage. Any tree pit that holds water for more than 24 hours shall be installed using tree pit drainage.
- Tree Protection Fencing is the responsibility of the Contractor. Minimum protected area shall include the full drip line of the canopy. NO construction activities, material storage, etc. may occur within that area. The Contractor shall ensure that no soil compaction or tree damage occurs in any Protected areas, at any time during the construction process.
- Trees shall be matched in groups unless otherwise noted.




PLANT SCHEDULE


CODE	QTY	BOTANICAL NAME	COMMON NAME	CONT	CAL	REMARKS
TREES						
Clg-k	8	<i>Cladrastis kentukea</i>	American Yellowwood	B & B	2.5" Cal	full, strong central leader, matched
Gin-p	2	<i>Ginkgo biloba</i> 'Princeton Sentry'	Princeton Sentry Ginkgo	B & B	2.5" Cal	full, strong central leader, matched
Gle-s	2	<i>Gleditsia triacanthos</i> 'Imperial'	Imperial Honey Locust	B & B	2.5" Cal	strong central leader, symmetrical, full, matched
Ulm-x	4	<i>Ulmus x 'Frontier'</i>	Frontier Elm	B & B	2.5" Cal	
UNDERSTORY TREES						
Cer-c	1	<i>Cercis canadensis</i>	Eastern Redbud	B & B	min. 6' ht.	clump form 3-5 stems
SHRUBS						
Cor-c	20	<i>Cornus sericea</i> 'Arctic Fire'	Arctic Fire Red Twig Dogwood	Container	18" ht. min.	space @ 3'-0" o.c.
Die-k	13	<i>Diervilla x Kodiac Orange</i>	Kodiac Orange Northern Bush Honeysuckle	Container	18" ht. min.	space @ 3'-6" o.c.
Hyd-o	5	<i>Hydrangea quercifolia</i>	Oakleaf Hydrangea	Container	18" ht. min.	
Hyd-q	17	<i>Hydrangea quercifolia</i> 'Pee Wee'	Pee Wee Oakleaf Hydrangea	Container	18" ht. min.	space @ 3'-0" o.c.
Ite-v	8	<i>Itea virginica</i> 'Henry's Garnet'	Henry's Garnet Sweetspire	Container	18" ht. min.	space @ 3'-0" o.c.
Pot-f	8	<i>Potentilla fruticosa</i> 'Goldfinger'	Goldfinger Potentilla	Container	18" ht. min.	space @ 4'-0" o.c.
Vib-x	6	<i>Viburnum x juddii</i>	Judd Viburnum	Container	18" ht. min.	space @ 4'-0" o.c., allow to mass
GRASSES						
Spo-h	8	<i>Sporobolus heterolepis</i> 'Tara'	Dwarf Prairie Dropseed	pot	#1	space @ 2'-0" o.c.
PERENNIALS						
Nep-x	31	<i>Nepeta x faassenii</i> 'Novanepjun'	Junior Walker Catmint	pot	#1	space @ 2'-0" o.c.




7 SPADE EDGE
Not to Scale

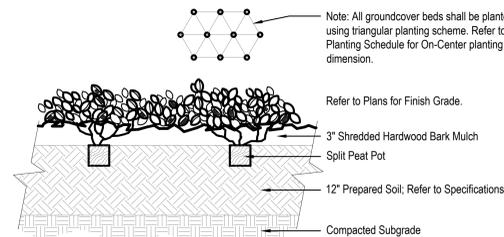


6 GROUNDCOVER PLANTING
Not to Scale

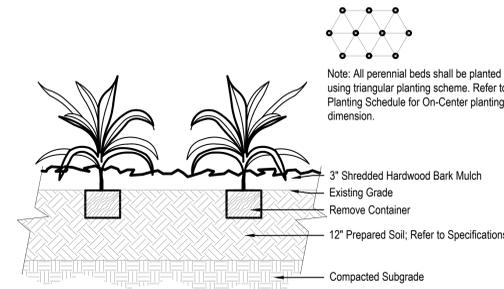


5 PERENNIAL PLANTING
Not to Scale

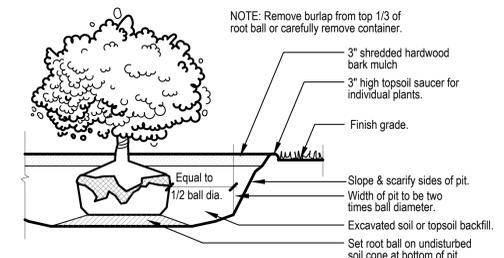


4 SHRUB PLANTING
Not to Scale

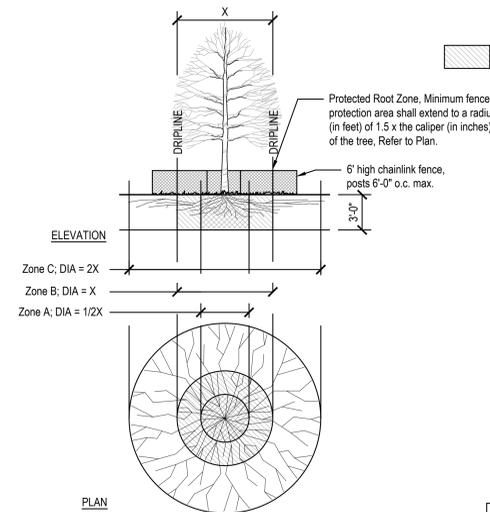

3 TREE & ROOT PROTECTION
Not To Scale

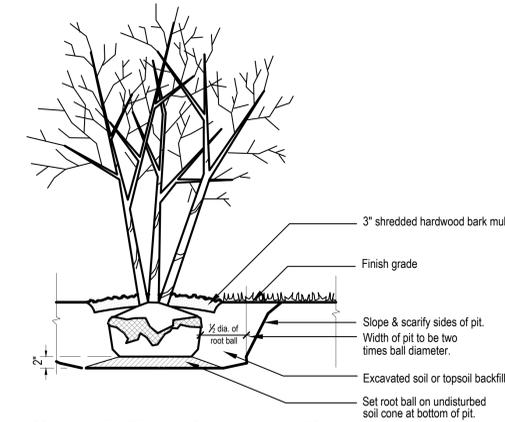

2 MULTI-STEM TREE PLANTING
Not to Scale

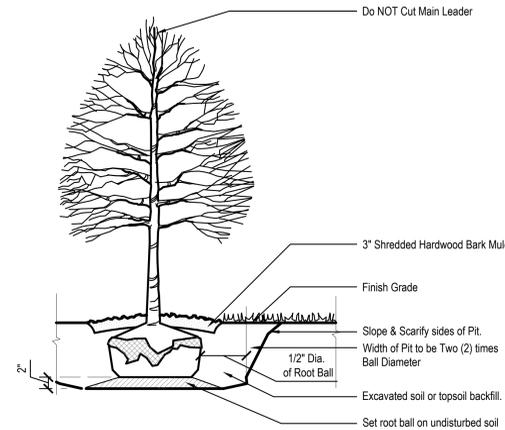

1 TREE PLANTING
Not to Scale

TRENCHING/EXCAVATION

Should Work be Required within the Protected Root Zone, the Following Shall be Minimally Coordinated in the Field with the Landscape Architect prior to Construction.

ZONE A (CRITICAL ROOT ZONE)

- NO DISTURBANCE ALLOWED without site-specific inspection and approval of methods to minimize root damage.
- Severance of roots larger than 2" diameter requires Landscape Architect's approval.
- Tunneling or boring required to install utilities 3'-0" below grade or deeper.

ZONE B (DRIPLINE)

- Operation of heavy equipment and/or stockpiling of materials subject to Landscape Architect's approval. Surface Protection* measures required.
- Trenching allowed as follows:
 - Excavation by hand or with hand-driver trencher may be required.
 - Limit trench width. Do not disturb Zone A, maintain 2/3 or more of Zone B in undisturbed condition.
- Tunneling or boring may be required for trenches deeper than 3'-0".

ZONE C (FEEDER ROOT ZONE)

- Operation of heavy equipment and/or stockpiling of materials subject to Landscape Architect's approval. Surface Protection* measures required.
- Trenching with heavy equipment allowed as follows:
 - Minimize trench width.
 - Maintain 2/3 or more of Zone C in undisturbed condition.

FENCING/ROOT PROTECTION

4' high vinyl protection fence at the greater of Zone B (Dripline) or to a radius (in feet) of 1.5x the caliper (in inches) of the tree, minimum, and at Zone C (Protected Root Zone) if possible. Upon Landscape Architect's approval, a plywood box (8' minimum height) may be used where fencing cannot be achieved.

Landscape Architect's approval required for use/access within Zone B. Permission for use/access requires Surface Protection Measures for all unfenced, unpaved surfaces within Zone B.

***SURFACE PROTECTION MEASURES**

- Mulch Layer, 6"-8" Depth
- 3/4" Plywood
- Steel Plates

NOTE:

- Refer to Tree Preservation specification 01-56-39.
- Contractor may submit alternate methods of tree protection to Landscape Architect for Consideration Prior to Construction.

SCOPE DRAWINGS:
These drawings indicate the general scope of the project in terms of architectural design content, the structure of structural, mechanical and electrical systems. The drawings do not necessarily indicate or describe all work required for the performance and completion of the requirements of the Contract.
On the basis of the general scope indicated on these drawings, the contractor shall furnish all items required for the proper execution and completion of the work.

REVISIONS:		
1	Addendum 01	03/08/2024
2	Addendum 02	03/15/2024


ISSUE DATE	DRAWN BY	CHECKED BY
02/16/2024	MA	LM

DRAWING TITLE:
PLANTING DETAILS & SCHEDULE


CERTIFIED BY:
ALYSSA P. PRAZU
REGISTERED
No. 2020-0132
STATE OF INDIANA
LANDSCAPE ARCHITECT
EXPIRES 12-31-2025

DRAWING NUMBER
L400


PROJECT NUMBER
2021049

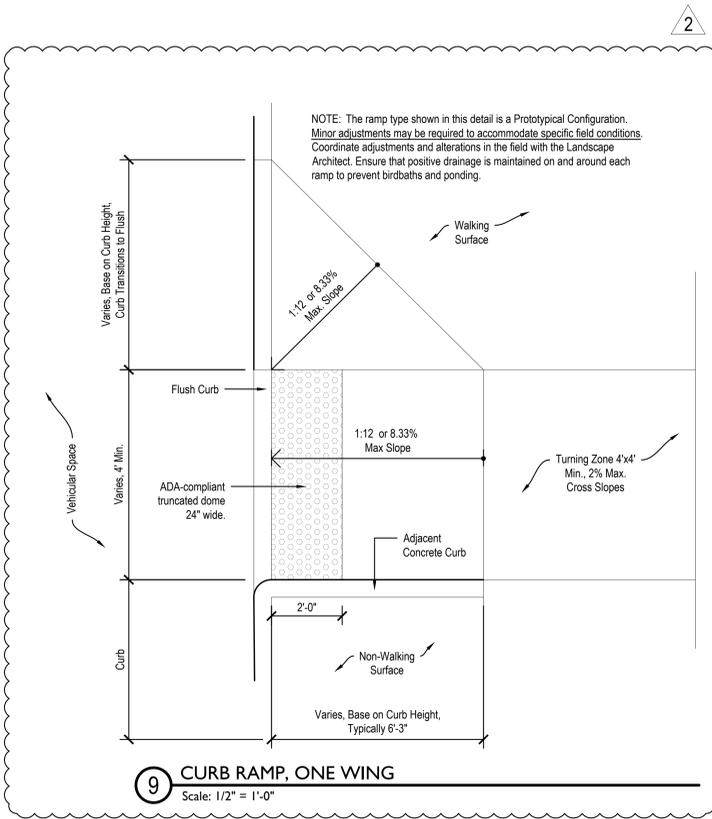


9 CURB RAMP, ONE WING
Scale: 1/2" = 1'-0"

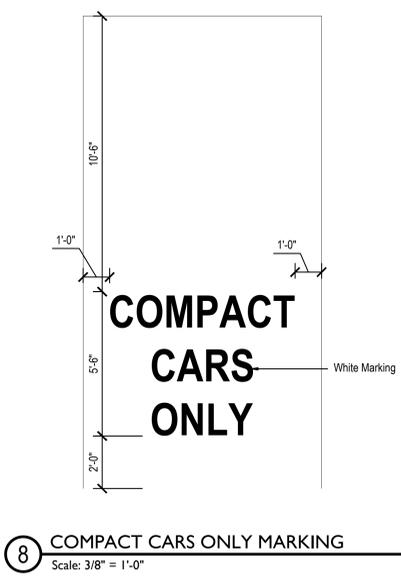


8 COMPACT CARS ONLY MARKING
Scale: 3/8" = 1'-0"

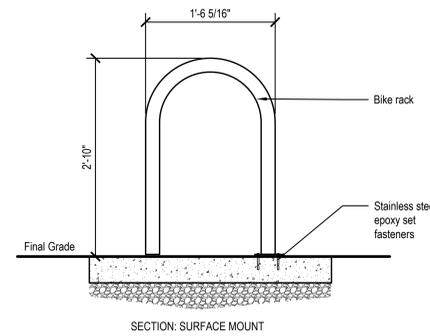


5 BIKE RACK - SURFACE MOUNT
Scale: 1" = 1'-0"

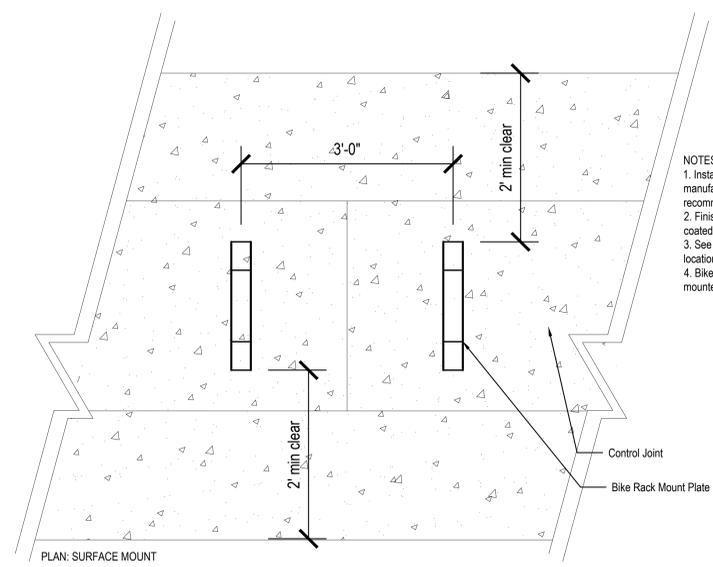


5 BIKE RACK - SURFACE MOUNT
Scale: 1" = 1'-0"

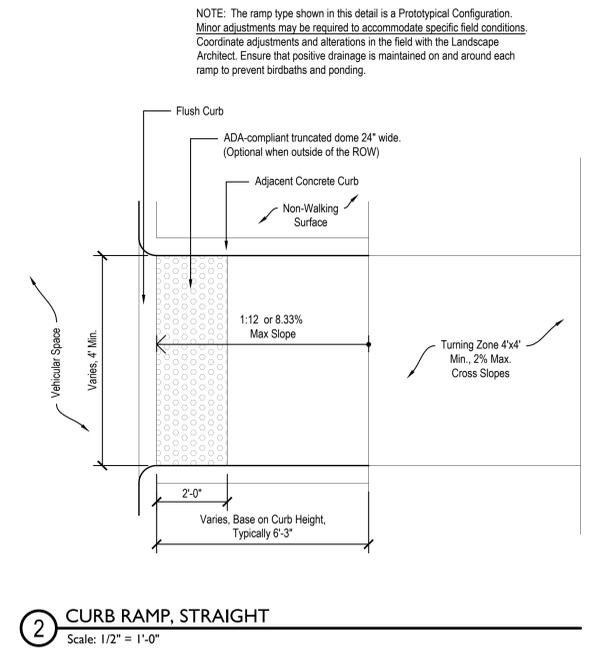


2 CURB RAMP, STRAIGHT
Scale: 1/2" = 1'-0"

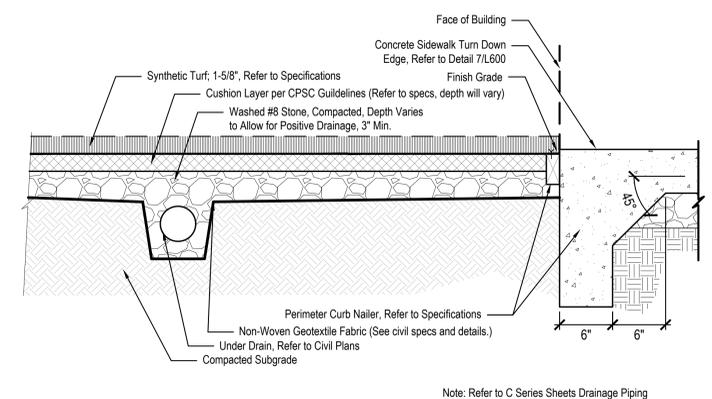


7 SYNTHETIC PLAYGROUND TURF
Scale: 1-1/2" = 1'-0"

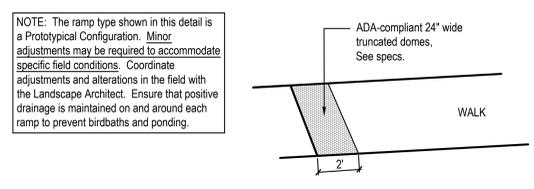


4 TRUNCATED DOMES WITH NO RAMP CONDITION
Scale: 1/4" = 1'-0"

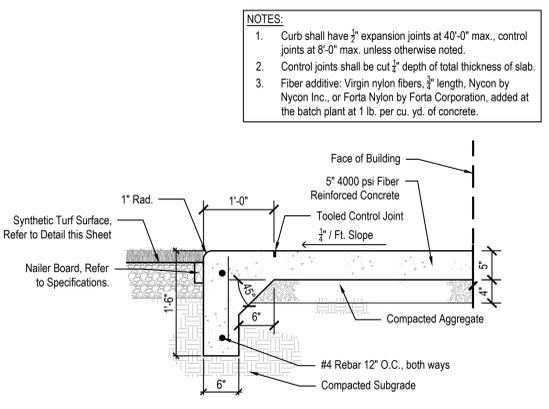


6 PERIMETER CURB NAILER AT INTEGRAL CURB AND WALK
Scale: 1" = 1'-0"

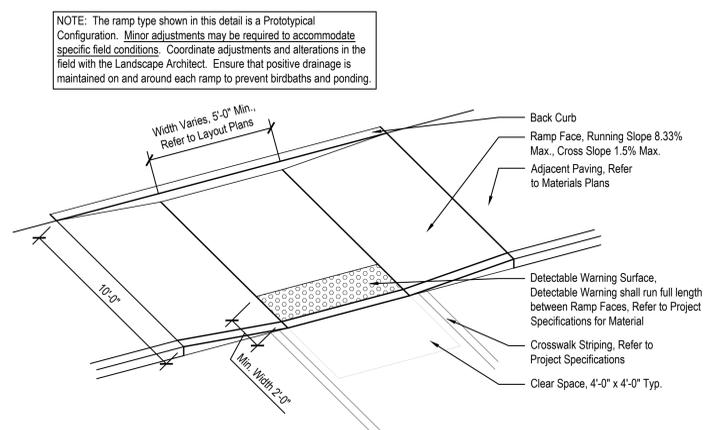


3 PARALLEL CURB RAMP
Scale: 1/4" = 1'-0"

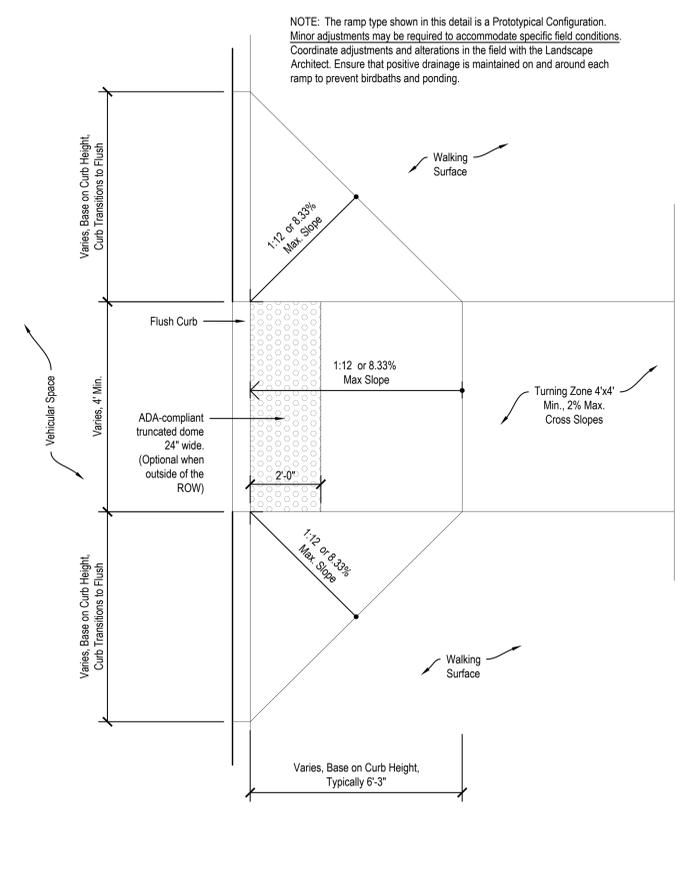


1 CURB RAMP, DOUBLE WING
Scale: 1/2" = 1'-0"

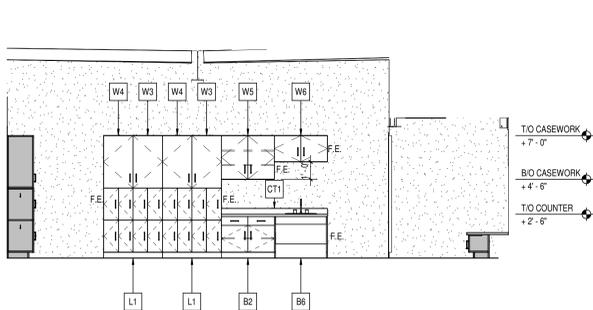

16 CLASSROOM 147 - WEST
A606 SCALE: 1/4" = 1'-0"

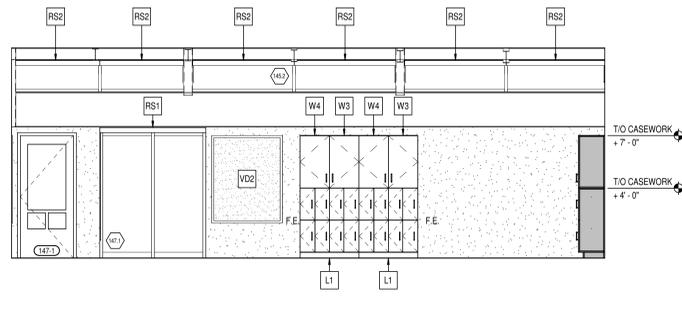


15 CLASSROOM 147 - SOUTH
A606 SCALE: 1/4" = 1'-0"

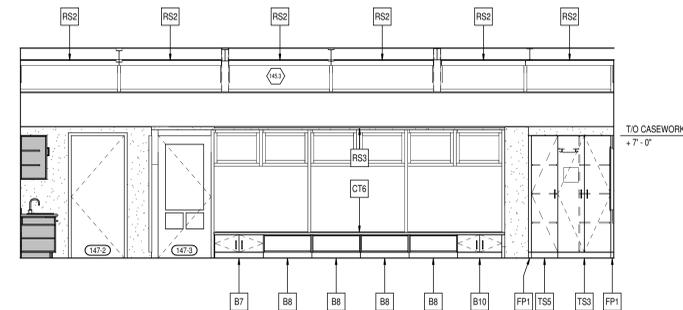


14 CLASSROOM 147 - NORTH
A606 SCALE: 1/4" = 1'-0"

GENERAL CASEWORK NOTES


- A. PROVIDE COUNTERTOP SUPPORTS AT ALL OPEN KNEE SPACE COUNTERTOPS.
- B. PROVIDE FILLER PANELS AT ALL LOCATIONS WHERE CASEWORK IS FLANKED BY WALLS AS REQUIRED TO CLOSE OFF SPACE AND PROVIDE A NEAT, FINISHED INSTALLATION. PROVIDE EQUAL FILLER PANELS AT EITHER SIDE OF CASEWORK TO BALANCE APPEARANCE.
- C. PROVIDE FINISHED ENDS AT ALL CABINET SIDES PARTIALLY OR FULLY EXPOSED TO VIEW.
- D. SEE INTERIOR CASEWORK ELEVATIONS FOR DOOR SWING.
- E. PROVIDE COUNTER GROMMETS FOR ALL OPEN KNEE SPACE COUNTERTOP INSTALLATIONS.
- F. REFER TO A600 SERIES FOR ALL MATERIAL FINISHES, SPECIFICATIONS, AND LOCATIONS.
- G. ALL CASEWORK TO HAVE LOCKS PROVIDED UNLESS SPECIFICALLY NOTED OTHERWISE.
- H. SEE REFLECTED CEILING PLAN FOR MOST ACCURATE CEILING HEIGHTS. CONFIRM FIELD DIMENSIONS PRIOR TO FABRICATION.
- I. PROVIDE ALL NECESSARY FURRING AND GROUNDING FOR CASEWORK. COORDINATE LOCATION OF BLOCKING WITHIN PARTITIONS FOR ITEMS TO BE SECURED TO SURFACE. ALL FASTENERS SHALL BE CONCEALED.
- J. WHERE DROP SINKS OCCUR, ENSURE THAT NO PORTION OF THE ASSEMBLY EXCEEDS 34" A.F.F. AS REQUIRED BY ADA.
- L. CALK CASEWORK TO ADJOINING FINISHED SURFACES.
- M. REFER TO A600 SERIES FOR EQUIPMENT SCHEDULE AND LOCATIONS.

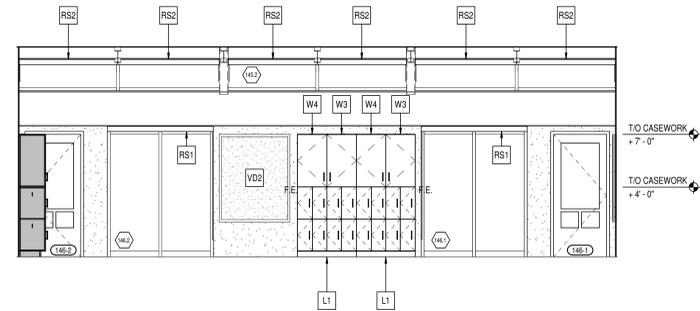


13 FLEX CLASSROOM 146 - SOUTH
A606 SCALE: 1/4" = 1'-0"

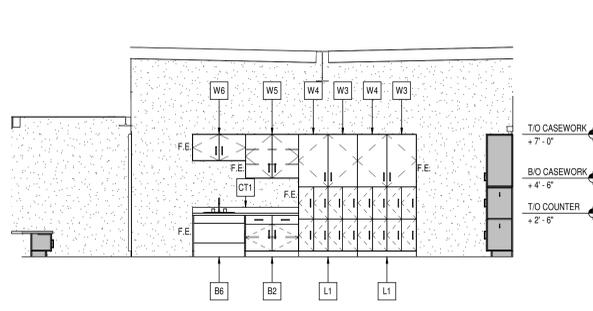


12 FLEX CLASSROOM 146 - EAST
A606 SCALE: 1/4" = 1'-0"

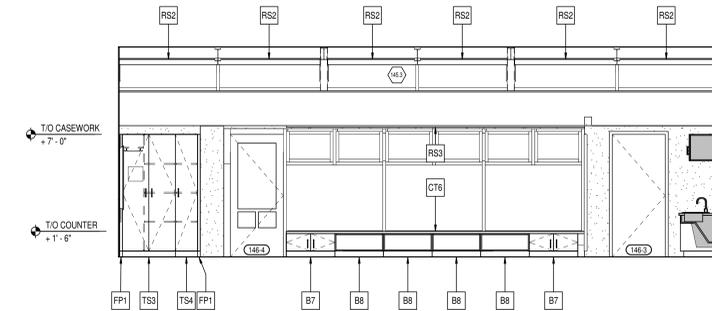


11 FLEX CLASSROOM 146 - NORTH
A606 SCALE: 1/4" = 1'-0"

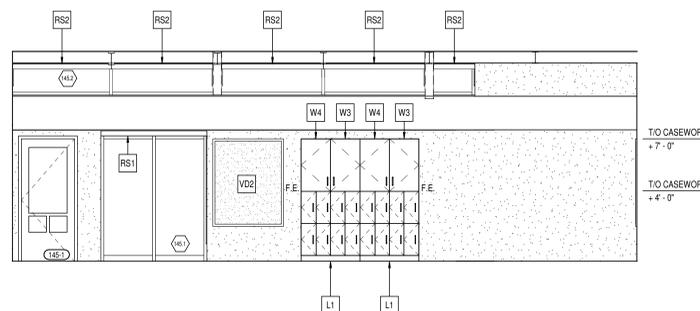


10 CLASSROOM 145 - SOUTH
A606 SCALE: 1/4" = 1'-0"

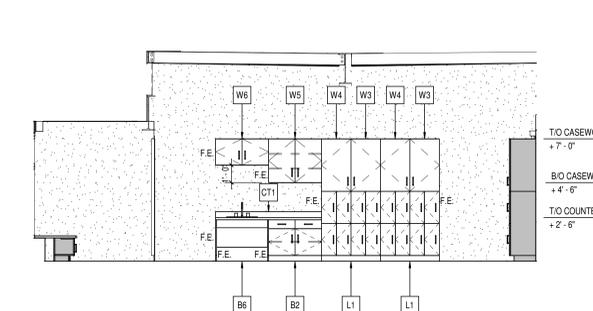


9 CLASSROOM 145 - EAST
A606 SCALE: 1/4" = 1'-0"

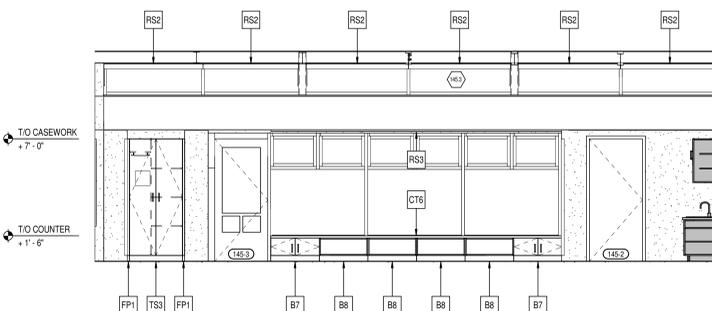


8 CLASSROOM 145 - NORTH
A606 SCALE: 1/4" = 1'-0"

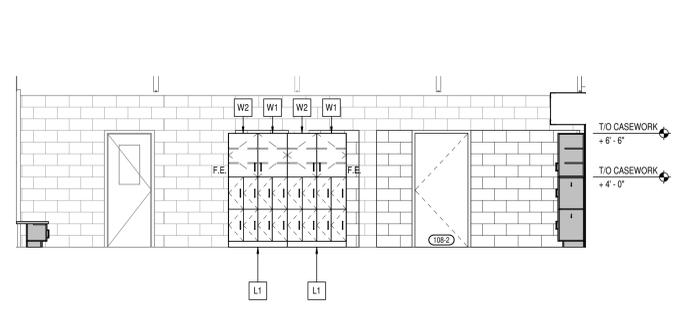


7 CLASSROOM 108 - EAST
A606 SCALE: 1/4" = 1'-0"

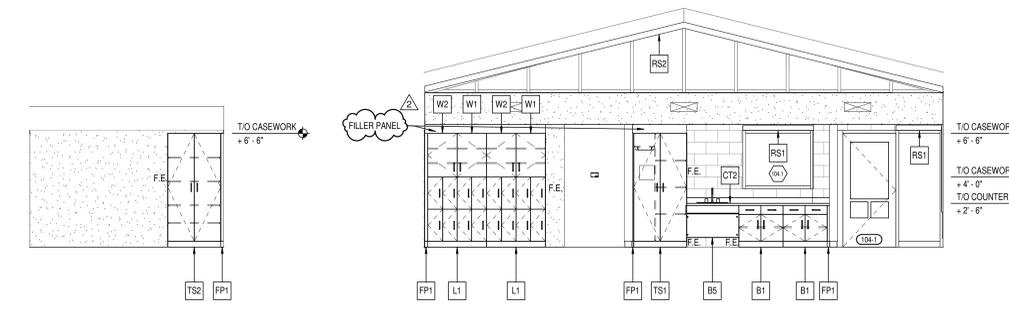


5 CLASSROOM 104 - SOUTH
A606 SCALE: 1/4" = 1'-0"

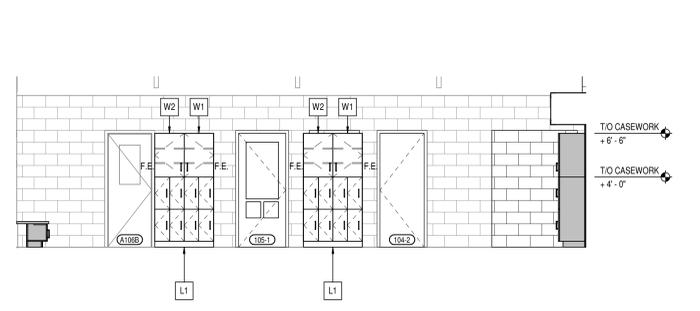


4 CLASSROOM 104 - EAST
A606 SCALE: 1/4" = 1'-0"

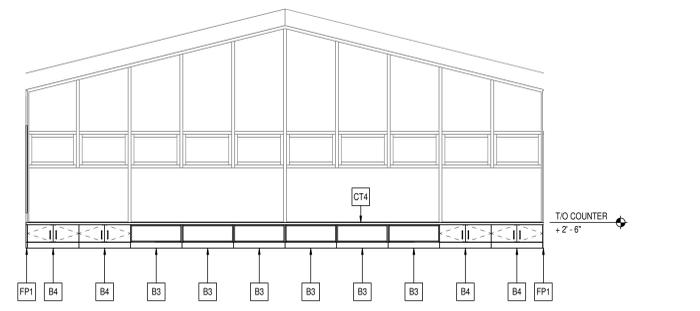

3 CLASSROOM 104 - NORTH
A606 SCALE: 1/4" = 1'-0"

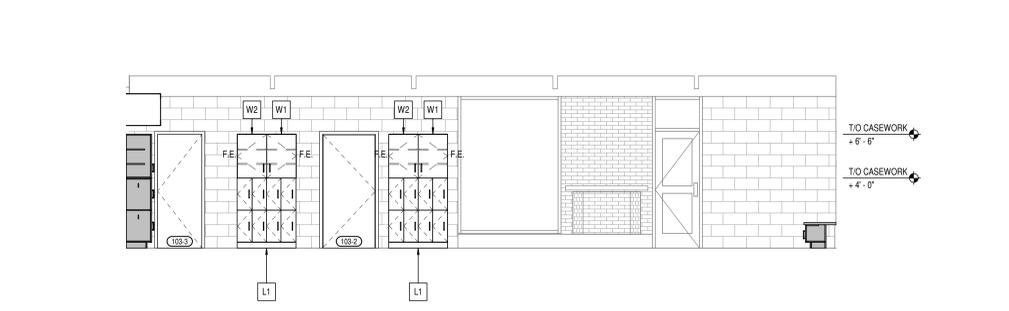

2 COMMUNITY/ FLEX CLASSROOM 103 - WEST
A606 SCALE: 1/4" = 1'-0"

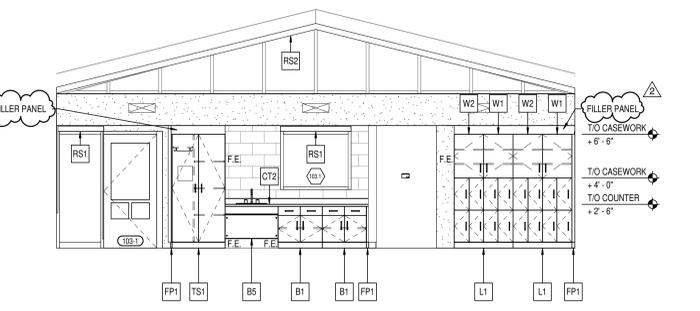

1 COMMUNITY/ FLEX CLASSROOM 103 - SOUTH
A606 SCALE: 1/4" = 1'-0"

SCOPE DRAWINGS:
These drawings indicate the general scope of the project. The contractor shall verify the accuracy of all dimensions and conditions of work prior to construction. The contractor shall be responsible for obtaining all necessary permits and approvals from the appropriate authorities. On the basis of the general scope indicated on these drawings, the contractor shall furnish all items required for the proper execution and completion of the work.

REVISIONS:
2 ADDENDUM #2 03/15/2024

ISSUE DATE DRAWN BY CHECKED BY
02/16/24 LNM BJK

DRAWING TITLE:
CASEWORK
ELEVATIONS

CERTIFIED BY:
JAMES ROBERT FLEMING
REGISTERED ARCHITECT
No. A00000003
STATE OF INDIANA
JRF

DRAWING NUMBER
A606

PROJECT NUMBER
2021049

GENERAL CASEWORK NOTES

- A. PROVIDE COUNTERTOP SUPPORTS AT ALL OPEN KNEE SPACE COUNTERTOPS.
- B. PROVIDE FILLER PANELS AT ALL LOCATIONS WHERE CASEWORK IS FLANKED BY WALLS AS REQUIRED TO CLOSE OFF SPACE AND PROVIDE A NEAT, FINISHED INSTALLATION. PROVIDE EQUAL FILLER PANELS AT EITHER SIDE OF CASEWORK TO BALANCE APPEARANCE.
- C. PROVIDE FINISHED ENDS AT ALL CABINET SIDES PARTIALLY OR FULLY EXPOSED TO VIEW.
- D. SEE INTERIOR CASEWORK ELEVATIONS FOR DOOR SWING.
- E. PROVIDE COUNTER GROMMETS FOR ALL OPEN KNEE SPACE COUNTERTOP INSTALLATIONS.
- F. REFER TO A600 SERIES FOR ALL MATERIAL FINISHES, SPECIFICATIONS, AND LOCATIONS.
- G. ALL CASEWORK TO HAVE LOCKS PROVIDED UNLESS SPECIFICALLY NOTED OTHERWISE.
- H. SEE REFLECTED CEILING PLAN FOR MOST ACCURATE CEILING HEIGHTS. CONFIRM FIELD DIMENSIONS PRIOR TO FABRICATION.
- I. PROVIDE ALL NECESSARY FURRING AND GROUNDS FOR CASEWORK. COORDINATE LOCATION OF BLOCKING WITHIN PARTITIONS FOR ITEMS TO BE SECURED TO SURFACE. ALL FASTENERS SHALL BE CONCEALED.
- J. WHERE DROP SINKS OCCUR, ENSURE THAT NO PORTION OF THE ASSEMBLY EXCEEDS 34" A.F.F. AS REQUIRED BY ADA.
- L. CAULK CASEWORK TO ADJOINING FINISHED SURFACES.
- M. REFER TO A600 SERIES FOR EQUIPMENT SCHEDULE AND LOCATIONS.

SCOPE DRAWINGS:
 These drawings indicate the general scope of the project. The drawings are not intended to be a contract document. The drawings do not necessarily indicate or describe all work required for the proper execution and completion of the project. On the basis of the general scope indicated on these drawings, the trade contractors shall furnish all items required for the proper execution and completion of the work.


REVISIONS:

1	ADDENDUM #1	03/08/2024
2	ADDENDUM #2	03/15/2024

ISSUE DATE **DRAWN BY** **CHECKED BY**


02/16/24	LMN	BJK
----------	-----	-----

DRAWING TITLE:
CASEWORK ELEVATIONS

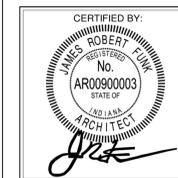


DRAWING NUMBER:
A608

PROJECT NUMBER:
 2021049

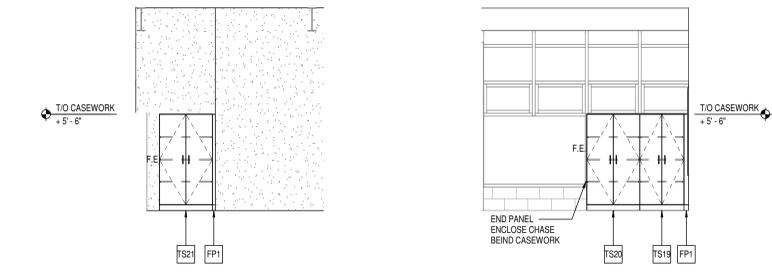


19 SMALL GROUP ROOM 127
 A608 SCALE: 1/4" = 1'-0"


18 SMALL GROUP ROOM 126
 A608 SCALE: 1/4" = 1'-0"

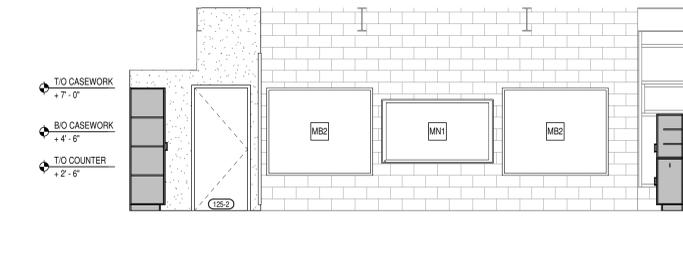


17 CLASSROOM 125 - WEST
 A608 SCALE: 1/4" = 1'-0"

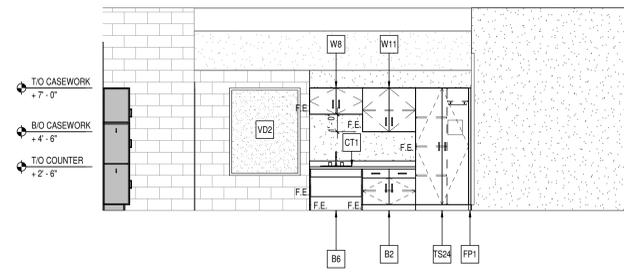


16 CLASSROOM 125 - SOUTH
 A608 SCALE: 1/4" = 1'-0"

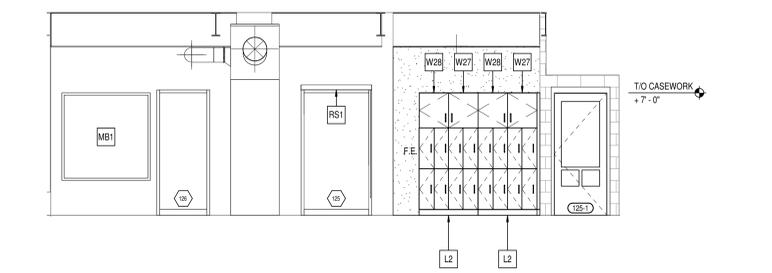


15 CLASSROOM 125 - EAST
 A608 SCALE: 1/4" = 1'-0"

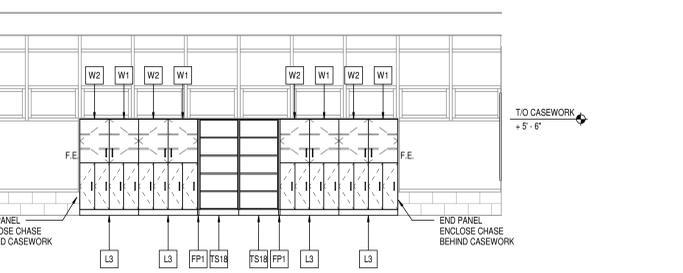


14 TYP. UNIT C CLASSROOM
 A608 SCALE: 1/4" = 1'-0"

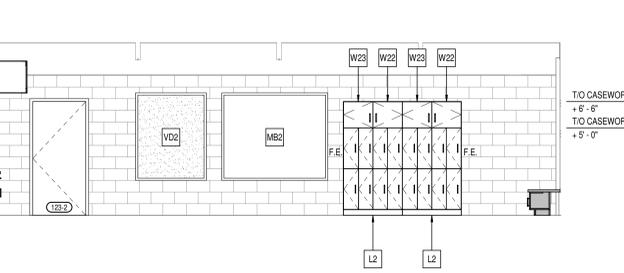


13 CLASSROOM 123 - EAST
 A608 SCALE: 1/4" = 1'-0"

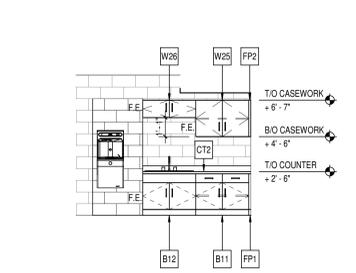


12 ACTIVITY COMMONS 122
 A608 SCALE: 1/4" = 1'-0"

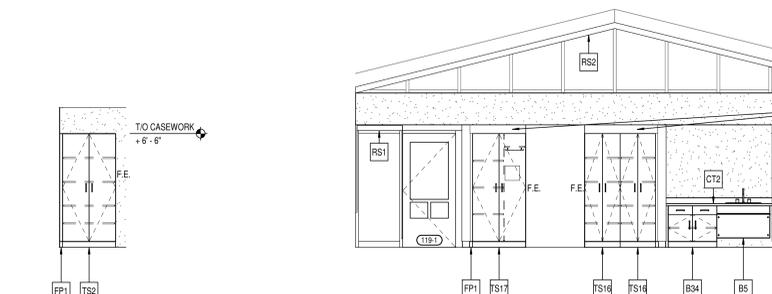


11 TOILET 119A
 A608 SCALE: 1/4" = 1'-0"

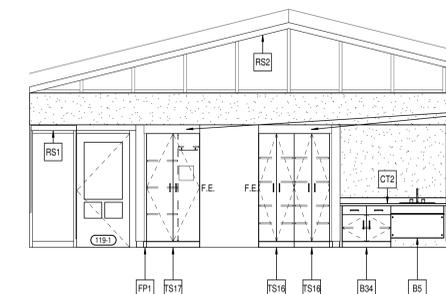


10 LIFE SKILLS 119 - NORTH
 A608 SCALE: 1/4" = 1'-0"

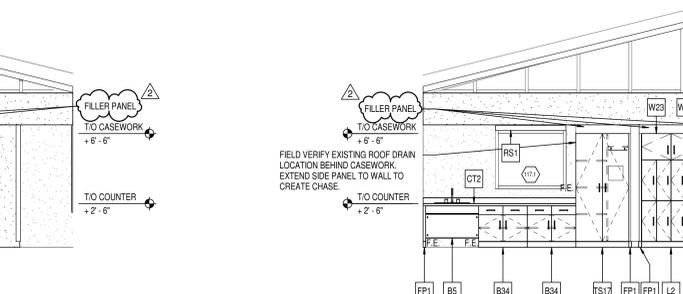


9 CLASSROOM 117 - SOUTH
 A608 SCALE: 1/4" = 1'-0"

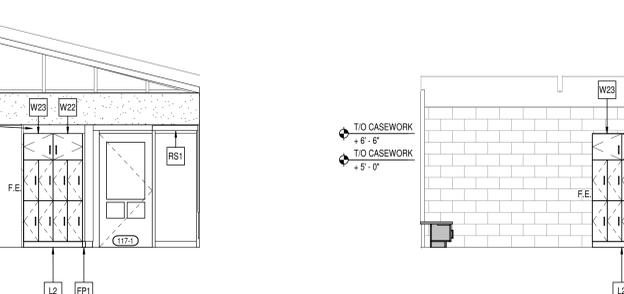


8 CLASSROOM 117 - EAST
 A608 SCALE: 1/4" = 1'-0"

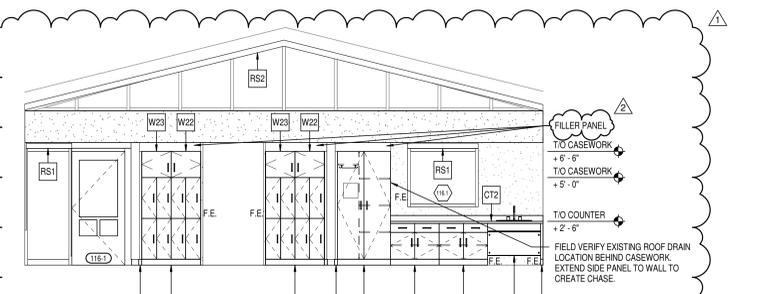


7 CLASSROOM 116 - SOUTH
 A608 SCALE: 1/4" = 1'-0"

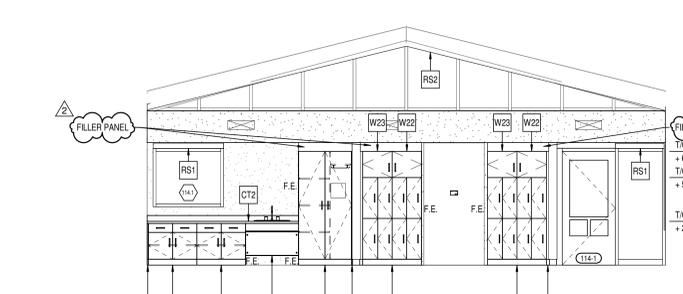


6 FLEX CLASSROOM 114 - SOUTH
 A608 SCALE: 1/4" = 1'-0"

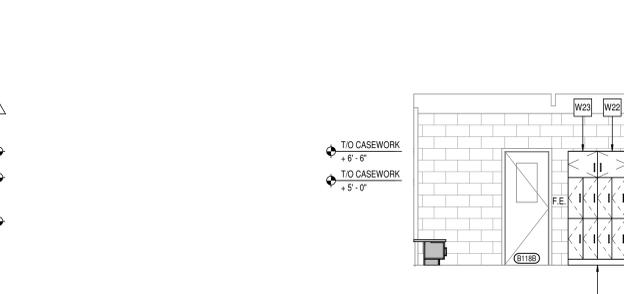


5 FLEX CLASSROOM 144 - EAST
 A608 SCALE: 1/4" = 1'-0"

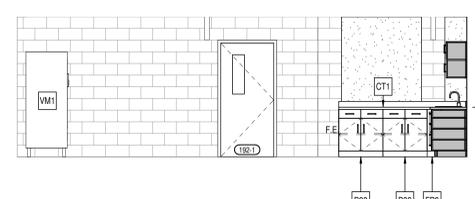


4 STAFF DINING 192 - WEST
 A608 SCALE: 1/4" = 1'-0"

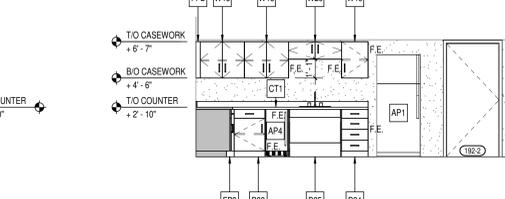

3 STAFF DINING 192 - NORTH
 A608 SCALE: 1/4" = 1'-0"

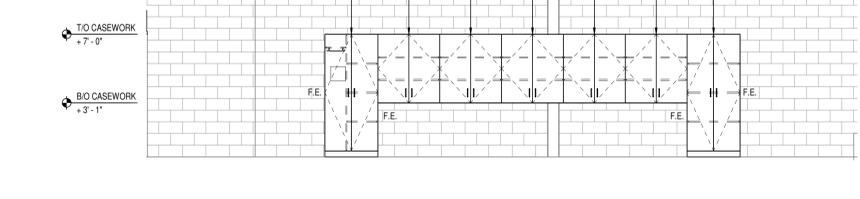

2 MUSIC LAB 186 - EAST
 A608 SCALE: 1/4" = 1'-0"

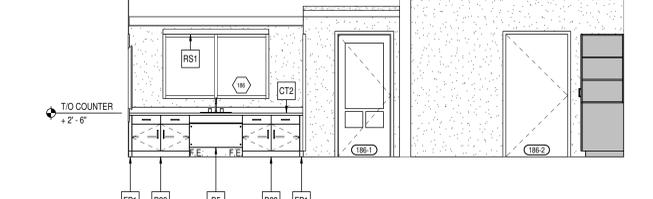

1 MUSIC LAB 186 - NORTH
 A608 SCALE: 1/4" = 1'-0"

GENERAL CASEWORK NOTES

- A. PROVIDE COUNTERTOP SUPPORTS AT ALL OPEN KNEE SPACE COUNTERTOPS.
- B. PROVIDE FILLER PANELS AT ALL LOCATIONS WHERE CASEWORK IS FLANKED BY WALLS AS REQUIRED TO CLOSE OFF SPACE AND PROVIDE A NEAT, FINISHED INSTALLATION. PROVIDE EQUAL FILLER PANELS AT EITHER SIDE OF CASEWORK TO BALANCE APPEARANCE.
- C. PROVIDE FINISHED ENDS AT ALL CABINET SIDES PARTIALLY OR FULLY EXPOSED TO VIEW.
- D. SEE INTERIOR CASEWORK ELEVATIONS FOR DOOR SWING.
- E. PROVIDE COUNTER GROMMETS FOR ALL OPEN KNEE SPACE COUNTERTOP INSTALLATIONS.
- F. REFER TO A600 SERIES FOR ALL MATERIAL FINISHES, SPECIFICATIONS, AND LOCATIONS.
- G. ALL CASEWORK TO HAVE LOCKS PROVIDED UNLESS SPECIFICALLY NOTED OTHERWISE.
- H. SEE REFLECTED CEILING PLAN FOR MOST ACCURATE CEILING HEIGHTS. CONFIRM FIELD DIMENSIONS PRIOR TO FABRICATION.
- I. PROVIDE ALL NECESSARY FURRING AND GROUNDS FOR CASEWORK. COORDINATE LOCATION OF BLOCKING WITHIN PARTITIONS FOR ITEMS TO BE SECURED TO SURFACE. ALL FASTENERS SHALL BE CONCEALED.
- J. WHERE DROP SINKS OCCUR, ENSURE THAT NO PORTION OF THE ASSEMBLY EXCEEDS 34" A.F.F. AS REQUIRED BY ADA.
- K. CALK CASEWORK TO ADJOINING FINISHED SURFACES.
- L. REFER TO A600 SERIES FOR EQUIPMENT SCHEDULE AND LOCATIONS.
- M.

SCOPE DRAWINGS:
These drawings indicate the general scope of the project. The contractor shall coordinate the structural, mechanical and electrical systems. The drawings do not necessarily indicate or describe all work required for the performance and completion of the project. On the basis of the general scope indicated on drawings, the contractor shall furnish all items required for the proper execution and completion of the work.


REVISIONS:
1 ADDENDUM #1 03/08/2024
2 ADDENDUM #2 03/15/2024

ISSUE DATE 02/16/24 **DRAWN BY** LNM **CHECKED BY** BJK


DRAWING TITLE:
**ENLARGED
MILLWORK,
PLANS,
SECTIONS AND
DETAILS**

CERTIFIED BY:
JAMES ROBERT FLEMING
REGISTERED PROFESSIONAL ARCHITECT
No. AR00900003
STATE OF INDIANA
JRF


DRAWING NUMBER
A611
PROJECT NUMBER
2021049

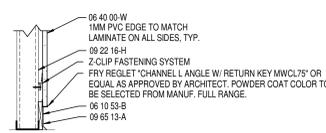


14 TYP. CORRIDOR PANEL SECTION DETAIL
A611 SCALE: 1" = 1'-0"

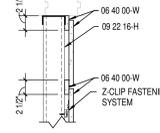


13 TYP. CORRIDOR PANEL SECTION DETAIL
A611 SCALE: 1" = 1'-0"

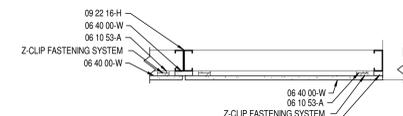


12 TYP. CORRIDOR PANEL ENLARGED PLAN DETAIL
A611 SCALE: 1" = 1'-0"

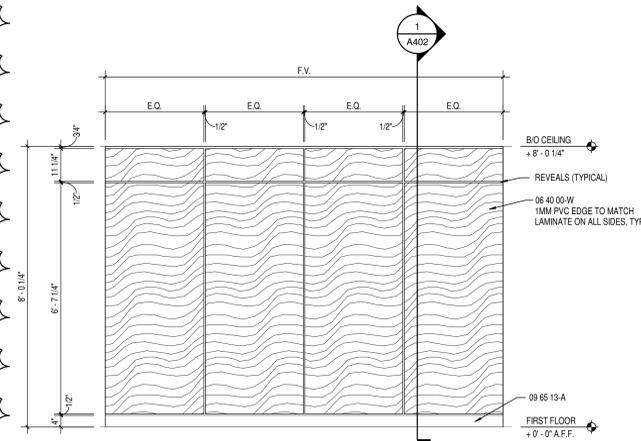


11 TYP. CORRIDOR PANEL ELEVATION
A611 SCALE: 1/2" = 1'-0"

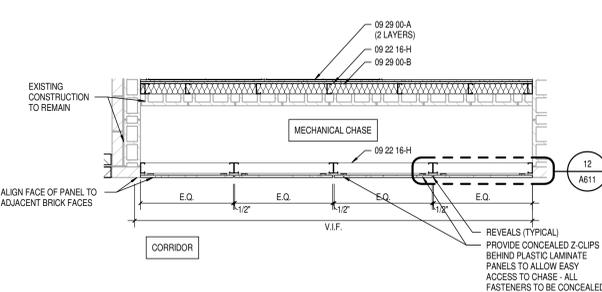


10 TYP. CORRIDOR PANEL ENLARGED PLAN
A611 SCALE: 1/2" = 1'-0"

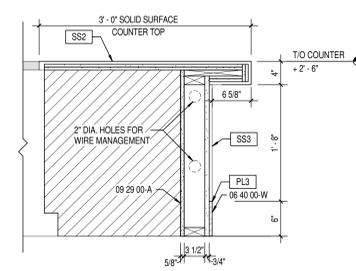


9 ENLARGED MILLWORK SECTION
A611 SCALE: 1" = 1'-0"

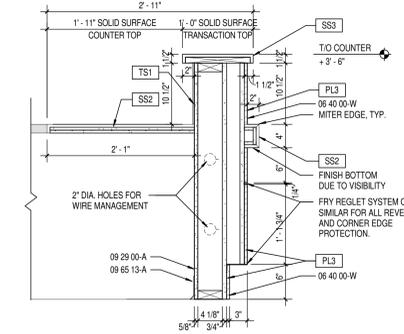


8 ENLARGED MILLWORK SECTION
A611 SCALE: 1" = 1'-0"

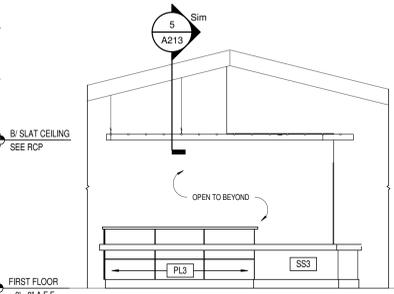


7 RECEPTION DESK ELEVATION
A611 SCALE: 1/4" = 1'-0"

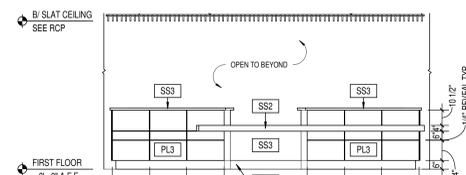


6 RECEPTION DESK ELEVATION
A611 SCALE: 1/4" = 1'-0"

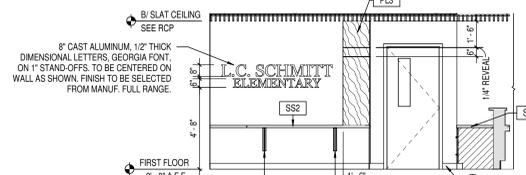


5 RECEPTION DESK ELEVATION
A611 SCALE: 1/4" = 1'-0"

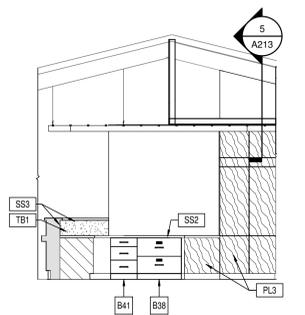


4 RECEPTION DESK ELEVATION
A611 SCALE: 1/4" = 1'-0"

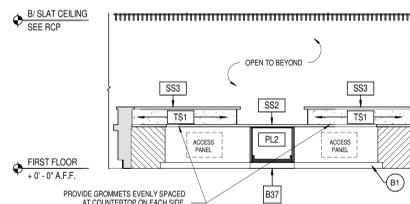


3 RECEPTION DESK ELEVATION
A611 SCALE: 1/4" = 1'-0"

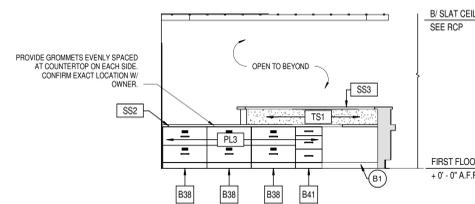


2 RECEPTION DESK ELEVATION
A611 SCALE: 1/4" = 1'-0"

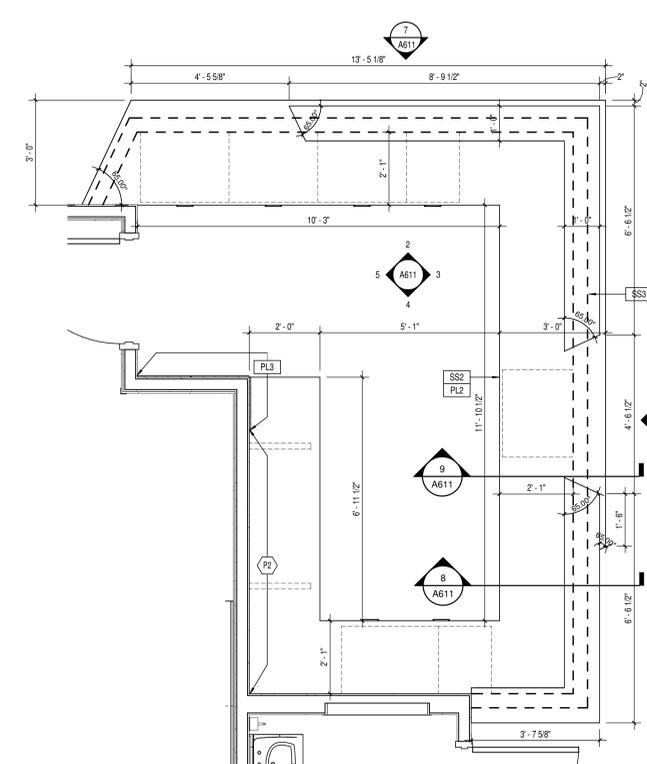

1 RECEPTION DESK ENLARGED PLAN
A611 SCALE: 1/2" = 1'-0"

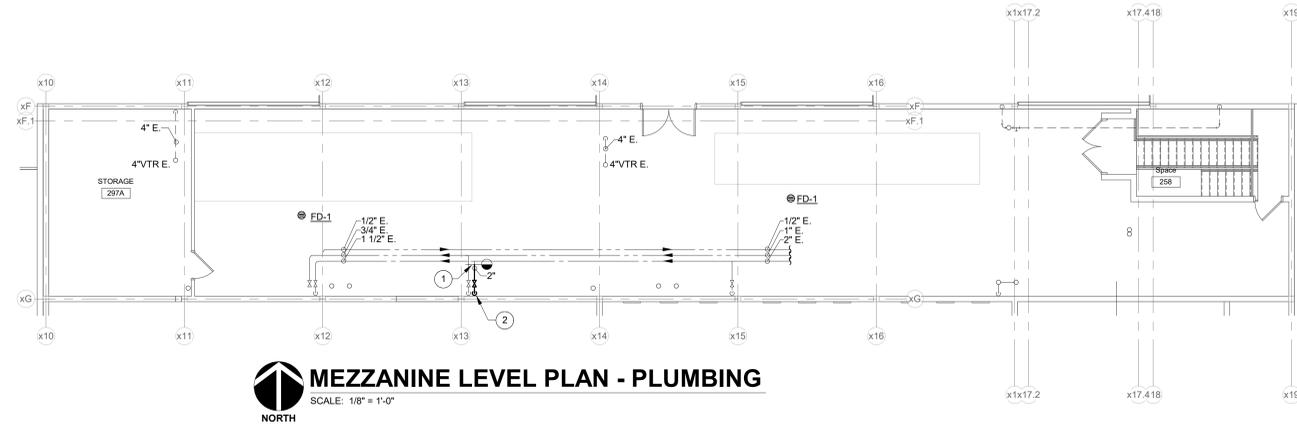

MEZZANINE LEVEL PLAN - PLUMBING
SCALE: 1/8" = 1'-0"
NORTH

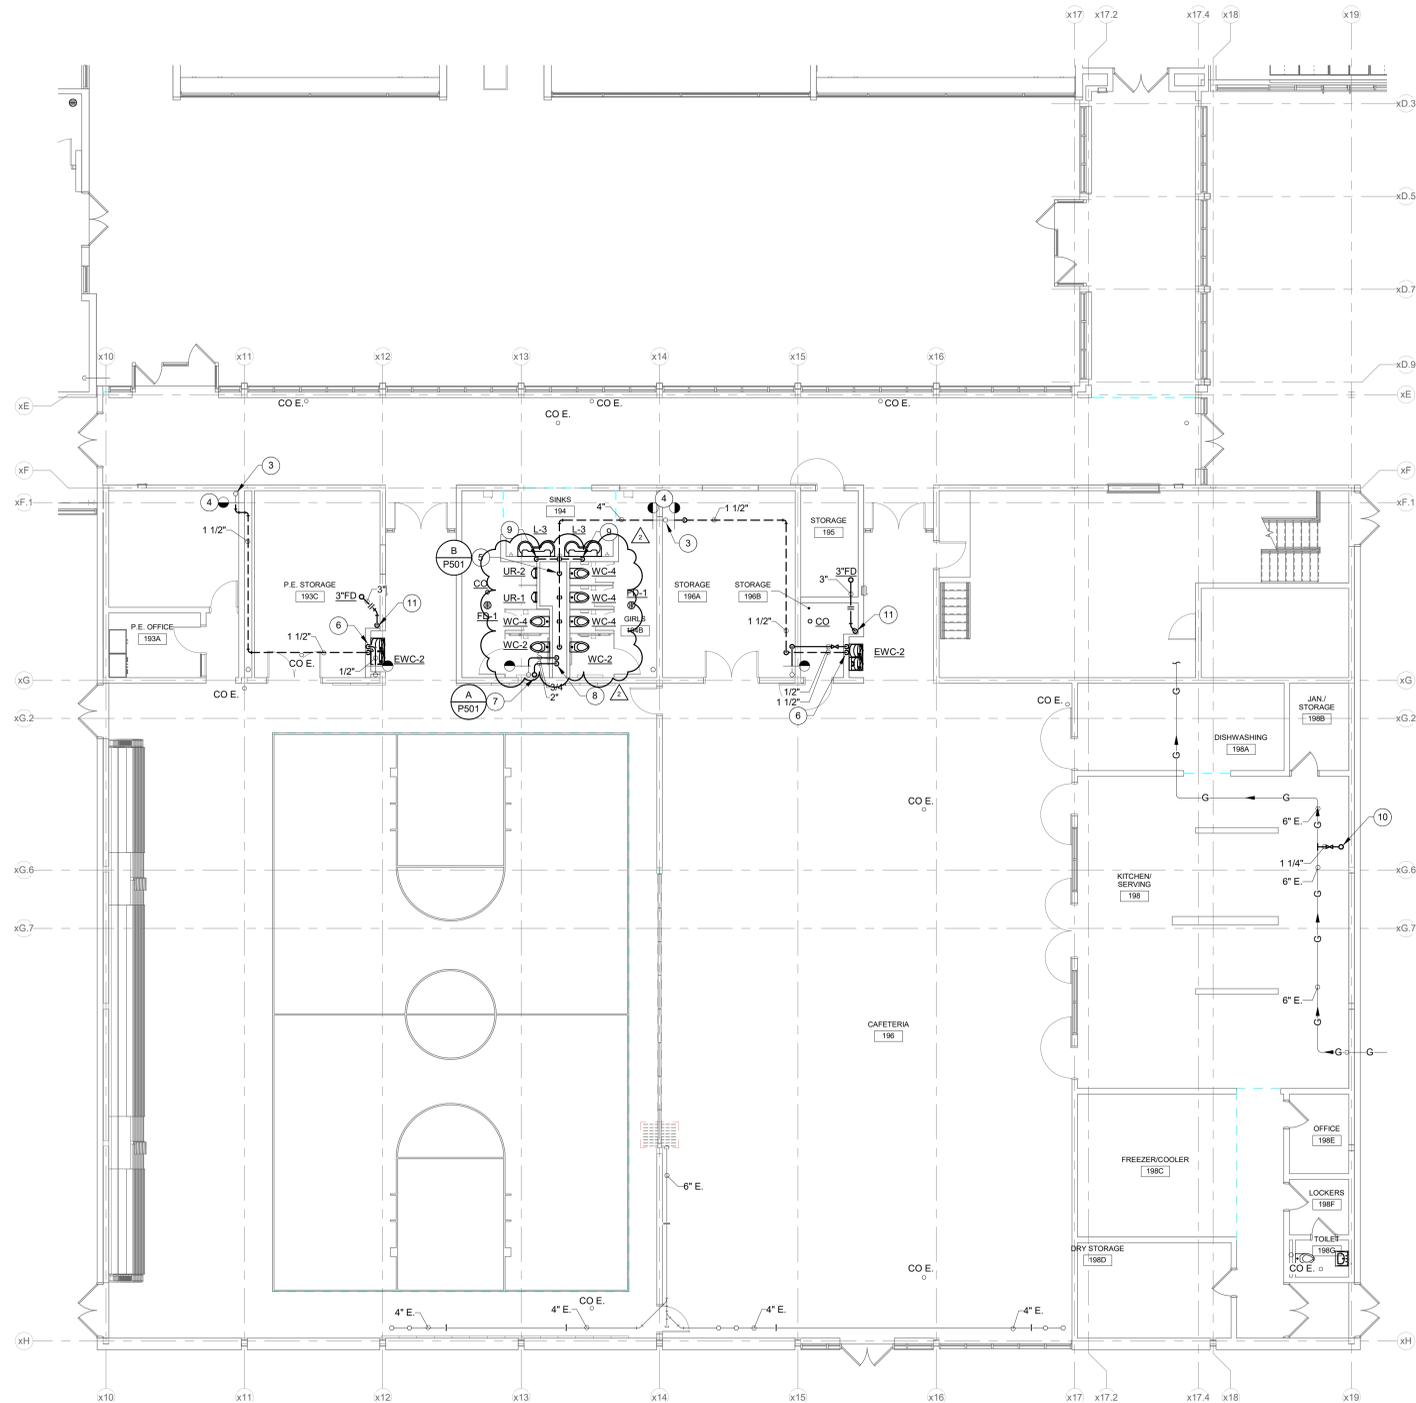


FIRST FLOOR - UNIT D - PLUMBING
SCALE: 1/8" = 1'-0"
NORTH



- RENOVATION LEGEND:**
- WORK TO BE INSTALLED
 - WORK TO REMAIN
- GENERAL NOTES:**
1. REFER TO SHEET PM001 FOR ADDITIONAL GENERAL NOTES.

- PLAN NOTES:**
1. CONNECT NEW 2" COLD WATER TO EXISTING 2" MAIN.
 2. 2" COLD WATER DOWN.
 3. EXISTING 4" VENT UP.
 4. CONNECT TO EXISTING VENT PIPING AT THIS POINT.
 5. 4" WASTE DOWN. 4" VENT UP.
 6. 1/2" COLD WATER AND 2" WASTE DOWN. 1 1/2" VENT UP.
 7. 2" COLD WATER AND EXISTING 3/4" HOT WATER FROM ABOVE.
 8. 2" COLD WATER AND EXISTING 3/4" HOT WATER DOWN.
 9. 2" WASTE DOWN. 1 1/2" VENT UP.
 10. 1 1/4" GAS UP.
 11. 3" WASTE DOWN.

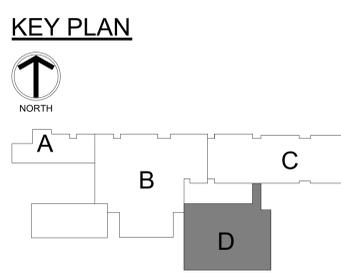

BCSC
TOGETHER WE LEARN

CSO

8831 Keystone Crossing, Indianapolis, IN 46240
317.847.7800 | CSOinc.net
© 2015 CSO Architects, Inc. All Rights Reserved.

DCA #22054

R.E. Dimond
and Associates, Inc.
Consulting Engineers

732 North Capitol Avenue
Indianapolis, IN 46204
Phone: (317) 634-4672
Fax: (317) 638-8725

PROJECT:

**BARTHOLOMEW CONSOLIDATED
SCHOOL CORPORATION
RENOVATIONS TO
L. C. SCHMITT ELEMENTARY**
2675 California St., Columbus, IN 47201

SCOPE DRAWINGS:

These drawings indicate the general scope of the project in terms of mechanical design concepts, the structure of electrical, mechanical and electrical systems. The drawings do not necessarily indicate or describe all work required for the performance and completion of the project. On the basis of the general scope indicated on drawings, the trade contractors shall furnish all items required for the proper execution and completion of the work.

REVISIONS:

2	ADDENDUM #2	03/15/2024
---	-------------	------------

ISSUE DATE	DRAWN BY	CHECKED BY
02/16/2024	AMB	DED

DRAWING TITLE:

**FIRST FLOOR
PLAN - UNIT D -
PLUMBING**

CERTIFIED BY:

REGISTERED PROFESSIONAL ENGINEER
No. **PE60910351**
STATE OF INDIANA
David E. Dimond
02/16/2024

DRAWING NUMBER
P201D

PROJECT NUMBER
22054

RENOVATION LEGEND:


- WORK TO BE INSTALLED
- WORK TO REMAIN

GENERAL NOTES:

1. REFER TO SHEET PM001 FOR ADDITIONAL GENERAL NOTES.

PLAN NOTES:


1. 1" COLD WATER FROM BELOW. 4" WASTE STACK. 2 1/2" VENT STACK. 4" VENT THROUGH ROOF.
2. 1/2" COLD WATER AND 1/2" HOT WATER FROM BELOW. 2" COMBINATION WASTE AND VENT STACK DOWN. 2" VENT UP.
3. 1/2" COLD WATER FROM BELOW. 2" COMBINATION WASTE AND VENT STACK DOWN. 2" VENT UP.
4. 1" COLD WATER FROM BELOW. 4" WASTE STACK. 2 1/2" VENT STACK UP.
5. 4" STORM DOWN.
6. 3/4" COLD WATER AND 3/4" HOT WATER FROM BELOW. 3" COMBINATION WASTE AND VENT STACK DOWN. 3" VENT UP.

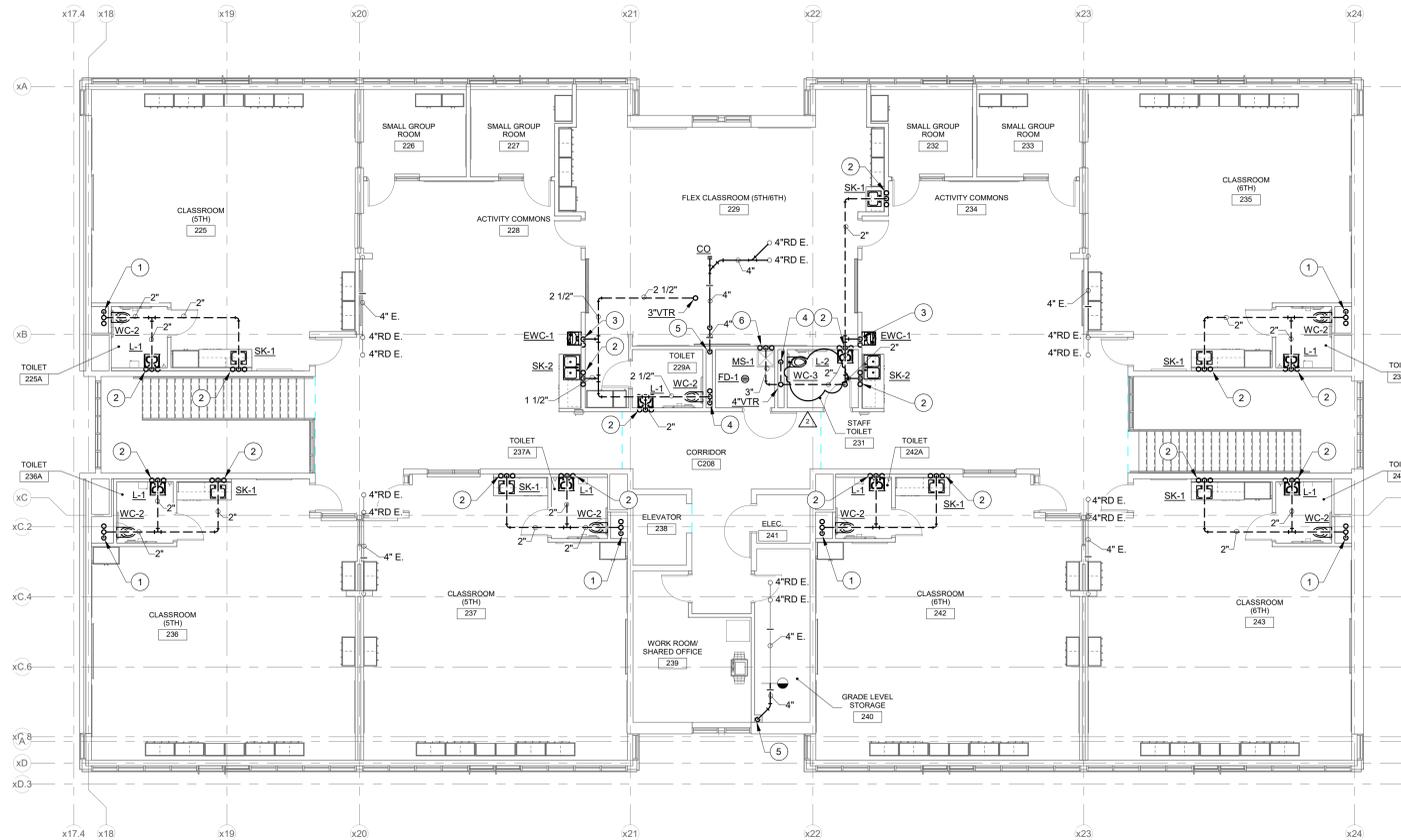

SECOND FLOOR - UNIT C - PLUMBING
SCALE: 1/8" = 1'-0"
NORTH



KEY PLAN

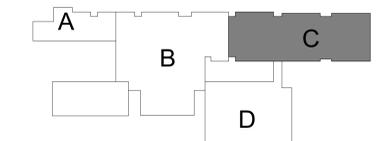

8831 Keystone Crossing, Indianapolis, IN 46240
317.847.7800 | 5061McIntire
© 2011 CSO Architects, Inc. All Rights Reserved.



R.E. Dimond
and Associates, Inc.
Consulting Engineers

732 North Capitol Avenue
Indianapolis, IN 46204
Phone: (317) 634-4672
Fax: (317) 638-8725


PROJECT:
**BARTHOLOMEW CONSOLIDATED
SCHOOL CORPORATION
RENOVATIONS TO
L. C. SCHMITT ELEMENTARY**
2675 California St, Columbus, IN 47201

SCOPE DRAWINGS:
These drawings indicate the general scope of the project in terms of mechanical design concept, the structure of mechanical, electrical and electrical systems.
The drawings do not necessarily indicate or describe all work required for full performance and completion of the project.
On the basis of the general scope indicated on drawings, the trade contractors shall furnish all items required for the proper execution and completion of the work.

REVISIONS:
2 ADDENDUM #2 03/15/2024

ISSUE DATE	DRAWN BY	CHECKED BY
02/16/2024	AMB	DED

DRAWING TITLE:
**SECOND FLOOR
PLAN - UNIT C -
PLUMBING**

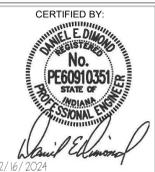

DRAWING NUMBER
P202C

PROJECT NUMBER
22054

PLUMBING EQUIPMENT SCHEDULE									
MARK NO.	SPECIFICATION NAME	MANUFACTURER & MODEL NO.	ELECTRICAL DATA			GAS LOAD INPUT - BTU	WT.	CAPACITY	REMARKS
			LOAD	VOLTS	PHASE				
SI-A	SOLIDS INTERCEPTOR	ZURN Z1180	-	-	-	-	-	1-1/2" INLET AND OUTLET CONNECTIONS	KEEP MIN 6" OF CLEARANCE FOR SCREEN REMOVAL, LOCATED IN ART ROOM
GD-A	GARBAGE DISPOSAL	INSINKERATOR BADGER 5	3/4 HP	115	1 PH	-	-	-	COORDINATE WITH GENERAL CONTRACTOR
-	-	-	-	-	-	-	-	-	-

FIXTURE ROUGH-IN SCHEDULE & MOUNTING HEIGHTS									
MARK NO.	FIXTURE DESCRIPTION	HW	CW	TRAP	W	V	MOUNTING HEIGHTS		
							W	V	W
WC-1	WATER CLOSET - WALL HUNG, FLUSH VALVE, CHILD HEIGHT	-	1"	INTEGRAL	4"	2"	15" TO SEAT		
WC-2	WATER CLOSET - WALL HUNG, FLUSH VALVE, CHILD HEIGHT, ADA	-	1"	INTEGRAL	4"	2"	15" TO SEAT		
WC-3	WATER CLOSET - WALL HUNG, FLUSH VALVE, ADA	-	1"	INTEGRAL	4"	2"	17" TO SEAT		
WC-4	WATER CLOSET - WALL HUNG, FLUSH VALVE, CHILD HEIGHT (SEE NOTE #1)	-	1"	INTEGRAL	4"	2"	15" TO SEAT		
UR-1	URINAL - CHILD HEIGHT (SEE NOTE #1)	-	3/4"	INTEGRAL	2"	1 1/2"	17" TO RIM		
UR-2	URINAL - CHILD HEIGHT, ADA (SEE NOTE #1)	-	3/4"	INTEGRAL	2"	1 1/2"	14" TO RIM		
L-1	LAVATORY - WALL HUNG, CHILD HEIGHT, ADA	1/2"	1/2"	1 1/4"	1 1/2"	1 1/2"	31" TO TOP OF RIM		
L-2	LAVATORY - WALL HUNG, ADA	1/2"	1/2"	1 1/4"	1 1/2"	1 1/2"	34" TO TOP OF RIM		
L-3	LAVATORY - 2-USER, WALL HUNG	1/2"	1/2"	1 1/4"	1 1/2"	1 1/2"	31" TO LOWEST RIM		
SK-1	SINGLE BOWL SINK - CLASSROOMS, ADA	1/2"	1/2"	1 1/2"	1 1/2"	1 1/2"	DROP-IN COUNTER MOUNT		
SK-2	DOUBLE BOWL SINK - ACTIVITY COMMONS	1/2"	1/2"	1 1/2"	1 1/2"	1 1/2"	DROP-IN COUNTER MOUNT		
SK-3	SINGLE BOWL SINK - CLINIC, ADA	1/2"	1/2"	1 1/4"	1 1/2"	1 1/2"	DROP-IN COUNTER MOUNT		
SK-4	SINGLE BOWL SINK - MOTHERS ROOM, ADA	1/2"	1/2"	1 1/4"	1 1/2"	1 1/2"	DROP-IN COUNTER MOUNT		
SK-5	SINGLE BOWL SINK - STAFF DINING, ADA	1/2"	1/2"	1 1/4"	1 1/2"	1 1/2"	DROP-IN COUNTER MOUNT		
SK-6	SINGLE COMPARTMENT SINK WITH LEGS	1/2"	1/2"	1 1/4"	1 1/2"	1 1/2"	PROVIDE SOLIDS INTERCEPTOR BELOW SINK		
SK-7	SINGLE BOWL ART SINK - ADA	1/2"	1/2"	1-1/2"	1-1/2"	1-1/2"	DROP-IN COUNTER MOUNT, PROVIDE SOLIDS INTERCEPTOR IN ADJACENT CASEWORK		
SK-8	SINGLE COMPARTMENT SINK WITH LEGS	1/2"	1/2"	1 1/4"	1 1/2"	1 1/2"	-		
SK-9	SINGLE BOWL ART SINK - ADA	1/2"	1/2"	1-1/2"	1-1/2"	1-1/2"	DROP-IN COUNTER MOUNT		
EW-1	WATER COOLER W/BOTTLE FILLER - CHILD HEIGHT, ADA	-	1/2"	1 1/4"	1 1/2"	1 1/2"	32" TO BUBBLER		
EW-2	WATER COOLER W/BOTTLE FILLER - HILO CHILD HEIGHT, ADA	-	1/2"	1 1/4"	1 1/2"	1 1/2"	32" TO LO BUBBLER, 44" TO HI BUBBLER		
MS-1	MOP SINK	3/4"	3/4"	3"	3"	2"	MOUNT FAUCET 36" ABOVE FINISHED FLOOR		
IMB-1	ICE MAKER OUTLET BOX	-	1/2"	-	-	-	24"		
WB-1	WASHING MACHINE OUTLET BOX	3/4"	3/4"	2"	2"	2"	42" TO TOP OF BOX		
HYD-1	WALL HYDRANT - NON FREEZE	-	3/4"	-	-	-	24" A.F.F.		
HB-1	HOSE BIBB - INTERIOR USE	-	3/4"	-	-	-	24" A.F.F.		

NOTES:
1. AUTOMATIC FLUSH VALVE TO BE REUSED FROM EXISTING FIXTURE.

WATER HAMMER ARRESTER SCHEDULE						
TYPE	I.P.S.	F.U. RATING	J.R. SMITH NO.	WADE NO.	ZURN NO.	REMARKS
A	3/4"	1 - 11	5005	W-5	100	P.D.I. CERTIFIED
B	1"	12 - 32	5010	W-10	200	P.D.I. CERTIFIED
C	1"	33 - 60	5020	W-20	300	P.D.I. CERTIFIED
D	1"	61 - 113	5030	W-50	400	P.D.I. CERTIFIED



CSO
 8831 Keystone Crossing, Indianapolis, IN 46240
 317.846.7800 | CSOinc.net
 © 2015 CSO Architects, Inc. All Rights Reserved.

DNA #22054
R.E. Dimond
 and Associates, Inc.
 Consulting Engineers
 732 North Capitol Avenue
 Phone: (317) 634-4672
 Fax: (317) 638-8725

PROJECT:
BARTHOLOMEW CONSOLIDATED SCHOOL CORPORATION RENOVATIONS TO L. C. SCHMITT ELEMENTARY
 2675 California St, Columbus, IN 47201

SCOPE DRAWINGS:
 These drawings indicate the general scope of the project in terms of mechanical design concepts, the structure of mechanical, electrical and electrical systems.
 The drawings do not necessarily indicate or describe all work required for full performance and completion of the project.
 On the basis of the general scope indicated on drawings, the trade contractors shall furnish all items required for the proper execution and completion of the work.

REVISIONS:
 2 ADDENDUM #2 03/15/2024


ISSUE DATE	DRAWN BY	CHECKED BY
02/16/2024	AMB	DED

DRAWING TITLE:
SCHEDULES - PLUMBING




DRAWING NUMBER
P601

PROJECT NUMBER
22054

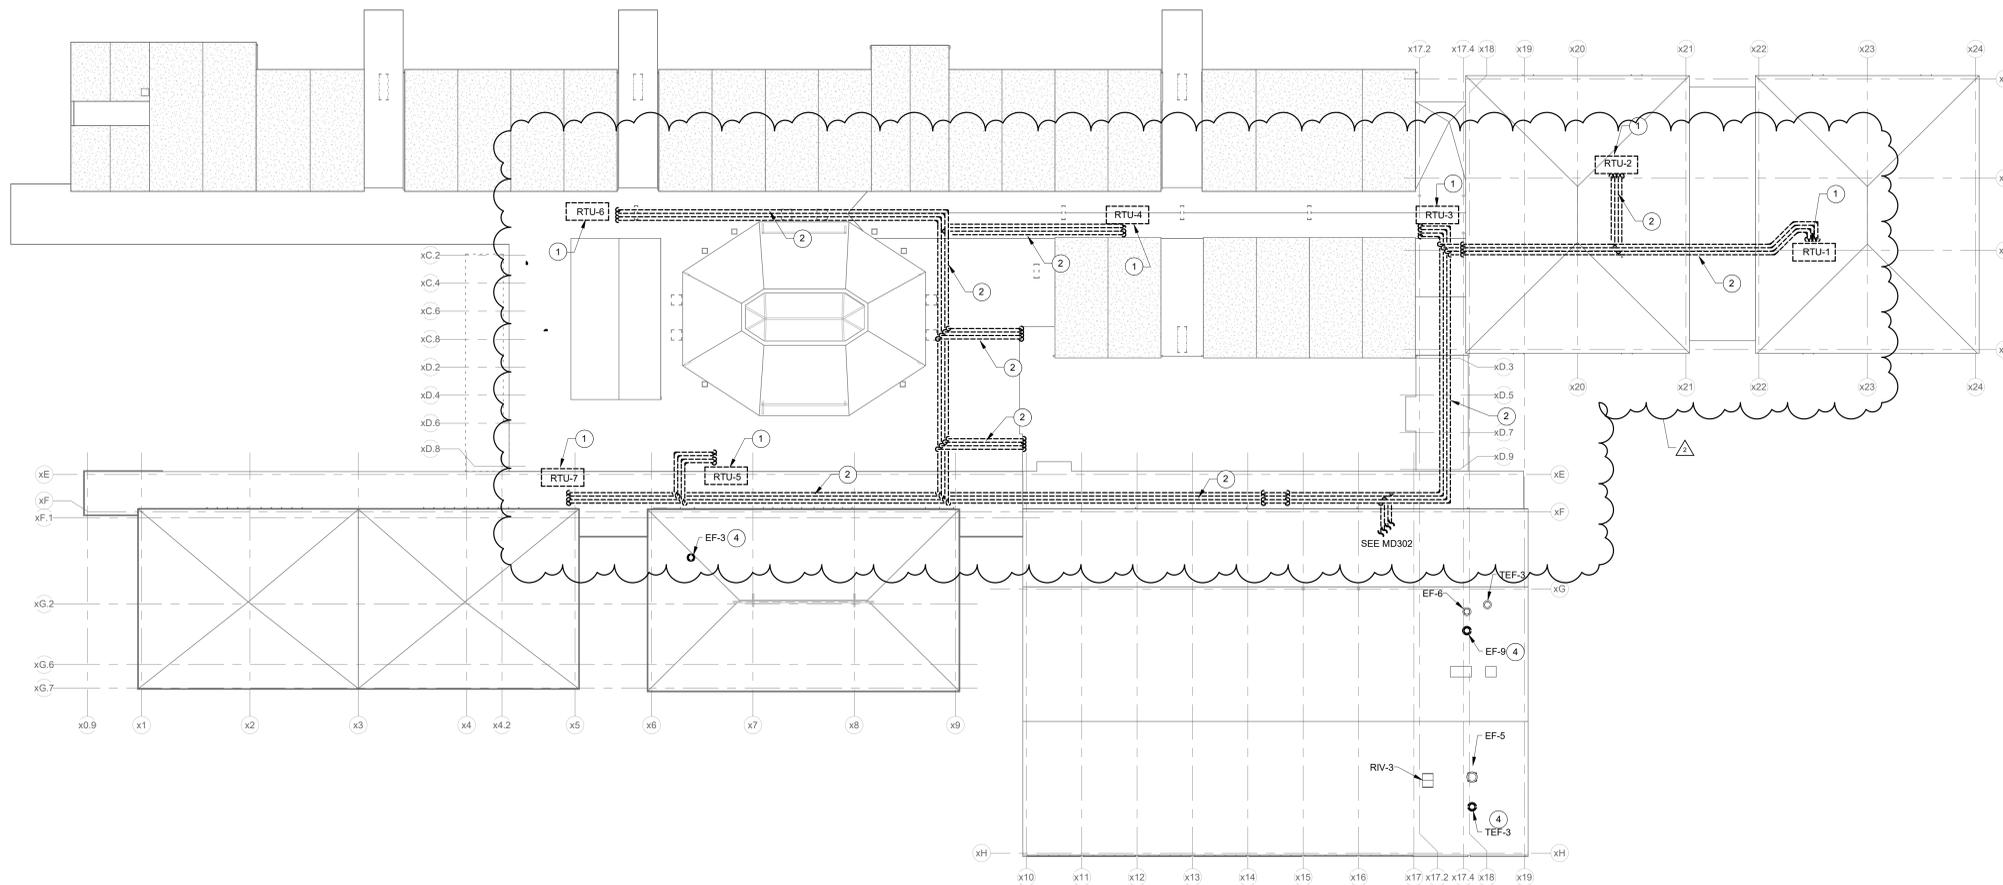


ROOF PLAN - HYDRONIC DEMOLITION
SCALE: 1" = 20'-0"

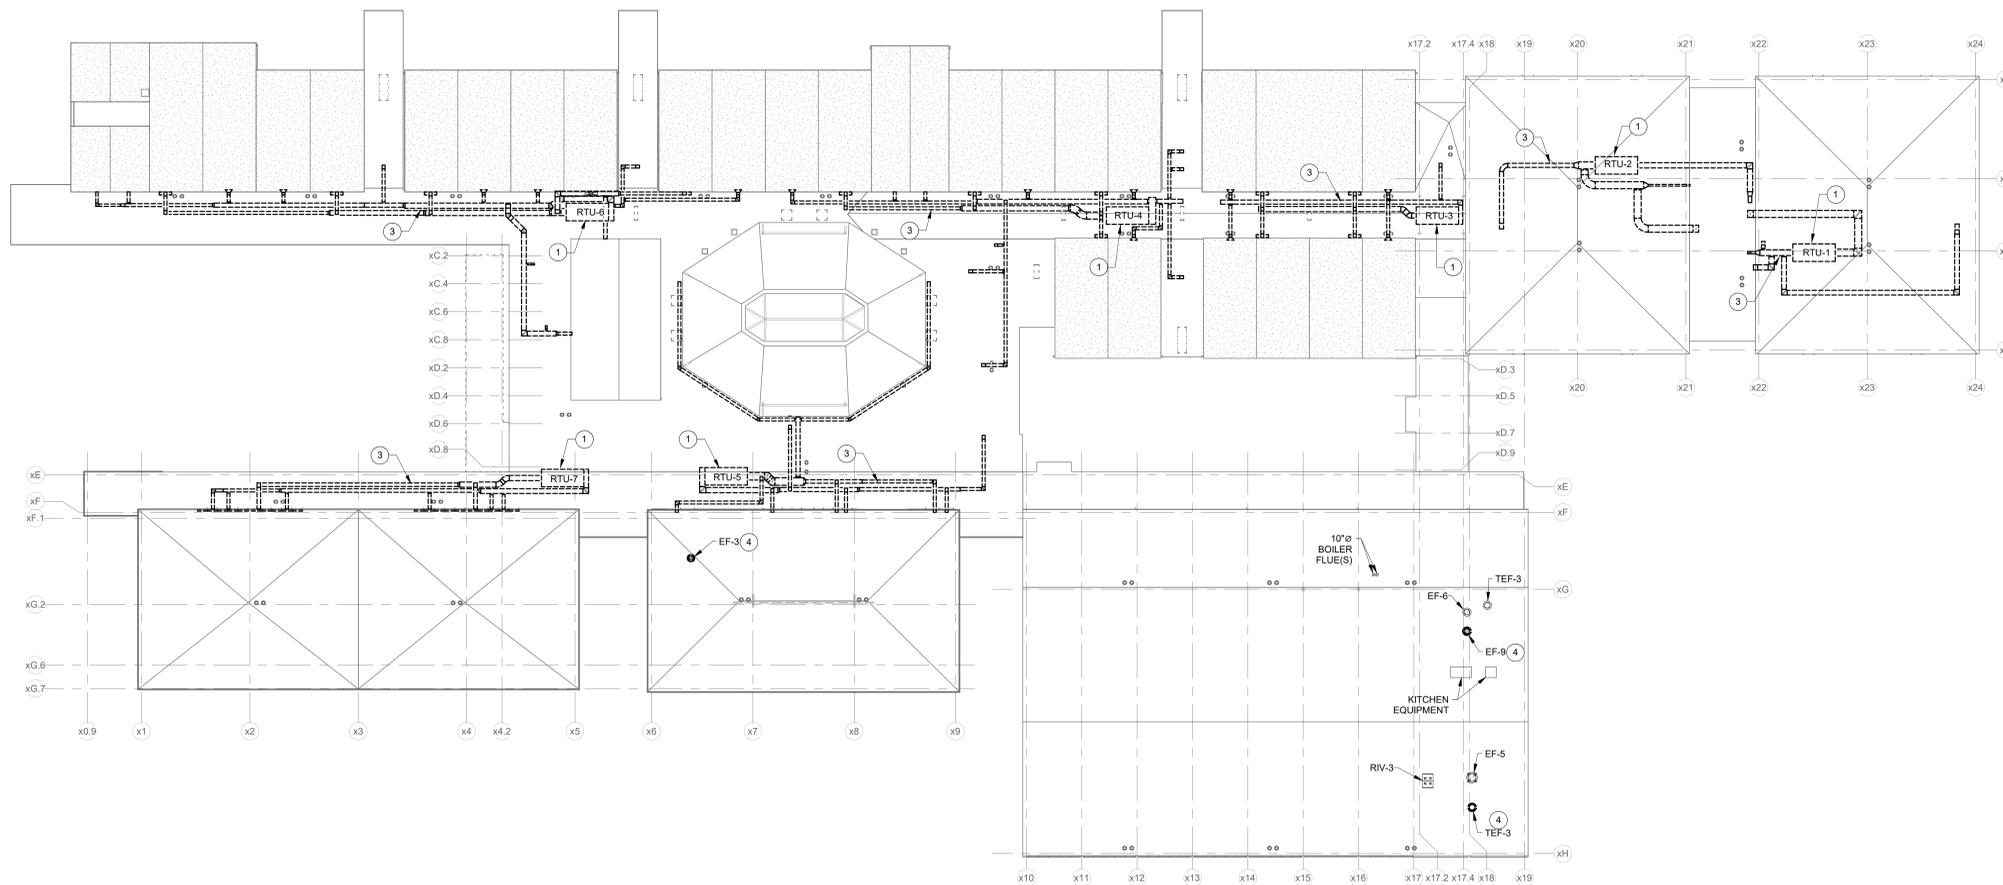

ROOF PLAN - AIR DISTRIBUTION DEMOLITION
SCALE: 1" = 20'-0"



KEY PLAN

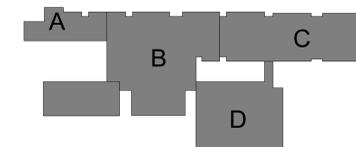

DEMOLITION LEGEND:

- WORK TO BE REMOVED
- WORK TO REMAIN

GENERAL NOTES - DEMOLITION:

1. ALSO SEE MD200 FOR ADDITIONAL GENERAL NOTES.

PLAN NOTES:

1. REMOVE ALL RTUs ON ROOF COMPLETE.
2. REMOVE ALL HYDRONIC PIPING ON ROOF COMPLETE.
3. REMOVE ALL SHEET METAL ON ROOF COMPLETE.
4. REMOVE EXHAUST FAN COMPLETE.

SCOPE DRAWINGS:
These drawings indicate the general scope of the project in terms of mechanical design concepts, the arrangement of structural, mechanical and electrical systems. The drawings do not necessarily indicate or describe all work required for the performance and completion of the project. On the basis of the general scope indicated on drawings, the trade contractors shall furnish all items required for the proper execution and completion of the work.

REVISIONS:
2 ADDENDUM #2 03/15/2024

ISSUE DATE	DRAWN BY	CHECKED BY
02/16/2024	ACB	WCE

DRAWING TITLE:
**ROOF PLAN -
MECHANICAL
DEMOLITION**

CERTIFIED BY:
L. E. DIMOND
No. PE60910351
STATE OF INDIANA
Professional Engineer
L. E. Dimond
02/16/2024

DRAWING NUMBER
MD220

PROJECT NUMBER
22054

DEMOLITION LEGEND:


- WORK TO BE REMOVED
- WORK TO REMAIN

GENERAL NOTES - DEMOLITION:


1. ALSO SEE MD200 FOR ADDITIONAL GENERAL NOTES.

PLAN NOTES:

1. REMOVE AHUs COMPLETE INCLUDING SHEETMETAL, PIPING, CONDENSATE DRAIN, CONTROLS, AND CONCRETE PAD.
2. REMOVE MECHANICAL EQUIPMENT COMPLETE.
3. REMOVE PIPING AND SHEET METAL BACK TO WHERE SHOWN INCLUDING DUCT MOUNTED REHEAT COILS.

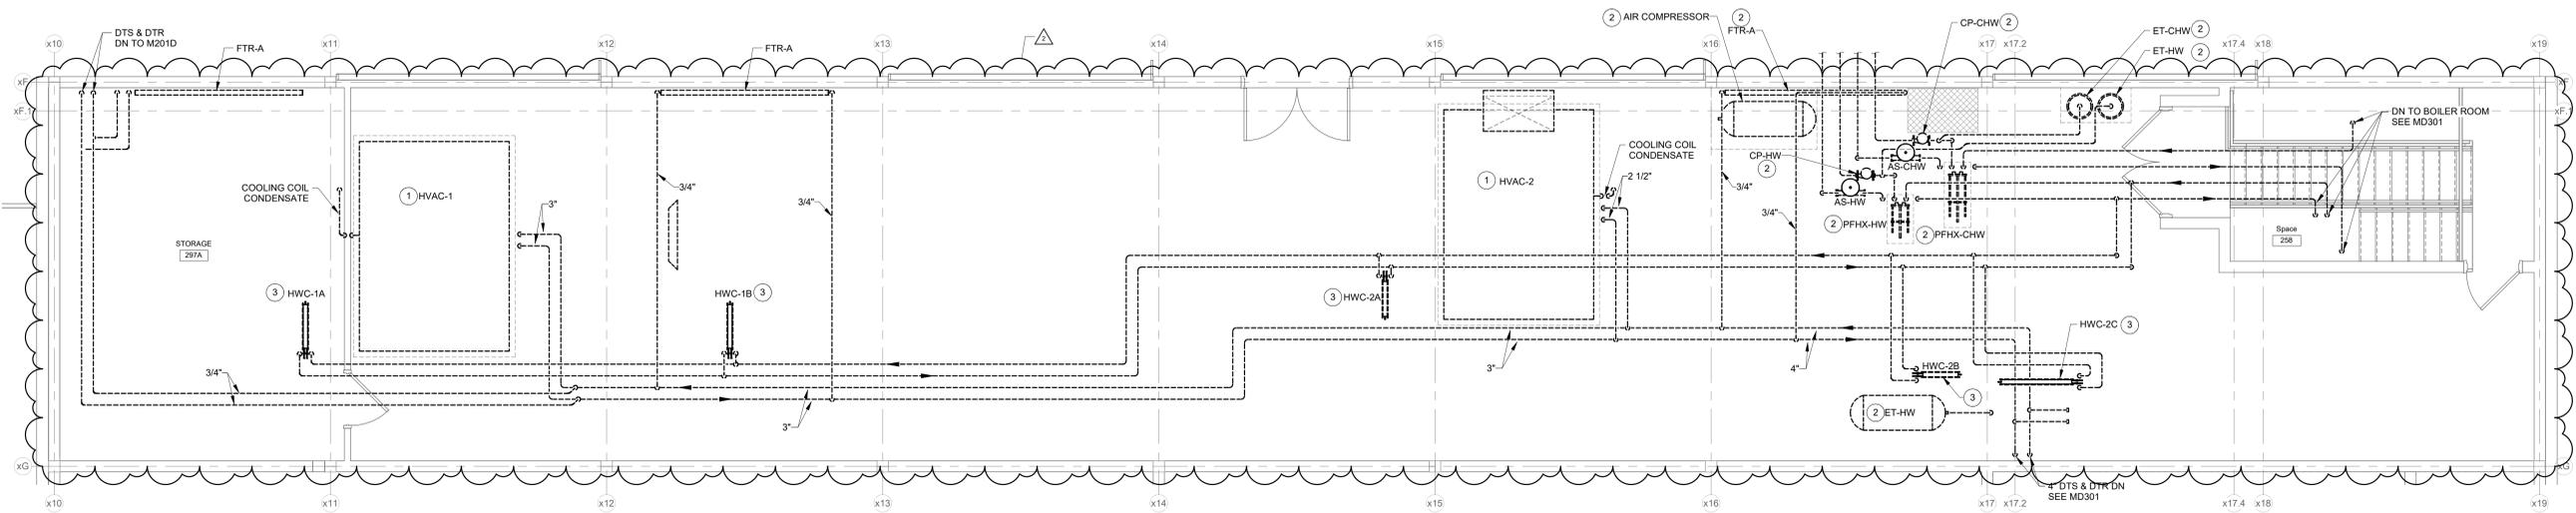

MEZZANINE LEVEL PLAN - HYDRONIC DEMOLITION
SCALE: 1/4" = 1'-0"
NORTH


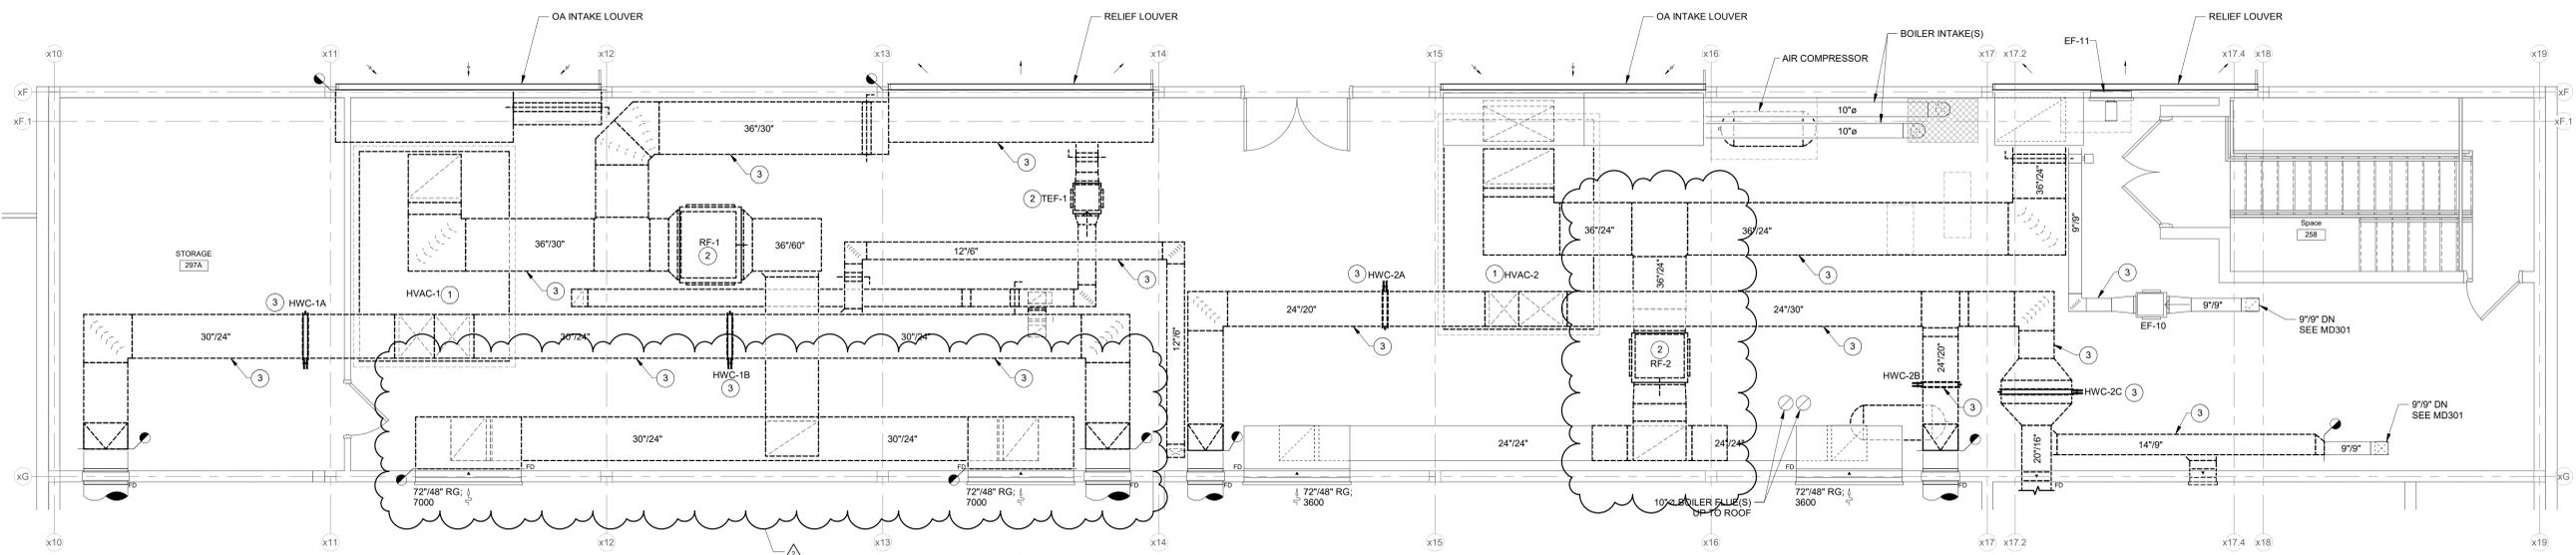


MEZZANINE LEVEL PLAN - AIR DISTRIBUTION DEMOLITION
SCALE: 1/4" = 1'-0"
NORTH

KEY PLAN



NORTH

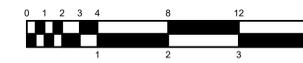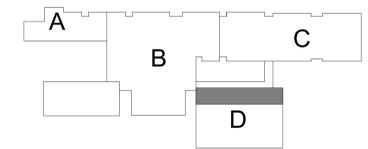

RENOVATION LEGEND:


- WORK TO BE INSTALLED
- WORK TO REMAIN

GENERAL NOTES - MECHANICAL


1. SEE SHEET M200 FOR ADDITIONAL GENERAL NOTES.

PLAN NOTES:


1. 1-1/4" CHILLED WATER SUPPLY / RETURN, 1" HEATING WATER SUPPLY / RETURN, AND 1" CONDENSATE DRAIN DN TO TUNNEL. SEE M200.
2. HYDRONIC / CONDENSATE PIPING ROUTED IN EXISTING TRENCH TO TUNNEL. SEE M200.
3. HEATING WATER SUPPLY / HEATING WATER RETURN DN NEW TRENCH. SEE M200.
4. 1" CONDENSATE DRAIN DN TO NEW TRENCH. SEE M200.
5. OA DUCTWORK UP THRU ROOF FOR VENTILATION AIR. SEE 'J' / M401.
6. LOUVER IN CLERESTORY WINDOWS FOR VENTILATION AIR. SEE ARCHITECTURE DRAWINGS.
7. ROUTE CONDENSATE TO FLOOR DRAIN BEHIND UNIT. SEE 'P' SERIES DRAWINGS FOR DRAIN LOCATION.
8. TERMINATE 1" CONDENSATE DRAIN OUT WALL.
9. 3" WIDE HEAVY DUTY LINEAR BAR GRILLE MOUNTED IN TOP OF FURRED WALL BEHIND CASEWORK. SEE SECTION 'A' / M304 FOR DETAILS. LINEAR BAR GRILLE TO BE LIKE PRICE MODEL LBPH, 3" WIDE, 1/4" BAR SPACING, 0" DEFLECTION, 3/4" FLANGE WIDTH AND SPRING CLIP MOUNTING. LENGTH AS NOTED ON PLANS. FINISH TO BE CUSTOM COLOR SELECTED BY ARCHITECT.
10. PROVIDE FTR-B WITH ENCLOSURE. VERIFY DIMENSIONS IN FIELD.
11. ROUTE HYDRONIC PIPING IN FTR-B STYLE ENCLOSURE. NO HEATING ELEMENT REQUIRED.
12. PROVIDE ADDITIONAL FTR-B STYLE ENCLOSURE. NO HEATING ELEMENT REQUIRED.
13. ROUTE HYDRONIC PIPING IN CONTRACTOR PROVIDED SHEET METAL ENCLOSURE.
14. PROVIDE BACKDRAFT DAMPER IN RELIEF AIR DUCT.

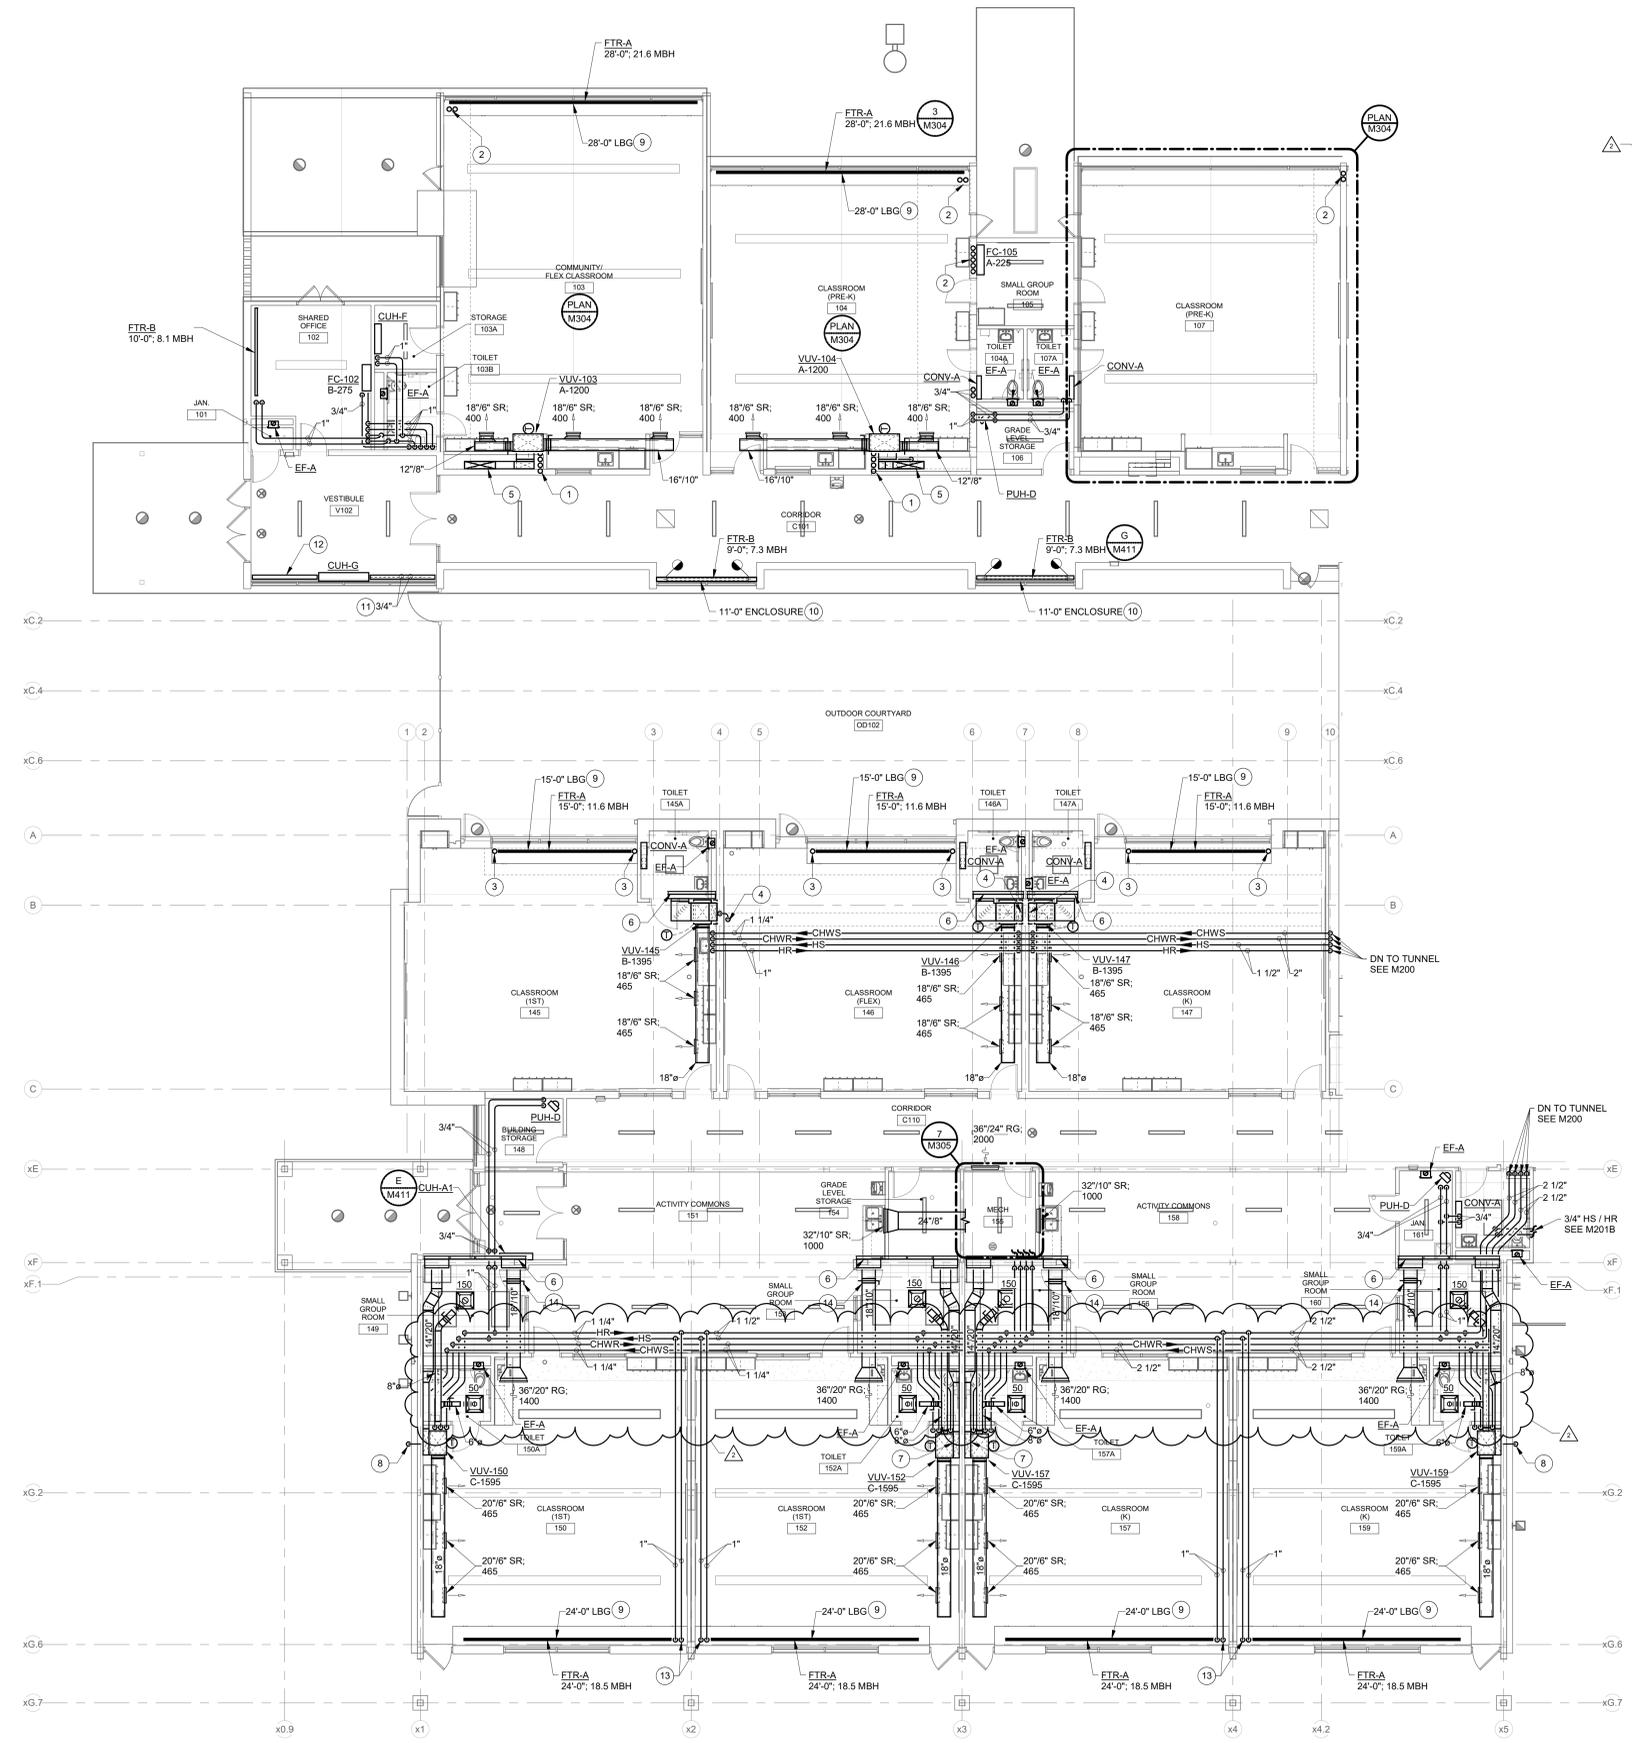


FIRST FLOOR - UNIT A - MECHANICAL
SCALE: 1/8" = 1'-0"

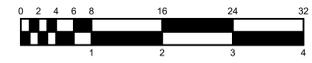

KEY PLAN

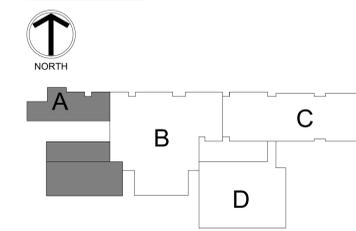

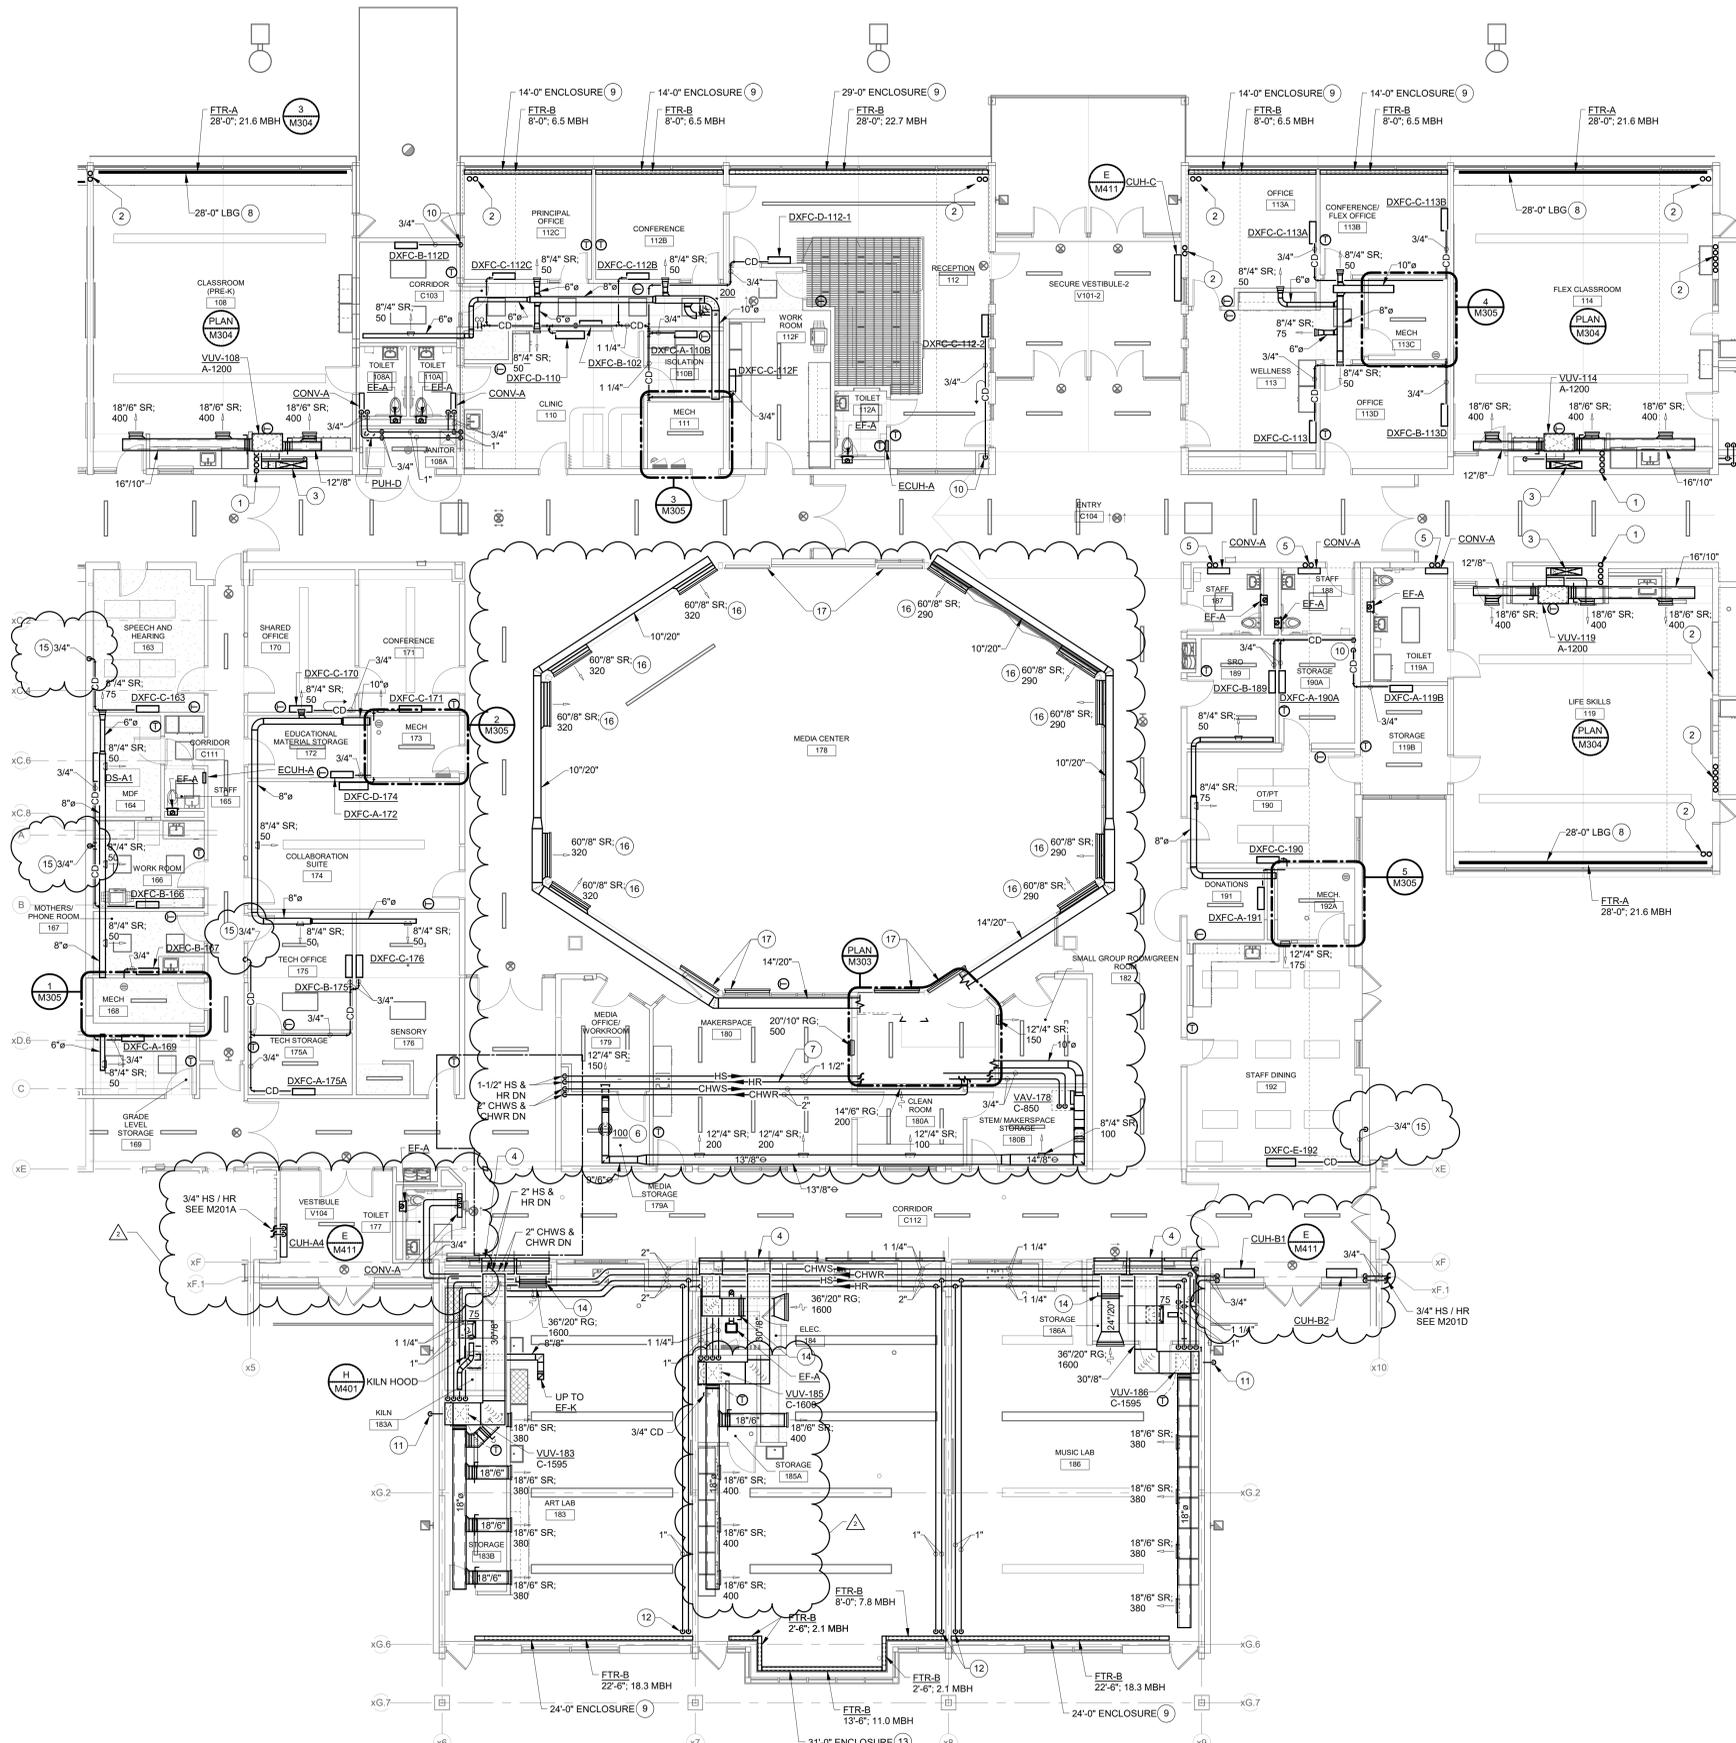


RENOVATION LEGEND:

- WORK TO BE INSTALLED
- WORK TO REMAIN

GENERAL NOTES - MECHANICAL

1. SEE SHEET M200 FOR ADDITIONAL GENERAL NOTES.
2. 1-1/4" CHILLED WATER SUPPLY / RETURN, 1" HEATING WATER SUPPLY / RETURN, AND 1" CONDENSATE DRAIN DN TO TUNNEL. SEE M200.
3. 0A DUCTWORK UP THRU ROOF FOR VENTILATION AIR. SEE 'J' / M401.
4. LOUVER FOR VENTILATION AIR. SEE ARCHITECTURAL DRAWINGS.
5. 3/4" HEATING WATER SUPPLY / RETURN DN TO TUNNEL.
6. ROUND CONE DIFFUSER LIKE PRIE RCD.
7. INSTALL HYDRONIC PIPING TIGHT TO BEAM AND DECK ABOVE.
8. 3" WIDE HEAVY DUTY LINEAR BAR GRILLE MOUNTED IN TOP OF FURRED WALL BEHIND CASEWORK. SEE SECTION 'A' / M304 FOR DETAIL. LINEAR BAR GRILLE TO BE LIKE PRICE MODEL LBPB, 3" WIDE, 1/4" BAR SPACING, 0° DEFLECTION, 3/4" FLANGE WIDTH AND SPRING CLIP MOUNTING. LENGTH AS NOTED ON PLANS. FINISH TO BE CUSTOM COLOR SELECTED BY ARCHITECT.
9. PROVIDE FTR-B WITH ENCLOSURE. VERIFY DIMENSIONS IN FIELD.
10. ROUTE CONDENSATE DOWN TO EXISTING TRENCH. PROVIDE SHEET METAL ENCLOSURE AS NEEDED.
11. TERMINATE 1" CONDENSATE DRAIN OUT WALL.
12. ROUTE HYDRONIC PIPING IN CONTRACTOR PROVIDED SHEET METAL ENCLOSURE.
13. PROVIDE FTR-B WITH ENCLOSURE. DIMENSION NOTED IS TOTAL ENCLOSURE LINEAR LENGTH. VERIFY DIMENSIONS IN FIELD.
14. PROVIDE BACKDRAFT DAMPER IN RELIEF AIR DUCT.
15. ROUTE CONDENSATE DOWN WALL IN EXISTING CONDENSATE PATHWAY TO TUNNEL BELOW.
16. LINEAR BAR GRILLE LIKE PRICE LBP CORE 16A WITH DAMPER. BALANCE TO NOTED CFM. VERIFY DIMENSIONS IN FIELD.
17. LINEAR BAR GRILLE LIKE PRICE LBP CORE 16A WITHOUT DAMPER. GRILLE TO NOT BE ACTIVE. VERIFY DIMENSIONS IN FIELD.

KEY PLAN

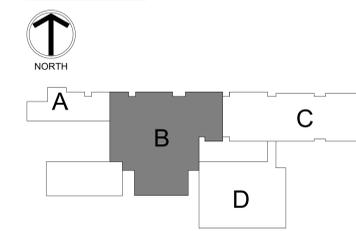

FIRST FLOOR - UNIT B - MECHANICAL
SCALE: 1/8" = 1'-0"




BARTHOLOMEW CONSOLIDATED SCHOOL CORPORATION
RENOVATIONS TO
L. C. SCHMITT ELEMENTARY
2675 California St, Columbus, IN 47201

SCOPE DRAWINGS:
These drawings indicate the general scope of the project. The contractor shall verify the location and condition of all existing mechanical and electrical systems. The drawings do not necessarily indicate or describe all work required for full performance and completion of the project. On the basis of the general scope indicated on drawings, the contractor shall furnish all items required for the proper installation and completion of the work.

REVISIONS:
2 ADDENDUM #2 03/15/2024

ISSUE DATE 02/16/2024
DRAWN BY ACG
CHECKED BY WCE

DRAWING TITLE:
FIRST FLOOR PLAN - UNIT B - MECHANICAL

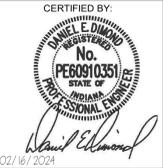

DRAWING NUMBER
M201B

PROJECT NUMBER
22054

RENOVATION LEGEND:


- WORK TO BE INSTALLED
- WORK TO REMAIN

GENERAL NOTES - MECHANICAL

1. SEE SHEET M200 FOR ADDITIONAL GENERAL NOTES.



PLAN NOTES:

1. 1-1/4" CHILLED WATER SUPPLY / RETURN, 1" HEATING WATER SUPPLY / RETURN, AND 1" CONDENSATE DRAIN DN TO TUNNEL. SEE M200.
2. HYDRONIC / CONDENSATE PIPING ROUTED IN EXISTING TRENCH TO TUNNEL. SEE M200.
3. DOWN TO TUNNEL LEVEL. SEE M200 FOR HYDRONIC PIPING CONTINUATION.
4. ROUTE 3/4" CONDENSATE TO MOP SINK IN JANITOR 130.
5. 3" WIDE HEAVY DUTY LINEAR BAR GRILLE MOUNTED IN TOP OF FURRED WALL BEHIND CASEWORK. SEE SECTION A / M304 FOR DETAILS. LINEAR BAR GRILLE TO BE LIKE PRICE MODEL LBPH, 3" WIDE, 1/4" BAR SPACING, 0" DEFLECTION, 3/4" FLANGE WIDTH AND SPRING CLIP MOUNTING LENGTH AS NOTED ON PLANS. FINISH TO BE CUSTOM COLOR SELECTED BY ARCHITECT.
6. PROVIDE FTR-B WITH ENCLOSURE. VERIFY DIMENSIONS IN FIELD.
7. PROVIDE 10"10" TRANSFER WITH FIRST DAMPER IN WALL.
8. PROVIDE FIRE DAMPER AT EACH FLOOR PENETRATION.
9. ROUTE 3/4" CONDENSATE TO MOP SINK IN JANITOR 130. TERMINATE WITH 90° FITTING ABOVE MOP SINK.
10. ROUTE HYDRONIC PIPING IN CONTRACTOR PROVIDED SHEET METAL ENCLOSURE.
11. PROVIDE FTR-B WITH ENCLOSURE. DIMENSION NOTED IS TOTAL ENCLOSURE LINEAR LENGTH. VERIFY DIMENSIONS IN FIELD.
12. OFFSET HYDRONIC PIPING BELOW STRUCTURE. INSTALL PIPING TIGHT TO STRUCTURE.
13. OUTSIDE AIR DUCT UP TO RIV ON ROOF. ROUTE OA DUCT TO BACK OF VUV FOR OA CONNECTION. SEE '1' / M310.
14. ROUTE CONDENSATE FROM SECOND FLOOR CONDENSATE DRAIN AND ADJACENT VUVs TO FLOOR DRAIN LOCATED BEHIND VUV. SEE 'P' SERIES FOR FD LOCATION.
15. SAW CUT AND PATCH FLOOR AS REQUIRED FOR HYDRONIC PIPING INSTALLATION.

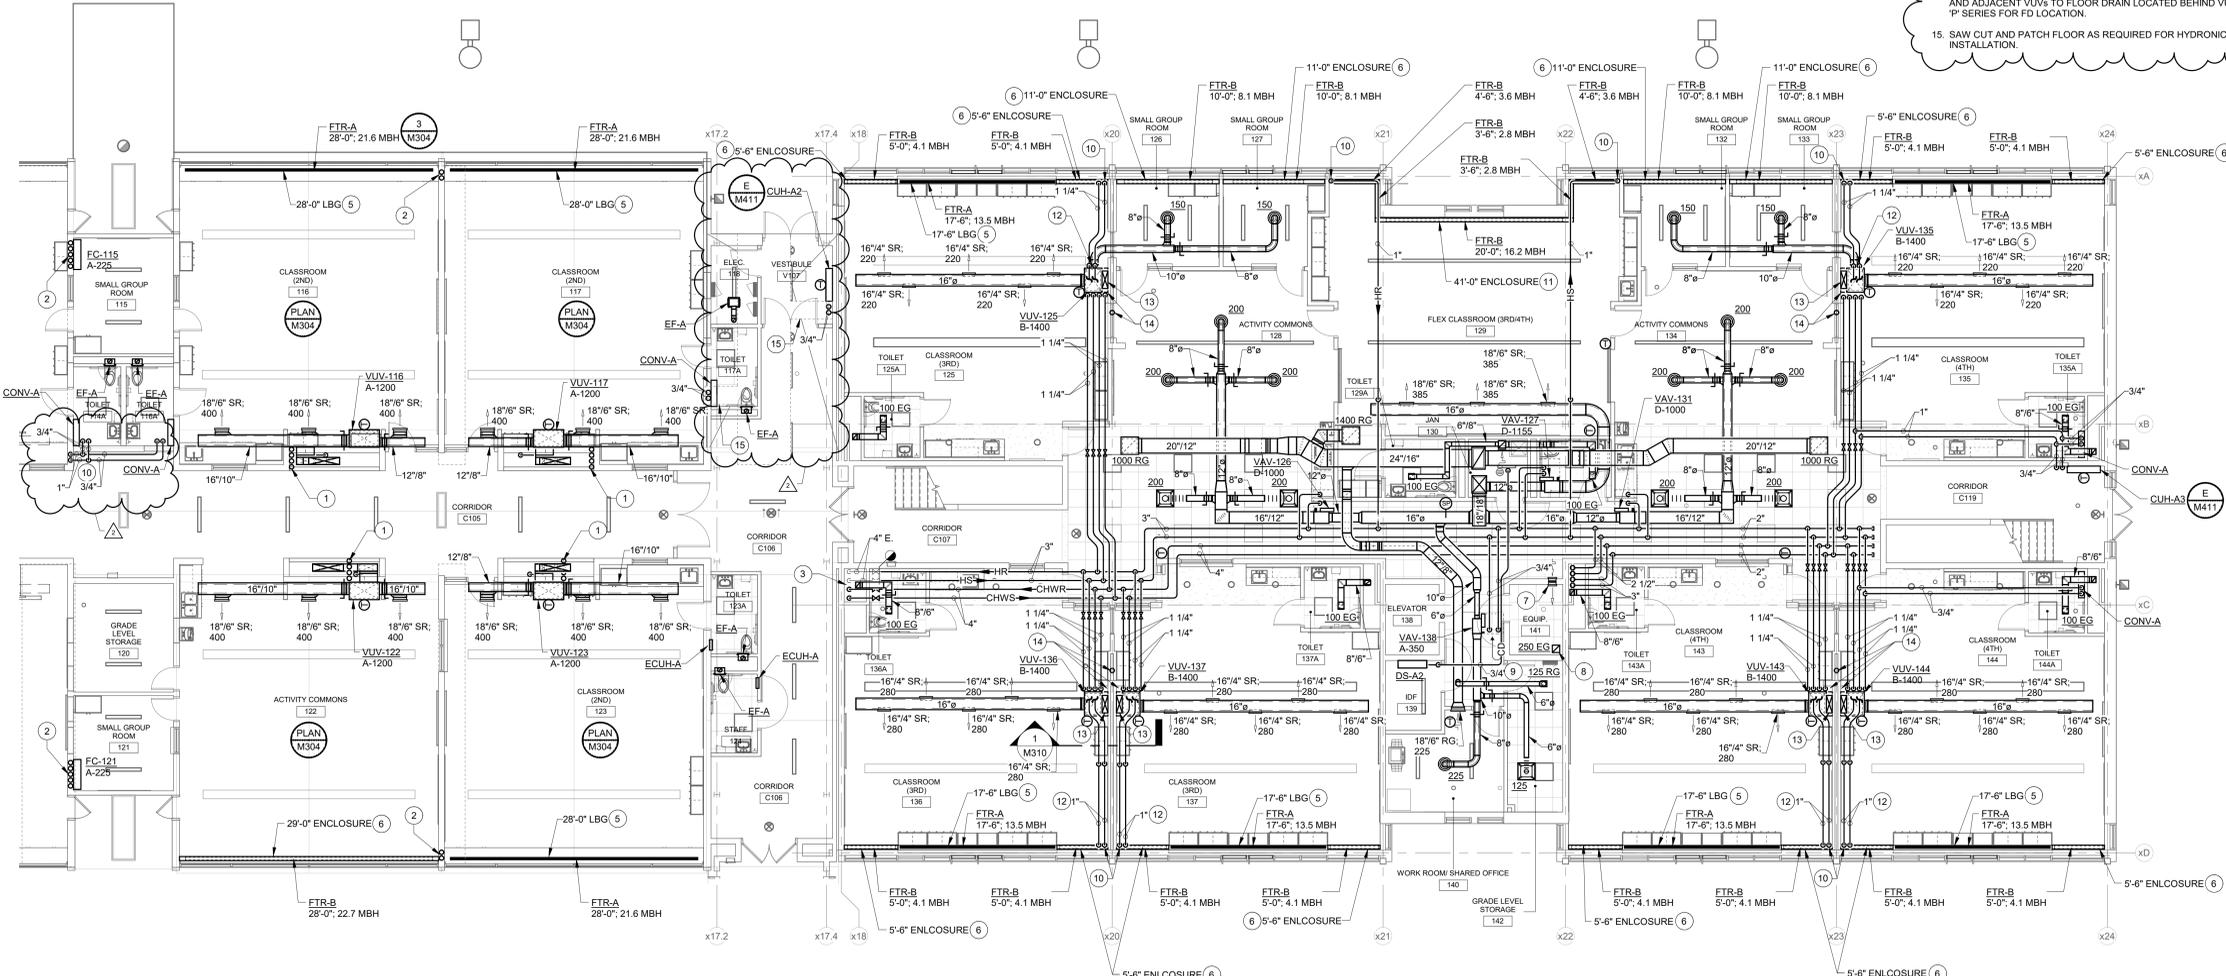

FIRST FLOOR - UNIT C - MECHANICAL
SCALE: 1/8" = 1'-0"
NORTH

KEY PLAN

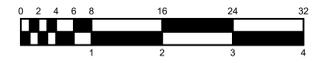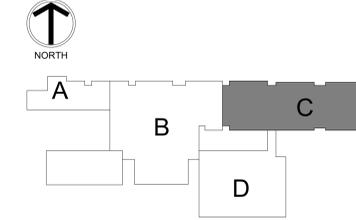

RENOVATION LEGEND:


- WORK TO BE INSTALLED
- WORK TO REMAIN

GENERAL NOTES - MECHANICAL

1. SEE SHEET M200 FOR ADDITIONAL GENERAL NOTES.



PLAN NOTES:

1. 2-1/2" CHWS / CHWR & 1-1/4" HS / HR PIPING UP TO AHU-4 PIPE CABINET ON ROOF. SEE M220.
2. 30"Ø30" SUPPLY DUCT UP TO AHU-4 ON ROOF.
3. 26"Ø44" RETURN DUCT UP TO AHU-4 ON ROOF.
4. INTERNALLY LINE ALL RETURN AIR DUCTWORK WITH 1" ACOUSTICAL DUCT LINER DOWN THRU SECOND FLOOR PENETRATION.
5. 3" WIDE HEAVY DUTY LINEAR BAR GRILLE MOUNTED IN TOP OF FURRED WALL BEHIND CASEWORK. SEE SECTION A / M304 FOR DETAILS. LINEAR BAR GRILLE TO BE LIKE PRICE MODEL LBPH, 3" WIDE, 1/4" BAR SPACING, 0" DEFLECTION, 3/4" FLANGE WIDTH AND SPRING CLIP MOUNTING. LENGTH AS NOTED ON PLANS. FINISH TO BE CUSTOM COLOR SELECTED BY ARCHITECT.
6. PROVIDE FTR-B WITH ENCLOSURE. VERIFY DIMENSIONS IN FIELD.
7. ROUTE HYDRONIC PIPING IN CONTRACTOR PROVIDED SHEET METAL ENCLOSURE.
8. PROVIDE FTR-B WITH ENCLOSURE. DIMENSION NOTED IS TOTAL ENCLOSURE LINEAR LENGTH. VERIFY DIMENSIONS IN FIELD.
9. PROVIDE FIRE DAMPER AT EACH FLOOR PENETRATION.
10. OFFSET HYDRONIC PIPING BELOW STRUCTURE. INSTALL PIPING TIGHT TO STRUCTURE.
11. OUTSIDE AIR DUCT UP TO RIV ON ROOF. ROUTE OA DUCT TO BACK OF VUV FOR OA CONNECTION. SEE 1" / M310.
12. 1-1/4" CONDENSATE DRAIN DOWN IN WALL CAVITY TO FLOOR DRAIN ON FIRST FLOOR. ROUTE CONDENSATE DRAIN FROM VUV DRIP PAN TO CONDENSATE DOWN WALL CAVITY. SEE 1" SERIES FOR FLOOR DRAIN LOCATION ON FIRST FLOOR.
13. AHU-4 TPC, SUPPLY FAN VFD, AND RETURN FAN VFD.
14. ROUTE 3/4" HS / HR TO EACH CONV-A IN EACH TOILET ROOM.

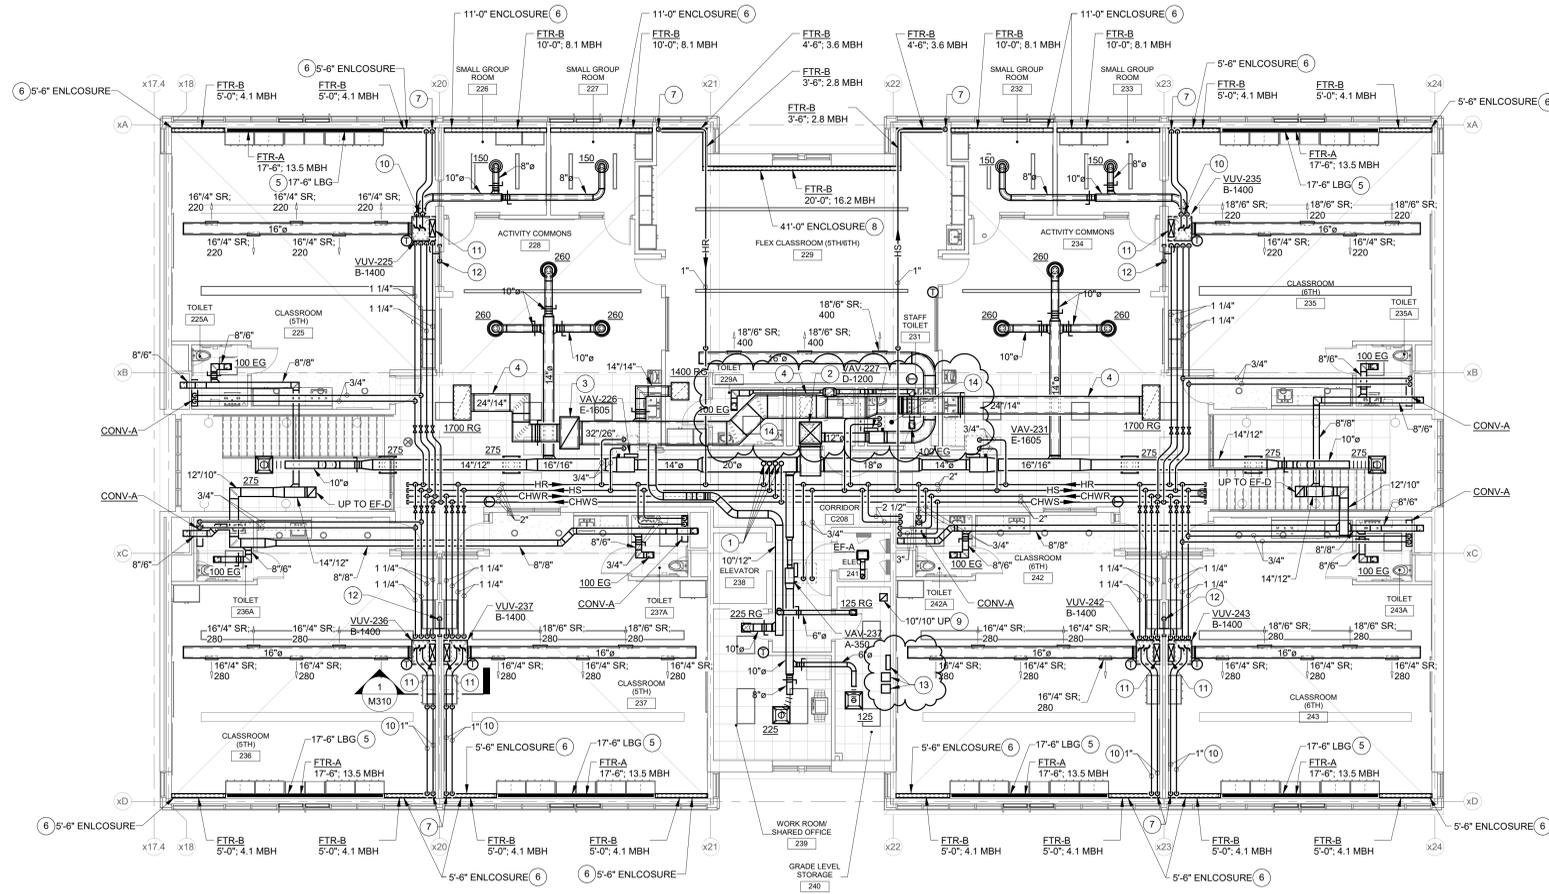

SECOND FLOOR - UNIT C - MECHANICAL
SCALE: 1/8" = 1'-0"
NORTH

KEY PLAN

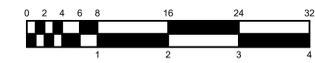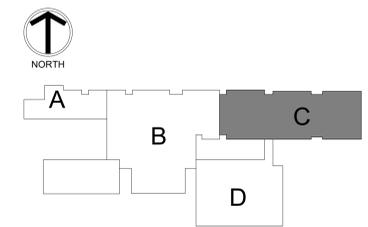

RENOVATION LEGEND:


- WORK TO BE INSTALLED
- WORK TO REMAIN

GENERAL NOTES:


1. ALSO SEE M200 FOR ADDITIONAL GENERAL NOTES.

PLAN NOTES:

1. INTERLOCK MOTORIZED DAMPER OPERATION WITH EF-11 E. OPERATION FOR MECHANICAL MEZZANINE VENTILATION. CONTRACTOR TO CONFIRM FAN OPERATION.
2. MOUNT VFDs AND TCPs TO CONTRACTOR PROVIDED UNISTRUT.
3. ROUTE RETURN AIR DUCTWORK / PLENUM FROM EXISTING FIRE DAMPER BACK TO INSTALLED AHU. RETURN GRILLE AND FIRE DAMPER ARE BOTH EXISTING TO REMAIN.


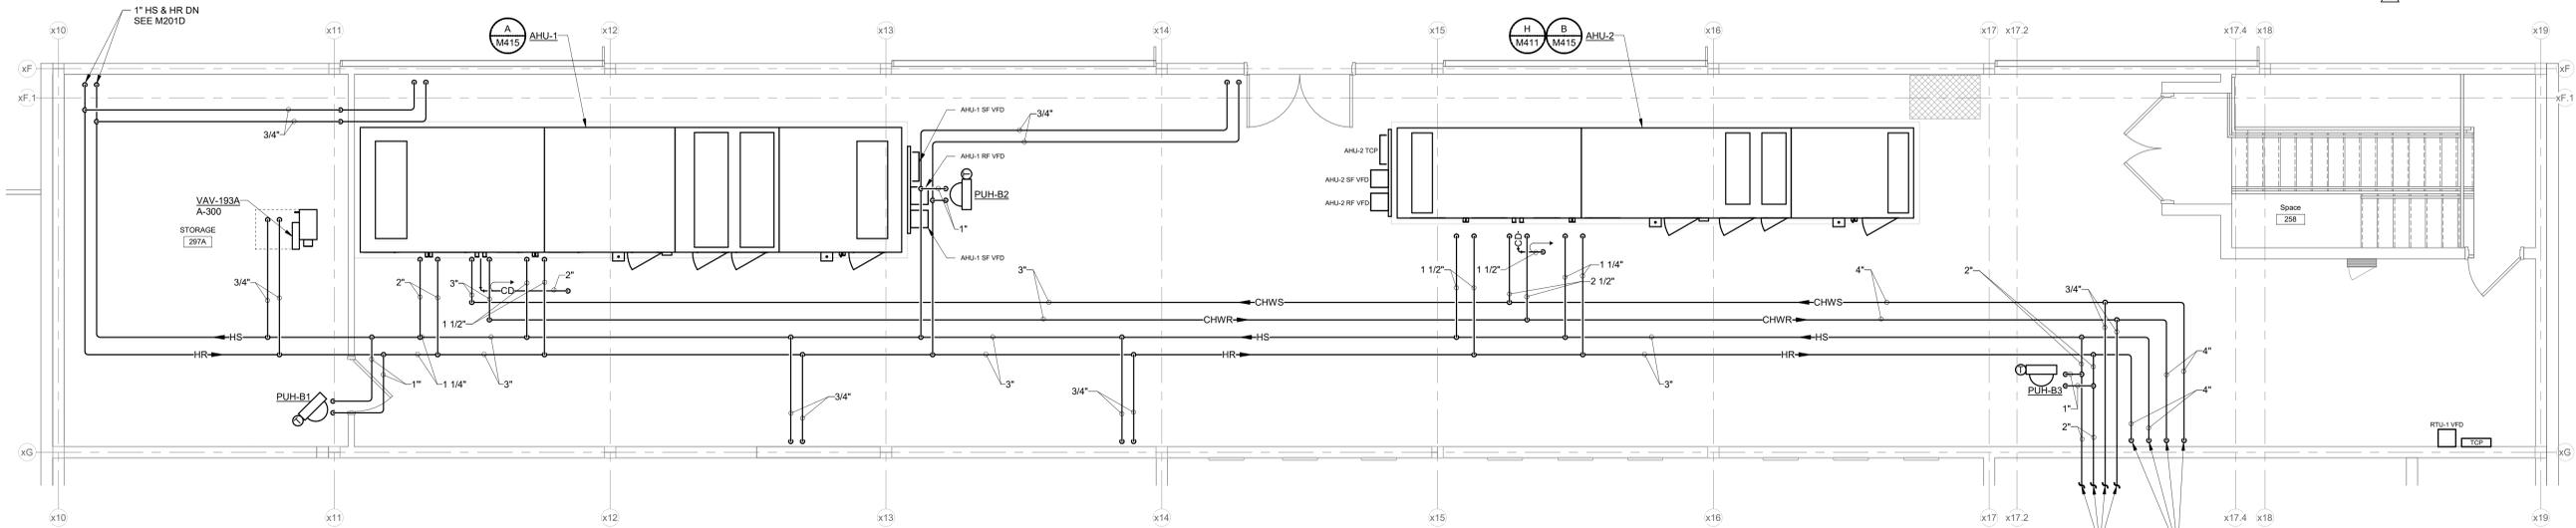


MEZZANINE LEVEL PLAN - HYDRONICS
SCALE: 1/4" = 1'-0"
NORTH

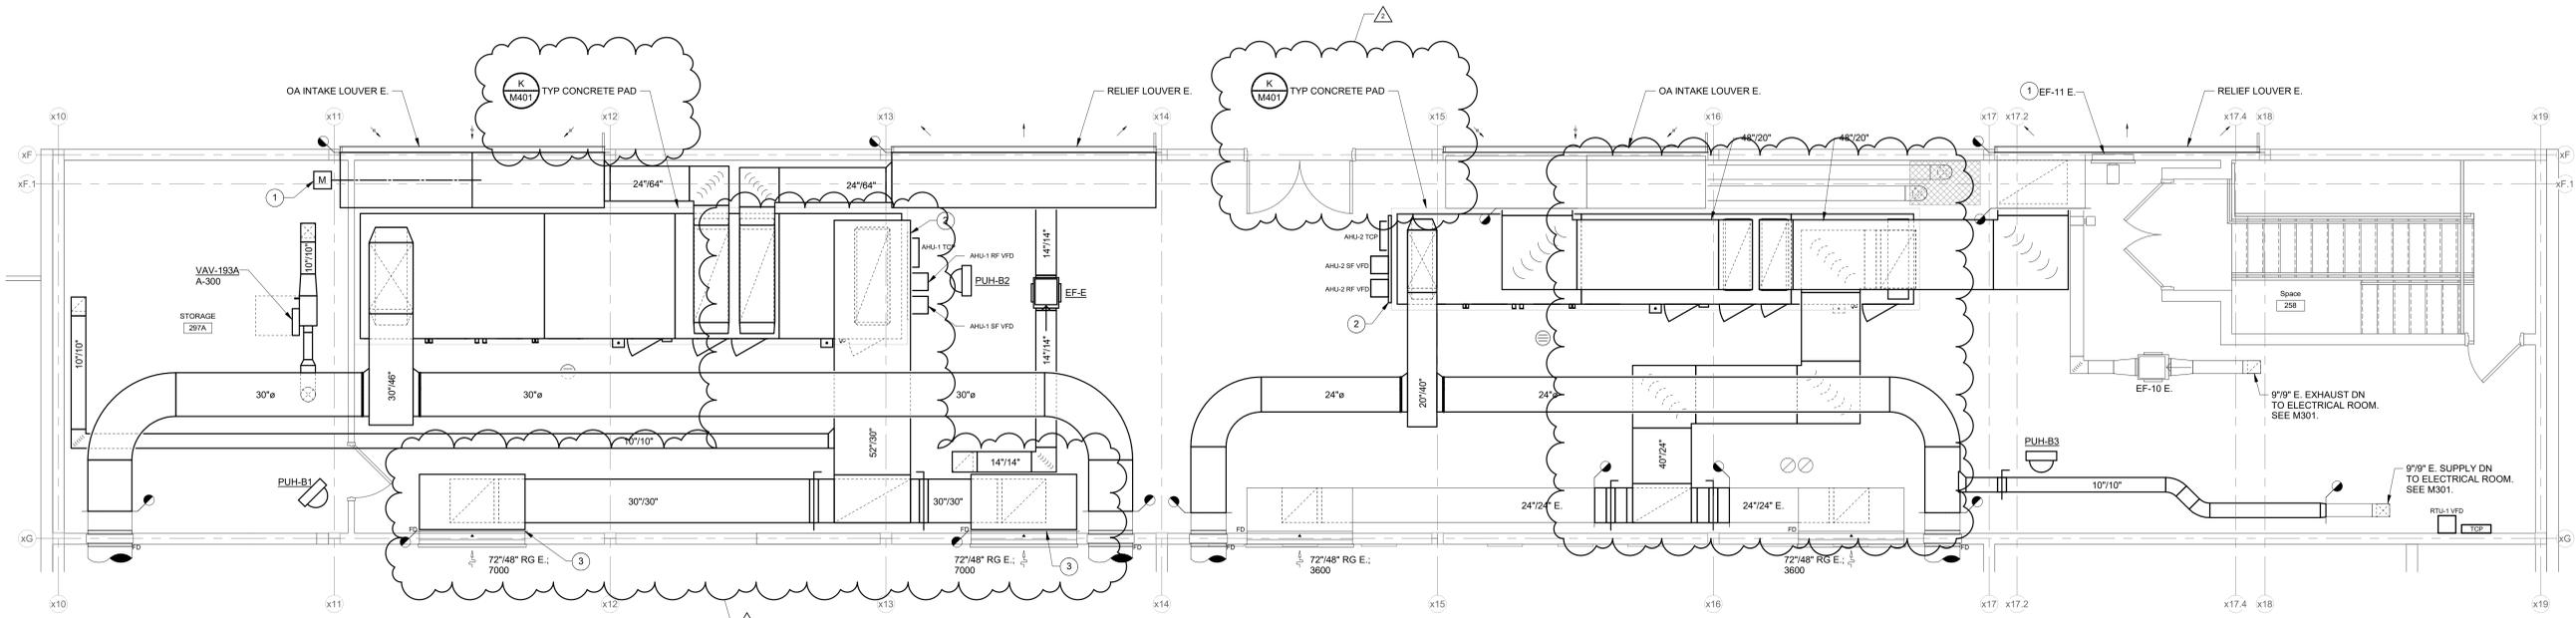

MEZZANINE LEVEL PLAN - AIR DISTRIBUTION
SCALE: 1/4" = 1'-0"
NORTH

KEY PLAN


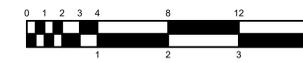
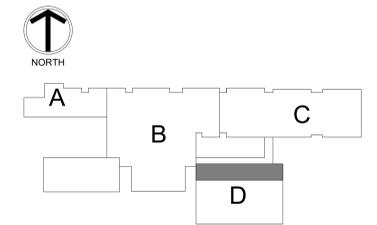


RENOVATION LEGEND:


- WORK TO BE INSTALLED
- WORK TO REMAIN

GENERAL NOTES:


1. ALSO SEE M200 FOR ADDITIONAL GENERAL NOTES.
- PLAN NOTES:**
1. 3/4" HS / HR BELOW FINISHED FLOOR IN EXISTING TRENCH.
2. 1-1/4" CHWS / CHWR FROM TUNNEL TO VUV ON GROUND LEVEL.
3. 1" HS / HR FROM TUNNEL TO VUV ON GROUND LEVEL.
4. 1" CONDENSATE DRAIN FROM VUV TO TUNNEL.
5. 42/110" INSULATED OUTSIDE AIR DUCT FROM GOOSENECK ON ROOF TO BACK OF VUV.
6. 3" WIDE HEAVY DUTY LINEAR BAR GRILLE MOUNTED IN TOP OF FURRED WALL BEHIND CASEWORK. SEE SECTION 'A' / M303 FOR DETAILS. LINEAR BAR GRILLE TO BE LIKE PRICE MODEL LBPH, 3" WIDE, 1/4" BAR SPACING, 0" DEFLECTION, 3/4" FLANGE WIDTH AND SPRING CLIP MOUNTING. LENGTH AS NOTED ON PLANS. FINISH TO BE CUSTOM COLOR SELECTED BY ARCHITECT.
7. 30" LONG X 2" WIDE HEAVY DUTY LINEAR BAR GRILLE MOUNTED IN TOE KICK OF CASEWORK. SEE SECTION 'A' / M303 AND ELEVATION THIS DRAWING FOR DETAILS. LINEAR BAR GRILLE TO BE LIKE PRICE MODEL LBPH, 3" WIDE, 1/4" BAR SPACING, 0" DEFLECTION, 3/4" FLANGE WIDTH AND SPRING CLIP MOUNTING. FINISH TO BE CUSTOM COLOR SELECTED BY ARCHITECT.
8. BARE FINNED-TUBE ELEMENT (FTR) INSTALLED IN WALL BEHIND CASEWORK. LENGTH AS NOTED ON PLANS.
9. VUV AND PIPE CHASE HAVE BEEN PRE-PURCHASED BY OWNER AND ARE TO BE INSTALLED ON THIS PROJECT. CONTRACTOR TO PROVIDE TOP PLENUM EXTENSION, DUCTWORK, INSULATION, AND SUPPLY REGISTERS FOR THESE TYPICAL ROOMS.
10. INTERNALLY LINE SUPPLY AIR DUCTWORK AND TOP SUPPLY PLENUM EXTENSION WITH 1" ACOUSTICAL DUCT LINER.

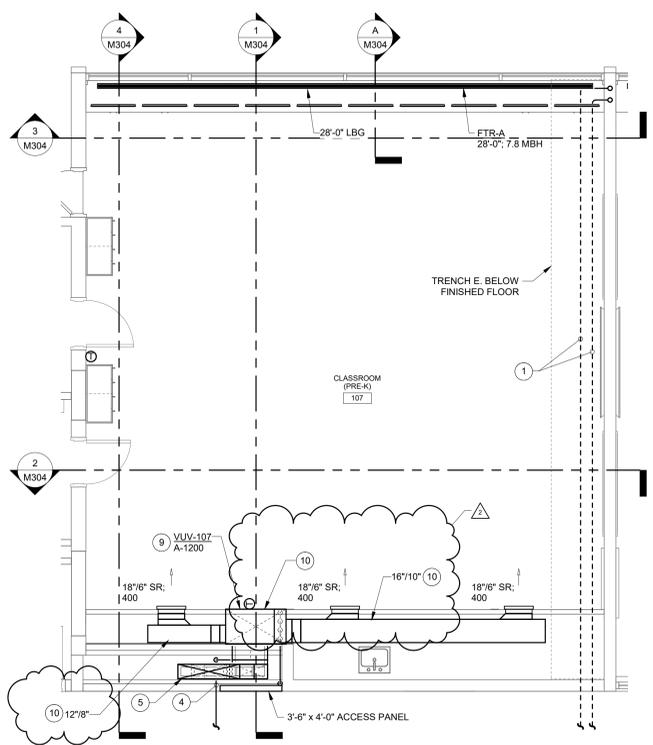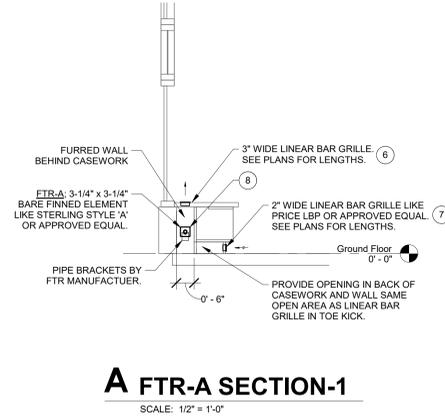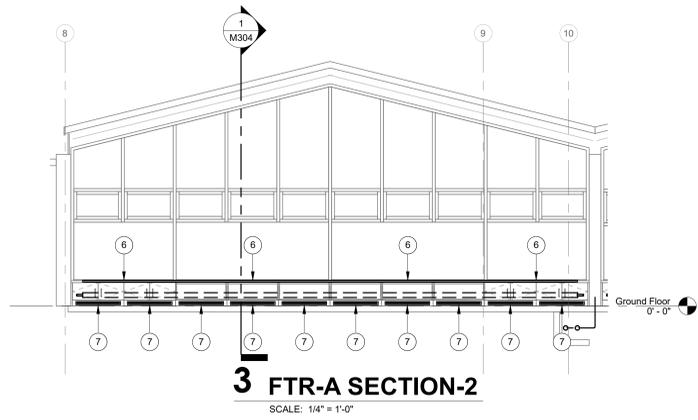


TYPICAL CLASSROOM LAYOUT - AREA A - MECHANICAL
SCALE: 1/4" = 1'-0"
NORTH

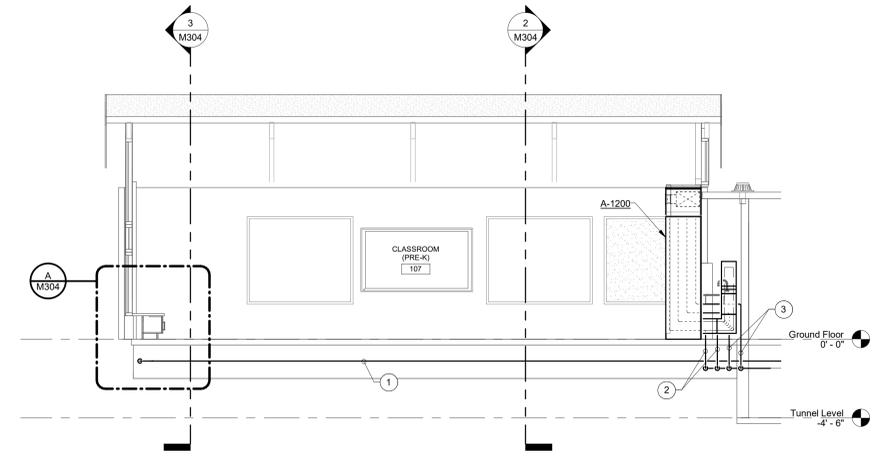


1 DUCTWORK - SECTION
SCALE: 1/4" = 1'-0"

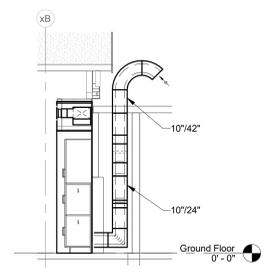


4 OA INTAKE - SECTION
SCALE: 1/4" = 1'-0"

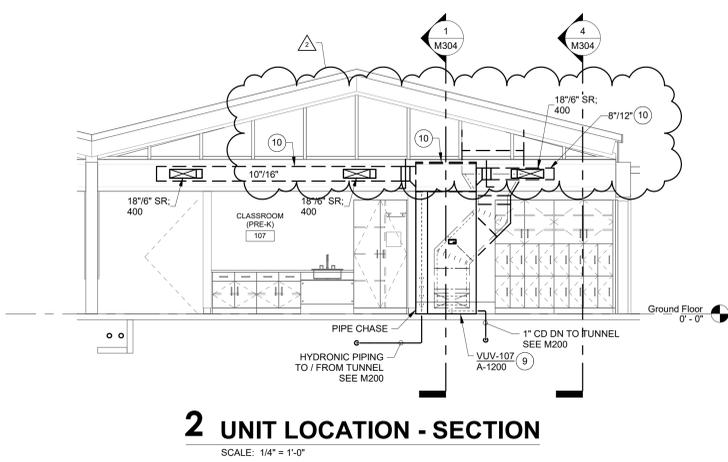

2 UNIT LOCATION - SECTION
SCALE: 1/4" = 1'-0"

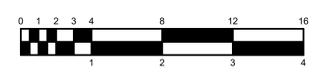

KEY PLAN

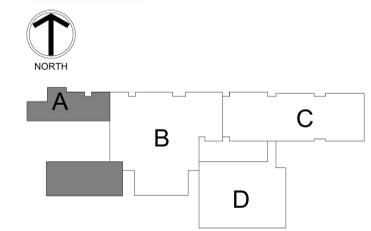

RENOVATION LEGEND:


- WORK TO BE INSTALLED
- WORK TO REMAIN

GENERAL NOTES:

1. ALSO SEE M200 FOR ADDITIONAL GENERAL NOTES.

PLAN NOTES:

1. CONNECT OA DUCT FROM VERTICAL RISER TO VUVs MOTORIZED OUTSIDE AIR DAMPER.

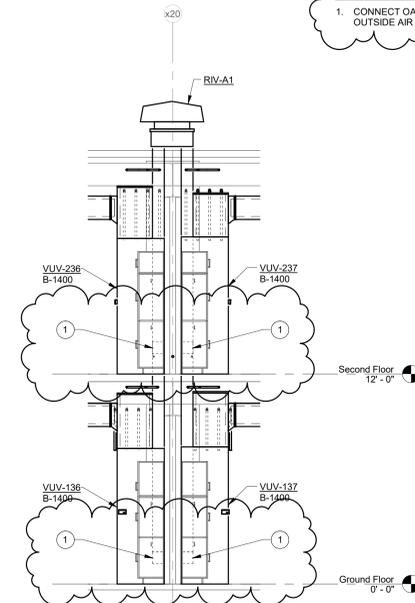

1 OA INTAKE CHASE
SCALE: 1/4" = 1'-0"

SCOPE DRAWINGS:
These drawings indicate the general scope of the project in terms of mechanical design concept, the structure of ductwork, mechanical and electrical systems.
The drawings do not necessarily indicate or describe all work required for full performance and completion of the requirements of the Contract.
On the basis of the general scope indicated on drawings, the trade contractors shall furnish all items required for the proper execution and completion of the work.

REVISIONS:

2	ADDENDUM #2	03/15/2024
---	-------------	------------

ISSUE DATE	DRAWN BY	CHECKED BY
02/16/2024	ACB	WCE


DRAWING TITLE:
**SECTIONS -
MECHANICAL**


CERTIFIED BY:

02/16/2024


DRAWING NUMBER
M310

PROJECT NUMBER
22054

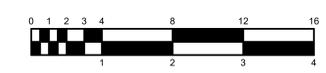


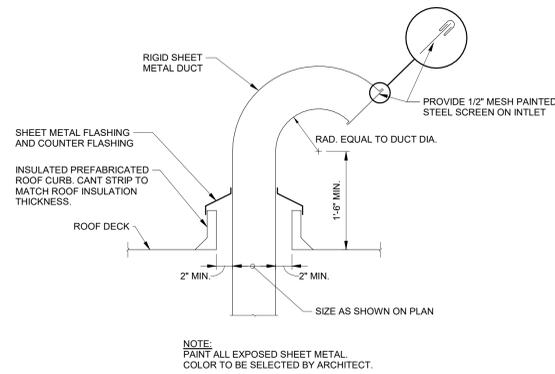


G TYPICAL OA INTAKE THRU ROOF
SCALE: NONE

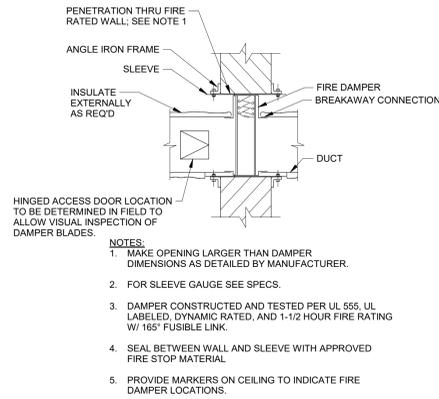

D CURTAIN FIRE DAMPER
SCALE: NONE

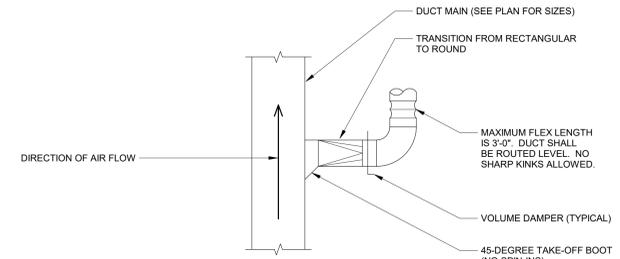


A BRANCH DUCT TAKE-OFF FROM MAIN DUCT
SCALE: NONE

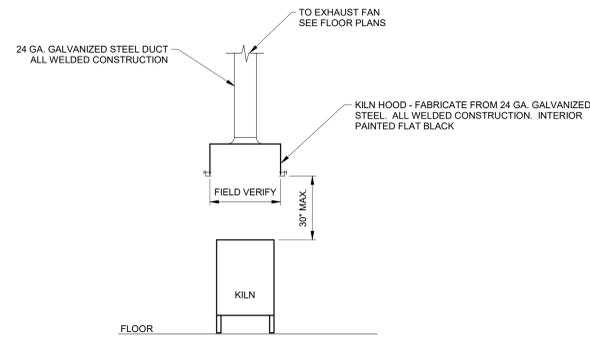

- NOTES:**
- KILN HOOD SHALL HAVE FACE OPENING AREA 6" WIDER THEN TOP OF KILN ON ALL SIDES. FIELD MEASURE EXACT SIZE REQUIRED.
 - EXHAUST FAN TO TIE-IN WITH KILN POWER WITH DELAYED TIMED SHUT-OFF. CONTROLS AND RELAYS BY DIVISION 26. SEE DETAIL.
 - HOOD MOUNTING HEIGHT MAY REQUIRE ADJUSTMENT TO ALLOW FOR OPENING IN LID. COORDINATE WITH ARCHITECT/ENGINEER.


KILN HOOD DETAIL

H KILN HOOD DETAIL
SCALE: NONE

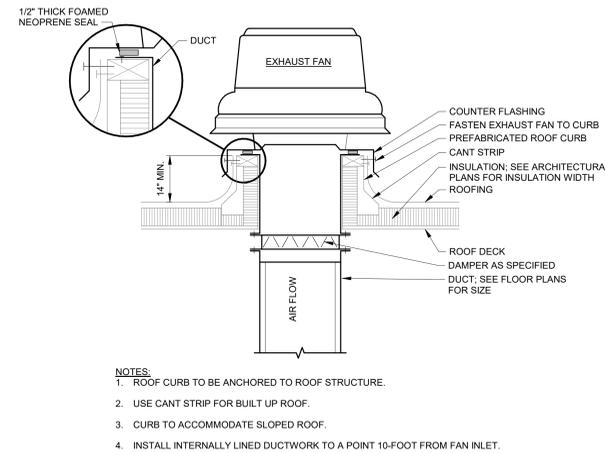


- NOTES:**
- ROOF CURB TO BE ANCHORED TO ROOF STRUCTURE.
 - USE CANT STRIP FOR BUILT UP ROOF.
 - CURB TO ACCOMMODATE SLOPED ROOF.
 - INSTALL INTERNALLY LINED DUCTWORK TO A POINT 10-FOOT FROM FAN INLET.


E CENTRIFUGAL ROOF EXHAUST FAN - FLAT ROOF
SCALE: NONE

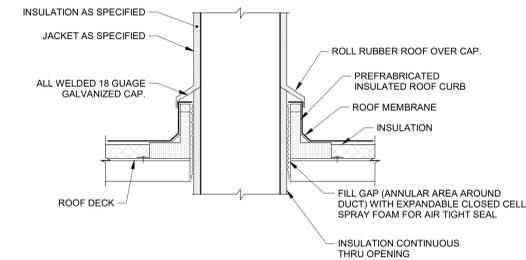


B DUCT THROUGH ROOF
SCALE: NONE

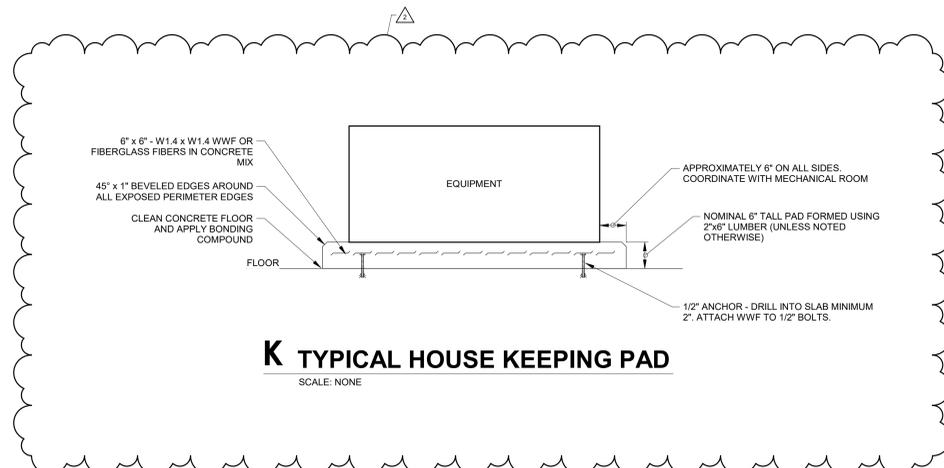


K TYPICAL HOUSE KEEPING PAD
SCALE: NONE

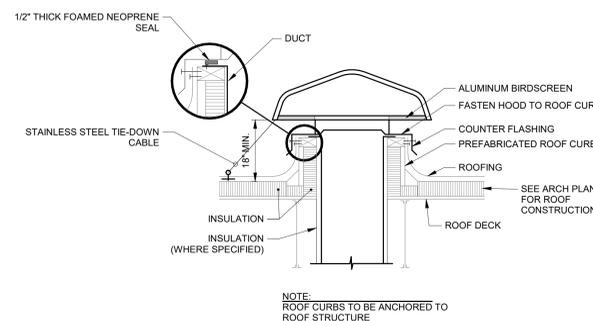

F ROOF INTAKE/RELIEF VENTILATOR
SCALE: NONE

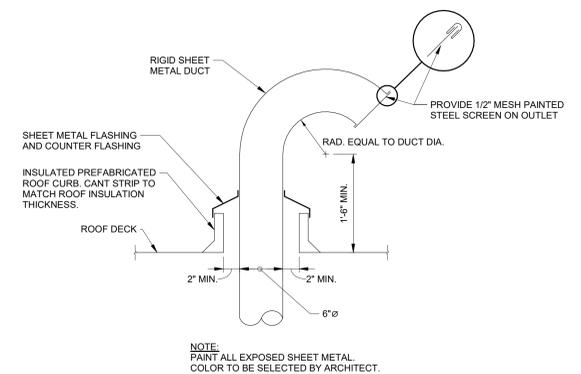

C TYPICAL EXHAUST DUCT TERMINATION THRU ROOF
SCALE: NONE

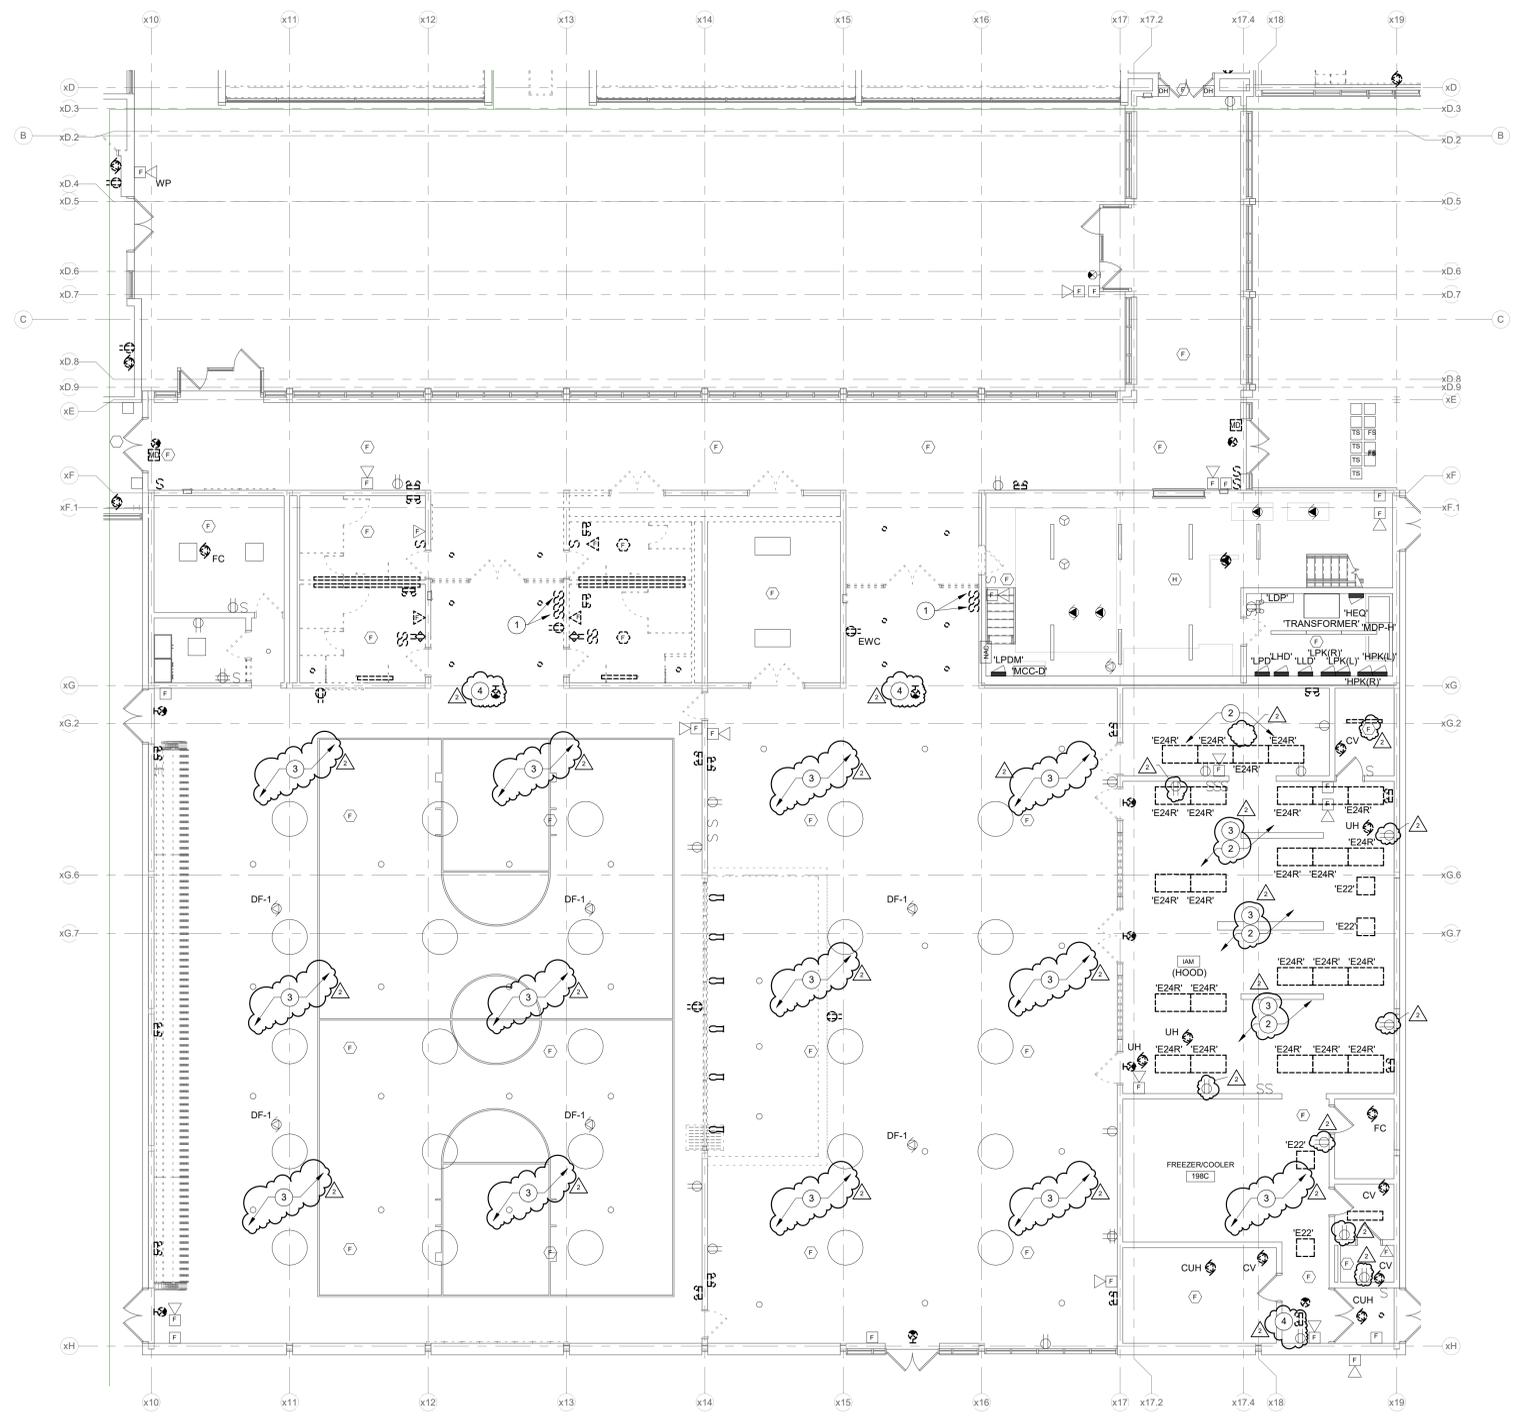

DEMOLITION LEGEND:

- WORK TO BE REMOVED
- WORK TO REMAIN

GENERAL NOTES:

1. SEE E001 FOR GENERAL NOTES.


PLAN NOTES:

1. LIGHTING CONTROLS TO BE RELOCATED. SEE E200 SERIES FOR RELOCATION.
2. LIGHT FIXTURES/FIXTURES TO BE REMOVED BUT KEPT FOR USE IN NEW CONSTRUCTION. SEE E200 SERIES FOR RELOCATION.
3. REMOVE EXIT SIGN AND EMERGENCY LIGHTS. CIRCUITS TO REMAIN IN THIS AREA FOR USE IN NEW CONSTRUCTION. PREPARE FOR NEW DEVICE IN EXISTING LOCATION.
4. FIXTURE TO BE REPLACED AND RELOCATED IN NEW CONSTRUCTION.

FIRST FLOOR - UNIT D - ELECTRICAL DEMOLITION
SCALE: 1/8" = 1'-0"



KEY PLAN

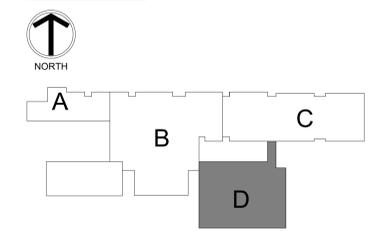

CSO
6831 Keystone Crossing, Indianapolis, IN 46240
317.847.7800 | CSOinc.net
© 2015 CSO Architects, Inc. All Rights Reserved.

DCA #22054
R.E. Dimond
and Associates, Inc.
Consulting Engineers
732 North Capitol Avenue
Indianapolis, IN 46204
Phone: (317) 634-4672
Fax: (317) 638-8725

PROJECT:
**BARTHOLOMEW CONSOLIDATED
SCHOOL CORPORATION
RENOVATIONS TO
L. C. SCHMITT ELEMENTARY**
2675 California St, Columbus, IN 47201

SCOPE DRAWINGS:
These drawings indicate the general scope of the project. The drawings are not intended to be used for the design of structural, mechanical and electrical systems. The drawings do not necessarily indicate or describe all work required for the performance and completion of the project. On the basis of the general scope indicated on drawings, the contractor shall furnish all items required for the proper execution and completion of the work.

REVISIONS:
2 ADDENDUM #2 03/15/2024

ISSUE DATE	DRAWN BY	CHECKED BY
02/16/2024	GSR	DEW

DRAWING TITLE:
**FIRST FLOOR
PLAN - UNIT D -
ELECTRICAL
DEMOLITION**

CERTIFIED BY:

Timothy E. Hill
02/16/2024

DRAWING NUMBER
ED201D

PROJECT NUMBER
22054

ABBREVIATIONS

A	AMPERE	MDF	MAN DISTRIBUTION FRAME
AC	ALTERNATING CURRENT; ARMORED CABLE	MDP	MAN DISTRIBUTION PANELBOARD
ADJ	ADJUSTABLE	MEB	MECHANICAL ELECTRICAL BOX
AF	AMPERE FUSE; AMPERE FRAME	MFG	MANUFACTURING
AFB	ABOVE FINISHED FLOOR	MFR	MANUFACTURER
AFG	AMPERE FINISHED GRADE	MH	MANHOLE; METAL HALIDE; MAN-HOUR
AFI	AMPERE INTERRUPTING CAPACITY	MHZ	MEGHERTZ
AL	ALUMINUM	MI	MINERAL INSULATED
ALCR	AUTOMATIC LOAD CONTROL RELAY	MIC	MICROPHONE
ANSI	AMERICAN NATIONAL STANDARDS INSTITUTE	MM	MINIMUM
ASYM	ASYMMETRICAL	MISC	MISCELLANEOUS
AT	AMPERE TRIPOLE	ML	MINIMUM LENGTH ONLY
ATS	AUTOMATIC TRANSFER SWITCH	MOC	MAXIMUM OVERCURRENT PROTECTION
AUX	AUXILIARY	MOD	MOUNTED
AVG	AVERAGE	MTS	MANUAL TRANSFER SWITCH
AWG	AMERICAN WIRE GAUGE	MV	MEGAVOLT; MEDIUM VOLTAGE
BATT	BATTERY	MVA	MEGAVOLT AMPERES
BPS	BOLTED PRESSURE SWITCH	MVAR	MEGAVOLT AMPERES REACTIVE
C	CONDUIT; CENTRIGRADE	MW	MEGAWATT
CC	CENTER TO CENTER	N	NEUTRAL
CB	CIRCUIT BREAKER	NA	NOT APPLICABLE
CCTV	CLOSED CIRCUIT TELEVISION	NC	NORMALLY CLOSED
CD	CANDELA	NEC	NATIONAL ELECTRICAL CODE
CF	CUBIC FEET	NEMA	NATIONAL ELECTRICAL MANUFACTURERS ASSOCIATION
CFL	COMPACT FLUORESCENT	NF	NON-FUSED
CIR	CIRCUIT	NFCS	NON-FUSED DISCONNECT
CLG	CEILING	NIC	NOT IN CONTRACT
CMU	CONCRETE MASONRY UNIT	NI	NIGHT LIGHT
COL	COLUMN	NM	NON-METALLIC SHEATHED CABLE
COMB	COMBINATION	NO	NORMALLY OPEN
CONC	CONCRETE	NTS	NOT TO SCALE
COND	CONDUCTOR	O&P	OVERHEAD AND PROFIT
CONT	CONTINUOUS; CONTINUED	OC	ON CENTER; OVERCURRENT
CP	CONTROL PANEL	OD	OUTSIDE
CPT	CONTROL POWER TRANSFORMER	OH	OVERHEAD
CT	CURRENT TRANSFORMER	OL	OVERLOAD
CJ	COPPER	OS&Y	OUTSIDE SCREW AND YOKE
CJFT	CUBIC FOOT	OZ	OUNCE
CY	CUBIC YARD	P	POLE; PULL
CYL	CYLINDER	PA	PUBLIC ADDRESS
D	DEEP; DEPTH	PB	PUSH BUTTON; PULL BOX
DB	DESCRIBE; DIRECT BURIED	PC	PHOTOCELL
DC	DIRECT CURRENT	PED	PEDESTAL
DD	DIRECT DIGITAL CONTROL	PF	POWER FACTOR
DF	DUAL FACE	PH	PHASE
DIAG	DIAMETER	PV	PISTON INDICATOR VALVE
DIA	DIAGONAL	PL	PANEL LIGHT
DISC	DISCONNECT	PNL	PANEL
DISTR	DISTRIBUTION	PR	PAIR
DN	DOWN	PR1	PRIMARY
DPST	DOUBLE POLE DOUBLE THROW	PR	PRIMARY
DPST	DOUBLE POLE, SINGLE THROW	PSF	POUNDS PER SQUARE FOOT
DWG	DRAWING	PSG	POUNDS PER SQUARE INCH
DX	DIRECT EXPANSION	PT	POTENTIAL TRANSFORMER
E	EAST; EXISTING	PJ	PER UNIT
EA	EACH	PVC	POLYVINYL CHLORIDE
EBR	ELECTRIC BASEBOARD RADIATION	PWR	POWER
EB	ELECTRONIC BALLAST	Q	QUANTITY
EC	ELECTRICAL CONTRACTOR	R	RESISTANCE; RELOCATED
ECC	ELECTRICAL CODE	RECEPT	RECEPTACLE
ELEC	ELECTRICAL	REFR	REFRIGERATOR
ELEV	ELEVATOR; ELEVATION	REQD	REQUIRED
EM	EMERGENCY	RIG	RIGID GALVANIZED STEEL
EMS	ENERGY MANAGEMENT SYSTEM	RLA	RUNNING LOAD AMPS
EMT	ELECTRICAL METALLIC TUBING	RM	RIGID METALIC CONDUIT
ENCL	ENCLOSURE	RMS	ROOM MEAN SQUARE
ENR	ENGINEERING	RNC	RIGID NON-METALLIC CONDUIT
EQUIP	EQUIPMENT	RT	RAINTIGHT
EST	ESTIMATED	SCCR	SHORT-CIRCUIT CURRENT-RATING
EWC	ELECTRIC WATER COOLER	SCHED	SCHEDULE
EWH	ELECTRIC WATER HEATER	SCR	SHORT CIRCUIT RATING
EXP	EXPOSED	SE	SECONDARY
EXT	EXTERIOR	SEC	SECONDARY
F	FUSE; FAHRENHEIT	SE	SECONDARY
FA	FIRE ALARM	SF	SOLID NEUTRAL
FAA	FIRE ALARM ANNIUNCIATOR	SP	SINGLE POLE
FACP	FIRE ALARM CONTROL PANEL	SPD	SURGE PROTECTIVE DEVICE
FC	FOOT-CANDLE	SPN	SINGLE PHASE, SINGLE THROW
FD	FUSED DISCONNECT	SPKR	SPEAKER
FEDER	FEEDED	SP	SINGLE POLE, SINGLE THROW
FIN	FINISHED	ST	SQUARE
FIT	FITTING	SQ FT	SQUARE FEET
FLA	FULL LOAD AMPS	SQ IN	SQUARE INCH
FLOR	FLOOR	SS	STAINLESS STEEL; SAFETY SWITCH
FM	FREQUENCY MODULATION; FACTORY MUTUAL	SS	SHUNT TRIP
FURN	FURNISHED	STD	STANDARD
FVNR	FULL VOLTAGE NON-REVERSING	SURF	SURFACE
G	GROUND	SW	SWITCH
GA	GALVANIZED	SWD	SWITCHING DUTY
GALV	GALVANIZED	SWBD	SWITCHBOARD
GC	GENERAL CONTRACTOR	SYD	SYMMETRICAL
GEN	GENERATOR	T	TEMPERATURE; TRANSFORMER
GFCI	GROUND FAULT CIRCUIT INTERRUPTER	TB	TERMINAL BLOCK
GFP	GROUND FAULT PROTECTION	TC	TEMPERATURE CONTROLS CONTRACTOR
GND	GROUND	TCC	TEMPERATURE CONTROL PANEL
GRS	GALVANIZED RIGID STEEL CONDUIT	TD	TIME DELAY
H	HIGH	TELE	TELECOMMUNICATIONS GROUNDING BUSBAR
HD	HEAVY DUTY; HIGH DEFINITION	TGB	TELECOMMUNICATIONS GROUNDING BUSBAR
HG	MERCURY	THD	TOTAL HARMONIC DISTORTION; THREAD
HOA	HAND-OFF-AUTOMATIC	TMBG	TELECOMMUNICATIONS MAIN GROUNDING BUSBAR
HPRZ	HORIZONTAL	TO	TELECOMMUNICATIONS OUTLET
HP	HORSEPOWER	TR	TAMPER RESISTANT
HPS	HIGH PRESSURE SODIUM	TB	TELEPHONE TERMINAL BOARD
HR	HOUR	TV	TELEVISION
HRS/DAY	HOURS PER DAY	TVSS	TRANSIENT VOLTAGE SURGE SUPPRESSOR
HGT	HIGHT	TYP	TYPICAL
HV	HIGH VOLTAGE	UC	UNDER (CABINET OR COUNTER)
HZ	HERTZ	UF	UNDERGROUND FEEDER
ID	INSIDE DIAMETER	UG	UNDERGROUND
IDF	INTERMEDIATE DISTRIBUTION FRAME	UH	ULTRA-HIGH FREQUENCY
IEEE	INSTITUTE OF ELECTRICAL AND ELECTRONICS ENGINEERS	UL	ULTRAWRITERS LABORATORY
IG	ISOLATED GROUND	UNFIN	UNFINISHED
IMC	INTERMEDIATE METAL CONDUIT	UNO	UNLESS NOTED OTHERWISE
IMP	IMPEDANCE	UTIL	UTILITY
IN	INCH	UTP	UNSHIELDED TWISTED PAIR
INCNAN	INCANDESCENT	V	VOLT
INSUL	INSULATION; INSULATED	VA	VOLT AMPERES
INT	INTERIOR	VAR	VOLT AMPERES REACTIVE
INV EL	INVERTED ELEVATION	VER	VERTICAL
J	JOULE; JUNCTION	VFD	VARIABLE FREQUENCY DRIVE
JB	JUNCTION BOX	VHF	VERY HIGH FREQUENCY
K	THOUSAND	VOL	VOLUME
KCMIL	THOUSAND CIRCULAR MILS	W	WIRE; WATT; WIDE
KHZ	KILOHERTZ	W	WITH
KK	KIRKKEY	WAP	WIRELESS ACCESS POINT
KP	KIRKKEY	WG	WIRE GUARD
KV	KILOVOLT	WM	"WIREMANT" SURFACE RACEWAY
KVA	KILOVOLT AMPERE	WP	WEATHERPROOF
KVAR	KILOVOLT AMPERE REACTIVE	WT	WEIGHT; WATERTIGHT
KWH	KILOWATT-HOUR	XFMR	TRANSFORMER
L	LENGTH; LONG; LUMEN	XFR	TRANSFER
LB	POUND; ELL CONDUIT BODY	Y	WYE
LED	LIGHT EMITTING DIODE	-	DEGREE
LFD	LINEAR FOOT	Δ	DELTA
LLO	LAMP LUMEN DEPRECIATION	Ø	PHASE; DIAMETER
LO	LOCK OUT	∅	PERCENT
LRA	LOCKED ROTOR AMPS	%	PERCENT
LT	LIGHT; LIGHT-TIGHT	@	APPROXIMATELY
LTO	LIGHTING	-	FEE
LV	LOW VOLTAGE	-	INCHES
M	METER		
MA	MILLIAMPERE		
MAG STR	MAGNETIC STARTER		
MAN	MANUAL		
MAT	MATERIAL		
MATV	MASTER ANTENNA TELEVISION		
MAX	MAXIMUM		
MC	METAL CABLE; MOTOR CONTROLLER		
MCA	MINIMUM CIRCUIT AMPS		
MCB	MAIN CIRCUIT BREAKER		
MCC	MOTOR CONTROL CENTER		
MCCB	MOLDED CASE CIRCUIT BREAKER		
MCM	THOUSAND CIRCULAR MILS		
MCP	MOTOR CIRCUIT PROTECTOR		
MCS	MOTOR CIRCUIT SWITCH		

NOT ALL SYMBOLS ON THIS SHEET ARE USED IN THESE DOCUMENTS.


BRANCH CIRCUIT WIRING CHART

FEEDER CONDUCTOR SIZES SHOWN ON THESE BID DOCUMENTS HAVE BEEN SELECTED TO MAINTAIN LESS THAN 2% VOLTAGE DROP AT POTENTIAL FULL LOAD CONDITION (80% OF CIRCUIT SIZE) PER ANTICIPATED ROUTING AND CONDUCTOR LENGTH. BRANCH CIRCUIT CONDUCTORS SHALL BE SIZED TO MAINTAIN LESS THAN 3% VOLTAGE DROP FROM PANELBOARD TO LOAD BASED UPON 80% OF CIRCUIT SIZE LOAD CONDITIONS. THE FOLLOWING CHART REPRESENTS WIRE SIZES FOR A 20 AMP CIRCUIT BASED UPON CIRCUIT LENGTH IN ORDER TO MAINTAIN LESS THAN 3% VOLTAGE DROP FOR A 12 AMP LOAD. CONTRACTOR SHALL USE THIS CHART FOR BIDDING AND INSTALLATION GUIDELINES. FOR KNOWN CIRCUITS WITH LARGER LOAD CONDITIONS, CONTRACTOR SHALL ADJUST ACCORDINGLY. GROUND CONDUCTOR SIZES SHALL BE INCREASED SAME AS CIRCUIT CONDUCTORS, PER NEC. ADJUST RACEWAY SIZES ACCORDINGLY.


WIRE SIZE	120V-1P	208V-1P	208V-3P	277V-1P	480V-3P
#12	0'-80"	0'-140"	0'-160"	0'-185"	0'-375"
#10	81'-135"	141'-230"	161'-270"	186'-310"	376'-620"
#8	136'-200"	231'-350"	271'-410"	311'-470"	621'-940"
#6	201'-315"	351'-550"	411'-635"	471'-735"	941'-1475"

CONDUCTOR LENGTHS INDICATED ARE TO THE FIRST DEVICE (BUT MAINTAIN MAXIMUM 5% VOLTAGE DROP TO THE LAST DEVICE FOR KNOWN LOADS).


TYPICAL WIRING DESIGNATIONS

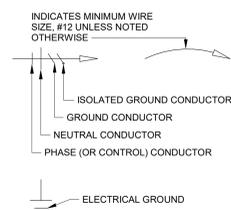


ROOM CIRCUIT DESIGNATIONS

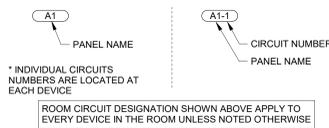

ROOM CIRCUIT DESIGNATIONS WITH RELAY NUMBER

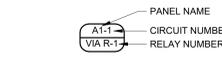


RACEWAYS

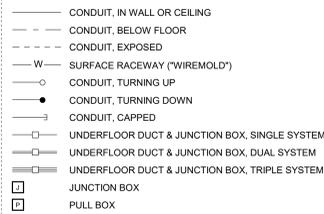


MISCELLANEOUS



TYPICAL DEVICE DESIGNATIONS

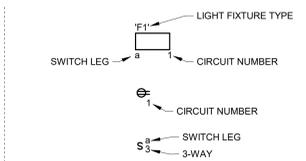


CIRCUIT DESCRIPTIONS

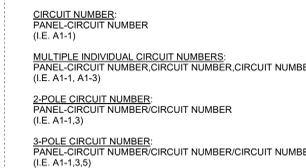


PANELS



POWER EQUIPMENT

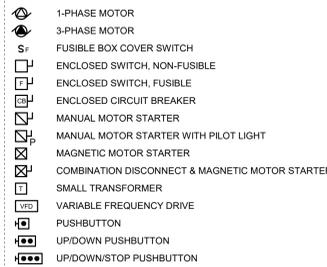

RECEPTACLES AND OUTLETS

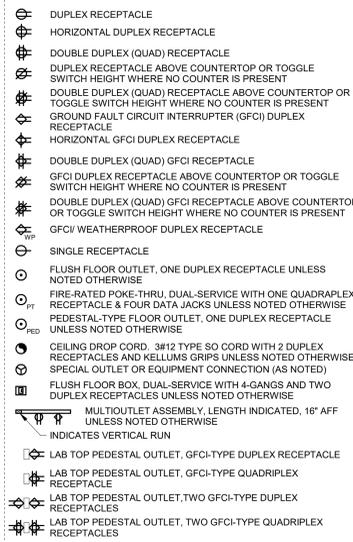


TYPICAL MOUNTING HEIGHTS


DEVICE TYPE	HEIGHT
RECEPTACLE OUTLETS (GENERAL), TELEPHONE & DATA OUTLETS	16"
RECEPTACLE OUTLETS ABOVE 36" HIGH COUNTERTOPS, TELEPHONE AND DATA OUTLETS ABOVE 36" COUNTERTOPS	36"
RECEPTACLE OUTLETS ABOVE 36" HIGH COUNTERTOPS, TELEPHONE AND DATA OUTLETS ABOVE 36" COUNTERTOPS	42"
ELEVATOR AND HOISTWAY CONTROL BUTTONS	42" TO CENTER OF DEVICE BOX
CARD READERS, FIRE ALARM STATIONS, PUSH BUTTONS, THERMOSTATS, TOGGLE SWITCHES, WALL INTERCOM STATIONS, WALL TELEPHONE OUTLETS	48" TO TOP OF DEVICE BOX
SPECIAL PURPOSE OUTLETS	WITHIN 72" OF INTENDED USE.
FIRE ALARMS (GONGS, BELLS, HORNS, LIGHTS)	80" OR 6" BELOW CEILING, WHICHEVER IS LOWEST.
WALL LIGHTING OUTLETS	84" TO CENTER OF DEVICE BOX
CLOCKS	97" TO CENTER OF CLOCK, BUT AT LEAST 6" BETWEEN TOP OF CLOCK AND CEILING. ABOVE DOORS CENTER CLOCK BETWEEN TOP OF DOOR FRAME AND CEILING
BELLS, BUZZERS, CHIMES	96" TO CENTER OF DEVICE BOX, BUT AT LEAST 6" BELOW CEILING

- NOTES:
1. MOUNTING HEIGHTS ARE TO BOTTOM OF DEVICE BOX UNLESS NOTED OTHERWISE.
2. COMPLY WITH ACCESSIBILITY CODE.


LIGHT FIXTURES

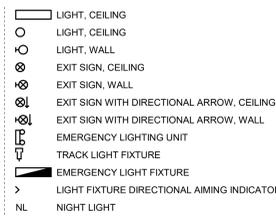

SWITCHES

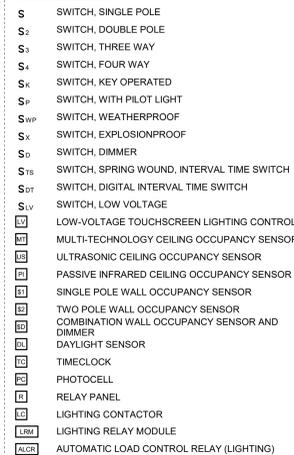


FIRE ALARM SYSTEMS

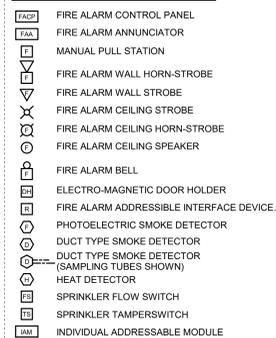


GENERAL NOTES:

- COORDINATE LOCATIONS OF DEVICES TO BE INSTALLED IN CEILINGS WITH THE ARCHITECTURAL REFLECTED CEILING PLANS. NOTIFY ENGINEER OF ANY CONFLICTS PRIOR TO INSTALLATION.
- 120 VOLT CIRCUITS SHALL UTILIZE SEPARATE INDEPENDENT NEUTRAL CONDUCTORS. DO NOT SHARE NEUTRALS.
- CONTRACTOR SHALL COORDINATE WITH ALL TRADES. NO ADDITIONAL COMPENSATION WILL BE ALLOWED FOR INCORRECT WORK, OR FOR INFREQUENT UPON OTHERS' WORK, DUE TO A LACK OF COORDINATION.
- DEVICES IN GENERAL SHALL BE CENTERED IN WALL SPACE IN WHICH THEY ARE INSTALLED OR THEY SHALL BE SPACED SYMMETRICALLY (FOR EXAMPLE, CENTER DEVICES WHEN MOUNTED ON FACE OF COLUMNS).
- COORDINATE AND VERIFY LOCATIONS OF DEVICES WITH BLOCK COURSING, FINISH MATERIALS, CASEWORK, ETC. PRIOR TO RUSH-IN.
- WIRING TO ALL RECEPTACLES ON DEDICATED CIRCUITS SHALL BE A MINIMUM #10 AWG UNLESS OTHERWISE NOTED.
- RECEPTACLES CONNECTED TO EMERGENCY CIRCUITS SHALL BE RED COLOR.
- WIRING SHALL BE MINIMUM #12 AWG IN 3/4" EMT CONDUIT UNLESS OTHERWISE NOTED OR REQUIRED.
- COORDINATE LOCATION OF RECEPTACLES AT ELECTRIC WATER COOLERS (EWC) WITH EWC MANUFACTURER. PROVIDE DUPEX RECEPTACLE SO THAT IT IS CONCEALED BY EWC HOUSING.
- LOW VOLTAGE PLENUM-RATED CABLING (FIRE ALARM, LIGHTING CONTROL, ETC.) SHALL BE

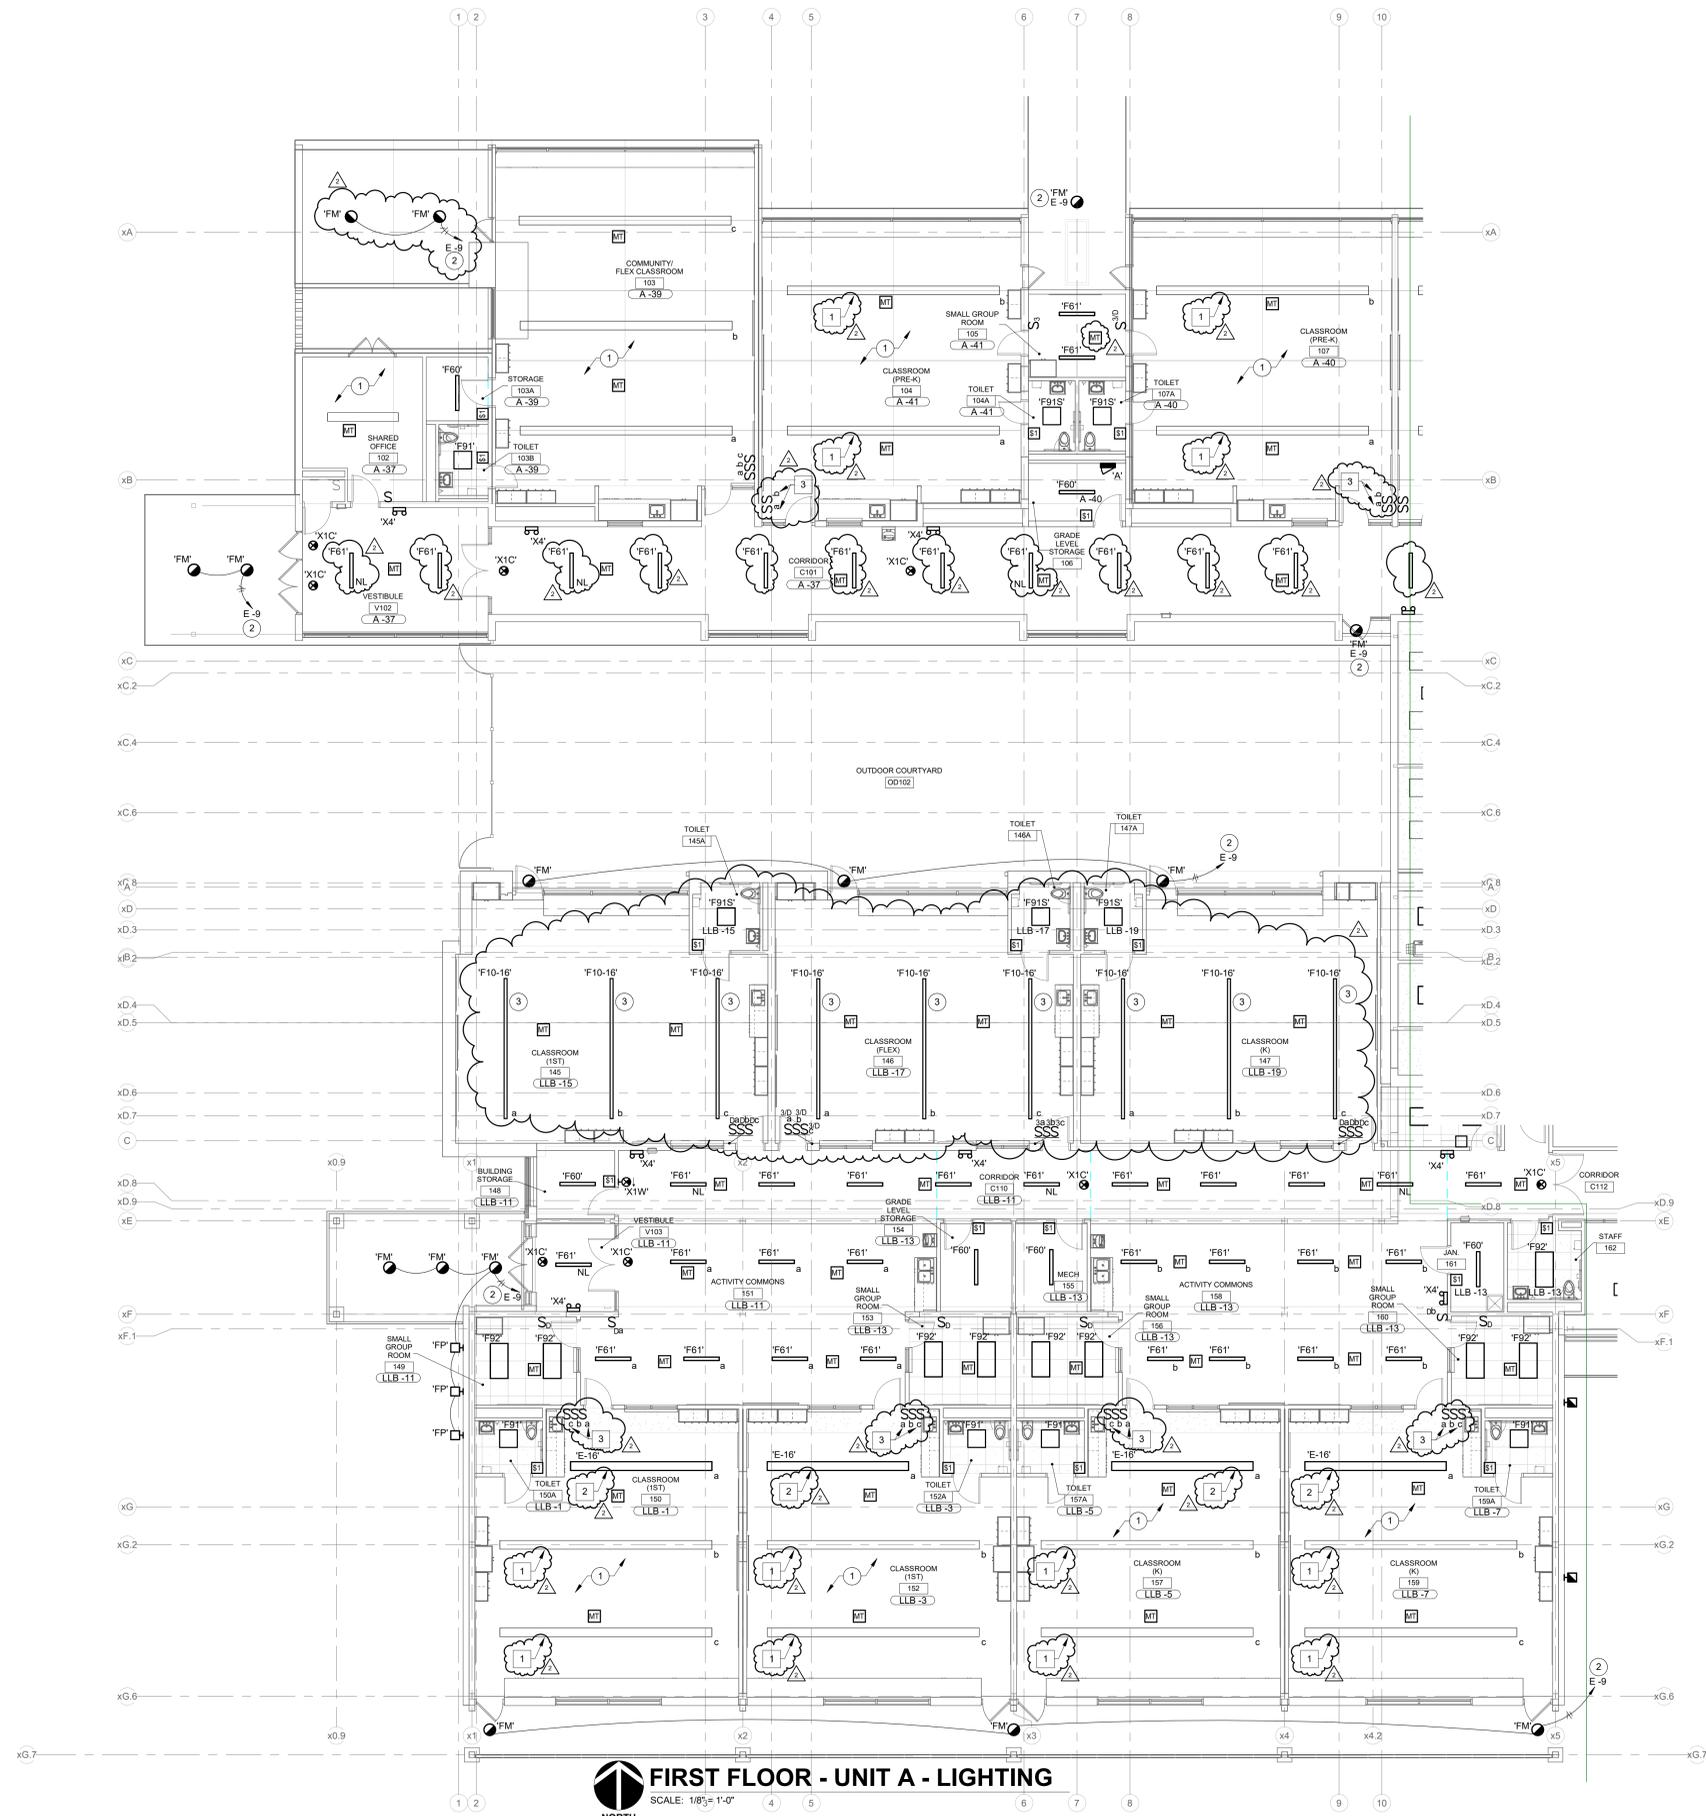

FIRST FLOOR - UNIT A - LIGHTING
SCALE: 1/8" = 1'-0"
NORTH

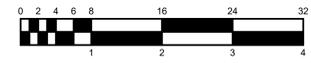

RENOVATION LEGEND:

- WORK TO BE INSTALLED
- WORK TO REMAIN

GENERAL NOTES:

1. SEE E001 FOR GENERAL NOTES.
 2. LIGHT FIXTURES CONTAINING PREFIX 'E' ARE RELOCATED FIXTURES. SEE E001 SHEET FOR SALVAGED LIGHT FIXTURE COUNT.
 3. PLAN NOTES ANNOTATED INSIDE SQUARE SYMBOLS ARE PART OF ALTERNATE BID PACKAGE FOR LIGHTING.
- PLAN NOTES:**
1. EXISTING CLASSROOM LIGHTING TO REMAIN. REWORK AS REQUIRED TO ADD OCCUPANCY SENSORS, MANUAL CONTROLS. MODIFICATIONS REQUIRED BY NEW CONSTRUCTION. REWIRE TO CIRCUIT INDICATED.
 2. CONNECT TO CIRCUIT INDICATED THROUGH LIGHTING RELAY PANEL IN ELECTRICAL ROOM 118. SEE DRAWING E201C. SEE DRAWING E-403 FOR RELAY PANEL AND CONTROL DETAILS. COORDINATE LOCATION WITH ARCHITECT AND BLOCK COURSING.
 3. FIXTURES TO BE INSTALLED 9'-0" AFF.

PLAN NOTES (ALTERNATE LIGHTING BID):

1. REMOVE LIGHT FIXTURE AND REPLACE WITH FIXTURE TYPE 'F10-24'. REPLACEMENT FIXTURE TO BE MOUNTED AT SAME HEIGHT AS FIXTURE REMOVED.
2. REMOVE LIGHT FIXTURE AND REPLACE WITH FIXTURE TYPE 'F10-16'. REPLACEMENT FIXTURE TO BE MOUNTED AT SAME HEIGHT AS FIXTURE REMOVED.
3. PROVIDE DIMMER SWITCHES INSTEAD OF TOGGLE SWITCHES.



BARTHOLOMEW CONSOLIDATED SCHOOL CORPORATION
RENOVATIONS TO
L. C. SCHMITT ELEMENTARY
2675 California St, Columbus, IN 47201

SCOPE DRAWINGS:
These drawings indicate the general scope of the project. The drawings do not necessarily indicate or describe all work required for the performance and completion of the project. On the basis of the general scope indicated on drawings, the contractor shall furnish all items required for the proper execution and completion of the work.

REVISIONS:
2 ADDENDUM #2 03/15/2024

ISSUE DATE 02/16/2024
DRAWN BY GSR
CHECKED BY DEW

DRAWING TITLE:
FIRST FLOOR PLAN - UNIT A - LIGHTING



DRAWING NUMBER
E201A

PROJECT NUMBER
22054

RENOVATION LEGEND:


- WORK TO BE INSTALLED
- WORK TO REMAIN

GENERAL NOTES:

1. SEE E001 FOR GENERAL NOTES.
 2. LIGHT FIXTURES CONTAINING PREFIX 'E' ARE RELOCATED FIXTURES. SEE E001 SHEET FOR SALVAGED LIGHT FIXTURE SCHEDULE.
 3. PLAN NOTES ANNOTATED INSIDE SQUARE SYMBOLS ARE PART OF ALTERNATE BID PACKAGE FOR LIGHTING.
- # PLAN NOTES:**
1. EXISTING CLASSROOM LIGHTING TO REMAIN. REWORK AS REQUIRED TO ADD OCCUPANCY SENSORS, MANUAL CONTROLS. MODIFICATIONS REQUIRED BY NEW CONSTRUCTION. REWIRE TO CIRCUIT INDICATED.
 2. CONNECT TO EXISTING CIRCUIT IN THIS AREA. PROVIDE NECESSARY WIRING.
 3. RELAY PANEL TO CONTROL EXTERIOR LIGHT FIXTURES. SEE DRAWING E-403 FOR RELAY PANEL AND CONTROL DETAILS.
 4. CONNECT TO CIRCUIT INDICATED THROUGH LIGHTING RELAY PANEL IN ELECTRICAL ROOM 118. THIS DRAWING. SEE DRAWING E-403 FOR RELAY PANEL AND CONTROL DETAILS. COORDINATE LOCATION WITH ARCHITECT AND BLOCK COURSEING.
 5. CONNECT LIGHT FIXTURE TO EXISTING CIRCUIT IN THIS AREA.
 6. EXISTING CORRIDOR LIGHTING TO REMAIN. REWORK AS REQUIRED TO ADD OCCUPANCY SENSORS. MODIFICATIONS REQUIRED BY NEW CONSTRUCTION. REWIRE TO EXISTING CIRCUIT IN THE AREA.
 7. MOUNT LIGHTING FIXTURE(S) 9'-0" AFF.

PLAN NOTES (ALTERNATE LIGHTING BID):


1. REMOVE LIGHT FIXTURE AND REPLACE WITH FIXTURE TYPE 'F10-24'. REPLACEMENT FIXTURE TO BE MOUNTED AT SAME HEIGHT AS FIXTURE REMOVED.
2. PROVIDE DIMMER SWITCHES INSTEAD OF TOGGLE SWITCHES.

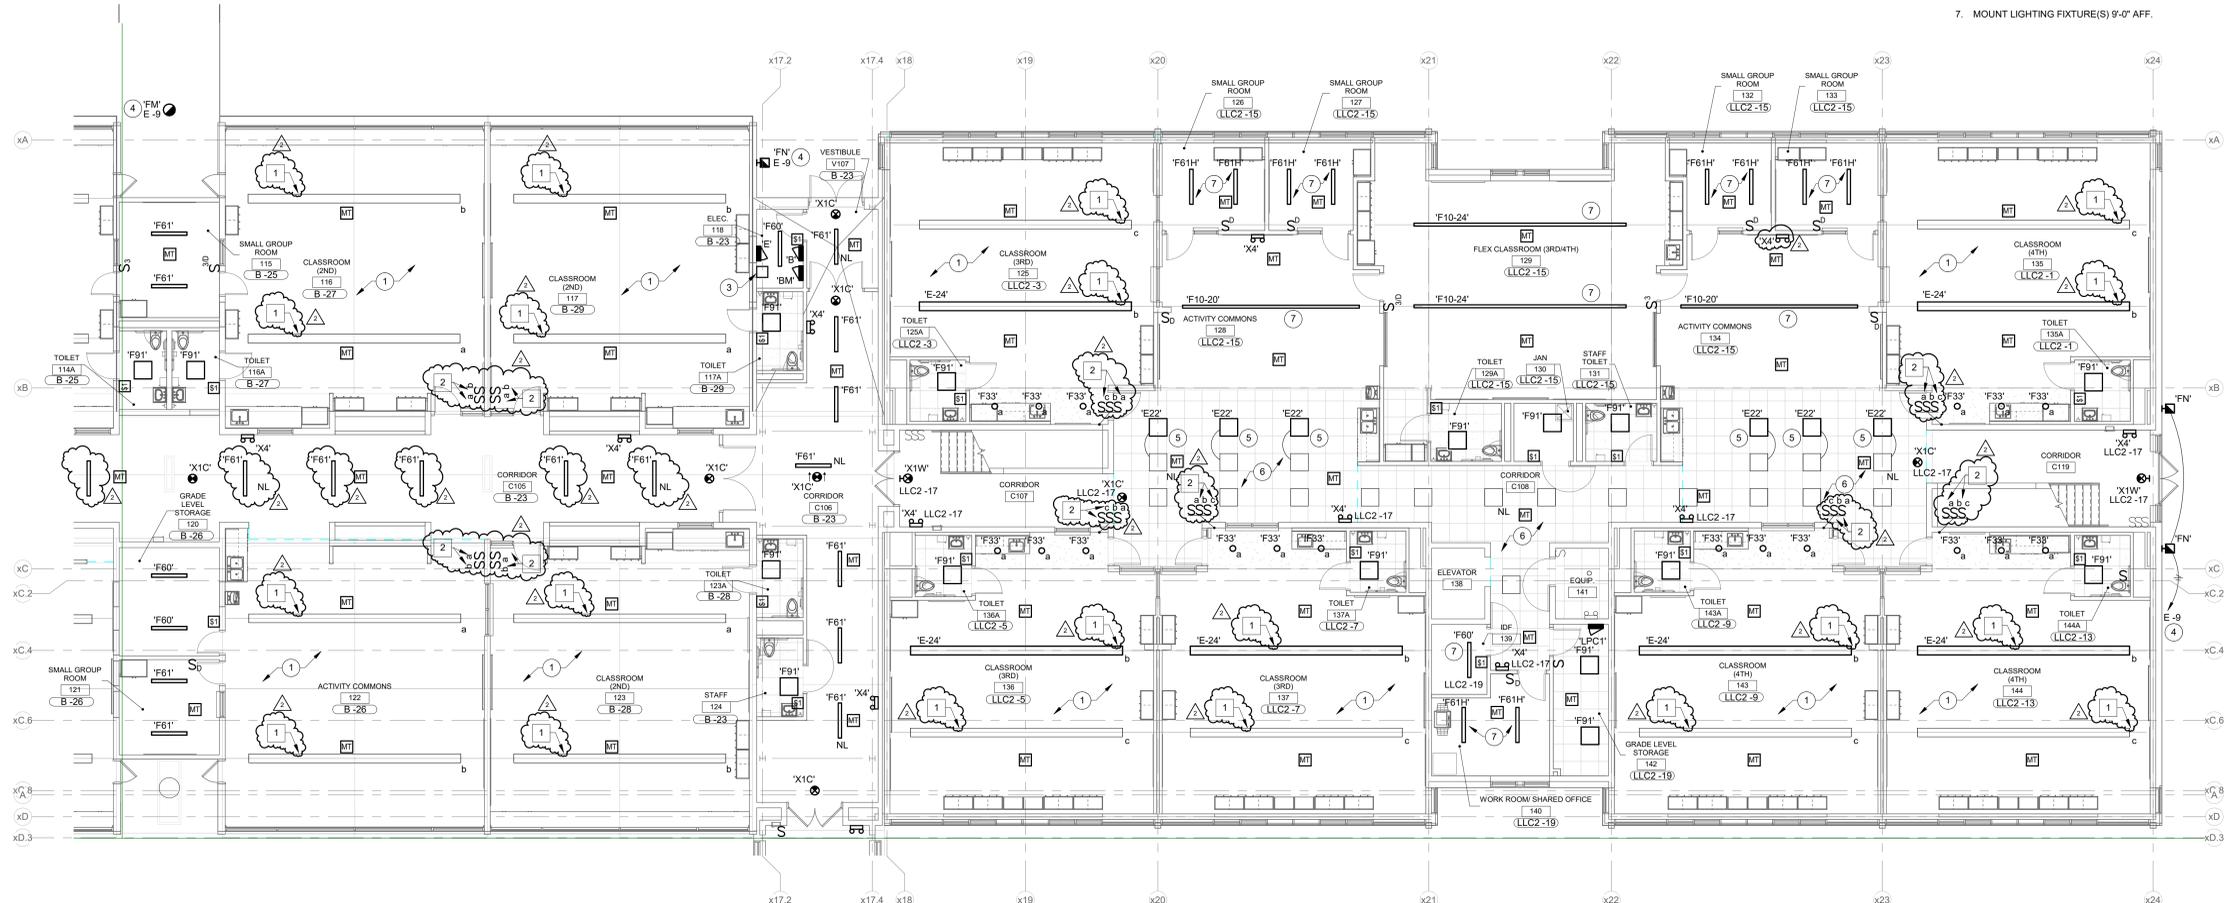


FIRST FLOOR - UNIT C - LIGHTING
SCALE: 1/8" = 1'-0"
NORTH



KEY PLAN

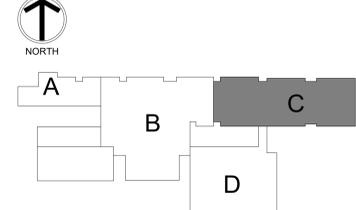

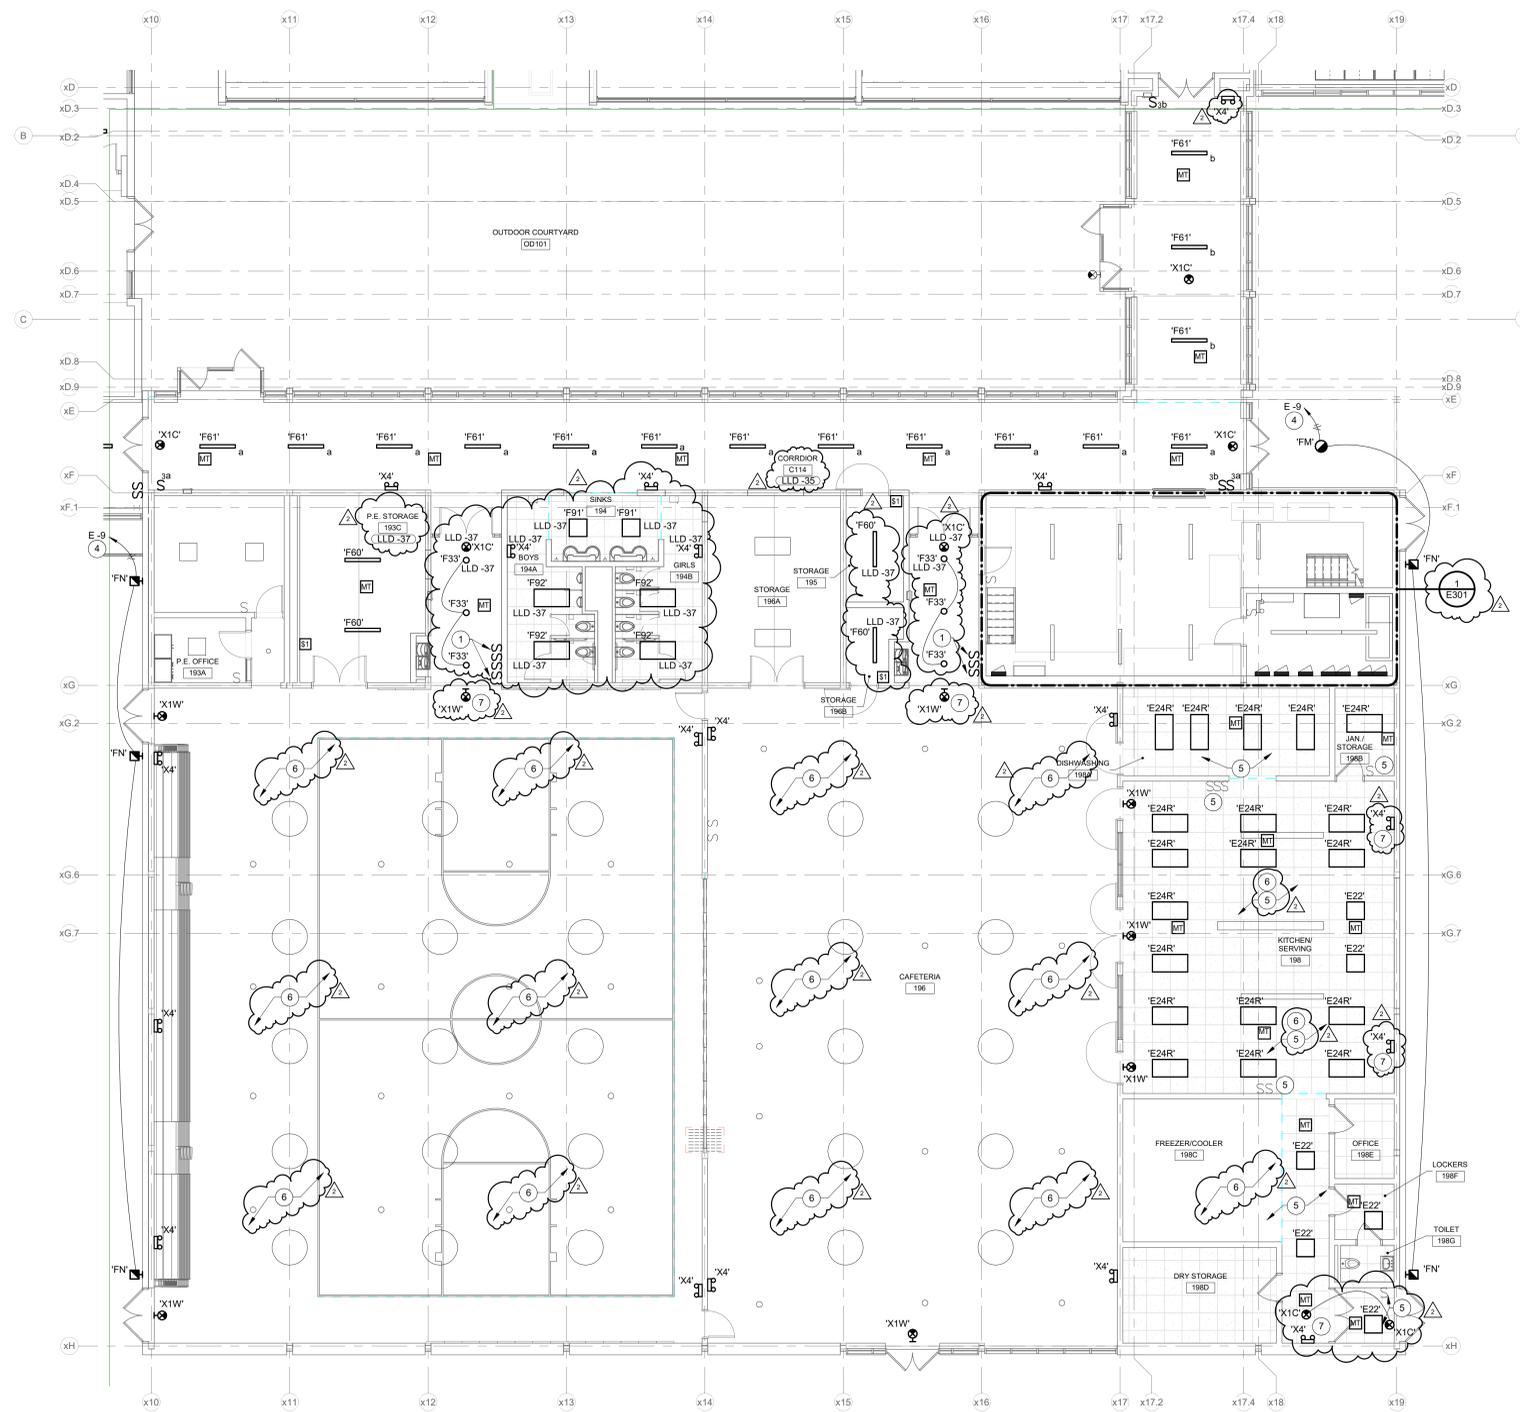

FIRST FLOOR - UNIT D - LIGHTING
SCALE: 1/8" = 1'-0"
NORTH

RENOVATION LEGEND:

- WORK TO BE INSTALLED
- WORK TO REMAIN

GENERAL NOTES:

1. SEE E001 FOR GENERAL NOTES.
 2. LIGHT FIXTURES CONTAINING PREFIX 'E' ARE RELOCATED FIXTURES. SEE E001 SHEET FOR SALVAGED LIGHT FIXTURE SCHEDULE.
- # **PLAN NOTES:**
1. RELOCATED COURT LIGHTING CONTROLS. RECONNECT TO DESIGNATED LIGHTS AND CIRCUITS. PROVIDE NEW DEVICES AND NECESSARY WIRING.
 2. NEW LIGHTING CONTROLS IN THIS AREA. CONNECT TO EXISTING CIRCUITS AND PROVIDE NECESSARY WIRING.
 3. CONNECT TO EXISTING CIRCUIT IN THIS AREA. PROVIDE NECESSARY WIRING.
 4. CONNECT TO CIRCUIT INDICATED THROUGH LIGHTING RELAY PANEL IN ELECTRICAL ROOM 118. SEE DRAWING E201C. SEE DRAWING E-403 FOR RELAY PANEL AND CONTROL DETAILS. COORDINATE LOCATION WITH ARCHITECT AND BLOCK COURSING.
 5. REWORK AS REQUIRED TO ADD OCCUPANCY SENSORS AND MODIFICATIONS REQUIRED BY NEW CONSTRUCTION. REWIRE TO EXISTING CIRCUIT IN THE AREA. PROVIDE NEW LIGHT SWITCHES.
 6. ALL NEW EMERGENCY LIGHTS AND EXIT SIGNS IN THIS AREA TO BE CONNECTED TO EXISTING CIRCUITS.
 7. RELOCATED EXIT SIGN OR EMERGENCY LIGHT. REPLACE EXISTING FIXTURE WITH FIXTURE SPECIFIED.



CSO
6831 Keystone Crossing, Indianapolis, IN 46240
317.847.7800 | CSOinc.net
© 2015 CSO Architects, Inc. All Rights Reserved.

DNA #22054
R.E. Dimond
and Associates, Inc.
Consulting Engineers
732 North Capitol Avenue
Phone: (317) 634-4672
Fax: (317) 638-8725

PROJECT:
**BARTHOLOMEW CONSOLIDATED
SCHOOL CORPORATION
RENOVATIONS TO
L. C. SCHMITT ELEMENTARY**
2675 California St, Columbus, IN 47201

SCOPE DRAWINGS:
These drawings indicate the general scope of the project. The drawings do not constitute a contract. The drawings of electrical, mechanical and electrical systems. The drawings do not necessarily indicate or describe all work required for the performance and completion of the project. On the basis of the general scope indicated on drawings, the contractor shall furnish all items required for the proper execution and completion of the work.

REVISIONS:
2 ADDENDUM #2 03/15/2024

ISSUE DATE	DRAWN BY	CHECKED BY
02/16/2024	GSR	DEW


DRAWING TITLE:
**FIRST FLOOR
PLAN - UNIT D -
LIGHTING**

CERTIFIED BY:
TIMOTHY E. HILL
REGISTERED
No. PE19800083
STATE OF INDIANA
PROFESSIONAL ENGINEER
Timothy E. Hill
02/16/2024

DRAWING NUMBER
E201D

PROJECT NUMBER
22054

KEY PLAN

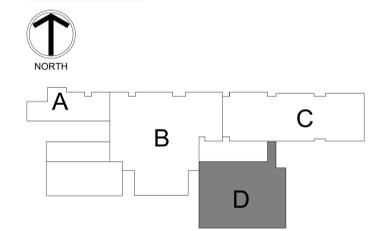

RENOVATION LEGEND:

- WORK TO BE INSTALLED
- WORK TO REMAIN

GENERAL NOTES:


1. SEE E001 FOR GENERAL NOTES.
2. LIGHT FIXTURES CONTAINING PREFIX 'E' ARE RELOCATED FIXTURES. SEE E001 SHEET FOR SALVAGED LIGHT FIXTURE SCHEDULE.
3. PLAN NOTES ANNOTATED INSIDE SQUARE SYMBOLS ARE PART OF ALTERNATE BID PACKAGE FOR LIGHTING.

PLAN NOTES:

1. EXISTING CLASSROOM LIGHTING TO REMAIN. REWORK AS REQUIRED TO ADD OCCUPANCY SENSORS, MANUAL CONTROLS, MODIFICATIONS REQUIRED BY NEW CONSTRUCTION. REWIRE TO CIRCUIT INDICATED.
2. CONNECT LIGHT FIXTURE TO EXISTING CIRCUIT IN THIS AREA.
3. EXISTING CORRIDOR LIGHTING TO REMAIN. REWORK AS REQUIRED TO ADD OCCUPANCY SENSORS, MODIFICATIONS REQUIRED BY NEW CONSTRUCTION. REWIRE TO EXISTING CIRCUIT IN THE AREA.
4. MOUNT LIGHTING FIXTURE(S) 9'-0" AFF.

PLAN NOTES (ALTERNATE LIGHTING BID):


1. REMOVE LIGHT FIXTURE AND REPLACE WITH FIXTURE TYPE 'F10-24'. REPLACEMENT FIXTURE TO BE MOUNTED AT SAME HEIGHT AS FIXTURE REMOVED.
2. PROVIDE DIMMER SWITCHES INSTEAD OF TOGGLE SWITCHES.

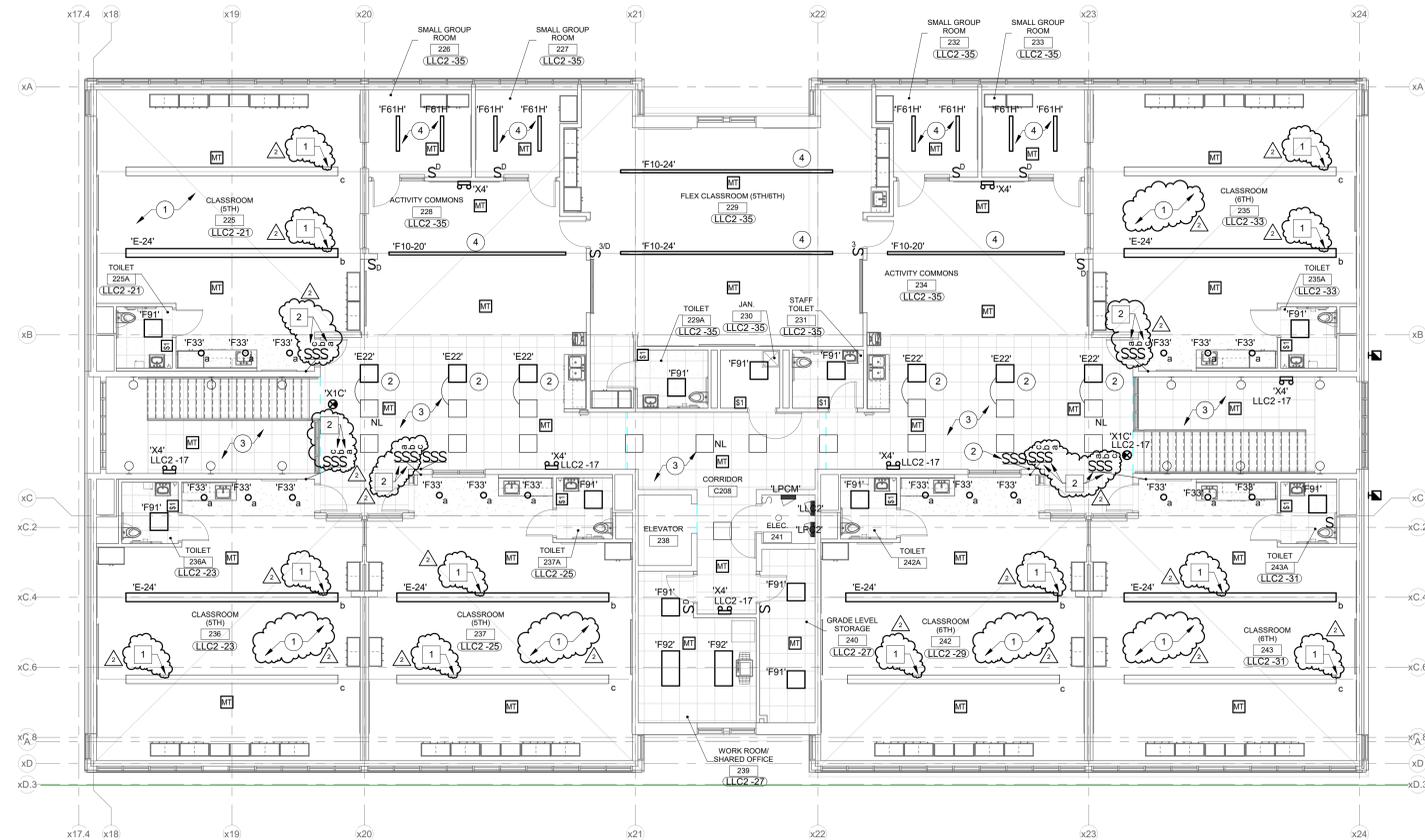

SECOND FLOOR - UNIT C - LIGHTING
SCALE: 1/8" = 1'-0"
NORTH



KEY PLAN

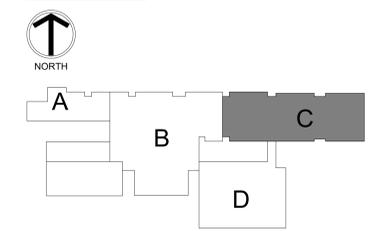

RENOVATION LEGEND:


-  WORK TO BE INSTALLED
-  WORK TO REMAIN

GENERAL NOTES:

1. SEE E001 FOR GENERAL NOTES.

PLAN NOTES:


1. UTILITY TUNNEL EXISTING ELECTRICAL DEVICES, WIRING, FEEDERS SHALL REMAIN UNLESS OTHERWISE NOTED.
2. TYPICAL EXISTING PIPE AND CONDUIT TRENCH IN FIRST FLOOR SLAB TO REMAIN. REWORK UTILITIES AS REQUIRED.
3. BOILER ROOM. SEE E301.

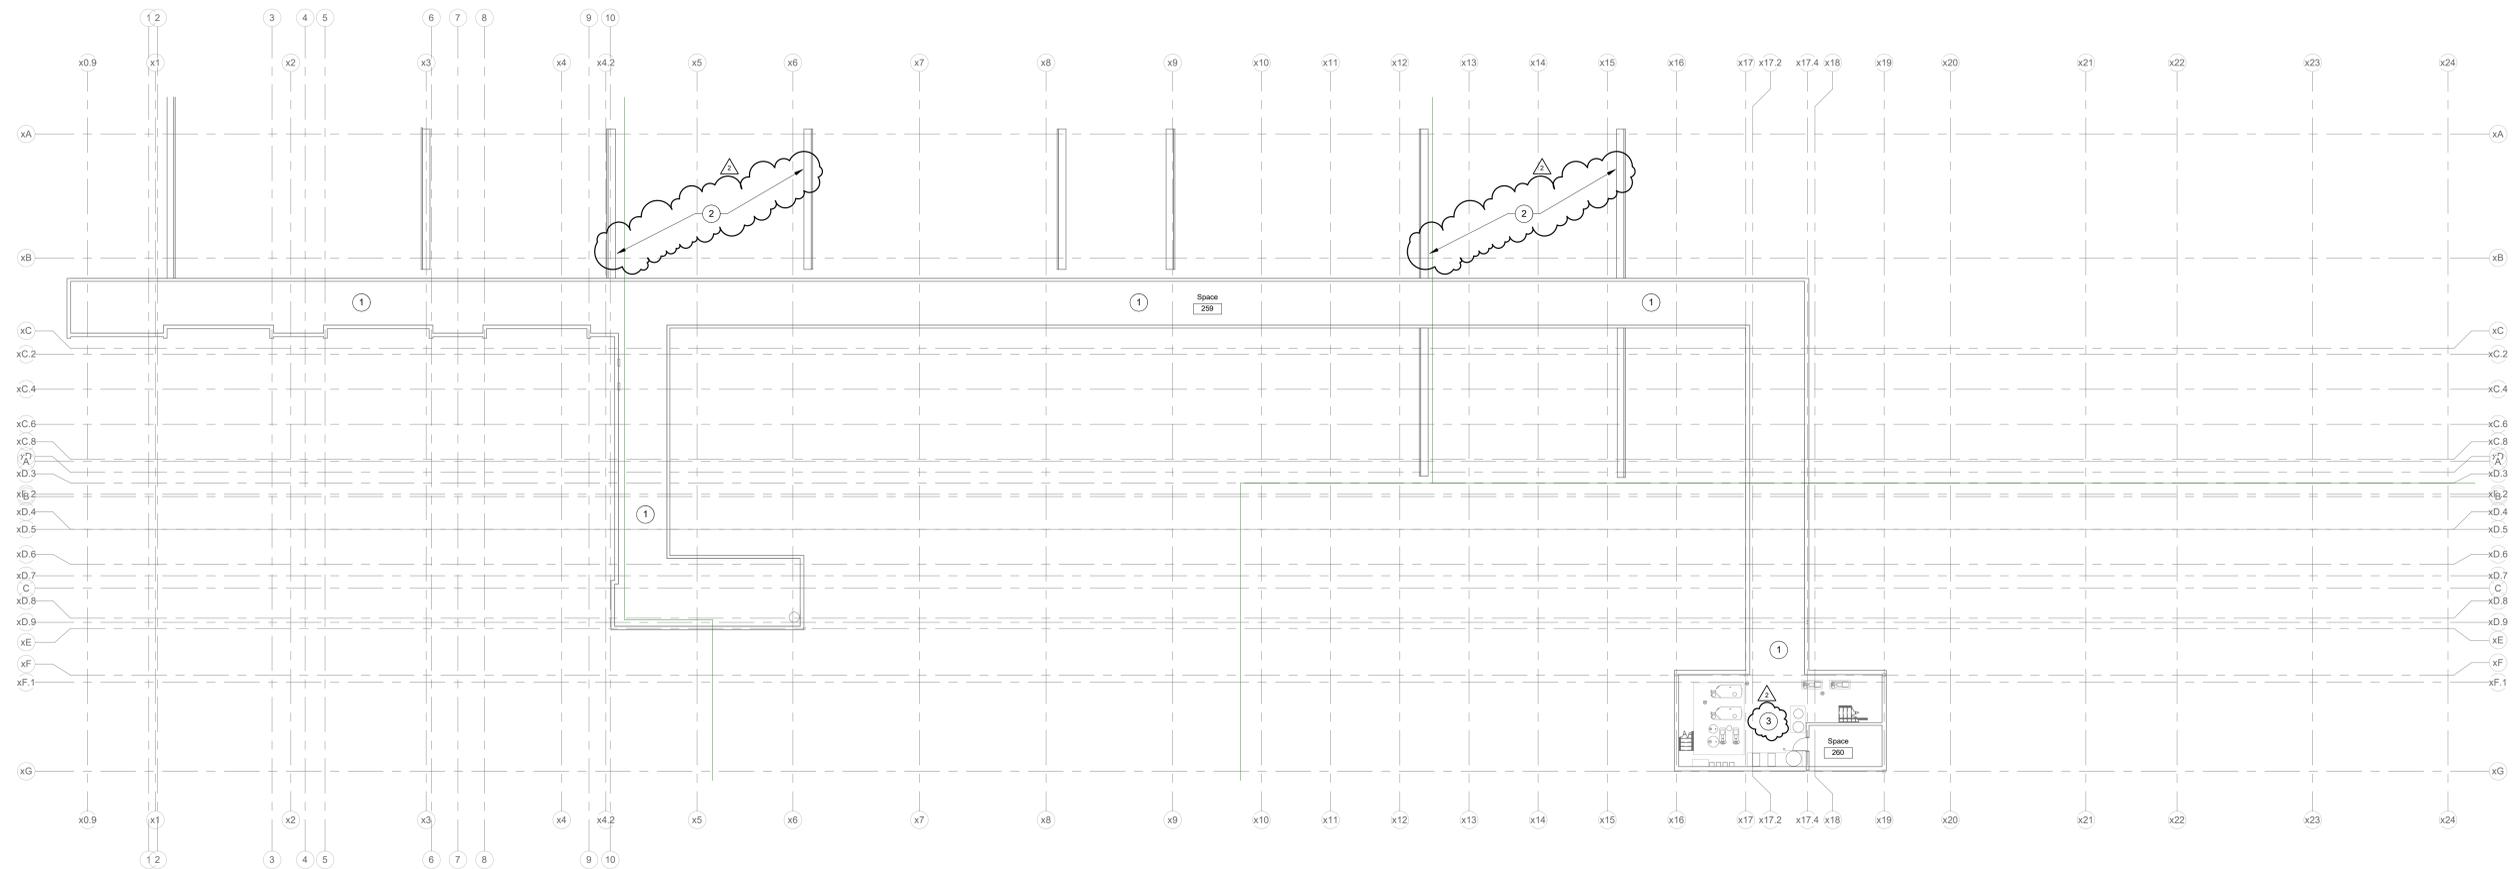

TUNNEL LEVEL - POWER
SCALE: 1/16" = 1'-0"
NORTH



KEY PLAN

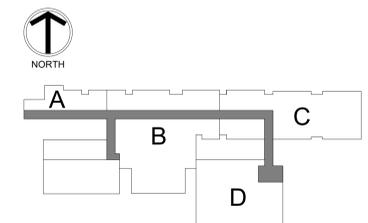

PROJECT:
BARTHOLOMEW CONSOLIDATED SCHOOL CORPORATION RENOVATIONS TO L. C. SCHMITT ELEMENTARY
2675 California St, Columbus, IN 47201

SCOPE DRAWINGS:
These drawings indicate the general scope of the project. The drawings are not intended to be used for the construction of any mechanical, electrical, or plumbing system. The drawings do not necessarily indicate or describe all work required for the performance and completion of the project. On the basis of the general scope indicated on drawings, the contractor shall furnish all items required for the proper execution and completion of the work.

REVISIONS:
2 ADDENDUM #2 03/15/2024


ISSUE DATE 02/16/2024
DRAWN BY GSR
CHECKED BY DEW

DRAWING TITLE:
TUNNEL PLAN - POWER



DRAWING NUMBER
E210

PROJECT NUMBER
22054

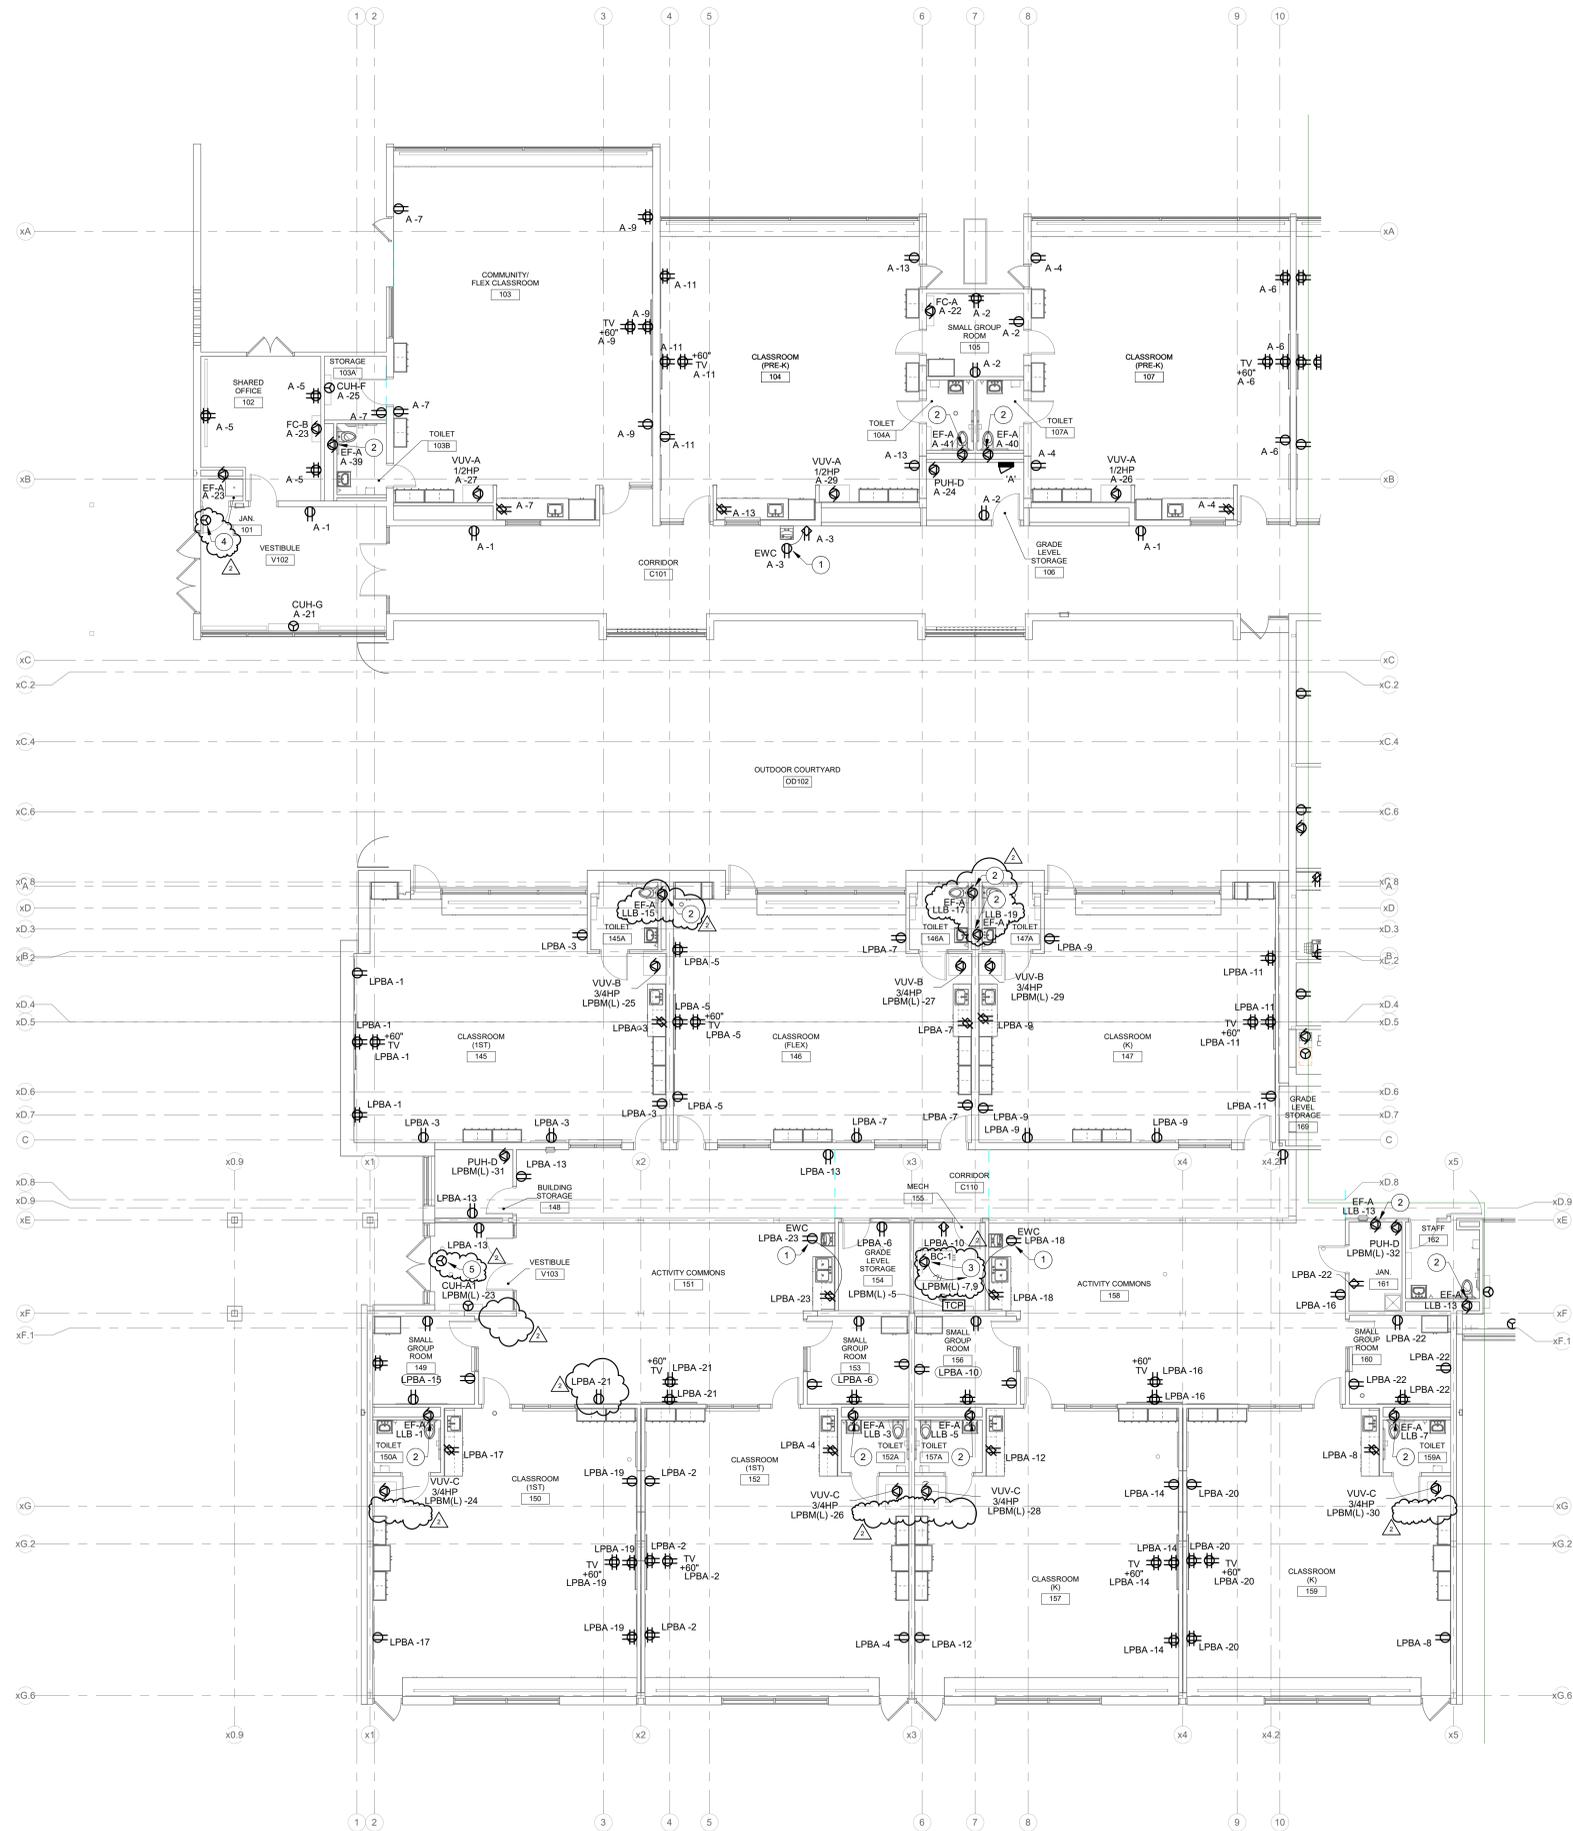

RENOVATION LEGEND:

- WORK TO BE INSTALLED
- WORK TO REMAIN


GENERAL NOTES:

1. SEE E001 FOR GENERAL NOTES.
- # PLAN NOTES:**
1. FEED FROM LOAD SIDE OF NEAREST GFCI RECEPTACLE.
 2. EXHAUST FAN TO BE CONNECTED TO LIGHTING CIRCUIT AND CONTROLS IN THIS AREA. SEE E200 SERIES.
 3. ELECTRICAL CONTRACTOR TO PROVIDE COMBINATION MOTOR STARTER AND DISCONNECT FOR BLOWER COIL.
 4. EXISTING DOOR ACCESS CONTROLS TO REMAIN. REPLACE EXISTING 120V CIRCUIT FROM NEW PANEL 'A'.
 5. PROVIDE A DEDICATED 120V CIRCUIT FOR DOOR ACCESS CONTROLS FROM PANEL LPBA.

FIRST FLOOR - UNIT A - POWER
 SCALE: 1/8" = 1'-0"
 NORTH



KEY PLAN

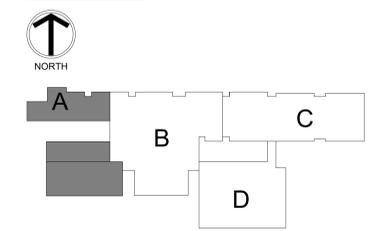

BARTHOLOMEW CONSOLIDATED SCHOOL CORPORATION
SCHOOL CORPORATION RENOVATIONS TO
L. C. SCHMITT ELEMENTARY
 2675 California St, Columbus, IN 47201

SCOPE DRAWINGS:
 These drawings indicate the general scope of the project in terms of mechanical design content. The structural, electrical, mechanical and electrical systems. The drawings do not necessarily indicate or describe all work required for full performance and completion of the Contract.
 On the basis of the general scope indicated on drawings, the trade contractors shall furnish all items required for the proper execution and completion of the work.

REVISIONS:
 2 ADDENDUM #2 03/15/2024


ISSUE DATE	DRAWN BY	CHECKED BY
02/16/2024	GSR	DEW

DRAWING TITLE:
FIRST FLOOR PLAN - UNIT A - POWER



DRAWING NUMBER
E211A

PROJECT NUMBER
22054

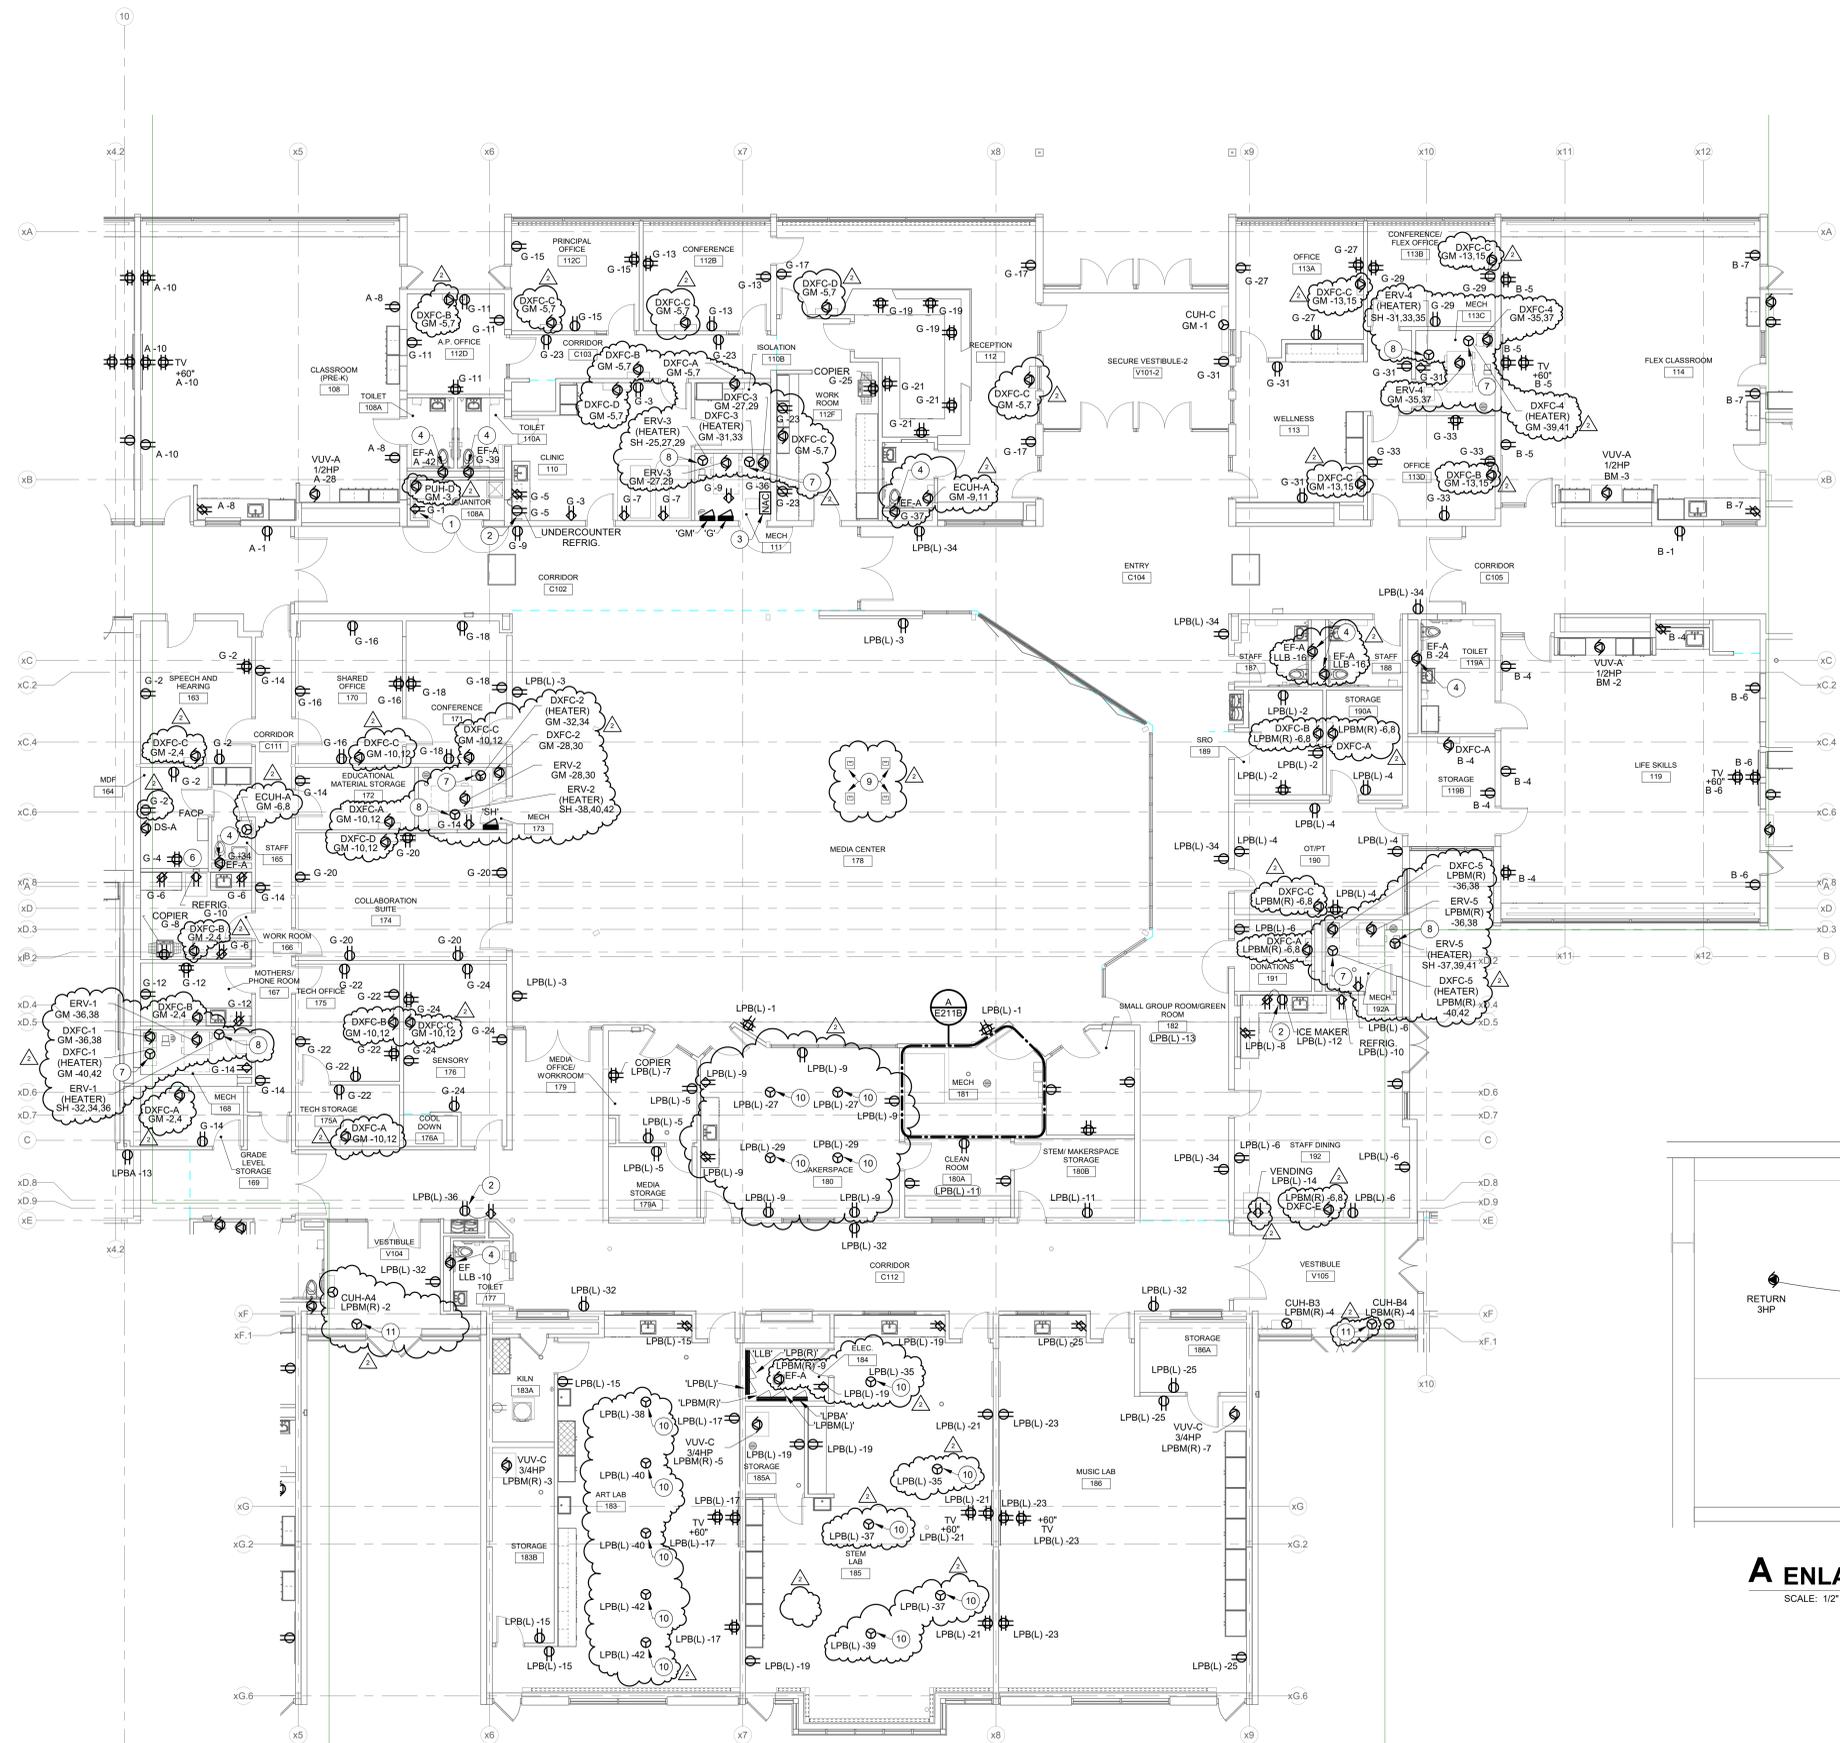


FIRST FLOOR - UNIT B - POWER
SCALE: 1/8" = 1'-0"

RENOVATION LEGEND:

- WORK TO BE INSTALLED
- WORK TO REMAIN


GENERAL NOTES:

1. SEE E001 FOR GENERAL NOTES.
 2. PROVIDE A LOCAL ON/OFF SWITCH AT EACH DXFC, ERV, AND BSB MECHANICAL UNIT.
- PLAN NOTES:**
1. INSTALL DEVICE 36 INCH ABOVE FINISH FOR WASHER. COORDINATE WITH PLUMBING.
 2. FEED FROM LOAD SIDE OF NEAREST GFCI RECEPTACLE.
 3. RELOCATED EXISTING NOTIFICATION APPLIANCE CIRCUIT PANEL. PANEL TO BE RECONNECTED TO ALL PREVIOUSLY SERVED FIRE ALARM DEVICES. CONNECT TO SPECIFIED PANELBOARD AND CIRCUIT.
 4. EXHAUST FAN TO BE CONNECTED TO LIGHTING CIRCUIT AND CONTROLS IN THIS AREA. SEE E200 SERIES.
 5. VFD'S PROVIDED BY TEMPERATURE CONTROL CONTRACTOR AND INSTALLED BY ELECTRICAL CONTRACTOR. E.C. TO PROVIDE SUPPORT RACKS IF NECESSARY. E.C. TO DO ALL WIRING.
 6. PROVIDE A DEDICATED 120V/1P RECEPTACLE INSIDE TELECOMMUNICATIONS RACK.
 7. PROVIDE A DEDICATED 20A, 208V-1Ø CIRCUIT TO DXFC ELECTRIC DUCT HEATER. PROVIDE LOCAL ON/OFF SWITCH AT HEATER.
 8. PROVIDE A DEDICATED 20A, 480V-3Ø CIRCUIT TO ERV ELECTRIC DUCT HEATER. HEATER HAS DOOR INTERLOCK DISCONNECT.
 9. ALL EXISTING FLOOR BOXES IN THIS AREA TO REMAIN.
 10. PROVIDE A HUBBELL #HDL25123GF220M1 CORD REEL. ALIGN WITH PROPOSED STUDENT DESK LAYOUT. ADJUST CORD LENGTH AS DIRECTED. PROVIDE RECEPTACLE ON CEILING FOR CORD REEL PLUS IN.
 11. EXISTING DOOR ACCESS CONTROLS TO REMAIN. REPLACE EXISTING

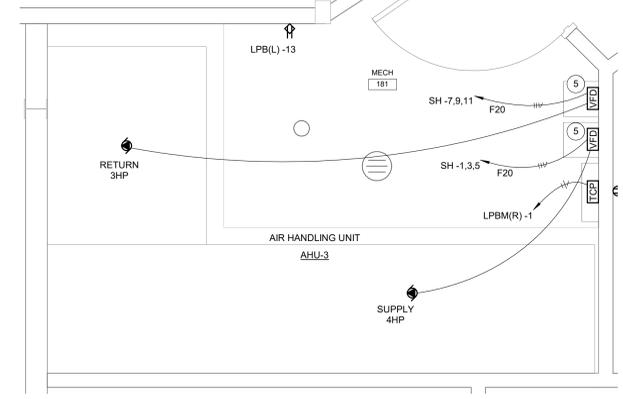

A ENLARGED MECH 181 - POWER
SCALE: 1/2" = 1'-0"

KEY PLAN

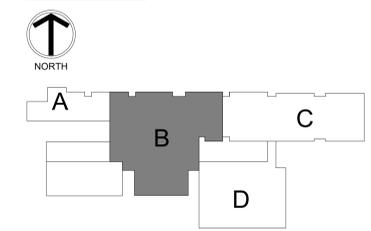

SCOPE DRAWINGS:
These drawings indicate the general scope of the project. The drawings are not intended to be a substitute for the detailed design and construction documents. The contractor shall verify all items required for the proper installation and completion of the work.

REVISIONS:	DATE:
2 ADDENDUM #2	03/15/2024

ISSUE DATE:	DRAWN BY:	CHECKED BY:
02/16/2024	GSR	DEW

DRAWING TITLE:
FIRST FLOOR PLAN - UNIT B - POWER

CERTIFIED BY:
TIMOTHY E. HILL
REGISTERED PROFESSIONAL ENGINEER
No. PE19800083
STATE OF INDIANA
02/16/2024

DRAWING NUMBER:
E211B

PROJECT NUMBER:
22054

RENOVATION LEGEND:


-  WORK TO BE INSTALLED
-  WORK TO REMAIN

GENERAL NOTES:

1. SEE E001 FOR GENERAL NOTES.



PLAN NOTES:

1. FEED FROM LOAD SIDE OF NEAREST GFCI RECEPTACLE.
2. EXHAUST FAN TO BE CONNECTED TO LIGHTING CIRCUIT AND CONTROLS IN THIS AREA. SEE E200 SERIES.
3. PROVIDE A DEDICATED 120V/1P RECEPTACLE INSIDE TELECOMMUNICATIONS RACK.

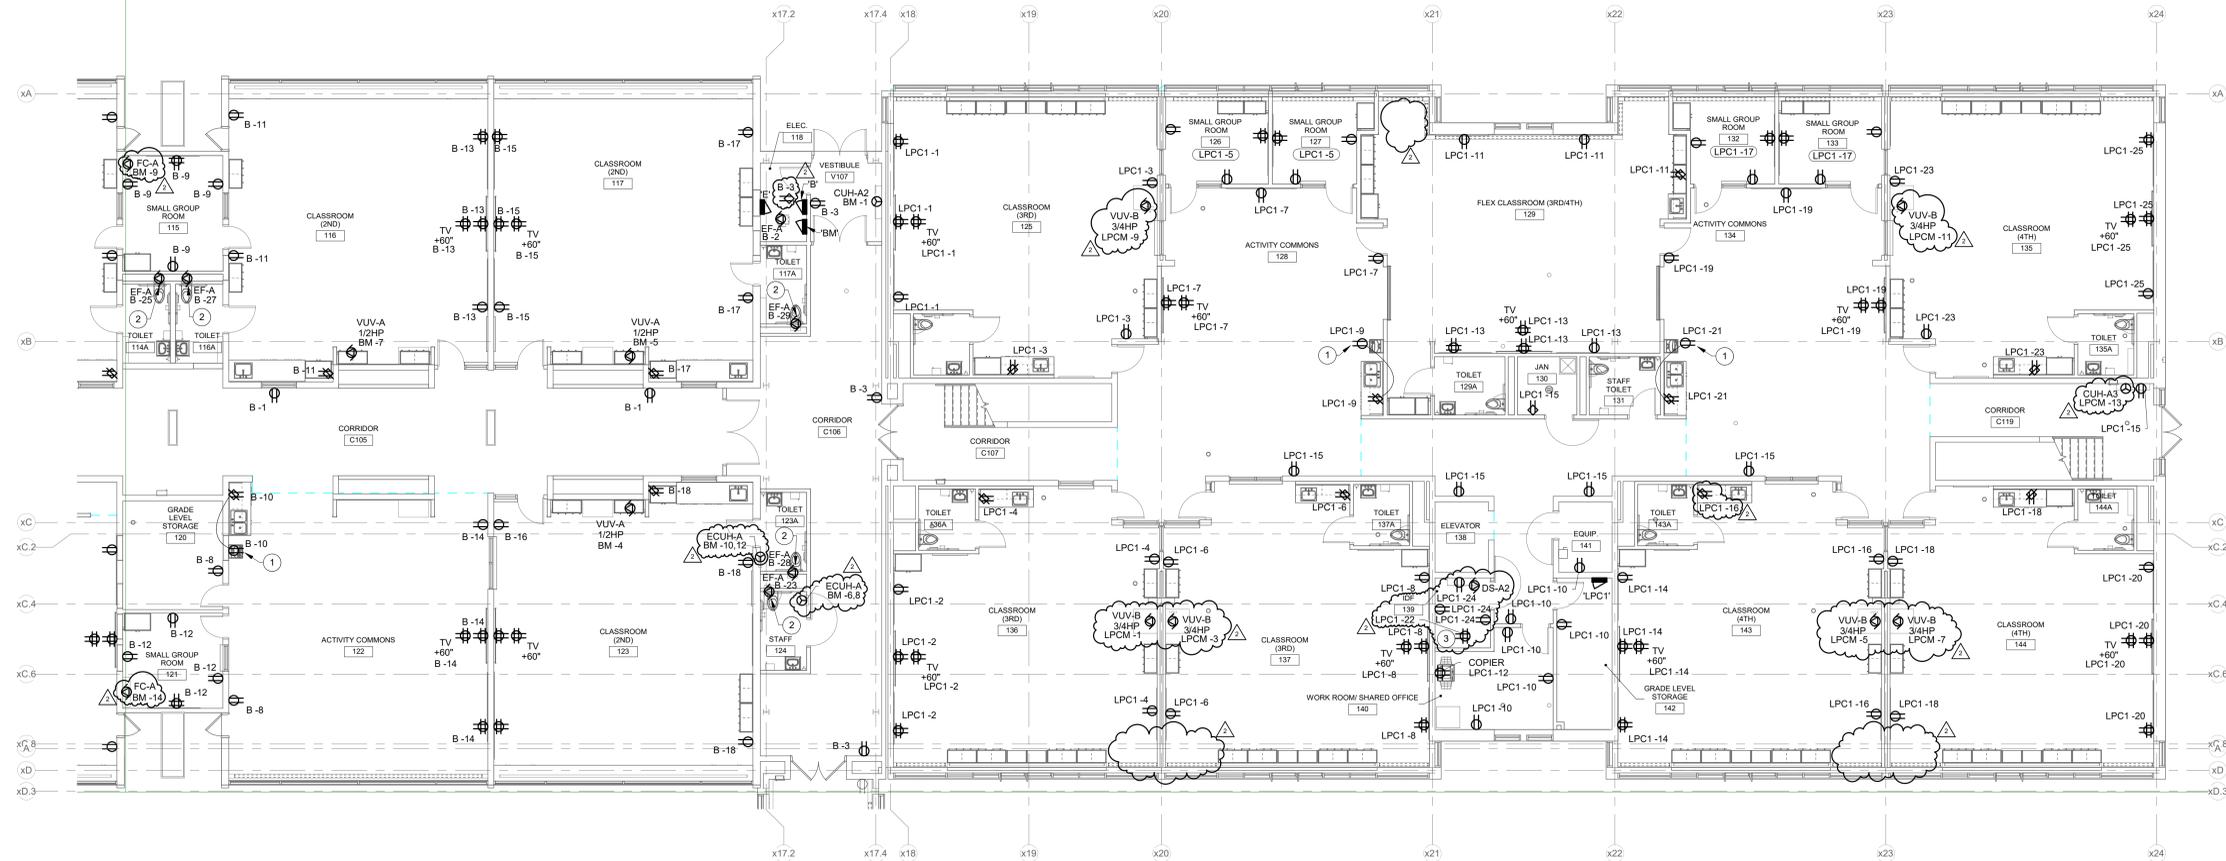

FIRST FLOOR - UNIT C - POWER
SCALE: 1/8" = 1'-0"
NORTH

KEY PLAN

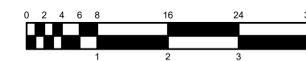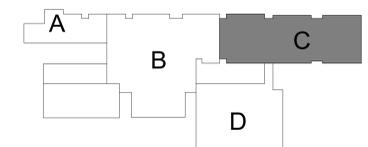

SCOPE DRAWINGS:
These drawings indicate the general scope of the project. The drawings are not intended to be a contract. The drawings are not intended to be a contract. The drawings are not intended to be a contract. The drawings are not intended to be a contract.

REVISIONS:
2 ADDENDUM #2 03/15/2024

ISSUE DATE	DRAWN BY	CHECKED BY
02/16/2024	GSR	DEW

DRAWING TITLE:
**FIRST FLOOR
PLAN - UNIT C -
POWER**



DRAWING NUMBER
E211C

PROJECT NUMBER
22054

RENOVATION LEGEND:


-  WORK TO BE INSTALLED
-  WORK TO REMAIN

GENERAL NOTES:

1. SEE E001 FOR GENERAL NOTES.

PLAN NOTES:


1. FEED FROM LOAD SIDE OF NEAREST GFCI RECEPTACLE.

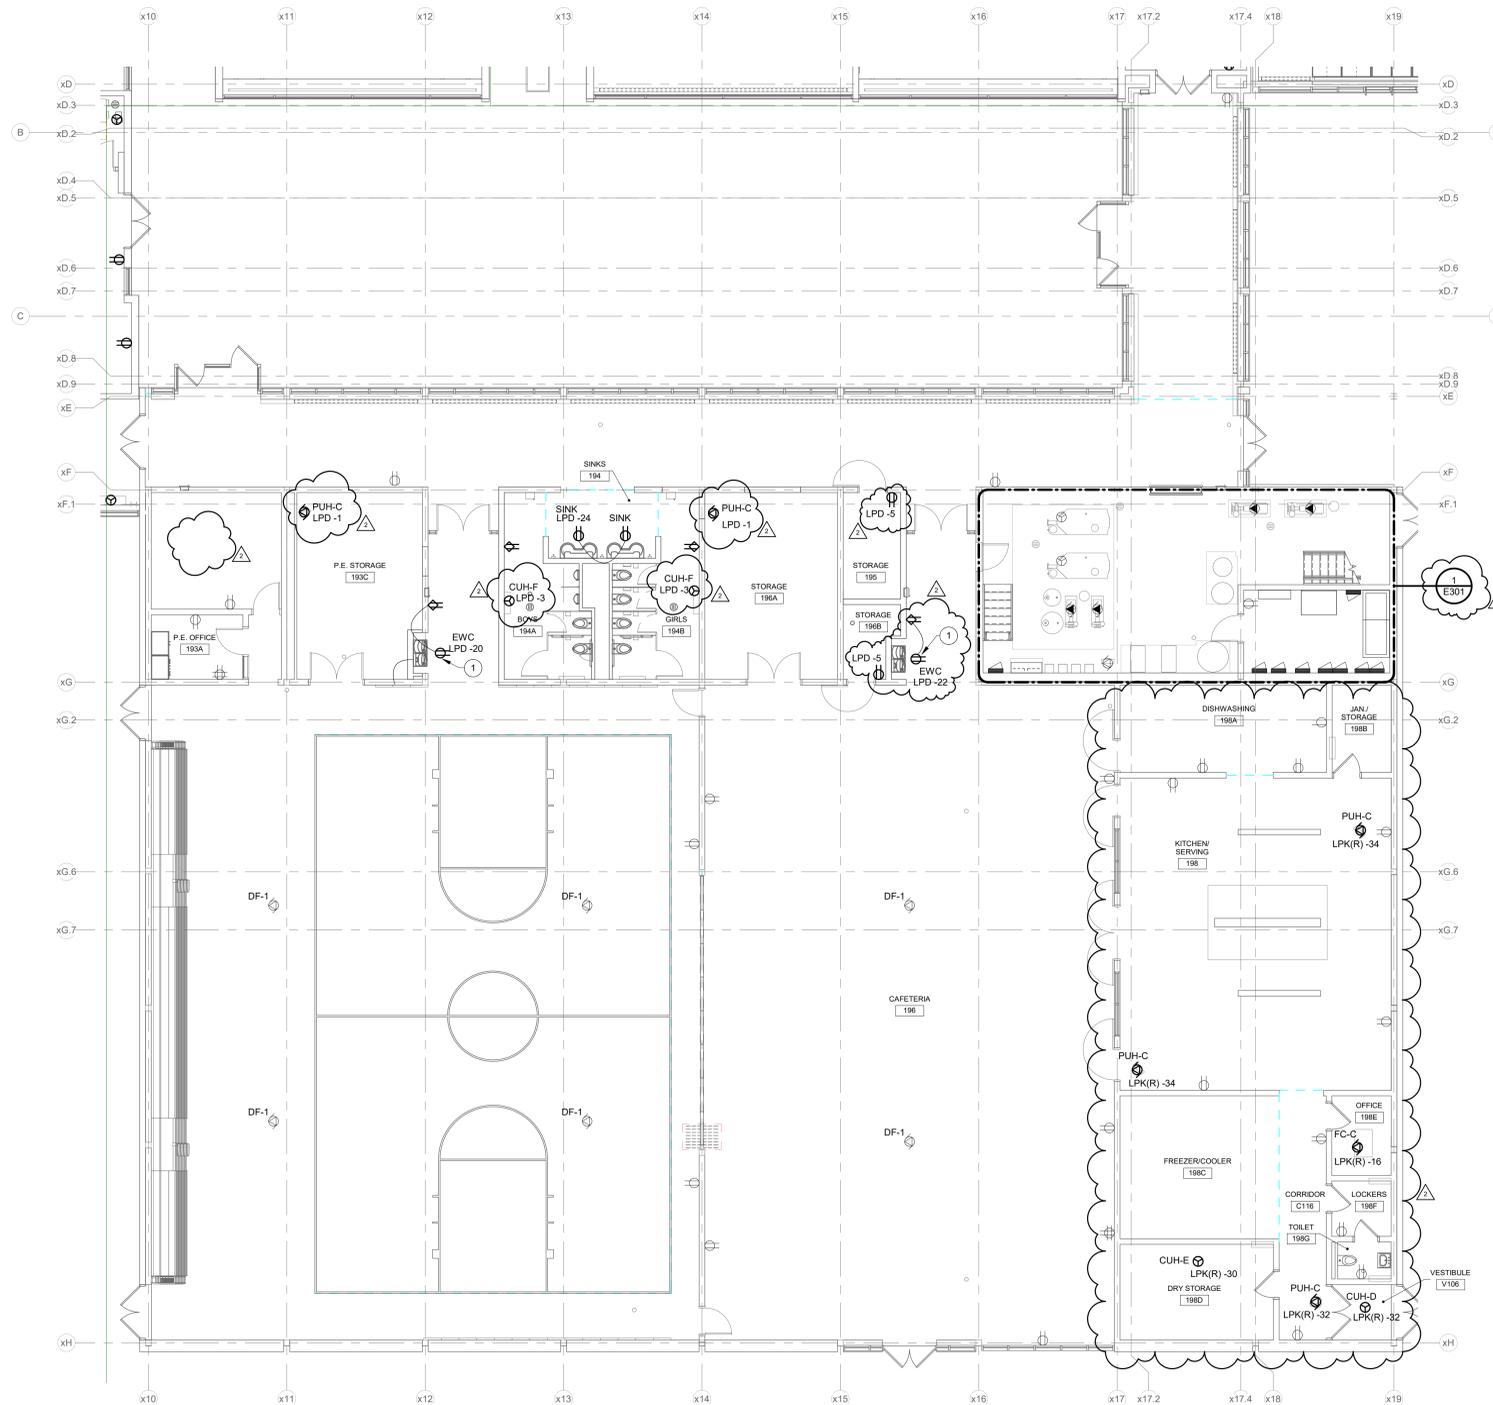

FIRST FLOOR - UNIT D - POWER
SCALE: 1/8" = 1'-0"
NORTH



KEY PLAN

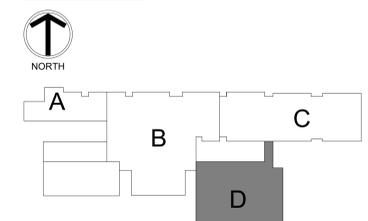

CSO
8831 Keystone Crossing, Indianapolis, IN 46240
317.842.7800 | CSOInc.net
© 2018 CSO Architects, Inc. All Rights Reserved.

DCA #22054
R.E. Dimond
and Associates, Inc.
Consulting Engineers
732 North Capitol Avenue
Indianapolis, IN 46204
Phone: (317) 634-4672
Fax: (317) 638-8725

PROJECT:
**BARTHOLOMEW CONSOLIDATED
SCHOOL CORPORATION
RENOVATIONS TO
L. C. SCHMITT ELEMENTARY**
2675 California St, Columbus, IN 47201

SCOPE DRAWINGS:
These drawings indicate the general scope of the project in terms of mechanical design concept, the structure of electrical, mechanical and electrical systems.
The drawings do not necessarily indicate or describe all work required for the performance and completion of the project.
On the basis of the general scope indicated on drawings, the trade contractors shall furnish all items required for the proper execution and completion of the work.

REVISIONS:
2 ADDENDUM #2 03/15/2024

ISSUE DATE 02/16/2024
DRAWN BY GSR
CHECKED BY DEW

DRAWING TITLE:
**FIRST FLOOR
PLAN - UNIT D -
POWER**

CERTIFIED BY:
TIMOTHY E. HILL
No. PE19800083
STATE OF INDIANA
PROFESSIONAL ENGINEER
Timothy E. Hill
02/16/2024

DRAWING NUMBER
E211D

PROJECT NUMBER
22054

RENOVATION LEGEND:


-  WORK TO BE INSTALLED
-  WORK TO REMAIN

GENERAL NOTES:

1. SEE E001 FOR GENERAL NOTES.

PLAN NOTES:


1. FEED FROM LOAD SIDE OF NEAREST GFCI RECEPTACLE.
2. CONTROL WIRING TO AIR HANDLING UNIT (AHU-4) SUPPLY FAN ON UNIT C ROOF, 3#12, 1#12 GND, 3/4" C.
3. CONTROL WIRING TO AIR HANDLING UNIT (AHU-4) RETURN FAN ON UNIT C ROOF, 3#12, 1#12 GND, 3/4" C.

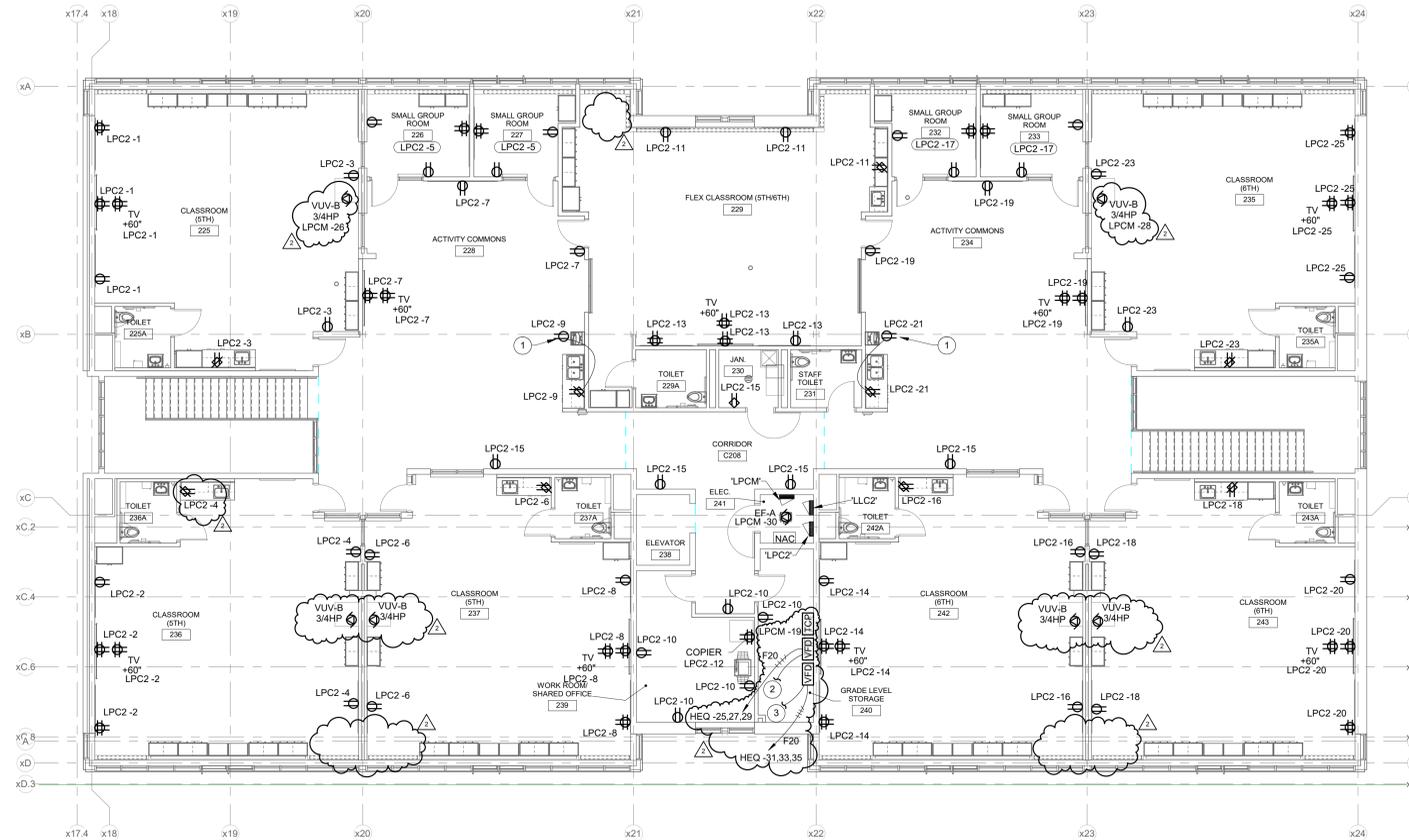

SECOND FLOOR - UNIT C - POWER
SCALE: 1/8" = 1'-0"
NORTH



KEY PLAN

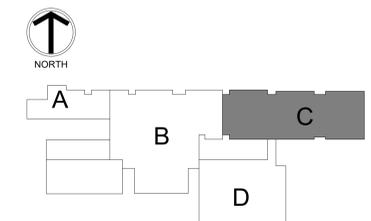

SCOPE DRAWINGS:
These drawings indicate the general scope of the project. The drawings do not necessarily indicate or describe all work required for the performance and completion of the project. On the basis of the general scope indicated on these drawings, the contractor shall furnish all items required for the proper execution and completion of the work.

REVISIONS:
2 ADDENDUM #2 03/15/2024

ISSUE DATE	DRAWN BY	CHECKED BY
02/16/2024	GSR	DEW

DRAWING TITLE:
SECOND FLOOR PLAN - UNIT C - POWER

CERTIFIED BY:

Timothy E. Hill
02/16/2024

DRAWING NUMBER
E212C

PROJECT NUMBER
22054

RENOVATION LEGEND:


- WORK TO BE INSTALLED
- WORK TO REMAIN

GENERAL NOTES:

1. REFER TO SHEET E001 FOR ADDITIONAL GENERAL NOTES.

PLAN NOTES:


1. INSTALL DUCT MOUNTED SMOKE DETECTOR IN RTU RETURN DUCT AND WIRE TO SHUT DOWN.

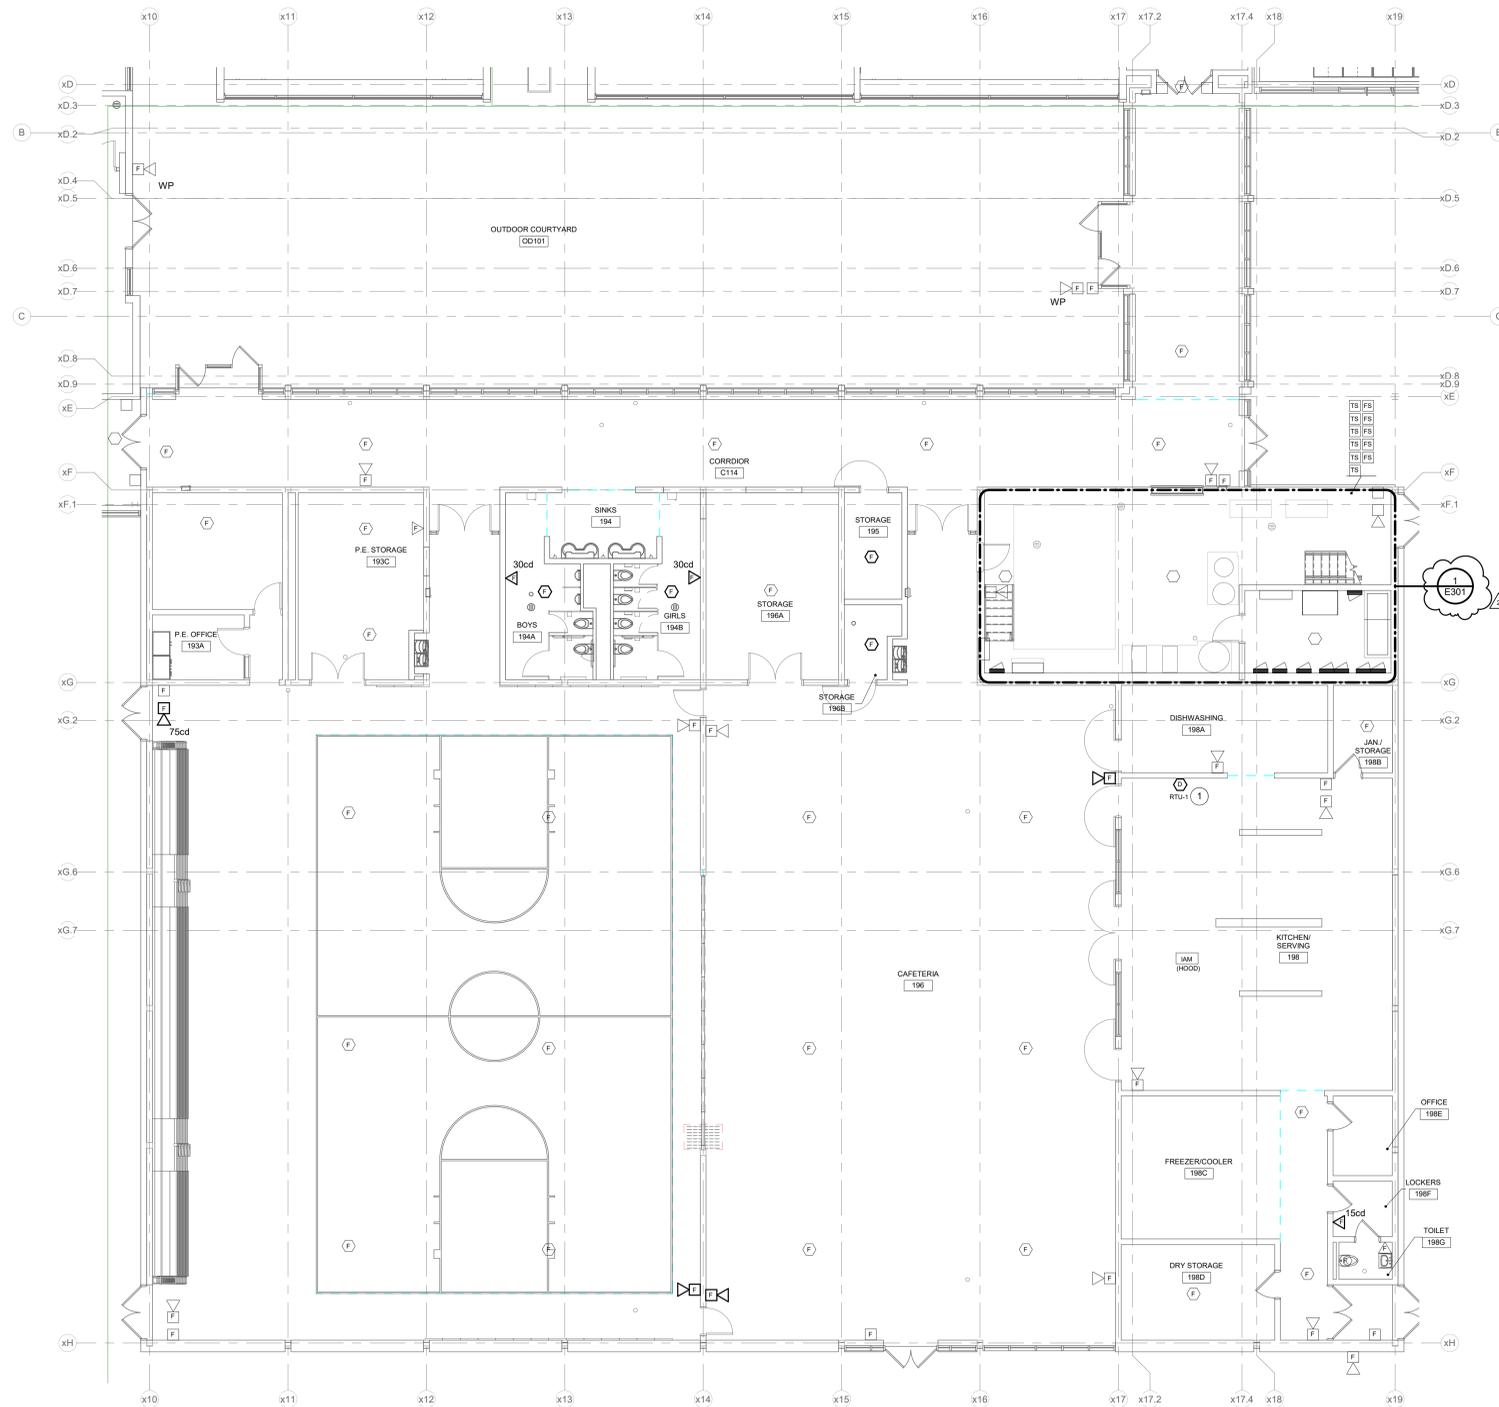

FIRST FLOOR - UNIT D - FIRE ALARM
SCALE: 1/8" = 1'-0"
NORTH



KEY PLAN

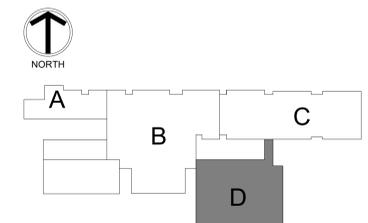

RENOVATION LEGEND:


- WORK TO BE INSTALLED
- WORK TO REMAIN

GENERAL NOTES:

1. SEE E001 FOR GENERAL NOTES.

PLAN NOTES:


1. INSTALL DUCT MOUNTED SMOKE DETECTOR IN AHU RETURN DUCT AND WIRE TO SHUT DOWN AHU.
2. PROVIDE NEW MOTOR STARTER FOR EXISTING MECHANICAL EQUIPMENT. RECONNECT MECHANICAL EQUIPMENT TO SPECIFIED CIRCUIT. PROVIDE NECESSARY WIRING.
3. VFDs PROVIDED BY TEMPERATURE CONTROL CONTRACTOR AND INSTALLED BY ELECTRICAL CONTRACTOR. E.C. TO PROVIDE SUPPORT RACKS IF NECESSARY. E.C. TO DO ALL WIRING.
4. PROVIDE A DEDICATED 120V/1P RECEPTACLE INSIDE TELECOMMUNICATIONS RACK.
5. MOUNT VFDs AND TCPs TO CONTRACTOR PROVIDED UNISTRUT.
6. CONTROL WIRING TO ROOFTOP UNIT RTU-1 LOCATED ON ROOF. 3#10, 1#10 GND, 3/4" C.

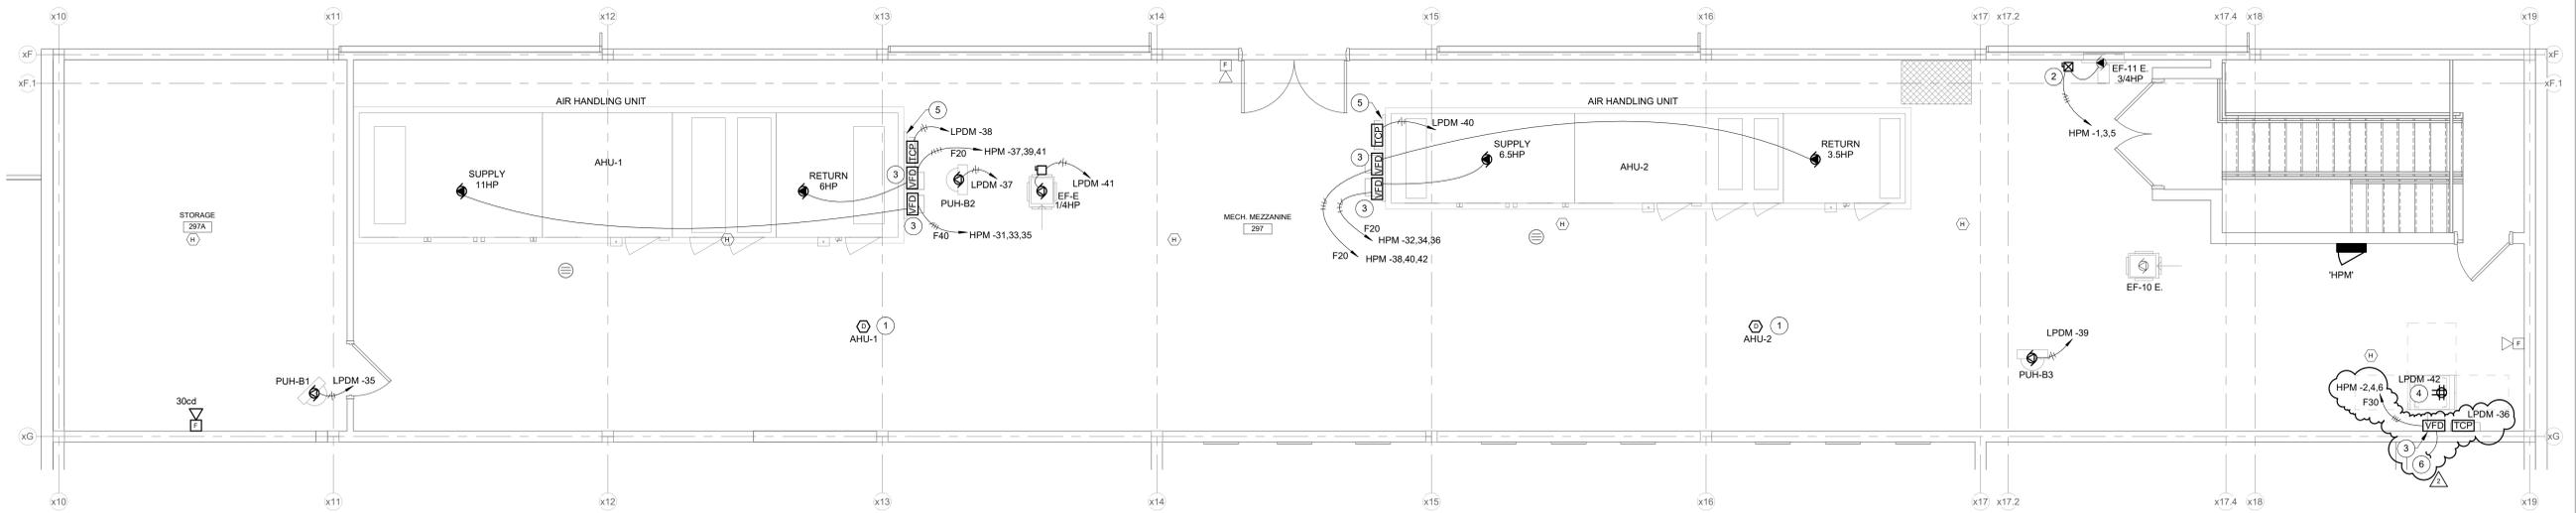

MEZZANINE LEVEL PLAN - POWER AND SIGNAL
SCALE: 1/4" = 1'-0"
NORTH



KEY PLAN

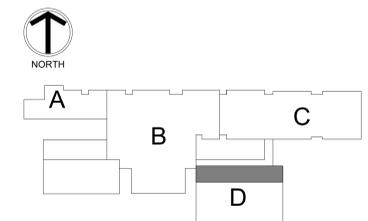

BARTHOLOMEW CONSOLIDATED SCHOOL CORPORATION RENOVATIONS TO L. C. SCHMITT ELEMENTARY
2675 California St, Columbus, IN 47201

SCOPE DRAWINGS:
These drawings indicate the general scope of the project in terms of mechanical design concept, the arrangement of structural, mechanical and electrical systems. The drawings do not necessarily indicate or describe all work required for the performance and completion of the project. On the basis of the general scope indicated on drawings, the trade contractors shall furnish all items required for the proper execution and completion of the work.

REVISIONS:
2 ADDENDUM #2 03/15/2024


ISSUE DATE	DRAWN BY	CHECKED BY
02/16/2024	GSR	DEW

DRAWING TITLE:
ENLARGED MEZZANINE LEVEL PLAN - ELECTRICAL




DRAWING NUMBER
E302

PROJECT NUMBER
22054

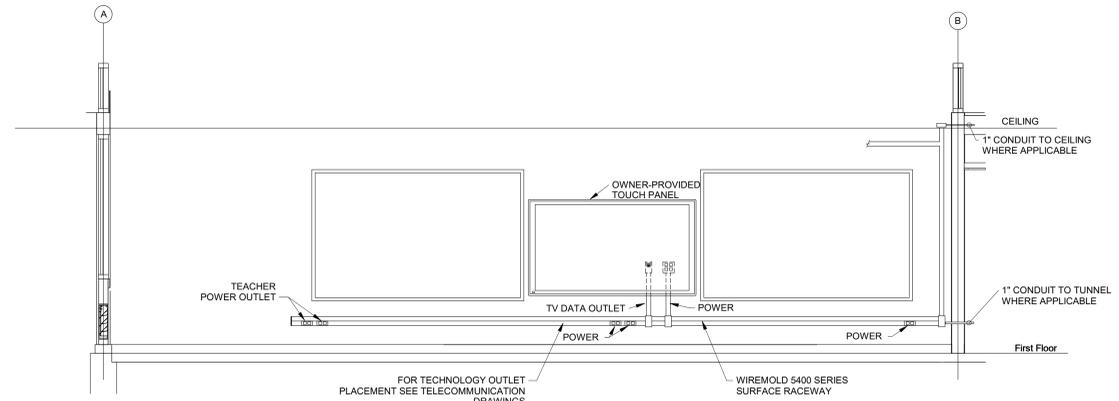

**TYPICAL ACTIVITY COMMONS
SECONDARY PATHWAY
RACEWAY FOR ELECTRICAL
A**
SCALE: NONE

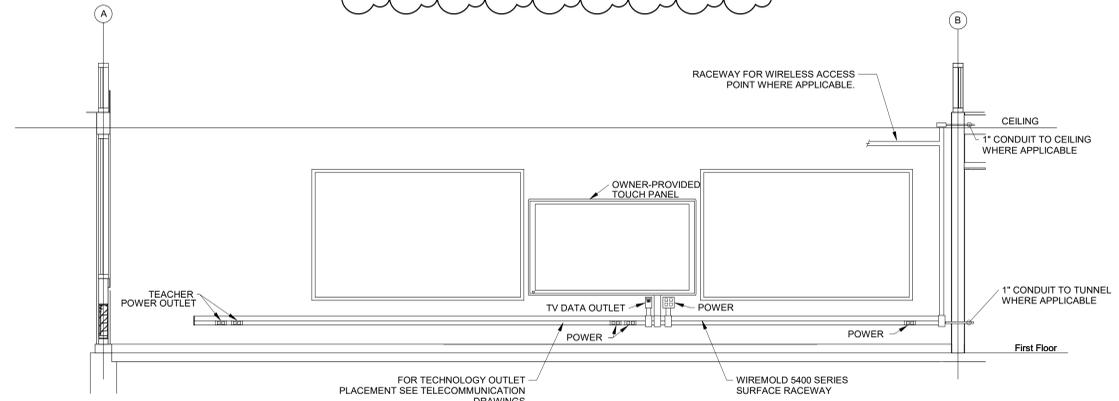

**TYPICAL CLASSROOM
SECONDARY PATHWAY
RACEWAY FOR ELECTRICAL
B**
SCALE: NONE

SALVAGED LIGHT FIXTURE SCHEDULE		
MARK	COUNT	DESCRIPTION
E22	26	EXISTING 2 BY 2-FOOT FIXTURE, RECESSED.
E24	6	EXISTING 2 BY 4-FOOT FIXTURE, SURFACE MOUNTED.
E24R	24	SAME AS 'E24' EXCEPT RECESSED.
E-8	10	EXISTING 8 FOOT FLORESCENT FIXTURE.
E-16	26	SAME AS 'E-8' EXCEPT LENGTH, MADE UP OF 2 SECTIONS OF TYPE 'E-8' FIXTURES.
E-24	10	SAME AS 'E-8' EXCEPT LENGTH, MADE UP OF 3 SECTIONS OF TYPE 'E-8' FIXTURES.

NOTE:

- VERIFY PROPER OPERATION AND REPLACE BALLASTS AND DRIVERS AS REQUIRED.
- REPLACE ALL FLORESCENT TUBES WITH NEW. VERIFY COLOR TEMPERATURE WITH OWNER/ARCHITECT.
- COUNT ONLY SHOWN FOR REFERENCE. VERIFY IN FIELD.
- FIXTURES MAY BE TAKEN APART TO FORM DESIRED LENGTHS.
- ALL RELOCATED FIXTURES MUST BE MOUNTED TO MATCH EXISTING (OR PREVIOUSLY EXISTING) FIXTURES IN RELOCATION AREA.

LIGHT FIXTURE SCHEDULE											
MARK	DESCRIPTION	MOUNTING	TOTAL FIXTURE WATTS	CRI	WATTS	COLOR	LUMENS	VOLTS	MANUFACTURER(S)		MARK
F01-12	LINEAR DIREC 2.5-INCH WIDE BY LENGTH INDICATED, ALUMINUM HOUSING, ADJUSTABLE COLOR TEMPERATURE, WHITE LENS, 0-10V DIMMING.	SURFACE/ SURFACE WALL	90	80	7.5W/FT	3500K	1010/FT	120 V	FINELITE HP-4 R SERIES FOCAL POINT FSM4L SERIES MERCURY ML54 SERIES PINNACLE EV4D SERIES		F01-12
F01-18	SAME AS 'F01-12' EXCEPT DIFFERENT LENGTH.	RECESSED	135	80	7.5W/FT	3500K	1010/FT	120 V	FINELITE HP-4 R SERIES FOCAL POINT FSM4L SERIES MERCURY ML54 SERIES PINNACLE EV4D SERIES		F01-18
F10-4	LINEAR DIRECT/INDIRECT 2.5-INCH WIDE BY LENGTH INDICATED, AIRCRAFT CABLE, ALUMINUM HOUSING, ADJUSTABLE COLOR TEMPERATURE, WHITE LENS, 0-10V DIMMING.	SUSPENDED	40	80	10W/FT	3500K	1319/FT	120 V	JESCO LIN-DI SERIES		F10-4
F10-8	LINEAR DIRECT/INDIRECT 2.5-INCH WIDE BY LENGTH INDICATED, AIRCRAFT CABLE, WHITE LENS, 0-10V DIMMING.	SUSPENDED	80	80	10W/FT	3500K	1319/FT	120 V	JESCO LIN-DI SERIES		F10-8
F10-10	SAME AS 'F10-4' EXCEPT DIFFERENT LENGTH.	SUSPENDED	100	80	10W/FT	3500K	1319/FT	120 V	JESCO LIN-DI SERIES		F10-10
F10-16	SAME AS 'F10-4' EXCEPT DIFFERENT LENGTH.	SUSPENDED	160	80	10W/FT	3500K	1319/FT	120 V	JESCO LIN-DI SERIES		F10-16
F10-20	SAME AS 'F10-4' EXCEPT DIFFERENT LENGTH.	SUSPENDED	200	80	10W/FT	3500K	1319/FT	120 V	JESCO LIN-DI SERIES		F10-20
F10-24	SAME AS 'F10-4' EXCEPT DIFFERENT LENGTH.	SUSPENDED	240	80	10W/FT	3500K	1319/FT	120 V	JESCO LIN-DI SERIES		F10-24
F33	OPEN DOWNLIGHT, 8-INCH DIAMETER APERTURE, CLEAR SEMI-SPECULAR REFLECTOR, SELF FLANGED, 0-10V DIMMING TO 10-PERCENT, NON-IC RATED.	RECESSED	14	80	14.4W	3500K	1100	120 V	HALO COMMERCIAL HC8 SERIES LITHONIA LDNS SERIES PRESCOLITE LC8 SERIES		F33
F60	4-FOOT LENSED INDUSTRIAL, FORMED STEEL HOUSING, WHITE FINISH, SEMI-FROST ACRYLIC DIFFUSER.	SURFACE/ CHAIN HUNG	48	80	48W	3500K	5000	120 V	COLUMBIA MPS SERIES CREE LS4 SERIES LITHONIA ZL1D SERIES METALUX SNLED SERIES		F60
F61	4-FOOT LENSED INDUSTRIAL, FORMED STEEL HOUSING, WHITE FINISH, FROSTED ACRYLIC LENS, SELECTABLE LUMEN OUTPUT AND TEMPERATURE.	SURFACE	38	80	38W	VERIFY	5000	120 V	ILP QWIKLINK		F61
F61H	SAME AS 'F61' EXCEPT SUSPENDED	SUSPENDED	38	80	38W	VERIFY	5000	120 V			F61H
F91	2 BY 2-FOOT FLAT PANEL, ACRYLIC LENS, EDGE-LIT, 0-10V DIMMING TO 10-PERCENT	RECESSED	32	80	32W	3500K	3200	120 V	COLUMBIA CFP22 SERIES CREE C-TR-A-FP22 LITHONIA CPANL22 SERIES METALUX 22FP SERIES		F91
F91S	SAME AS 'F91' EXCEPT SURFACE MOUNTED.	SURFACE	32	80	32W	3500K	3200	120 V			F91S
F92	2 BY 4-FOOT FLAT PANEL, ACRYLIC LENS, EDGE-LIT, 0-10V DIMMING TO 10-PERCENT	RECESSED	40	80	40W	3500K	4000	120 V	COLUMBIA CFP24 SERIES CREE C-TR-A-FP24 SERIES LITHONIA CPANL24 SERIES METALUX 24FP SERIES		F92
F92S	SAME AS 'F92' EXCEPT SURFACE MOUNTED.	RECESSED	40	80	40W	3500K	4000	120 V			F92S
F-WC	LINEAR DOWNLIGHT WITH INTEGRAL DRIVER, SUITABLE FOR WOODWORKS GRILLE - FORTE' CEILING, 6 CELL, PLACED BETWEEN SLATS, ARCHITECT TO SELECT FINISH, 35 DEGREE BEAM, VERIFY CEILING MODEL WITH ARCHITECT BEFORE ORDERING, BOTTOM OF FIXTURE ALIGNED WITH BOTTOM OF CEILING.	RECESSED (IN DESCRIPTION)	21	80	21W	3500K	60W TO 72W	120 V	USAI LIGHTING MICRO MULTI-CELL SERIES		F-WC
FM	17-INCH NOMINAL DIAMETER ROUND FIXTURE, CAST ALUMINUM HOUSING, FROSTED POLYCARBONATE LENS, WET LOCATION LISTED, GASKETED, INTEGRAL EMERGENCY BATTERY BACKUP, FINISH TO BE SELECTED BY ARCHITECT FROM MANUFACTURER'S CATALOG OF STANDARD FINISHES.	SURFACE CEILING	20	70	20W	3000K	2000	120 V	KENALL MR17FD SERIES		FM
FN	ARCHITECTURAL WALL PACK, CAST ALUMINUM HOUSING, GASKETED, FULL CUTOFF, WET LOCATION LISTED, INTEGRAL EMERGENCY BATTERY BACKUP, FINISH TO BE SELECTED BY ARCHITECT FROM MANUFACTURER'S CATALOG OF STANDARD COLORS.	SURFACE WALL	20	70	20W	3000K	2000	120 V	EXO SG SERIES LITHONIA WPX SERIES LUMARK AXCS SERIES		FN
FP	SAME AS FIXTURE 'FN', EXCEPT NO INTEGRAL EMERGENCY BATTERY BACKUP.	SURFACE WALL	20	70	20W	3000K	2000	120 V	EXO SG SERIES LITHONIA WPX SERIES LUMARK AXCS SERIES		FP
X1C	THERMOPLASTIC EXIT SIGN, WHITE HOUSING, SELF POWERED, SELF DIAGNOSTIC.	SURFACE CEILING	5	80	5W	GREEN	N/A	120 V	DUAL-LITE SE SERIES SURE-LITES CX SERIES LITHONIA LE SERIES MULE MD SERIES		X1C
X1W	THERMOPLASTIC EXIT SIGN, WHITE HOUSING, SELF POWERED, SELF DIAGNOSTIC.	SURFACE WALL	5	80	5W	GREEN	N/A	120 V	DUAL-LITE SE SERIES SURE-LITES CX SERIES LITHONIA LE SERIES MULE MD SERIES		X1W
X4	EMERGENCY LIGHTING UNIT, 90-MINUTE EMERGENCY CAPACITY, DAMP LOCATION LISTED, SELF DIAGNOSTIC.	SURFACE WALL	5	80	5W	WHITE	N/A	120 V	DUAL-LITE EV SERIES SURE-LITES SEL25 SERIES LITHONIA ELM2 SERIES MULE SQ-80-LED SERIES		X4

SEE DRAWING E100 FOR "EXTERIOR LIGHTING SCHEDULE."



DNA #22054

R.E. Dimond
and Associates, Inc.
Consulting Engineers

732 North Capitol Avenue
Indianapolis, IN 46204
Phone: (317) 634-4672
Fax: (317) 638-8725


PROJECT:
**BARTHOLOMEW CONSOLIDATED
SCHOOL CORPORATION
RENOVATIONS TO
L. C. SCHMITT ELEMENTARY**
2675 California St, Columbus, IN 47201

SCOPE DRAWINGS:
These drawings indicate the general scope of the project in terms of architectural design content, the structural, mechanical, electrical and plumbing systems. The drawings do not necessarily indicate or describe all work required for the performance and completion of the project. On the basis of the general scope indicated on drawings, the contractor shall furnish all items required for the proper execution and completion of the work.

REVISIONS:
2 ADDENDUM #2 03/15/2024

ISSUE DATE	DRAWN BY	CHECKED BY
02/16/2024	GSR	DEW

DRAWING TITLE:
**SCHEDULES -
ELECTRICAL**

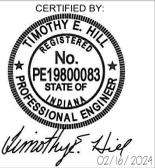

DRAWING NUMBER
E601

PROJECT NUMBER
22054

DISTRIBUTION PANEL

PANEL ID: LDP	LOCATION: ELEC. 197A
CONFIGURATION: 208Y/120V 3Ø 4-Wire+Ground	ENCLOSURE: SQUARE D - E1 SERIES
MAIN: 1200 A	TRIM: MCB
SCCR (AMPS RMS SYMM):	MODIFICATIONS:

NO.	Load Name	Rating	POLES	PHASE A	PHASE B	PHASE C
1	PANELBOARD 'E'	100 A	3	4 A	11 A	10 A
2	E. 100A BREAKER	100 A	3	--	--	--
3	E. PANELBOARD 'LDP'	100 A	3	--	--	--
4	E. PANELBOARD 'LPCM'	100 A	3	--	--	--
5	E. PANELBOARD 'LPBM'	100 A	3	--	--	--
6	E. PANELBOARD 'LPC2'	100 A	3	--	--	--
7	E. PANELBOARD 'LPBA'	100 A	3	--	--	--
8	E. PANELBOARD 'LPB'	100 A	3	--	--	--
9	E. PANELBOARD 'LBF'	125 A	3	--	--	--
10	E. PANELBOARD 'LLD'	125 A	3	--	--	--
11	E. PANELBOARD 'LLC2'	125 A	3	--	--	--
12	PANELBOARD 'LPC1'	150 A	3	93 A	44 A	53 A
13	E. PANELBOARD 'LPCM'	150 A	3	--	--	--
14	PANELBOARD 'A'	175 A	3	44 A	75 A	61 A
15	E. PANELBOARD 'LPK'	300 A	3	--	--	--
16	PANELBOARD 'B'	200 A	3	85 A	96 A	89 A
17	PANEL 'LDP' DISCONNECT	1200 A	3	--	--	--
18	PANELBOARD 'G'	200 A	3	161 A	164 A	140 A

TOTAL LOAD (VA): 138844 VA **TOTAL LOAD (A):** 372 A
REMARKS: EXISTING SQUARE D HCWM I-LINE PANEL

SWITCHBOARD

PANEL ID: MDP-H	LOCATION: Space 260
CONFIGURATION: 480Y/277V 3Ø 4-Wire+Ground	ENCLOSURE: SQUARE D - TYPE 1
MAIN: 2000 A	TRIM:
SCCR (AMPS RMS SYMM):	MODIFICATIONS:

NO.	Load Name	Rating	POLES	PHASE A	PHASE B	PHASE C
1	TRANSFORMER TO 'LDP'	800 A	3	--	--	--
2	CHILLER	500 A	3	--	--	--
3	PANEL 'HPM'	200 A	3	75 A	75 A	75 A
4	E. BREAKER ON	200 A	3	--	--	--
5	E. BREAKER OFF	50 A	3	--	--	--
6	PANEL 'LHD'	100 A	3	--	--	--
7	E. BREAKER OFF	100 A	3	--	--	--
8	ELEVATOR	100 A	3	--	--	--
9	PANELBOARD 'SH'	20 A	3	126 A	126 A	126 A
10	MCC-D	200 A	3	--	--	--
11	E. BREAKER ON	200 A	3	--	--	--

TOTAL LOAD (VA): 167003 VA **TOTAL LOAD (A):** 201 A
REMARKS:

DISTRIBUTION

BM PANELBOARD SCHEDULE

LOCATION: ELEC. 118	SCCR (AMPS RMS SYMM):	SERVICE: 208Y/120V 3Ø 4-Wire+Ground	AMP: 100 A	MAIN: MCB	NEMA: Type 1	MOUNTING: SURFACE
----------------------------	------------------------------	--	-------------------	------------------	---------------------	--------------------------

CKT	DESCRIPTION	NOTE	AMP	POLE	A	B	C	POLE	AMP	NOTE	DESCRIPTION	CKT
1	CUH-A2 VESTIBULE V107		20 A	1	1000 / 1176			1	20 A		VUV-A 1/2HP LIFE SKILLS 119	2
3	VUV-A 1/2HP FLEX CLASSROOM 114		20 A	1		1176 / 1176			1	20 A	VUV-A 1/2HP CLASSROOM (2ND) 123	4
5	VUV-A 1/2HP CLASSROOM (2ND) 117		20 A	1			1176 / 750		2	20 A	ECU-H STAFF 124	6
7	VUV-A 1/2HP CLASSROOM (2ND) 116		20 A	1	1176 / 750							8
9	FAN COIL FC-A SMALL GROUP ROOM 115		20 A	1		200 / 750			2	20 A	ECU-H A TOILET 123A	10
11	SPARE		20 A	1			0 / 750					12
13	SPARE		20 A	1	0 / 0				1	20 A	FAN COIL FC-A SMALL GROUP ROOM 121	14
15	SPARE		20 A	1			0 / 0				SPARE	16
17	SPARE		20 A	1			0 / 0				SPARE	18
19	SPARE		20 A	1	0 / 0				1	20 A	SPARE	20
21	SPARE		20 A	1		0 / 0			1	20 A	SPARE	22
23	SPARE		20 A	1			0 / 0		1	20 A	SPARE	24
25	SPARE		20 A	1	0 / 0						SPARE	26
27	SPARE		20 A	1		0 / 0			1	20 A	SPARE	28
29	SPARE		20 A	1			0 / 0		1	20 A	SPARE	30
31	SPARE		20 A	1	0 / 0				1	20 A	SPARE	32
33	SPARE		20 A	1			0 / 0				SPARE	34
35	SPARE		20 A	1			0 / 0		1	20 A	SPARE	36
37	SPARE		20 A	1	0 / 0				1	20 A	SPARE	38
39	SPARE		20 A	1			0 / 0		1	20 A	SPARE	40
41	SPARE		20 A	1			0 / 0		1	20 A	SPARE	42

TOTALS: 4102 VA 3302 VA 2676 VA
TOTAL CONNECTED LOAD (VA): 10080 VA **TOTAL CONNECTED LOAD (AMPS):** 28 A
REMARKS: **NOTES:**

B PANELBOARD SCHEDULE

LOCATION: ELEC. 118	SCCR (AMPS RMS SYMM):	SERVICE: 208Y/120V 3Ø 4-Wire+Ground	AMP: 200 A	MAIN: MCB	NEMA: Type 1	MOUNTING: SURFACE
----------------------------	------------------------------	--	-------------------	------------------	---------------------	--------------------------

CKT	DESCRIPTION	NOTE	AMP	POLE	A	B	C	POLE	AMP	NOTE	DESCRIPTION	CKT
1	RECEPT CORRIDOR C105		20 A	1	540 / 300			1	20 A		POWER ELEC. 118	2
3	RECEPT CORR. 106, VEST. 107		20 A	1		720 / 1380			1	20 A	RECEPT ROOM 119, 119B	4
5	RECEPT FLEX CLASSROOM 114		20 A	1			1260 / 1080		1	20 A	RECEPT LIFE SKILLS 119	6
7	RECEPT FLEX CLASSROOM 114		20 A	1	540 / 300				1	20 A	RECEPT ROOM 120, 122	8
9	RECEPT SMALL GROUP ROOM 115		20 A	1		900 / 680			1	20 A	RECEPT ACTIVITY COMMONS 121	10
11	RECEPT CLASSROOM (2ND) 116		20 A	1			540 / 900		1	20 A	RECEPT SMALL GROUP ROOM 121	12
13	RECEPT CLASSROOM (2ND) 116		20 A	1	1260 / 1260				1	20 A	RECEPT ACTIVITY COMMONS 122	14
15	RECEPT CLASSROOM (2ND) 117		20 A	1			1260 / 1260		1	20 A	RECEPT CLASSROOM (2ND) 123	16
17	RECEPT CLASSROOM (2ND) 117		20 A	1			540 / 540		1	20 A	RECEPT CLASSROOM (2ND) 123	18
19	SPARE		20 A	1	0 / 0				1	20 A	SPARE	20
21	SPARE		20 A	1		0 / 0			1	20 A	SPARE	22
23	LIGHTING CORRIDOR C105		20 A	1			1048 / 1076		1	20 A	LIGHTING AND EF-A ROOM 119	24
25	LIGHTING 115, EF-A 114		20 A	1	1048 / 612				1	20 A	LIGHTING ROOM 120-122	26
27	LIGHTING AND EF-A 116		20 A	1		972 / 972			1	20 A	LIGHTING AND EF-A 123	28
29	LIGHTING AND EF-A 117		20 A	1			972 / 0		1	20 A	SPARE	30
31	SPARE		20 A	1	0 / 0				1	20 A	SPARE	32
33	SPARE		20 A	1			0 / 0				SPARE	34
35	SPARE		20 A	1			0 / 0		1	20 A	SPARE	36
37	SPARE		20 A	1	0 / 4102				3	100 A	PANELBOARD 'BM'	38
39	SPARE		20 A	1		0 / 3302			3	100 A		40
41	SPARE		20 A	1			0 / 2676		3	100 A		42

TOTALS: 10222 VA 11446 VA 10632 VA
TOTAL CONNECTED LOAD (VA): 32300 VA **TOTAL CONNECTED LOAD (AMPS):** 90 A
REMARKS: PANEL TO REPLACE EXISTING PANELBOARD 'B' AND 'D' **NOTES:**

A PANELBOARD SCHEDULE

LOCATION: GRADE	SCCR (AMPS RMS SYMM):	SERVICE: 208Y/120V 3Ø 4-Wire+Ground	AMP: 175 A	MAIN: MCB	NEMA: Type 1	MOUNTING: SURFACE
------------------------	------------------------------	--	-------------------	------------------	---------------------	--------------------------

CKT	DESCRIPTION	NOTE	AMP	POLE	A	B	C	POLE	AMP	NOTE	DESCRIPTION	CKT
1	RECEPT VEST. V102, CORRIDOR A NORTH		20 A	1	720 / 900			1	20 A		RECEPT ROOM 105, 106	2
3	EWG CORRIDOR A NORTH		20 A	1		680 / 540			1	20 A	RECEPT CLASSROOM (PRE-K) 107	4
5	RECEPT SHARED OFFICE 102		20 A	1			1080 / 1260		1	20 A	RECEPT CLASSROOM (PRE-K) 107	6
7	RECEPT ROOM 103, 103A		20 A	1	720 / 540				1	20 A	RECEPT CLASSROOM (PRE-K) 108	8
9	RECEPT COMMUNITY FLEX CLASSROOM 103		20 A	1		1260 / 1260			1	20 A	RECEPT CLASSROOM (PRE-K) 108	10
11	RECEPT CLASSROOM (PRE-K) 104		20 A	1			1260 / 0		1	20 A	SPARE	12
13	RECEPT CLASSROOM (PRE-K) 104		20 A	1	540 / 0				1	20 A	SPARE	14
15	SPARE		20 A	1			0 / 0				SPARE	16
17	SPARE		20 A	1			0 / 0				SPARE	18
19	SPARE		20 A	1	0 / 0				1	20 A	SPARE	20
21	CUH-G VESTIBULE V102		20 A	1		384 / 200			1	20 A	FC-A SMALL GROUP ROOM 105	22
23	EF-A ROOM 101, FC-A ROOM 102		20 A	1			500 / 86		1	20 A	PUH-D STORAGE 106	24
25	CUH-F STORAGE 103A		20 A	1	64 / 1176				1	20 A	VUV-A 1/2HP ROOM 107	26
27	VUV-A 1/2HP ROOM 103		20 A	1		1176 / 1176			1	20 A	VUV-A 1/2HP ROOM 108	28
29	VUV-A 1/2HP ROOM 104		20 A	1			1176 / 0		1	20 A	SPARE	30
31	SPARE		20 A	1	0 / 0				1	20 A	SPARE	32
33	SPARE		20 A	1			0 / 0				SPARE	34
35	SPARE		20 A	1			0 / 0		1	20 A	SPARE	36
37	LIGHTING VESTIBULE V102, CORR. C101		20 A	1	646 / 0				1	20 A	SPARE	38
39	LIGHTING AND EF-A ROOM 103		20 A	1		1340 / 720			1	20 A	LIGHTING 106, 107 AND EF-A 107	40
41	LIGHTING AND EF-A ROOM 104		20 A	1			748 / 972		1	20 A	LIGHTING AND EF-A ROOM 108	42

TOTALS: 5306 VA 8736 VA 7092 VA
TOTAL CONNECTED LOAD (VA): 21134 VA **TOTAL CONNECTED LOAD (AMPS):** 59 A
REMARKS: PANEL TO REPLACE EXISTING PANELBOARD 'A' **NOTES:**

GM PANELBOARD SCHEDULE

LOCATION: MECH 111	SCCR (AMPS RMS SYMM):	SERVICE: 208Y/120V 3Ø 4-Wire+Ground	AMP: 100 A	MAIN: MLO	NEMA: Type 1	MOUNTING: SURFACE
---------------------------	------------------------------	--	-------------------	------------------	---------------------	--------------------------

CKT	DESCRIPTION	NOTE	AMP	POLE	A	B	C	POLE	AMP	NOTE	DESCRIPTION	CKT
1	CUH-C SECURE VESTIBULE-2 V101-2		20 A	1	300 / 420				2	20 A	DXFC UNIT ROOM 163, 165-168	2
3	PUH-D JANITOR 106A		20 A	1		96 / 420			2	20 A	DXFC UNIT ROOM 163, 165-168	4
5	DXFC UNIT ROOM 110, 112, C103		20 A	2	945 / 750		945 / 750		2	20 A	ECU-H STAFF 165	6
7	SPARE		20 A	2			750 / 735		2	20 A	DXFC UNIT ROOM 170-172, 174-176	8
9	ECU-H A TOILET 112A		20 A	2			750 / 735		2	20 A	DXFC UNIT ROOM 170-172, 174-176	10
11	SPARE		20 A	2			420 / 0		1	20 A	SPARE	12
13	DXFC UNIT ROOM 113, 113A-B		20 A	2		420 / 0			1	20 A	SPARE	14
15	SPARE		20 A	1			420 / 0		1	20 A	SPARE	16
17	SPARE		20 A	1			0 / 0		1	20 A	SPARE	18
19	SPARE		20 A	1	0 / 0				1	20 A	SPARE	20
21	SPARE		20 A	1			0 / 0		1	20 A	SPARE	22
23	SPARE		20 A	2			0 / 0		2	15 A	SPARE	24
25	SPARE		20 A	2	0 / 0				2	15 A	SPARE	26
27	ERV-3 AND DXFC-3 MECH 111		15 A	2		546 /						

LPB(L)		PANELBOARD SCHEDULE											
LOCATION: ELEC. 184		SCCR (AMPS RMS SYMM):		SERVICE: 208Y/120V 3Ø 4-Wire-Ground		AMP: 100 A		MAIN: MLO		NEMA: Type 1		MOUNTING: SURFACE	
CKT	DESCRIPTION	NOTE	AMP	POLE	A	B	C	POLE	AMP	NOTE	DESCRIPTION	CKT	
1	RECEPT MEDIA CENTER 178	E	20 A	1	720 / 120			1	20 A	E	RECEPT RSO 189	2	
3	RECEPT MEDIA CENTER 178	E	20 A	1				1	20 A	E	RECEPT OT/PT 190	4	
5	RECEPT WORKROOM 179	E	20 A	1			540 / 1080	1	20 A	E	RECEPT ROOM 191, 192	6	
7	COPIER MEDIA OFFICE/WORKROOM 179	E	20 A	1	1000 / 180			1	20 A	E	RECEPT STAFF DINING 192	8	
9	RECEPT MAKERSPACE 180	E	20 A	1		1000 / 1000		1	20 A	E	REFRID. STAFF DINING 192	10	
11	RECEPT ROOM 180A, 180B	E	20 A	1			720 / 680	1	20 A	E	ICE MAKER STAFF DINING 192	12	
13	RECEPT ROOM 181, 182	E	20 A	1	900 / 1000			1	20 A	E	VENDING STAFF DINING 192	14	
15	RECEPT ART LAB 183	E	20 A	1		720 / 0		1	20 A	E	SPARE	16	
17	RECEPT ART LAB 183	E	20 A	1			1280 / 0	1	20 A	E	SPARE	18	
19	RECEPT STEM LAB 185	E	20 A	1	900 / 0			1	20 A	E	SPARE	20	
21	RECEPT STEM LAB 185	E	20 A	1		1260 / 0		1	20 A	ER	FIRE ALARM CONTROL PANEL MDF 164	22	
23	RECEPT MUSIC LAB 186	E	20 A	1			1260 / 0	1	20 A	E	SPARE	24	
25	RECEPT MUSIC LAB 186	E	20 A	1	720 / 0			1	20 A	E	SPARE	26	
27	CORD REELS MAKERSPACE 180	E	20 A	1		720 / 0		1	20 A	E	SPARE	28	
29	CORD REELS MAKERSPACE 180	E	20 A	1			720 / 0	1	20 A	E	SPARE	30	
31	LIGHTS TUNNEL	ER	20 A	1	0 / 720			1	20 A	E	RECEPT CORRIDOR C112, VEST. V104	32	
33	LIGHTS TUNNEL	ER	20 A	1		0 / 900		1	20 A	E	RECEPT CORRIDOR C104, C113	34	
35	CORD REELS STEM LAB 185	E	20 A	1			720 / 680	1	20 A	E	EWG CORRIDOR C112	36	
37	CORD REELS STEM LAB 185	E	20 A	1		720 / 360		1	20 A	E	CORD REELS ART LAB 183	38	
39	CORD REELS STEM LAB 185	E	20 A	1			360 / 720	1	20 A	E	CORD REELS ART LAB 183	40	
41	SPACE	-	-	-			0 / 720	1	20 A	E	CORD REELS ART LAB 183	42	
TOTALS:					7940 VA		8360 VA				6380 VA		
TOTAL CONNECTED LOAD (VA):			24700 VA			TOTAL CONNECTED LOAD (AMPS):			69 A				
REMARKS: EXISTING SQUARE D PANELBOARD TYPE 'NOOD'													
NOTES: E - CONNECT TO EXISTING BREAKER. LEAVE AS SPARE IF UNUSED. ER - EXISTING CIRCUIT TO REMAIN.													

LPB(R)		PANELBOARD SCHEDULE											
LOCATION: ELEC. 184		SCCR (AMPS RMS SYMM):		SERVICE: 208Y/120V 3Ø 4-Wire-Ground		AMP: 100 A		MAIN: MLO		NEMA: Type 1		MOUNTING: SURFACE	
CKT	DESCRIPTION	NOTE	AMP	POLE	A	B	C	POLE	AMP	NOTE	DESCRIPTION	CKT	
1	EXISTING		20 A	1	0 / 0			1	20 A	E	EXISTING	2	
3	EXISTING		20 A	1		0 / 0		1	20 A	E	EXISTING	4	
5	EXISTING		20 A	1			0 / 0	1	20 A	E	EXISTING	6	
7	EXISTING		20 A	1	0 / 0			1	20 A	E	EXISTING	8	
9	EXISTING		20 A	1			0 / 0	1	20 A	E	EXISTING	10	
11	EXISTING		20 A	1			0 / 0	1	20 A	E	EXISTING	12	
13	EXISTING		20 A	1	0 / 0			1	20 A	E	EXISTING	14	
15	EXISTING		20 A	1		0 / 0		1	20 A	E	EXISTING	16	
17	EXISTING		20 A	1			0 / 0	1	20 A	E	EXISTING	18	
19	EXISTING		20 A	1		0 / 0		1	20 A	E	EXISTING	20	
21	EXISTING		20 A	1		0 / 0		1	20 A	E	EXISTING	22	
23	EXISTING		20 A	1			0 / 0	1	20 A	E	EXISTING	24	
25	EXISTING		20 A	1	0 / 0			1	20 A	E	EXISTING	26	
27	EXISTING		20 A	1			0 / 0	1	20 A	E	EXISTING	28	
29	EXISTING		20 A	1			0 / 0	1	20 A	E	EXISTING	30	
31	EXISTING		20 A	2	0 / 0			1	20 A	E	EXISTING	32	
33	EXISTING		20 A	2		0 / 0		1	20 A	E	EXISTING	34	
35	EXISTING		20 A	1			0 / 0	1	20 A	E	EXISTING	36	
37	EXISTING		20 A	2	0 / 0			1	20 A	E	SPACE	38	
39	EXISTING		20 A	2		0 / 0		1	20 A	E	SPACE	40	
41	SPACE	-	-	-			0 / 0	1	20 A	E	SPACE	42	
TOTALS:					0 VA		0 VA				0 VA		
TOTAL CONNECTED LOAD (VA):			0 VA			TOTAL CONNECTED LOAD (AMPS):			0 A				
REMARKS: EXISTING SQUARE D PANELBOARD TYPE 'NOOD'													
NOTES: PANELBOARD HAS WRONG CIRCUIT DIRECTORY. CONTRACTOR TO UPDATE. BREAKER SIZES MAY NOT BE DISPLAYED CORRECTLY. VERIFY IN FIELD.													

LPBA		PANELBOARD SCHEDULE											
LOCATION: ELEC. 184		SCCR (AMPS RMS SYMM):		SERVICE: 208Y/120V 3Ø 4-Wire-Ground		AMP: 100 A		MAIN: MLO		NEMA: Type 1		MOUNTING: SURFACE	
CKT	DESCRIPTION	NOTE	AMP	POLE	A	B	C	POLE	AMP	NOTE	DESCRIPTION	CKT	
1	RECEPT CLASSROOM (1ST) 145	E	20 A	1	1260 / 1260			1	20 A	E	RECEPT CLASSROOM (1ST) 152	2	
3	RECEPT CLASSROOM (1ST) 145	E	20 A	1		900 / 360		1	20 A	E	RECEPT CLASSROOM (1ST) 152	4	
5	RECEPT CLASSROOM (FLEX) 146	E	20 A	1			1260 / 1080	1	20 A	E	RECEPT ROOM 153, 154	6	
7	RECEPT CLASSROOM (FLEX) 146	E	20 A	1	720 / 360			1	20 A	E	RECEPT CLASSROOM (K) 159	8	
9	RECEPT CLASSROOM (K) 147	E	20 A	1			900 / 1080	1	20 A	E	RECEPT ROOM 153, 154	10	
11	RECEPT CLASSROOM (K) 147	E	20 A	1			1260 / 360	1	20 A	E	RECEPT CLASSROOM (K) 157	12	
13	RECEPT ROOM 148, 169 A TO CORRIDOR C110	E	20 A	1	900 / 1260			1	20 A	E	RECEPT CLASSROOM (K) 157	14	
15	RECEPT SMALL GROUP ROOM 149	E	20 A	1			900 / 900	1	20 A	E	RECEPT ACTIVITY COMMONS 158	16	
17	RECEPT CLASSROOM (1ST) 150	E	20 A	1			360 / 600	1	20 A	E	EWG ACTIVITY COMMONS 159	18	
19	RECEPT CLASSROOM (1ST) 150	E	20 A	1	1260 / 1260			1	20 A	E	RECEPT CLASSROOM (K) 159	20	
21	RECEPT ACTIVITY COMMONS 151	E	20 A	1			900 / 1080	1	20 A	E	RECEPT ROOM 160, 161	22	
23	EWG ACTIVITY COMMONS 151	E	20 A	1			680 / 0	1	20 A	E	SPARE	24	
25	SPARE	E	20 A	1	0 / 0			1	20 A	E	SPARE	26	
27	SPARE	E	20 A	1		0 / 0		1	20 A	E	SPARE	28	
29	SPARE	E	60 A	2	0 / 0			2	20 A	E	SPARE	30	
31	SPARE	E	60 A	2	0 / 0			2	20 A	E	SPARE	32	
33	SPARE	E	60 A	2	0 / 0			2	20 A	E	SPARE	34	
35	SPARE	E	20 A	1		0 / 0		1	20 A	E	SPARE	36	
37	SPARE	E	20 A	1	0 / 0			1	20 A	E	SPARE	38	
39	SPARE	E	20 A	1		0 / 0		1	20 A	E	SPARE	40	
41	SPARE	E	20 A	1		0 / 0		1	20 A	E	SPARE	42	
TOTALS:					6280 VA		7020 VA				5680 VA		
TOTAL CONNECTED LOAD (VA):			20980 VA			TOTAL CONNECTED LOAD (AMPS):			58 A				
REMARKS: EXISTING SQUARE D PANELBOARD TYPE 'NOOD'													
NOTES: E - CONNECT TO EXISTING BREAKER. LEAVE AS SPARE IF UNUSED.													

LLB		PANELBOARD SCHEDULE											
LOCATION: ELEC. 184		SCCR (AMPS RMS SYMM):		SERVICE: 208Y/120V 3Ø 4-Wire-Ground		AMP: 125 A		MAIN: MLO		NEMA: Type 1		MOUNTING: SURFACE	
CKT	DESCRIPTION	NOTE	AMP	POLE	A	B	C	POLE	AMP	NOTE	DESCRIPTION	CKT	
1	LIGHTING AND EF-A ROOM 150	E	20 A	1	1187 / 934			1	20 A	E	LIGHTING MEDIA CENTER 178	2	
3	LIGHTING AND EF-A ROOM 152	E	20 A	1		1187 / 0		1	20 A	E	SPARE	4	
5	LIGHTING AND EF-A ROOM 157	E	20 A	1			1187 / 668	1	20 A	E	LIGHTING ROOM 179 - 182	6	
7	LIGHTING AND EF-A ROOM 159	E	20 A	1	1187 / 1154			1	20 A	E	LGST VEST. V104, V105 & CORR. C112, C104	8	
9	NAC PANEL ELEC. 184	ER	20 A	1		0 / 1326		1	20 A	E	LIGHTING ART LAB 113	10	
11	LIGHTING ROOM 148, 149, 151, V103, C110	E	20 A	1			807 / 956	1	20 A	E	LIGHTING STEM LAB 185	12	
13	LIGHTING ROOM 153-156, 158, 160, 161	E	20 A	1	1333 / 792			1	20 A	E	LIGHTING MUSIC LAB 186	14	
15	LIGHTING AND EF-A ROOM 145	E	20 A	1		812 / 664		1	20 A	E	LIGHTING AND EF-A STAFF, 187, 188	16	
17	LIGHTING AND EF-A ROOM 146	E	20 A	1			812 / 1056	1	20 A	E	LIGHTING ROOM 189-192	18	
19	LIGHTING AND EF-A ROOM 147	E	20 A	1	812 / 0			1	20 A	E	SPARE	20	
21	SPACE	-	-	-	0 / 0			1	20 A	E	SPARE	22	
23	SPACE	-	-	-	0 / 0			1	20 A	E	SPARE	24	
25	SPACE	-	-	-	0 / 0			1	20 A	E	SPARE	26	
27	SPACE	-	-	-	0 / 0			1	20 A	E	SPARE	28	
29	SPACE	-	-	-	0 / 0			1	20 A	E	SPARE	30	
31	SPACE	-	-	-	0 / 0			1	20 A	E	SPARE	32	
33	SPACE	-	-	-	0 / 0			1	20 A	E	SPARE	34	
35	SPACE	-	-	-	0 / 0			1	20 A	E	SPACE	36	
37	SPACE	-	-	-	0 / 0			1	20 A	E	SPACE	38	
39	SPACE	-	-	-	0 / 0			1	20 A	E	SPACE	40	
41	SPACE	-	-	-	0 / 0			1	20 A	E	SPACE	42	
TOTALS:					7399 VA		3991 VA				5540 VA		
TOTAL CONNECTED LOAD (VA):			16830 VA			TOTAL CONNECTED LOAD (AMPS):			47 A				
REMARKS: EXISTING SQUARE D PANELBOARD TYPE 'NOOD'													
NOTES: E - CONNECT TO EXISTING BREAKER. LEAVE AS SPARE IF UNUSED. ER - EXISTING CIRCUIT TO REMAIN.													

LPBM(L)		PANELBOARD SCHEDULE											
LOCATION: ELEC. 184		SCCR (AMPS RMS SYMM):		SERVICE: 208Y/120V 3Ø 4-Wire-Ground		AMP: 100 A		MAIN: MLO		NEMA: Type 1		MOUNTING: SURFACE	
CKT	DESCRIPTION	NOTE	AMP	POLE	A	B	C	POLE	AMP	NOTE	DESCRIPTION	CKT	
1	SPACE	-	-	-	0 / 0			1	20 A	E	SPACE	2	
3	SPACE	-	-	-	0 / 0			1	20 A	E	SPACE	4	
5	TOP MECH 155	E	20 A	1			0 / 0	1	20 A	E	SPACE	6	
7	BLOWER COIL BC-1 MECH 155	E	20 A	2	500 / 0			1	20 A	E	SPACE	8	
9	SPACE	-	-	-	500 / 0			1	20 A	E	SPACE	10	
11	SPACE	-	-	-	0 / 0			1	20 A	E	SPACE	12	
13	SPACE	-	-	-	0 / 0			1	20 A	E	SPACE	14	
15	SPACE	-	-	-	0 / 0			1	20 A	E	SPACE	16	
17	SPACE	-	-	-	0 / 0			1	20 A	E	SPACE	18	
19	SPACE	-	-	-	0 / 0			1	20 A	ER	LIBRARY FLOOR BOX	20	
21	SPACE	-	-	-	0 / 0			1	20 A	E	SPACE	22	
23	CUH-A VESTIBULE V103	E	20 A	1			190 / 1656	1	20 A	E	VUV-C 3/4HP CLASSROOM (1ST) 150	24	
25	VUV-B 3/4HP CLASSROOM (1ST) 145	E	20 A	1	1656 / 1656			1	20 A	E	VUV-C 3/4HP CLASSROOM (1ST) 152	26	
27	VUV-B 3/4HP CLASSROOM (1ST) 146	E	20 A	1		1656 / 1656		1	20 A	E	VUV-C 3/4HP CLASSROOM (1ST) 157	28	
29	VUV-C 3/4HP CLASSROOM (1ST) 147	E	20 A	1		1656 / 1656		1	20 A	E	VUV-C 3/4HP CLASSROOM (1ST) 159	30	
31	PUH-D BUILDING STORAGE 148	E	20 A	1	96 / 96			1	20 A	E	PUH-D JAN. 161	32	
33	SPACE	-	-	-	0 / 0			1	20 A	E	SPACE	34	
35	SPACE	-	-	-	0 / 0			1	20 A	E	SPACE	36	
37	SPACE	-	-	-	0 / 0			1	20 A	E	SPACE	38	
39	SPACE	-	-</										

LLD		PANELBOARD SCHEDULE											
LOCATION : ELEC. 197A		SCCR (AMPS RMS SYMM):		SERVICE : 208Y120V 3Ø 4-Wire-Ground		AMP : 125 A		MAIN : MLO		NEMA : Type 1		MOUNTING : SURFACE	
CKT	DESCRIPTION	NOTE	AMP	POLE	A	B	C	POLE	AMP	NOTE	DESCRIPTION	CKT	
1	DIMMER-GYM-LIGHTING	ER	20 A	1	0/0			1	20 A	ER	DIMMER-GYM-LIGHT	2	
3	DIMMER-GYM-LIGHTING	ER	20 A	1	0/0			1	20 A	ER	DIMMER-GYM-LIGHT	4	
5	DIMMER-GYM-LIGHTING	ER	20 A	1			0/0	1	20 A	ER	DIMMER-GYM-LIGHT	6	
7	DIMMER-GYM-LIGHTING	ER	20 A	1	0/0			1	20 A	ER	LIGHTS GYM & STAGE	8	
9	DIMMER-CAFE-LIGHTS	ER	20 A	1		0/0		1	20 A	ER	DIMMER-CAFE-LIGHT	10	
11	DIMMER-CAFE-LIGHTS	ER	20 A	1		0/0		1	20 A	ER	DIMMER-CAFE-LIGHT	12	
13	DIMMER-CAFE-LIGHTS	ER	20 A	1	0/0			1	20 A	ER	DIM-SPARE-GYM PANEL	14	
15	DIMMER-GYM-LIGHTING	ER	20 A	1		0/0		1	20 A	ER	DIM-SPARE-GYM PANEL	16	
17	SPARE DIM-GYM PANEL	ER	20 A	1		0/0		1	20 A	ER	SPARE GYM-DIM-PANEL	18	
19	LGTS-CORR & COURT YARD	ER	20 A	1	0/0			1	20 A	ER	LGTS-P-E OFFICE-STORAGE	20	
21	LGTS-CORR & COURT YARD	ER	20 A	1		0/0		1	20 A	E	SPARE	22	
23	LGTS-MEZZ-DISPLAY CASE	ER	20 A	1		0/0		1	20 A	ER	LIGHTS-BOILER ROOM	24	
25	LIGHTS-COURTYARD	ER	20 A	1	0/0			1	20 A	ER	EMERGENCY LIGHTS	26	
27	SPARE	ER	20 A	1		0/0		1	20 A	ER	LGTS-GYM & CAFETERIA	28	
29	TWO-POLE-LIGHTS-PILOT	ER	20 A	1		0/0		1	20 A	ER	LGTS-D-WING-ENTRANCE	30	
31	?	ER	20 A	1	0/0			1	20 A	E	SPARE	32	
33	?	ER	20 A	1		0/0		1	20 A	E	SPARE	34	
35	LIGHTING CORRIDOR C14	E	20 A	1		605/0		1	20 A	E	SPARE	36	
37	LGTN 193C, 194, 195, 196B, GYM & CAFE ENT	E	20 A	1	522/0			1	20 A	E	SPARE	38	
39	SPARE	E	20 A	1		0/0		1	20 A	E	SPARE	40	
41	SPARE	E	20 A	1		0/0		1	20 A	E	SPARE	42	
TOTALS :			522 VA		0 VA		605 VA						
TOTAL CONNECTED LOAD (VA) :			1127 VA										
TOTAL CONNECTED LOAD (AMPS) :			3 A										
REMARKS: EXISTING SQUARE D PANELBOARD TYPE 'N000'													
NOTES: E - CONNECT TO EXISTING BREAKER. LEAVE AS SPARE IF UNUSED. ER - EXISTING CIRCUIT TO REMAIN.													

LPDM		PANELBOARD SCHEDULE											
LOCATION : MECHANICAL 197		SCCR (AMPS RMS SYMM):		SERVICE : 208Y120V 3Ø 4-Wire-Ground		AMP : 225 A		MAIN : MLO		NEMA : Type 1		MOUNTING : SURFACE	
CKT	DESCRIPTION	NOTE	AMP	POLE	A	B	C	POLE	AMP	NOTE	DESCRIPTION	CKT	
1	TAC - PANEL	ER	20 A	1	0/0			1	20 A	ER	RECEPTACLE - B.R.	2	
3	TAC - PANEL	ER	20 A	1		0/0		1	20 A	ER	RECEPTACLE - B.R.	4	
5	SPARE	ER	20 A	1			0/0	1	20 A	ER	CHILLER PIPE HEAT TAPE	6	
7	SPARE	ER	20 A	1			0/0	1	20 A	ER	PUMP #4 FUEL	8	
9	SPARE	ER	20 A	1			0/0	1	20 A	ER	PUMP #6 FUEL	10	
11	UNIT HEATER - KITCHEN	ER	20 A	1			0/0	1	20 A	ER	EXHAUST FAN #10	12	
13	SOUTH BOILER CONTROL	ER	20 A	1	0/0			1	20 A	ER	NORTH BOILER CONTROL	14	
15	WATER HEATER #2	ER	20 A	1		0/0		1	20 A	ER	L WATER CIRCULATING P.	16	
17	WATER HEATER #1	ER	20 A	1		0/0		1	20 A	ER	R WATER CIRCULATING P.	18	
19	?	ER	20 A	1	0/0			1	20 A	ER	SPARE	20	
21	SPARE	ER	20 A	1		0/0		1	20 A	ER	SPARE	22	
23	SPARE	ER	20 A	1		0/0		1	20 A	ER	SPARE	24	
25	SPARE	ER	20 A	1	0/0			1	20 A	ER	RECEPTACLE B.R.	26	
27	SPARE	ER	20 A	1		0/0		1	20 A	ER	SPARE	28	
29	SPARE	ER	20 A	1		0/0		1	20 A	ER	SPARE	30	
31	SPARE	ER	20 A	3	0/0			1	20 A	ER	RECEPTACLE B.R.	32	
33	SPARE	ER	20 A	1		0/0		1	20 A	ER	SPARE	34	
35	PUH-B1 STORAGE 297A	ER	20 A	1			864 / 1000	1	20 A	E	TCP RTU-1 MECH. MEZZANINE 297	36	
37	PUH-B2 MECH. MEZZANINE 297	ER	20 A	1			864 / 1000	1	20 A	E	TCP AHU-1 MECH. MEZZANINE 297	38	
39	PUH-B3 MECH. MEZZANINE 297	ER	20 A	1			864 / 1000	1	20 A	E	TCP AHU-2 MECH. MEZZANINE 297	40	
41	EF-E 14HP MECH. MEZZANINE 297	ER	20 A	1			866 / 360	1	20 A	E	AV RACK RECEPT MECH. MEZZ. 297	42	
TOTALS :			1864 VA		1864 VA		2920 VA						
TOTAL CONNECTED LOAD (VA) :			6648 VA										
TOTAL CONNECTED LOAD (AMPS) :			18 A										
REMARKS: EXISTING PANELBOARD													
NOTES: ER - EXISTING CIRCUIT TO REMAIN. VERIFY IN FIELD. LEAVE AS SPARE IF UNUSED.													

LPD		PANELBOARD SCHEDULE											
LOCATION : ELEC. 197A		SCCR (AMPS RMS SYMM):		SERVICE : 208Y120V 3Ø 4-Wire-Ground		AMP : 100 A		MAIN : MLO		NEMA : Type 1		MOUNTING : SURFACE	
CKT	DESCRIPTION	NOTE	AMP	POLE	A	B	C	POLE	AMP	NOTE	DESCRIPTION	CKT	
1	PUH-C STORAGE 193C, 196A	ER	20 A	1	400/0			1	20 A	E	SPARE	2	
3	CUH-F RESTROOM 194A, 194B	ER	20 A	1		400/0		1	20 A	E	SPARE	4	
5	RECEPT STORAGE 195, 196B	ER	20 A	1			360/0	1	20 A	E	SPARE	6	
7	SPARE	ER	20 A	1	0/0			1	20 A	E	SPARE	8	
9	SPARE	ER	20 A	1		0/0		1	20 A	E	SPARE	10	
11	SPARE	ER	20 A	1		0/0		1	20 A	E	SPARE	12	
13	SPARE	E	20 A	1	0/0			1	20 A	ER	SPARE	14	
15	SPARE	ER	20 A	1		0/0		1	20 A	E	SPARE	16	
17	SPARE	ER	20 A	1		0/0		1	20 A	E	SPARE	18	
19	SPARE	ER	20 A	1	0/360			1	20 A	E	EWV GYM	20	
21	SPARE	ER	20 A	1		0/360		1	20 A	E	EWV CAFETERIA 196	22	
23	SPARE	E	20 A	1	0/360		0/360	1	20 A	E	SINKS RESTROOM 194	24	
25	SPARE	E	20 A	2	0/360		0/0	1	20 A	E	RECEPT RESTROOM 194	26	
27	SPARE	ER	20 A	1		0/0		1	20 A	ER	SPARE	28	
29	SPARE	E	20 A	2	0/0		0/0	2	20 A	ER	SPARE	30	
31	SPARE	E	20 A	2	0/0		0/0	1	20 A	ER	SPARE	32	
33	SPARE	E	20 A	2	0/0		0/0	1	20 A	ER	SPARE	34	
35	SPARE	E	20 A	2	0/0		0/0	2	20 A	ER	SPARE	36	
37	SPARE	E	20 A	2	0/0		0/0	2	20 A	ER	SPARE	38	
39	SPARE	E	20 A	2	0/0		0/0	2	20 A	ER	SPARE	40	
41	SPARE	E	20 A	2	0/0		0/0	2	20 A	ER	SPARE	42	
TOTALS :			1120 VA		760 VA		720 VA						
TOTAL CONNECTED LOAD (VA) :			2600 VA										
TOTAL CONNECTED LOAD (AMPS) :			7 A										
REMARKS: EXISTING SQUARE D PANELBOARD TYPE 'N000'													
NOTES: E - CONNECT TO EXISTING BREAKER. LEAVE AS SPARE IF UNUSED. ER - EXISTING CIRCUIT TO REMAIN.													

LPK(L)		PANELBOARD SCHEDULE											
LOCATION : ELEC. 197A		SCCR (AMPS RMS SYMM):		SERVICE : 208Y120V 3Ø 4-Wire-Ground		AMP : 400 A		MAIN : MLO		NEMA : Type 1		MOUNTING : SURFACE	
CKT	DESCRIPTION	NOTE	AMP	POLE	A	B	C	POLE	AMP	NOTE	DESCRIPTION	CKT	
1	RECEPT-FLOOR-SALAD BAR	ER	20 A	1	0/0			1	20 A	ER	REFRIGERATOR	2	
3	SERV-TABL-CASH REG-W	ER	20 A	1		0/0		1	20 A	ER	SERV-TAB-CASH REGIS-E	4	
5	SERV-TABL-COMP-PLISTS	ER	20 A	1		0/0		1	20 A	ER	SERVING-TABLE-COMP LGT	6	
7	ANSEL-SYST-CONTRACTOR	ER	20 A	1	0/0			1	20 A	ER	EXHAUST FAN - 6	8	
9	SPARE	E	20 A	1		0/0		1	20 A	ER	T. EXHAUST FAN - 3	10	
11	SPARE	E	20 A	1			0/360	1	20 A	E	EXHAUST FAN EF-C KITCHEN ROOF	12	
13	SPARE	E	20 A	1	0/0			1	20 A	ER	WORK-TABLE-RECEPT	14	
15	SPARE	E	20 A	1		0/0		1	20 A	ER	RECEPT-WORK-TABLE-E	16	
17	SPARE	E	20 A	1		0/0		1	20 A	ER	RECEPT-WORK-TABLE-E	18	
19	MICROWAVE	ER	30 A	2	0/0			1	20 A	ER	KETTLE - CONTROL	20	
21	REF-HALF-HALF-W-WAR	ER	20 A	2		0/0		1	20 A	ER	RECEPT - WORK TABLE	22	
23	REF-HALF-HALF-W-WAR	ER	20 A	2		0/0		1	20 A	ER	RECEPT-LOCKER TABLE	24	
25	REF-HALF-HALF-W-WAR	ER	20 A	2		0/0		1	20 A	ER	SPARE	26	
27	REFR-HALF-HALF-W-WAR	ER	20 A	2		0/0		3	90 A	ER	STOVE	28	
29	QUART-MIXER	ER	20 A	3	0/0			1	20 A	ER	SPARE	30	
31	QUART-MIXER	ER	20 A	3	0/0			1	20 A	ER	110 V-REFRIG-WARMER	32	
33	QUART-MIXER	ER	20 A	3	0/0			1	20 A	ER	ICE MACHINE	34	
35	RECEPT-KIT-EAST WALL	ER	20 A	1	0/0			1	20 A	ER	RECEPT-OFFICE-LOCKER	36	
37	RECEPT-LOCKER-STORAGE	ER	20 A	1	0/0			1	20 A	E	SPARE	38	
39	SPARE	E	20 A	1		0/0		1	20 A	E	SPARE	40	
41	SPARE	E	20 A	1		0/0		1	20 A	E	SPARE	42	
TOTALS :			0 VA		0 VA		300 VA						
TOTAL CONNECTED LOAD (VA) :			300 VA										
TOTAL CONNECTED LOAD (AMPS) :			1 A										
REMARKS: EXISTING SQUARE D PANELBOARD TYPE 'N000'													
NOTES: E - CONNECT TO EXISTING BREAKER. LEAVE AS SPARE IF UNUSED. ER - EXISTING CIRCUIT TO REMAIN.													

LPK(R)		PANELBOARD SCHEDULE											
LOCATION : ELEC. 197A		SCCR (AMPS RMS SYMM):		SERVICE : 208Y120V 3Ø 4-Wire-Ground		AMP : 400 A		MAIN : MLO		NEMA : Type 1		MOUNTING : SURFACE	
CKT	DESCRIPTION	NOTE	AMP	POLE	A	B	C	POLE	AMP	NOTE	DESCRIPTION	CKT	
1	LIGHTS - HOOD	ER	20 A	1	0/0			1	20 A	ER	SP-CIR-KIT-JBOX-A-OFF	2	
3	SP-IN-HOOD-FOR-CONTROL	ER	20 A	1		0/0		1	20 A	ER	SP-CIR-KIT-JBOX-A-OFF	4	
5	SPARE	ER	20 A	1		0/0		1	20 A	ER	SP-CIR-KIT-JBOX-A-OFF	6	
7	DISH-AREA-LIGHTS	ER	20 A	1	0/0			1	20 A	ER	?	8	
9	LIGHTS - KITCHEN	ER	20 A	1		0/300		1	20 A	ER	EXHAUST FAN EF-B KITCHEN ROOF	10	
11	LIGHTS-KITCHEN	ER	20 A	1		0/0		1	20 A	ER	EXHAUST FAN - 5	12	
13	COMPRESSOR	ER	20 A	3	0/0		0/200	1	20 A	ER	LIGHTS - FREEZER - COOLER	14	
15	WALK-IN-COOLER-COM	ER	20 A	3	0/0		0/0	1	20 A	ER	FAN COIL FCA OFFICE 198E	16	
17	WALK-IN-FREEZER-COM	ER	20 A	3	0/0		0/0	2	30 A	ER	HOT-FD-SERVING-TAB-W	20	
19	WALK-IN-FREEZER-COM	ER	20 A	3	0/0		0/0	2	20 A	E	SPARE	28	
21	WALK-IN-FREEZER-COM	ER	20 A	3	0/244		0/600	1	20 A	P	CUH-E DRY STORAGE 198D	30	
23	SPARE	E	20 A	3	0/298		0/0	1	20 A	P	CUH-D WEST VIBR. PUH-C CORR. CT16	34	
25	SPARE	E	20 A	3	0/0		0/0	1	20 A	P	HEATER PUH-C SERVING 198	36	
27	SPARE	E	20 A	3	0/0		0/0	3	20 A	E	SPARE	38	
29	SPARE	E	20 A	3	0/0		0/0	3	20 A	E	SPARE	40	
31	SPARE	E	20 A	3	0/0		0/0	3	20 A	E	SPARE	42	
TOTALS :			244 VA		788 VA		600 VA						
TOTAL CONNECTED LOAD (VA) :			1632 VA										
TOTAL CONNECTED LOAD (AMPS) :			5 A										
REMARKS: EXISTING SQUARE D PANELBOARD TYPE 'N000'													
NOTES: E - CONNECT TO EXISTING BREAKER. LEAVE AS SPARE IF UNUSED. ER - EXISTING CIRCUIT TO REMAIN. P - PROVIDE NEW BREAK													