

ADDENDUM NO. 3

Nathaniel Jones Early Learning Center Addition and Expansion

MSD of Pike Township  
Indianapolis, Indiana

Index of Contents

**Addendum No. 3:** 2 Items, 1 page

**Revised Project Manual Sections:**  
27 41 16 - Integrated AV Systems

**Revised Drawing Sheets:**  
MP11C; MP11D; MC11C; M-401; M-402; M-502; M-601; M-602; M-701; M-702; M-703; EL11C; EP11C; EP11D; E-601; E-602; E-603; E-604; T-502; T-503

Date: March 30, 2026

I hereby certify that this Addendum was prepared by me or under my direct supervision and that I am a duly registered Architect/Engineer under the Laws of the State of Indiana.

FANNING/HOWEY ASSOCIATES, INC.  
ARCHITECTS/ENGINEERS/CONSULTANTS



Paul A. Miller, License No. AR10800161  
Expiration Date: 12/31/2027

TO: ALL BIDDERS OF RECORD

ADDENDUM NO. 3 to Drawings and Project Manual, dated March 13, 2026, for MSD of Pike Township, 3950 W. 56<sup>th</sup> Street, Indianapolis, Indiana 46278; as prepared by Fanning/Howey Associates, Inc., Indianapolis, Indiana. This Addendum shall hereby be and become a part of the Contract Documents the same as if originally bound thereto.

The following clarifications, amendments, additions, revisions, changes, and modifications change the original Contract Documents only in the amount and to the extent hereinafter specified in this Addendum.

Each bidder shall acknowledge receipt of this Addendum in his proposal or bid.

NOTE: Bidders are responsible for becoming familiar with every item of this Addendum. (This includes miscellaneous items at the very end of this Addendum.)

RE: ALL BIDDERS

ITEM NO. 1. PROJECT MANUAL, SECTION 27 41 16 INTEGRATED AV SYSTEMS

- A. Replace this section in its entirety. The new revised section, dated 3/30/2026, is included with and hereby made a part of this Addendum.

ITEM NO. 2. REVISED DRAWING SHEETS

- A. Drawing Sheets: The following sheets in the document set have been revised, dated 3/26/26, and are included with and hereby made a part of this Addendum. These Drawings supersede the original documents.

AF11C	M-601	E-601
AF601	M-602	E-602
MP11C	M-701	E-603
MP11D	M-702	E-604
MC11C	M-703	T-502
M-401	EL11C	T-503
M-402	EP11C	
M-502	EP11D	

END OF ADDENDUM

**SECTION 27 41 16 - INTEGRATED A/V SYSTEMS  
(MULTIPURPOSE ROOM AV SYSTEM)**

**PART 1 - GENERAL**

**1.1 RELATED DOCUMENTS**

- A. Drawings and general provisions of the Contract, including General and Supplementary Conditions and other Division 01 Specification Sections, apply to this section.

**1.2 SUMMARY**

- A. This section includes but is not limited to the minimum requirements for the installation, configuration and training of the audio-visual components in the Multipurpose Room (Cafeteria C101) as depicted on in the Drawings and required by these specifications. The Multipurpose Room A/V system shall be a turnkey system that is capable of being used independently in each divided room as well as combined as one room.
- B. These Specifications, together with the Drawings accompanying them, are intended to depict the installation requirements necessary to support this Project. Contractor shall furnish materials shown and/or called for on the Drawings but not mentioned in the Specifications, or vice versa, that are necessary for the installation and support of communications cabling, whether specifically called for in both. In addition, Contractor shall provide incidental equipment and materials required for the completion of systems included in this contract whether specified or shown on the drawings.
- C. All required back boxes and conduit to support the AV systems are provided and installed as indicated on the drawings. Contractor is required to provide, install, test, and configure all cabling, equipment, and AV systems as described within this specification and as shown on the Tech drawings.
- D. This section includes minimum requirements for the following:
  - 1. Multipurpose Room AV System Equipment, including but not limited to the following:
    - a. Video matrix switching
    - b. Distributed 70V audio system
    - c. Wireless microphone system
    - d. Digital signal processing with room combining logic
    - e. Touchpanel control system
    - f. Equipment rack, wiring, programming, testing, and commissioning
- E. Related section includes the following:
  - 1. Division 01 – General Requirements
  - 2. Division 26 – Electrical
  - 3. Division 27 – Communications Sections.
  - 4. Division 28 – Electronic Safety and Security

**1.3 QUALITY ASSURANCE**

- A. The following industry Standards are the basis for the audio-visual system described herein. The list is incorporated by this reference to them.
  - 1. ANSI - American National Safety Institute
  - 2. ASTM - American Society of Testing and Materials
  - 3. EIA - Electronics Industries Association
  - 4. FCC - Federal Communications Commission
  - 5. NEMA - National Electrical Manufacturer's Association

6. OSHA - Occupational Safety and Health Administration
  7. NEC - National Electric Code.
  8. NFPA - National Fire Protection Association.
  9. IEEE - Institute of Electrical and Electronics Engineers.
  10. ISO - International Standards Organization.
  11. UL - Underwriters Laboratories
  12. Davis and Davis, Sound System Engineering (2nd Edition), Howard W. Sams, 1987
  13. Giddings, Audio System Design and Installation (ASDI), Howard W. Sams, 1990
- B. All cable and equipment shall be installed in a neat and skillful manner. Equipment and materials shall be of the quality and manufacturer indicated. The equipment specified is based upon the acceptable manufacturers listed. Where "Or equal" is stated, equipment shall be equivalent in every way to that of the equipment specified and subject to approval.
- C. Materials and work specified herein shall comply with the requirements of the local authority having jurisdiction.
- D. Contractor should have the following qualifications:
1. Experienced in the installation of systems similar in complexity and scale to those included within the scope of work. If requested, the Contractor shall provide the names, locations, and points of contact for at least three installations of the type and complexity specified herein.
  2. Within the last two (2) years, installed an audio-visual system with similar equipment and functionality.
  3. Have at least one (1) person on staff with CTS-I certification.

#### 1.4 SUBMITTALS

- A. Provide update one line drawing/detail for each system for approval.
- B. See front end submittals section for more information.
- C. See Common Work Results for Communications section 270500 for more submittal requirements.

#### 1.5 RECORD DRAWINGS / OPERATION AND MAINTENANCE MANUALS

- A. Provide record drawings and operation and maintenance manuals, as described in Sections – "Operation and Maintenance of Communications Systems" and Common Work Results for Communications Systems".

#### 1.6 DELIVERY, STORAGE, AND HANDLING

- A. Equipment and components shall arrive onsite properly protected and undamaged with containers, packaging, and labels intact.
- B. Store, handle and protect materials and equipment in accordance with Manufacturer's recommendations.
- C. Store materials and equipment in dry, environmentally controlled space. Do not install equipment and materials until spaces are enclosed, watertight, and dry. Protect equipment from dust and other airborne materials.
- D. Provide additional protection during handling as necessary to prevent breaking, scraping, marring, or otherwise damaging products or surrounding areas.
- E. Protect all equipment and components that are to be installed within this project from theft, vandalism, and exposure to rain, freezing temperatures and direct sunlight.

- F. Protect installed equipment and components from damage and prevent use by unauthorized persons.

## 1.7 WARRANTY

- A. The integrated audio video system and equipment for classrooms shall carry a warranty as specified in Section – "Demonstration and Training of Communications Systems". The warranty shall include all labor and material to replace all components that fail and or do not comply with the performance specifications.
- B. Contractor shall repair, adjust, and/or replace, whichever the Owner determines to be in its best interests, any defective equipment, materials, or workmanship, as well as such parts of the work damaged or destroyed by such defect, during the warranty period, at the Contractor's sole cost and expense. If parts or components need to be repaired, then a loaner will be supplied and installed until the part or component can be repaired and reinstalled.
- C. Manufacturer certified technicians shall perform all service work.
- D. At the end of the warranty period, the Contractor shall complete one (1) site visit to evaluate the status of the audio-visual systems. All equipment within this scope of work found to be defective shall be replaced at no cost to the Owner.
- E. Guarantees of material, equipment, and workmanship running in favor of the Contractor shall be transferred and assigned to the Owner on completion of the work and acceptance of said work by the Owner.

## PART 2 - PRODUCTS

### 2.1 VIDEO SYSTEM

- A. Video Matrix Switcher
  - 1. Shall meet or exceed the following specifications:
    - a. Support minimum 8 HDMI inputs
    - b. Support minimum 6 HDMI outputs
    - c. Support 4K resolution
    - d. HDCP compliant
    - e. Front panel lockout
    - f. Ethernet control
  - 2. Provide HDMI extension via DTP over CAT6A where required
  - 3. Provide necessary adapters, scaling, and EDID management
  - 4. Basis of Design:
    - a. Extron CrossPoint 86 4K
    - b. Or Equal
- B. Video Transmitter
  - 1. Provide an HDMI decorator-style wallplate twisted pair transmitter that shall support the distribution of video, audio, and control over a shielded CATx cable.
  - 2. Single-gang decorator-style wallplate transmitter for the transmission of HDMI, audio, and control
  - 3. Video input requirements
    - a. Provide one (1) video input for digital video signals
    - b. Supported HDMI specifications include data rates up to 10.2 Gbps, Deep Color up to 12-bit, 3D, HD lossless audio formats, and CEC pass-through
  - 4. Audio input requirements
    - a. Support embedded digital audio on HDMI input

- b. Provide a dedicated analog audio input connection
5. Control input requirements
    - a. Provide communication connections for AV device control
    - b. One bidirectional RS-232 pass-through
    - c. One bidirectional IR pass-through
  6. Interconnection requirements
    - a. Support interconnection between transmitter and receiver or DTP®-enabled products
    - b. One RJ-45 twisted pair connection
    - c. Shall be configurable for sending digital video and embedded audio, plus bidirectional RS-232 and IR signals to an HDBaseT-enabled display
  7. Transmission requirements
    - a. Provide signal transmission distance capability of 230 feet (70 m) at 1920x1200, including 1080p @ 60 Hz and 2K using a shielded CATx cable
    - b. Support signal transmission distance capability of 4K @ 30 Hz, UHD, and 2560x1600 up to 130 feet (40 m) using a shielded CATx cable
    - c. Support video, audio, and control over a single shielded CATx cable
    - d. Support embedded HD lossless audio formats
    - e. Actively buffer DDC channels
  8. Resolution requirements
    - a. Support computer and video resolutions up to 4K, including 1080p/60 Deep Color
    - b. Support RGB and YCbCr digital video formats
  9. Audio requirements
    - a. The unit shall accept additional analog stereo audio signals for simultaneous transmission with HDMI embedded audio
    - b. The unit shall support multiple embedded audio formats
    - c. The unit shall support embedded HD lossless audio formats
  10. HDCP requirements
    - a. The unit shall be HDCP 2.3 compliant with backward compatibility with earlier HDCP versions
  11. Communication requirements
    - a. The unit shall support bidirectional RS-232 communication pass-through up to 115200 baud
    - b. The unit shall support bidirectional IR pass-through
    - c. The unit shall support EDID and HDCP transmission
  12. Power requirements
    - a. The unit shall support remote power capability
    - b. The unit shall support being locally powered
  13. General Requirements
    - a. The unit shall be compatible with CATx shielded twisted pair cable, and Extron XTP DTP 24 shielded twisted pair cable
    - b. The unit shall support HDMI specifications including data rates up to 10.2 Gbps, Deep Color, 3D, HD lossless audio formats, and CEC pass-through
    - c. The unit shall support being locally or remotely powered
    - d. The unit shall support embedded HD lossless audio formats
    - e. The unit shall support the use of HDMI to DVI-D cables or adapters for DVI-D
    - f. The unit shall support installation into standard US one-gang electrical junction boxes
    - g. Shall provide visual indication of signal presence and power
    - h. Shall meet regulatory compliances
      - CE, c-UL, UL
      - CE, C-tick, FCC Class A, ICES, VCCI
    - i. Shall provide at least 3 years parts and labor warranty
    - j. Shall be compatible with other DTP-enabled products
  14. Basis of Design - Extron DTP T HWP 4K 231 D or Equal

C. Video Receiver

1. Provide an HDMI twisted pair receiver that shall support the distribution of video, audio, and control over a shielded CATx cable.
  - a. Rack-mountable receiver for HDMI, audio, and control
2. Video output requirements
  - a. Provide one (1) video output for digital video signals
  - b. Supported HDMI specifications include data rates up to 10.2 Gbps, Deep Color up to 12-bit, 3D, HD lossless audio formats, and CEC pass-through
3. Audio output requirements
  - a. Support embedded digital audio on HDMI output
  - b. Provide a dedicated analog audio output connection
  - c. One (1) stereo analog audio
4. Control output requirements
  - a. Provide communication connections for AV device control
  - b. One bidirectional RS-232 pass-through
  - c. One bidirectional IR pass-through
5. Interconnection requirements
  - a. Support interconnection between receiver and transmitter or DTP®-enabled products
  - b. One RJ-45 twisted pair connection
6. Transmission requirements
  - a. Provide signal transmission distance capability of 230 feet (70 m) at 1920x1200, including 1080p @ 60 Hz and 2K using a shielded CATx cable
  - b. Support signal transmission distance capability of 4K @ 30 Hz, UHD, and 2560x1600 up to 130 feet (40 m) using a shielded CATx cable
  - c. Support video, audio, and control over a single shielded CATx cable
  - d. Support embedded HD lossless audio formats
  - e. Actively buffer DDC channels
7. Resolution requirements
  - a. Support computer and video resolutions up to 4K, including 1080p/60 Deep Color
  - b. Support RGB and YCbCr digital video formats
8. Audio requirements
  - a. The unit shall support analog stereo audio pass-through signals
  - b. The unit shall support multiple embedded audio formats
  - c. The unit shall support embedded HD lossless audio formats
9. HDCP requirements
  - a. The unit shall be HDCP 2.3 compliant with backward compatibility with earlier HDCP versions
10. Communication requirements
  - a. The unit shall support bidirectional RS-232 communication pass-through up to 115200 baud
  - b. The unit shall support bidirectional IR pass-through
  - c. The unit shall support EDID and HDCP transmission
11. Power requirements
  - a. The unit shall support remote power capability
  - b. The unit shall support being locally powered
12. General requirements
  - a. The unit shall be HDCP 2.3 compliant with backward compatibility with earlier HDCP versions
  - b. The unit shall be compatible with CATx shielded twisted pair cable, and Extron XTP DTP 24 shielded twisted pair cable
  - c. The unit shall support HDMI specifications including data rates up to 10.2 Gbps, Deep Color, 3D, HD lossless audio formats, and CEC pass-through
  - d. The unit shall support being locally or remotely powered
  - e. The unit shall support embedded HD lossless audio formats
  - f. The unit shall support the use of HDMI to DVI-D cables or adapters for DVI-D
  - g. The unit shall have a low profile enclosure and versatile mounting capability
  - h. Shall provide visual indication for signal presence and power
  - i. Shall meet regulatory compliances

- CE, c-UL, UL
  - CE, C-tick, FCC Class A, ICES, VCCI
  - j. Shall provide at least 3 years parts and labor warranty
  - k. Shall be compatible with other DTP-enabled products
13. Basis of design - Extron DTP HDMI 4K 230 Rx or Equal

## 2.2 AUDIO SYSTEM

- A. Digital Signal Processor
1. Shall meet or exceed the following specifications:
    - a. Minimum 12 mic/line inputs.
    - b. Auto-mixer functionality.
    - c. Feedback suppression.
    - d. Parametric EQ per output.
    - e. Room combining logic.
    - f. Preset recall via control processor and partition sensor.
  2. Basis of Design:
    - a. Extron DMP 128 Plus C AT
    - b. Or Equal
- B. Power Amplifier
1. Shall meet or exceed the following specifications:
    - a. Amplifier shall be four-channel, professional-grade, convection or forced-air cooled.
    - b. Amplifier shall be capable of delivering minimum 600 watts per 70V channel.
    - c. Amplifier shall be capable of continuous operation at full rated load without thermal shutdown.
    - d. Each channel shall serve one room of the divisible Large Group Instruction space as follows:
      - Channel 1 – Room A Pendant Speakers (6)
        - Minimum 400W @ 70V
      - Channel 2 – Room A Ceiling Speakers (3)
        - Minimum 200W @ 70V
      - Channel 3 – Room B Pendant Speakers (3)
        - Minimum 300W @ 70V
      - Channel 4 – Room B Ceiling Speakers (3)
        - Minimum 200W @ 70V
    - e. Amplifier shall be sized such that total connected loudspeaker load does not exceed 80% of rated output capacity per channel under normal operating conditions.
    - f. Design connected load per room shall be approximately 240W–300W depending on final transformer tap settings, providing adequate headroom for:
      - Speech reinforcement
      - Music program material
      - Community event use
      - Dynamic peak levels without clipping
  2. Amplifier shall support:
    - a. 70V constant voltage operation
    - b. Balanced line-level inputs
    - c. Signal presence indicators
    - d. Independent gain controls
    - e. Protection circuitry (thermal, short circuit, overcurrent)
  3. Amplifier shall be rack-mounted in central AV equipment rack.
  4. Contractor shall verify total transformer tap load and submit final amplifier load calculation with shop drawings.
  5. Basis of Design - Extron XPA U 2004 SB or Equal

C. Loudspeakers

1. Provide complete distributed loudspeaker systems for each room of the divisible Large Group Instruction space.
2. Loudspeakers shall be 70V constant voltage type with integral multi-tap transformer.
3. All loudspeakers shall be:
  - a. UL listed
  - b. Plenum rated where installed in air handling spaces
  - c. Suitable for speech reinforcement and moderate music program material
  - d. Provided with seismic restraint where required by code
  - e. Finished to match ceiling/architectural conditions (white unless noted otherwise)
  - f. Transformer taps shall be field selectable and coordinated with final amplifier load calculations.
4. Provide all mounting hardware, backcans, tile bridges, grilles, suspension cables, and safety cables required for a complete installation.
5. Pendant Type Loudspeakers (High-Ceiling Areas)
6. Pendant loudspeakers shall be provided for high-ceiling areas as indicated on the drawings.
  - a. Pendants shall meet or exceed the following specifications:
    - Frequency response: 65 Hz – 20 kHz ( $\pm 10$  dB minimum)
    - Minimum continuous power handling: 60W
    - Transformer taps: 15W, 30W, 45W, 60W (minimum)
    - Coverage pattern: 100° conical minimum
    - Sensitivity: Minimum 87 dB SPL (1W/1m)
    - Maximum SPL: Minimum 105 dB continuous
    - Sealed enclosure design
    - Suspension via manufacturer-supplied cable system
    - Secondary independent safety cable attached to structure
    - Cabling concealed within suspension cable where available
  - b. Basis of design - Extron SF 26PT or Equal
7. Ceiling Type Loudspeakers
  - a. Ceiling loudspeakers shall be provided as indicated on the drawings. Ceiling speakers shall meet or exceed the following specifications:
    - 8-inch coaxial driver minimum
    - Frequency response: 70 Hz – 20 kHz ( $\pm 10$  dB minimum)
    - Transformer taps: 7.5W, 15W, 30W (minimum)
    - Sensitivity: Minimum 88 dB SPL (1W/1m)
    - Wide dispersion for even coverage
    - Plenum-rated backcan
    - Powder-coated steel grille
    - Tile bridge support rail system
    - Seismic tie wire attachment point
  - b. Basis of design - Extron SF 26CT or Equal

D. Wireless Microphone System

1. Wireless Microphone Receiver
  - a. Shall meet or exceed the following specifications:
    - Two channel digital wireless receiver, rack mountable.
    - Shall utilize a 64 MHz bandwidth.
    - Shall provide digital predictive switching for true diversity.
    - Shall have up to 60 frequency presets available.
    - Shall provide automatic frequency scanning.
    - Transmitters and receivers shall utilize a metal housing.
    - Coordinate operating frequency with local RF environment.
  - b. Basis of design - Shure ULXD4D or Equal
2. Directional Antennas

- a. Shall be wall-mounted at high elevation or ceiling grid mounted.
  - b. Basis of design - Shure UA874 – qty 2
3. Wireless Microphone Transmitters
- a. Handheld transmitter – Basis of design: Shure ULXD2/SM58 – qty 2
  - b. Bodypack transmitter – Basis of design: Shure ULXD1 – qty 2
  - c. Lavalier microphone – Basis of design: Shure WL185 – qty 2
  - d. Rechargeable 8-bay charging station and rechargeable batteries. Include one spare battery per transmitter. Basis of design: Shure SB900C – qty 8, Shure SBC8000 – qty 1
- E. Rack Mounted Media Player
- 1. Shall meet or exceed the following specifications:
    - a. Digital media player - Blu-Ray, DVD, CD and files from SD/USB media
    - b. RS-232C and IP control capability
    - c. Shall be 1RU rack mountable
    - d. Basis of design - Denon Pro DN-500BD MKII or equal

## 2.3 CONTROL SYSTEM

- A. Control Processor
- 1. Provide a fully integrated control system capable of managing:
    - a. Video Matrix Switching
    - b. Audio DSP and volume control
    - c. Display power and input control
    - d. Media player
    - e. Room combine/divide logic
    - f. Projection screen control
    - g. Power sequencing
    - h. Shall provide for control of entire AV system including, but not limited to, system power, source selection, screen control and audio volumes.
  - 2. Basis of design - Extron IPCP Pro 255Q xi with TLCA 1 TouchLink Control Port Expansion Adapters, IPL EXP S5 bidirectional RS-232 as required or Equal
- B. Touch Panel Control – in Cafeteria
- 1. Shall meet the following specifications:
    - a. Shall have Ethernet monitoring and control.
    - b. Shall have a capacitive touch screen interface.
    - c. Shall have a resolution of 1024x600.
    - d. Shall be 7” diagonal.
    - e. Shall have a contrast ratio of 700:1
    - f. Provide all necessary hardware and brackets required for installation.
    - g. Confirm final color with owner prior to procurement & installation.
  - 2. Basis of Design - Extron TLP Pro 725M or Equal
- C. Touch Panel Control – in Rack
- 1. Shall meet the following specifications:
    - a. Shall have Ethernet monitoring and control.
    - b. Shall have a capacitive touch screen interface.
    - c. Shall have a resolution of 1280x800.
    - d. Shall be 10” diagonal.
    - e. Shall have a contrast ratio of 800:1
    - f. Provide all necessary hardware and brackets required for installation.
    - g. Confirm final color with owner prior to procurement & installation.
  - 2. Basis of Design - Extron TLP Pro 1025M or Equal
- D. Hearing Assist Transmitter

1. Shall meet or exceed the following specifications:
  - a. Shall have a minimum of two (2) balanced audio inputs on XLR and/or RCA connectors.
  - b. Shall have an internal audio compressor.
  - c. Shall have an operating frequency of 216MHz.
  - d. Shall have a maximum output power of 100mW.
  - e. Provide remote antenna as shown on the drawings.
  - f. Provide quantity and type of receivers to meet ADA requirements.
  - g. Provide charging carrying case to accommodate all receivers.
  - h. Acceptable Manufacturers:
    - Listen Tech LT-800-216
    - Listen Tech LA-122
    - Listen Tech LT-400-216
    - Listen Tech LA-164
    - Listen Tech LA-165
    - Listen Tech LA-166

#### 2.4 LOUDSPEAKER RIGGING COMPONENTS

- A. Contractor shall provide and install speaker rigging components as necessary to mount loudspeakers as shown on the drawings.
- B. Structural support members to have a safety factor of at least 5. Mounting hardware and wire rope to have a safety factor of 8. All fasteners to be graded and certified for use in the intended applications. Overhead suspension hardware shall comply with ASME B30.20 standards and all applicable local building and safety codes.
- C. Overhead suspension hardware must be of a type that includes product traceability controls.
- D. Once the systems are installed, the engineer shall physically inspect the methods and means used to verify compliance with the original design.
- E. Loudspeaker Rigging Components shall meet or exceed the following specifications:
  1. Loudspeaker Rigging Components shall be made of quenched or tempered forged steel.
  2. Loudspeaker Rigging Components shall meet or exceed all the requirements of ASME B30.26 including identification, ductility, design factor, proof load and temperature requirements.
  3. Loudspeaker Rigging Components shall be hot dip galvanized or self-colored.
  4. Shackles shall meet the performance requirements of Federal Specification RR-C-271D Type IVA, Grade A, Class1.
  5. Turnbuckles shall meet the performance requirements of Federal Specifications FF-T-791b, Type 1 Form 1 - CLASS 4, and ASTM F-1145.
  6. Wire rope thimble shall meet the performance requirements of Federal Specification FF-T-276b Type II.
  7. Wire rope shall be sized as 7x19 utility cable.
  8. Provide all screw pin type shackles with mouse wire.
  9. All end fittings shall be moused to the body with mousing cable.
  10. Select size of product based working load limits required.
  11. Acceptable product:
    - a. Chicago Hardware Company
    - b. Crosby Group
    - c. Wire Rope Corporation of America (WRCA)

## 2.5 AV EQUIPMENT RACK

- A. Shall meet or exceed the following specifications:
  - 1. Shall have 44 units of available rack space.
  - 2. Shall have 16-gauge steel construction with black textured powder coat finish.
  - 3. Shall have side panels and fans for proper cooling.
  - 4. Shall have an overall depth of 26" and useable depth of 24".
  - 5. Acceptable Manufacturers:
    - a. Middle Atlantic MRK-4426-AV
    - b. Or Equal

## 2.6 EQUIPMENT RACK BLANKS

- A. Contractor to provide equipment rack blanks where required.
- B. Shall meet or exceed the following specifications:
  - 1. Shall have a flanged construction.
  - 2. Shall be made of 1/16" thick aluminum.
  - 3. Shall have a black brushed and anodized finish.
  - 4. Provide rack blank sizes as required.
  - 5. Acceptable Manufacturers:
    - a. Middle Atlantic BL Series
    - b. Or Equal

## 2.7 EQUIPMENT RACK VENTS

- A. Contractor to provide equipment rack vents where required.
- B. Equipment rack vents shall meet or exceed the following specifications:
  - 1. Shall have a flanged construction.
  - 2. Shall be made of 1/16" thick aluminum.
  - 3. Shall have a black brushed and anodized finish.
  - 4. Provide rack vent sizes as required.
  - 5. Acceptable Manufacturers:
    - a. Middle Atlantic VTP Series
    - b. Or Equal

## 2.8 MICROPHONE/LINE LEVEL CABLING

- A. Contractor shall provide and install microphone/line level cabling as required.
  - 1. Provide cabling meeting the following specifications:
    - a. Minimum shielded 22 AWG, 7x30 stranded cabling
    - b. Nominal conductor to conductor capacitance: 114 pF/m
    - c. Tinned copper drain wire
    - d. Cable to be PVC jacketed.
  - 2. Acceptable Manufacturers
    - a. Belden 9451
    - b. Or Equal

## 2.9 12AWG LOUDSPEAKER CABLING

- A. Contractor shall provide and install 12AWG loudspeaker cabling as required.
  - 1. Provide speaker cabling meeting the following specifications:
    - a. Minimum unshielded 12 AWG, 65x30 stranded cabling
    - b. Nominal conductor to conductor capacitance: 32 pF/ft
    - c. Cable to be PVC jacketed.
  - 2. Acceptable Manufacturers
    - a. Belden 5000UP

- b. Or Equal

#### 2.10 16AWG LOUDSPEAKER CABLING

- A. Contractor shall provide and install 16AWG loudspeaker cabling as required.
  - 1. Provide speaker cabling meeting the following specifications:
    - a. Minimum unshielded 16 AWG, 65x34 stranded cabling
    - b. Nominal conductor to conductor capacitance: 98 pF/ft
    - c. Cable to be PVC jacketed.
  - 2. Acceptable Manufacturers
    - a. Belden 5200UP
    - b. Or Equal

#### 2.11 UTP CABLING

- A. Contractor shall provide and install UTP cabling as required per manufacturer's recommendations.
  - 1. Provide UTP cabling meeting the following specifications.
    - a. Minimum 24 AWG, eight (8) conductor cable
    - b. Nominal conductor to conductor capacitance: 15 pF/ft
  - 2. Acceptable Manufacturers
    - a. Belden
    - b. Commscope
    - c. General Cable
    - d. Superior Essex
    - e. Or Equal

#### 2.12 XTP CABLING

- A. Contractor shall provide and install XTP cabling as required per manufacturer's recommendations.
  - 1. Acceptable Manufacturers
    - a. Extron
    - b. Or Equal

#### 2.13 HDMI CABLING

- A. Contractor shall provide and install HDMI cabling as required.
  - 1. Provide pre-molded cables in lengths as required.
  - 2. Shall support HDMI signal transmission up to 328 ft. via optical cabling.
  - 3. Shall support up to 4k 60Hz 4:4:4 HDR video.
  - 4. Shall meet HDMI 2.0/HDCP 2.2 testing standards.
  - 5. Shall be plenum rated.
  - 6. Shall not require external power.
  - 7. Acceptable Manufacturers
    - a. FSR HDMI 2.0 Digital Ribbon Cables
    - b. Or Equal

#### 2.14 RS-232 CABLING

- A. Contractor shall provide and install RS-232 cabling as required.
  - 1. Provide pre-molded cables in lengths as required.
  - 2. Acceptable Manufacturers
    - a. Extron
    - b. Or Equal

#### 2.15 RELAY CABLING

- A. Contractor shall provide and install relay cabling as required.
  - 1. Provide control cabling meeting the following specifications:
    - a. Minimum unshielded 22 AWG, 26x34 stranded cabling
    - b. Nominal conductor to conductor capacitance: 98 pF/m
    - c. Provide number of conductors as required.
  - 2. Acceptable Manufacturers
    - a. Belden
    - b. Or Equal

#### 2.16 RF CABLING

- A. Contractor shall provide and install RF cabling as required.
  - 1. Provide RF cabling meeting the following specifications:
    - a. Provide RG-8X type cable.
    - b. Center conductor 16 AWG solid.
    - c. Gas-injected FPE insulation
    - d. Cable to be PVC jacketed.
  - 2. Acceptable Product:
    - a. Belden 9258
    - b. Or Equal

#### 2.17 CUSTOM FACEPLATE

- A. Contractor shall provide plates as required by the T-series drawings. Engrave as shown on the drawings.
- B. Contractor shall coordinate plate finish and color with the Owner. Plastic plates are not acceptable.
- C. On dark plates, letters shall be white; on stainless steel or brushed natural aluminum plates, letters shall be black.
- D. Custom and/or engraved plates/panels:
  - 1. Custom panels constructed of 1/8-inch brushed aluminum
  - 2. Finish: Black Anodized.
  - 3. Acceptable Manufacturer:
    - a. ProCo
    - b. Or Equal

#### 2.18 GROMMETED FACEPLATES

- A. Contractor shall provide grommet faceplates as needed by audio and video locations as shown on the T-series drawings.
- B. Grommet faceplates shall provide a minimum of 1.5" Diameter opening for cable pass-through unless otherwise noted.
- C. Contractor shall coordinate plate finish and color with the Owner. Plastic plates are not acceptable.
- D. Grommeted plates/panels:
  - 1. Custom panels constructed of 1/8-inch brushed aluminum
  - 2. Finish: Black Anodized.

3. Acceptable Manufacturer:
  - a. ProCo
  - b. Or Equal

#### 2.19 XLR PANEL MOUNT CONNECTORS

- A. Contractor shall provide the quantity of XLR jacks as needed.
- B. Provide XLR jack meeting the following specifications:
  1. XLR jack shall be panel mounted with metal shell.
  2. XLR jack shall utilize gold contact solder terminations.
  3. Shell color shall match plate finish.
  4. Acceptable Manufacturers:
    - a. Neutrik
    - b. Switchcraft
    - c. Or Equal

#### 2.20 RCA PANEL MOUNT CONNECTORS

- A. Contractor shall provide the quantity of RCA jacks as needed.
- B. Provide RCA jack meeting the following specifications:
  1. RCA jack shall be panel mounted with metal shell.
  2. RCA jack shall utilize gold contact solder terminations.
  3. Shell color shall match plate finish.
  4. Each RCA jack shall have correct color code depending on input (i.e. left or right).
  5. Acceptable Manufacturers:
    - a. Neutrik
    - b. Switchcraft
    - c. Or Equal

#### 2.21 BNC PANEL MOUNT CONNECTORS

- A. Contractor shall provide the quantity of BNC jacks as needed.
- B. Provide BNC jack meeting the following specifications:
  1. BNC jack shall be panel mounted with metal shell.
  2. BNC jack shall utilize an RF protector.
  3. BNC jack shall utilize a feed-through connector.
  4. Acceptable Manufacturers:
    - a. Neutrik
    - b. Switchcraft
    - c. Or Equal

#### 2.22 ETHERNET PANEL MOUNT CONNECTORS

- A. Contractor shall provide the quantity of Ethernet jacks as needed.
- B. Provide Ethernet jack meeting the following specifications:
  1. Ethernet jack shall be panel mounted with metal shell.
  2. Ethernet jack shall utilize bronze contact terminations.
  3. Acceptable Manufacturers:
    - a. Neutrik
    - b. Switchcraft
    - c. Or Equal

#### 2.23 HDMI PANEL MOUNT CONNECTORS

- A. Contractor shall provide the quantity of HDMI jacks as needed.
- B. Provide HDMI jack meeting the following specifications:
  - 1. Shall be compatible with telecom faceplate.
  - 2. Shall meet HDMI 1.4 standards.
  - 3. Shall utilize a Type A female port.
  - 4. Color shall match telecom faceplate.
  - 5. Acceptable Manufacturers:
    - a. Panduit CMHDMIXX
    - b. Or Equal

#### 2.24 RS-232 PANEL MOUNT CONNECTORS

- A. Contractor shall provide the quantity of RS-232 jacks as needed.
- B. Provide RS-232 jack meeting the following specifications:
  - 1. Shall be compatible with telecom faceplate.
  - 2. Shall provide RS-232 female port.
  - 3. Color shall match telecom faceplate.
  - 4. Acceptable Manufacturers:
    - a. Panduit CMD15HDXXX
    - b. Or Equal

#### 2.25 XLR CABLE CONNECTORS

- A. Contractor shall provide the quantity of XLR cable connectors as needed.
- B. Provide XLR cable connector meeting the following specifications:
  - 1. XLR cable connector shall have black die-cast shell.
  - 2. XLR cable connector shall utilize gold contact solder terminations.
  - 3. XLR cable connector shall include strain relief.
  - 4. Acceptable Manufacturers:
    - a. Neutrik
    - b. Switchcraft
    - c. Or Equal

#### 2.26 RCA MALE CABLE CONNECTORS

- A. Contractor shall provide the quantity of RCA male cable connectors as needed.
- B. Provide RCA cable connector meeting the following specifications:
  - 1. RCA cable connector shall have a silver die-cast shell.
  - 2. XLR jack shall utilize silver contact solder terminations.
  - 3. Acceptable Manufacturers:
    - a. Neutrik
    - b. Switchcraft
    - c. Or Equal

#### 2.27 BNC CABLE CONNECTORS

- A. Contractor shall provide the quantity of BNC cable connectors as shown on the T-series drawings.
- B. Provide BNC cable connector meeting the following specifications:
  - 1. BNC cable connector shall have brass or copper contacts.
  - 2. BNC cable connector shall utilize a crimp termination.
  - 3. BNC cable connector shall provide the proper impedance.

4. Acceptable Manufacturers:
  - a. Kings
  - b. Amphenol
  - c. Canare

### PART 3 - EXECUTION

#### 3.1 GENERAL

- A. Coordinate incorporation of the Work specified herein with other project work to facilitate a cohesive final product.
- B. The installation recommendations contained within ASDI and Telecommunications Distribution Methods Manual are mandatory minimum standards and requirements.
- C. Mount equipment and enclosures plumb and level.
- D. Permanently installed equipment to be firmly and safely held in place. Design equipment supports to support loads imposed with a safety factor of at least five.
- E. Seismic bracing shall be installed on appropriate equipment where local codes require such installation.
- F. Verify all locations of equipment in all rooms with Owner's Representative, Owner, and Consultant.
- G. Follow all manufacturer requirements and recommendations for the installation of all AV equipment.

#### 3.2 CEILING MOUNTED SPEAKERS

- A. Shall be wired in parallel according to Manufacturer specifications.
- B. All speaker cabling shall be supported above the ceiling and may not rest on ceiling tiles or other structural devices.
- C. A minimum five (5) foot service loop shall be provided and secured above each speaker.

#### 3.3 RACK MOUNT POWER SEQUENCER

- A. Contractor to ensure all equipment is powered in the correct order to avoid audible pops or click from the audio-video system in response to the power sequencing.

#### 3.4 AUDIO VIDEO CONTROL SYSTEM

- A. Control system shall be programmed to at a minimum switch between available AV sources, power on/off video projector and control audio source and system volume.
- B. Contractor to provide iterations of the touchscreen layout and programming for review by the Owner and Consultant. The first phase will involve only the layout and proposed operation. Once reviewed, the Contractor will utilize this information to begin programming the touch panels. The touch panels will be reviewed again after the programming has been implemented in the field. Any changes from this phase shall be incorporated into the work. Final review will occur at the one-year walk-through.

#### 3.5 CABLING

- A. All cable routing shall meet Owner's standards.
- B. Run wire with conduit, exposed above accessible ceilings, below accessible floors, cable trays and in riser rooms.
- C. Provide plenum cabling where required.
- D. J-hooks shall be used so cables are supported at a maximum of 4 feet intervals. Cables shall not rest on light fixtures, ceiling tiles, conduits, sprinkler pipes, HVAC ducting, or any other building structure. Provide appropriate support for all horizontal to vertical transitions to keep weight of cable from damaging the point of transition.
- E. Horizontal cabling shall be in groups of no more than 60 cables when supported by J-hooks.
- F. Cable runs shall be continuous from device location to the point of termination. Properly installed transition points are acceptable.
- G. Provide plastic cable ties or Velcro straps to bundle cabling. Electrical tape or adhesive backed cable ties are not acceptable.
- H. Isolate cabling of different signals to minimize crosstalk. Separate wiring between microphone/line level circuits, loudspeaker circuits, and power circuits.
- I. Dress, lace, and/or harness all wiring and cabling to prevent mechanical stress on electrical connections. Neatly tie cabling in bundles with cable lengths cut to minimize excess slack.
- J. Provide adequate service loops to allow equipment racks to be pulled out for servicing.
- K. To prevent against electrostatic hum, on unused shields, fold back shield over cable jacket and cover with heat-shrink tubing. Do not cut off unused shield.
- L. Provide grommets and strain relief material where necessary to avoid abrasion of wire and excess tension on wire and cable.

### 3.6 COMPONENT CONNECTIONS

- A. Prepare wire ends for attachment to components in accordance with manufacturer recommendations.
- B. Wire nuts shall not be an acceptable means of connecting wire or cable.

### 3.7 LABELING

- A. Cables, jacks, system components, etc. shall be labeled according to ANSI/EIA/TIA-606 specifications and in coordination with the District/Technology Consultant.
- B. All Audio-Video cables shall be equipped with a self-laminating, wrap-around machine printed label at both ends of the cable and wiring label permanently affixed for easy identification.
- C. Cover labels with clear heat-shrink tubing.
- D. Hand-written labels are not acceptable.
- E. Locate the cable designator at the origination and destination of each circuit within 3 inches of the termination.

### 3.8 AUDIO VIDEO PLATE INSTALLATION

- A. Install plate mounted connectors rigidly attached to plates, plumb and level.
- B. Install XLR type connectors in accordance with IED-268 standard.

### 3.9 TESTING

- A. Prior to turning on the system, verify all electronic devices are properly grounded and each audio video AC receptacle has the proper hot, neutral, and ground connections.
- B. Audio Testing:
  - 1. Verify each amplifier channel is correctly wired by providing a test signal to each channel and verify the correct speakers are operating.
  - 2. Adjust the input and output gain of each device to properly set the system gain.
  - 3. Adjust the output level of each amplifier channel and/or speaker tap settings to achieve  $85 \text{ dB} \pm 2 \text{ dB}$  in the area covered by the respective speaker zone when the output of the sound reinforcement system is set to 0 dBu.
  - 4. Equalize all loudspeakers to provide an acceptable frequency response based on the specifications of the provided loudspeakers.
  - 5. Verify no hum or buzz is present in the system at all operating levels. If present, propose a resolution and correct the issue at no cost to the Owner.
- C. Video Testing:
  - 1. Using a video signal generator, verify performance of all equipment meets manufacturer's specifications.
  - 2. Verify correct operation of all inputs and outputs through audio video matrix switcher.

### 3.10 TRAINING

- A. After final completion, provide instruction to Owner designated personnel.
- B. Provide a minimum of twenty-four (24) hours of training to the Owner. Plan for multiple training trips to the site. Training session(s) shall cover the following topics at a minimum:
  - 1. System Equipment Connectivity
  - 2. Device Configurations
  - 3. Operation, maintenance, and upgrade procedures.
- C. Training to be arranged with Owner personnel and be coordinated with Owner personnel and their needs.
- D. Training plan, timeline, and agenda shall be provided to and signed off by Owner.
- E. Warranty certificate and agreement shall be provided to Owner at initial training session.
- F. Provide a digital video copy of the training sessions.
- G. Contractor to be present at first two (2) uses of the facility.

### 3.11 SYSTEM ACCEPTANCE

- A. Contractor shall demonstrate to the Owner that all systems have been installed per the plans and specifications and that all programming functions, display functions, control functions and all interfaced equipment operate as expected.
- B. Contractor shall demonstrate to the Owner that all the end user staff has a working knowledge of how to operate the installed equipment and that the facilities staff also has a

working knowledge of the troubleshooting methods for non-critical service problems.

- C. Contractor shall collaborate with the General Contractor to complete all punch lists and work required to allow the General Contractor to close out his project in a timely manner. This will include but not limited to any work that would impact any final inspection for turnover of the building.

END OF SECTION 27 41 16

# PIKE MSD/NATHANIEL JONES ELC EXPANSION

7839 New Augusta Rd  
Indianapolis, IN 46268


MSD OF PIKE TOWNSHIP



ARCHITECT




317.848.00966 WWW.FHAI.COM  
350 E New York St, Ste 300 Indianapolis, IN 46202

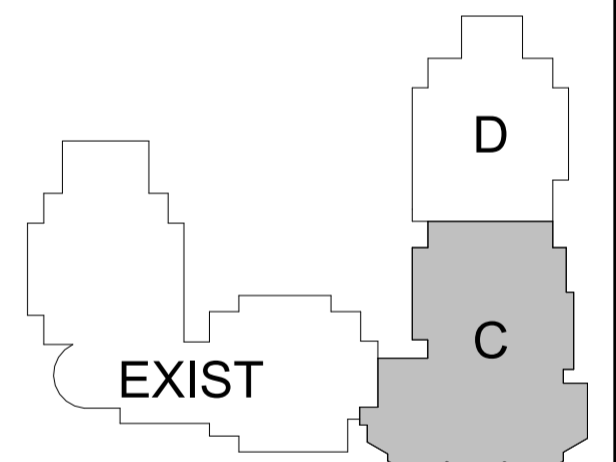

### KEY PLAN

### BID DOCUMENTS

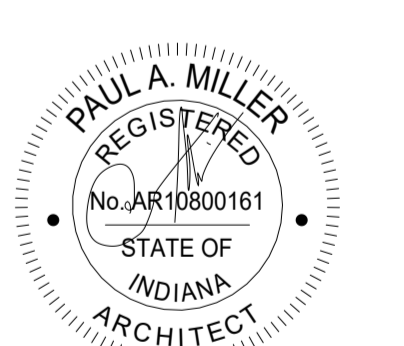

PROJECT MANAGER: PW  
DRAWN BY: MKH  
PROJECT NUMBER: 22216.00  
PROJECT ISSUE DATE: 2-26-2026

REV. NO.	DESCRIPTION	DATE
2	ADDENDUM-03	03-30-2026

### FIRST FLOOR FINISH PLAN - UNIT C

# AF11C

### ROOM LEGEND

ROOM NO.	OWNER ROOM NO.	ROOM NAME	AREA (SF)
C100		GYM / RECREATIONAL ROOM	2,515 SF
C100		GYM / RECREATIONAL ROOM	2,515 SF
C100A		STORAGE	274 SF
C100A		STORAGE	274 SF
C100B		CHAIR STORAGE	248 SF
C100B		CHAIR STORAGE	248 SF
C100C		PLAY EQUIPMENT	77 SF
C100C		PLAY EQUIPMENT	77 SF
C100D		STORAGE	318 SF
C100D		STORAGE	318 SF
C101		CAFETERIA	5,761 SF
C101		CAFETERIA	5,761 SF
C102		FAMILY RR	70 SF
C102		FAMILY RR	70 SF
C103		KITCHEN	1,515 SF
C103		KITCHEN	1,515 SF
C103A		KITCHEN STORAGE	177 SF
C103A		KITCHEN STORAGE	177 SF
C103B		LOCKERS	62 SF
C103B		LOCKERS	62 SF
C103C		RESTROOM	51 SF
C103C		RESTROOM	51 SF
C103D		OFFICE	88 SF
C103D		OFFICE	88 SF
C103E		KITCHEN VESTIBULE	122 SF
C103E		KITCHEN VESTIBULE	122 SF
C104		CUSTODIAL	220 SF
C104		CUSTODIAL	220 SF
C105		MEN'S RESTROOM	173 SF
C105		MEN'S RESTROOM	173 SF
C106		WOMEN'S RESTROOM	258 SF
C106		WOMEN'S RESTROOM	258 SF
C107		ELECTRICAL	92 SF
C107		ELECTRICAL	92 SF
C108		CLASSROOM 3	1,090 SF
C108		CLASSROOM 3	1,090 SF
C108A		STORAGE	79 SF
C108A		STORAGE	79 SF
C109		TOILET	136 SF
C109		TOILET	136 SF
C110		CLASSROOM 4	1,085 SF
C110		CLASSROOM 4	1,085 SF
C110A		STORAGE	73 SF
C110A		STORAGE	73 SF
C111		CLASSROOM 5	1,085 SF
C111		CLASSROOM 5	1,085 SF
C111A		STORAGE	73 SF
C111A		STORAGE	73 SF
C112		TOILET	136 SF
C112		TOILET	136 SF
C113		CLASSROOM 6	1,089 SF
C113		CLASSROOM 6	1,089 SF
C113A		STORAGE	79 SF
C113A		STORAGE	79 SF
C114		CLASSROOM 2	1,089 SF
C114		CLASSROOM 2	1,089 SF
C114A		STORAGE	79 SF
C114A		STORAGE	79 SF
C115		TOILET	135 SF
C115		TOILET	135 SF
C116		CLASSROOM 1	1,088 SF
C116		CLASSROOM 1	1,088 SF
C116A		STORAGE	73 SF
C116A		STORAGE	73 SF
C117		MECHANICAL	771 SF
C117		MECHANICAL	771 SF
C118		IT CLOSET	123 SF
C118		IT CLOSET	123 SF
C119		MAINTENANCE	178 SF
C119		MAINTENANCE	178 SF
C200		VESTIBULE	75 SF
C200		VESTIBULE	75 SF
C500		CORRIDOR	1,838 SF
C500		CORRIDOR	1,838 SF
C540		CORRIDOR	272 SF
C540		CORRIDOR	272 SF
C550		CORRIDOR	1,218 SF
C550		CORRIDOR	1,218 SF
C560		CORRIDOR	293 SF
C560		CORRIDOR	293 SF
C580		CORRIDOR	380 SF
C580		CORRIDOR	380 SF
C600		CLASSROOM 7	1,076 SF
C600		CLASSROOM 7	1,076 SF
D112		CLASSROOM 14	1,076 SF
D112		CLASSROOM 14	1,076 SF
D540		CORRIDOR	259 SF
D540		CORRIDOR	259 SF

- ### GENERAL FINISH NOTES
- FIXED CASEWORK AND TACKBOARDS SHALL REMAIN IN PLACE (UNO). NEW WALL FINISHES SHALL BE INSTALLED AROUND THESE ITEMS.
  - SEALANT SHALL BE APPLIED AT ALL MATERIAL TRANSITIONS, BACKSPLASHES, AND DOOR FRAMES. ALL LOCATIONS WHERE NEW FINISH ABUTS A DISSIMILAR MATERIAL.
  - REMOVE AND REINSTALL EXISTING DEVICE FACEPLATES, SWITCH FACEPLATES, TECHNOLOGY FACEPLATES, AND CLOCKS.
  - EXISTING ITEMS TO REMAIN AND NEW FINISHES APPLIED AROUND THESE ITEMS BUT NOT LIMITED TO THERMOSTATS, AND FIRE EXTINGUISHER CABINETS (UNO).
  - RESILIENT TRANSITION STRIP BETWEEN NEW FLOOR FINISH AND EXISTING FLOOR FINISH.
  - PROVIDE NEW RESILIENT TRANSITION STRIPS AT EXPOSED EDGE OF NEW FLOOR FINISH TO EXISTING FLOOR FINISH. PAINT ALL SIDES (VERT AND HORZ.) OF BULKHEAD/SOFFIT COLOR INDICATED (UNO).
  - EXISTING INTERIOR DOOR FRAMES ARE TO REMAIN. DO NOT PAINT.
  - PAINT ALL NEW INTERIOR DOOR FRAMES TO MATCH EXISTING DOOR FRAME COLOR. PAINT ON ALL FACES (PAINT CODE #6-12).
  - PATCH AND REPAIR ALL HOLES AND IMPERFECTIONS, TO RECEIVE NEW FINISHES.

- ### FLOOR PATTERN/FINISH KEY NOTES
- (ALL NOTES MAY NOT BE INDICATED ON THIS SHEET)
- | NO. | DESCRIPTION  |
|-----|--|
| 1   | THIS ROOM TO RECEIVE IRWC-4 UP TO 8' PAINT ABOVE. REFER TO LIST OF FINISHES  |
| 2   | ALL WALLS IN THIS ROOM TO RECEIVE PORCELAIN WALL TILE UP TO 6'-0" AND PAINT FROM 6'-0" TO CEILING                                  |
| 3   | PAINT ENTIRE DOOR FRAME ACCENT COLOR AS INDICATED  |
| 4   | ALIGN FLOOR TRANSITION WITH CORNER OF DOOR FRAME.  |
| 5   | ALIGN FLOOR TRANSITION WITH CORNER OF WALL.  |
| 6   | CONTINUE EUF-1 FLOORING INTO WALK IN COOLER/FREEZER UNITS. REFER TO FOOD SERVICE EQUIPMENT DRAWINGS FOR WALL AND CEILING FINISHES. |
| 7   | ALL WALLS IN THIS ROOM TO RECEIVE PORCELAIN WALL TILE UP TO 5'-6" WITH 6" TILE AT BASE AND PAINT FROM 5'-6" TO CEILING             |
| 8   | ALL WALLS IN THIS ROOM OR EXTENTS AS INDICATED TO RECEIVE CERAMIC WALL TILE UP TO 6'-0" AND PAINT FROM 6'-0" TO CEILING            |
| 9   | INSTALL METAL TRANSITION SIMILAR TO GRADUS KAS76 TO GO FROM EXISTING RUBBER TILE TO NEW ECT.                                       |
| 10  | IRWC CONTINUES ON ALL WALLS. CUT IRWC TO FIT AROUND STRUCTURE.   |
| 11  | INSTALL IRWC ON ALL WALLS IN ROOM AND PAINT NEW GWP-1.   |
| 12  | ALL EXPOSED STRUCTURAL MEMBERS, INCLUDING COLUMNS, AND DUCTS TO BE PAINTED TO MATCH PES-3.   |


### FLOOR PATTERN LEGEND

CART-1	SVF-1
RFT-1	SVF-2
RFT-2	SVF-3
RFT-3	SVF-4
RFT-4	SVF-5
ECT-1	

### VERIFICATION NOTE

CONTRACTOR SHALL VERIFY ALL DIMENSIONS AND CLEARANCES AND ALL EXISTING FIELD CONDITIONS BEFORE STARTING CONSTRUCTION. COMMENCEMENT OF WORK CONSTITUTES ACCEPTANCE OF CONDITIONS.

SHOULD DIFFERENT CONDITIONS BE ENCOUNTERED, CONTACT THE ARCHITECT BEFORE PROCEEDING WITH WORK.

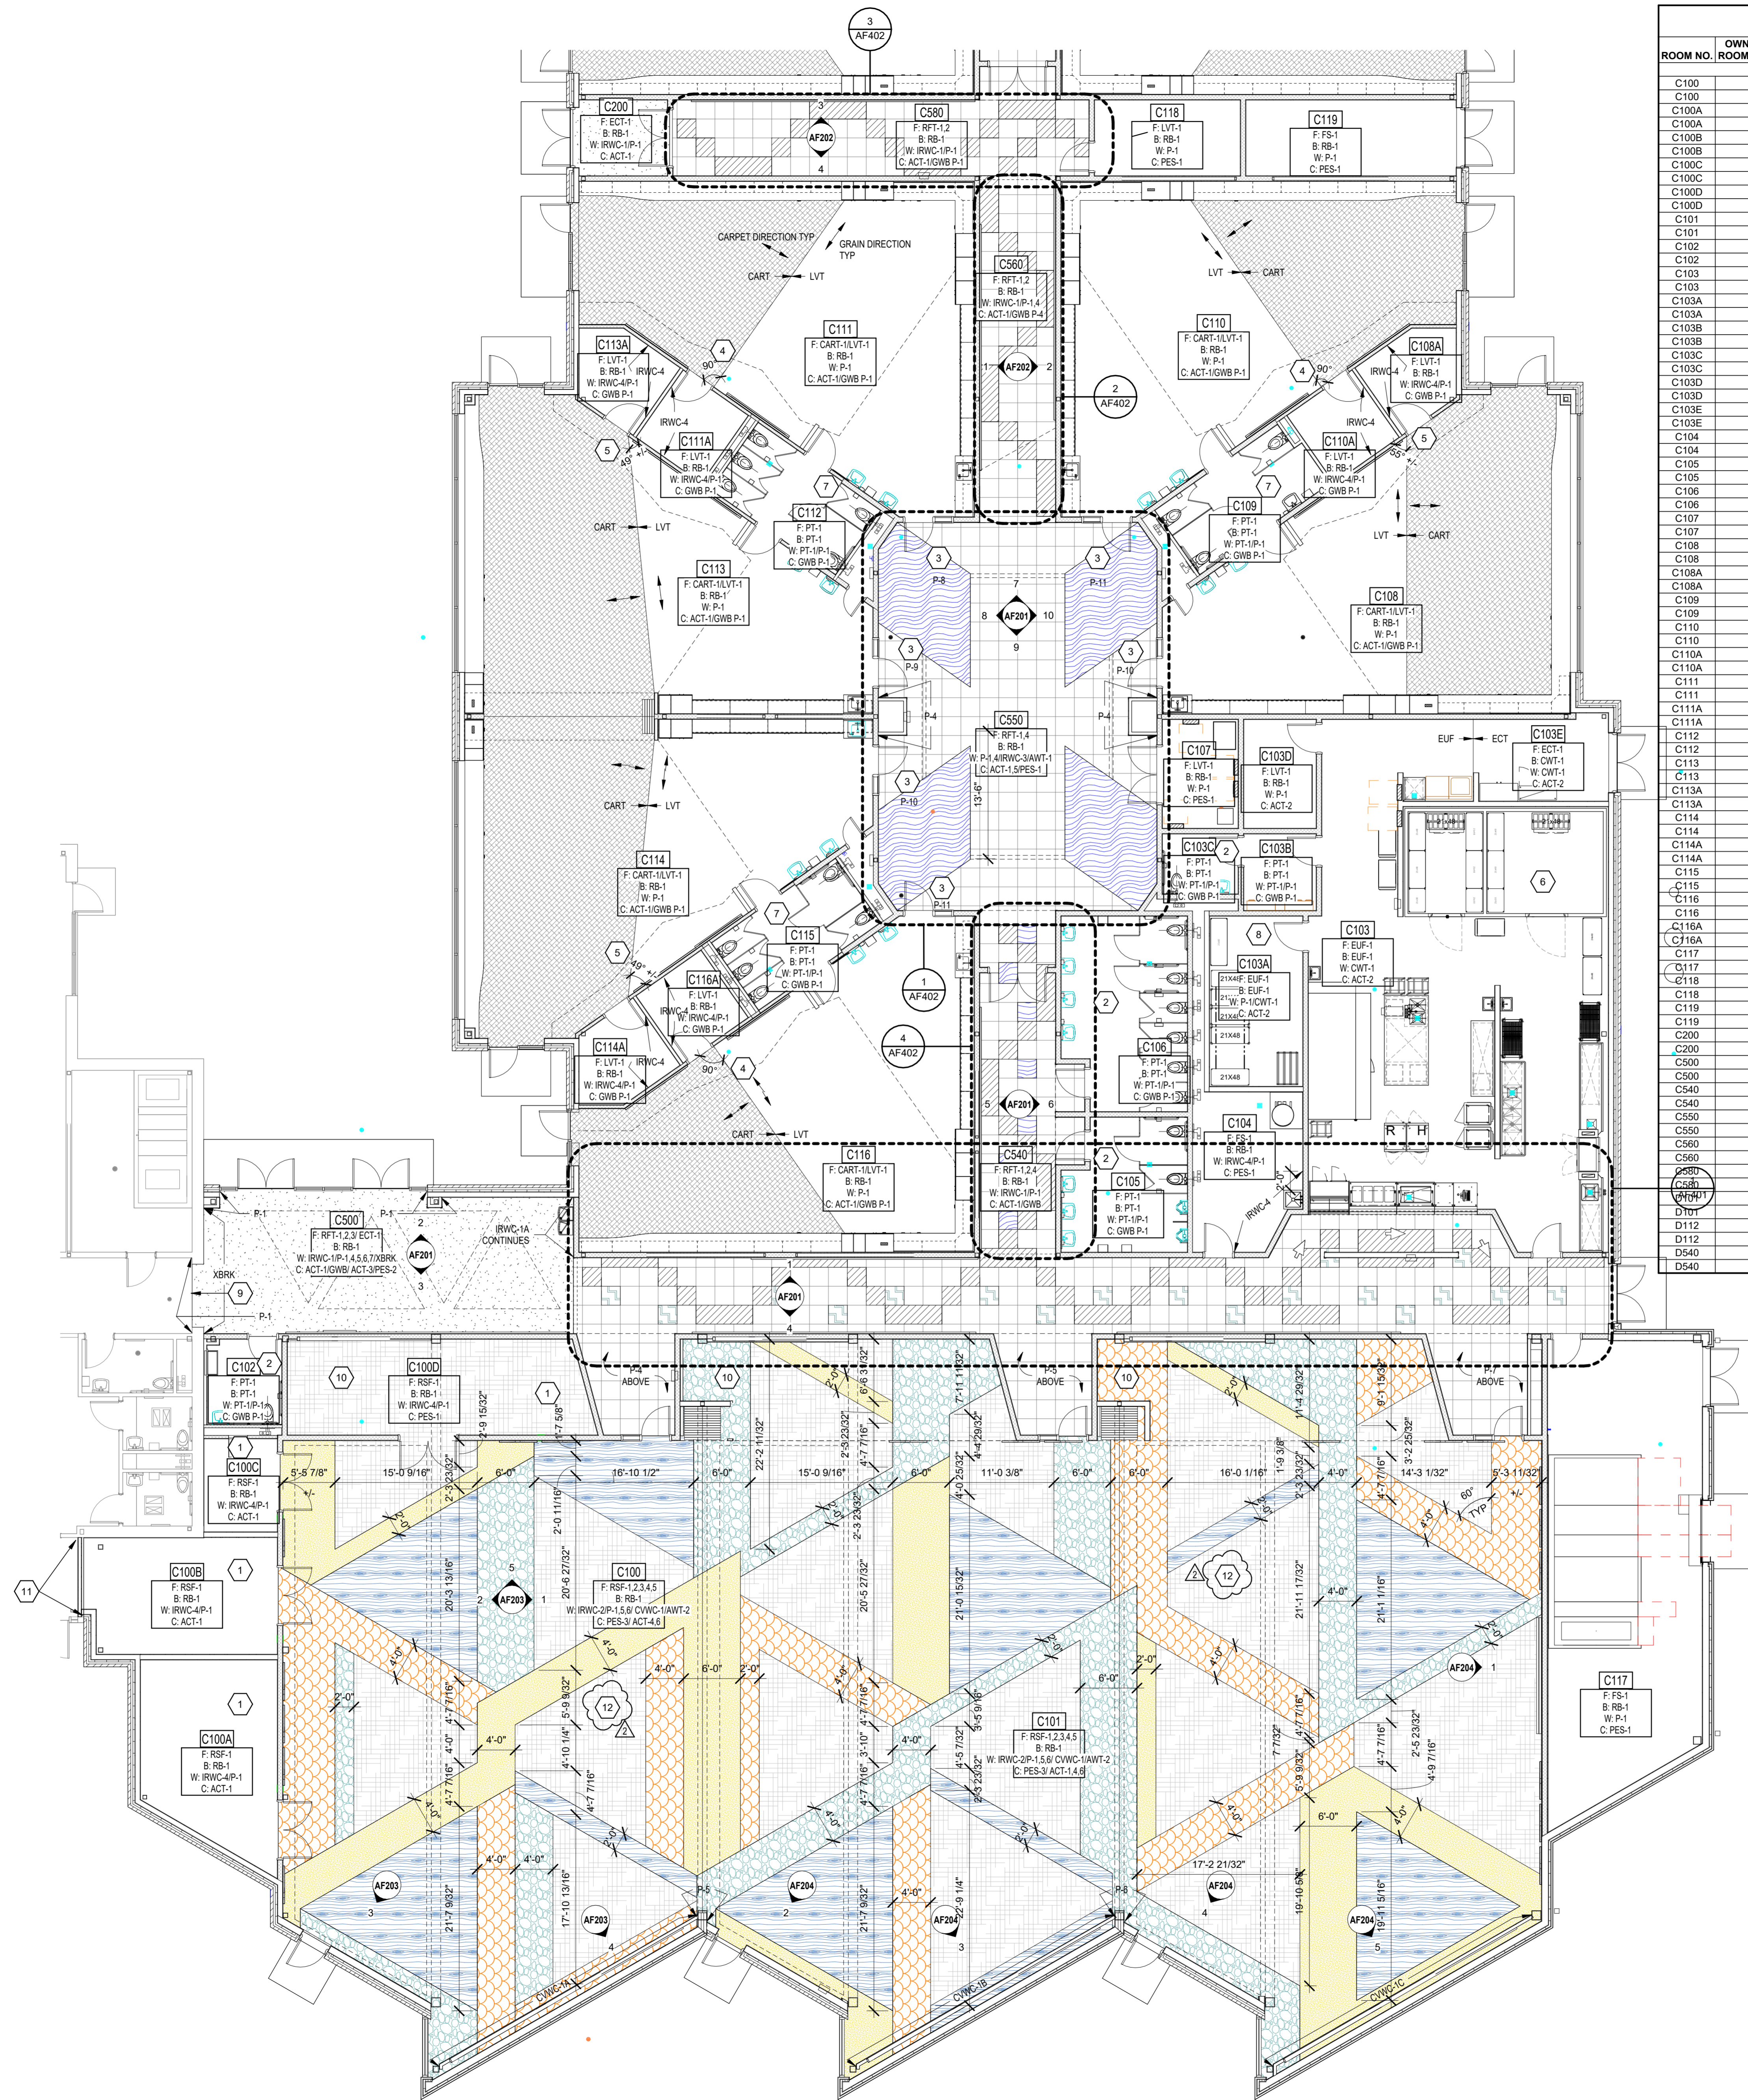

**LIST OF FINISHES**

REFER TO AQ ARCH. DWG. SHEETS

**EQUIPMENT MATERIALS**

**HP PLASTIC LAMINATE**

MATERIAL ABBREVIATION	MATERIAL/MANUFACTURER	COLOR SELECTION
PL-1 (CABS)	WILSONART	MISTED ZEPHYR 4843-80
PL-2 (COUNTERS)	WILSONART	CRISP LINEN 4942-38
PL-3 (SERVING)	NEVAMAR	FINE SYCAMORE W-8351T

**SOLID SURFACE MATERIAL**

MATERIAL ABBREVIATION	MATERIAL/MANUFACTURER	COLOR SELECTION
SSM-1	WILSONART	FROSTY WHITE MIRAGE 1573MG

**TACKBOARD**

MATERIAL ABBREVIATION	MATERIAL/MANUFACTURER	COLOR SELECTION
TB-A	DESIGNTEX "GAMUT" 4'-0" H	PEBBLE 3468-803
TB-B (CORRIDORS)	CARNEGIE XOREL "METEOR" 1'-0" H	6427-766

**TACKABLE WALL SURFACE**

MATERIAL ABBREVIATION	MATERIAL/MANUFACTURER	COLOR SELECTION
TWS-1	CARNEGIE XOREL "FRACTAL EMOSS"	6281-706
TWS-2	CARNEGIE XOREL "METEOR"	6427-766

**PHENOLIC TOILET PARTITIONS/COMPARTMENTS**

MATERIAL ABBREVIATION	MATERIAL/MANUFACTURER	COLOR SELECTION
TPP-1	BOBRICK - SOLID PHENOLIC EAD DESIGN - SOLID PHENOLIC	PANELS, PILASTERS AND DOORS TO MATCH ARBORITE PLASTIC LAMINATE MARIGOLD TWILL P-384 CA
TPP-2	REFER TO SPECS	PANELS, PILASTERS AND DOORS TO MATCH FORMICA PLASTIC LAMINATE FLAX GAUZE, T708-58

**MARKERBOARD**

WHITE
-------

**CORNER GUARDS**

MATERIAL ABBREVIATION	MATERIAL/MANUFACTURER	COLOR SELECTION
CG-1	CS ACROVYN	MISSION WHITE 933
CG-2 (TEAL)	CS ACROVYN	BALTIC BLUE
CG-3 (BLUE)	CS ACROVYN	BRIGHTS

**ROLLER WINDOW SHADE**

MATERIAL ABBREVIATION	MATERIAL/MANUFACTURER	COLOR SELECTION
RWS	DRAPER "E-SCREEN"	PEARL/LINEN 5% OPENNESS

**CUBICLE CURTAINS**

MATERIAL ABBREVIATION	MATERIAL/MANUFACTURER	COLOR SELECTION
CC	INPRO "SOFTETT"	CHAMOMILE

**KICKPLATES**

STAINLESS STEEL
-----------------

**OPERABLE PANEL PARTITION**

MATERIAL ABBREVIATION	MATERIAL/MANUFACTURER	COLOR SELECTION
OP-1 (CLASSROOMS)	REFER TO SPECIFICATIONS / KOROSEAL INTERLOOM	COCONUT NMD1-02
OP-2 (MULTIPURPOSE)	REFER TO SPECIFICATIONS / CARNEGIE XOREL "METEOR"	TO BE SELECTED
OP-3 (MULTIPURPOSE)	REFER TO SPECIFICATIONS / CARNEGIE XOREL "METEOR"	TO BE SELECTED

**EQUIPMENT MATERIAL/FINISH GEN. NOTES**

- COLOR SELECTION OF ALL FINISHES FOR INTERIOR ARCHITECTURAL WOODWORK/CUSTOM CASEWORK ITEMS ARE NOTED ON CASEWORK ELEVATIONS AND DETAIL DRAWINGS.
- EDUCATION CASEWORK FINISHES ARE AS FOLLOWS (UNLESS OTHERWISE NOTED):
  - HIGH PRESSURE PLASTIC LAMINATE COUNTERTOPS AND WORKSURFACES ARE TO BE PL-2, UNLESS OTHERWISE NOTED.
  - HIGH PRESSURE PLASTIC LAMINATE CABINETS/VERTICAL SURFACES ARE TO BE PL-1, UNLESS OTHERWISE NOTED.
  - INTERIOR MELAMINE TO BE WHITE.
  - OPEN CASEWORK AND CASEWORK WITH GLASS DOORS TO HAVE LAMINATE INTERIOR TO MATCH EXTERIOR.
  - 3MM AND 1MM PVC EDGES ON COUNTERTOPS AND WORKSURFACES ARE TO MATCH PL-2.
  - 3MM AND 1MM PVC EDGES ON CASEWORK ARE TO MATCH PL-1.
  - HANDLES TO BE BRUSHED CHROME.
  - HINGES TO BE BRUSHED CHROME.
  - GROMMETS TO MATCH MCKETT 85-WHITE.
  - TECHNOLOGY CABINET VENT COLOR TO BE DETERMINED.
- REFER TO FOOD SERVICE DRAWINGS FOR MORE INFORMATION.
- SOLID SURFACE WINDOW SILLS TO BE SSM-1.

**LIST OF FINISHES**

REFER TO AF ARCH. DWG. SHEETS

**FLOOR MATERIALS**

**CARPET TILE**

MATERIAL ABBREVIATION	MATERIAL/MANUFACTURER	COLOR SELECTION
CART-1	TANDUS CENTIVA "THIN LINES 04631" SIZE: 18"x36"	STORMY SKY 71407 INSTALL: VERTICAL ASHLAR

- ALL SPECIFIED MANUFACTURER'S MUST HAVE A MINIMUM FACE WEIGHT OF 20 oz./sq. yd.
- ALL CARPET BACKING TO HAVE A MOISTURE RESISTANT BARRIER.
- SUBMIT INSTALLATION DRAWINGS INDICATING LAYOUT OF CARPET TILE PRIOR TO INSTALLATION FOR APPROVAL.

**ENTRANCE CARPET TILE**

MATERIAL ABBREVIATION	MATERIAL/MANUFACTURER	COLOR SELECTION
ECT-1	INTERFACE "STEP REPEAT 799"	GRANITE
	QUARTER TURN INSTALLATION	

**LUXURY VINYL TILE**

MATERIAL ABBREVIATION	MATERIAL/MANUFACTURER	COLOR SELECTION
LVT-1	MANNINGTON "SPACIA"	DRY CEDAR, 7.25"x48"

**PORCELAIN TILE**

MATERIAL ABBREVIATION	MATERIAL/MANUFACTURER	COLOR SELECTION
PT-1	CROSSVILLE "RETROACTIVE 2.0" SIZE: 12"x12" X5/16" FINISH: HYBRID TILE FINISHING SYSTEM - REFER TO SPECS	FEATHERSTONE C370-CCS

**RUBBER FLOOR TILE**

MATERIAL ABBREVIATION	MATERIAL/MANUFACTURER	COLOR SELECTION
RFT-1	JOHNSONITE "COLOR SPLASH"	SPOKANE WARM VE3
RFT-2	JOHNSONITE "COLOR SPLASH"	PUGET SOUND VK3
RFT-3	JOHNSONITE "COLOR SPLASH"	SAN JUAN VK1
RFT-4	JOHNSONITE "COLOR SPLASH"	MARINER VH1

- ALL RFT TO BE 24"x24" TILE, U.N.O.
- RUBBER TILE TO HAVE A HAMMERED FINISH

**RESILIENT SHEET FLOORING**

HEAT WELD

MATERIAL ABBREVIATION	MATERIAL/MANUFACTURER	COLOR SELECTION
RSF-1	NORA, NORAPLAN "SENTICA"	CASHMERE 6506
RSF-2	NORA, NORAPLAN "SENTICA"	HEAT WAVE 6514
RSF-3	NORA, NORAPLAN "SENTICA"	REGATTA 6531
RSF-4	NORA, NORAPLAN "SENTICA"	DESTINATION 6535
RSF-5	NORA, NORAPLAN "SENTICA"	HAYRIDE 6513

- ALL HEAT WELDS TO MATCH FLOOR COLOR.
- SUBMIT INSTALLATION DRAWINGS INDICATING LAYOUT AND WELD COLORS PRIOR TO INSTALLATION FOR APPROVAL.

**FLUID-APPLIED EPOXY URETHANE FLOORING**

MATERIAL ABBREVIATION	MATERIAL/MANUFACTURER	COLOR SELECTION
EUF-1	REFER TO SPECIFICATIONS	ARCHITECT TO CHOOSE FROM FULL RANGE OF MANUFACTURER STANDARDS

**FLOOR SEALER**

MATERIAL ABBREVIATION	MATERIAL/MANUFACTURER	COLOR SELECTION
FS-1	REFER TO SPECIFICATIONS	CLEAR

**BASE MATERIALS**

**FLUID-APPLIED EPOXY URETHANE FLOORING (INTEGRAL COVE BASE)** 6" H COVE BASE

MATERIAL ABBREVIATION	MATERIAL/MANUFACTURER	COLOR SELECTION
EUF-1	REFER TO SPECIFICATIONS	MATCH EUF-1 FLOORING

**PORCELAIN TILE BASE**

MATERIAL ABBREVIATION	MATERIAL/MANUFACTURER	COLOR SELECTION
PT-1	CROSSVILLE "RETROACTIVE 2.0" SIZE: 6"x12" X5/16" FINISH: HYBRID TILE FINISHING SYSTEM - REFER TO SPECS	FEATHERSTONE C370-CCS

**RESILIENT BASE**

COVE BASE

MATERIAL ABBREVIATION	MATERIAL/MANUFACTURER	COLOR SELECTION
RB-1	JOHNSONITE, 4" H	FAWN 80
RB-2	JOHNSONITE, 2.5" H	MATCH EXISTING

**WALL FINISHES**

**PAINT**

MATERIAL ABBREVIATION	MATERIAL/MANUFACTURER	COLOR SELECTION
P-1 (FIELD)	SHERWIN WILLIAMS	SW7010 WHITE DUCK
P-2 (FRAMES-GEN)	SHERWIN WILLIAMS	SW7018 DOVETAIL
P-3	SHERWIN WILLIAMS	SW7030 ANEW GRAY
P-4 (BLUE)	PPG	SINGING THE BLUES 1159-7
P-5 (TEAL)	SHERWIN WILLIAMS	SW6487 LAKESHORE
P-6	SHERWIN WILLIAMS	SW6689 VANTAGE
P-7	SHERWIN WILLIAMS	SW6555 TRUPENNY
P-8 (FRAME CLASS)	BENJAMIN MOORE	2073-30 PASSION PLUM
P-9 (FRAME CLASS)	SHERWIN WILLIAMS	SW6768 GULLSTREAM
P-10 (FRAME CLASS)	BENJAMIN MOORE	2019-40 AMERICAN CHEESE
P-11 (FRAME CLASS)	SHERWIN WILLIAMS	SW6796 BLUE PLATE

**PORCELAIN WALL TILE**

MATERIAL ABBREVIATION	MATERIAL/MANUFACTURER	COLOR SELECTION
PT-1	CROSSVILLE "RETROACTIVE 2.0" SIZE: 12"x12" X5/16" FINISH: HYBRID TILE FINISHING SYSTEM - REFER TO SPECS	FEATHERSTONE C370-CCS

**CERAMIC WALL TILE**

MATERIAL ABBREVIATION	MATERIAL/MANUFACTURER	COLOR SELECTION
CWT-1 (KITCHEN)	FLORIDA TILE "FLUENT" SIZE: 3"x12" X5/16" FINISH: GLOSS	CREAM

**CUSTOM VINYL WALLCOVERING**

MATERIAL ABBREVIATION	MATERIAL/MANUFACTURER	COLOR SELECTION
CVWC-1A, 1B, 1C	REFER TO SPECIFICATIONS WALLCOVERING WITH UV GUARDIAN COATING	CUSTOM DIGITAL GRAPHIC ARTWORK PROVIDED BY ARCHITECT

**IMPACT-RESISTANT WALLCOVERING**

MATERIAL ABBREVIATION	MATERIAL/MANUFACTURER	COLOR SELECTION
IRWC-1	CS ACROVYN BY DESIGN SIZE: 4X10' PANELS	CUSTOM DIGITAL IMAGE ARTWORK BY ARCHITECT
IRWC-2	CS ACROVYN BY DESIGN SIZE: 4X10' PANELS	CUSTOM DIGITAL IMAGE ARTWORK BY ARCHITECT
IRWC-3	CS ACROVYN BY DESIGN SIZE: 4X10' PANELS	CUSTOM DIGITAL IMAGE ARTWORK BY ARCHITECT
IRWC-4	CS ACROVYN WALL PROTECTION SIZE: 4X8' PANELS	OYSTER GRAY 929

**CEILING FINISHES**

**ACOUSTICAL CEILING TILE**

MATERIAL ABBREVIATION	MATERIAL/MANUFACTURER	COLOR SELECTION
ACT-1	REFER TO SPECIFICATIONS	WHITE, SQUARE, 2'x2'
ACT-2	REFER TO SPECIFICATIONS	WHITE, SQUARE, 2'x2'
ACT-3	ARMSTRONG "LYRA PB SHAPES DESIGNFLEX" ARMSTRONG "AXIOM TRIM" ARMSTRONG "LYRA CAPZ"	TRIANGLE 100003, WHITE 4" MATCH P-6 CUSTOM PAINT MATCH PES-3 DECK COLOR. REFER TO PLANS FOR SIZES
ACT-5	ARMSTRONG "TECTUM 2" THICK	SW7030 ANEW GRAY
ACT-6	ARMSTRONG "ACOUSTIBUILT" ARMSTRONG "AXIOM TRIM"	P-1

**PAINTED EXPOSED STRUCTURE**

MATERIAL ABBREVIATION	MATERIAL/MANUFACTURER	COLOR SELECTION
PES-1	REFER TO SPECIFICATIONS	SW7030 ANEW GRAY TO BE SELECTED
PES-2	REFER TO SPECIFICATIONS	TO BE SELECTED
PES-3 (MULTIPURPOSE)	REFER TO SPECIFICATIONS	TO BE SELECTED

**MISCELLANEOUS FINISHES**

**INTERIOR WOOD DOORS/ INTERIOR WOOD TRIM**

- STAIN ALL WOOD DOORS, WOOD TRIM, ETC. TO MATCH MARSHFIELD "WHITE BIRCH, CLEAR 0-95".
- WOOD SPECIES TO BE PLAIN SLICED WHITE BIRCH.
- PROVIDE WOOD STAIN SAMPLES FOR VERIFICATION.

**GROUT**

MATERIAL ABBREVIATION	MATERIAL/MANUFACTURER	COLOR SELECTION
GT-1	LATICRETE	SILK 03

**ACOUSTICAL WALL TILES**

MATERIAL ABBREVIATION	MATERIAL/MANUFACTURER	COLOR SELECTION
AWT-1	REFER TO SPECIFICATIONS FABRIC WRAPPED, 2" THICK	MAHARAM / MESSENGER COLOR OYSTER
AWT-2 (MULTIPURPOSE)	REFER TO SPECIFICATIONS FABRIC WRAPPED, 2" THICK	CARNEGIE XOREL / STRIE COLOR TBD

**RESILIENT MOLDING ACCESSORIES**

MATERIAL ABBREVIATION	MATERIAL/MANUFACTURER	COLOR SELECTION
RMA	JOHNSONITE	FAWN 80

**MATERIAL & FINISH GENERAL NOTES**

**GENERAL**

REFER TO FINISH PLAN DRAWINGS AND DETAILS (AF SERIES) FOR MATERIALS, PATTERNS AND COLORS.

**FLOORING**

- CENTER FLOORING TILE AND PATTERN IN ROOM UNLESS OTHERWISE INDICATED ON FINISH PLANS.
- ALIGN EDGE OF FINISHED FLOOR MATERIAL WITH EDGE OF WALL OR CASEWORK.
- FLOOR FINISH MATERIAL TRANSITIONS SHALL OCCUR UNDER THE CENTER OF THE DOOR UNLESS OTHERWISE INDICATED. WHERE THE FLOORING MATERIAL CHANGES FROM ROOM TO ROOM.
- EXTEND FLOOR MATERIAL AND PATTERN UNDER ALL OPEN TO THE FLOOR CASEWORK AND FURNITURE.
- COORDINATE CONTROL JOINTS IN CONCRETE SLAB WITH STRUCTURAL DRAWINGS AND FINISH FLOORING INSTALLER.
- REFER TO FLOOR PLANS, RESTROOM ENLARGED PLANS, PLUMBING DRAWINGS, ETC. FOR FLOOR DRAIN LOCATIONS.
- AT BUILDING EXPANSION JOINTS (IF APPLICABLE) PROVIDE PRE-FABRICATED MOVEMENT PROFILE SYSTEM IN MORTAR BED. PROVIDE SCHLUTER DILEX/EDP OR APPROVED EQUAL. TYPICAL AT ALL LOCATIONS.
- AT BUILDING EXPANSION JOINTS (IF APPLICABLE) PROVIDE PRE-FABRICATED MOVEMENT PROFILE SYSTEM AT PORCELAIN TILE FLOORING. PROVIDE SCHLUTER DILEX-BWS OR APPROVED EQUAL. TYPICAL AT ALL LOCATIONS.

**RUBBER TILE**

- ALL RUBBER TILE PATTERNS BASED ON 2'-0" INCREMENTS.

**CARPET TILE**

- ALL CARPET TILE TO BE INSTALLED VERTICAL ASHLAR FOR ALL SPECIFIED TYPES/COLORS.

**PORCELAIN TILE**

- GROUT AT ALL CERAMIC AND PORCELAIN TILE LOCATIONS TO BE GT-1.
- PROVIDE PREFORMED BASE TO MATCH TRANSITION AT ALL LOCATIONS WHERE BASE COVERS MASONRY BULLNOSE. REFER TO FINISH SCHEDULE FOR BASE MATERIAL TYPE.
- ALL RESTROOMS TO RECEIVE HYBRID TILE FINISHING SYSTEM OVER PORCELAIN TILE. REFER TO LIST OF FINISHES AND SPECIFICATIONS.
- ALL LARGE GROUP RESTROOMS, AS INDICATED ON AF11C, ARE TO HAVE PORCELAIN WALL TILE WAINSCOT.
- PROVIDE METAL PROFILES AT ALL EXPOSED EDGES, OUTSIDE AND OUTSIDE CORNERS AND FLOOR TILE TO WALL TILE TRANSITIONS AND WALL TILE TO FLOORING TRANSITIONS. REFER TO AF501 FOR MORE DETAILS.

**WALL BASE**

- RUBBER BASE (RB-1) TO BE INSTALLED AT ALL RESILIENT TILE, CART, RFT, RSF, ECT. AND FS LOCATIONS UNLESS OTHERWISE INDICATED. ALL RB BASE TO BE COVERED.
- PROVIDE PREFORMED BASE TO MATCH TRANSITION AT ALL LOCATIONS WHERE BASE COVERS MASONRY BULLNOSE. REFER TO FINISH SCHEDULE FOR BASE MATERIAL TYPE. TYPICAL AT ALL LOCATIONS. AT RB LOCATIONS PROVIDE PREFORMED OUTSIDE CORNERS, AND USE MANUFACTURER'S RECOMMENDED ADHESIVE (CONTACT CEMENT) FOR PROPER ADHESION WITH NO GAPS.

**PAINT & STAIN**

- PAINT ALL WALLS UNLESS OTHERWISE INDICATED ON FINISH PLANS.
- PAINT ONCE MOCK-UP CLASSROOM TO RECEIVE ARCHITECT'S APPROVAL PRIOR TO ORDERING PAINT FOR THE ENTIRE BUILDING.

**PAINT TYPE GENERAL NOTES**

- UNDER SECTION 099123 - INTERIOR PAINTING, PAINT EXPOSED PIPES, DUCTWORK, BREACHING, CONDUIT, INSULATED PIPES, CONDUIT HANGERS, SUPPORTS, BRACING, ETC., WHICH OCCURS IN SPACES DESIGNATED TO BE PAINTED IN PART OR WHOLE.
- PAINTING AND FINISHING OF EXTERIOR SURFACES AS DESIGNATED. DETAILS SHALL BE UNDER THE WORK SECTION 0991113 - EXTERIOR PAINTING.
- ALL GYPSUM BOARD WALLS SHALL BE PAINTED WITH INTERIOR PAINT TYPE #9.22 (SEMI-GLOSS) UNLESS OTHERWISE INDICATED.
- ALL GYPSUM BOARD CEILINGS AND SOFFITS SHALL BE PAINTED WITH PAINT TYPE #9.21 (FLAT) UNLESS OTHERWISE INDICATED.
- PAINT ALL NON-INTEGRALLY COLORED CMU WALLS WITH INTERIOR PAINT TYPE #4.14 (SEMI-GLOSS), UNLESS OTHERWISE INDICATED.
- IN THE FOLLOWING ROOMS PAINT WITH PAINT CODE #9.211 (EPOXY-SEMI-GLOSS). REFER TO SECTION 099600 - HIGH PERFORMANCE COATINGS: **D108, D540, C580, D580, C109, C109B, C109C, C109E, C109, C106, C109, C112, C116, C200, C500, C540, C580, C580, D102, D111, D105, D108, D540, C580, D580**
- ALL FERROUS METAL (EXCLUDING STRUCTURE) SHALL BE PAINTED INTERIOR PAINT TYPE #5.12.
- ALL GALVANIZED METAL (EXCLUDING STRUCTURE) SHALL BE PAINTED INTERIOR PAINT TYPE #5.32.
- ALL EXPOSED STEEL (FERROUS) STRUCTURE SHALL BE PAINTED INTERIOR PAINT TYPE #5.11.
- ALL EXPOSED GALVANIZED-METAL STRUCTURE SHALL BE PAINTED INTERIOR PAINT TYPE #5.31.

**PAINT COLOR GENERAL NOTES**

- ALL INTERIOR WALLS SHALL BE PAINTED P-1, UNLESS OTHERWISE INDICATED ON FINISH PLANS OR INTERIOR ELEVATIONS.
- PAINT ALL GWS SOFFITS P-1 UNLESS OTHERWISE NOTED ON FINISH PLANS OR INTERIOR ELEVATIONS.
- PAINT ALL SIDES (HORIZ. AND VERT.) OF SOFFIT INDICATED COLOR, UNLESS OTHERWISE NOTED.
- PAINT ALL PAINTED EXPOSED CEILINGS P-3 UNLESS OTHERWISE NOTED ON FINISH PLANS, CEILING PLANS, OR INTERIOR ELEVATIONS.
- PAINT ALL PAINTED GYPSUM BOARD CEILINGS P-1 UNLESS OTHERWISE NOTED ON FINISH PLANS, CEILING PLANS, OR INTERIOR ELEVATIONS.
- ALL INTERIOR HOLLOW METAL FRAMES AND DOOR FRAMES TO BE PAINTED P-2 UNLESS OTHERWISE NOTED.
- ALL EXPOSED INTERIOR STEEL COLUMNS SHALL BE PAINTED TO MATCH ADJACENT WALL COLOR, UNLESS OTHERWISE INDICATED ON INTERIOR ELEVATIONS OR FINISH PLANS. REFER TO FINISH PLANS FOR SPECIAL CONDITIONS AT C100 AND C101.

**PIKE MSD/NATHANIEL JONES ELC EXPANSION**

7839 New Augusta Rd Indianapolis, IN 46268

**MSD OF PIKE TOWNSHIP**




ARCHITECT



317.848.0096

WWW.FHAI.COM

350 E New York St. Ste 300 Indianapolis, IN 46202

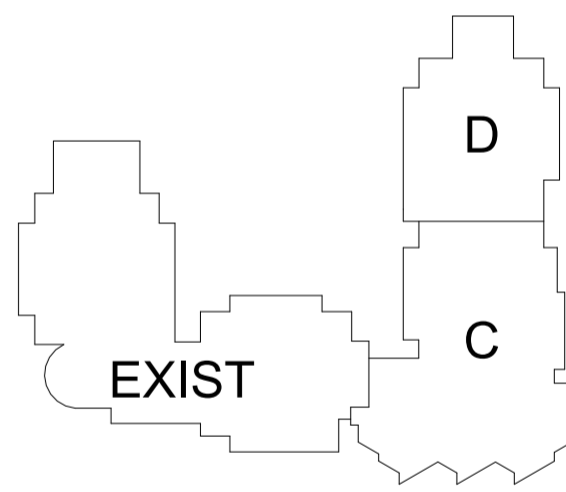






# NATHANIEL JONES EARLY LEARNING CENTER ADDITION & EXPANSION

7839 NEW AUGUSTA RD,  
INDIANAPOLIS, IN 46268


MSD OF PIKE TOWNSHIP

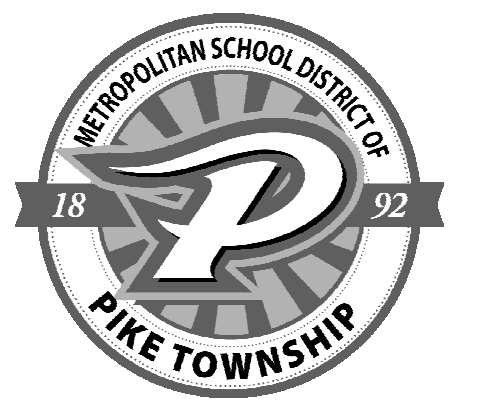


ARCHITECT

## FANNING HOWEY


317-848-0966 WWW.FHAI.COM  
350 E NEW YORK ST, SUITE 300, INDIANAPOLIS, IN 46204

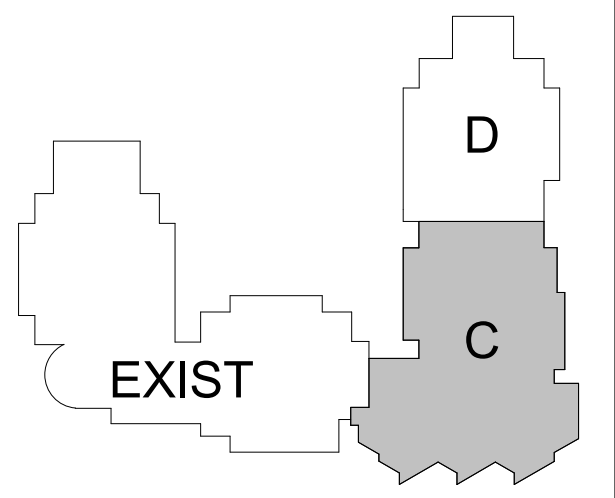

### KEY PLAN

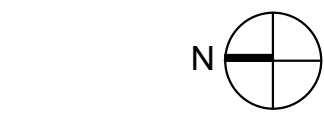

BID DOCUMENTS

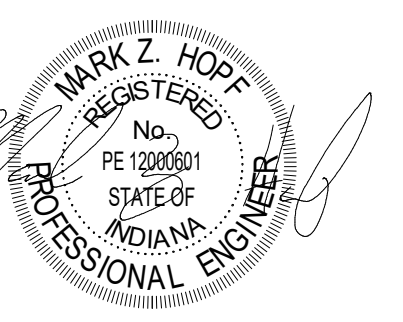

PROJECT MANAGER: PW  
DRAWN BY: CMS  
PROJECT NUMBER: 223216.00  
PROJECT ISSUE DATE: 03-26-2026

REV. NO.	DESCRIPTION	DATE
1	ADDENDUM #2	03/26/2026
2	ADDENDUM #3	3/30/2026

### FIRST FLOOR CONTROLS PLAN - UNIT C

# MC11C

ROOM NO.	ROOM NAME	AREA (SF)
C1	STAGE	Not Placed
C102	GYM / RECREATIONAL ROOM	2515 SF
C100A	STORAGE	274 SF
C100B	CHAIR STORAGE	248 SF
C100C	PLAY EQUIPMENT	77 SF
C100D	STORAGE	318 SF
C101	CATERERIA	576 SF
C102	FAMILY RR	70 SF
C103	KITCHEN	1515 SF
C103A	KITCHEN STORAGE	177 SF
C103B	LOCKERS	62 SF
C103C	RESTROOM	51 SF
C103D	OFFICE	88 SF
C103E	KITCHEN VESTIBULE	122 SF
C104	CUSTODIAL	220 SF
C105	MEN'S RESTROOM	173 SF
C106	WOMEN'S RESTROOM	250 SF
C107	ELECTRICAL	92 SF
C108	CLASSROOM 3	1090 SF
C108A	STORAGE	79 SF
C109	TOILET	136 SF
C110	CLASSROOM 4	1089 SF
C110A	STORAGE	73 SF
C111	CLASSROOM 5	1085 SF
C111A	STORAGE	73 SF
C112	TOILET	136 SF
C113	CLASSROOM 6	1089 SF
C113A	STORAGE	79 SF
C114	CLASSROOM 2	1089 SF
C114A	STORAGE	79 SF
C115	TOILET	135 SF
C116	CLASSROOM 1	1088 SF
C116A	STORAGE	73 SF
C117	MECHANICAL	771 SF
C118	IT CLOSET	123 SF
C119	MAINTENANCE	178 SF
C200	VESTIBULE	75 SF
C500	CORRIDOR	1838 SF
C540	CORRIDOR	272 SF
C550	CORRIDOR	1218 SF
C560	CORRIDOR	293 SF
C580	CORRIDOR	360 SF

**TEMPERATURE CONTROL PLAN GENERAL NOTES**

A. REFER TO SECTION 23 05 00 GENERAL REQUIREMENTS AND CONDITIONS FOR THE TRANSPORT, STORAGE, DEMOLITION, & INSTALLATION AS DESCRIBED HEREIN.

B. **BUILDING HEATING & COOLING PLANT CONTROLS:** TEMPERATURE CONTROL CONTRACTOR SHALL PROVIDE ITEMS SUCH AS, BUT NOT BE LIMITED TO, CONTROL EQUIPMENT, VALVES, ACTUATORS, SENSORS, DEVICES, COMPONENTS, & COORDINATION FOR NEW COMPLETE & FUNCTIONAL BUILDING TEMPERATURE CONTROL SYSTEM.


C. **TEMP CONTROL (WALL MTD) SENSORS/THERMOSTATS:** ANTICIPATED LOCATIONS FOR TEMPERATURE CONTROL SYSTEMS AMBIENT SENSORS & THERMOSTATIC CONTROLLERS ARE SHOWN. REFER TO SECTIONS 23 05 00 & 23 09 00 FOR DEVICE REQUIREMENT(S) RELEVANT TO EQUIPMENT & ZONE INSTALLATIONS. CONTRACTOR IS RESPONSIBLE TO IDENTIFY MOST APPROPRIATE DEVICE LOCATION. CONTACT PROJECT ENGINEER IF CLARIFICATION BECOMES NECESSARY. CONTRACTOR SHALL PROVIDE ALL WIRING, DEVICES AND COMPONENTS.

D. **TEMPERATURE CONTROL PLAN NOTES** (X)  
(ALL NOTES MAY NOT BE INDICATED ON THIS SHEET)

**NO. DESCRIPTION**

T1 TEMPERATURE SENSOR PROVIDED BY THE TEMPERATURE CONTROL CONTRACTOR TO MONITOR SPACE TEMPERATURE.

T4 EXHAUST AIR CONTROL DAMPER SHALL BE FACTORY MOUNTED IN AIR HANDLING UNIT DAMPER OPERATORS PROVIDED BY TEMPERATURE CONTROL CONTRACTOR.

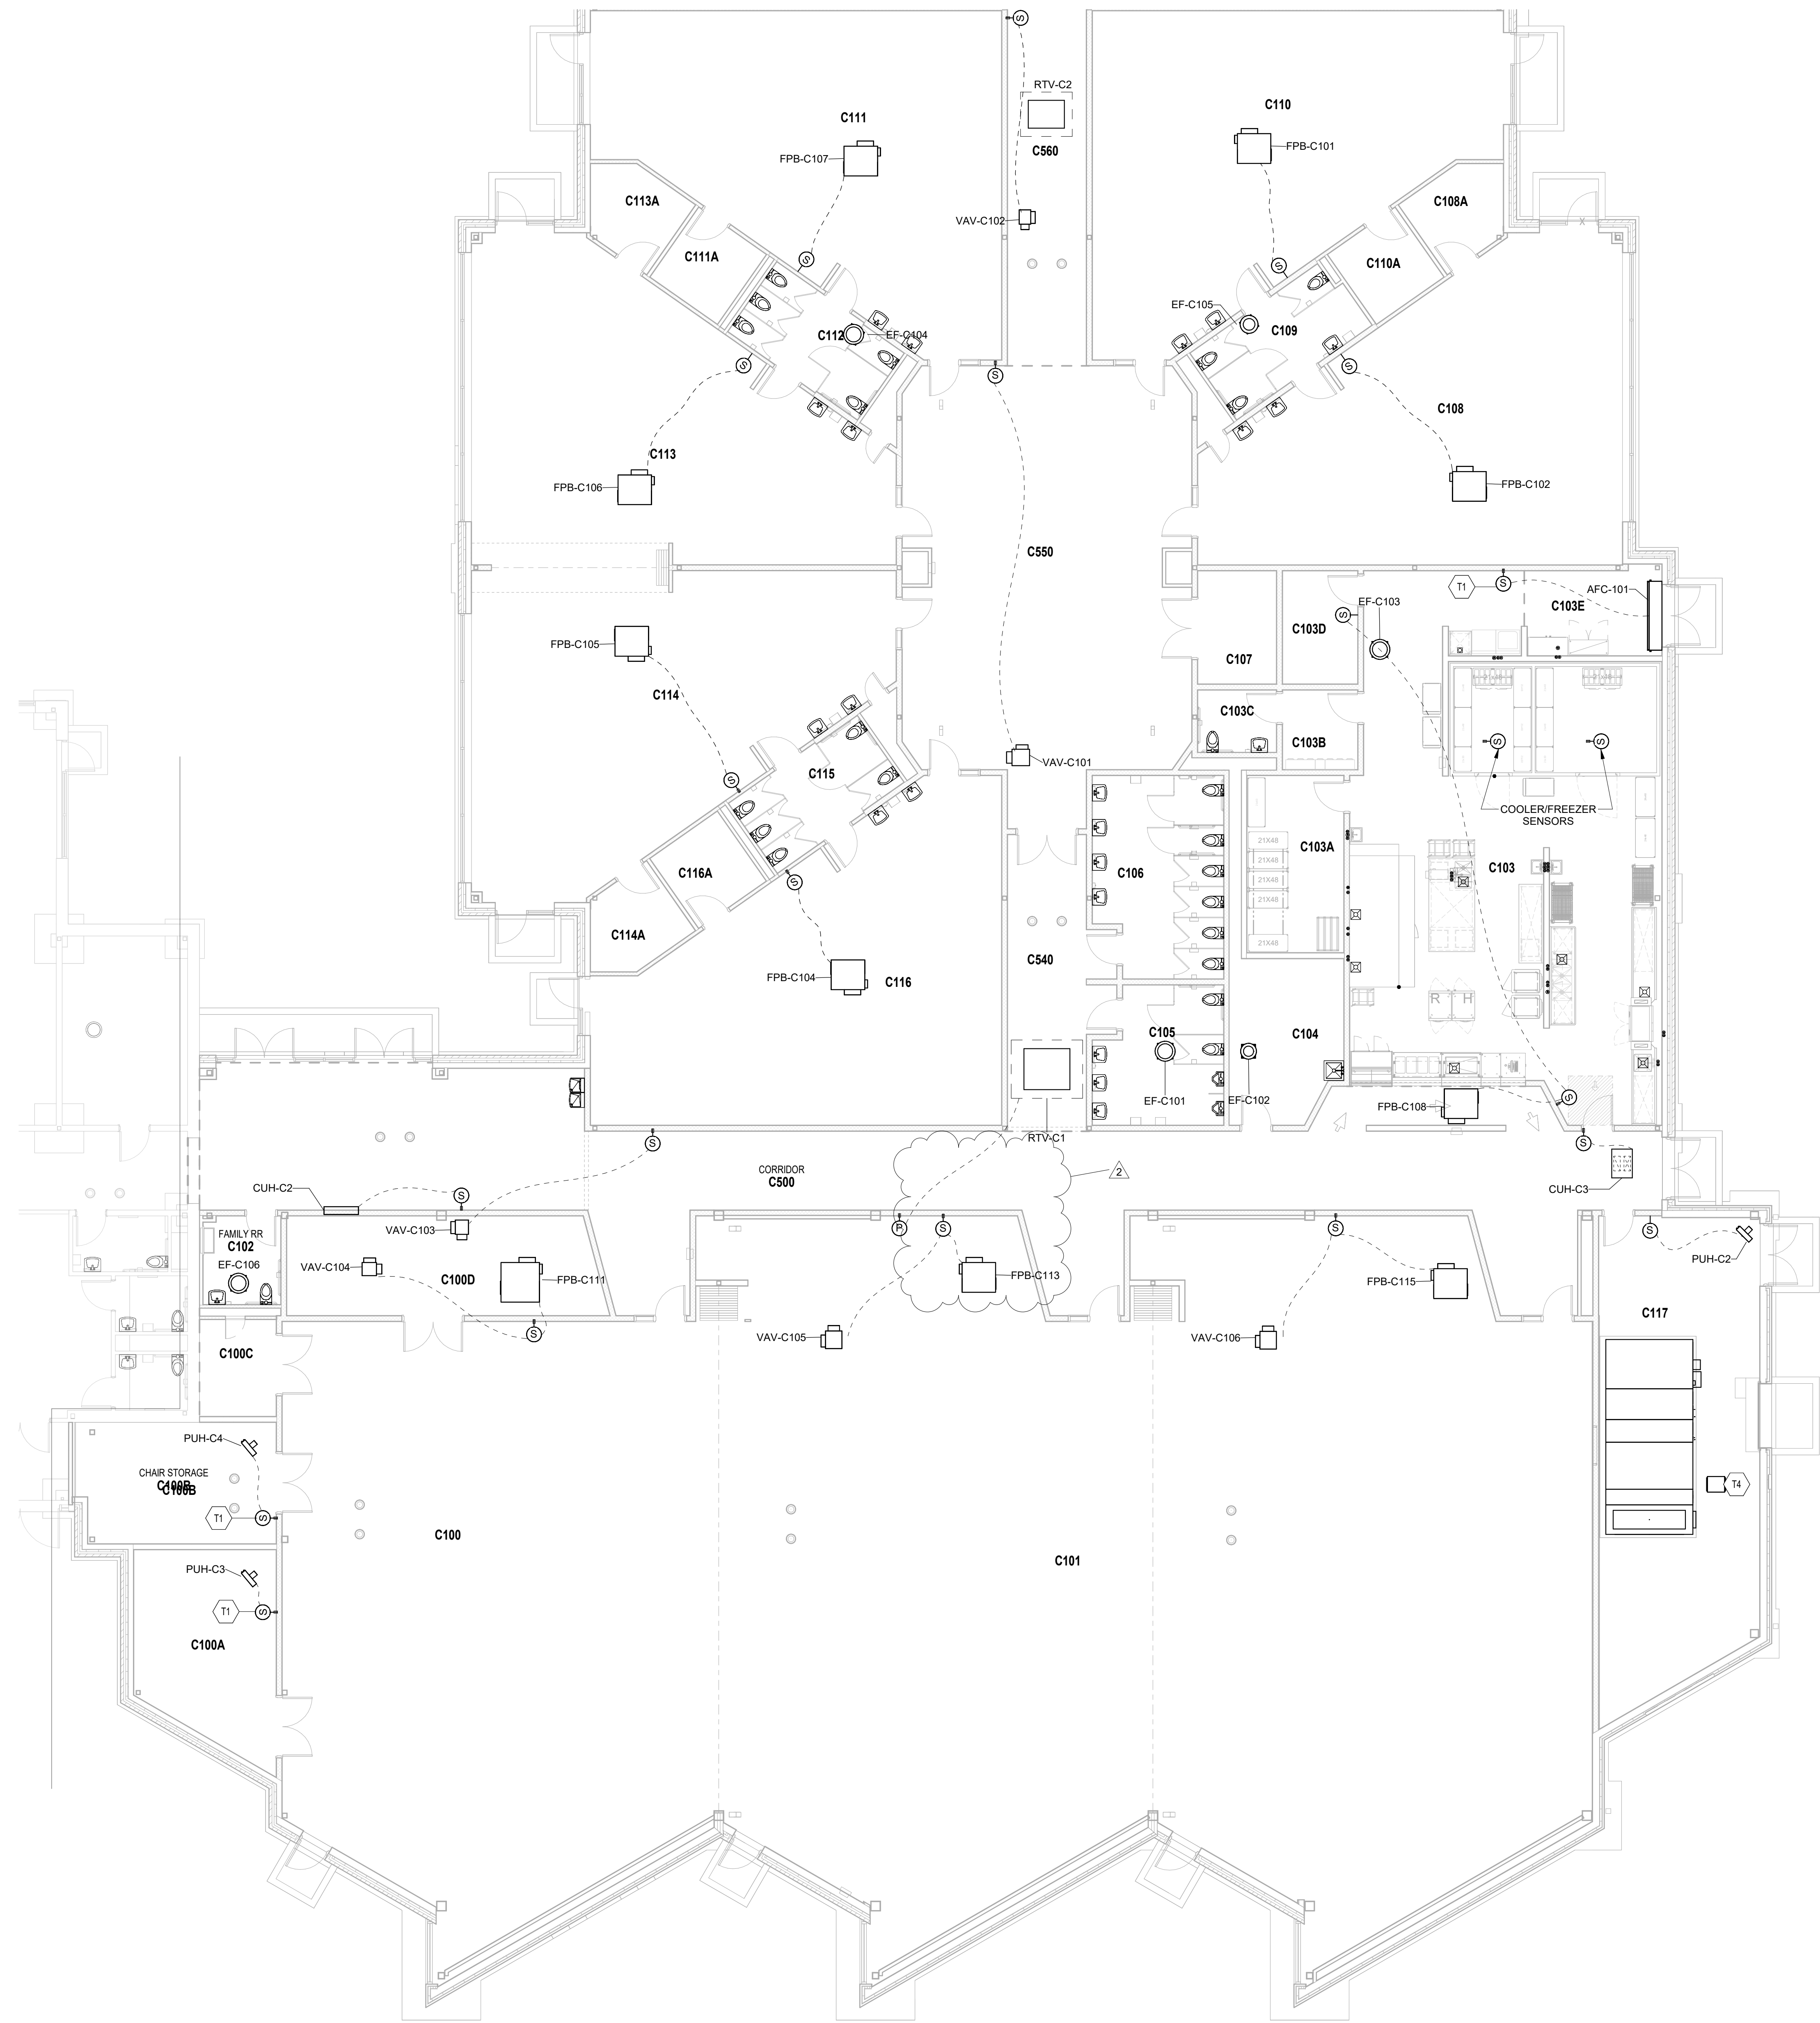

**FIRST FLOOR CONTROLS PLAN - UNIT C**  
SCALE: 1/8" = 1'-0"

**VERIFICATION NOTE**  
CONTRACTOR SHALL VERIFY ALL DIMENSIONS AND CLEARANCES AND ALL EXISTING FIELD CONDITIONS BEFORE STARTING CONSTRUCTION. COMMENCEMENT OF WORK CONSTITUTES ACCEPTANCE OF CONDITIONS.  
SHOULD DIFFERENT CONDITIONS BE ENCOUNTERED, CONTACT THE ARCHITECT BEFORE PROCEEDING WITH WORK.

# NATHANIEL JONES EARLY LEARNING CENTER ADDITION & EXPANSION

7839 NEW AUGUSTA RD.  
INDIANAPOLIS, IN 46268


MSD OF PIKE TOWNSHIP



ARCHITECT

## FANNING HOWEY

317-848-0966 WWW.FHAI.COM  
350 E NEW YORK ST. SUITE 300, INDIANAPOLIS, IN 46204

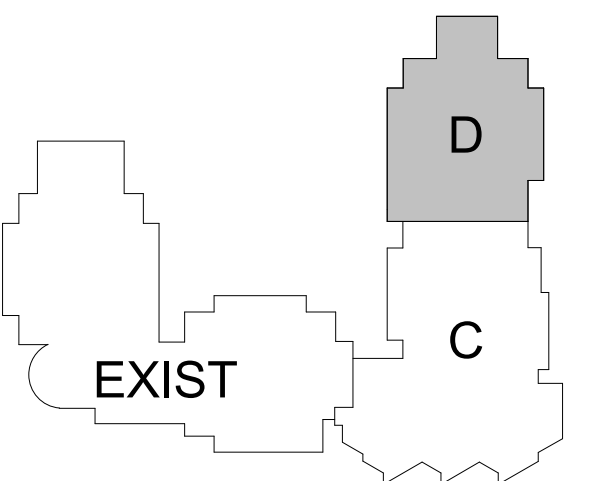

KEY PLAN

BID DOCUMENTS



PROJECT MANAGER: PW  
DRAWN BY: CMS  
PROJECT NUMBER: 223216.00  
PROJECT ISSUE DATE: 03-26-2026

REV. NO.	DESCRIPTION	DATE
1	ADDENDUM #2	03/26/2026
2	ADDENDUM #3	3/30/2026

MECHANICAL ROOM

# M-401

**MECHANICAL ROOM PLAN GENERAL NOTES**

- A. ALL DUCTWORK, PIPING AND VALVES SHALL BE CONCEALED ABOVE THE CEILING AND WITHIN WALLS, UNLESS OTHERWISE NOTED.
- B. REFER TO THE SPECIFICATIONS FOR REQUIREMENTS RELATED TO EQUIPMENT QUALITY, CONSTRUCTION AND FINISH OF MATERIALS.
- C. ARRANGE DUCTWORK, PIPING, ETC. TO ALLOW FOR EASY ACCESS TO COOLS, VALVES, DAMPERS AND CONTROLS. KEEP AREAS ADJACENT TO ACCESS PANELS FREE AND CLEAR OF ANY OBSTRUCTIONS.
- D. SEAL DUCT PENETRATIONS THROUGH THE FLOOR AND/OR WALLS IN ACCORDANCE WITH MECHANICAL CODE AND SMACNA REQUIREMENTS. SEAL DUCT PENETRATIONS THROUGH FIRE RATED FLOORS AND/OR WALLS WITH A MATERIAL HAVING SAME FIRE RATING AS THE WALL AND/OR FLOOR.
- E. MECHANICAL CONTRACTOR IS RESPONSIBLE FOR HIS RESPECTIVE WORK FOR REPAIRING AND PATCHING TO MATCH EXISTING SURFACES, SIDEWALKS, STREETS, FLOORS, WALLS, ROOFS, CEILING AND PAVEMENT.
- F. ALL RECTANGULAR SHEET METAL DUCT SIZES SHOWN ARE INSIDE FREE AREA DIMENSIONS. ALL ROUND DUCT SIZES SHOWN ARE INSIDE DIAMETERS.
- G. PROVIDE BALANCING DAMPER AT EACH DUCT BRANCH, SERVING DIFFUSER, GRILLE AND REGISTER.
- H. INSTALL WALL THERMOSTATS, TEMPERATURE SENSORS, HUMIDISTATS, ETC. 44" FROM BOTTOM OF DEVICE ABOVE THE FINISH FLOOR IN ACCORDANCE WITH ADA REQUIREMENTS.
- I. COORDINATE ALL REQUIRED WALL, ROOF AND FLOOR OPENINGS (BOTH DIMENSIONS AND LOCATIONS) WITH ALL OTHER TRADES.
- J. COORDINATE MECHANICAL SYSTEM INSTALLATION WITH STRUCTURE, FIRE PROTECTION AND LIGHTING LAYOUT.
- K. PROVIDE ALL NECESSARY TRANSITIONS TO EQUIPMENT FROM SIZES SHOWN ON PLAN.
- L. HYDRONIC SUPPLY AND RETURN PIPING SHALL BE THE SAME SIZE UNLESS OTHERWISE NOTED.
- M. ALL RETURN/EXHAUST AIR DUCT ABOVE LOCKERS/SHOWER AREAS SHALL BE MADE OF ALUMINUM IN ACCORDANCE WITH SMACNA REQUIREMENTS.
- N. UNLESS OTHERWISE INDICATED, ALL ABOVE CEILING SPACES SHALL BE CONSIDERED PART OF THE RETURN PLENUM. THEREFORE ALL PIPE, DUCT, CONTROL DEVICES, WIRING, AND EQUIPMENT SHALL BE RATED AND ACCEPTABLE FOR INSTALLATION IN THE PLENUM SPACE.

**MECHANICAL ROOM PLAN NOTES**

(ALL NOTES MAY NOT BE INDICATED ON THIS SHEET)


**NO. DESCRIPTION**

- M1. INSTALL EQUIPMENT ON 3'-10" HIGH CONCRETE HOUSEKEEPING PAD. COORDINATE SIZE OF HOUSEKEEPING PAD WITH EQUIPMENT TO BE PROVIDED.
- M5. TRANSITION DUCTWORK AS REQUIRED TO MAKE FINAL CONNECTION TO AIR HANDLING UNIT.
- M6. MECHANICAL CONTRACTOR SHALL INSTALL AN ACCESS DOOR IN DUCTWORK TO ACCESS THE AIRFLOW MEASURING STATION. INSTALL GASKETING AROUND THE DOOR FOR AIR-TIGHT INSTALLATION. PROVIDE CONTINUOUS HINGE REINFORCE DUCTWORK AS REQUIRED.
- M7. OUTSIDE AIR CONTROL DAMPERS FACTORY MOUNTED IN AIR HANDLING UNIT. DAMPER OPERATORS PROVIDED AND INSTALLED BY TEMPERATURE CONTROL CONTRACTOR.
- M8. RETURN AIR CONTROL DAMPERS FACTORY MOUNTED IN AIR HANDLING UNIT. DAMPER OPERATORS PROVIDED AND INSTALLED BY TEMPERATURE CONTROL CONTRACTOR.
- M12. CLEARANCE REQUIRED FOR AIR HANDLING UNIT COIL AND HEAT WHEEL FULLS.
- M13. FLOW SWITCH PROVIDED BY TEMPERATURE CONTROL CONTRACTOR AND INSTALLED BY MECHANICAL CONTRACTOR. WIRING AND TERMINATIONS BY TEMPERATURE CONTROL CONTRACTOR.
- M15. AL-28-4C FLUE PIPE SYSTEM FROM THE BOILER CONNECTION ROUTED UP AND TERMINATED THROUGH THE ROOF. FLUE PIPE SIZE AND INSTALLATION PER MANUFACTURERS REQUIREMENTS.
- M16. SINGLE WALL STAINLESS STEEL INTAKE PIPE FROM THE BOILER CONNECTION TERMINATED THROUGH THE ROOF. INTAKE PIPE SIZE AND INSTALLATION PER MANUFACTURERS REQUIREMENTS.
- M17. PRESSURE RELIEF VALVE. REFER TO BOILER MANUFACTURER FOR RECOMMENDED LOCATION. PIPE FULL SIZE TO FLOOR DRAIN. SUPPORT PIPING INDEPENDENTLY OF VALVE TO PREVENT STRESS AND TO ALLOW PROPER OPERATION.
- M18. CONDENSATE DRAIN WITH TRAP PIPED FROM BOILER TO FLOOR DRAIN FULL SIZE. EACH BOILER TO BE PROVIDED WITH INDEPENDENT ACID NEUTRALIZATION BASIN. REFER TO DETAIL.
- M19. APPROXIMATE LOCATION OF AIR HANDLING UNIT CONTROL PANEL. COORDINATE EXACT LOCATION WITH ALL TRADES.
- M20. APPROXIMATE LOCATION OF BOILER AND CHILLER CONTROL PANELS. COORDINATE EXACT LOCATION WITH ALL TRADES.
- M22. INSTALL EQUIPMENT ON 6" HIGH CONCRETE HOUSEKEEPING PAD.
- M24. MECHANICAL EQUIPMENT TO BE INSULATED PER 23 07 00.
- M25. END OF DUCT OPEN TO PLENUM SPACE ABOVE CEILING. OPENING TO BE PROTECTED WITH BIRDSCREEN.
- P14. ALL REFRIGERANT PIPING ON THE EXTERIOR OF THE BUILDING SHALL BE WRAPPED WITH INSULATION AND THEN COVERED WITH A PVC JACKET PER THE PROJECT MANUAL. PIPING IS SIZED PER MANUFACTURER RECOMMENDATIONS. PROVIDE PIPE SUPPORTS PER MANUFACTURERS RECOMMENDATIONS.
- V9. INSTALL DRIP PAN UNDER WALL LOUVER. PAN SHALL BE SEALED WATER TIGHT. DRIP PAN TO EXTEND A MINIMUM OF 6" BEYOND DUCTWORK.


**VERIFICATION NOTE**

CONTRACTOR SHALL VERIFY ALL DIMENSIONS AND CLEARANCES AND ALL EXISTING FIELD CONDITIONS BEFORE STARTING CONSTRUCTION. COMMENCEMENT OF WORK CONSTITUTES ACCEPTANCE OF CONDITIONS.

SHOULD DIFFERENT CONDITIONS BE ENCOUNTERED, CONTACT THE ARCHITECT BEFORE PROCEEDING WITH WORK.

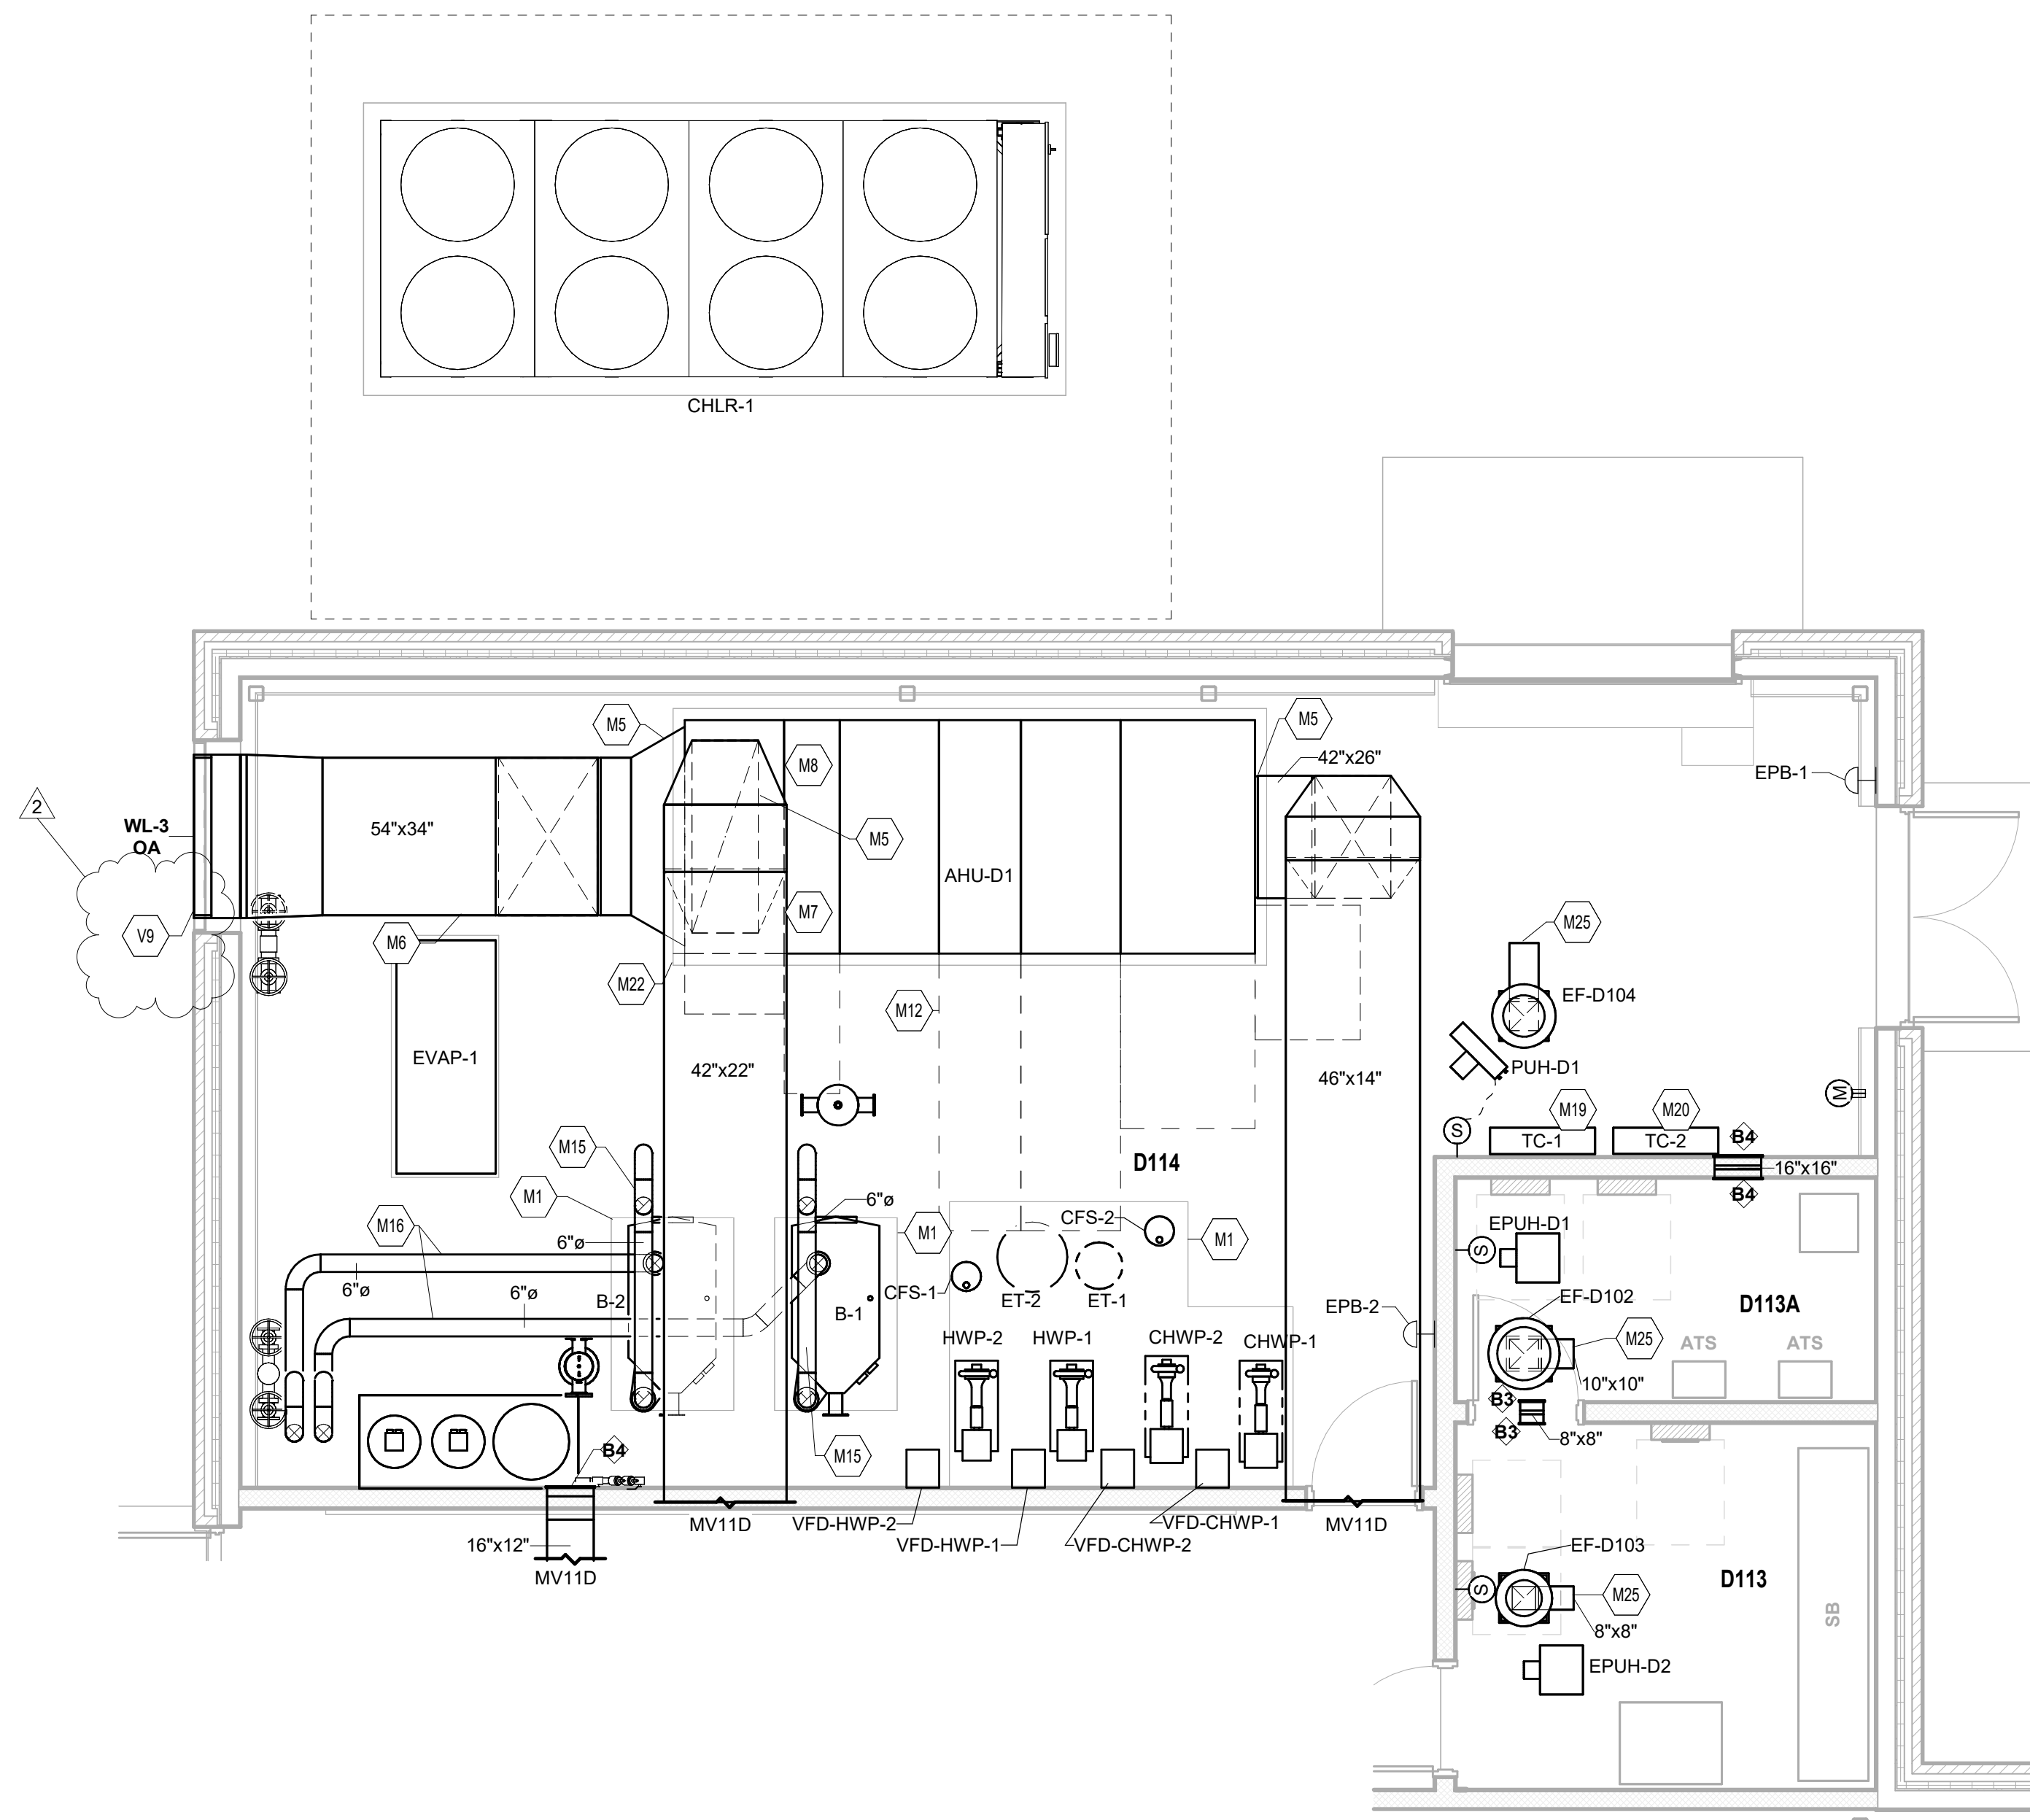

**2 ENLARGED EAST MECHANICAL ROOM A VENTILATION PLAN**  
SCALE: 1/4" = 1'-0"  
NOTE: SOME ELEMENTS HIDDEN FOR CLARITY

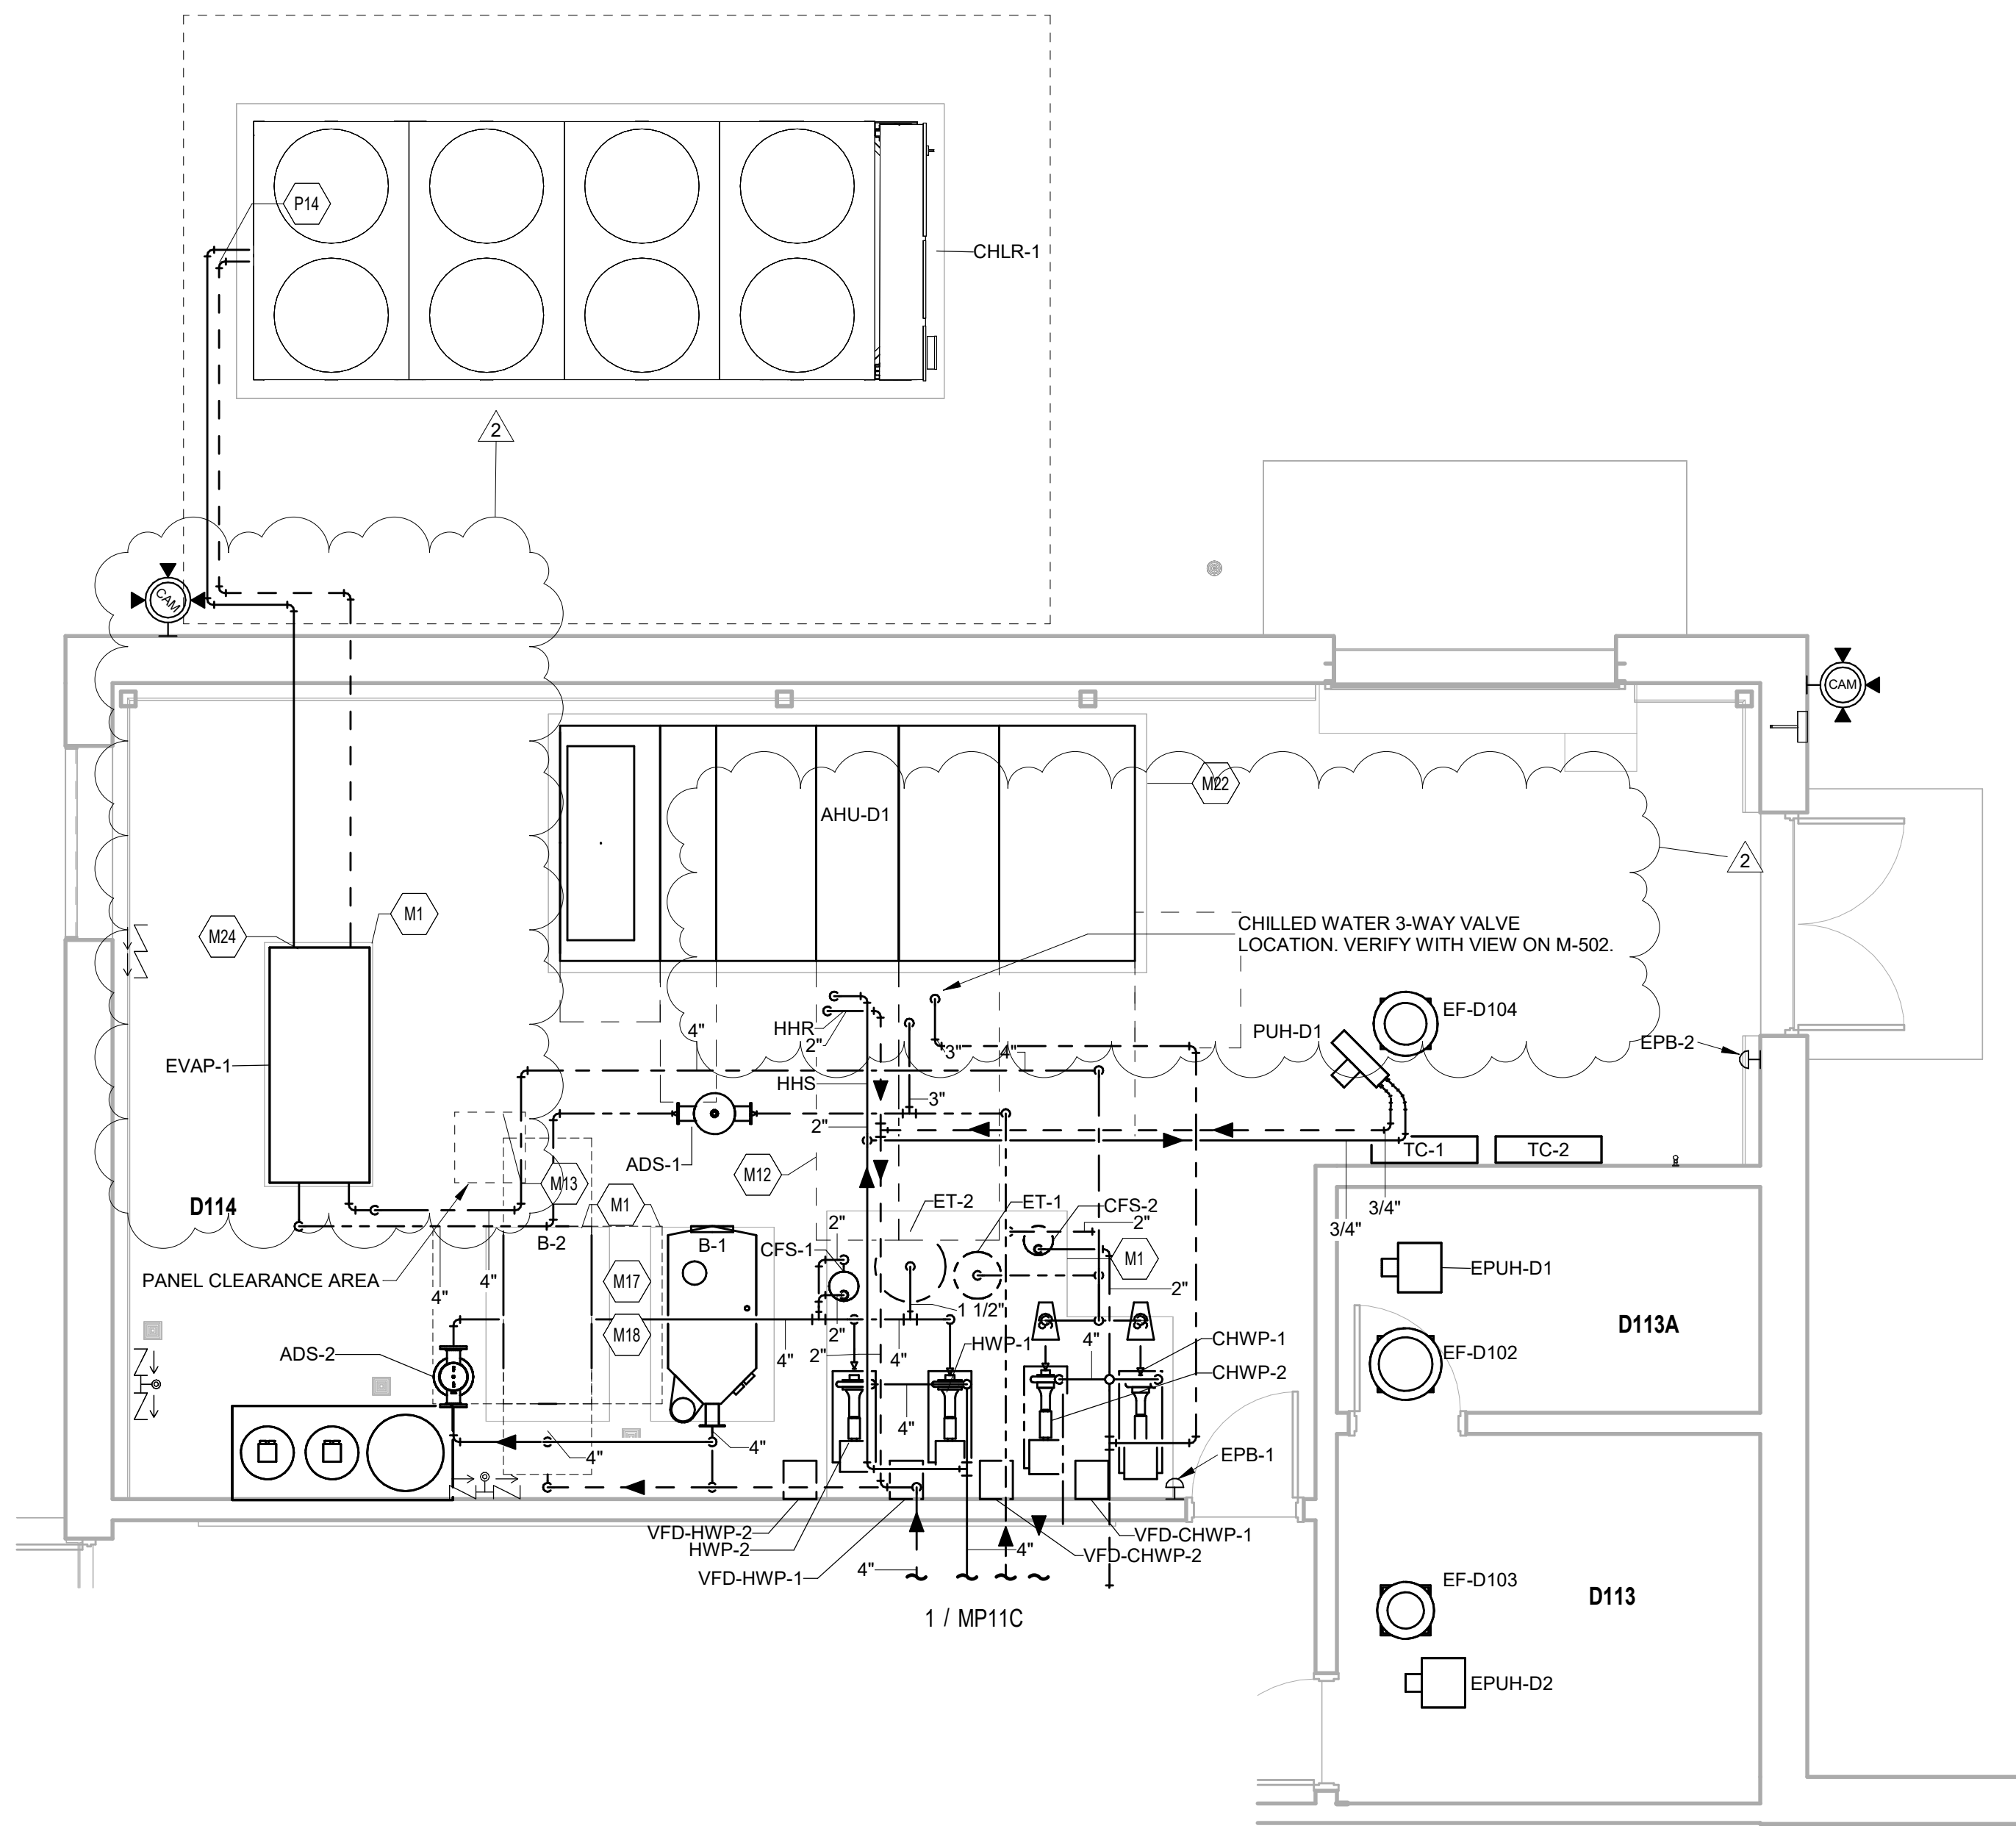


**1 ENLARGED EAST MECHANICAL ROOM PIPING PLAN**  
SCALE: 1/4" = 1'-0"  
NOTE: SOME ELEMENTS HIDDEN FOR CLARITY



# NATHANIEL JONES EARLY LEARNING CENTER ADDITION & EXPANSION

7839 NEW AUGUSTA RD.  
INDIANAPOLIS, IN 46268


MSD OF PIKE TOWNSHIP

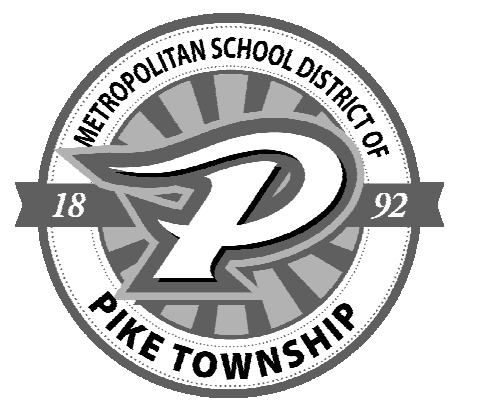

ARCHITECT


# FANNING HOWEY

317-848-0966 WWW.FHAI.COM  
390 E NEW YORK ST. SUITE 300, INDIANAPOLIS, IN 46204

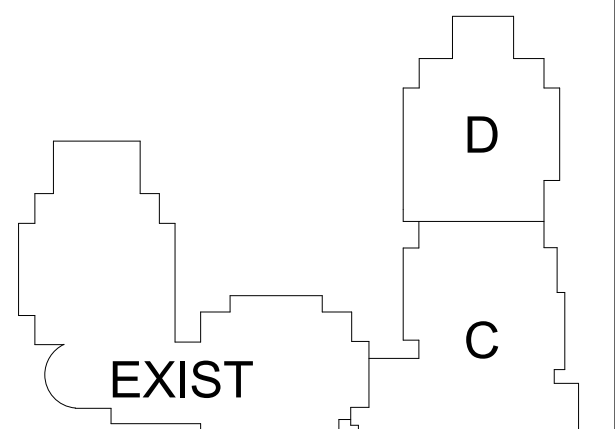

KEY PLAN

BID DOCUMENTS



















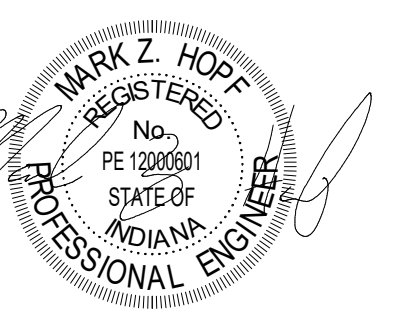


PROJECT MANAGER: PW  
DRAWN BY: CMS  
PROJECT NUMBER: 232216.00  
PROJECT ISSUE DATE: 03-26-2026

REV. NO.	DESCRIPTION	DATE
1	ADDENDUM #2	03/26/2026
2	ADDENDUM #3	3/30/2026

MECHANICAL DETAILS

# M-502

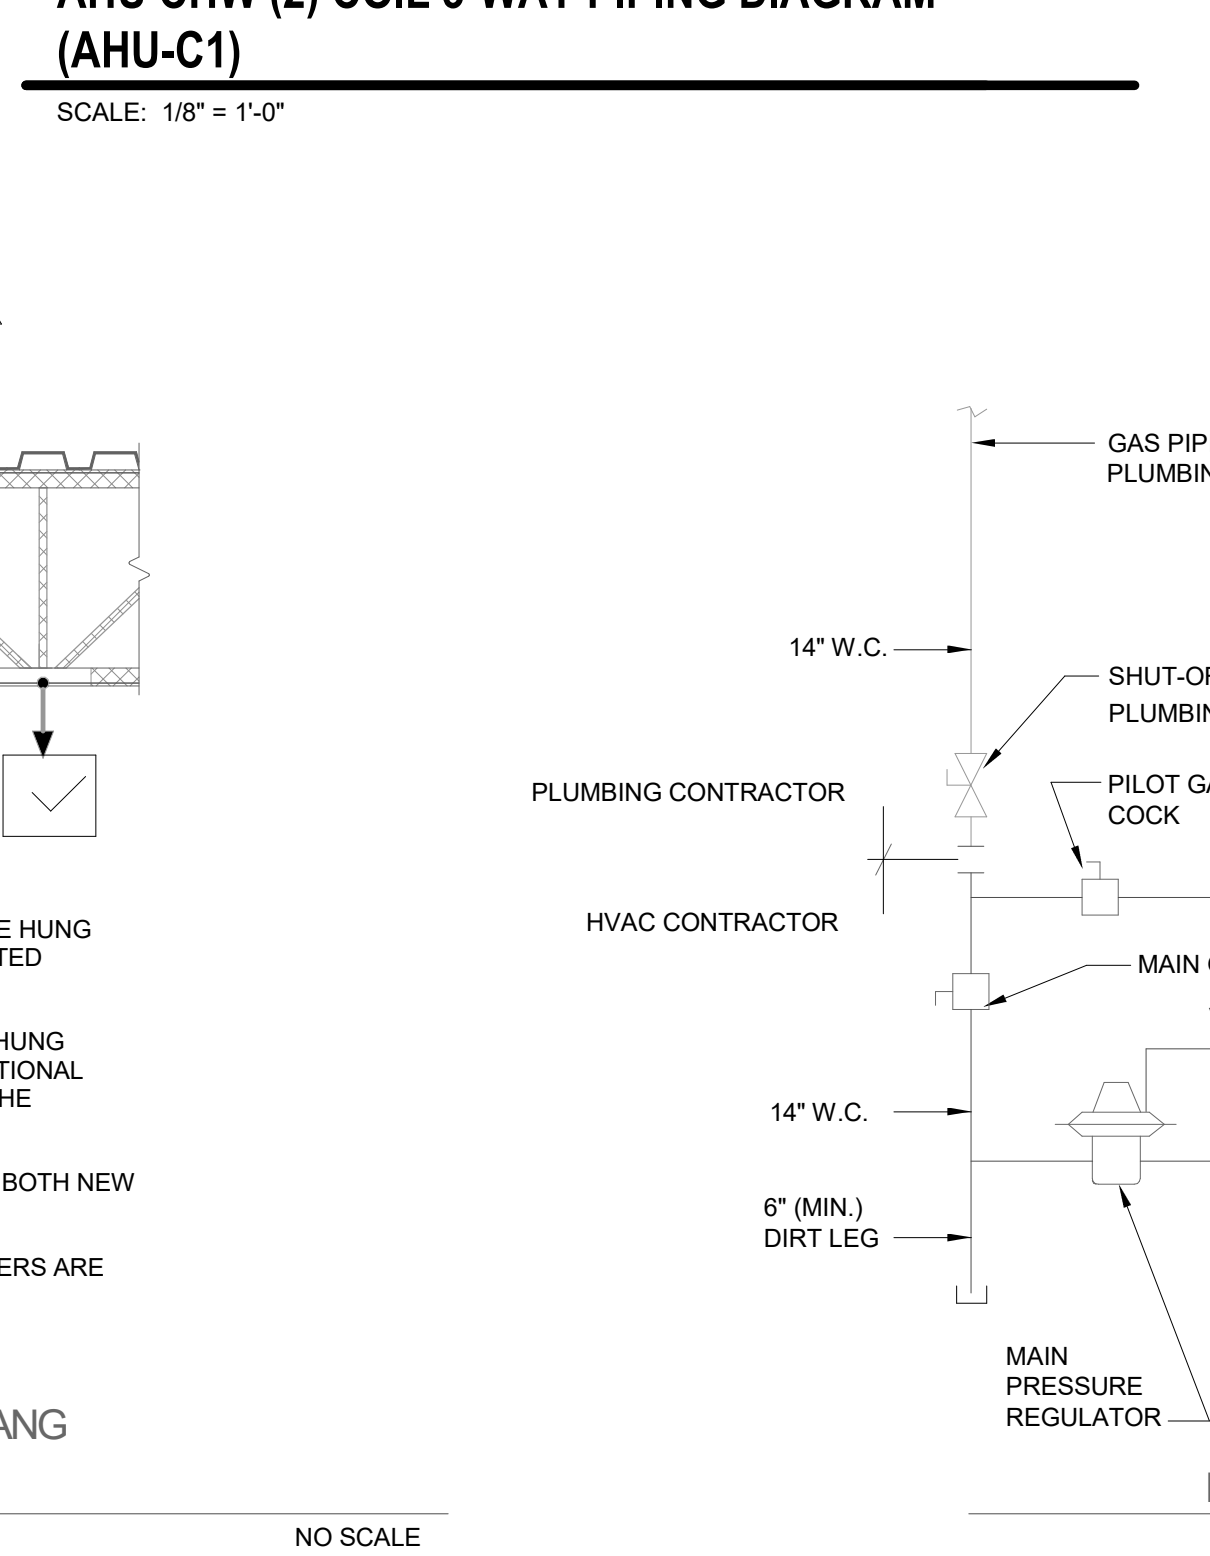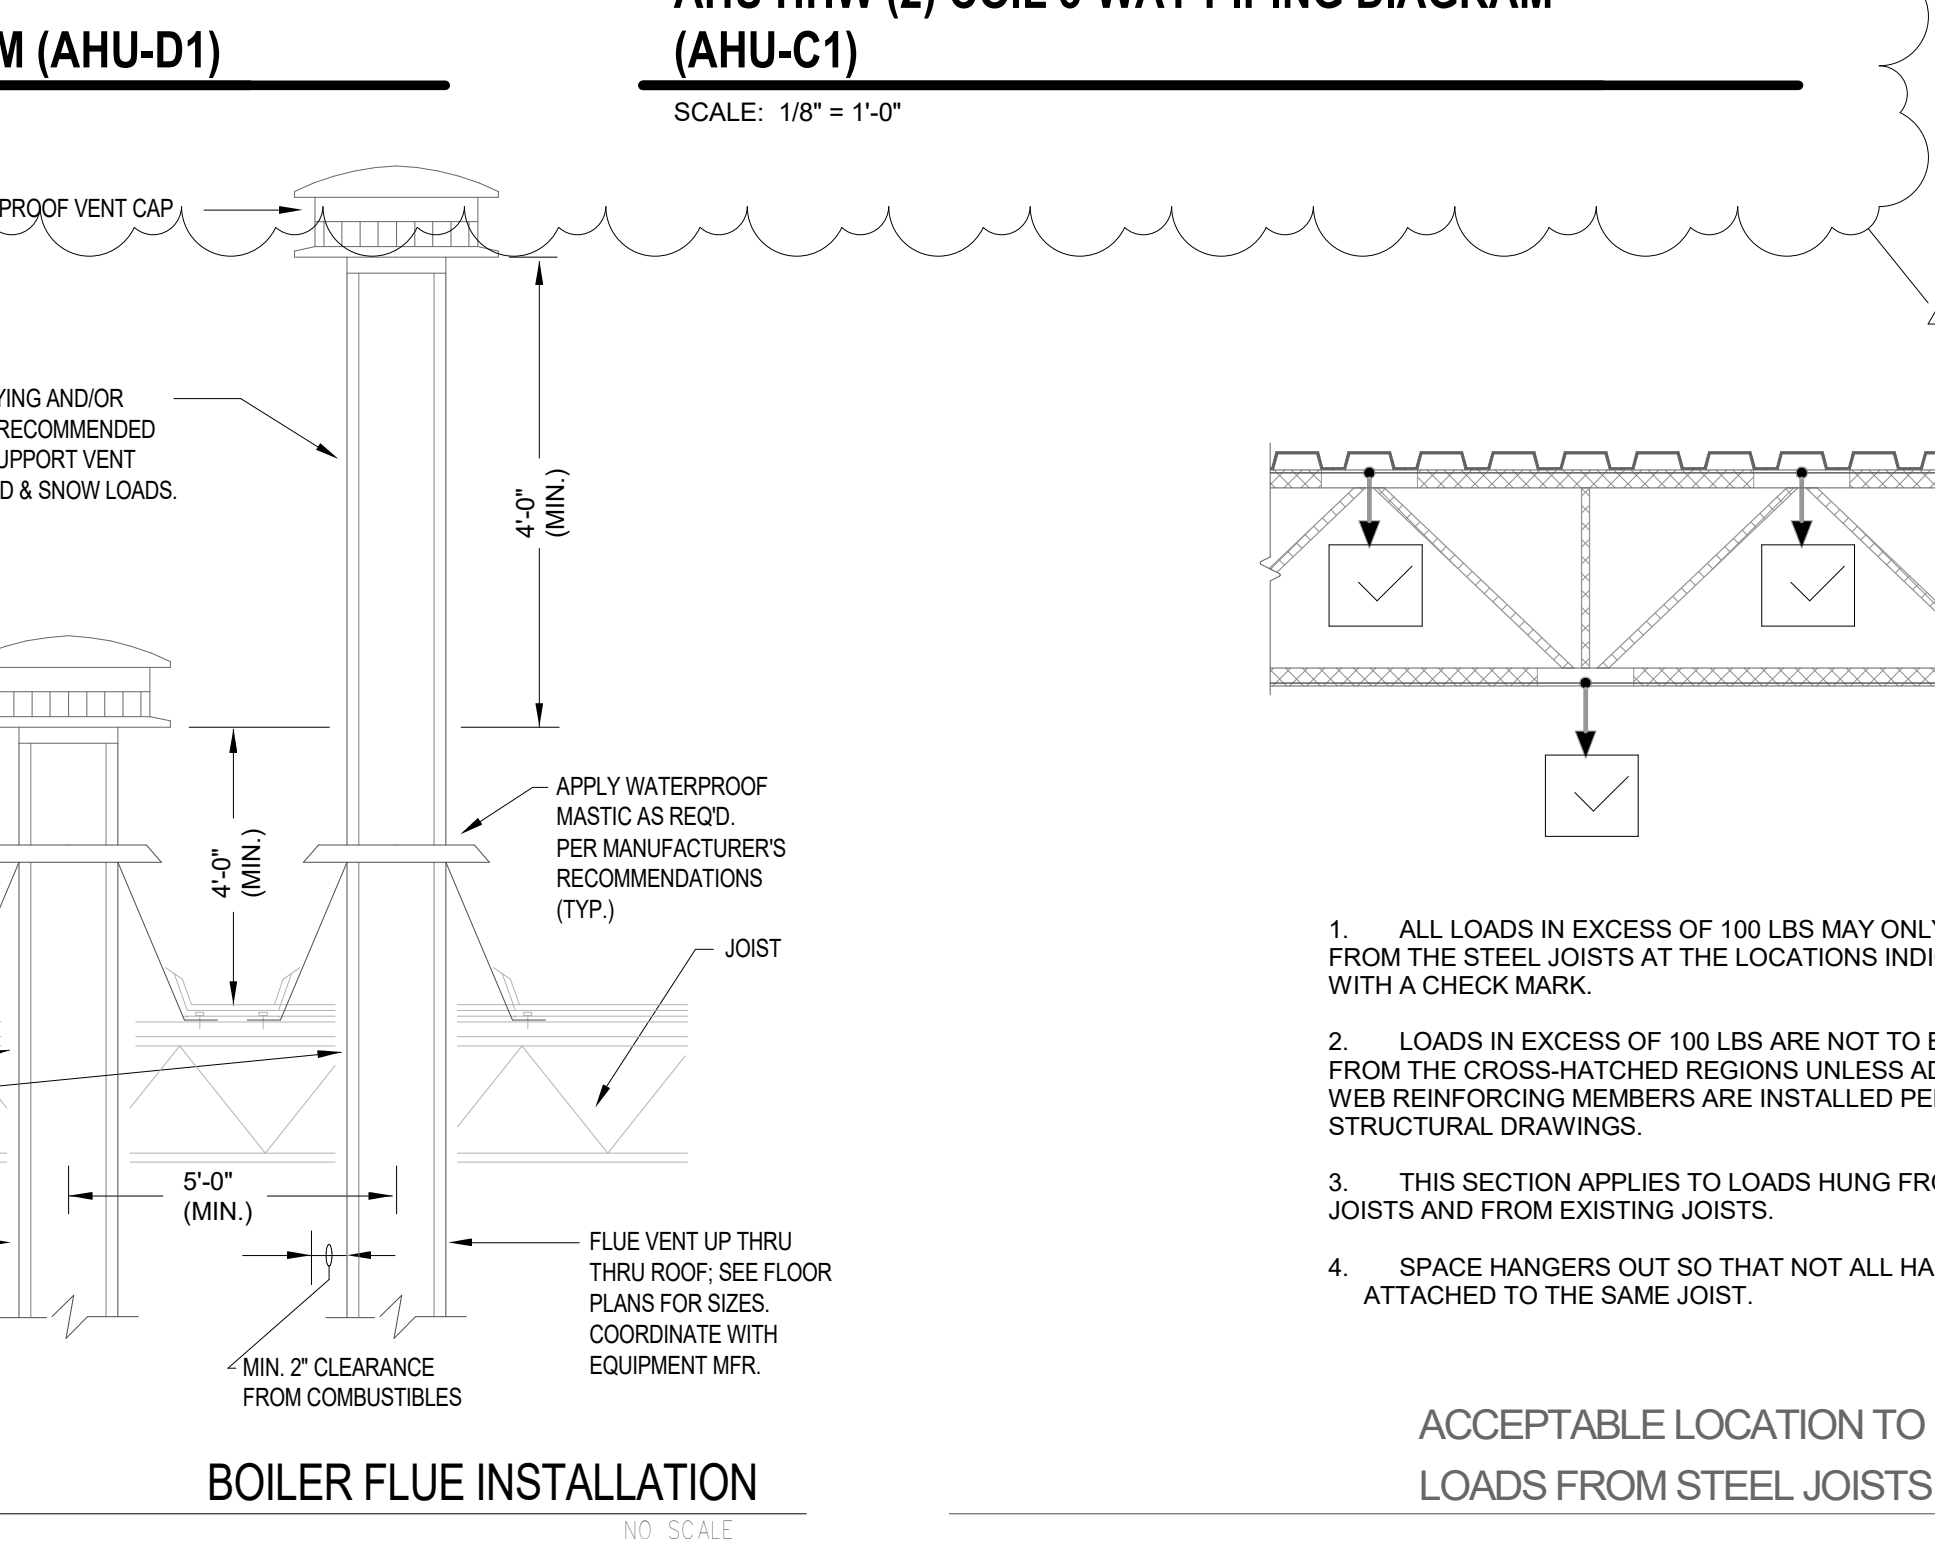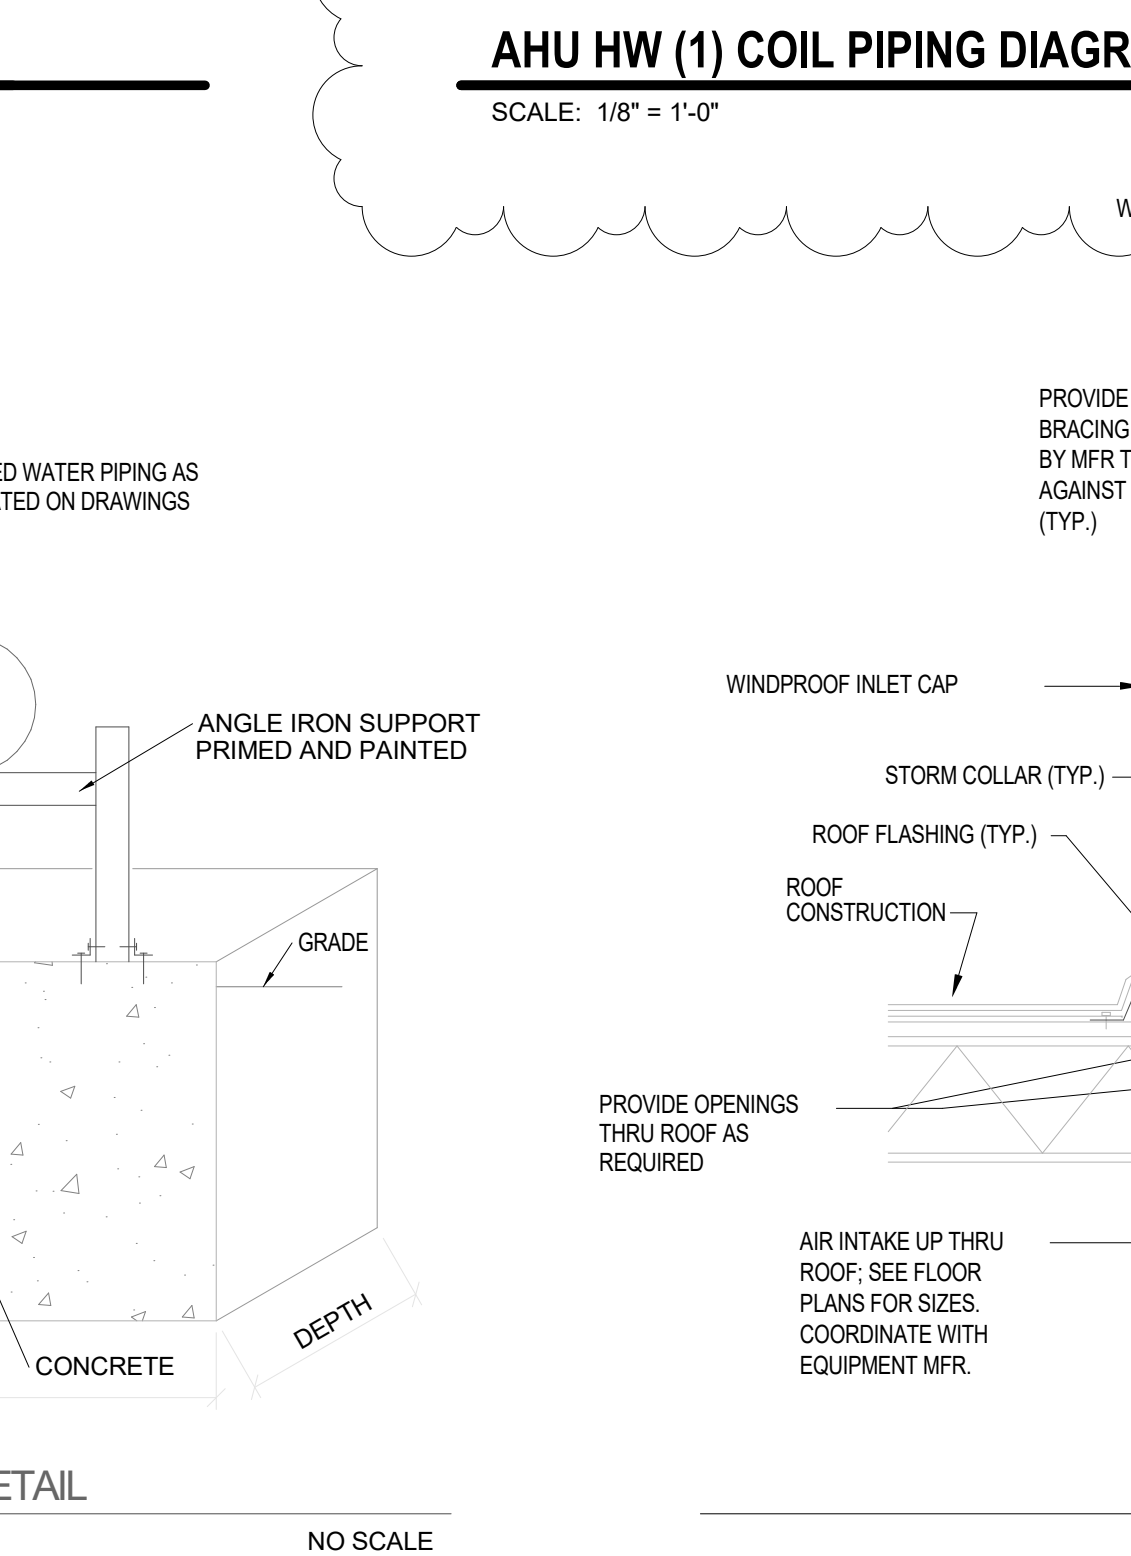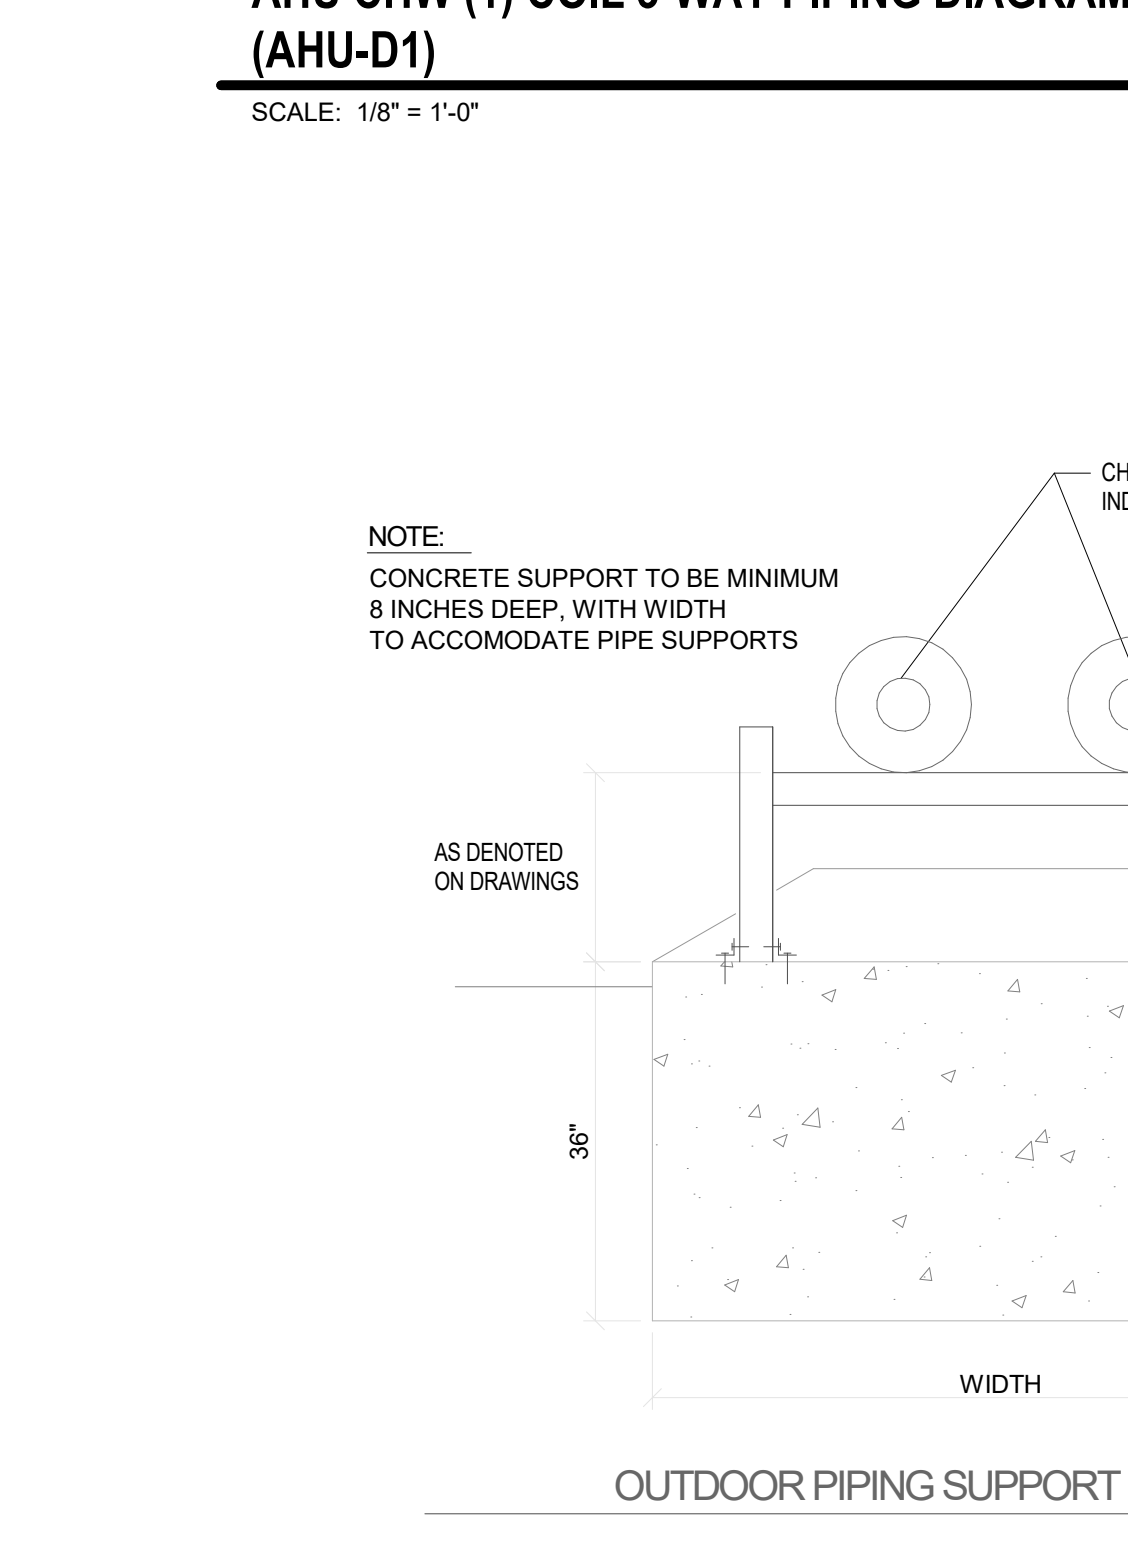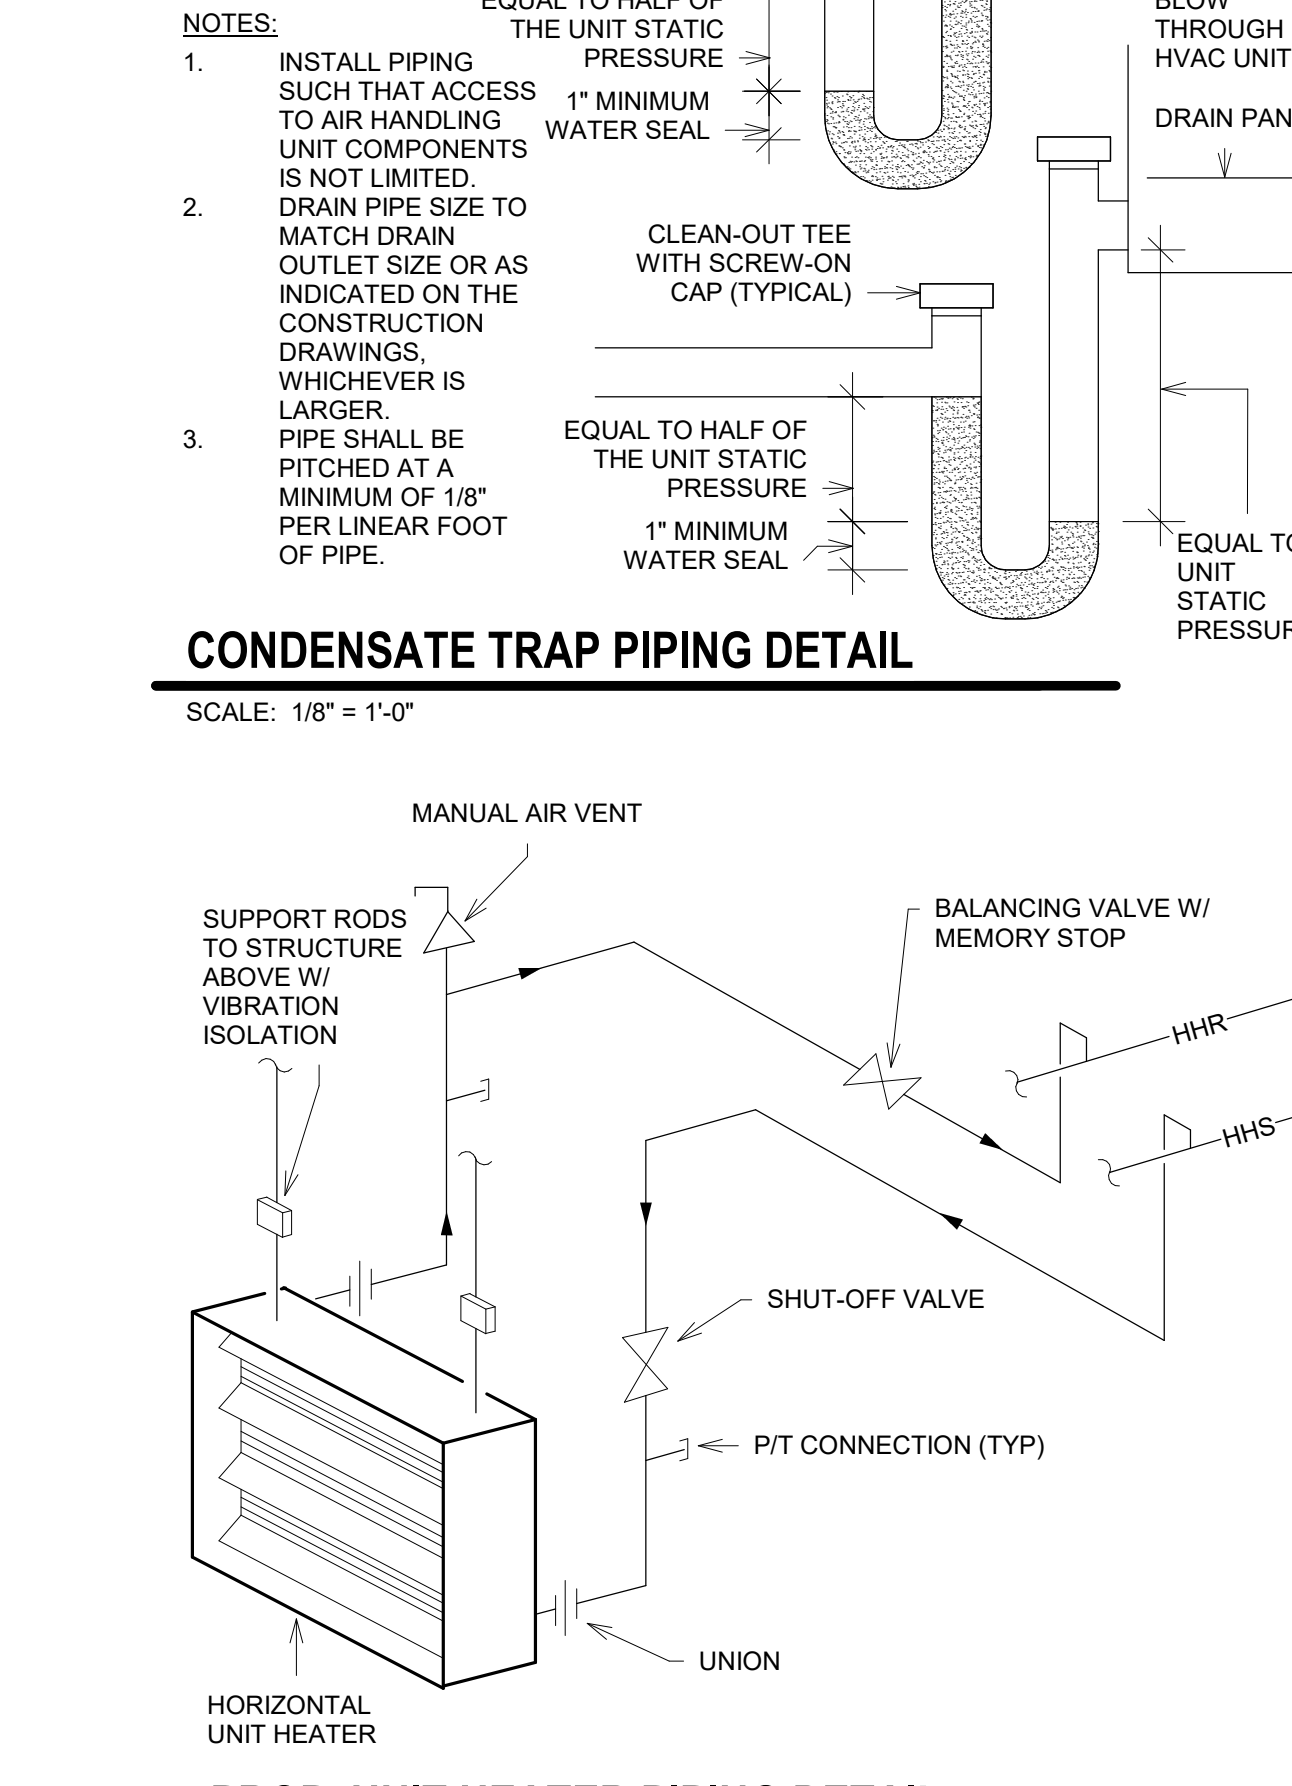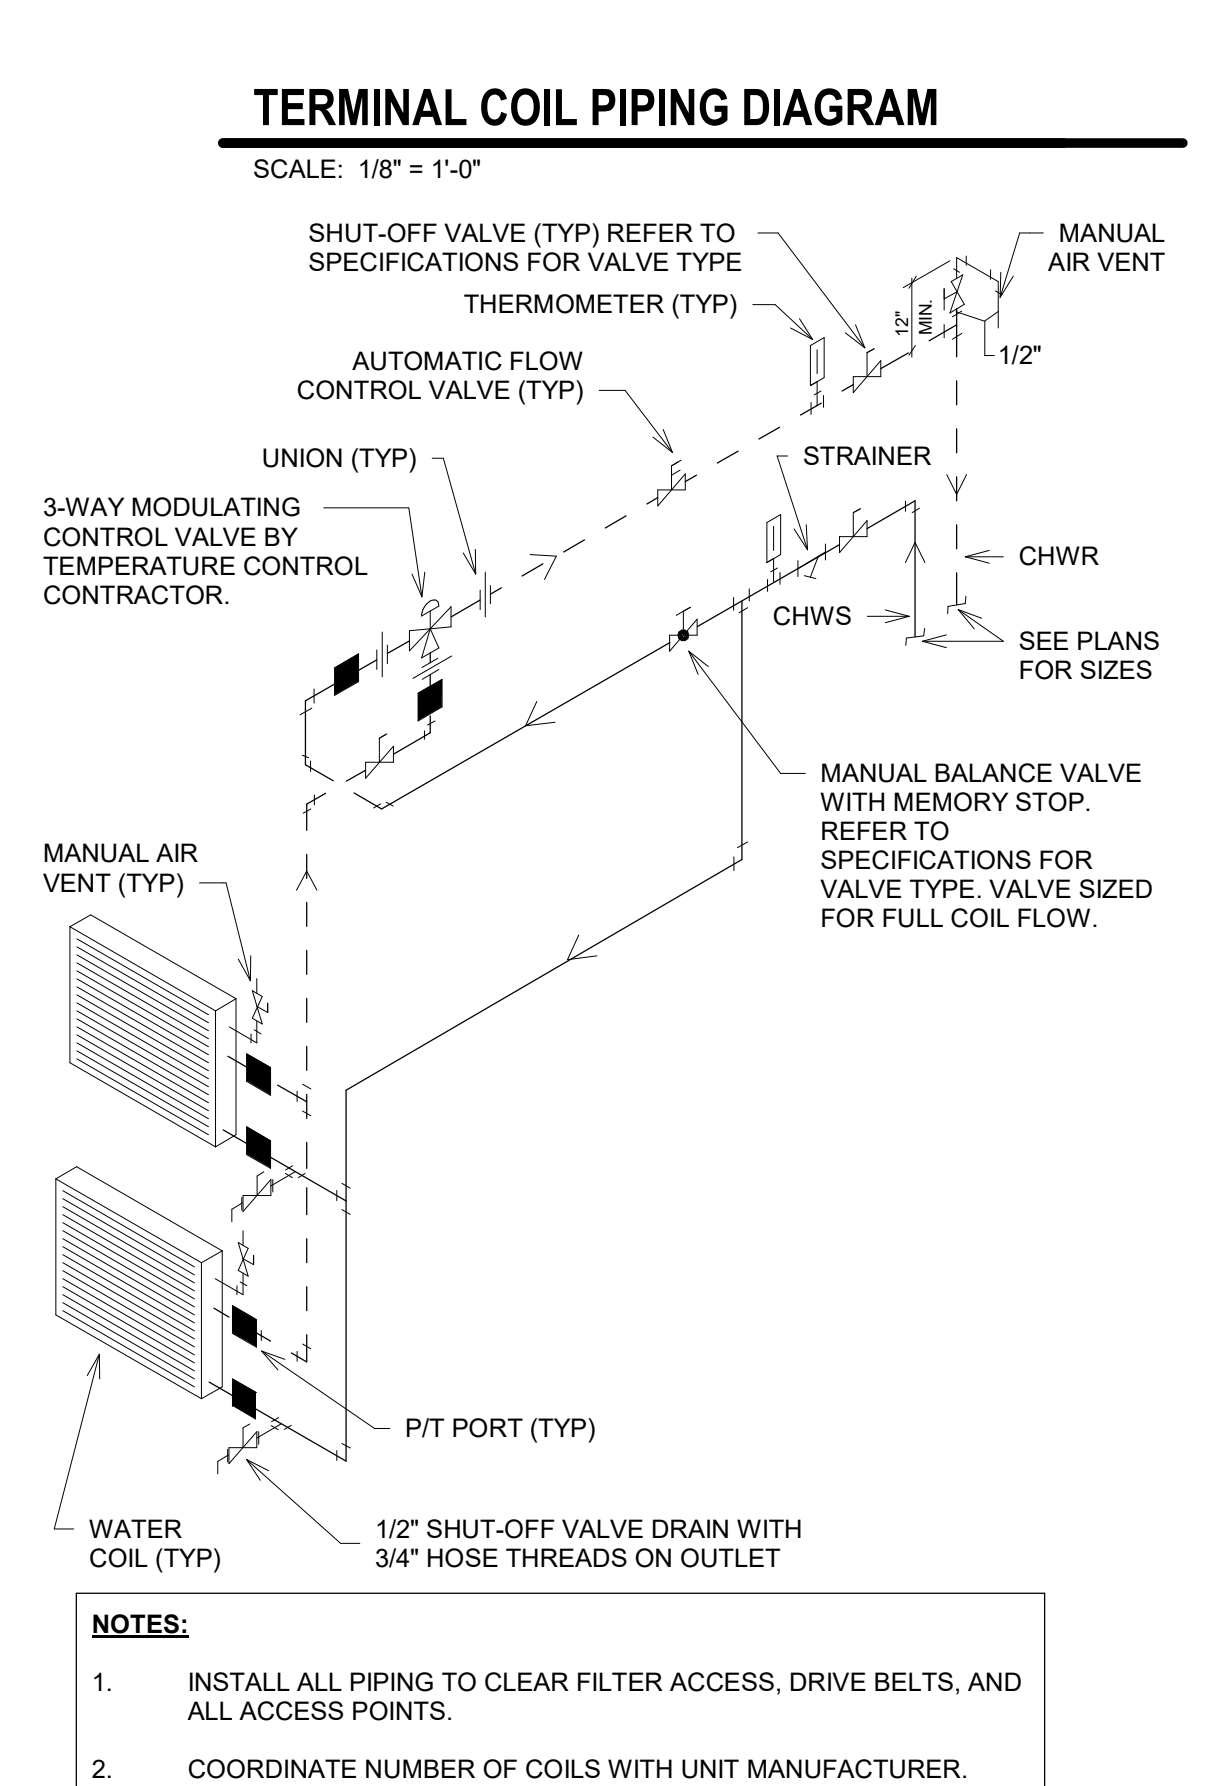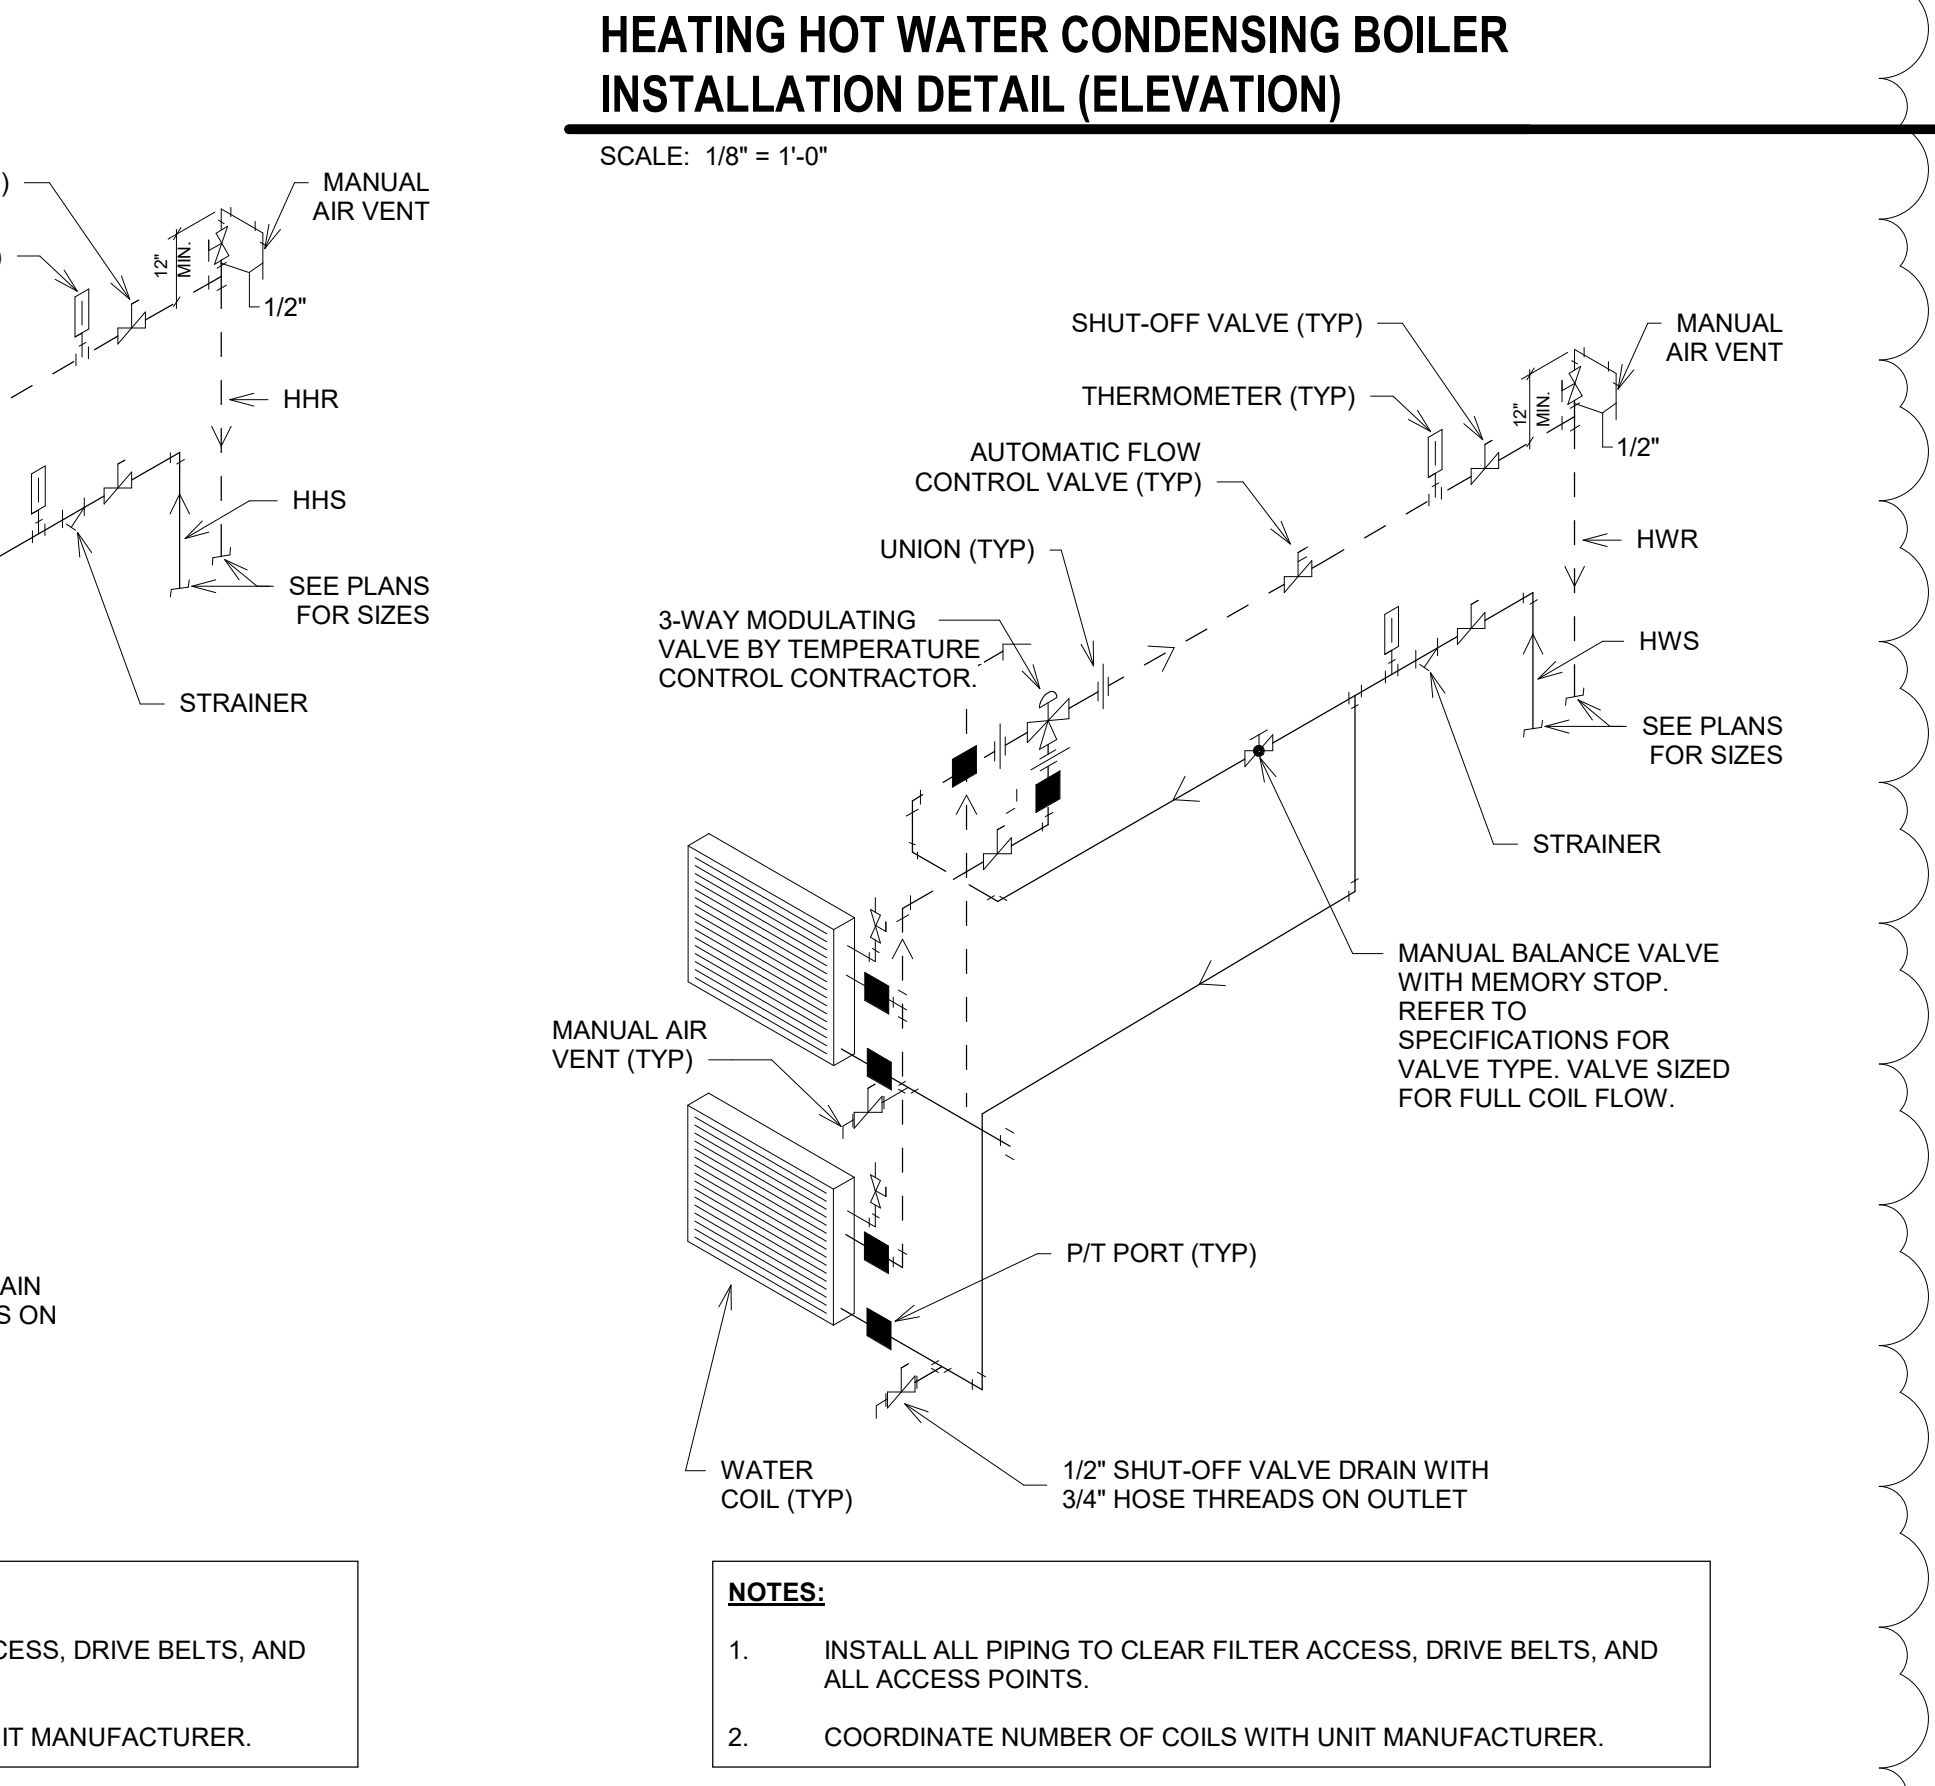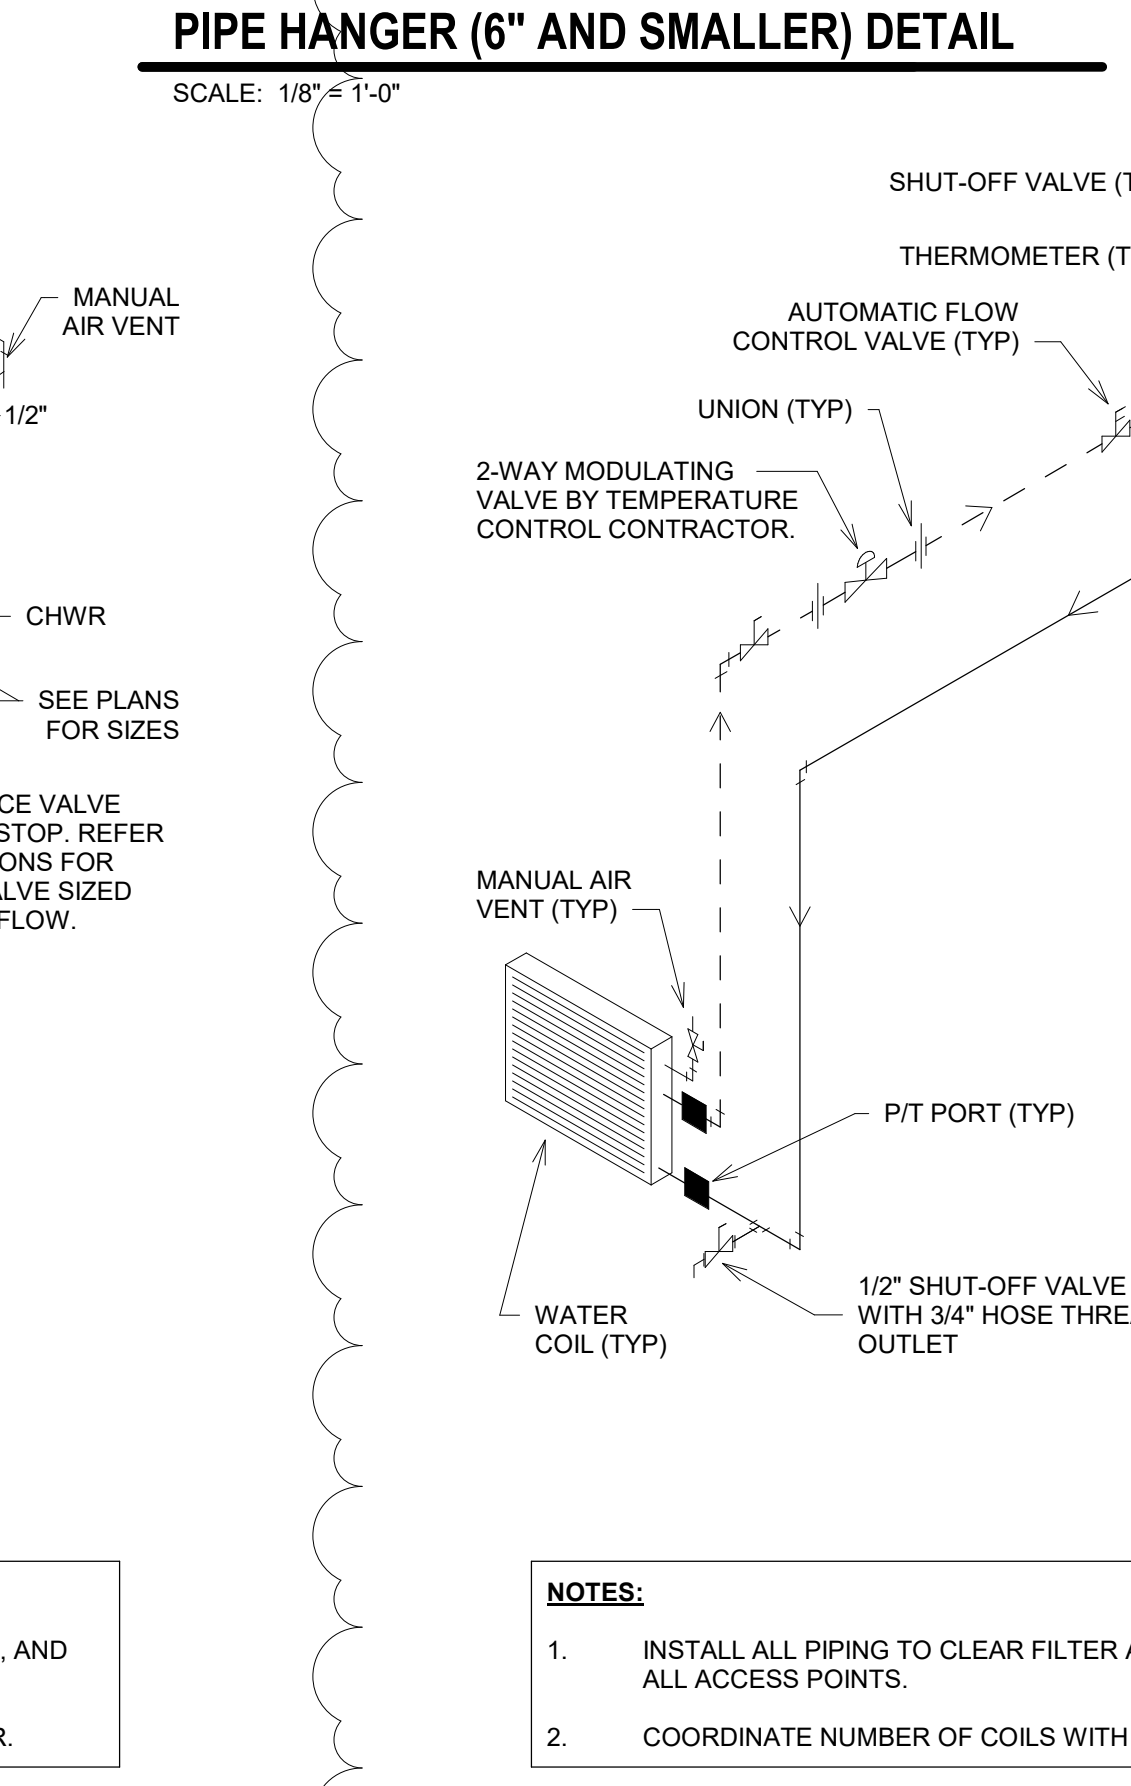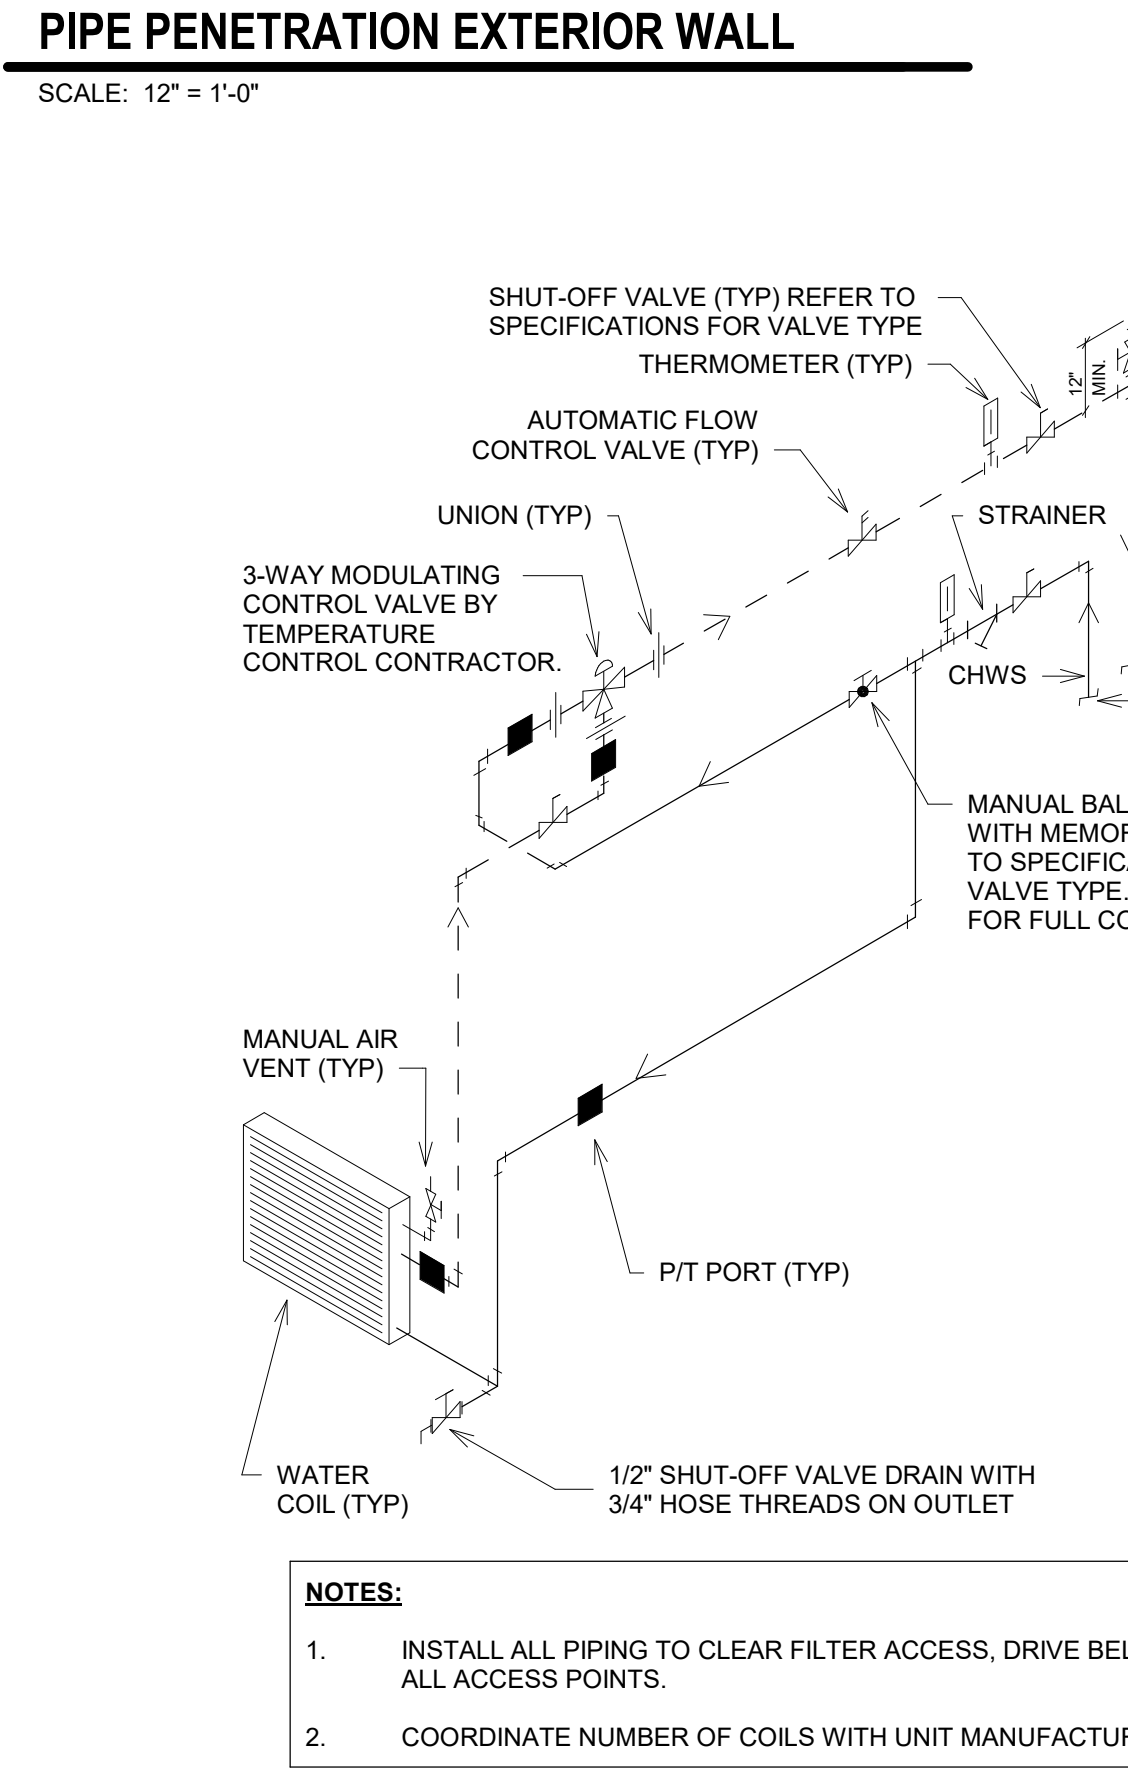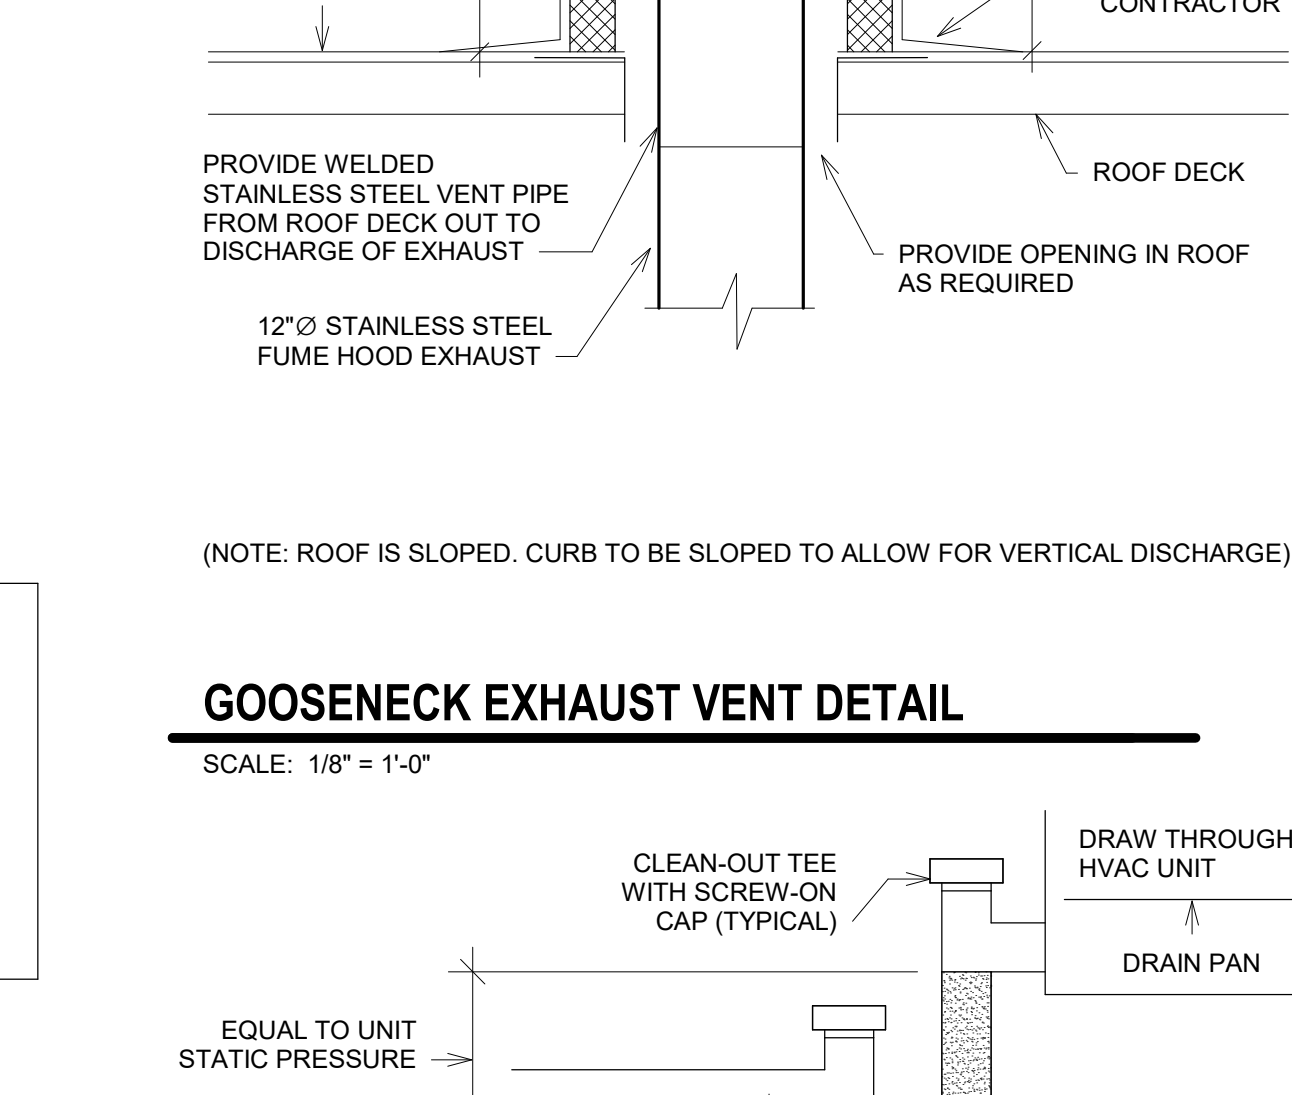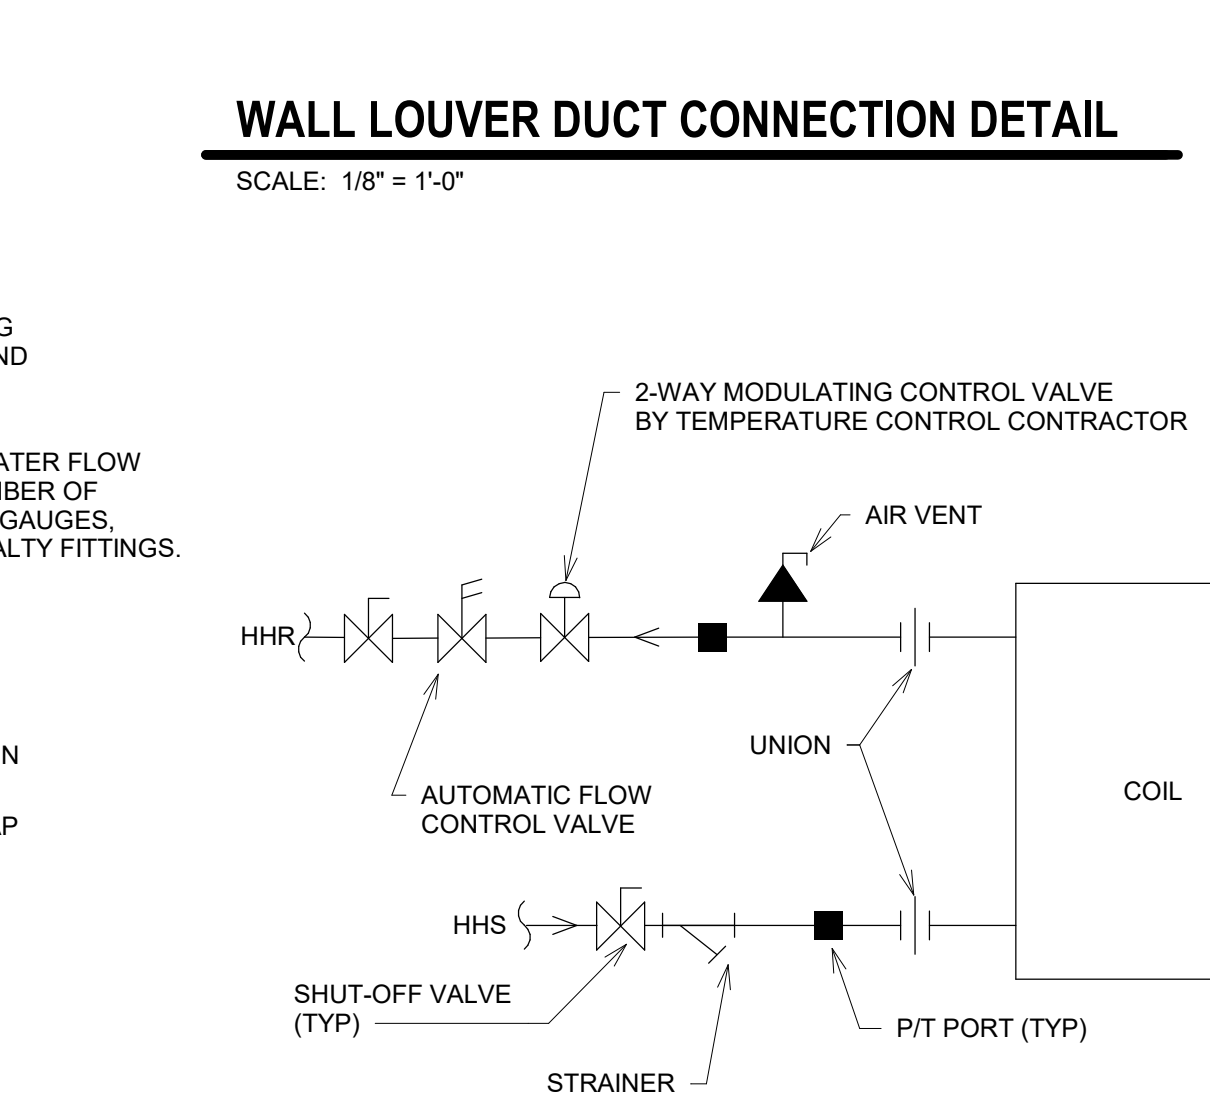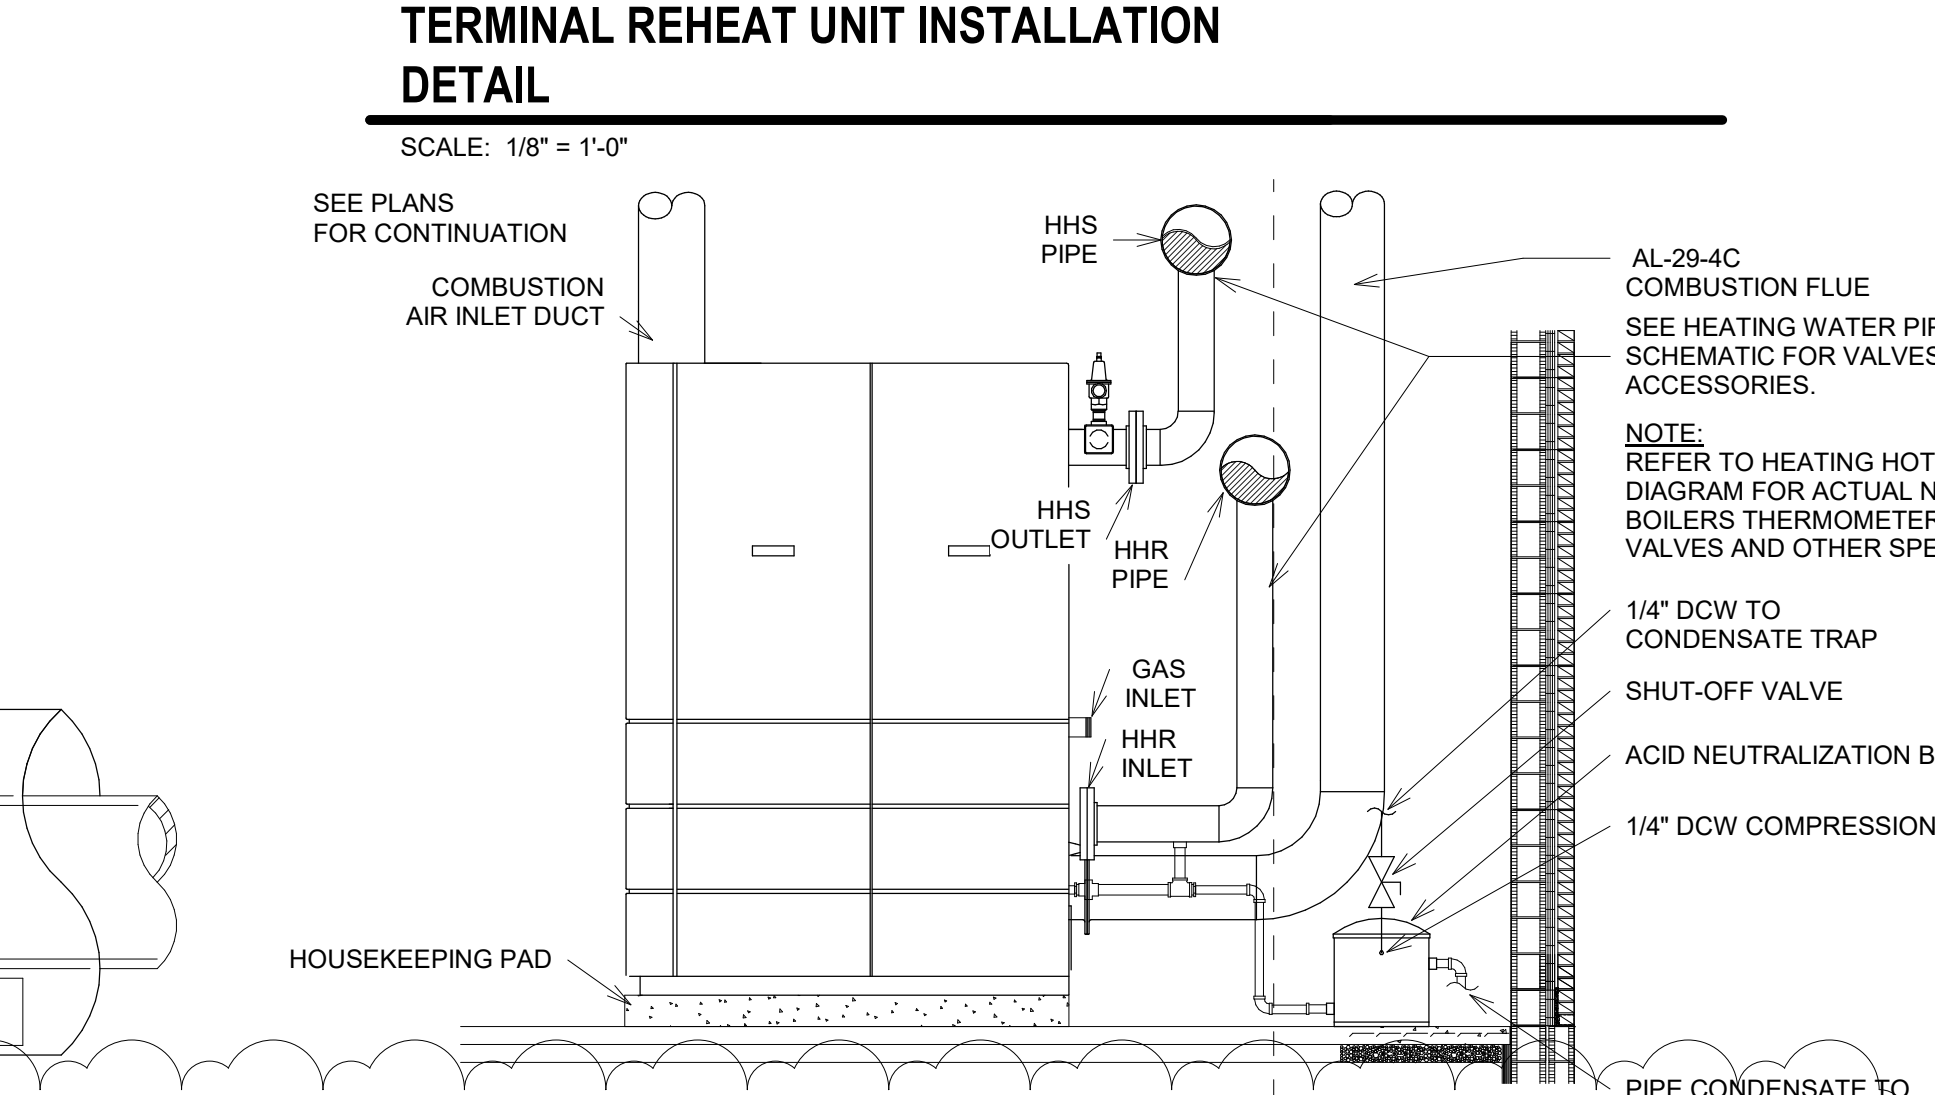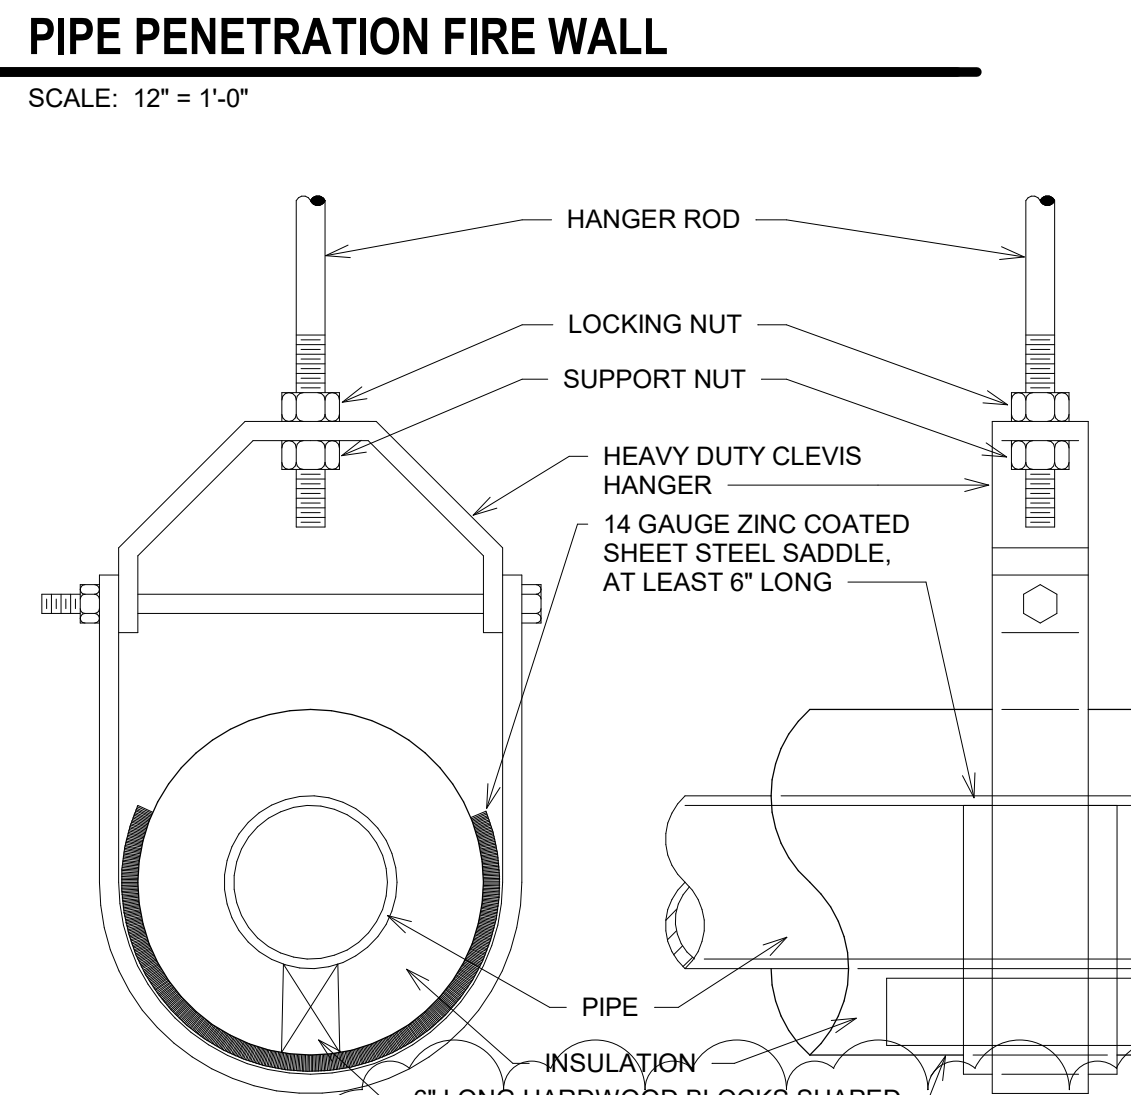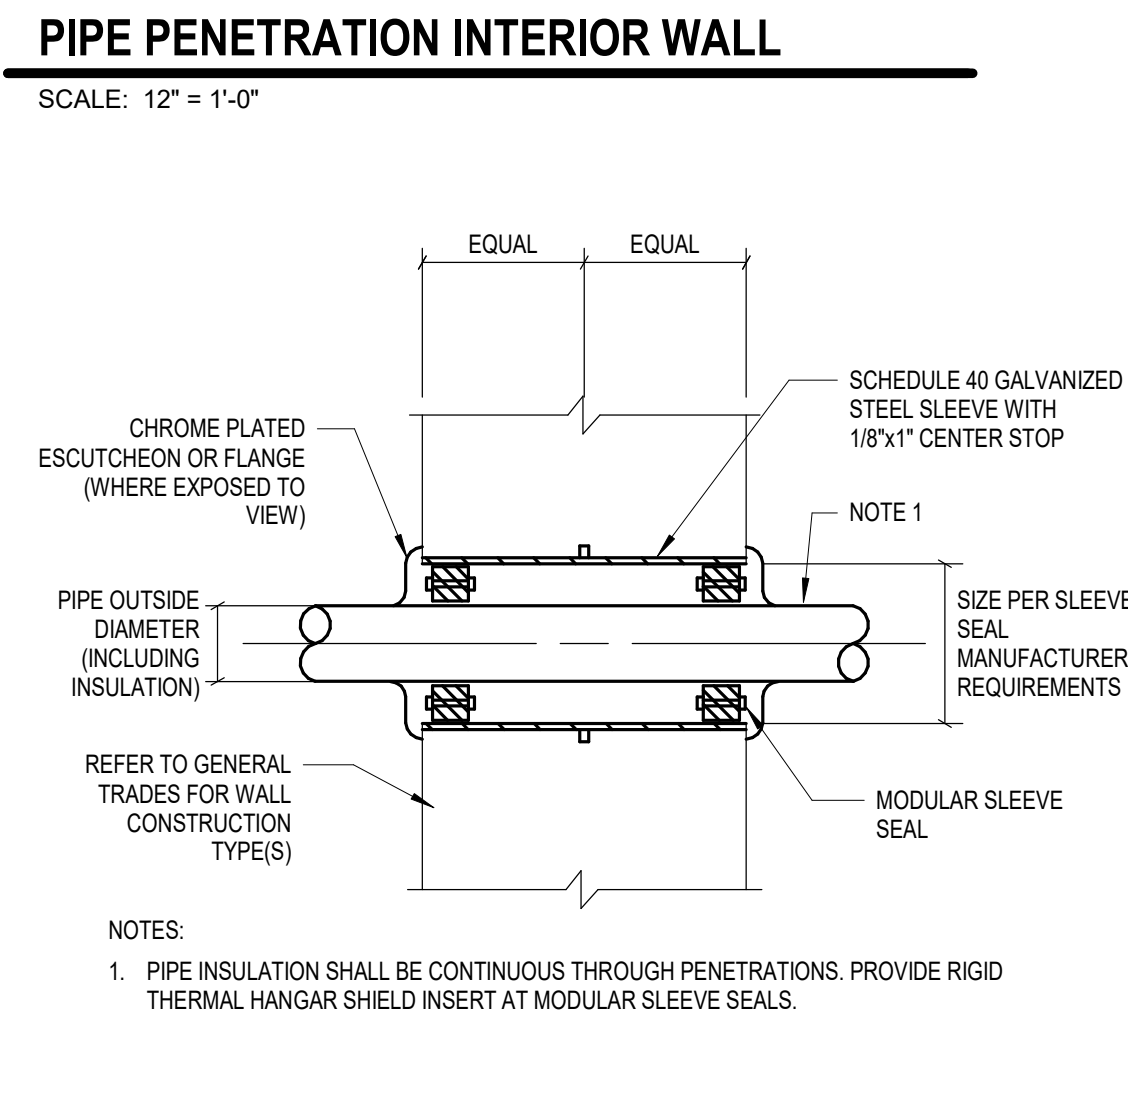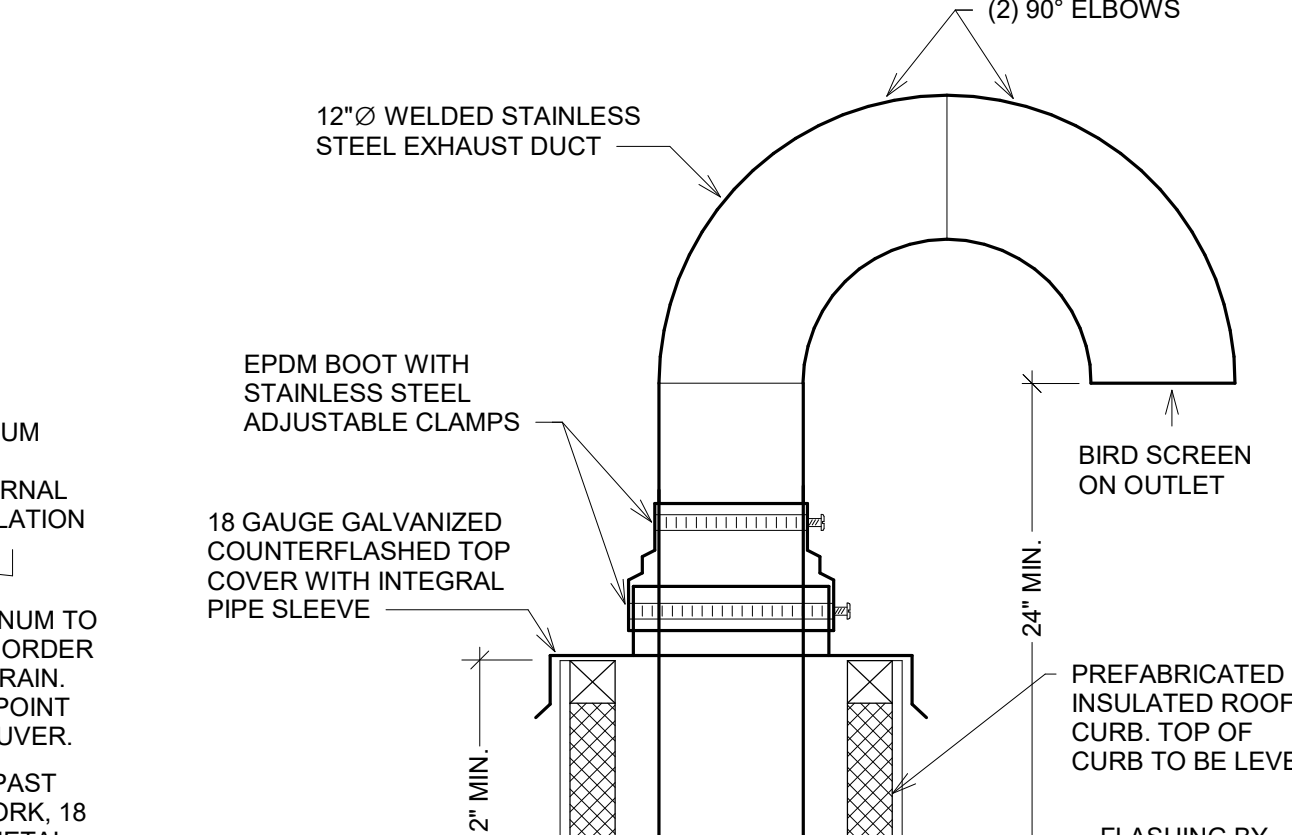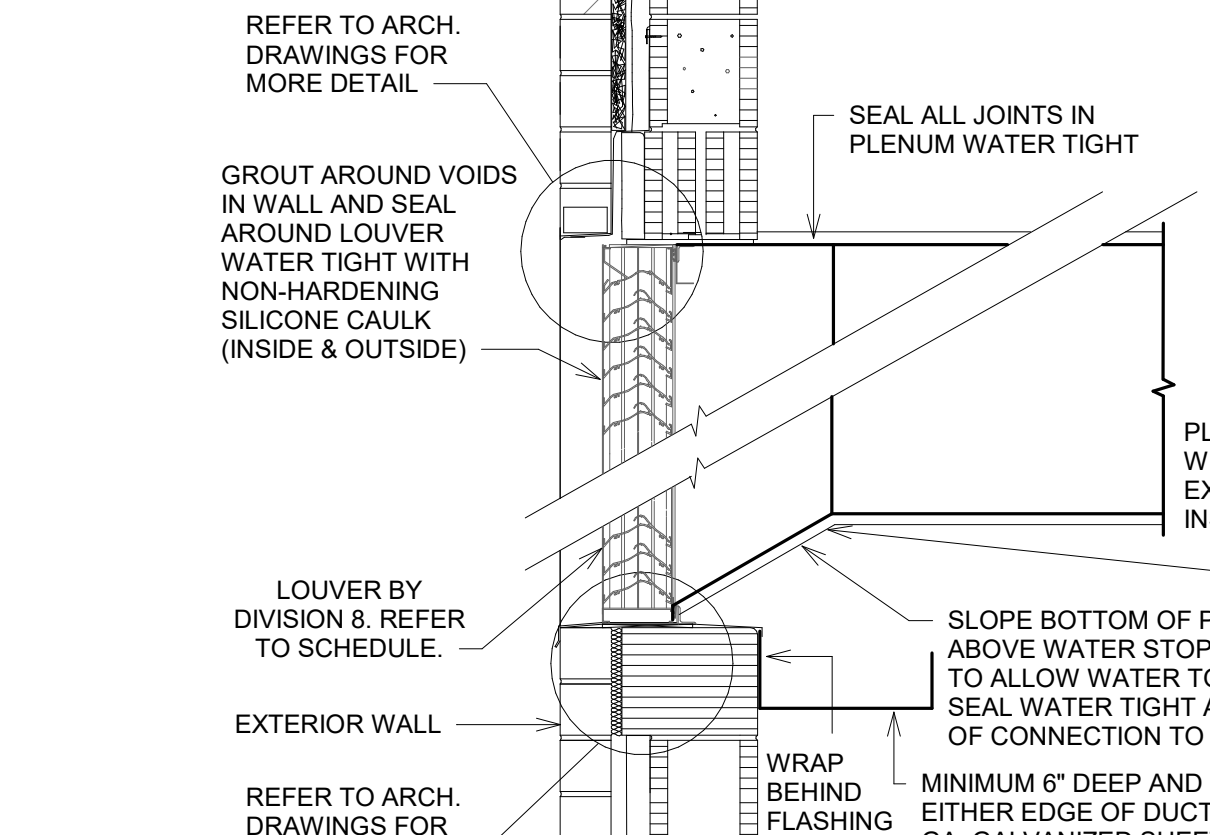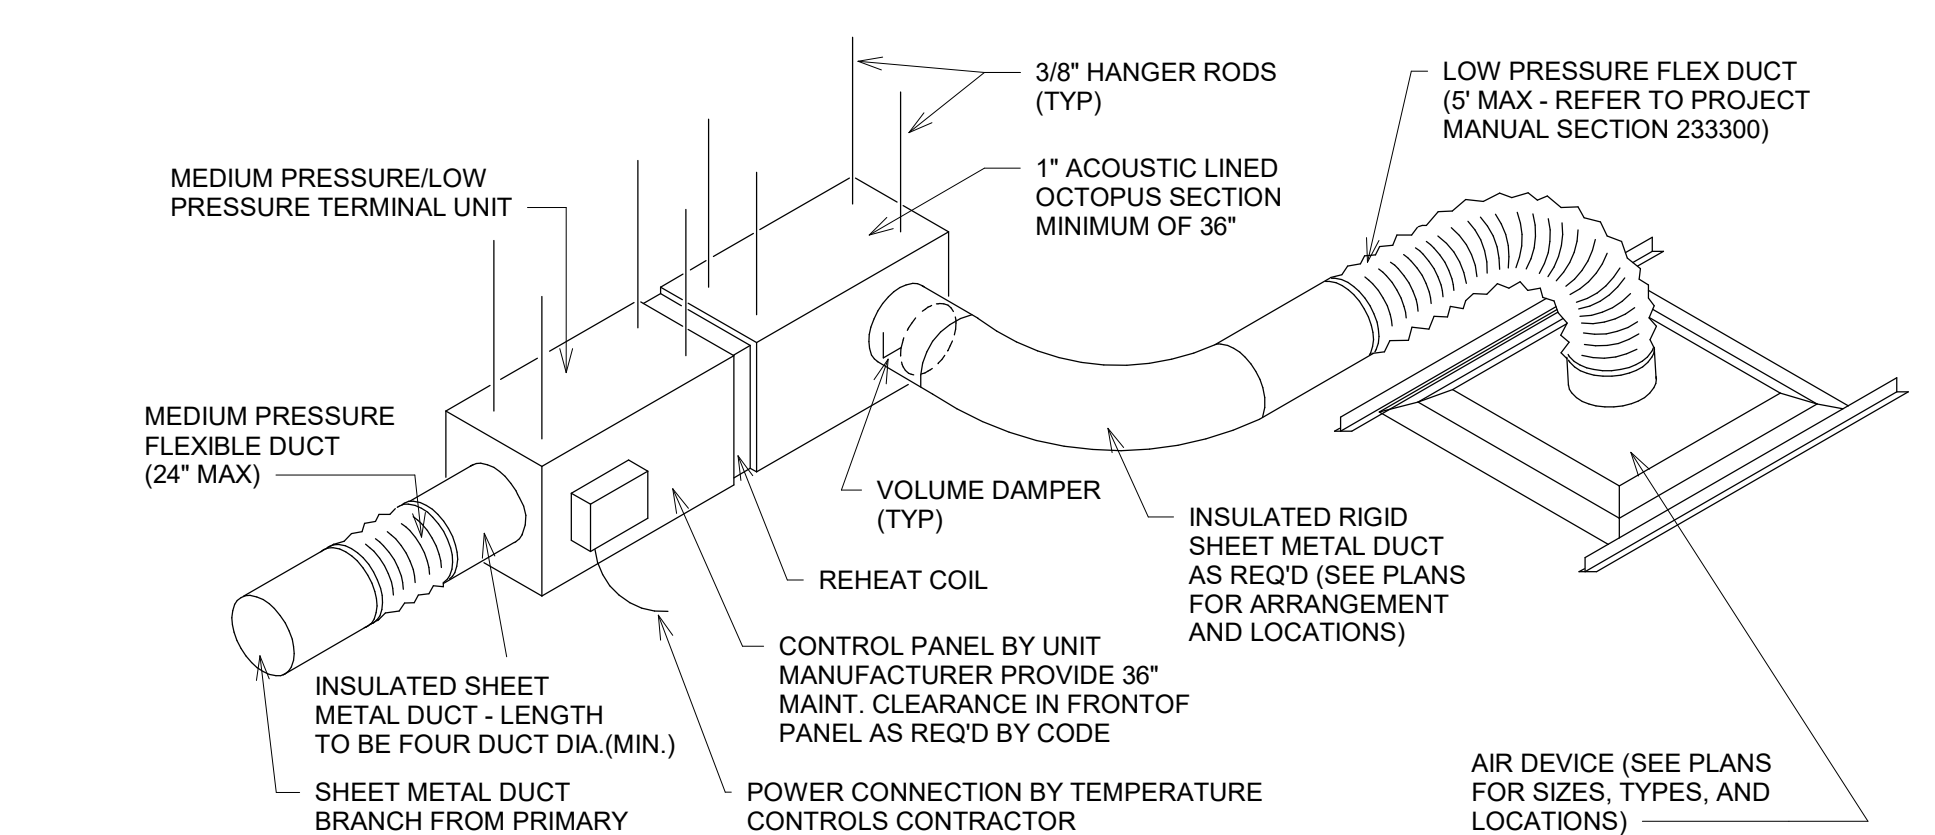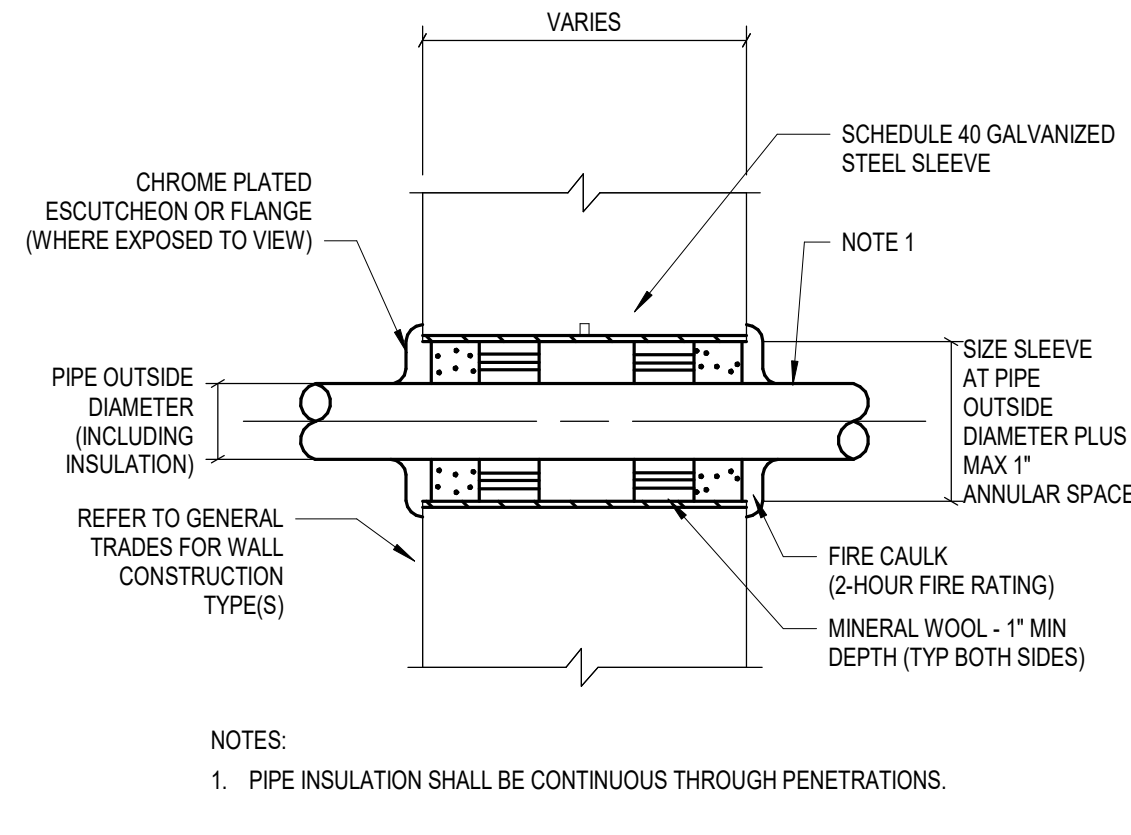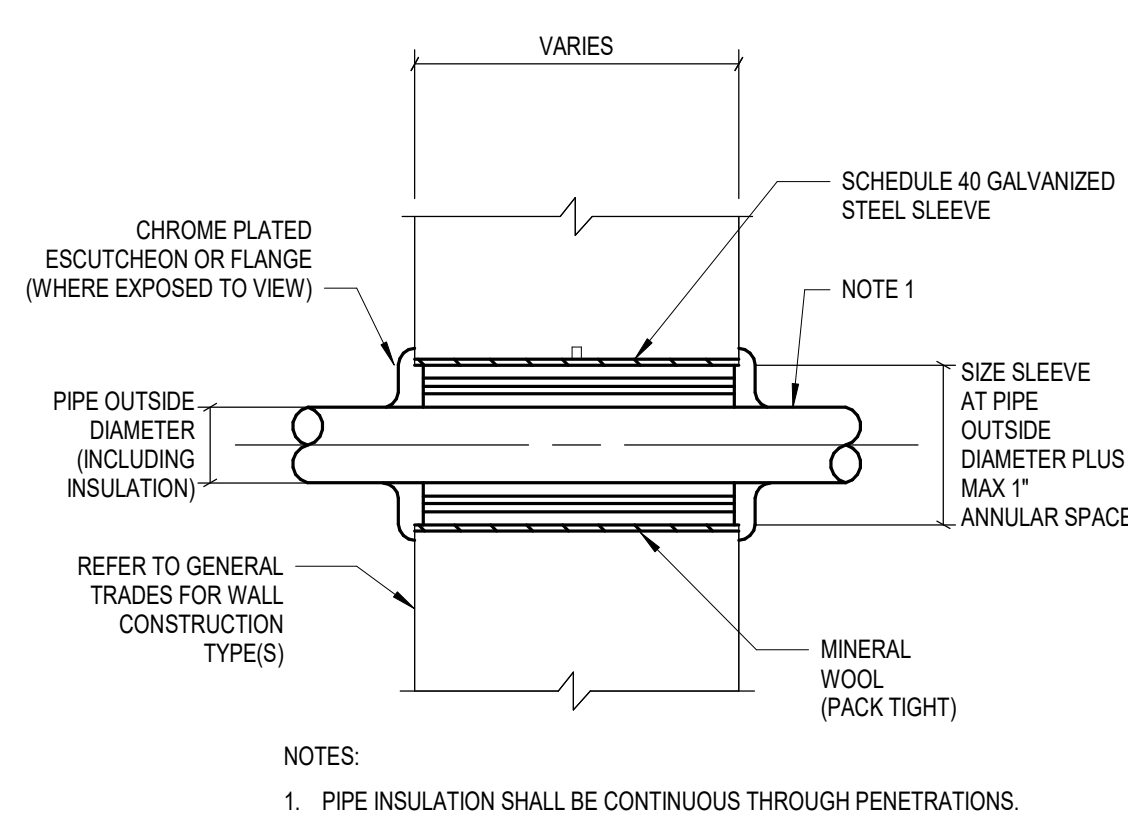

Autodesk Docs\Nathaniel Jones.EIC - Add\_Renov#2025\_MECH\_232216.00.rvt  
3/30/2026 1:59:01 PM

# NATHANIEL JONES EARLY LEARNING CENTER ADDITION & EXPANSION

7839 NEW AUGUSTA RD.  
INDIANAPOLIS, IN 46268


MSD OF PIKE TOWNSHIP



ARCHITECT


## FANNING HOWEY

317-848-0966 WWW.FHAI.COM  
390 E NEW YORK ST. SUITE 300, INDIANAPOLIS, IN 46204

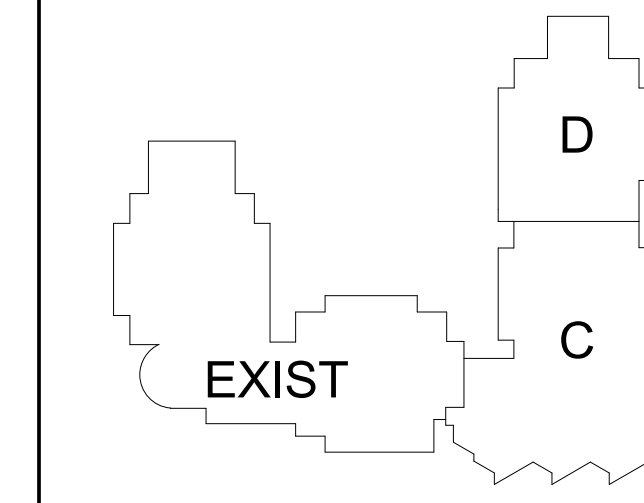

KEY PLAN

BID DOCUMENTS

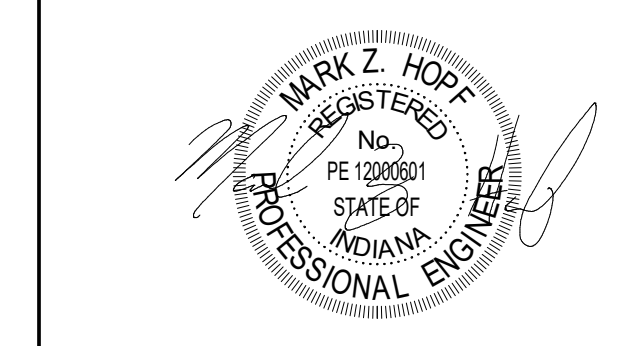

PROJECT MANAGER: PW  
DRAWN BY: CMS  
PROJECT NUMBER: 223216.00  
PROJECT ISSUE DATE: 03-26-2026

REV. NO.	DESCRIPTION	DATE
1	ADDENDUM #2	03/26/2026
2	ADDENDUM #5	3/30/2026

MECHANICAL SCHEDULES

# M-601

### 23.73.13 - AIR HANDLING UNIT SCHEDULE

IDENTITY		SUPPLY FAN	SUPPLY FAN	SUPPLY FAN		ELECTRICAL		COOLING											CHILLED WATER COIL				HEATING				HOT WATER COIL				PREFILTER		FILTER		UNIT SIZE (IN)			OPER. WT (LB)	NOTES							
MARK	MFG	AREA SERVED	EQUIPMENT NOMINAL (CFM)	MIN OSA (CFM)	SUPPLY FAN TOTAL SP (IN-WG)	EXTERNAL SP (IN-WG)	FAN RPM	DRIVE	BHP	HP	VFD	VOLT.	PH	FLA	MCA	TOT. CAP. (BTU/H)	SENS. CAP. (BTU/H)	EAT DB (°F)	EAT WB (°F)	LAT DB (°F)	LAT WB (°F)	ROWS	FPI	APD (IN-WG)	FACE VEL. (FPM)	EWV (°F)	LWT (°F)	WPD (FT-WG)	FLOW (GPM)	CAP. (BTU/H)	EAT DB (°F)	LAT DB (°F)	ROWS	APD (IN-WG)	FACE VEL. (FPM)	EWV (°F)	LWT (°F)	WPD (FT-WG)	FLOW (GPM)	MERV	MERV	L	W	H	WT (LB)	NOTES
AHU-C1	TRANE	C-BLOCK/CAFETERIA	22310	10040	3.50	6.62	1970	DIRECT	35.3	20x2	Yes	460 V	3	55.30	62 A	1025390	684260	82	68	54	54	6	9	0.62	490	42	57	15.76	134.0	1096040	40	85	2	0.18	490	140	100	2.83	54.9	8	13	237	106	89	8736	SEE NOTES 1-14
AHU-D1	TRANE	D-BLOCK	9900	4455	5.75	3.00	1916	DIRECT	13.6	15	Yes	460 V	3	22.30	28 A	467750	314560	82	68	53	53	6	10	0.67	484	42	57	15.22	62.2	486370	40	85	2	0.17	476	140	100	5.88	24.4	8	13	191	80	53	3646	SEE NOTES 1-15

- NOTES:
- REFER TO PROJECT MANUAL SECTION 237313 FOR ADDITIONAL REQUIREMENTS.
  - REFER TO PLANS & SCHEMATIC SHEETS FOR UNIT LAYOUT DETAILS.
  - PROVIDE A FACTORY MOUNTED CONVENIENCE OUTLET ON THE EXTERIOR OF EACH AIR HANDLER. PROVIDE INTERNAL LIGHTS AT EACH ACCESS DOOR OPERATED BY A SINGLE LIGHT SWITCH MOUNTED ON THE EXTERIOR OF EACH AIR HANDLER. THE CONVENIENCE OUTLET AND LIGHTS ARE TO BE ON A SEPARATE CIRCUIT THAN THE AIR HANDLER POWER SUPPLY. IF THE MANUFACTURER IS UNABLE TO PROVIDE THE CONVENIENCE OUTLET AND/OR LIGHTS, IT IS THE MECHANICAL CONTRACTOR RESPONSIBILITY TO COORDINATE THE ELECTRICAL CONTRACTOR FOR INSTALLATION OF THE CONVENIENCE OUTLET AND/OR LIGHTS.
  - MAXIMUM COIL FACE VELOCITY SHALL BE 500 FPM.
  - MAXIMUM PRE FILTER AND PRIMARY FILTER FACE VELOCITY SHALL BE 500 FPM.
  - INCLUDE FACTORY MOUNTED RETURN AND OUTSIDE AIR DAMPERS.
  - HEATING WATER COIL SHALL BE IN A PREHEAT POSITION.
  - FACTORY MOUNTED VARIABLE FREQUENCY CONTROLLER (VFC) SHALL BE PROVIDED ON SUPPLY FAN.
  - COOLING COIL SHALL BE SELECTED WITH 100% WATER.
  - PROVIDE FACTORY MOUNTED DISCONNECT
  - SINGLE POINT ELECTRICAL CONNECTION TO UNITS.
  - SUMMER DESIGN CONDITIONS: INDOOR 74°db, 50% RH, OUTDOOR 91.3°db/75°wb
  - WINTER DESIGN CONDITIONS: INDOOR 70°db, OUTDOOR 2.8°db
  - UNIT SHALL INCLUDE FACTORY MOUNTED BELMOUTH FITTINGS.
  - PROVIDE WITH SCRR RATING >7KAC@480V.

### 23.37.13 - DIFFUSERS, REGISTERS, AND GRILLES SCHEDULE

IDENTITY DATA		NECK SIZE		FACE SIZE (W x L)	MAX CORE/NECK VELO.	AIR FLOW	MAX N.C.	FRAME/ MOUNTING
MARK	DESCRIPTION	MANUFACTURER	MODEL	NECK SIZE	FACE SIZE (W x L)	MAX CORE/NECK VELO.	MAX N.C.	FRAME/ MOUNTING
A1	STEEL PLAQUE FACE DIFFUSER	TITUS	OMNI	4"ø	12" x 12"	600 FPM	50	REFER TO REFLECTED CEILING PLAN
A2	STEEL PLAQUE FACE DIFFUSER	TITUS	OMNI	6"ø	24" x 24"	600 FPM	250	REFER TO REFLECTED CEILING PLAN
A3	STEEL PLAQUE FACE DIFFUSER	TITUS	OMNI	8"ø	24" x 24"	700 FPM	250	REFER TO REFLECTED CEILING PLAN
A4	STEEL PLAQUE FACE DIFFUSER	TITUS	OMNI	10"ø	24" x 24"	750 FPM	400	REFER TO REFLECTED CEILING PLAN
B1	ALUMINUM LOUVERED RETURN	TITUS	350FL	32"x32"	32" x 32"	400 FPM	2,500	REFER TO REFLECTED CEILING PLAN
B2	ALUMINUM LOUVERED RETURN	TITUS	350FL	22"x22"	22" x 22"	400 FPM	1,500	REFER TO REFLECTED CEILING PLAN
B3	ALUMINUM LOUVERED RETURN	TITUS	350FL	8"x8"	8" x 8"	500 FPM	185	SURFACE
B4	ALUMINUM LOUVERED RETURN	TITUS	350FL	16"x16"	16" x 16"	500 FPM	800	SURFACE
B5	ALUMINUM LOUVERED RETURN	TITUS	350FL	18"x12"	18" x 12"	500 FPM	675	SURFACE
B6	ALUMINUM LOUVERED RETURN	TITUS	350FL	14"x14"	14" x 14"	500 FPM	610	SURFACE
C1	ALUMINUM EGGRATE	TITUS	50F	8"x8"	8" x 8"	400 FPM	150	REFER TO REFLECTED CEILING PLAN
C2	ALUMINUM EGGRATE	TITUS	50F	10"x10"	10" x 10"	400 FPM	225	REFER TO REFLECTED CEILING PLAN
C3	ALUMINUM EGGRATE	TITUS	50F	12"x12"	12" x 12"	400 FPM	350	REFER TO REFLECTED CEILING PLAN
C5	ALUMINUM EGGRATE	TITUS	50F	16"x16"	16" x 16"	400 FPM	650	REFER TO REFLECTED CEILING PLAN
C6	ALUMINUM EGGRATE	TITUS	50F	24"x24"	24" x 24"	400 FPM	1,500	REFER TO REFLECTED CEILING PLAN
D1	STEEL DOUBLE DEFLECTION SUPPLY GRILLE	TITUS	300RS	18"x14"	18" x 14"	500 FPM	795	REFER TO REFLECTED CEILING PLAN
E1	HIGH CAPACITY DRUM LOUVER	TITUS	S-DL	18"x6"	18" x 6"	500 FPM	333	DUCT
F1	Architectural Linear Diffuser	Titus HVAC	FL-10	-	3"x48"	100	20	HIGH-THROW W/INSULATED PLENUM - 1" SLOT WIDTH, TOTAL 1 SLOT, SUSPENDED
F2	Architectural Linear Diffuser	Titus HVAC	FL-20	-	9"x48"	290	21	HIGH-THROW W/INSULATED PLENUM - 2" SLOT WIDTH, TOTAL 2 SLOTS, SURFACE MOUNTED
F3	Architectural Linear Diffuser	Titus HVAC	FL-30	-	13"x48"	510	20	HIGH-THROW W/INSULATED PLENUM - 3" SLOT WIDTH, TOTAL 2 SLOTS, SURFACE MOUNTED

### 23.34.23 - HVAC POWER VENTILATOR SCHEDULE

IDENTITY DATA				LOCATION		DESCRIPTION	PERFORMANCE DATA				ELECTRICAL DATA				DISCONNECT	CONTROLS	NOTES		
MARK	MANUFACTURER	MODEL	WEIGHT (LBS)	TYPE	LOCATION	AREA SERVED	DRIVE	CFM	RPM	ESP (IN-WG)	MOTOR HP	ELECTRICAL	VOLTS	PH	FREQ	DISCONNECT	CONTROLS	NOTES	
EF-C101	Greenheck	G-100-VG	54	CENTRIFUGAL DOWNBLAST	ROOF C	C-BLOCK/CAFETERIA	RESTROOM EXHAUST	DIRECT	675	1141	0.39	0.25	115 V-1-60	115 V	1	60	YES	A	1,2,3,4,5
EF-C102	Greenheck	G-070-VG	36	CENTRIFUGAL DOWNBLAST	ROOF C	C-BLOCK/CAFETERIA	CUSTODIAL EXHAUST	DIRECT	220	1557	0.33	0.06	115 V-1-60	115 V	1	60	YES	C	1,2,3,4,5
EF-C103	Greenheck	G-099-VG	54	CENTRIFUGAL DOWNBLAST	ROOF C	C-BLOCK/CAFETERIA	ELECTRICAL EXHAUST	DIRECT	490	626	0.23	0.25	115 V-1-60	115 V	1	60	YES	B	1,2,3,4,5
EF-C104	Greenheck	G-099-VG	54	CENTRIFUGAL DOWNBLAST	ROOF C	C-BLOCK/CAFETERIA	RESTROOM EXHAUST	DIRECT	750	1442	0.58	0.25	115 V-1-60	115 V	1	60	YES	A	1,2,3,4,5
EF-C105	Greenheck	G-080-VG	40	CENTRIFUGAL DOWNBLAST	ROOF C	C-BLOCK/CAFETERIA	RESTROOM EXHAUST	DIRECT	225	1266	0.29	0.1	115 V-1-60	115 V	1	60	YES	A	1,2,3,4,5
EF-C106	Greenheck	G-099-VG	54	CENTRIFUGAL DOWNBLAST	ROOF C	C-BLOCK/CAFETERIA	RESTROOM EXHAUST	DIRECT	545	1072	0.33	0.25	115 V-1-60	115 V	1	60	YES	A	1,2,3,4,5
EF-C107	Greenheck	SQ-120-VG	61	INLINE	C117	C-BLOCK/CAFETERIA	MECHANICAL EXHAUST	DIRECT	550	776	0.25	0.5	115 V-1-60	115 V	1	60	YES	B	1,2,3,5
EF-D101	Greenheck	G-140-VG	68	CENTRIFUGAL DOWNBLAST	ROOF D	D-BLOCK	RESTROOM EXHAUST	DIRECT	1,200	1,073	0.63	0.5	120 V-1-60	120 V	1	60	YES	A	1,2,3,4,5
EF-D102	Greenheck	G-099-VG	54	CENTRIFUGAL DOWNBLAST	ROOF D	D-BLOCK	ELECTRICAL EXHAUST	DIRECT	490	916	0.22	0.25	115 V-1-60	115 V	1	60	YES	B	1,2,3,4,5
EF-D103	Greenheck	G-070-VG	36	CENTRIFUGAL DOWNBLAST	ROOF D	D-BLOCK	ELECTRICAL EXHAUST	DIRECT	240	1557	0.3	0.06	115 V-1-60	115 V	1	60	YES	B	1,2,3,4,5
EF-D104	Greenheck	G-090-E	54	CENTRIFUGAL DOWNBLAST	ROOF D	D-BLOCK	MECHANICAL EXHAUST	DIRECT	450	1315	0.29	0.1	115 V-1-60	115 V	1	60	YES	B	1,2,3,4,5

- NOTES:
- INCLUDE FACTORY MOUNTED DISCONNECT SWITCH.
  - INCLUDE BACKDRAFT DAMPER.
  - REFER TO SPECIFICATION SECTION 233423 FOR ADDITIONAL REQUIREMENTS.
  - MOUNT ON 12" HIGH ROOF CURB, UNLESS OTHERWISE NOTED.
  - INCLUDE FACTORY MOUNTED SPEED CONTROLLER.
- NOTES:
- AUTOMATIC OCCUPIED OPERATION BY LOCAL TEMPERATURE CONTROL ZONE
  - AUTOMATIC OPERATION BY REVERSE-ACTING THERMOSTAT
  - 24 HOUR CONTINUOUS OPERATION.

### 23.36.00 - TERMINAL UNIT (VARIABLE VOLUME) SCHEDULE

IDENTITY DATA		AIRFLOW		HEATING		HEATING		COIL		WPD		FLOW		ROWS		CONTROLS	WT (LB)	NOTES
MARK	MODEL	INLET SIZE	COOLING MAX	HEATING MAX	INLET APP (IN-WG)	CAP. (BTU/H)	EAT (°F)	LAT (°F)	EWV (°F)	LWT (°F)	APD (IN-WG)	WPD (FT-WG)	FLOW (GPM)	ROWS	CONTROLS	WT (LB)	NOTES	
VAV-C101	TSS	14"	900	450	0.68	41.38	55	95	140	108	0.12	0.21	2.7	3	SDC-FL110	56	SEE NOTES	
VAV-C102	TSS	10"	400	200	0.62	20.29	55	95	140	111	0.10	0.29	1.4	3	SDC-FL110	37	SEE NOTES	
VAV-C103	TSS	12"	1200	600	1.12	56.87	55	95	140	113	0.48	1.17	4.3	4	SDC-FL110	50	SEE NOTES	
VAV-C104	TSS	12"	870	435	0.93	40.11	55	95	140	113	0.21	1.02	3.0	3	SDC-FL110	44	SEE NOTES	
VAV-C105	TSS	14"	1520	760	1.1	67.87	55	95	140	96	0.38	0.31	4.5	4	SDC-FL110	65	SEE NOTES	
VAV-C106	TSS	14"	1520	760	1.19	67.87	55	95	140	96	0.35	0.31	4.5	4	SDC-FL110	65	SEE NOTES	
VAV-D101	TSS	14"	900	450	0.78	41.38	55	95	140	108	0.13	0.21	2.7	3	SDC-FL110	56	SEE NOTES	

- NOTES:
- REFER TO SPECIFICATION SECTION 233600 FOR ADDITIONAL REQUIREMENTS.
  - UNIT SELECTION MUST ALLOW FOR A MINIMUM OF 0.50" DOWNSTREAM STATIC PRESSURE.
  - PROVIDE FACTORY MOUNTED DISCONNECT SWITCH.
  - UNITS TO BE PROVIDED WITH FACTORY MOUNTED CONTROL TRANSFORMER FROM 277/1 VOLT TO 24 VOLT. COORDINATE ALL REQUIREMENTS WITH ELECTRICAL CONTRACTOR.
  - NOISE LEVELS NOT TO EXCEED 20 NC.

### 23.36.00 - TERMINAL UNIT (FAN-POWERED) SCHEDULE

IDENTITY		PRIMARY AIR (CFM)		FAN		SOUND		ELECTRICAL		HEATING				UNIT	NOTES														
MARK	MODEL	SIZE	MAX FLOW	MIN FLOW	MAX FLOW (CFM)	ESP (IN-WG)	QTY	PWR (HP)	INLET APD (IN-WG)	NC	UNIT POWER (W)	VOLT	FREQ (HZ)	PH	MCA (A)	MCCP (A)	CAP. (BTU/H)	EAT (°F)	LAT (°F)	DESCRIPTION	EWV (°F)	LWT (°F)	APD (IN-WG)	WPD (FT-WG)	FLOW (GPM)	ROWS	WT (LB)	NOTES	
FPB-C101	TCQO	1015E	1150	575	1150	0.25	1	1/2	0.44	29	25	246	277	60	1	4.50	15	42.32	61.5	95.00	HOT WATER	140	104	0.35	1.30	2.4	3	225	SEE NOTES
FPB-C102	TCQO	1015E	1100	550	1100	0.25	1	1/2	0.34	29	24	228	277	60	1	4.50	15	41.14	61.5	95.00	HOT WATER	140	104	0.32	1.26	2.3	3	225	SEE NOTES
FPB-C104	TCQO	1015E	1150	575	1150	0.25	1	1/2	0.5	29	25	246	277	60	1	4.50	15	42.32	61.5	95.00	HOT WATER	140	104	0.35	1.30	2.4	3	225	SEE NOTES
FPB-C105	TCQO	1015E	1100	550	1100	0.25	1	1/2	0.39	29	24	228	277	60	1	4.50	15	41.14	61.5	95.00	HOT WATER	140	104	0.32	1.26	2.3	3	225	SEE NOTES
FPB-C106	TCQO	1015E	1100	550	1100	0.25	1	1/2	0.36	29	24	228	277	60	1	4.50	15	41.14	61.5	95.00	HOT WATER	140	104	0.32	1.26	2.3	3	225	SEE NOTES
FPB-C107	TCQO	1015E	1150	575	1150	0.25	1	1/2	0.29	29	25	246	277	60	1	4.50	15	42.32	61.5	95.00	HOT WATER	140	104	0.35	1.30	2.4	3	225	SEE NOTES
FPB-C108	TCQO	1235E	2350	1175	2350	0.25	1	1/2	0.24	32	26	55																	









# NATHANIEL JONES EARLY LEARNING CENTER ADDITION & EXPANSION

7839 NEW AUGUSTA RD.  
INDIANAPOLIS, IN 46268


MSD OF PIKE TOWNSHIP



ARCHITECT




317-848-0966 WWW.FHAI.COM  
350 E NEW YORK ST. SUITE 300, INDIANAPOLIS, IN 46204

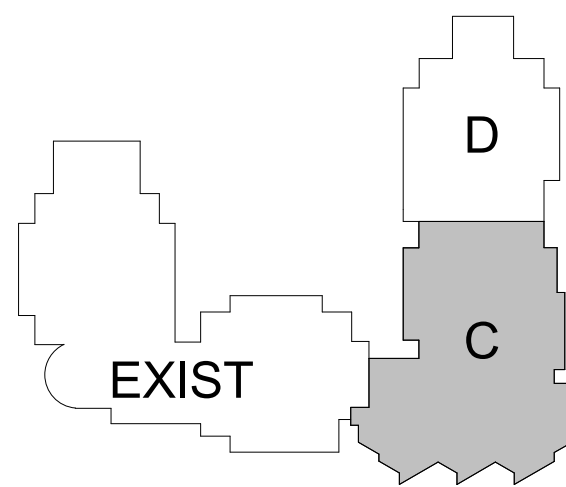

KEY PLAN

BID DOCUMENTS

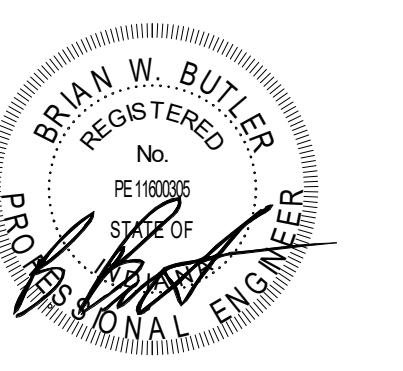

PROJECT MANAGER: PW  
DRAWN BY: ANE  
PROJECT NUMBER: 223216.00  
PROJECT ISSUE DATE: 03-13-2026

REV. NO.	DESCRIPTION	DATE
1	Addendum No. 3	03.30.26

FIRST FLOOR LIGHTING PLAN - UNIT C

## EL11C

**LIGHTING PLAN GENERAL NOTES**

- GENERATOR TRANSFER DEVICE TO TAKE FIXTURE TO 100% IN EMERGENCY CONDITION.
- FINAL CONNECTION TO RECESSED LUMINAIRES SHALL BE WITH FLEXIBLE METALLIC CONDUIT, MC CABLE OR MANUFACTURED WIRING SYSTEM.
- REFER TO ARCHITECTURAL REFLECTED CEILING PLANS FOR LOCATION OF LUMINAIRES. COORDINATE LOCATION OF LUMINAIRES, LOUDSPEAKERS, DIFFUSERS, GRILLES, AND OTHER CEILING INSTALLED ELEMENTS WITH THEIR RESPECTIVE INSTALLERS.
- REFER TO ARCHITECTURAL REFLECTED CEILING PLAN AND ROOM FINISH SCHEDULE TO DETERMINE PROPER TYPE OF LUMINAIRE TRIM REQUIRED FOR CEILING TYPE PRIOR TO ORDERING LUMINAIRES. PROVIDE LUMINAIRES COMPATIBLE WITH CEILING TYPE.
- RECESSED LUMINAIRE IN GRID CEILING SYSTEMS SHALL BE PROVIDED WITH SEISMIC CLIPS OR PROVIDE ATTACHMENT TO CEILING GRID SYSTEM AND SUPPORTED PER PROJECT MANUAL AND DETAIL "C10E-80".
- WHERE TWO SWITCHES ARE SHOWN ON PLAN, CONNECTED TO THE SAME LIGHT FIXTURE, CONTRACTOR SHALL WIRE TO PROVIDE MULTI-LEVEL LIGHTING. ONE SWITCH SHALL ENERGIZE THE INBOARD LAMPS AND ONE SWITCH SHALL ENERGIZE THE OUTBOARD LAMPS. ALL ROOMS SHALL BE WIRED THE SAME.
- LUMINAIRE TYPE IS SHOWN ONLY ONCE, AS "TYP" IN EVERY ROOM. PROVIDE SAME TYPE OF LUMINAIRE THROUGHOUT SAME ROOM UNLESS OTHERWISE INDICATED.  
PROVIDE NO. 10 AWG. MINIMUM CONDUCTORS FOR EXIT SIGNS AND SECURITY LIGHT CIRCUITS.

**LIGHTING PLAN NOTES**



(ALL NOTES MAY NOT BE INDICATED ON THIS SHEET)

**SHEET KEYNOTES**

- WIRE EXTERIOR LIGHTING FIXTURE THROUGH LIGHTING CONTRACTOR "L22" IN ROOM D113A FOR CONNECTION TO BRIS. CIRCUIT TO XDH-1 WITH (2) #6 @ 1' 1" O.C. MOUNT AT 10'-8" AFF.
- COORDINATE LOCATION OF LIGHTING FIXTURES IN THIS ROOM WITH MECHANICAL EQUIPMENT.
- MOUNT LIGHTING FIXTURES "LL6A" AND "LPD61X" IN THIS ROOM TO STRUCTURAL STEEL AT 18'-0" AFF. PROVIDE UNISTRUT AS APPLICABLE.
- THIS DIMMER SWITCH SHALL CONTROL ALL FIXTURES (LL6A, LPD61X, LD61X, AND LS12/6) WITHIN THIS SECTION OF THE DIVIDABLE ROOM.

ROOM LEGEND		
ROOM NO.	ROOM NAME	AREA (SF)
C100	GYM/RECREATIONAL ROOM	2515 SF
C100A	STORAGE	274 SF
C100B	CHAIR STORAGE	248 SF
C100C	PLAY EQUIPMENT	77 SF
C100D	STORAGE	318 SF
C101	CAFETERIA	5761 SF
C102	FAMILY RR	70 SF
C103	KITCHEN	1515 SF
C103A	KITCHEN STORAGE	177 SF
C103B	LOCKERS	82 SF
C103C	RESTROOM	51 SF
C103D	OFFICE	88 SF
C103E	KITCHEN VESTIBULE	122 SF
C104	CLUSTROOM	222 SF
C105	MEN'S RESTROOM	173 SF
C106	WOMEN'S RESTROOM	258 SF
C107	ELECTRICAL	92 SF
C108	CLASSROOM 3	1069 SF
C108A	STORAGE	79 SF
C109	TOILET	136 SF
C110	CLASSROOM 4	1068 SF
C110A	STORAGE	73 SF
C111	CLASSROOM 5	1068 SF
C111A	STORAGE	73 SF
C112	TOILET	136 SF
C113	CLASSROOM 6	1068 SF
C113A	STORAGE	79 SF
C114	CLASSROOM 2	1068 SF
C114A	STORAGE	79 SF
C115	TOILET	136 SF
C116	CLASSROOM 1	1068 SF
C116A	STORAGE	73 SF
C117	MECHANICAL	771 SF
C118	IT CLOSET	123 SF
C119	MAINTENANCE	178 SF
C200	VESTIBULE	75 SF
C500	CORRIDOR	1838 SF
C540	CORRIDOR	272 SF
C550	CORRIDOR	1218 SF
C560	CORRIDOR	293 SF
C580	CORRIDOR	380 SF

**NOTE:** CONNECT ALL EMERGENCY LIGHTING FIXTURES AND EXITS SIGNS ON THIS SHEET TO CIRCUIT XDH-1.

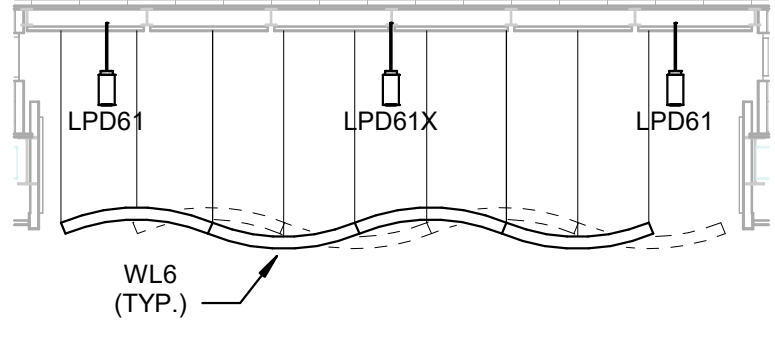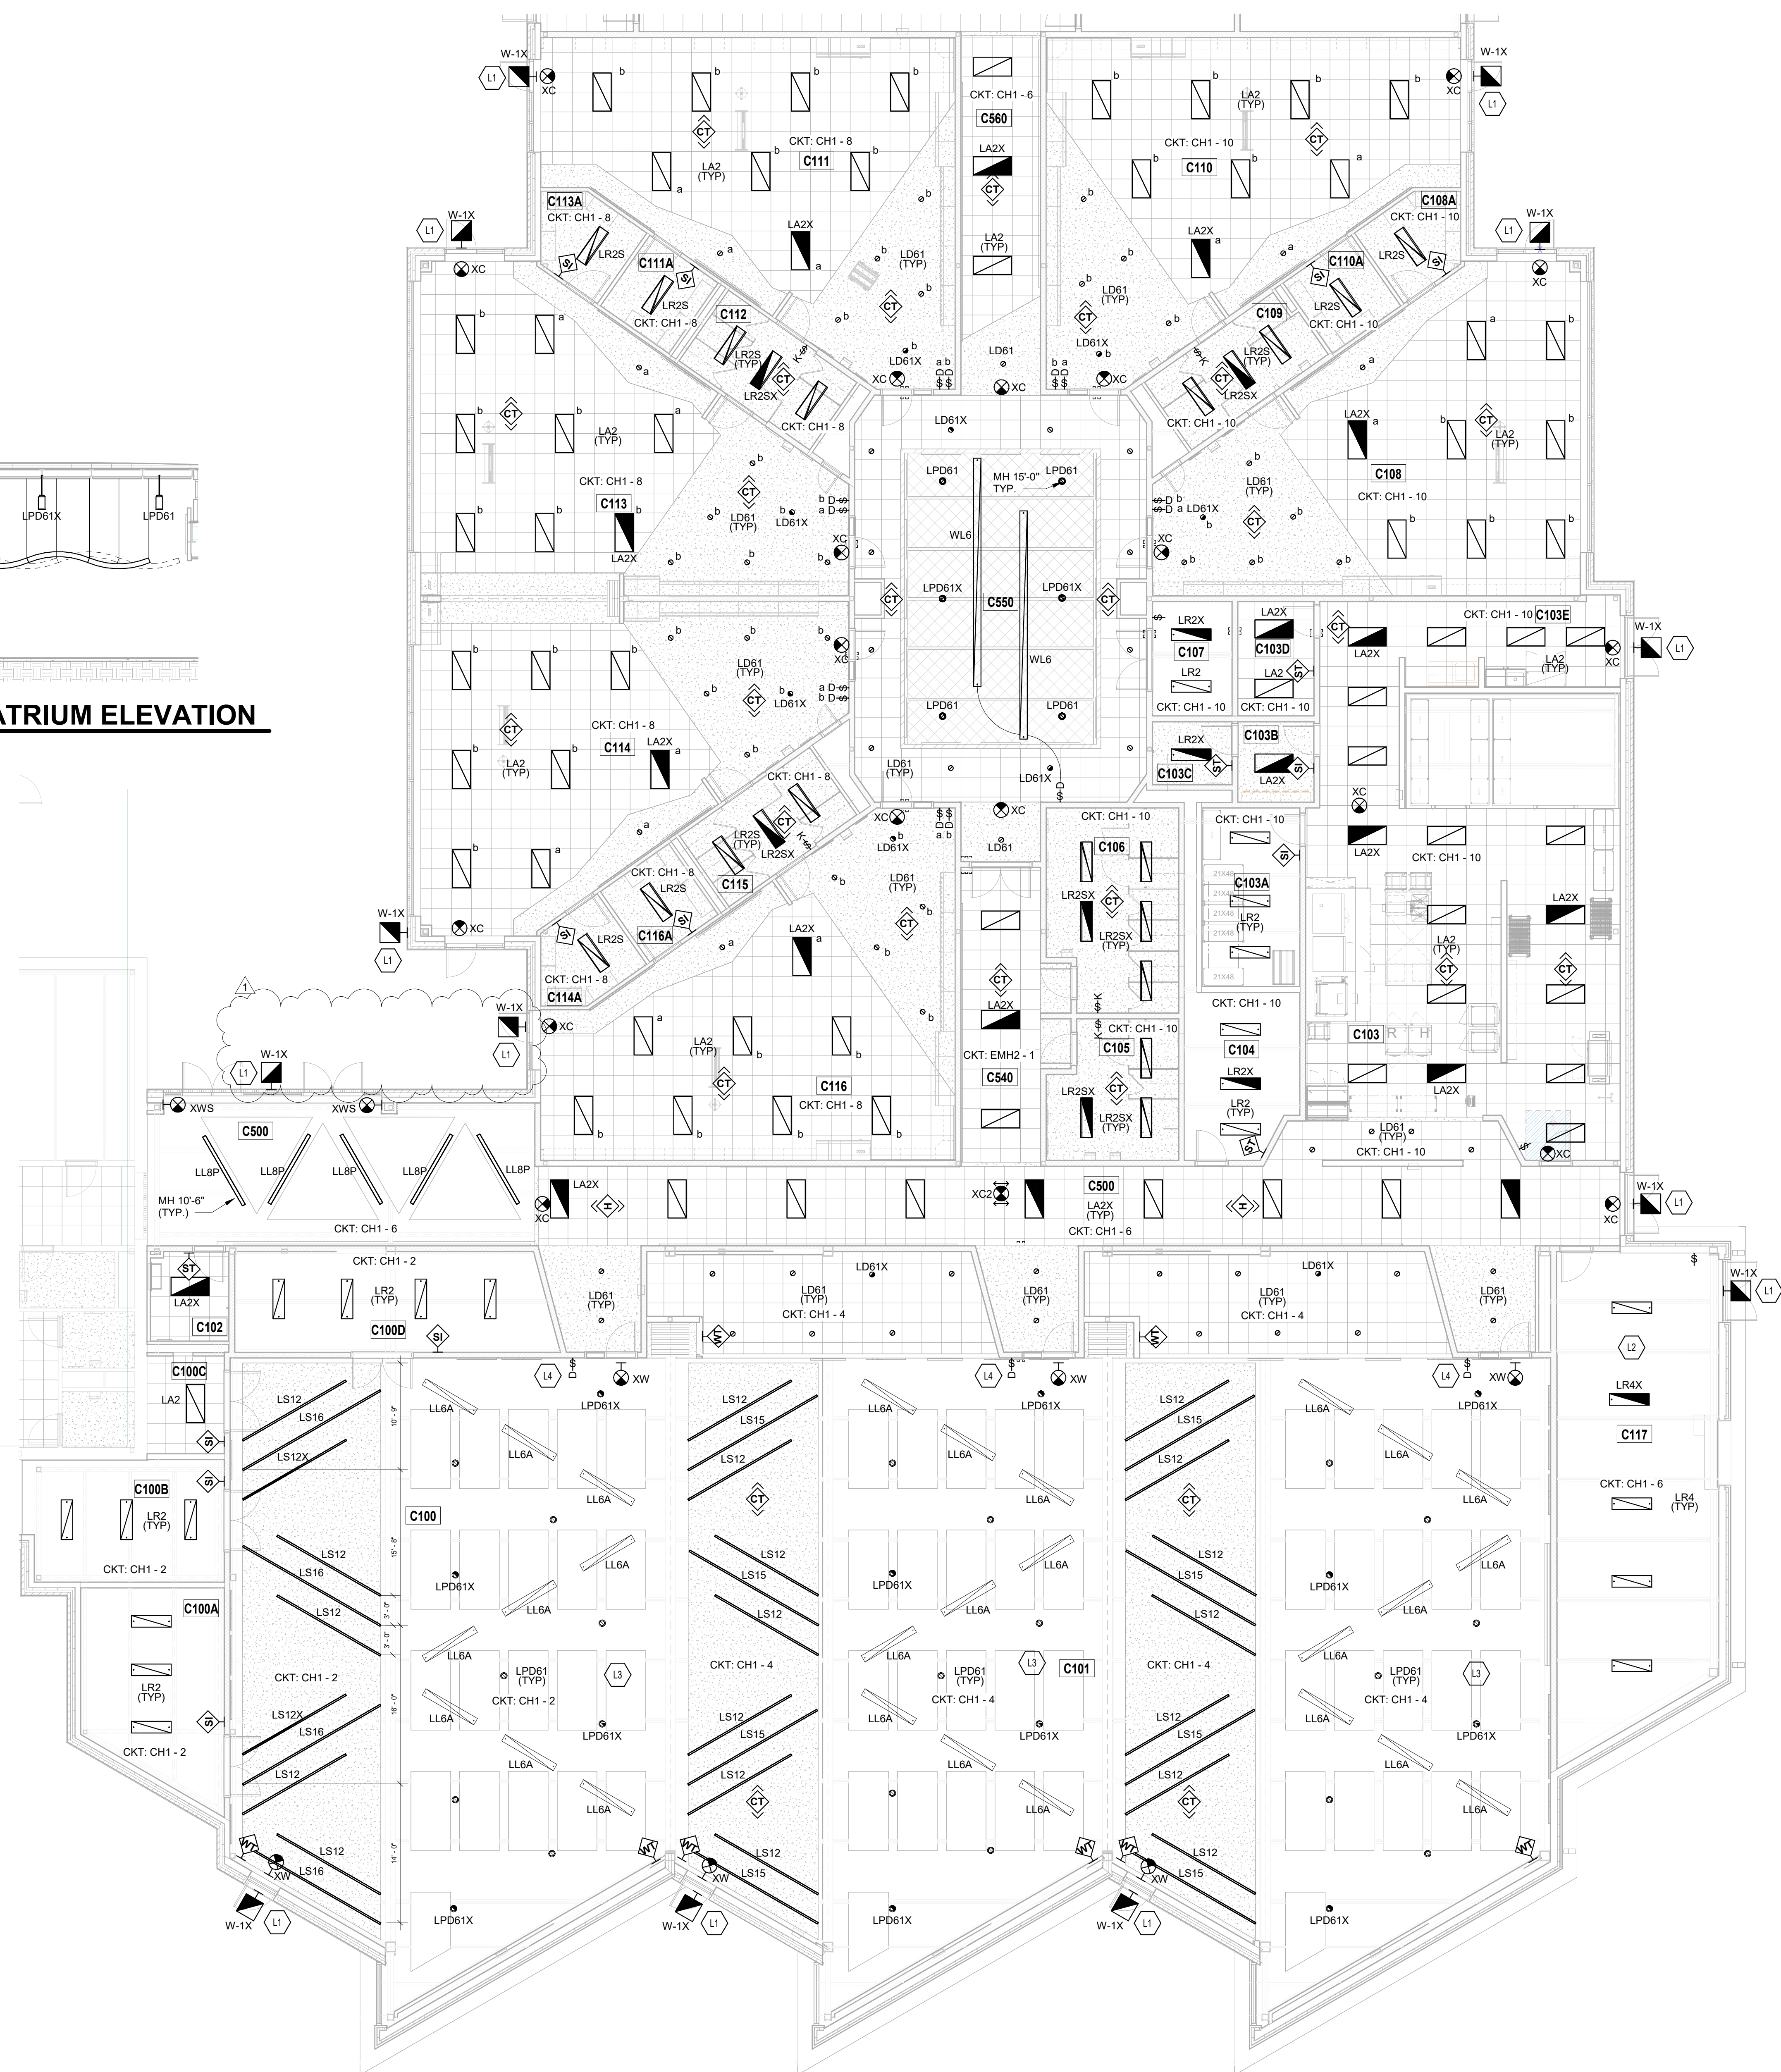

**RM C550 - ATRIUM ELEVATION**  
SCALE: 1/8" = 1'-0"

**FIRST FLOOR LIGHTING PLAN - UNIT C**

# NATHANIEL JONES EARLY LEARNING CENTER ADDITION & EXPANSION

7839 NEW AUGUSTA RD,  
INDIANAPOLIS, IN 46268


MSD OF PIKE TOWNSHIP



ARCHITECT




317-848-0966 WWW.FHAI.COM  
390 E NEW YORK ST, SUITE 300, INDIANAPOLIS, IN 46204

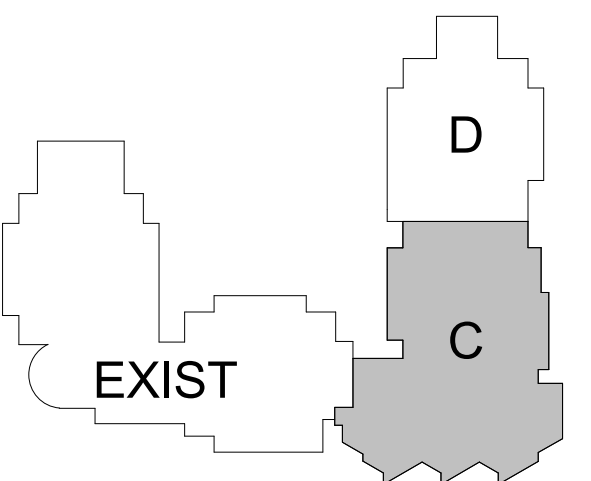

### KEY PLAN

BID DOCUMENTS

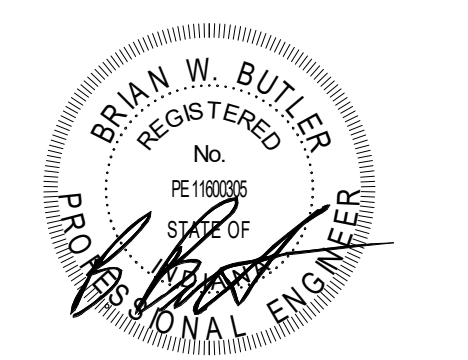

PROJECT MANAGER: PW  
DRAWN BY: ANE  
PROJECT NUMBER: 223216.00  
PROJECT ISSUE DATE: 03-13-2026

REV. NO.	DESCRIPTION	DATE
1	Addendum No. 3	03.30.26

FIRST FLOOR POWER PLAN - UNIT C

# EP11C

ROOM LEGEND		
ROOM NO.	ROOM NAME	AREA (SF)
C100	GYM/RECREATIONAL ROOM	2515 SF
C100A	STORAGE	274 SF
C100B	CHAIR STORAGE	248 SF
C100C	PLAY EQUIPMENT	77 SF
C100D	STORAGE	319 SF
C101	CAFETERIA	5761 SF
C102	FAMILY RR	70 SF
C103	KITCHEN	1515 SF
C103A	KITCHEN STORAGE	177 SF
C103B	LOCKERS	62 SF
C103C	RESTROOM	51 SF
C103D	OFFICE	88 SF
C103E	KITCHEN VESTIBULE	122 SF
C104	CUSTODIAL	220 SF
C105	MEN'S RESTROOM	173 SF
C106	WOMEN'S RESTROOM	258 SF
C107	ELECTRICAL	92 SF
C108	CLASSROOM 3	1090 SF
C108A	STORAGE	79 SF
C109	TOILET	136 SF
C110	CLASSROOM 4	1085 SF
C110A	STORAGE	73 SF
C111	CLASSROOM 5	1085 SF
C111A	STORAGE	73 SF
C112	TOILET	136 SF
C113	CLASSROOM 6	1089 SF
C113A	STORAGE	79 SF
C114	CLASSROOM 2	1089 SF
C114A	STORAGE	79 SF
C115	TOILET	136 SF
C116	CLASSROOM 1	1088 SF
C116A	STORAGE	73 SF
C117	MECHANICAL	771 SF
C118	IT CLOSET	123 SF
C119	MAINTENANCE	178 SF
C200	VESTIBULE	75 SF
C500	CORRIDOR	1838 SF
C540	CORRIDOR	272 SF
C550	CORRIDOR	1218 SF
C560	CORRIDOR	203 SF
C580	CORRIDOR	380 SF

### POWER PLAN GENERAL NOTES


- PROVIDE REVISED TYPED PANELBOARD DIRECTORIES FOR EACH PANELBOARD ADDED OR MODIFIED DURING CONSTRUCTION. FIELD VERIFY EXISTING CIRCUIT INFORMATION WITH OWNER'S ASSISTANCE TO ENSURE FINAL DIRECTORY IS ACCURATE. UNUSED SPARE BREAKERS SHALL BE IN THE OFF POSITION.
- VIDEO PROJECTOR RECEPTACLE TO BE MOUNTED ABOVE WALL MOUNTED PROJECTOR BRACKET, 36" AFF. UNO. CONTRACTOR SHALL VERIFY ALL DIMENSIONS AND CLEARANCES AND ALL EXISTING FIELD CONDITIONS BEFORE STARTING CONSTRUCTION. COMMENCEMENT OF WORK CONSTITUTES ACCEPTANCE OF CONDITIONS. SHOULD DIFFERENT CONDITIONS BE ENCOUNTERED, CONTACT THE ARCHITECT BEFORE PROCEEDING WITH WORK.
- LABEL EACH RECEPTACLE WITH THE PANEL NAME AND CIRCUIT NUMBER ON THE FACE OF EACH COVER PLATE WITH A TYPED LAMINATED LABEL.
- PROVIDE "GFCI PROTECTED" LABEL ON COVER PLATE FOR ANY GFCI PROTECTED DEVICE.
- CONTRACTOR SHALL INCREASE CIRCUIT CONDUCTOR SIZE TO COMPENSATE FOR VOLTAGE DROP DUE TO EXCESSIVE CIRCUIT LENGTHS. IN NO CASE SHALL VOLTAGE DROP EXCEED NFPA 70 (NEC) REQUIREMENTS.
- REFER TO MECHANICAL PLANS FOR LOCATION OF MECHANICAL EQUIPMENT. LOCATE DISCONNECT SWITCHES PER NEC.
- REFER TO "CONTROL SCHEMATICS" MECHANICAL DRAWINGS FOR ADDITIONAL CONTROL WIRING AND CONTROL CONNECTIONS.
- ALL DEVICES, EQUIPMENT, FIXTURES, AND THE LIKE, SHALL BE BONDED WITH A PROPERLY SIZED EQUIPMENT GROUNDING CONDUCTOR. MAINTAIN MECHANICAL/ELECTRICAL BONDS OF METALLIC RACEWAY SYSTEM.

### POWER PLAN NOTES

(ALL NOTES MAY NOT BE INDICATED ON THIS SHEET)


### SHEET KEYNOTES

- P1 DOOR LATCH POWER SUPPLY LOCATED ABOVE CEILING
- P3 PROVIDE FLOOR ANCHORED STRUT FOR RECEPTACLE
- P5 PROVIDE CONNECTION BETWEEN EACH EMERGENCY PUSH BUTTON (EPB), CONTACTOR, EMERGENCY GAS SHUTOFF VALVE (EGSV), AND BOILER POWER SOURCE AS SHOWN ON THE "EMERGENCY SHUTOFF" DETAIL ON SHEET "E-501"

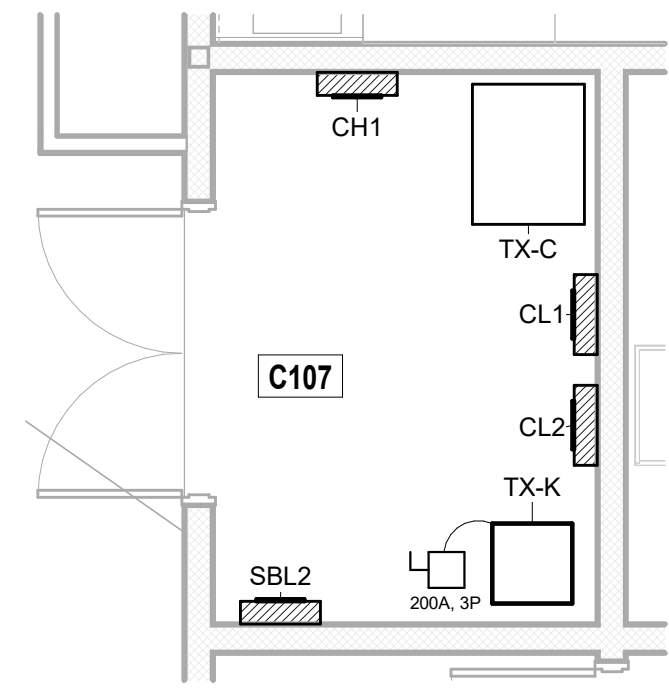

### ELECTRICAL ROOM - C107

SCALE: 1/4" = 1'-0"

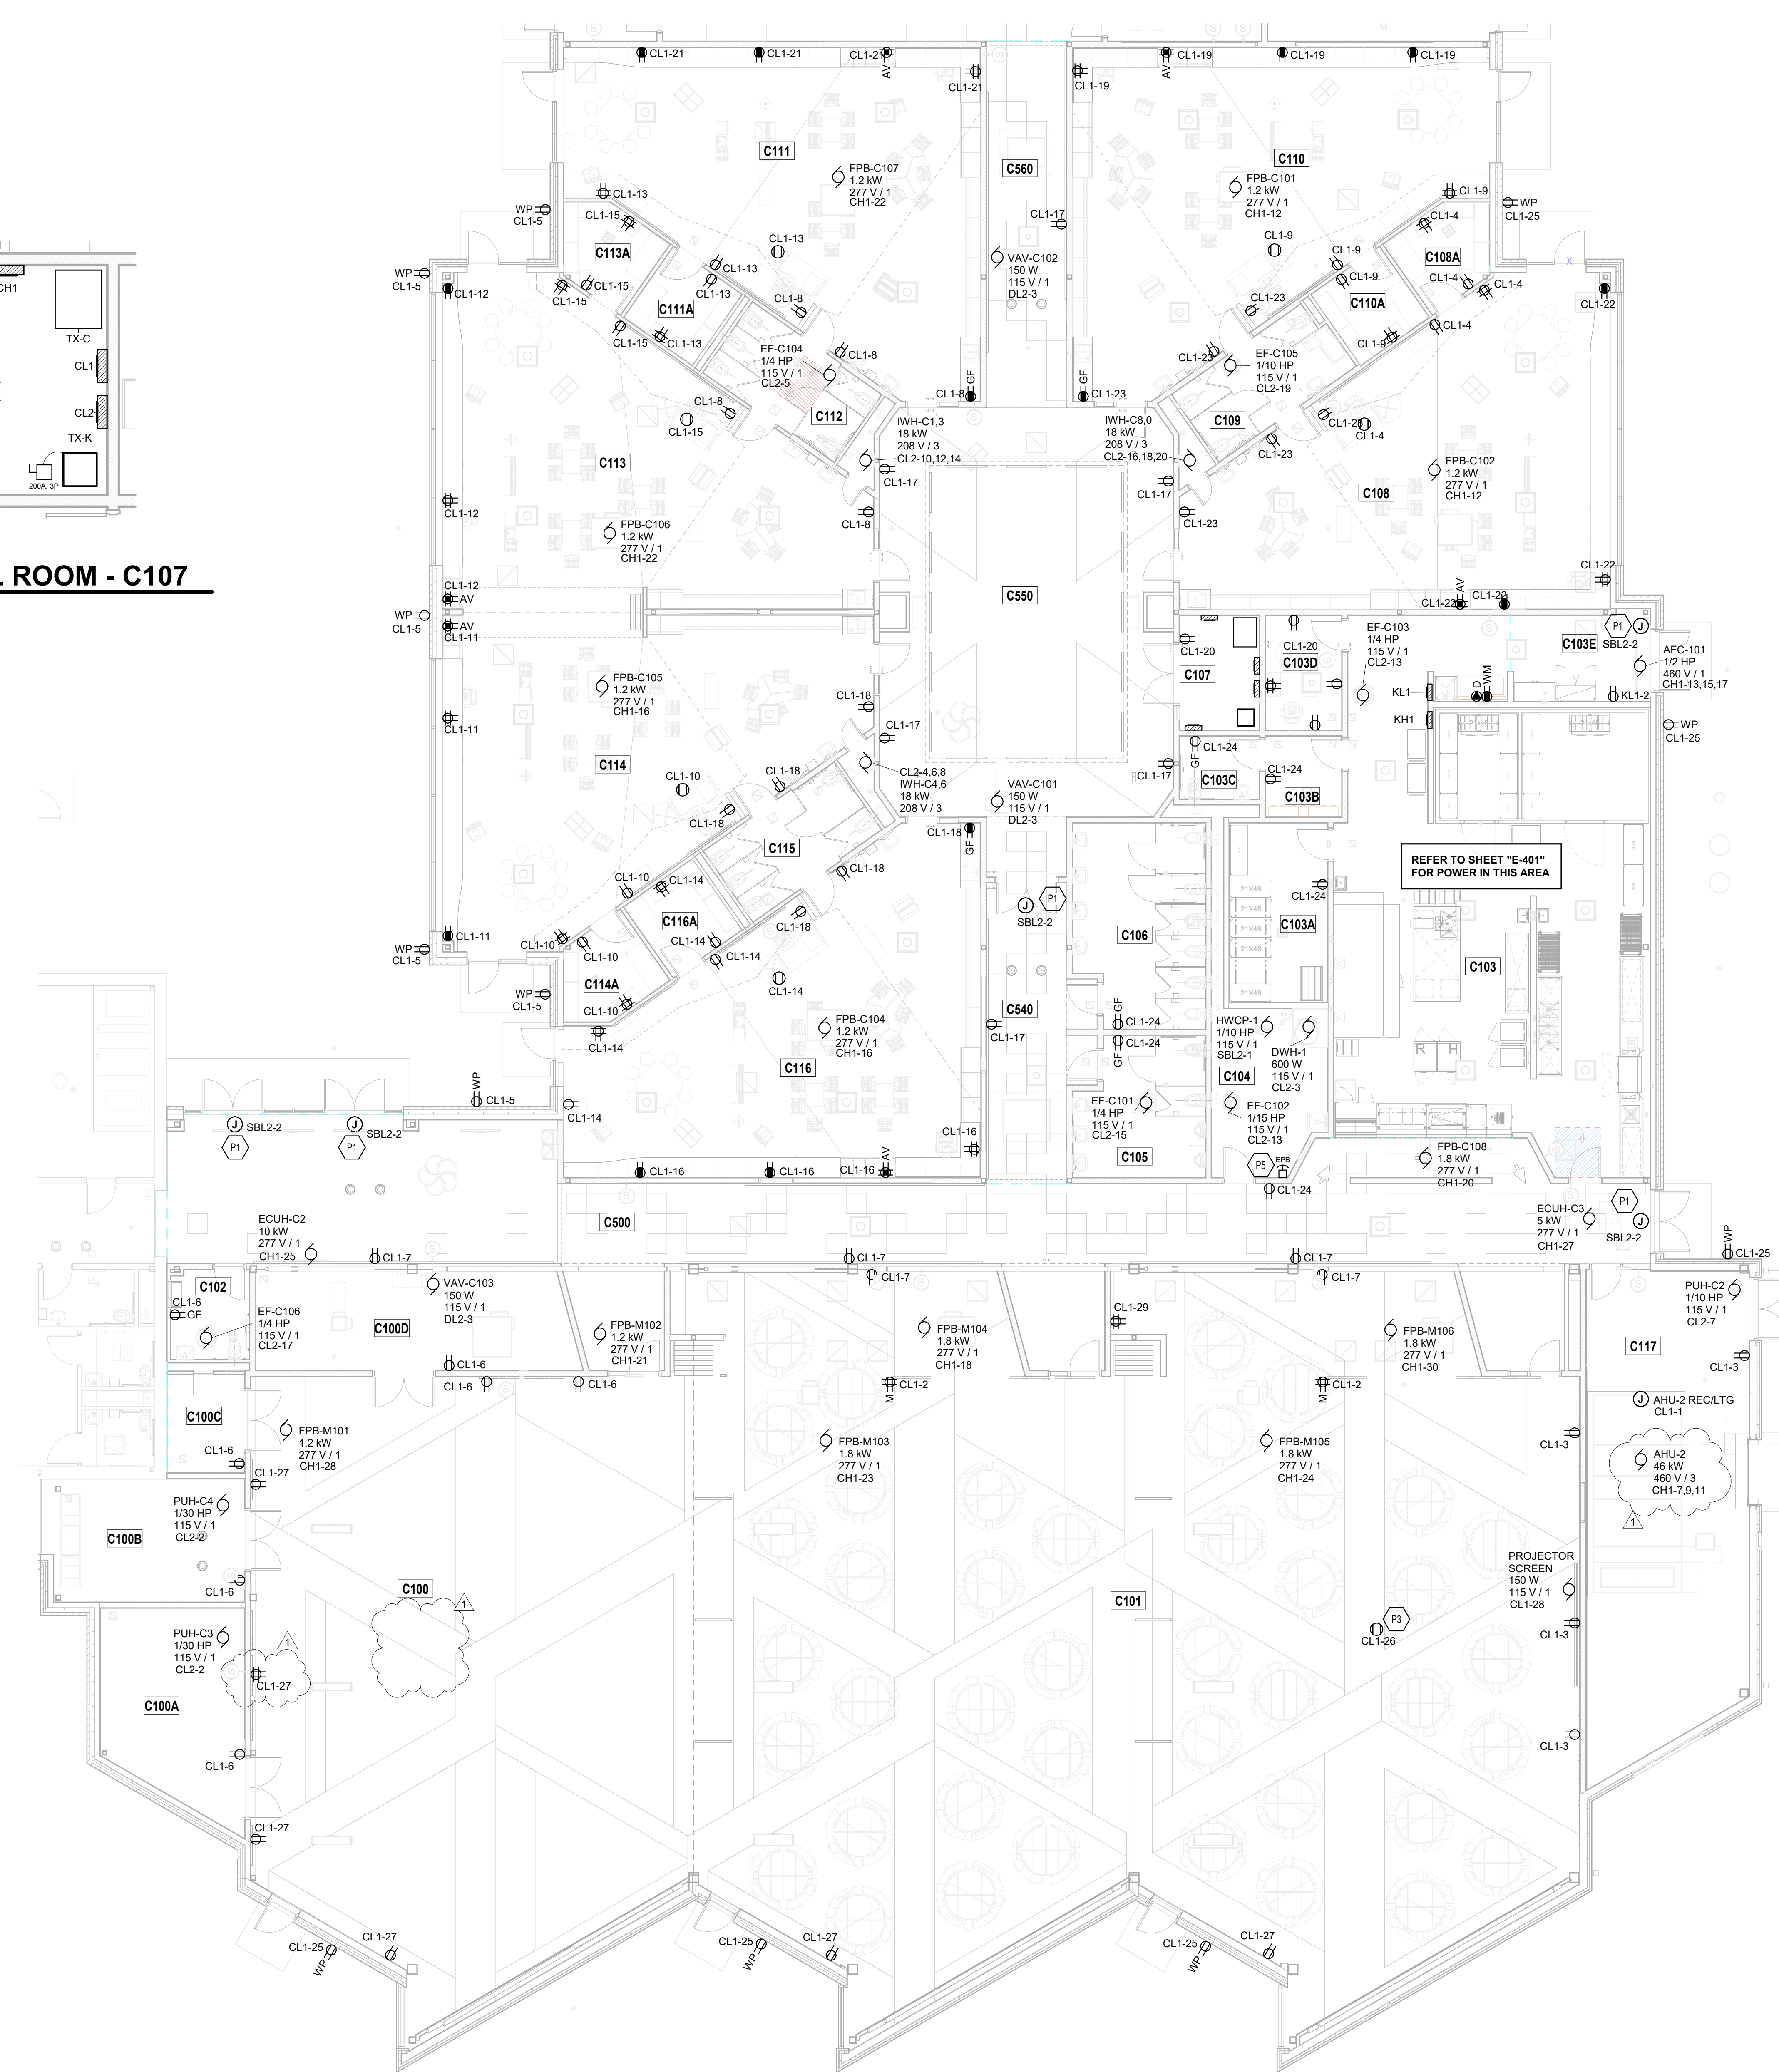

### FIRST FLOOR POWER PLAN - UNIT C

# NATHANIEL JONES EARLY LEARNING CENTER ADDITION & EXPANSION

7839 NEW AUGUSTA RD.  
INDIANAPOLIS, IN 46268


MSD OF PIKE TOWNSHIP




ARCHITECT

## FANNING HOWEY


317-848-0966 WWW.FHAI.COM  
390 E NEW YORK ST. SUITE 300, INDIANAPOLIS, IN 46204

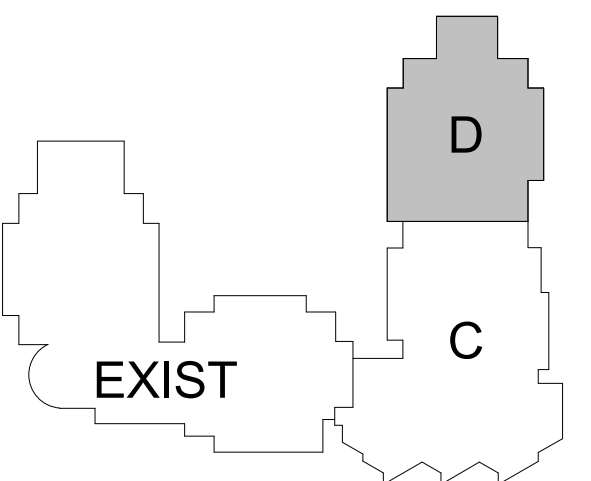

KEY PLAN

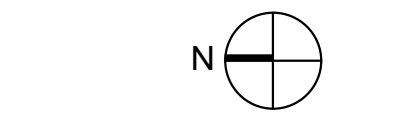

BID DOCUMENTS

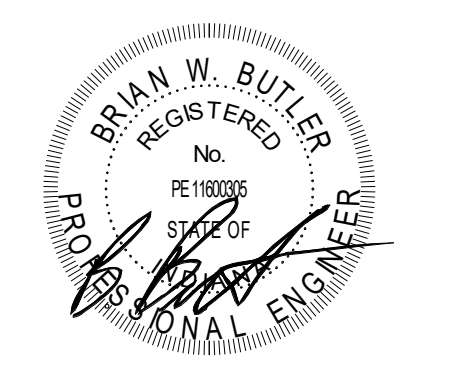

PROJECT MANAGER: PW  
DRAWN BY: ANE  
PROJECT NUMBER: 223216.00  
PROJECT ISSUE DATE: 03-13-2026

REV. NO.	DESCRIPTION	DATE
1	Addendum No. 3	03.30.26

FIRST FLOOR POWER PLAN - UNIT D

# EP11D


ROOM LEGEND		
ROOM NO.	ROOM NAME	AREA (SF)
C110	CLASSROOM 4	1086 SF
C111	CLASSROOM 5	1086 SF
C118	IT CLOSET	123 SF
C119	MAINTENANCE	178 SF
C200	VESTIBULE	76 SF
C560	CORRIDOR	293 SF
C580	CORRIDOR	380 SF
D101	CLASSROOM 7	1076 SF
D101A	STORAGE	73 SF
D102	TOILET	135 SF
D103	CLASSROOM 8	1089 SF
D103A	STORAGE	83 SF
D104	CLASSROOM 9	1089 SF
D104A	STORAGE	79 SF
D105	TOILET	136 SF
D106	CLASSROOM 10	1046 SF
D106A	STORAGE	73 SF
D107	CLASSROOM 11	1083 SF
D107A	STORAGE	73 SF
D108	TOILET	135 SF
D109	CLASSROOM 12	1089 SF
D109A	STORAGE	79 SF
D110	CLASSROOM 13	1089 SF
D110A	STORAGE	77 SF
D111	TOILET	136 SF
D112	CLASSROOM 14	1076 SF
D112A	STORAGE	73 SF
D113	ELECTRICAL	126 SF
D113A	EMERGENCY ELECTRICAL	17 SF
D114	MECHANICAL	961 SF
D540	CORRIDOR	259 SF
D550	CORRIDOR	1170 SF
D560	CORRIDOR	283 SF
D580	CORRIDOR	273 SF

- POWER PLAN GENERAL NOTES**
- PROVIDE REVISED TYPED PANELBOARD DIRECTORIES FOR EACH PANELBOARD ADDED OR MODIFIED DURING CONSTRUCTION. FIELD VERIFY EXISTING CIRCUIT INFORMATION WITH OWNER'S ASSISTANCE TO ENSURE FINAL DIRECTORY IS ACCURATE. UNUSED SPARE BREAKERS SHALL BE IN THE OFF POSITION.
  - VIDEO PROJECTOR RECEPTACLE TO BE MOUNTED ABOVE WALL MOUNTED PROJECTOR BRACKET, 36" A.F.F. UNO. CONTRACTOR SHALL VERIFY ALL DIMENSIONS AND CLEARANCES AND ALL EXISTING FIELD CONDITIONS BEFORE STARTING CONSTRUCTION. COMMENCEMENT OF WORK CONSTITUTES ACCEPTANCE OF CONDITIONS. SHOULD DIFFERENT CONDITIONS BE ENCOUNTERED, CONTACT THE ARCHITECT BEFORE PROCEEDING WITH WORK.
  - LABEL EACH RECEPTACLE WITH THE PANEL NAME AND CIRCUIT NUMBER ON THE FACE OF EACH COVER PLATE WITH A TYPED LAMINATED LABEL.
  - PROVIDE "GFCI PROTECTED" LABEL ON COVER PLATE FOR ANY GFCI PROTECTED DEVICE.
  - CONTRACTOR SHALL INCREASE CIRCUIT CONDUCTOR SIZE TO COMPENSATE FOR VOLTAGE DROP DUE TO EXCESSIVE CIRCUIT LENGTHS. IN NO CASE SHALL VOLTAGE DROP EXCEED NFPA 70 (IN C) REQUIREMENTS.
  - REFER TO MECHANICAL PLANS FOR LOCATION OF MECHANICAL EQUIPMENT. LOCATE DISCONNECT SWITCHES PER NEC.
  - REFER TO "CONTROL SCHEMATICS" MECHANICAL DRAWINGS FOR ADDITIONAL CONTROL WIRING AND CONTROL CONNECTIONS.
  - ALL DEVICES, EQUIPMENT, FIXTURES, AND THE LIKE, SHALL BE BONDED WITH A PROPERLY SIZED EQUIPMENT GROUNDING CONDUCTOR. MAINTAIN MECHANICAL/ELECTRICAL BONDS OF METALLIC RACEWAY SYSTEM.

**POWER PLAN NOTES**  
(ALL NOTES MAY NOT BE INDICATED ON THIS SHEET)


SHEET KEYNOTES	
P1	DOOR LATCH POWER SUPPLY LOCATED ABOVE CEILING.
P2	VARIABLE FREQUENCY CONTROLLERS PROVIDED BY DIVISION 23. DIVISION 26 TO PROVIDE WIRING BETWEEN PUMP AND CONTROLLERS AND BETWEEN MOTORS AND CONTROLLERS.
P3	PROVIDE FLOOR ANCHORED STRUT FOR RECEPTACLE.
P5	PROVIDE CONNECTION BETWEEN EACH EMERGENCY PUSH BUTTON (EPB), CONTACTOR, EMERGENCY GAS SHUTOFF VALVE (EGSOV), AND BOILER POWER SOURCE AS SHOWN ON THE "EMERGENCY SHUTOFF" DETAIL ON SHEET "E-501".

**VERIFICATION NOTE**  
CONTRACTOR SHALL VERIFY ALL DIMENSIONS AND CLEARANCES AND ALL EXISTING FIELD CONDITIONS BEFORE STARTING CONSTRUCTION. COMMENCEMENT OF WORK CONSTITUTES ACCEPTANCE OF CONDITIONS.  
SHOULD DIFFERENT CONDITIONS BE ENCOUNTERED, CONTACT THE ARCHITECT BEFORE PROCEEDING WITH WORK.

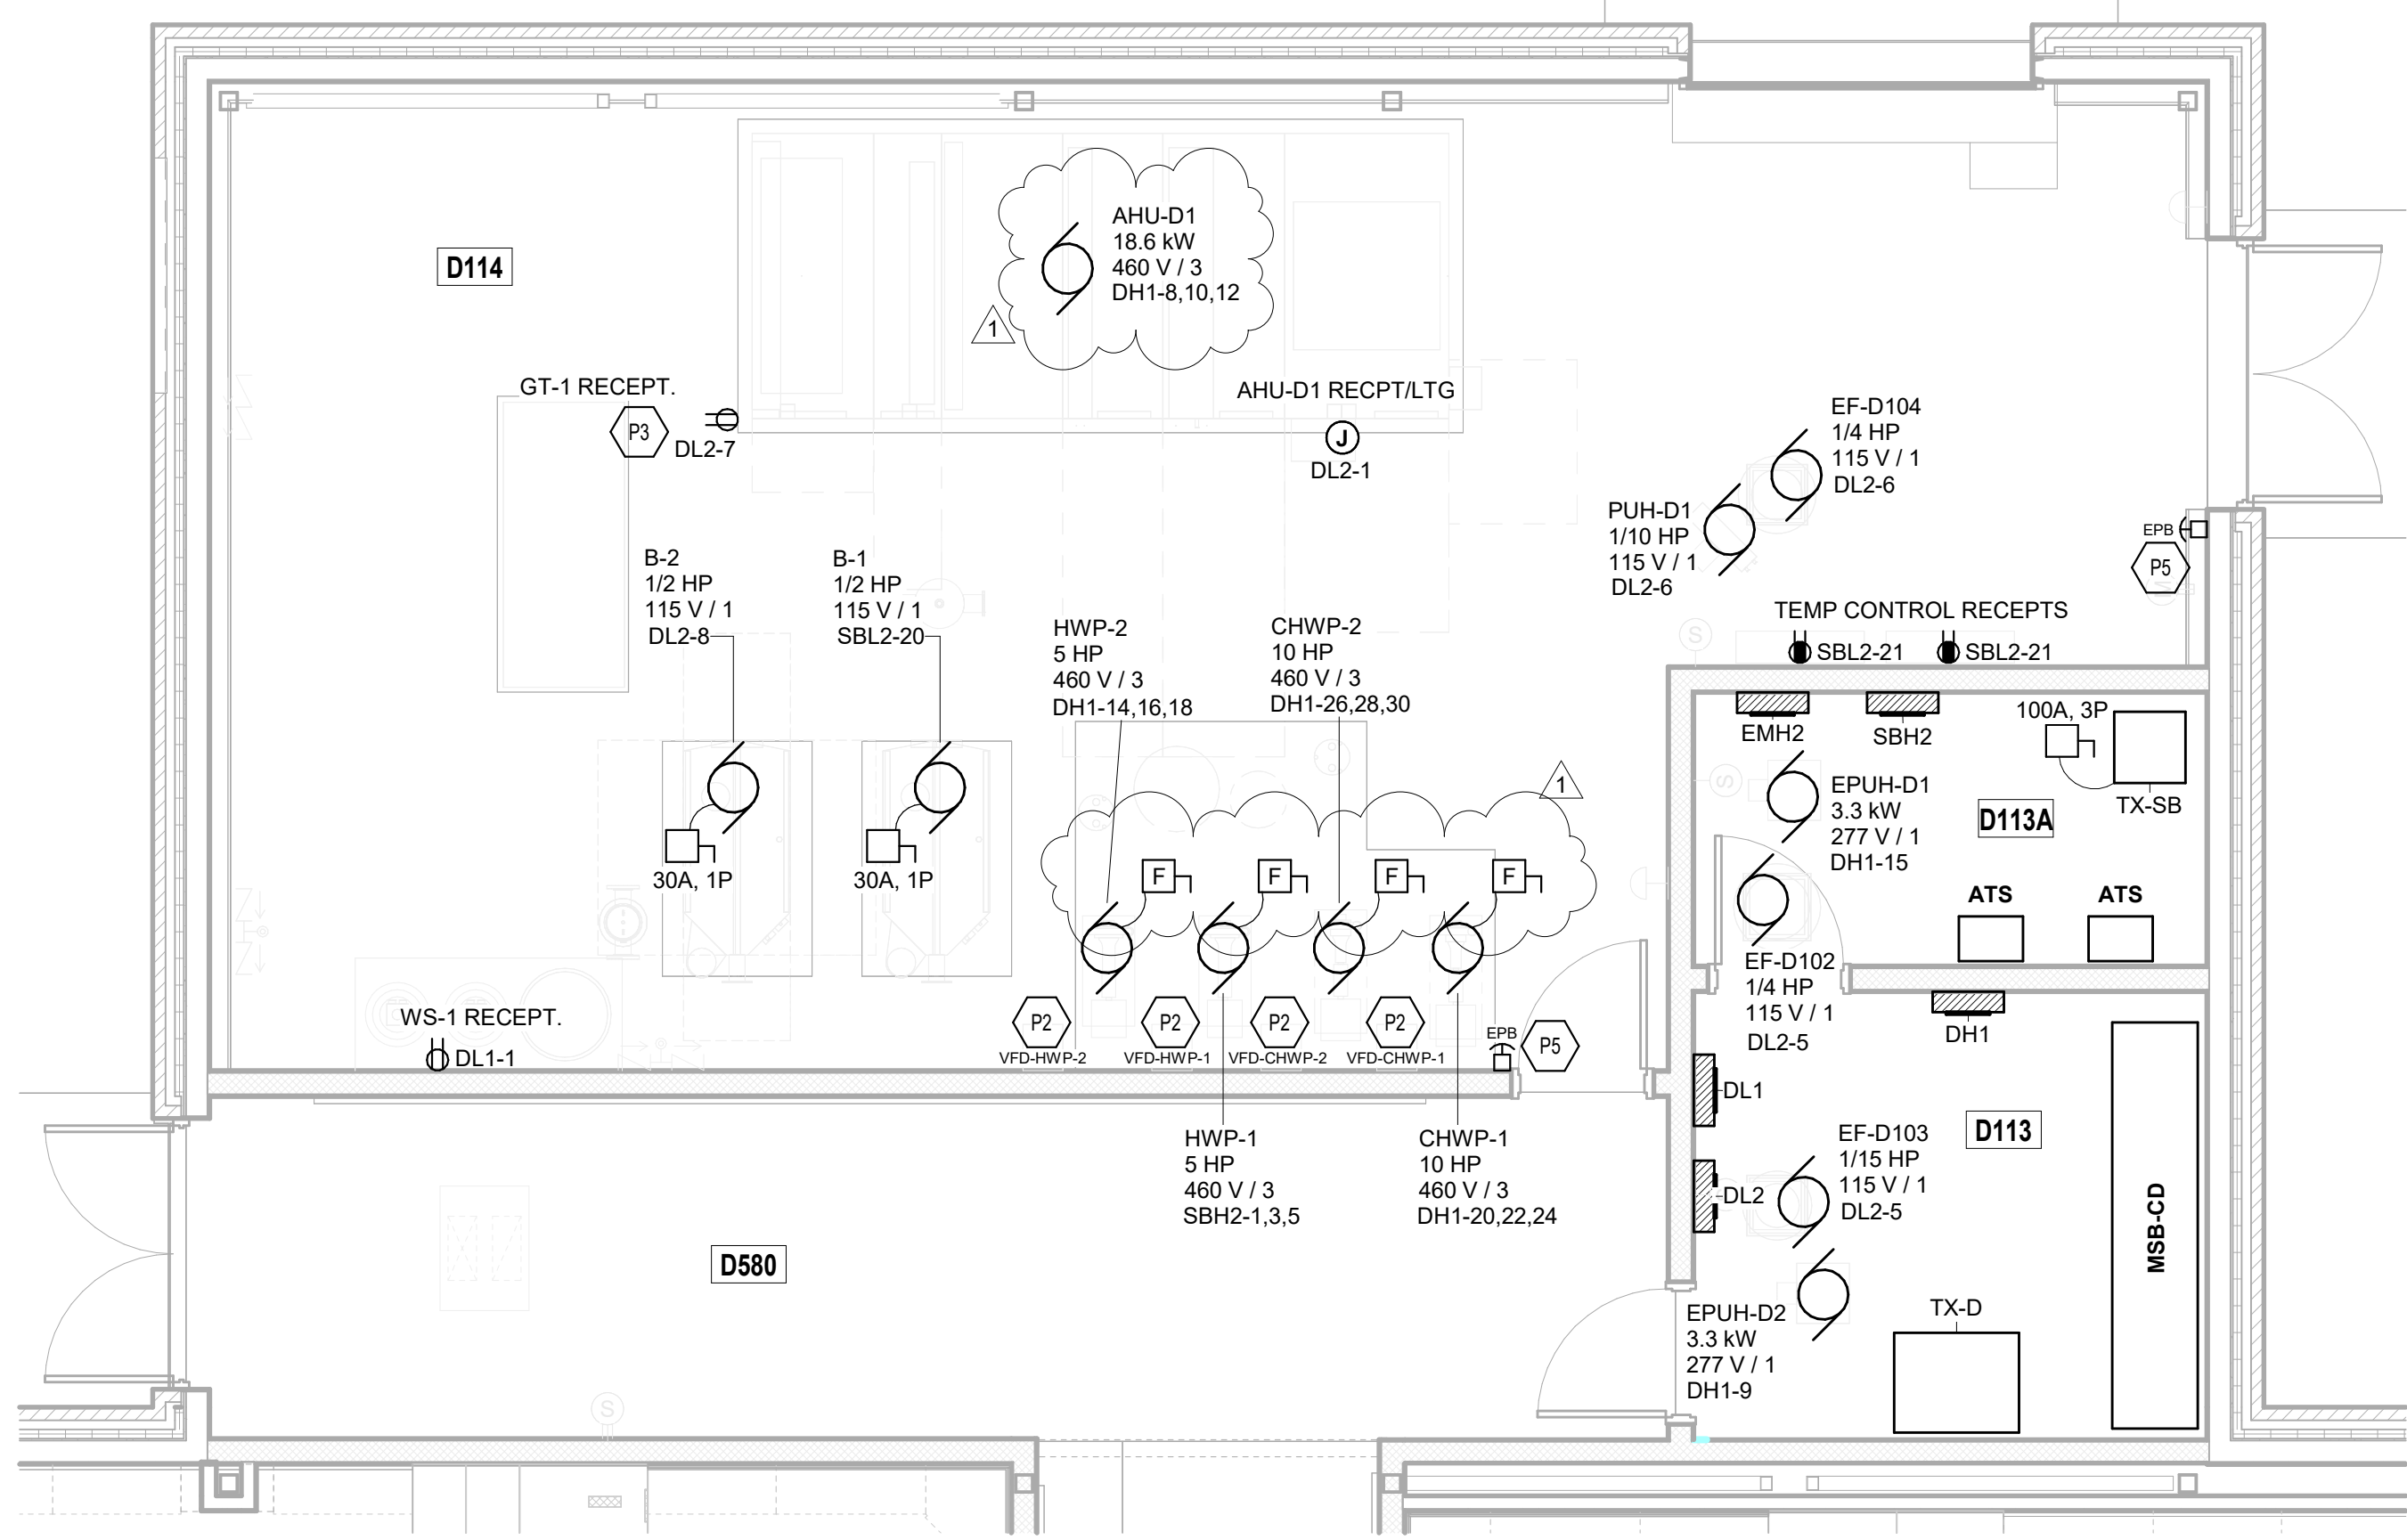

**MECHANICAL ROOM - D114**

SCALE: 1/4" = 1'-0"

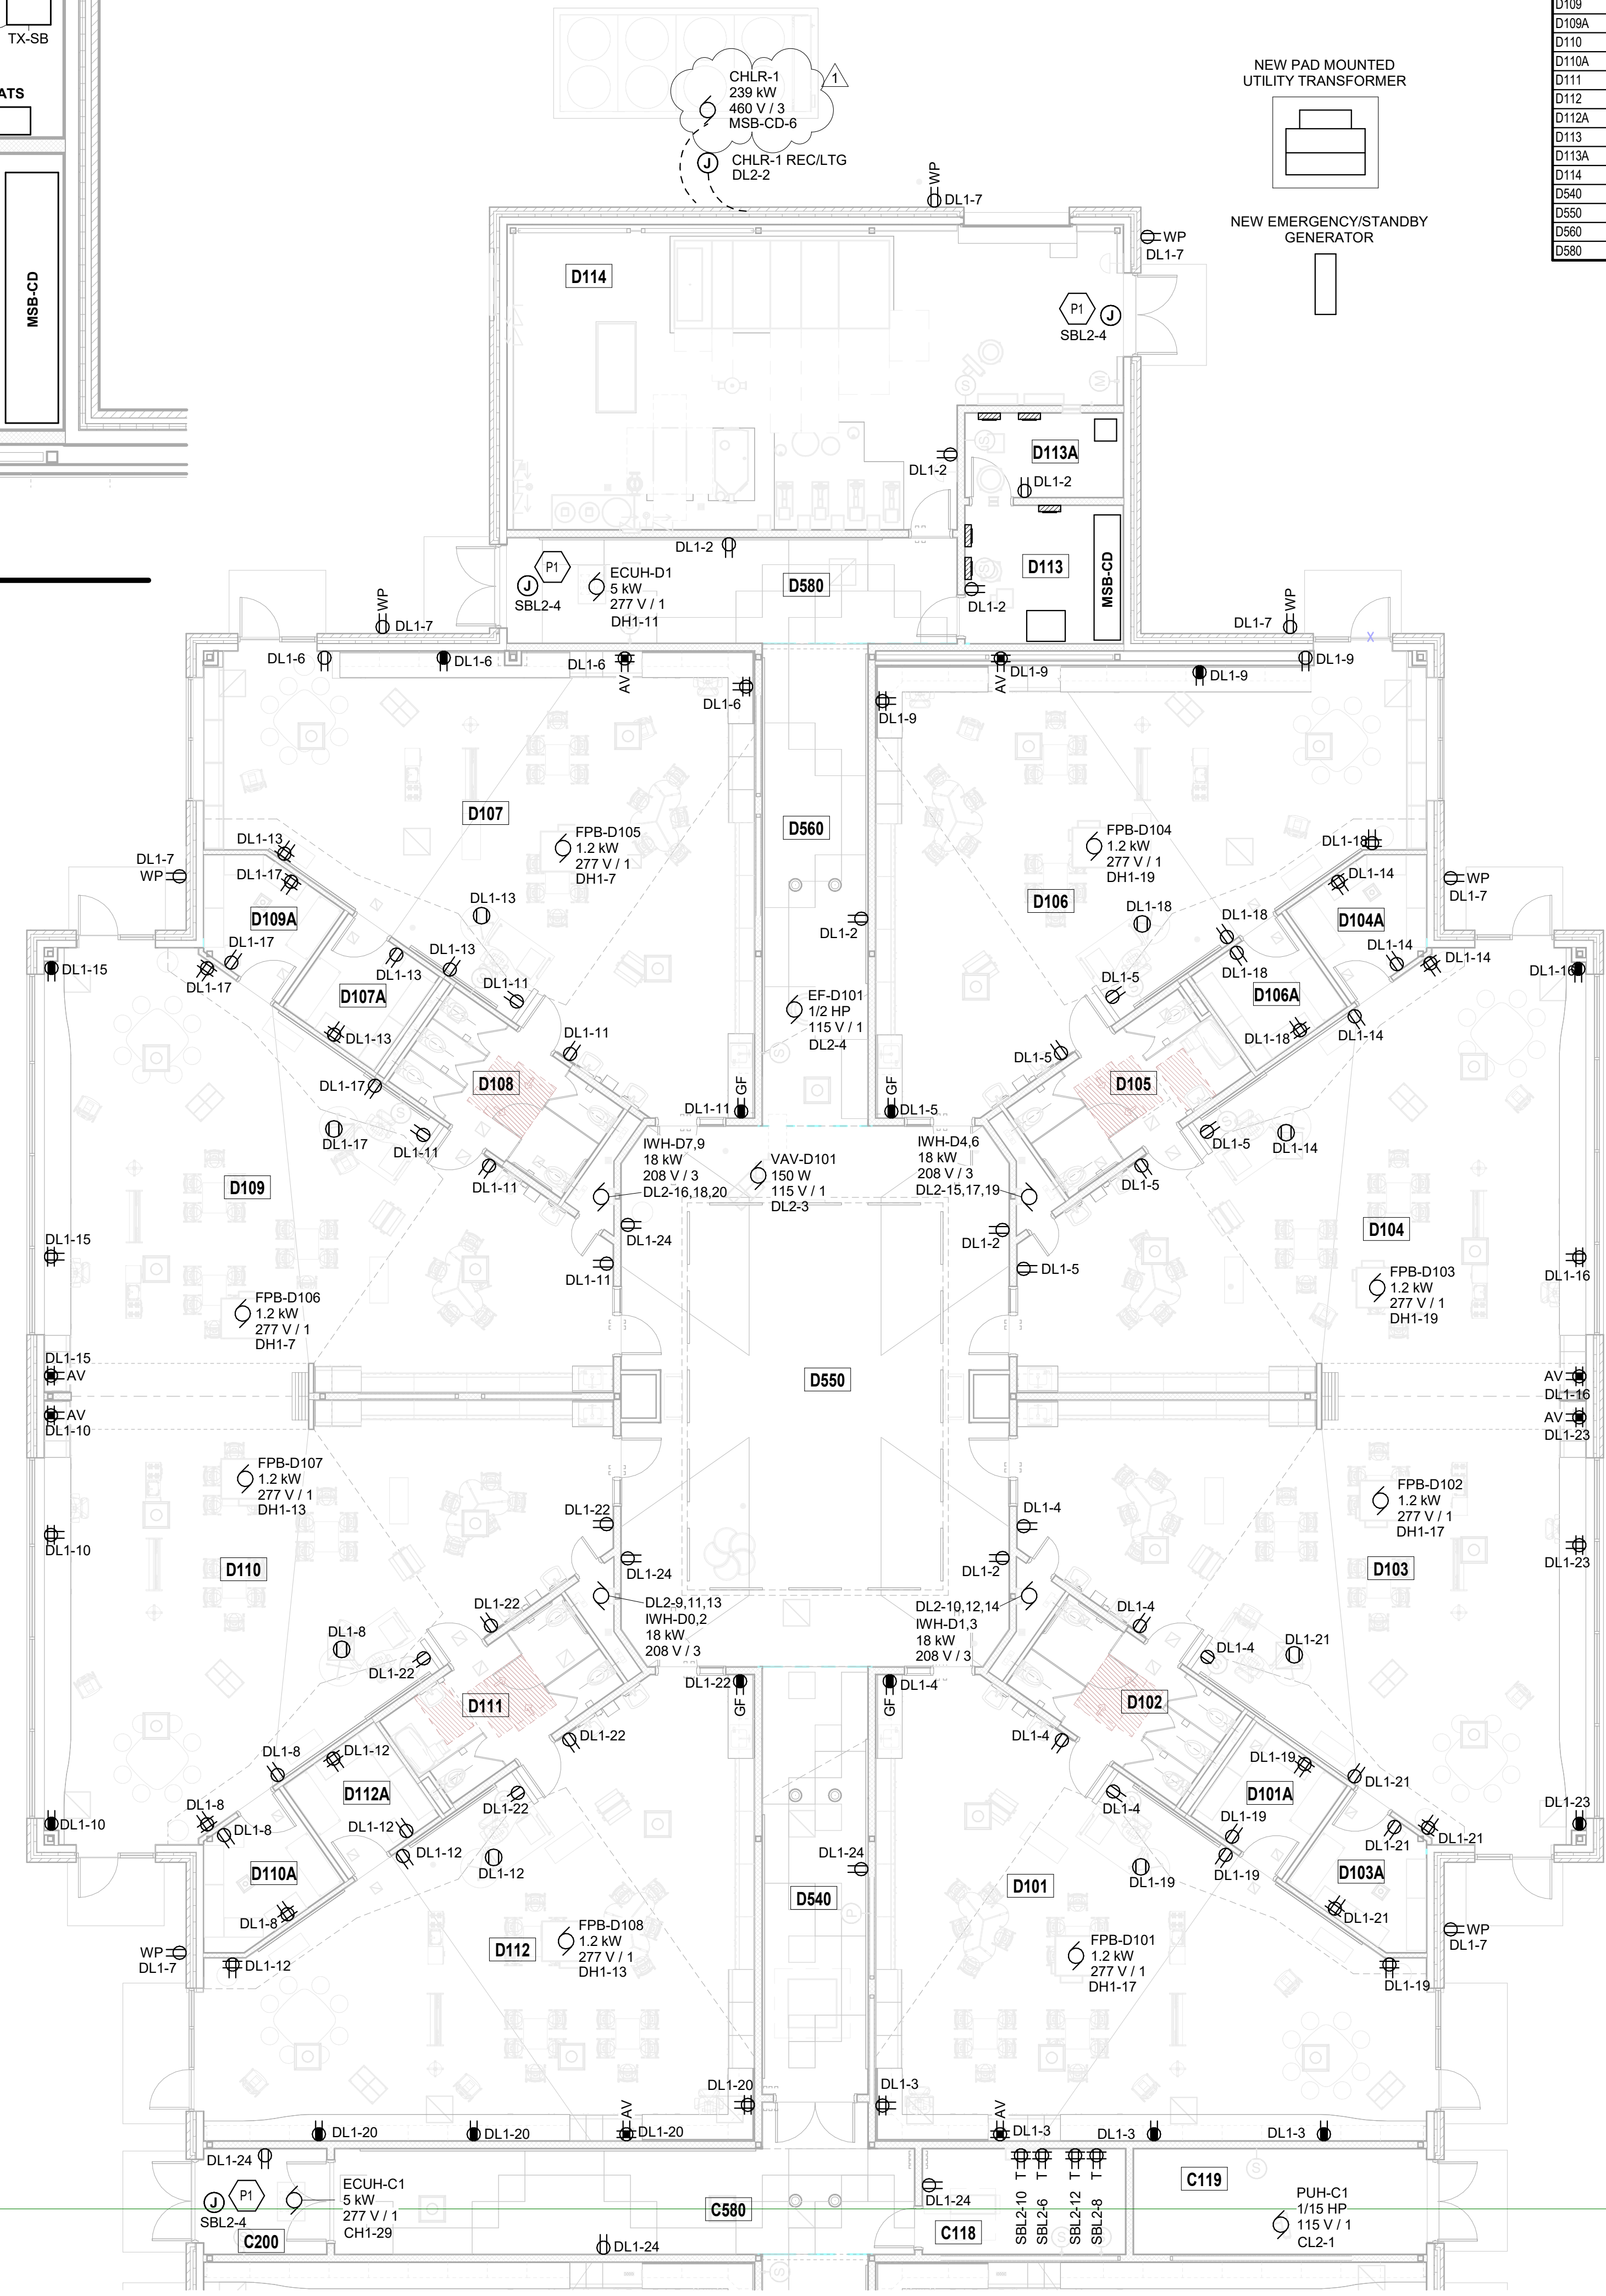

**FIRST FLOOR POWER PLAN - UNIT D**

# NATHANIEL JONES EARLY LEARNING CENTER ADDITION & EXPANSION

7839 NEW AUGUSTA RD.  
INDIANAPOLIS, IN 46268



MSD OF PIKE TOWNSHIP




ARCHITECT



317-848-0966 WWW.FHAI.COM  
390 E NEW YORK ST. SUITE 300, INDIANAPOLIS, IN 46204

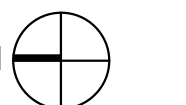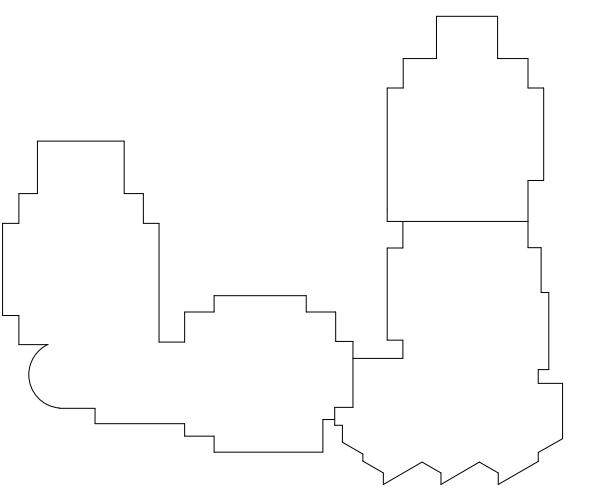

BID DOCUMENTS

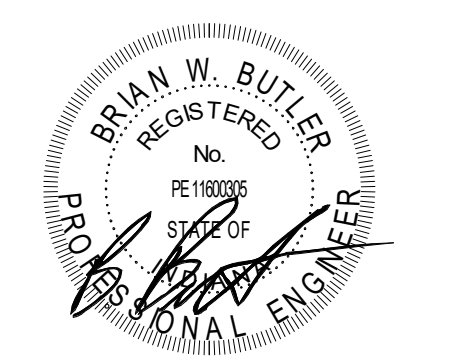

PROJECT MANAGER: PW  
DRAWN BY: ANE  
PROJECT NUMBER: 223216.00  
PROJECT ISSUE DATE: 03-13-2026

REV. NO.	DESCRIPTION	DATE
1	Addendum No. 3	03.30.26

LUMINAIRE SCHEDULE - GENERAL NOTES	
1.	ALL LAMPS LISTED IN SCHEDULE ARE SYLVANIA CATALOG NUMBERS. UNLESS OTHERWISE NOTED, EQUAL LAMPS BY MANUFACTURERS INDICATED IN SPECIFICATION SECTIONS 265600 ARE ACCEPTABLE.
2.	SEE SPECIFICATIONS FOR BALLAST REQUIREMENTS.
3.	FOR ALL DOWNLIGHTING FIXTURES, PROVIDE REQUIRED MOUNTING HARDWARE FOR MOUNTING IN LAY-IN TYPE CEILINGS.
4.	CONTRACTOR TO VERIFY TYPES AND QUANTITY OF LIGHT FIXTURES REQUIRING EMERGENCY TRANSFER DEVICES AND PROVIDE REQUIRED QUANTITY OF EMERGENCY TRANSFER DEVICES, LABOR, MATERIAL, ETC. IN THE PROJECT BID FOR FIELD INSTALLATION OF EMERGENCY TRANSFER DEVICES.
5.	LIGHT FIXTURE SUBMITTALS TO INCLUDE DATA SHEETS FOR ALL FIXTURE TYPES, INCLUDING ADDITIONAL DATA SHEETS FOR BALLAST COMBINATIONS REQUIRED TO MEET THE INSTALLATION REQUIREMENTS OF THE VARIOUS FIXTURE TYPES INDICATED IN THE REMARKS COLUMN OF THE FIXTURE SCHEDULES OR ON THE DRAWINGS. SUBMITTALS SHALL ALSO INDICATE COLOR FOR ANY CUSTOM COLOR LIGHT FIXTURES.

LUMINAIRE SCHEDULE

# E-601

PLAN TYPE	MANUFACTURER/CATALOG	MOUNTING	LUMPS					DESCRIPTION	VA LOAD
			NO.	WATTS	TYPE	LUMENS	APPLIED VOLTAGE		
LA2	LITHONIA BLT SERIES METALUX CRUZE ST SERIES COLUMBIA LCAT SERIES	RECESSED	1	38 W	LED	4000 lm	277 V	2 BY 4-FOOT CENTER LENS TROFFER, FROSTED ACRYLIC DIFFUSER, 80 CRI, 4000K CCT, 10% 0-10VDC DIMMING.	38 VA
LA2X	LITHONIA BLT SERIES METALUX CRUZE ST SERIES COLUMBIA LCAT SERIES	RECESSED	1	38 W	LED	4000 lm	277 V	2 BY 4-FOOT CENTER LENS TROFFER, FROSTED ACRYLIC DIFFUSER, 80 CRI, 4000K CCT, 10% 0-10VDC DIMMING, WITH EMERGENCY TRANSFER DEVICE.	38 VA
LD61	GOTHAM V06 SERIES PORTFOLIO LD6C SERIES PRESCOLITE LFR-6RD SERIES	RECESSED	1	22 W	LED	1500 lm	277 V	6-INCH APERTURE ROUND DOWNLIGHT, CLEAR SEMI-SPECULAR OPEN REFLECTOR, SELF-FLANGED WITH WHITE TRIM, WIDE DISTRIBUTION, 4000K CCT, 80+ CRI, 10% 0-10VDC DIMMING.	22 VA
LD61X	GOTHAM V06 SERIES PORTFOLIO LD6C SERIES PRESCOLITE LFR-6RD SERIES	RECESSED	1	22 W	LED	1500 lm	277 V	6-INCH APERTURE ROUND DOWNLIGHT, CLEAR SEMI-SPECULAR OPEN REFLECTOR, SELF-FLANGED WITH WHITE TRIM, WIDE DISTRIBUTION, 4000K CCT, 80+ CRI, 10% 0-10VDC DIMMING, WITH EMERGENCY TRANSFER DEVICE.	10 VA
LL6A	FRASH BEND 72 LIGHTING ELEMENTS ROUND LINE AC LUXE BOX DASCH	SUSPENDED	1	60 W	LED	6000 lm	277 V	72 INCH TUBE FIXTURE WITH ACOUSTICAL HOUSING, COLORS TO BE SELECTED BY ARCHITECT, 4000K CCT, 80+ CRI, 0-10VDC DIMMING	60 VA
LL8P	MARK SLOT 4 SERIES STARTEK BEAM SERIES LITECONTROL MOD 4L SERIES	PENDANT	1	32 W	LED	4000 lm	277 V	8-FOOT LENGTH 4-INCH LINEAR FIXTURE, FLUSH FROSTED ACRYLIC DIFFUSER, 500 LUMENS PER FOOT, 80 CRI, 4000K CCT, 10% 0-10VDC DIMMING. PROVIDE ALL MATERIALS NECESSARY FOR AIRCRAFT CABLE SUSPENSION.	32 VA
LPD61	GOTHAM EVO6 SERIES PORTFOLIO LER6C SERIES PRESCOLITE LTC-6RDW SERIES	PENDANT	1	25 W	LED	2500 lm	277 V	6-INCH APERTURE ROUND CYLINDER DOWNLIGHT, CLEAR SEMI-SPECULAR OPEN REFLECTOR, WHITE FINISH, MEDIUM DISTRIBUTION, 4000K CCT, 80+ CRI, 10% 0-10VDC DIMMING. INSTALL AS PENDANT WITH CONDUIT STEMS.	25 VA
LPD61X	GOTHAM EVO6 SERIES PORTFOLIO LER6C SERIES PRESCOLITE LTC-6RDW SERIES	PENDANT	1	25 W	LED	2500 lm	277 V	6-INCH APERTURE ROUND CYLINDER DOWNLIGHT, CLEAR SEMI-SPECULAR OPEN REFLECTOR, WHITE FINISH, MEDIUM DISTRIBUTION, 4000K CCT, 80+ CRI, 10% 0-10VDC DIMMING. INSTALL AS PENDANT WITH CONDUIT STEMS. PROVIDE WITH EMERGENCY TRANSFER DEVICE.	25 VA
LR2	LITHONIA SBL SERIES METALUX WNLED SERIED COLUMBIA LAW SERIES	SUSPENDED	1	37 W	LED	4000 lm	277 V	4-FOOT LED WRAP AROUND FIXTURE, ACRYLIC PRISMATIC DIFFUSER, 0-10VDC DIMMING. IF SUSPENDED, INSTALL AT 8-FOOT AFF WITH CONDUIT STEMS (UNO).	37 VA
LR2S	LITHONIA SBL SERIES METALUX WNLED SERIED COLUMBIA LAW SERIES	SURFACE	1	37 W	LED	4000 lm	277 V	4-FOOT LED WRAP AROUND FIXTURE, ACRYLIC PRISMATIC DIFFUSER, 0-10VDC DIMMING. IF SUSPENDED, INSTALL AT 8-FOOT AFF WITH CONDUIT STEMS (UNO).	37 VA
LR2SX	LITHONIA SBL SERIES METALUX WNLED SERIED COLUMBIA LAW SERIES	SURFACE	1	37 W	LED	4000 lm	277 V	4-FOOT LED WRAP AROUND FIXTURE, ACRYLIC PRISMATIC DIFFUSER, 0-10VDC DIMMING, WITH EMERGENCY TRANSFER DEVICE. IF SUSPENDED, INSTALL AT 8-FOOT AFF WITH CONDUIT STEMS (UNO).	37 VA
LR2X	LITHONIA SBL SERIES METALUX WNLED SERIED COLUMBIA LAW SERIES	SUSPENDED	1	37 W	LED	4000 lm	277 V	4-FOOT LED WRAP AROUND FIXTURE, ACRYLIC PRISMATIC DIFFUSER, 0-10VDC DIMMING, WITH EMERGENCY TRANSFER DEVICE. IF SUSPENDED, INSTALL AT 8-FOOT AFF WITH CONDUIT STEMS (UNO).	37 VA
LR4	LITHONIA SBL SERIES METALUX WNLED SERIED COLUMBIA LAW SERIES	SUSPENDED	1	60 W	LED	7000 lm	277 V	4-FOOT WRAP LED AROUND FIXTURE, ACRYLIC PRISMATIC DIFFUSER, 0-10VDC DIMMING. IF SUSPENDED, INSTALL AT 8-FOOT AFF WITH CONDUIT STEMS (UNO).	60 VA
LR4X	LITHONIA SBL SERIES METALUX WNLED SERIED COLUMBIA LAW SERIES	SUSPENDED	1	60 W	LED	7000 lm	277 V	4-FOOT WRAP LED AROUND FIXTURE, ACRYLIC PRISMATIC DIFFUSER, 0-10VDC DIMMING, WITH EMERGENCY TRANSFER DEVICE. IF SUSPENDED, INSTALL AT 8-FOOT AFF WITH CONDUIT STEMS (UNO).	60 VA
LS12	MARK SLOT 2 SERIES STARTEK SLIM BEAM SERIES LITECONTROL MOD 2L SERIES	RECESSED	1	48 W	LED	6000 lm	277 V	2-INCH LINEAR FIXTURE, 12-FOOT LENGTH, FLUSH FROSTED ACRYLIC DIFFUSER, 400 LUMENS PER FOOT, 80 CRI, 4000K CCT, 10% 0-10VDC DIMMING.	48 VA
LS12X	MARK SLOT 2 SERIES STARTEK SLIM BEAM SERIES LITECONTROL MOD 2L SERIES	RECESSED	1	48 W	LED	6000 lm	277 V	2-INCH LINEAR FIXTURE, 12-FOOT LENGTH, FLUSH FROSTED ACRYLIC DIFFUSER, 400 LUMENS PER FOOT, 80 CRI, 4000K CCT, 10% 0-10VDC DIMMING, WITH EMERGENCY TRANSFER DEVICE.	48 VA
LS15	MARK SLOT 2 SERIES STARTEK SLIM BEAM SERIES LITECONTROL MOD 2L SERIES	RECESSED	1	60 W	LED	7500 lm	277 V	2-INCH LINEAR FIXTURE, 15-FOOT LENGTH, FLUSH FROSTED ACRYLIC DIFFUSER, 400 LUMENS PER FOOT, 80 CRI, 4000K CCT, 10% 0-10VDC DIMMING.	60 VA
LS16	MARK SLOT 2 SERIES STARTEK SLIM BEAM SERIES LITECONTROL MOD 2L SERIES	RECESSED	1	64 W	LED	8000 lm	277 V	2-INCH LINEAR FIXTURE, 16-FOOT LENGTH, FLUSH FROSTED ACRYLIC DIFFUSER, 400 LUMENS PER FOOT, 80 CRI, 4000K CCT, 10% 0-10VDC DIMMING.	64 VA
SL2	LITHONIA DSX2 SERIES MCGRAW-EDISON GLEON SERIES BEACON VP2 SERIES	25'-0" POLE	1	135 W	LED	18000 lm	277 V	FULL CUT-OFF AREA LUMINAIRE, SINGLE FIXTURE, TYPE 2 DISTRIBUTION, RECTANGULAR HOUSING, SQUARE POLE ARM MOUNT, CONFIRM OPTICS WITH ENGINEER (P1, S4A, OR 160L-135), 75+ CRI, 4000K CCT, 0-10VDC DIMMING. PROVIDE 25-FOOT TALL 4-INCH SQUARE STRAIGHT STEEL POLE WITH VIBRATION DAMPENER, HANDHOLE, AND BASE COVERS FROM SAME MANUFACTURER AS LUMINAIRE. LUMINAIRE, POLE, AND MOUNTING ACCESSORIES SHALL BE DARK BRONZE IN COLOR. REFER TO SPECIFICATION SECTION 26 56 00 AND DETAILS ON "E-500" SERIES DRAWINGS FOR ADDITIONAL INFORMATION.	135 VA
SL3	LITHONIA DSX2 SERIES MCGRAW-EDISON GLEON SERIES BEACON VP2 SERIES	25'-0" POLE	1	135 W	LED	18000 lm	277 V	FULL CUT-OFF AREA LUMINAIRE, SINGLE FIXTURE, TYPE 3 DISTRIBUTION, RECTANGULAR HOUSING, SQUARE POLE ARM MOUNT, CONFIRM OPTICS WITH ENGINEER (P1, S4A, OR 160L-135), 75+ CRI, 4000K CCT, 0-10VDC DIMMING. PROVIDE 25-FOOT TALL 4-INCH SQUARE STRAIGHT STEEL POLE WITH VIBRATION DAMPENER, HANDHOLE, AND BASE COVERS FROM SAME MANUFACTURER AS LUMINAIRE. LUMINAIRE, POLE, AND MOUNTING ACCESSORIES SHALL BE DARK BRONZE IN COLOR. REFER TO SPECIFICATION SECTION 26 56 00 AND DETAILS ON "E-500" SERIES DRAWINGS FOR ADDITIONAL INFORMATION.	135 VA
SL3A	LITHONIA DSX2 SERIES MCGRAW-EDISON GLEON SERIES BEACON VP2 SERIES	25'-0" POLE	1	179 W	LED	24000 lm	277 V	FULL CUT-OFF AREA LUMINAIRE, SINGLE FIXTURE, TYPE 3 DISTRIBUTION, RECTANGULAR HOUSING, SQUARE POLE ARM MOUNT, CONFIRM OPTICS WITH ENGINEER (P2, S4B, OR 320L-170), 75+ CRI, 4000K CCT, 0-10VDC DIMMING. PROVIDE 25-FOOT TALL 4-INCH SQUARE STRAIGHT STEEL POLE WITH VIBRATION DAMPENER, HANDHOLE, AND BASE COVERS FROM SAME MANUFACTURER AS LUMINAIRE. LUMINAIRE, POLE, AND MOUNTING ACCESSORIES SHALL BE DARK BRONZE IN COLOR. REFER TO SPECIFICATION SECTION 26 56 00 AND DETAILS ON "E-500" SERIES DRAWINGS FOR ADDITIONAL INFORMATION.	179 VA
SL4	LITHONIA DSX2 SERIES MCGRAW-EDISON GLEON SERIES BEACON VP2 SERIES	25'-0" POLE	1	135 W	LED	18000 lm	277 V	FULL CUT-OFF AREA LUMINAIRE, SINGLE FIXTURE, TYPE 4 DISTRIBUTION, RECTANGULAR HOUSING, SQUARE POLE ARM MOUNT, CONFIRM OPTICS WITH ENGINEER (P1, S4A, OR 160L-135), 75+ CRI, 4000K CCT, 0-10VDC DIMMING. PROVIDE 25-FOOT TALL 4-INCH SQUARE STRAIGHT STEEL POLE WITH VIBRATION DAMPENER, HANDHOLE, AND BASE COVERS FROM SAME MANUFACTURER AS LUMINAIRE. LUMINAIRE, POLE, AND MOUNTING ACCESSORIES SHALL BE DARK BRONZE IN COLOR. REFER TO SPECIFICATION SECTION 26 56 00 AND DETAILS ON "E-500" SERIES DRAWINGS FOR ADDITIONAL INFORMATION.	135 VA
W-1X	LITHONIA WDGE2 SERIES MCGRAW-EDISON IMPACT ELITE SERIES BEACON GEOPACK 1 SERIES HUBBELL AIRO SERIES	SURFACE	1	20 W	LED	1200 lm	277 V	TRAPEZOIDAL WALL LUMINAIRE, FORWARD THROW DISTRIBUTION, CONFIRM OPTICS WITH ENGINEER (P2, SA1A, OR 24L-15), DARK BRONZE HOUSING, 75+ CRI, 4000K CCT, 0-10VDC DIMMING, IP65 RATED FOR WET LOCATIONS.	20 VA
WL6	BARBICAN WAVE INCLUDED IN FIXTURE ALLOWANCE	SUSPENDED	1	288 W	LED	4000 lm	277 V	FOUR SECTION "WAVE" LIGHT COMPRISED OF CONCAVE AND CONVEX LIGHTS. EACH SECTION IS 6" HIGH AND 6" WIDE WITH A CURVATURE RADIUS OF 90" FROM CENTER AND IS A 1/8 ARC. 0-10VDC DIMMING, 12W PER FOOT, 100 LM PER WATT. INCLUDED IN FIXTURE ALLOWANCE.	288 VA
XC	SURE-LITES CX SERIES CHLORIDE 55 LINE SERIES LITHONIA SIGNATURE SERIES DUAL-LITE SEMPRAS SERIES OR A/E APPROVED EQUAL	SURFACE CEILING	1	3 W	RED LED	0 lm	277 V	CAST ALUMINUM AC ONLY EXIT SIGN, SINGLE FACE, DIRECTIONAL ARROWS INDICATED, WHITE HOUSING. REFER TO PROJECT MANUAL FOR ADDITIONAL REQUIREMENTS.	3 VA
XC2	SURE-LITES CX SERIES CHLORIDE 55 LINE SERIES LITHONIA SIGNATURE SERIES DUAL-LITE SEMPRAS SERIES OR A/E APPROVED EQUAL	SURFACE CEILING	1	3 W	RED LED	0 lm	277 V	CAST ALUMINUM AC ONLY EXIT SIGN, DOUBLE FACE, DIRECTIONAL ARROWS INDICATED, WHITE HOUSING. REFER TO PROJECT MANUAL FOR ADDITIONAL REQUIREMENTS.	3 VA
XW	SURE-LITES CX SERIES CHLORIDE 55 LINE SERIES LITHONIA SIGNATURE SERIES DUAL-LITE SEMPRAS SERIES	SURFACE WALL	1	3 W	RED LED	0 lm	277 V	CAST ALUMINUM AC ONLY EXIT SIGN, SINGLE FACE, DIRECTIONAL ARROWS INDICATED, WHITE HOUSING. REFER TO PROJECT MANUAL FOR ADDITIONAL REQUIREMENTS.	3 VA
XWS	SURE-LITES CX SERIES CHLORIDE 55 LINE SERIES LITHONIA SIGNATURE SERIES DUAL-LITE SEMPRAS SERIES	SURFACE WALL, SIDE MTD.	1	3 W	RED LED	0 lm	277 V	CAST ALUMINUM AC ONLY EXIT SIGN, SINGLE FACE, DIRECTIONAL ARROWS INDICATED, WHITE HOUSING. REFER TO PROJECT MANUAL FOR ADDITIONAL REQUIREMENTS.	3 VA

**NATHANIEL JONES  
EARLY LEARNING  
CENTER ADDITION  
& EXPANSION**

7839 NEW AUGUSTA RD,  
INDIANAPOLIS, IN 46268



MSD OF PIKE TOWNSHIP




ARCHITECT



317-848-0966 WWW.FHAI.COM  
390 E NEW YORK ST, SUITE 300, INDIANAPOLIS, IN 46204

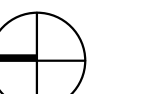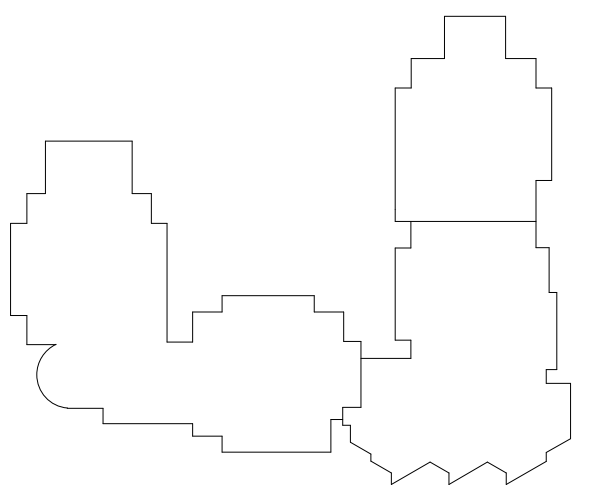

BID DOCUMENTS

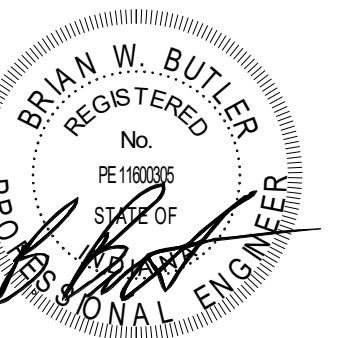

PROJECT MANAGER: PW  
DRAWN BY: ANE  
PROJECT NUMBER: 223216.00  
PROJECT ISSUE DATE: 03-13-2026

REV. NO.	DESCRIPTION	DATE
1	Addendum No. 3	03.30.26

PANELBOARD SCHEDULES - UNIT D

**E-602**

**Switchboard: MSB-CD**

Location: ELECTRICAL D113  
Supply From: MCB  
Mounting: Surface  
Enclosure: Type 1

Volts: 480/277 Wye  
Phases: 3  
Wires: 4

A.I.C. Rating: 22,000 A  
Mains Type: MCB  
Mains Rating: 1200 A  
MCB Rating: 1200 A

Notes:

CKT	Circuit Description	# of Poles	Frame Size	Trip Rating	Load	Remarks
1	CH1	3	400 A	400 A	181838 VA	
2	DH1	3	400 A	400 A	177846 VA	
3	KH1	3	200 A	200 A	92976 VA	
4	EMH2	3	100 A	100 A	3235 VA	
5	SBH2	3	100 A	100 A	6320 VA	
6	CHLR-1	3	400 A	350 A	239000 VA	ADJUSTABLE ELECTRONIC TRIP
7	Spare	1	200 A	200 A	0 VA	
8	Spare	1	200 A	200 A	0 VA	
9						
10						
11						
12						
					<b>Total Conn. Load:</b> 701215 VA	
					<b>Total Amps:</b> 843 A	

Legend:

Load Classification	Connected Load	Demand Factor	Estimated Demand	Panel Totals
Motor	53546 VA	111.17%	594796 VA	
Other	87316 VA	100.00%	87316 VA	<b>Total Conn. Load:</b> 701215 VA
Transformer	0 VA	0.00%	0 VA	<b>Total Est. Demand:</b> 752854 VA
Lighting	18533 VA	125.00%	23166 VA	<b>Total Conn.:</b> 843 A
Receptacle - Convenience	54720 VA	80.00%	43776 VA	<b>Total Est. Demand:</b> 906 A
Receptacle - Washing Machine	1200 VA	60.00%	720 VA	
Receptacle - Dryer	4400 VA	70.00%	3080 VA	

Notes:

**Branch Panel: DH1**

Location: ELECTRICAL D113  
Supply From: MSB-CD  
Mounting: Surface  
Enclosure: Type 1

Volts: 480/277 Wye  
Phases: 3  
Wires: 4

A.I.C. Rating: 18,000 A  
Mains Type: MCB  
Mains Rating: 400 A  
MCB Rating: 400 A

Notes:

CKT	Circuit Description	Trip	Poles	A	B	C	Poles	Trip	Circuit Description	CKT
1	LTG RM D101-106	20 A	1	1844...	3436...				TX-D	2
2	LTG RM D107-112	20 A	1		1844...	3406...				4
3	LTG RM C580, C118-119, D540-D580, D114	20 A	1			1692...	3464...			6
4	FPB D1056	15 A	1	2400...	6200...				3 40 A AHU-D1 - Note 1	8
5	EPUH-D2	20 A	1			3300...	6200...			10
6	ECUH-D1	20 A	1			5000...	6200...			12
7	FPB D1078	15 A	1	2400...	2107...				3 20 A HWP-2 - Note 2	14
8	EPUH-D1	20 A	1			3300...	2107...			16
9	FPB D1012	15 A	1			2400...	2107...			18
10	FPB D1034	15 A	1	2400...	3880...				3 20 A CHWP-1 - Note 2	20
11	Spare	20 A	1			0 VA	3880...			22
12	Spare	20 A	1			0 VA	3880...			24
13	Spare	20 A	1	0 VA	3880...				3 20 A CHWP-2 - Note 2	26
14	Spare	20 A	1			0 VA	3880...			28
15	Spare	20 A	1	0 VA	0 VA				1 20 A Spare	30
16	Spare	20 A	1	0 VA	0 VA				1 20 A Spare	32
17	Spare	20 A	1	0 VA	0 VA				1 20 A Spare	34
18	Spare	20 A	1	0 VA	0 VA				1 20 A Spare	36
19	Spare	20 A	1	0 VA	0 VA				1 20 A Spare	38
20	Spare	20 A	1	0 VA	0 VA				1 20 A Spare	40
21	Spare	20 A	1			0 VA	0 VA		1 20 A Spare	42
					<b>Total Load:</b> 59471 VA	<b>Total Amps:</b> 215 A	211 A	216 A		

Legend:

Load Classification	Connected Load	Demand Factor	Estimated Demand	Panel Totals
Motor	146006 VA	103.18%	150566 VA	
Other	0 VA	0.00%	0 VA	<b>Total Conn. Load:</b> 177846 VA
Lighting	5380 VA	125.00%	6725 VA	<b>Total Est. Demand:</b> 178549 VA
Receptacle - Convenience	26460 VA	80.00%	21168 VA	<b>Total Conn.:</b> 214 A
				<b>Total Est. Demand:</b> 215 A

Notes:

1 - 3 #8, #10 G in 3/4 C  
2 - 3 #12, #12 G in 3/4 C

**Branch Panel: DL1**

Location: ELECTRICAL D113  
Supply From: TX-D  
Mounting: Surface  
Enclosure: Type 1

Volts: 120/208 Wye  
Phases: 3  
Wires: 4

A.I.C. Rating: 65,000 A  
Mains Type: MCB  
Mains Rating: 200 A  
MCB Rating: 200 A

Notes:

CKT	Circuit Description	Trip	Poles	A	B	C	Poles	Trip	Circuit Description	CKT
1	WS-1 RECEPT	20 A	1	180 VA	1260...				RECEPT UNIT D CORRIDORS	2
2	RECEPT RM D101	20 A	1		1080...	1080...			RECEPT RM D103,101	4
3	RECEPT RM D106,104	20 A	1			1080...	1080...		RECEPT RM D107	6
4	EXT. RECEPT UNIT D - Note 1	20 A	1	1440...	1260...				RECEPT RM D110	8
5	RECEPT RM D106	20 A	1		1080...	900 VA			RECEPT RM D110	10
6	RECEPT RM D109,107	20 A	1		1080...	1260...			RECEPT RM D112	12
7	RECEPT RM D107	20 A	1	1260...	1260...				RECEPT RM D104	14
8	RECEPT RM D109	20 A	1		900 VA	900 VA			RECEPT RM D104	16
9	RECEPT RM D109	20 A	1		1260...	1260...			RECEPT RM D106	18
10	RECEPT RM D101	20 A	1	1260...	1080...				RECEPT RM D112	20
11	RECEPT RM D103	20 A	1		1260...	1080...			RECEPT RM D112,110	22
12	RECEPT RM D103	20 A	1			900 VA	1080...		RECEPT UNIT D CORRIDORS	24
13	Spare	20 A	1	0 VA	0 VA				Spare	26
14	Spare	20 A	1	0 VA	0 VA				Spare	28
15	Spare	20 A	1	0 VA	0 VA				Spare	30
16	Spare	20 A	1	0 VA	0 VA				Spare	32
17	Spare	20 A	1	0 VA	0 VA				Spare	34
18	Spare	20 A	1	0 VA	0 VA				Spare	36
19	Spare	20 A	1	0 VA	0 VA				Spare	38
20	Spare	20 A	1	0 VA	0 VA				Spare	40
21	Spare	20 A	1	0 VA	0 VA				Spare	42
					<b>Total Load:</b> 9000 VA	<b>Total Amps:</b> 76 A	8280 VA	9000 VA		

Legend:

Load Classification	Connected Load	Demand Factor	Estimated Demand	Panel Totals
Receptacle - Convenience	26280 VA	80.00%	21024 VA	<b>Total Conn. Load:</b> 26280 VA
				<b>Total Est. Demand:</b> 21024 VA
				<b>Total Conn.:</b> 73 A
				<b>Total Est. Demand:</b> 58 A

Notes:

1 - 2 #4, #8 G in 1-1/4 C

**Branch Panel: DL2**

Location: ELECTRICAL D113  
Supply From: TX-D  
Mounting: Surface  
Enclosure: Type 1

Volts: 120/208 Wye  
Phases: 3  
Wires: 4

A.I.C. Rating: 65,000 A  
Mains Type: MCB  
Mains Rating: 400 A  
MCB Rating: 400 A

Notes:

CKT	Circuit Description	Trip	Poles	A	B	C	Poles	Trip	Circuit Description	CKT
1	AHU-D1 RECLTG	20 A	1	0 VA	0 VA				CHLR-1 RECLTG	2
2	VAVs	20 A	1		600 VA	1180...			EF-D101	4
3	EF-D102/103	20 A	1			790 VA	856 VA		PUH-D1, EF-D104	6
4	GT-1 RECEPT	20 A	1	180 VA	1180...				B-1, B-2	8
5	IWH-D02 - Note 1	70 A	3		6000...	6000...			IWH-D13 - Note 1	10
6		12	11			6000...	6000...			12
7		14	13							14
8	IWH-D46 - Note 1	70 A	3		6000...	6000...			IWH-D79 - Note 1	16
9		18	17			6000...	6000...			18
10		20	19			6000...	6000...			20
11	Spare	20 A	1		0 VA	0 VA			Spare	22
12	Spare	20 A	1		0 VA	0 VA			Spare	24
13	Spare	20 A	1	0 VA	0 VA				Spare	26
14	Spare	20 A	1	0 VA	0 VA				Spare	28
15	Spare	20 A	1	0 VA	0 VA				Spare	30
16	Spare	20 A	1	0 VA	0 VA				Spare	32
17	Spare	20 A	1	0 VA	0 VA				Spare	34
18	Spare	20 A	1	0 VA	0 VA				Spare	36
19	Spare	20 A	1	0 VA	0 VA				Spare	38
20	Spare	20 A	1	0 VA	0 VA				Spare	40
21	Spare	20 A	1			0 VA	0 VA		Spare	42
					<b>Total Load:</b> 25360 VA	<b>Total Amps:</b> 211 A	25780 VA	25640 VA		

Legend:

Load Classification	Connected Load	Demand Factor	Estimated Demand	Panel Totals
Motor	76606 VA	105.87%	81106 VA	<b>Total Conn. Load:</b> 76796 VA
Other	0 VA	0.00%	0 VA	<b>Total Est. Demand:</b> 81250 VA
Receptacle - Convenience	180 VA	80.00%	144 VA	<b>Total Conn.:</b> 213 A
				<b>Total Est. Demand:</b> 226 A

Notes:

1 - 3 #6, #10 G in 1-1/2 C

NATHANIEL JONES EARLY LEARNING CENTER ADDITION & EXPANSION

7839 NEW AUGUSTA RD, INDIANAPOLIS, IN 46268


MSD OF PIKE TOWNSHIP




ARCHITECT



317-848-0966 WWW.FHAI.COM 390 E NEW YORK ST, SUITE 300, INDIANAPOLIS, IN 46204

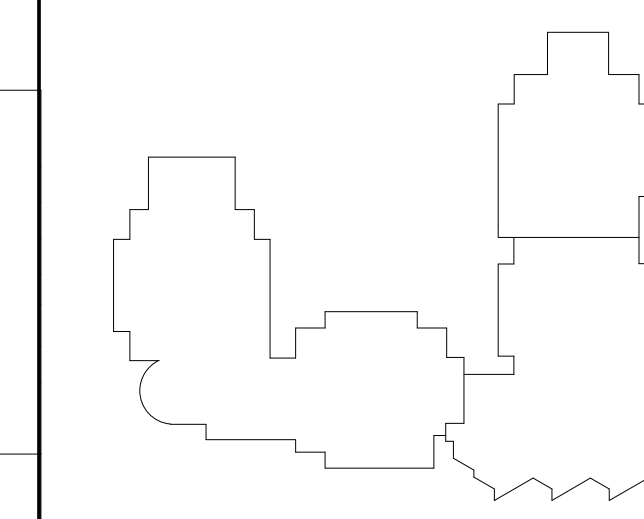

BID DOCUMENTS

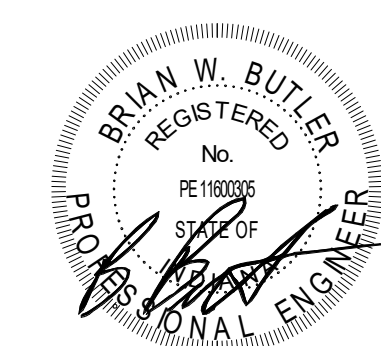

PROJECT MANAGER: PW DRAWN BY: ANE PROJECT NUMBER: 23216.00 PROJECT ISSUE DATE: 03-13-2026

Table with 3 columns: REV. NO., DESCRIPTION, DATE. Row 1: 1, Addendum No. 3, 03.30.26

PANELBOARD SCHEDULES - UNIT C

E-603

Branch Panel: KH1. Location: KITCHEN C103. Supply From: MSS-CD. Mounting: Surface. Enclosure: Type 1. Includes circuit schedule table with columns for CKT, Circuit Description, Trip, Poles, A, B, C, Poles, Trip, Circuit Description, CKT. Total Load: 31026 VA, Total Amps: 112 A.

Branch Panel: CL2. Location: ELECTRICAL C107. Supply From: TX-C. Mounting: Surface. Enclosure: Type 1. Includes circuit schedule table with columns for CKT, Circuit Description, Trip, Poles, A, B, C, Poles, Trip, Circuit Description, CKT. Total Load: 19360 VA, Total Amps: 161 A.

Branch Panel: CH1. Location: ELECTRICAL C107. Supply From: MSB-CD. Mounting: Surface. Enclosure: Type 1. Includes circuit schedule table with columns for CKT, Circuit Description, Trip, Poles, A, B, C, Poles, Trip, Circuit Description, CKT. Total Load: 59333 VA, Total Amps: 214 A.

Branch Panel: KL1. Location: KITCHEN C103. Supply From: TX-K. Mounting: Surface. Enclosure: Type 1. Includes circuit schedule table with columns for CKT, Circuit Description, Trip, Poles, A, B, C, Poles, Trip, Circuit Description, CKT. Total Load: 8729 VA, Total Amps: 73 A.

Branch Panel: CL1. Location: ELECTRICAL C107. Supply From: TX-C. Mounting: Surface. Enclosure: Type 1. Includes circuit schedule table with columns for CKT, Circuit Description, Trip, Poles, A, B, C, Poles, Trip, Circuit Description, CKT. Total Load: 19360 VA, Total Amps: 161 A.

Branch Panel: CL1. Location: ELECTRICAL C107. Supply From: TX-C. Mounting: Surface. Enclosure: Type 1. Includes circuit schedule table with columns for CKT, Circuit Description, Trip, Poles, A, B, C, Poles, Trip, Circuit Description, CKT. Total Load: 9120 VA, Total Amps: 76 A.

Autodesk Docs:\Nathaniel Jones.ELC - Add\_Renov\2025\_ELEC\_23216.00\_06\_andendum.rvt 3/30/2026 1:57:51 PM



**PIKE  
MSD/NATHANIEL  
JONES ELC  
EXPANSION**

7839 NEW AUGUSTA RD,  
INDIANAPOLIS, IN 46268


MSD OF PIKE TOWNSHIP



ARCHITECT




317-848-0966 WWW.FHAI.COM  
350 E NEW YORK ST, SUITE 300, INDIANAPOLIS, IN 46204

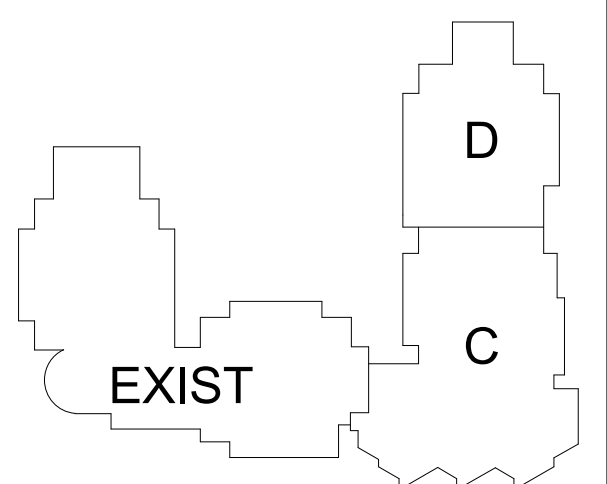

KEY PLAN

BID DOCUMENTS

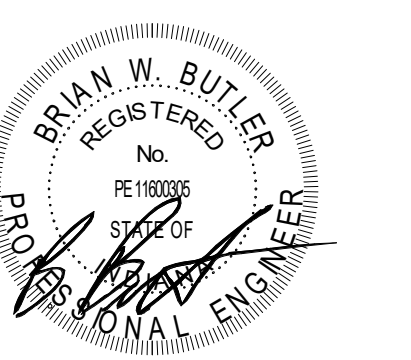


PROJECT MANAGER: PW  
DRAWN BY: CD  
PROJECT NUMBER: 223216.00  
PROJECT ISSUE DATE: 03-13-2025


REV. NO.	DESCRIPTION	DATE
3	Addendum No. 3	03/30/2025

TECHNOLOGY DETAILS

**T-502**

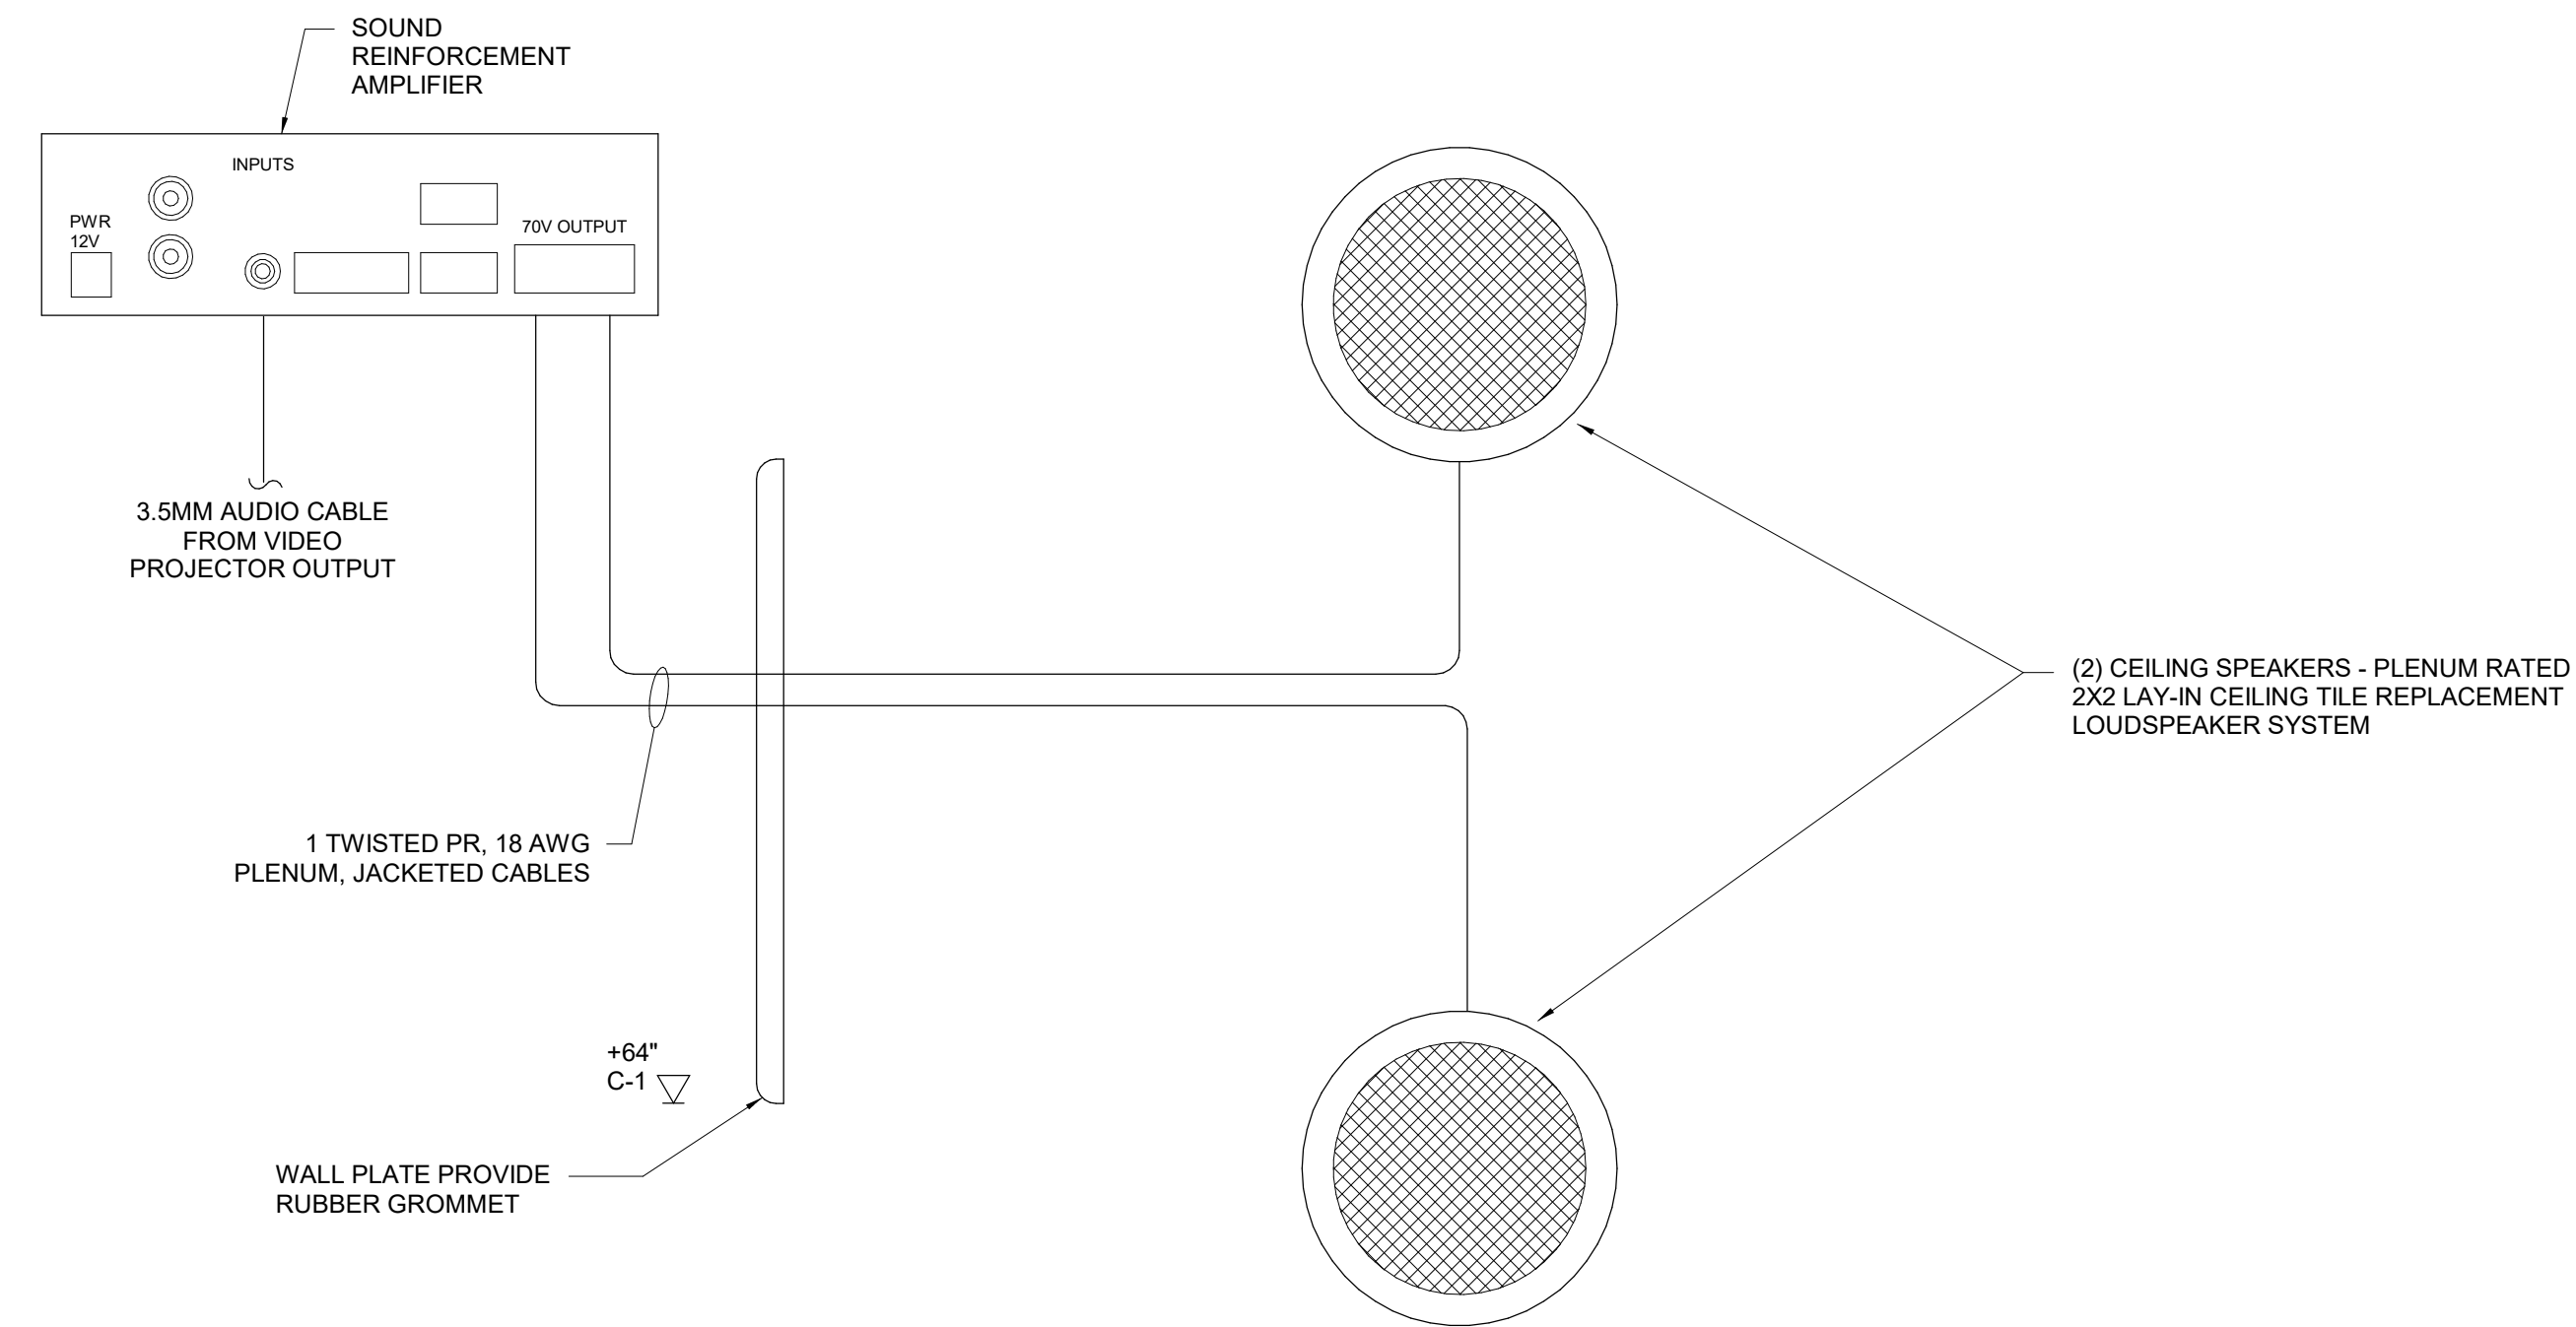


**3 CLASSROOM SOUND SYSTEM DETAIL**  
NOT TO SCALE

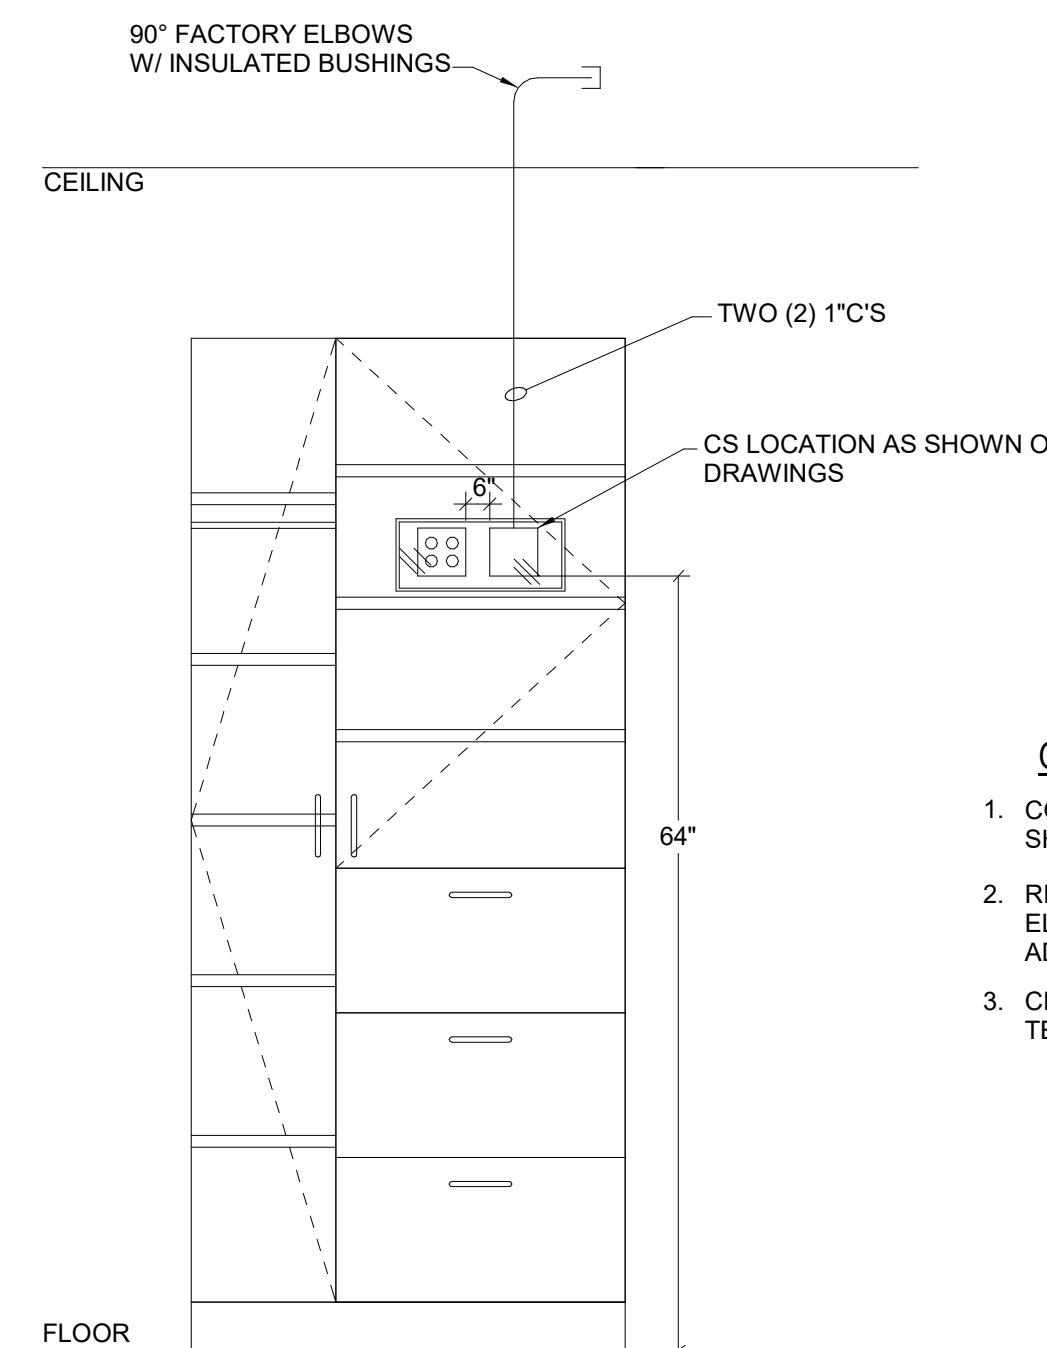

**GENERAL NOTES:**

- CONTRACTOR TO FOLLOW MOUNTING HEIGHTS AS LISTED ON THIS SHEET UNLESS NOTED DIFFERENTLY ON DRAWINGS.
- RECEPTACLES ARE SHOWN FOR COORDINATION ONLY. REFER TO ELECTRICAL DRAWINGS FOR SIZE, CIRCUITING, MOUNTING, AND ADDITIONAL REQUIREMENTS.
- CLASSROOM SOUND AMPLIFIERS ARE TO BE PLACED IN THE TEACHER WARDROBE AS SHOWN HERE.

**2 TYPICAL CLASSROOM SOUND SYSTEM LOCATION - TEACHER'S WARDROBE**  
NOT TO SCALE

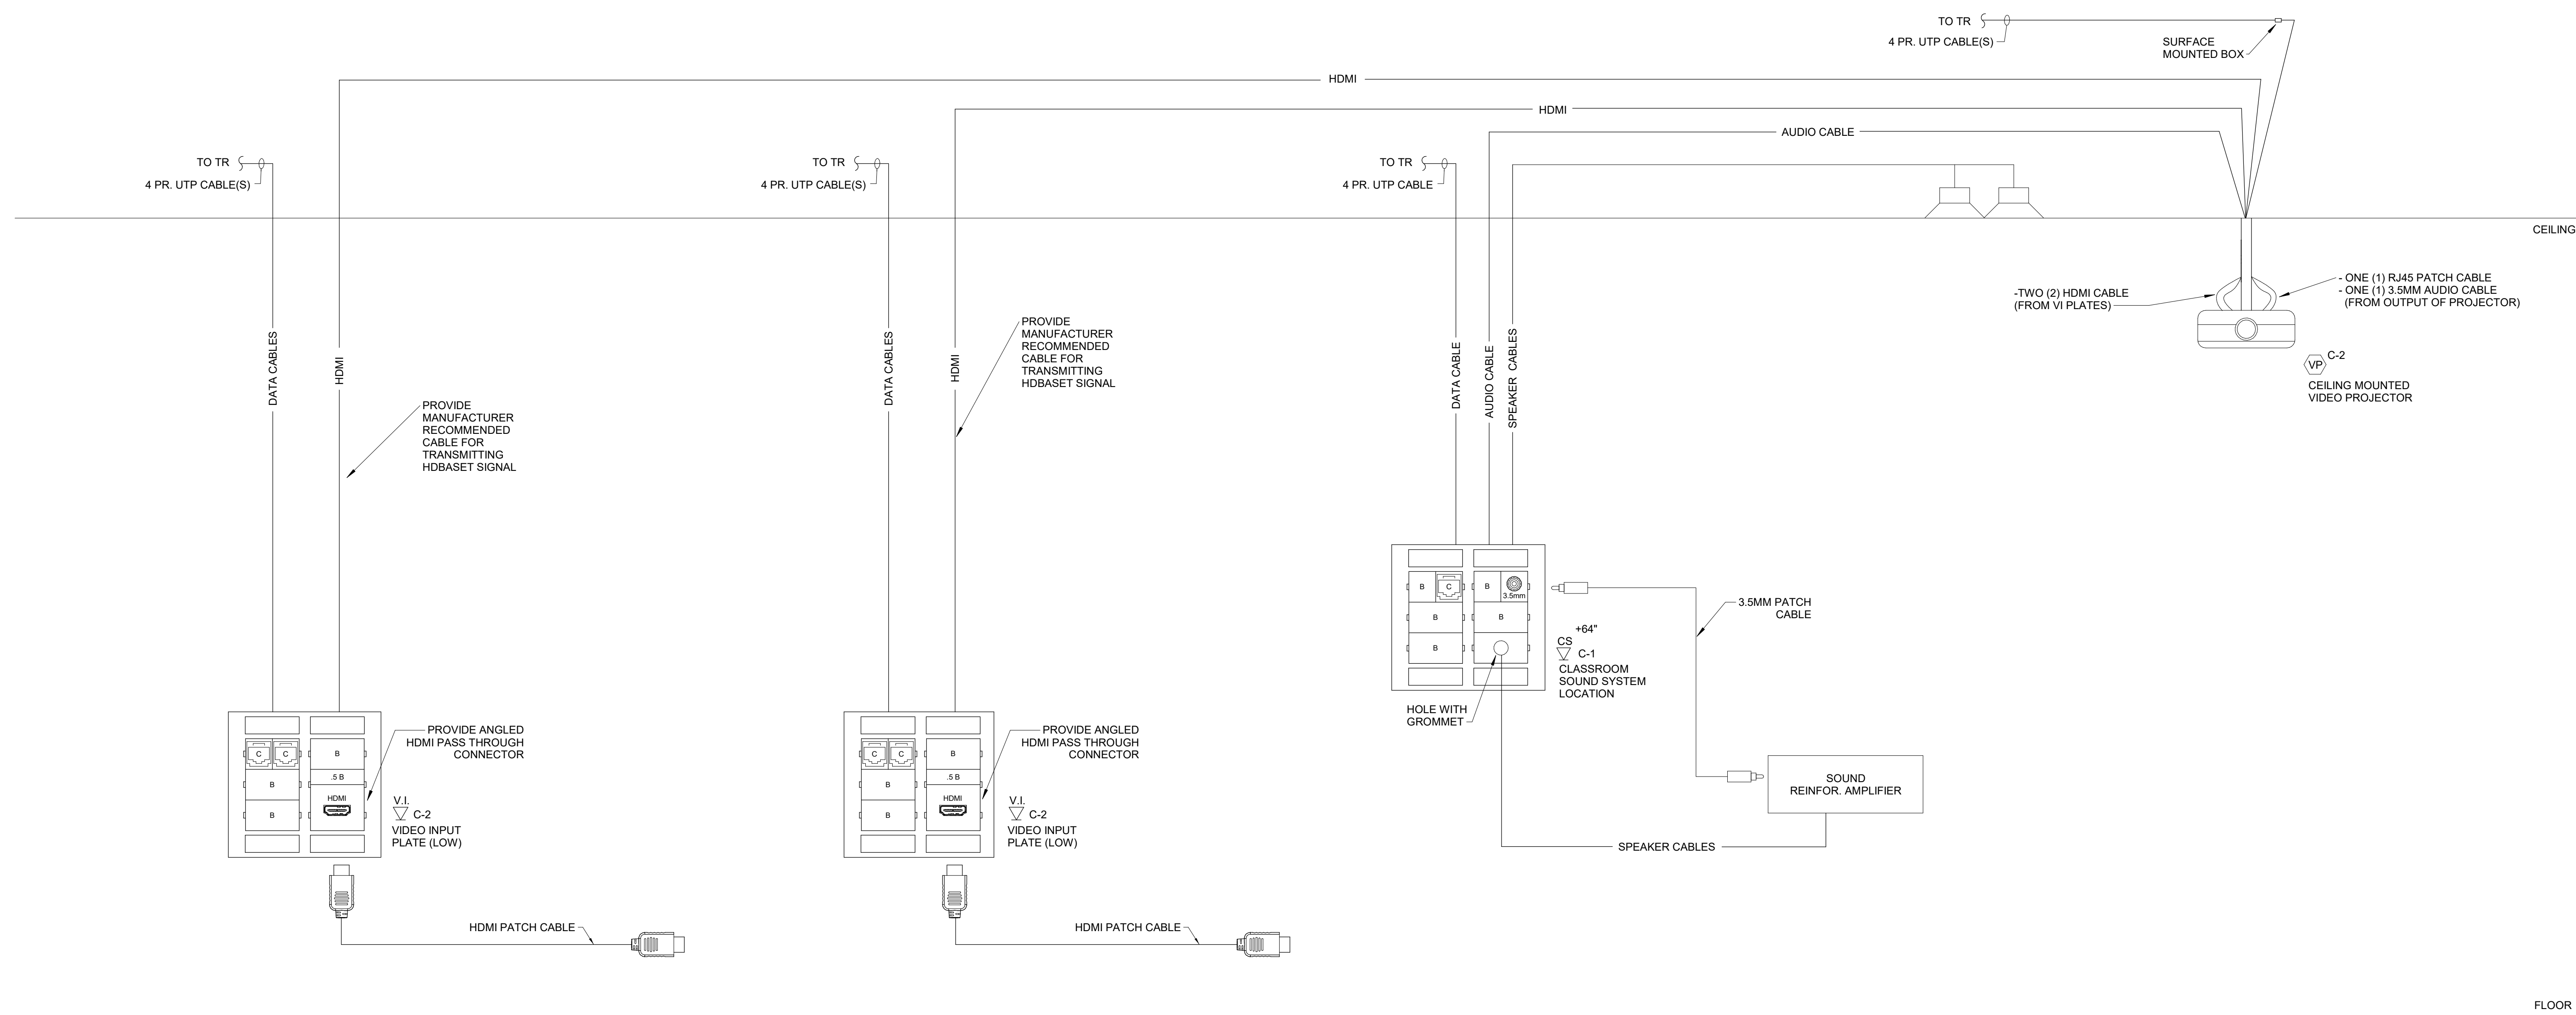

**1 CLASSROOM AV WIRING DETAIL**  
NOT TO SCALE

