



ADDENDUM # 2

10505 North College Avenue, Indianapolis, Indiana 46280 • Telephone: (317) 846-6611 • www.weihe.net

Project: Monon Community Center Paving Project

Architect's Project No.: W26-0292

DATE: July 23, 2026
TO: Distribute to all Bidders
PROJECT ADDRESS: 1195 Central Park Drive East, Carmel, Indiana 46032

CC: Carmel /Clay Board of Parks and Recreation
File

TO ALL BIDDERS OF RECORD:

The following addendum indicates revisions, additions, and deletions from the original bid information and project manual dated May 21, 2026. This addendum forms a part of these documents. Acknowledge receipt of this addendum by inserting its number on your bid proposal form. Failure to do so may subject the bidder to disqualification.

GENERAL

<u>ITEM</u>	<u>DESCRIPTION</u>
GENERAL ITEMS	Not used.

PROJECT MANUAL

<u>ITEM</u>	<u>DESCRIPTION</u>
ADD #2-PM1	Not used.

DRAWINGS

<u>ITEM</u>	<u>DESCRIPTION</u>
ADD #2-D1	C300-C800. Revised sheets are attached.

CONTRACTOR QUESTIONS

<u>ITEM</u>	<u>DESCRIPTION</u>
--------------------	---------------------------

Project: **Monon Community Center Paving Project**

Architect's Project No.: W26-0292

ADDENDUM #2 (Continued)

ADD #1-CQ1

Question: Can you confirm the concrete thickness for both colored and non-colored concrete to be 6"? Response: Yes, details on C800 have been clarified.

ADD #1-CQ2

Question: The current match lines on the drawings do not seem to align; can you provide match lines from sheet to sheet? Response: Sheets C300-C304 have been adjusted to show matchlines.

ADD #1-CQ3

Question: Sheet C300 appears to be missing one signage and marking note S1 for a planter/limestone rock. Can you confirm this unmarked item needs to be new as well? Response: No. The bollard shown in the original design drawings has since been replaced with a structural column.

ADD #1-CQ4

Question: Do each new planters/limestone rocks notated on Sheet C304 need to have the existing concrete slab removed and replaced with a thickened concrete slab? If so, please provide a jointing detail showing which current concrete panels get removed and replaced. Response: Most of the new bollards are to be located on new pavement. There are 5 bollards at the East entrance currently located on concrete pavement. This pavement is to be patched to allow setting the new bollards on this existing pavement.

ADD #2-CQ5

Question: Can you confirm that the thickened slab at the planters/limestone rocks is 5' x 5' by 12" thick per Detail 8 on Sheet C800? Response: This is correct.

ADD #2-CQ6

Question: Can you confirm expansion joint material will be required when abutting existing vertical services? For example: buildings, planter walls, or stone veneer seat walls. Response: Yes, this is correct.

ADD #2-CQ7

Question: Sheet C301 - Signage and Markings note S2 states concrete to be doweled into abutting concrete minimum of 1 Dowel per square. When referring to Detail 9 on Sheet C800, it states dowels are to be every 24" O.C. Can you please confirm which is correct? Response: Contractor should aim for 24" spacing, and use professional discretion when joints are in conflict. Contractor should, at a minimum, include one dowel into each adjacent concrete curb or panel.

ADD #2-CQ8

Question: Will these epoxy dowels per Detail 9 on C800 be required to be installed at all existing concrete curbs and sidewalks to new proposed sidewalks? If so, do they need to be drilled and epoxied every 24" O.C. per that same detail. Response: Yes, this is correct. See question above for more detail.

Project: **Monon Community Center Paving Project**

Architect's Project No.: W26-0292

ADDENDUM #2 (Continued)

ADD #2-CQ9

Question: For the concrete, are you requiring wire mesh or fiber? If requiring wire mesh, what size? Response: No, neither wire mesh nor fiber is required.

END OF ADDENDUM #2

LOCATION: I:\2026\W260292\Engineering\design\c300 SITE PLAN.dwg
DRAWN BY: JAW
DATE/TIME: July 02, 2026 - 9:37am
PLOTTED BY: wilson



SITE PLAN

1. THE CONTRACTOR(S) SHALL VERIFY ALL DIMENSIONS AND ELEVATIONS IN THE FIELD PRIOR TO THE START OF CONSTRUCTION. THE CONTRACTOR SHALL BE RESPONSIBLE FOR ELEVATIONS AND DIMENSIONS THROUGHOUT THE CONSTRUCTION SCHEDULE. IF ANY DISCREPANCIES ARE FOUND TO EXIST BETWEEN THE CONSTRUCTION DOCUMENTS AND ACTUAL FIELD CONDITIONS, THE CONTRACTOR(S) MUST CONTACT THE PROJECT MANAGER IMMEDIATELY FOR INSTRUCTION BEFORE PROCEEDING.
2. ALL RADI INDICATED SHALL BE FORMED AS CIRCULAR ARCS. SITE CONTRACTOR(S) SHALL MATCH EXISTING GRADE AND ALIGNMENT OF CURBS WHERE NEW CONSTRUCTION ABUTS EXISTING SITE CONDITIONS.
3. SITE CONTRACTOR(S) MUST PROVIDE AT THE CONTRACTOR'S EXPENSE, ALL NECESSARY VEHICULAR AND PEDESTRIAN CONTROL DEVICES. TEMPORARY VEHICULAR AND PEDESTRIAN TRAFFIC CONTROL DEVICES AND METHODS USED DURING CONSTRUCTION MUST CONFORM WITH APPLICABLE FEDERAL, STATE, AND LOCAL STANDARDS. CONTRACTOR(S) MUST MEET MINIMAL REQUIREMENTS FOR EMERGENCY VEHICLE ACCESS ON SITE DURING CONSTRUCTION AS DETERMINED BY LOCAL AND/OR STATE CODES AND REGULATIONS.
4. ALL CONSTRUCTION ACTIVITY ON THIS SITE TO BE PERFORMED IN COMPLIANCE WITH APPLICABLE O.S.H.A. STANDARDS FOR WORKER SAFETY.
5. EXPANSION JOINTS SHALL BE REQUIRED AT ALL CONDITIONS WHERE CONCRETE PAVEMENT IS DIRECTLY ADJACENT TO PROPOSED STRUCTURES.
6. ANY EXISTING VEGETATION ON OR ADJACENT TO THE PROJECT SITE THAT ARE DESIGNATED TO REMAIN SHALL BE PROTECTED FROM ANY AND ALL INJURY RESULTING FROM CONSTRUCTION TECHNIQUES AND/OR VEHICLES ON SITE. CONTRACTOR(S) MUST ESTABLISH A SUITABLE PERIMETER AROUND EACH SPECIMEN TO ENSURE THAT A PROPER ROOT ZONE IS MAINTAINED. FENCING MATERIAL USED TO DESIGNATE PLANT PROTECTION AREAS MUST BE CONSPICUOUS AND CLEARLY VISIBLE THROUGHOUT THE CONSTRUCTION SCHEDULE. EACH PROTECTION AREA SHALL CONTAIN PROPER SIGNAGE NOTIFYING WORKERS OF THE IMPORTANCE OF PREVENTING VEHICULAR TRAFFIC FROM ENTERING THE PROTECTED ROOT ZONE(S).
7. REMOVE ALL EXISTING TRASH, DEBRIS AND RUBBLE THROUGHOUT THE SITE BEFORE THE COMPLETION OF THE CONSTRUCTION SEQUENCE. DISPOSAL OF SUCH MATERIAL MUST BE DONE IN ACCORDANCE WITH FEDERAL, STATE, COUNTY AND LOCAL LAWS AND REGULATIONS. THE CONTRACTOR(S) SHALL BE RESPONSIBLE FOR DAILY INSPECTIONS OF THE PROJECT SITE AND ADJACENT PROPERTY(S) TO DETECT AND REMOVE ANY MUD, GRAVEL, OR DEBRIS THAT HAVE BEEN TRACKED, DUMPED, SPILLED OR WIND-BLOWN ONTO AREAS ADJACENT TO PROJECT INCLUDING, BUT NOT LIMITED TO: RIGHTS-OF-WAY, PUBLIC OR PRIVATE STREETS, AND ROADS, DRIVEWAYS, YARDS AND/OR SIDEWALKS.
8. IT SHALL BE THE RESPONSIBILITY OF EACH CONTRACTOR TO VERIFY ALL EXISTING UTILITIES AND CONDITIONS PERTAINING TO THE PHASE OF WORK. IT SHALL ALSO BE THE CONTRACTOR'S RESPONSIBILITY TO CONTACT THE OWNERS OF THE VARIOUS UTILITIES FOR PROPER STAKE LOCATION FOR EACH UTILITY BEFORE WORK IS STARTED. THE CONTRACTOR SHALL NOTIFY IN WRITING THE OWNER OR THE ENGINEER OF ANY CHANGES, OMISSIONS, OR ERRORS FOUND ON THESE PLANS OR IN THE FIELD BEFORE WORK IS STARTED OR RESUMED.
9. IT SHALL BE THE RESPONSIBILITY OF THE CONTRACTOR TO ENSURE THAT ALL FILL AREAS SHALL BE COMPACTED TO AT LEAST 95 PERCENT OF THE MAXIMUM DRY DENSITY MODIFIED (ASTM D-1557).
10. IT SHALL BE THE RESPONSIBILITY OF THE CONTRACTOR TO ADJUST ALL UTILITY COVERS, LIDS, AND ACCESS PANELS IN SUCH A MANNER AS TO BE FLUSH WITH THE WALKS AND CARE SHOULD BE TAKEN NOT TO DAMAGE THE UTILITY COVERS, LIDS AND ACCESS PANELS DURING CONSTRUCTION.

SITE PLAN NOTES


HARDSCAPE

- (H1) SAWCUT CONTROL JOINT
(SEE DETAIL 4 ON SHEET C800).
- (H2) EXPANSION JOINT
(SEE DETAIL 5 ON SHEET C800).

EXISTING BRICK AND STONE BASE TO REMOVE AND REPLACE WITH STANDARD CONCRETE
(SEE DETAIL 7 ON SHEET C800).

SIGNAGE & MARKINGS

- (S1) ALTERNATE #1: LIMESTONE BLOCK
ALTERNATE #2: CONCRETE PLANTER
(SEE DETAIL 1/2 ON SHEET C800).
- (S2) ALL NEW CONCRETE TO BE DOWELED INTO ABUTTING CONCRETE.
MINIMUM OF ONE DOWEL PER SQUARE.
(SEE DETAIL 9 ON SHEET C800).

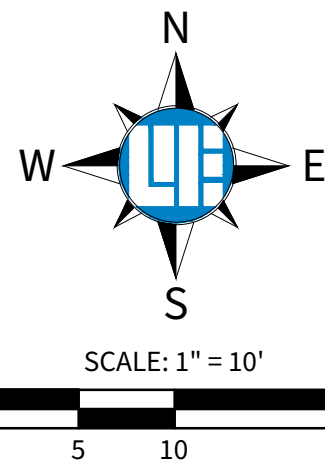

811
Know what's below.
Call before you dig.
Within Indiana Call
811 or 800-362-5544
24 Hours a Day, 7 Days a Week.
PER INDIANA STATE LAW IC 8-1-26,
IT IS AGAINST THE LAW TO EXCAVATE
WITHOUT NOTIFYING THE UNDERGROUND
LOCATION SERVICE (U.S.) WORKING
DAYS BEFORE COMMENCING WORK.

10505 N. College Ave.
Indianapolis, IN 46280
317.846.6611 · weihe.net

WEIHE ENGINEERS
BUILD WITH CONFIDENCE™

LAND SURVEYING · CIVIL ENGINEERING · SUSTAINABLE DESIGN · LANDSCAPE ARCHITECTURE

DATE	BY	DESIGNED BY:
07.16.2026	HW	MK
07.17.2026	HW	
07.17.2026	HW	
07.17.2026	HW	

DATE	BY	DRAWN BY:
07.16.2026	HW	MK
07.17.2026	HW	
07.17.2026	HW	
07.17.2026	HW	

DATE	BY	CHECKED BY:
07.16.2026	HW	MK
07.17.2026	HW	
07.17.2026	HW	
07.17.2026	HW	

SUBMITTALS AND REVISIONS

NO.	DATE	DESCRIPTION
1	05/21/2026	ADDENDUM #1
2		ADDENDUM #2
3		ADDENDUM #3


APPROVAL PENDING
NOT FOR CONSTRUCTION

MONON COMMUNITY CENTER PAVING PROJECT
1195 Central Park Dr., Carmel, IN 46032

SITE PLAN
Part of the 2024 of Section XX, Township XX North, Range X East, XXXX Township, XXX County, Indiana

SHEET NO.
C300

PROJECT NO.
W260292

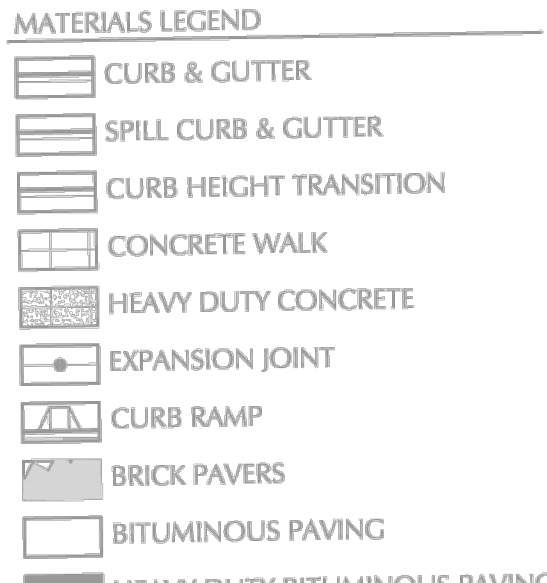

1. THE CONTRACTOR(S) SHALL VERIFY ALL DIMENSIONS AND ELEVATIONS IN THE FIELD PRIOR TO THE START OF CONSTRUCTION. THE CONTRACTOR SHALL BE RESPONSIBLE FOR ELEVATIONS AND DIMENSIONS THROUGHOUT THE CONSTRUCTION SCHEDULE. IF ANY DISCREPANCIES ARE FOUND TO EXIST BETWEEN THE CONSTRUCTION DOCUMENTS AND ACTUAL FIELD CONDITIONS, THE CONTRACTOR(S) MUST CONTACT THE PROJECT MANAGER IMMEDIATELY FOR INSTRUCTION BEFORE PROCEEDING.
2. ALL RADI INDICATED SHALL BE FORMED AS CIRCULAR ARCS. SITE CONSTRUCTION CURB(S) SHALL MATCH EXISTING GRADE AND ALIGNMENT OF CURBS WHERE NEW CONSTRUCTION ABUTS EXISTING SITE CONDITIONS.
3. SITE CONSTRUCTION(S) MUST PROVIDE AT THE CONTRACTOR'S EXPENSE, ALL NECESSARY VEHICULAR AND PEDESTRIAN CONTROL DEVICES. TEMPORARY VEHICULAR AND PEDESTRIAN TRAFFIC CONTROL DEVICES AND METHODS USED DURING CONSTRUCTION MUST CONFORM WITH APPLICABLE FEDERAL, STATE, AND LOCAL STANDARDS. CONTRACTOR(S) MUST MEET MINIMAL REQUIREMENTS FOR EMERGENCY VEHICLE ACCESS ON SITE DURING CONSTRUCTION AS DETERMINED BY LOCAL AND/OR STATE CODES AND REGULATIONS.
4. ALL CONSTRUCTION ACTIVITY ON THIS SITE TO BE PERFORMED IN COMPLIANCE WITH APPLICABLE O.S.H.A. STANDARDS FOR WORKER SAFETY.
5. EXPANSION JOINTS SHALL BE REQUIRED AT ALL CONDITIONS WHERE CONCRETE PAVEMENT IS DIRECTLY ADJACENT TO PROPOSED STRUCTURES.
6. ANY EXISTING VEGETATION ON OR ADJACENT TO THE PROJECT SITE THAT ARE DESIGNATED TO REMAIN SHALL BE PROTECTED FROM ANY AND ALL INJURY RESULTING FROM CONSTRUCTION TECHNIQUES AND/OR VEHICLES ON SITE. CONTRACTOR(S) MUST ESTABLISH A SUITABLE PERIMETER AROUND EACH SPECIMEN TO ENSURE THAT A PROPER ROOT ZONE IS MAINTAINED. FENCING MATERIAL USED TO DESIGNATE PLANT PROTECTION AREAS MUST BE CONSPICUOUS AND CLEARLY VISIBLE THROUGHOUT THE CONSTRUCTION SCHEDULE. EACH PROTECTION AREA SHALL CONTAIN PROPER SIGNAGE NOTIFYING WORKERS OF THE IMPORTANCE OF PREVENTING VEHICULAR TRAFFIC FROM ENTERING THE PROTECTED ROOT ZONE(S).
7. REMOVE ALL EXISTING TRASH, DEBRIS AND RUBBLE THROUGHOUT THE SITE BEFORE THE COMPLETION OF THE CONSTRUCTION SEQUENCE. DISPOSAL OF SUCH MATERIAL MUST BE DONE IN ACCORDANCE WITH FEDERAL, STATE, COUNTY AND LOCAL LAWS AND REGULATIONS. THE CONTRACTOR(S) SHALL BE RESPONSIBLE FOR DAILY INSPECTIONS OF THE PROJECT SITE AND ADJACENT PROPERTY(S) TO DETECT AND REMOVE ANY MUD, GRAVEL, OR DEBRIS THAT HAVE BEEN TRACKED, PUMPED, SPILLED OR WIND-BLOWN OUTSIDE AREAS ADJACENT TO PROJECT INCLUDING, BUT NOT LIMITED TO: RIGHTS-OF-WAY, PUBLIC OR PRIVATE STREETS, AND ROADS, DRIVEWAYS, YARDS AND/OR SIDEWALKS.
8. IT SHALL BE THE RESPONSIBILITY OF EACH CONTRACTOR TO VERIFY ALL EXISTING UTILITIES AND CONDITIONS PERTAINING TO THE PHASE OF WORK. IT SHALL ALSO BE THE CONTRACTOR'S RESPONSIBILITY TO CONTACT THE OWNERS OF THE VARIOUS UTILITIES FOR PROPER STAKE-OUT FOR EACH UTILITY BEFORE WORK IS STARTED. THE CONTRACTOR SHALL NOTIFY IN WRITING THE OWNER OR THE ENGINEER OF ANY CHANGES, OMISSIONS, OR ERRORS FOUND ON THESE PLANS OR IN THE FIELD BEFORE WORK IS STARTED OR RESUMED.
9. IT SHALL BE THE RESPONSIBILITY OF THE CONTRACTOR TO ENSURE THAT ALL FILL AREAS SHALL BE COMPACTED TO AT LEAST 95 PERCENT OF THE MAXIMUM DRY DENSITY MODIFIED (ASTM D-1557)
10. IT SHALL BE THE RESPONSIBILITY OF THE CONTRACTOR TO ADJUST ALL UTILITY COVERS, LIDS, AND ACCESS PANELS IN SUCH A MANNER AS TO BE FLUSH WITH THE WALKS AND CURE SHOULD BE TAKEN NOT TO DAMAGE THE UTILITY COVERS, LIDS AND ACCESS PANELS DURING CONSTRUCTION.


HARDSCAPE

- (H1) SAWCUT CONTROL JOINT
(SEE DETAIL 4 ON SHEET C800)
- (H2) EXPANSION JOINT
(SEE DETAIL 5 ON SHEET C800)

EXISTING BRICK AND STONE BASE TO REMOVE AND REPLACE WITH STANDARD CONCRETE (SEE DETAIL 7 ON SHEET C800).

SIGNAGE & MARKINGS

- (S1) ALTERNATE #1: LIMESTONE BLOCK
ALTERNATE #2: CONCRETE PLANTER
(SEE DETAIL 1/2 ON SHEET C800).
- (S2) ALL NEW CONCRETE TO BE DOWELED INTO ABUTTING CONCRETE.
MINIMUM OF ONE DOWEL PER SQUARE.
(SEE DETAIL 9 ON SHEET C800).

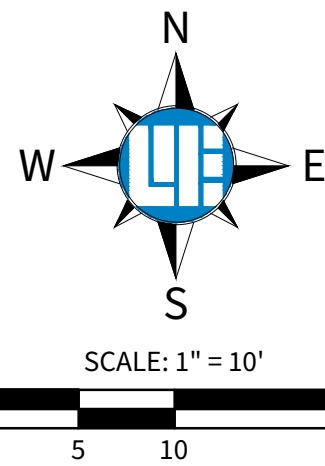

811

**Know what's below.
Call before you dig.**

*Within Indiana Call
811 or 800-352-5544
24 Hours a Day, 7 Days a Week.*

PER INDIANA STATE LAW ILC 8-1-26,
IT IS AGAINST THE LAW TO EXCAVATE
WITHOUT NOTIFYING THE UNDERGROUND
LOCATION SERVICE TWO (2) WORKING
DAYS BEFORE COMMENCING WORK.

MONON COMMUNITY CENTER PAVING PROJECT

1195 Central Park Dr, Carmel, IN 46032

SITE PLAN

SHEET NO.
C30

PROJECT NO.
W260292

**10505 N. College Ave.
Indianapolis, IN 46280
317.846.6611 • weihe.net**




WEIHE
ENGINEERS
BUILD WITH CONFIDENCESM

LAND SURVEYING • CIVIL ENGINEERING • SUSTAINABLE DESIGN • LANDSCAPE ARCHITECTURE

[illegible]

APPROVAL PENDING
NOT FOR CONSTRUCTION

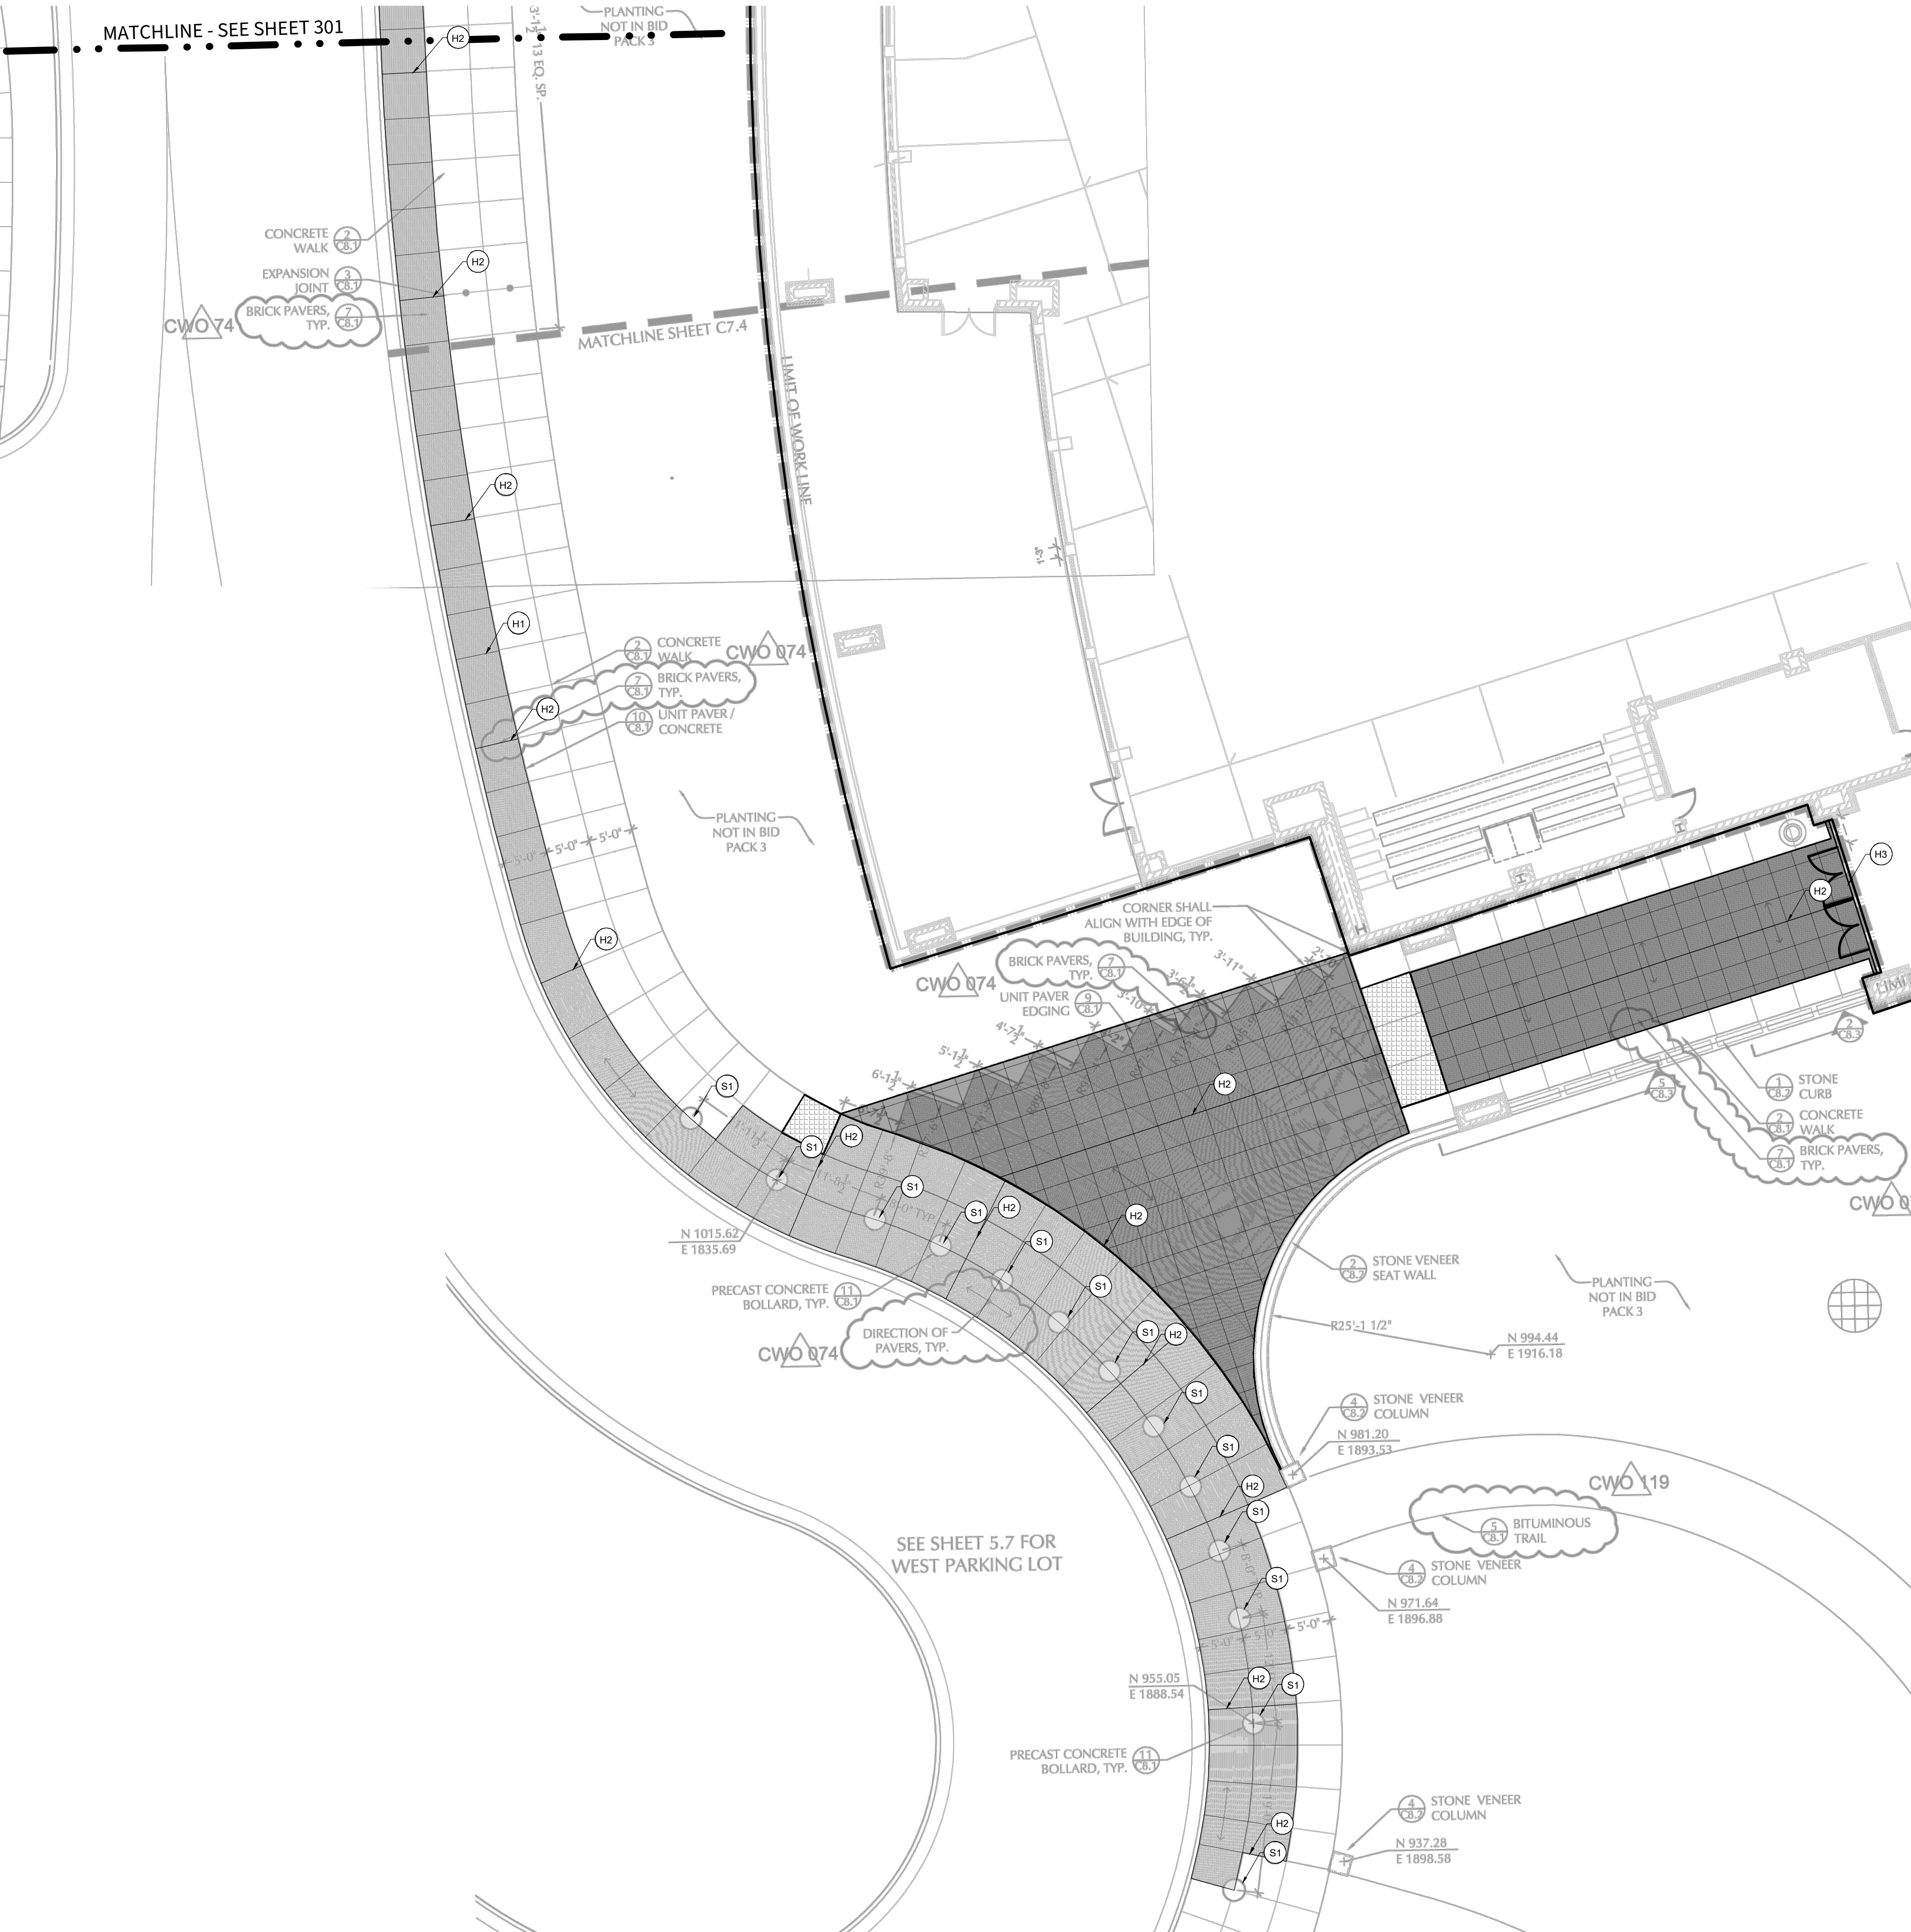

1. THE CONTRACTOR(S) SHALL VERIFY ALL DIMENSIONS AND ELEVATIONS IN THE FIELD PRIOR TO THE START OF CONSTRUCTION. THE CONTRACTOR SHALL BE RESPONSIBLE FOR ELEVATIONS AND DIMENSIONS THROUGHOUT THE CONSTRUCTION SCHEDULE. IF ANY DISCREPANCIES ARE FOUND TO EXIST BETWEEN THE CONSTRUCTION DOCUMENTS AND ACTUAL FIELD CONDITIONS, THE CONTRACTOR(S) MUST CONTACT THE PROJECT MANAGER IMMEDIATELY FOR INSTRUCTION BEFORE PROCEEDING.
2. ALL RADII INDICATED SHALL BE FORMED AS CURBING ARCS. SITE CONTRACTOR(S) SHALL MATCH EXISTING GRADE AND ALIGNMENT OF CURBS WHERE NEW CONSTRUCTION ABUTS EXISTING SITE CONDITIONS.
3. SITE CONTRACTOR(S) MUST PROVIDE AT THE CONTRACTOR'S EXPENSE, ALL NECESSARY VEHICULAR AND PEDESTRIAN CONTROL DEVICES, TEMPORARY VEHICULAR AND PEDESTRIAN TRAFFIC CONTROL DEVICES AND METHODS USED DURING CONSTRUCTION MUST CONFORM WITH APPLICABLE FEDERAL, STATE, AND LOCAL STANDARDS. CONTRACTOR(S) MUST MEET MINIMAL REQUIREMENTS FOR EMERGENCY VEHICULAR ACCESS ON SITE DURING CONSTRUCTION AS DETERMINED BY LOCAL AND/OR STATE CODES AND REGULATIONS.
4. ALL CONSTRUCTION ACTIVITY ON THIS SITE TO BE PERFORMED IN COMPLIANCE WITH APPLICABLE O.S.H.A. STANDARDS FOR WORKER SAFETY.
5. EXPANSION JOINTS SHALL BE REQUIRED AT ALL CONDITIONS WHERE CONCRETE PAVEMENT IS DIRECTLY ADJACENT TO PROPOSED STRUCTURES.
6. ANY EXISTING VEGETATION ON OR ADJACENT TO THE PROJECT SITE THAT ARE DESIGNATED TO REMAIN SHALL BE PROTECTED FROM ANY AND ALL INJURY RESULTING FROM CONSTRUCTION TECHNIQUES AND/OR VEHICLES ON SITE. CONTRACTOR(S) MUST ESTABLISH A SUITABLE PERIMETER AROUND EACH SPECIMEN TO ENSURE THAT A PROPER ROOT ZONE IS MAINTAINED, FENCING MATERIAL USED TO DESIGNATE PLANT PROTECTION AREAS MUST BE CONSPICUOUS AND CLEARLY VISIBLE THROUGHOUT THE CONSTRUCTION SCHEDULE. EACH PROTECTION AREA SHALL CONTAIN PROPER SIGNAGE NOTIFYING WORKERS OF THE IMPORTANCE OF PREVENTING VEHICULAR TRAFFIC FROM ENTERING THE PROTECTED ROOT ZONE(S).
7. REMOVE ALL EXISTING TRASH, DEBRIS AND RUBBLE THROUGHOUT THE SITE BEFORE THE COMPLETION OF THE CONSTRUCTION SEQUENCE. DISPOSAL OF SUCH MATERIAL MUST BE DONE IN ACCORDANCE WITH FEDERAL, STATE, COUNTY AND LOCAL LAWS AND REGULATIONS. THE CONTRACTOR(S) SHALL BE RESPONSIBLE FOR DAILY INSPECTIONS OF THE PROJECT SITE AND ADJACENT PROPERTY(S) TO DETECT AND REMOVE ANY MUD, GRAVEL, OR DEBRIS THAT HAVE BEEN TRACKED, DUMPED, SPILLED OR WIND-BLOWN INTO ADJACENT AREAS. ADJACENT AREAS INCLUDING, BUT NOT LIMITED TO: RIGHTS-OF-WAY, PUBLIC OR PRIVATE STREETS, AND ROADS, DRIVEWAYS, YARDS AND/OR SIDEWALKS.
8. IT SHALL BE THE RESPONSIBILITY OF EACH CONTRACTOR TO VERIFY ALL EXISTING UTILITIES AND CONDITIONS PERTAINING TO THE PHASE OF WORK. IT SHALL ALSO BE THE CONTRACTOR'S RESPONSIBILITY TO CONTACT THE OWNERS OF THE VARIOUS UTILITIES FOR PROPER SITE LOCATION FOR EACH UTILITY BEFORE WORK IS STARTED. THE CONTRACTOR SHALL NOTIFY IN WRITING THE OWNER OR THE ENGINEER OF ANY CHANGES, OMISSIONS, OR ERRORS FOUND ON THESE PLANS OR IN THE FIELD BEFORE WORK IS STARTED OR RESUMED.
9. IT SHALL BE THE RESPONSIBILITY OF THE CONTRACTOR TO ENSURE THAT ALL FILL AREAS SHALL BE COMPACTED TO AT LEAST 95 PERCENT OF THE MAXIMUM DRY DENSITY MODIFIED (ASTM D-1557)
10. IT SHALL BE THE RESPONSIBILITY OF THE CONTRACTOR TO ADJUST ALL UTILITY COVERS, LIDS, AND ACCESS PANELS IN SUCH A MANNER AS TO BE FLUSH WITH THE WALKS AND CARE SHOULD BE TAKEN NOT TO DAMAGE THE UTILITY COVERS, LIDS AND ACCESS PANELS DURING CONSTRUCTION.

HARDSCAPE

- | | |
|---|--|
|  | EXISTING BRICK AND STONE BASE TO REMOVE AND REPLACE WITH COLORED CONCRETE
(SEE DETAIL 6/7 ON SHEET C800). |
|  | EXISTING BRICK AND STONE BASE TO REMOVE AND REPLACE WITH STANDARD CONCRETE
(SEE DETAIL 7 ON SHEET C800). |
|  | EXISTING CONCRETE TO DEMO AND REPLACE WITH STANDARD CONCRETE
(SEE DETAIL 7 ON SHEET C800). |

SIGNAGE & MARKINGS

- (S1) ALTERNATE #1: LIMESTONE BLOCK
ALTERNATE #2: CONCRETE PLANTER
(SEE DETAIL 1/2 ON SHEET C800).
- (S2) ALL NEW CONCRETE TO BE DOWELED INTO ABUTTING CONCRETE.
MINIMUM OF ONE DOWEL PER SQUARE.
(SEE DETAIL 9 ON SHEET C800).



SITE PLAN


EET NO.
C302
OJECT NO.
W260292

LOCATION: I:\2026\W260292\Engineering\design\c300 SITE PLAN.dwg
DRAWN BY: J. Wilson
DATE/TIME: July 22, 2026 - 5:37pm
PLOTTER: b7r-wilson


- CURB & GUTTER
- SPILL CURB & GUTTER
- CURB HEIGHT TRANSITION
- CONCRETE WALK
- HEAVY DUTY CONCRETE
- EXPANSION JOINT
- CURB RAMP
- UNIT PAVERS
- BITUMINOUS PAVING
- HEAVY DUTY BITUMINOUS PAVING
- BITUMINOUS TRAIL
- AGGREGATE TRAIL
- BOARDWALK
- END SECTION TYPE 1A

- END SECTION TYPE 1B
- END SECTION TYPE 2
- END SECTION TYPE 3
- EXISTING STORM SEWER (FROM BP #1)
- STORM SEWER
- CATCH BASIN
- MANHOLE
- PLAZA DRAIN

LAYOUT NOTES
1. ALL DIMENSIONS ARE TO THE BACK OF CURB UNLESS OTHERWISE NOTED.
2. EXPANSION JOINTS TO BE LOCATED 50' O.C. MAX. AND AT ALL FIXED OBJECTS (i.e. STRUCTURES, CURBS, WALLS, ETC.)

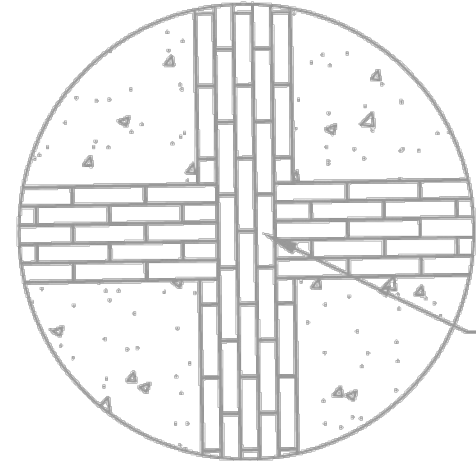

TYPICAL PAVER BAND JUNCTION

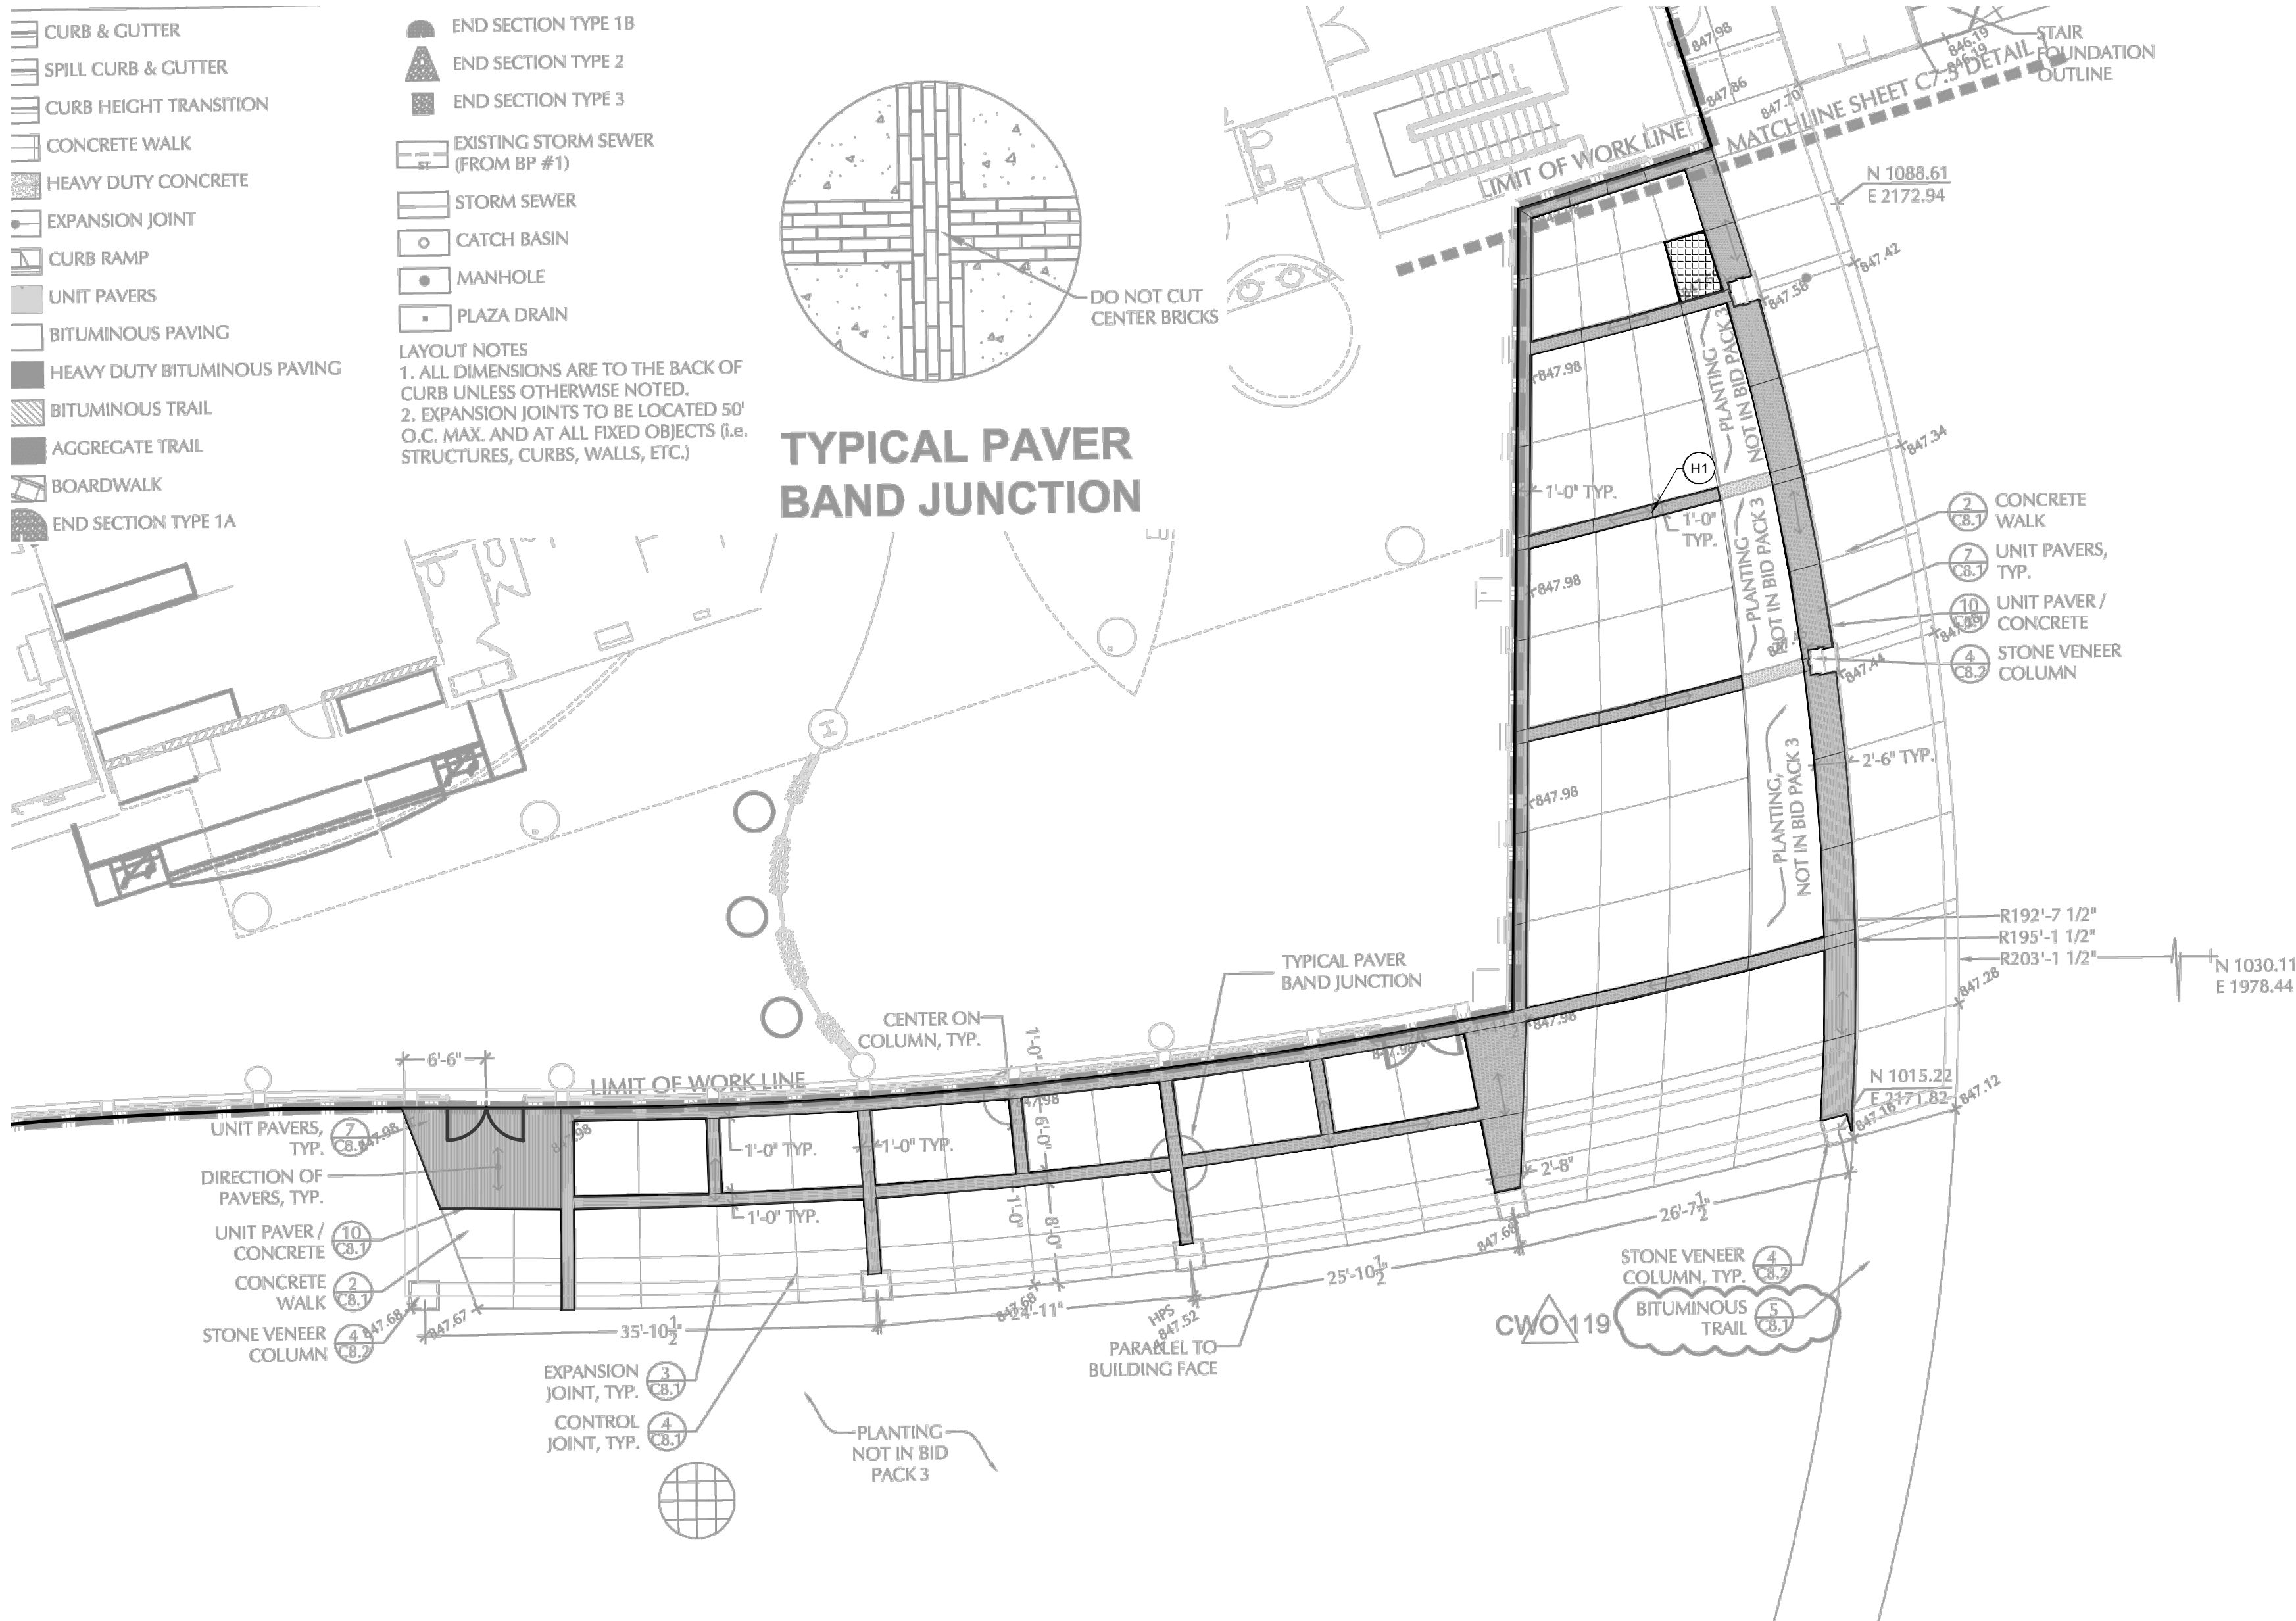

SITE PLAN

- THE CONTRACTOR(S) SHALL VERIFY ALL DIMENSIONS AND ELEVATIONS IN THE FIELD PRIOR TO THE START OF CONSTRUCTION. THE CONTRACTOR SHALL BE RESPONSIBLE FOR ELEVATIONS AND DIMENSIONS THROUGHOUT THE CONSTRUCTION SCHEDULE. IF ANY DISCREPANCIES ARE FOUND TO EXIST BETWEEN THE CONSTRUCTION DOCUMENTS AND ACTUAL FIELD CONDITIONS, THE CONTRACTOR(S) MUST CONTACT THE PROJECT MANAGER IMMEDIATELY FOR INSTRUCTION BEFORE PROCEEDING.
- ALL RADII INDICATED SHALL BE FORMED AS CIRCULAR ARCS. SITE CONTRACTOR(S) SHALL MATCH EXISTING GRADE AND ALIGNMENT OF CURBS WHERE NEW CONSTRUCTION ABUTS EXISTING SITE CONDITIONS.
- SITE CONTRACTOR(S) MUST PROVIDE AT THE CONTRACTOR'S EXPENSE, ALL NECESSARY VEHICULAR AND PEDESTRIAN CONTROL DEVICES. TEMPORARY VEHICULAR AND PEDESTRIAN TRAFFIC CONTROL DEVICES AND METHODS USED DURING CONSTRUCTION MUST CONFORM WITH APPLICABLE FEDERAL, STATE, AND LOCAL STANDARDS. CONTRACTOR(S) MUST MEET MINIMAL REQUIREMENTS FOR EMERGENCY VEHICLE ACCESS ON SITE DURING CONSTRUCTION AS DETERMINED BY LOCAL AND/OR STATE CODES AND REGULATIONS.
- ALL CONSTRUCTION ACTIVITY ON THIS SITE TO BE PERFORMED IN COMPLIANCE WITH APPLICABLE O.S.H.A. STANDARDS FOR WORKER SAFETY.
- EXPANSION JOINTS SHALL BE REQUIRED AT ALL CONDITIONS WHERE CONCRETE PAVEMENT IS DIRECTLY ADJACENT TO PROPOSED STRUCTURES.
- ANY EXISTING VEGETATION ON OR ADJACENT TO THE PROJECT SITE THAT ARE DESIGNATED TO REMAIN SHALL BE PROTECTED FROM ANY AND ALL INJURY RESULTING FROM CONSTRUCTION TECHNIQUES AND/OR VEHICLES ON SITE. CONTRACTOR(S) MUST ESTABLISH A SUITABLE PERIMETER AROUND EACH SPECIMEN TO ENSURE THAT A PROPER ROOT ZONE IS MAINTAINED. FENCING MATERIAL USED TO DESIGNATE PLANT PROTECTION AREAS MUST BE CONSPICUOUS AND CLEARLY VISIBLE THROUGHOUT THE CONSTRUCTION SCHEDULE. EACH PROTECTION AREA SHALL CONTAIN PROPER SIGNAGE NOTIFYING WORKERS OF THE IMPORTANCE OF PREVENTING VEHICULAR TRAFFIC FROM ENTERING THE PROTECTED ROOT ZONE(S).
- REMOVE ALL EXISTING TRASH, DEBRIS AND RUBBLE THROUGHOUT THE SITE BEFORE THE COMPLETION OF THE CONSTRUCTION SEQUENCE. DISPOSAL OF SUCH MATERIAL MUST BE DONE IN ACCORDANCE WITH FEDERAL, STATE, COUNTY AND LOCAL LAWS AND REGULATIONS. THE CONTRACTOR(S) SHALL BE RESPONSIBLE FOR DAILY INSPECTIONS OF THE PROJECT SITE AND ADJACENT PROPERTY(S) TO DETECT AND REMOVE ANY MUD, GRAVEL, OR DEBRIS THAT HAVE BEEN TRACKED, DUMPED, SPILLED OR WIND-BLOWN ONTO AREAS ADJACENT TO PROJECT INCLUDING, BUT NOT LIMITED TO: RIGHTS-OF-WAY, PUBLIC OR PRIVATE STREETS, AND ROADS, DRIVEWAYS, YARDS AND/OR SIDEWALKS.
- IT SHALL BE THE RESPONSIBILITY OF EACH CONTRACTOR TO VERIFY ALL EXISTING UTILITIES AND CONDITIONS PERTAINING TO THE PHASE OF WORK. IT SHALL ALSO BE THE CONTRACTOR'S RESPONSIBILITY TO CONTACT THE OWNERS OF THE VARIOUS UTILITIES FOR PROPER STAKE LOCATION FOR EACH UTILITY BEFORE WORK IS STARTED. THE CONTRACTOR SHALL NOTIFY IN WRITING THE OWNER OR THE ENGINEER OF ANY CHANGES, OMISSIONS, OR ERRORS FOUND ON THESE PLANS OR IN THE FIELD BEFORE WORK IS STARTED OR RESUMED.
- IT SHALL BE THE RESPONSIBILITY OF THE CONTRACTOR TO ENSURE THAT ALL FILL AREAS SHALL BE COMPACTED TO AT LEAST 95 PERCENT OF THE MAXIMUM DRY DENSITY MODIFIED (ASTM D-1557)
- IT SHALL BE THE RESPONSIBILITY OF THE CONTRACTOR TO ADJUST ALL UTILITY COVERS, LIDS, AND ACCESS PANELS IN SUCH A MANNER AS TO BE FLUSH WITH THE WALKS AND CARE SHOULD BE TAKEN NOT TO DAMAGE THE UTILITY COVERS, LIDS AND ACCESS PANELS DURING CONSTRUCTION.

SITE PLAN NOTES


HARDSCAPE

- (H1) SAWCUT CONTROL JOINT
(SEE DETAIL 4 ON SHEET C800).
- (H2) EXPANSION JOINT
(SEE DETAIL 5 ON SHEET C800).

- EXISTING BRICK AND STONE BASE TO REMOVE AND REPLACE WITH STANDARD CONCRETE
(SEE DETAIL 7 ON SHEET C800).
- EXISTING CONCRETE TO DEMO AND REPLACE WITH STANDARD CONCRETE
(SEE DETAIL 7 ON SHEET C800).

SIGNAGE & MARKINGS

- (S1) ALTERNATE #1: LIMESTONE BLOCK
ALTERNATE #2: CONCRETE PLANTER
(SEE DETAIL 1/2 ON SHEET C800).
- (S2) ALL NEW CONCRETE TO BE DOWELED INTO ABUTTING CONCRETE.
MINIMUM OF ONE DOWEL PER SQUARE.
(SEE DETAIL 9 ON SHEET C800).

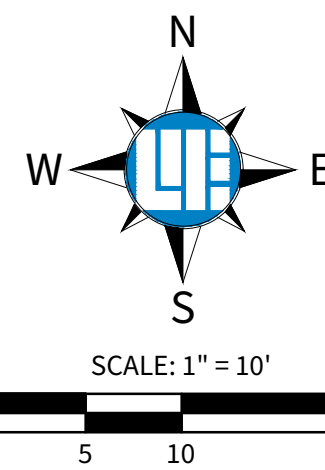

811
Know what's below.
Call before you dig.
Within Indiana Call
811 or 800-362-5544
24 Hours a Day, 7 Days a Week.
PER INDIANA STATE LAW IC 8-1-26,
IT IS AGAINST THE LAW TO EXCAVATE
WITHOUT NOTIFYING THE UNDERGROUND
LOCATION SERVICE (UDS) (2) WORKING
DAYS BEFORE COMMENCING WORK.

10505 N. College Ave.
Indianapolis, IN 46280
317.846.6611 · weihe.net

WEIHE
ENGINEERS
BUILD WITH CONFIDENCE™

LAND SURVEYING · CIVIL ENGINEERING · SUSTAINABLE DESIGN · LANDSCAPE ARCHITECTURE

DESIGNED BY:	BY:	DATE:
MM	HW	07.16.2026
MM	HW	07.17.2026
MM	HW	07.17.2026
MM	HW	07.17.2026

DRAWN BY:	BY:
AH	HW

CHECKED BY:	BY:
MM	HW

APPROVAL PENDING
NOT FOR CONSTRUCTION

MONON COMMUNITY CENTER PAVING PROJECT
1195 Central Park Dr., Carmel, IN 46032

SITE PLAN
Part of the 2024 of Section XX, Township XX North, Range X East, XXXX Township, XXX County, Indiana

SHEET NO.
C303

PROJECT NO.
W260292

