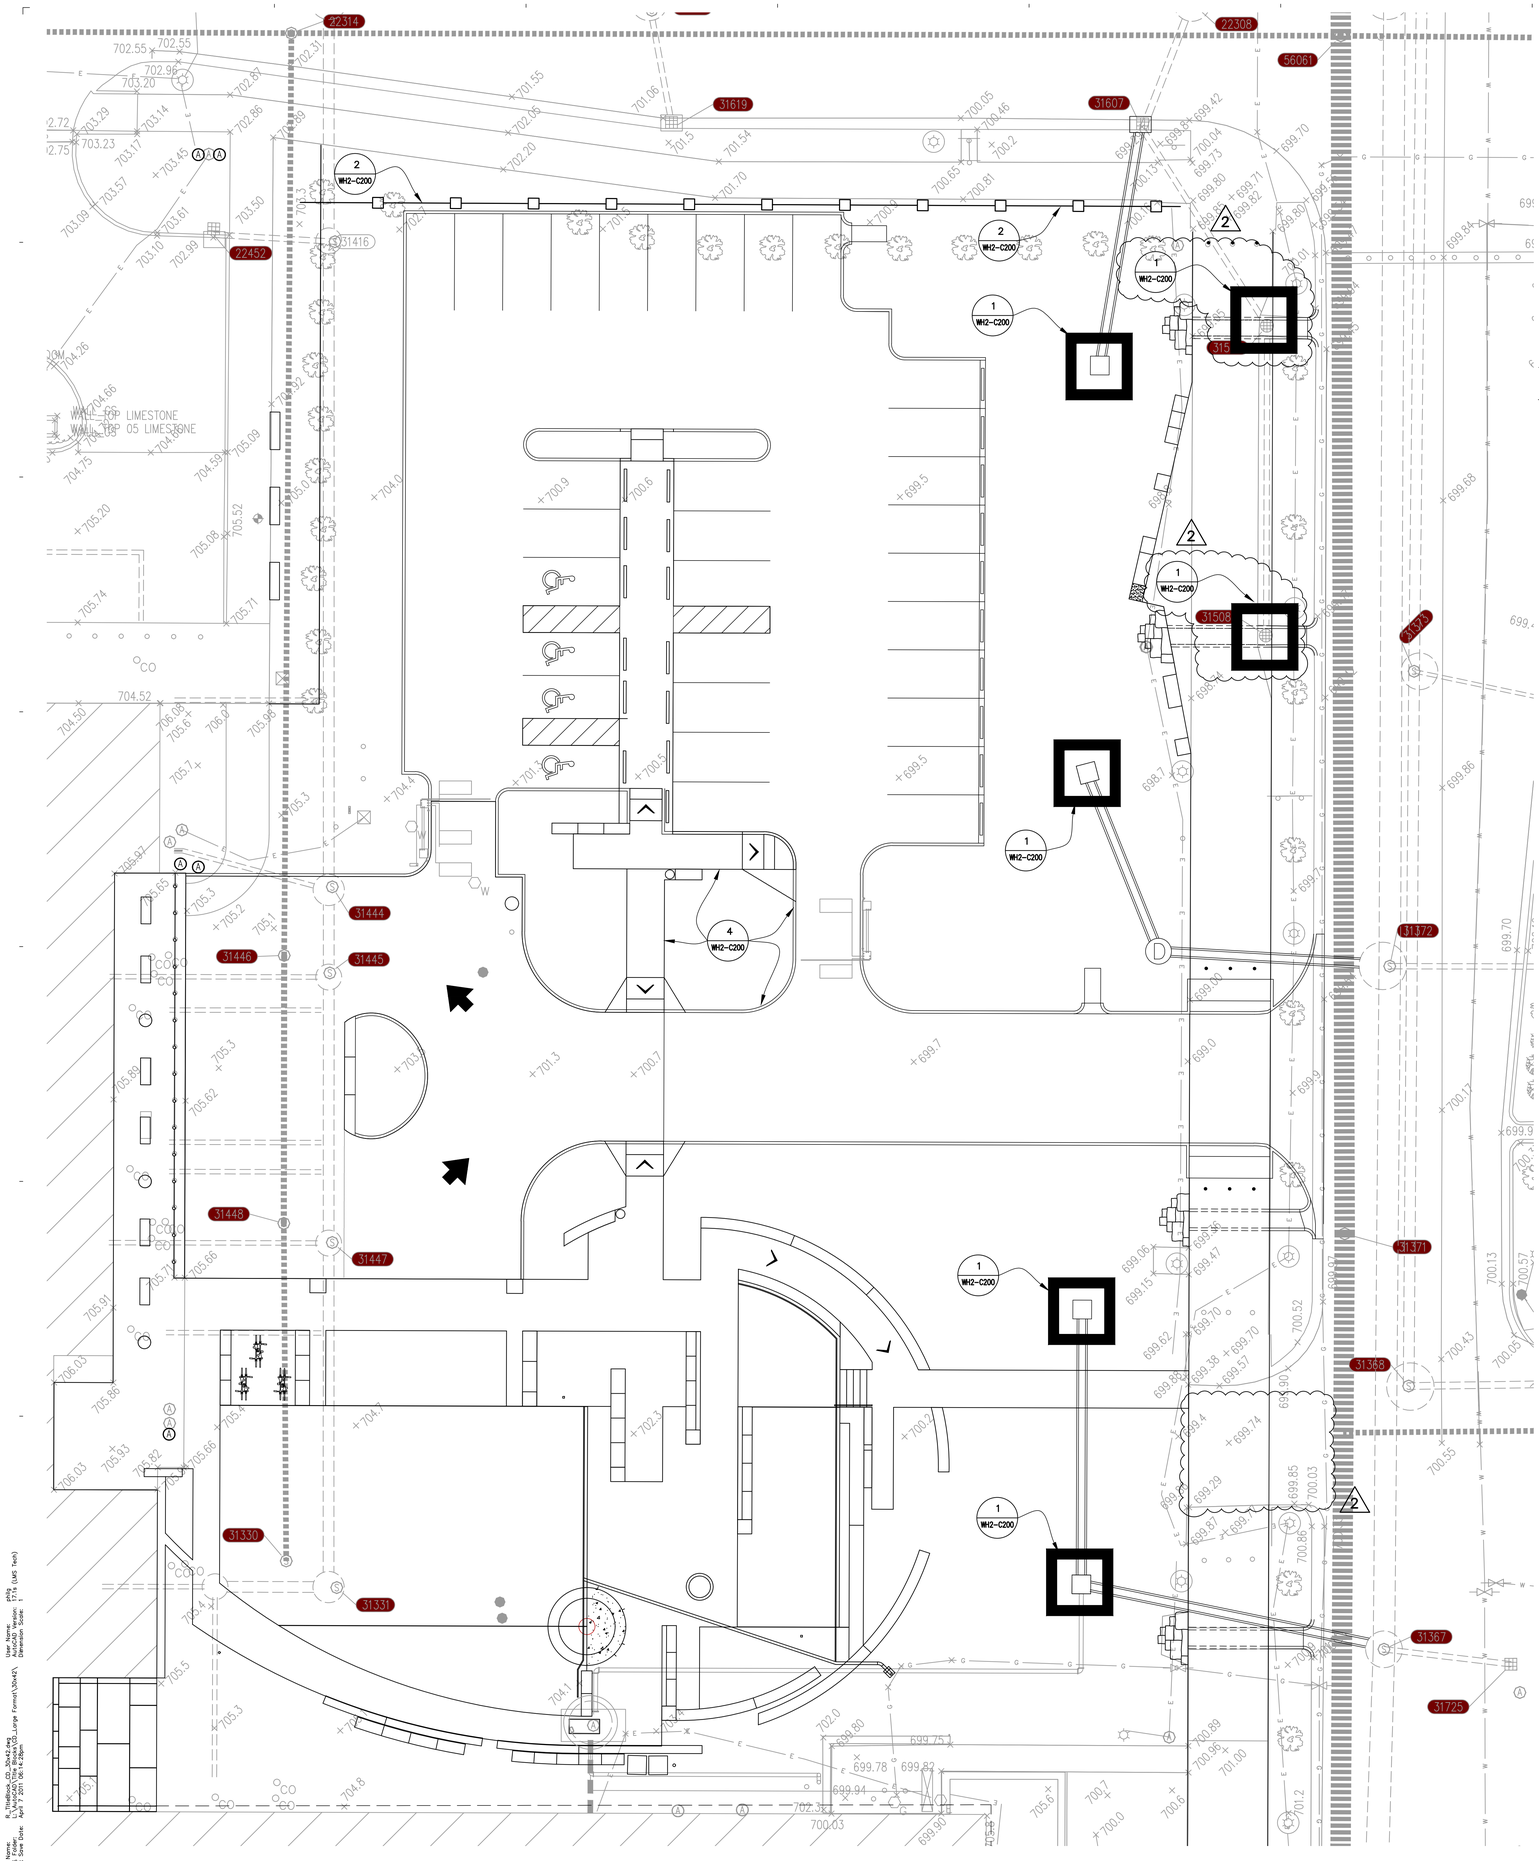

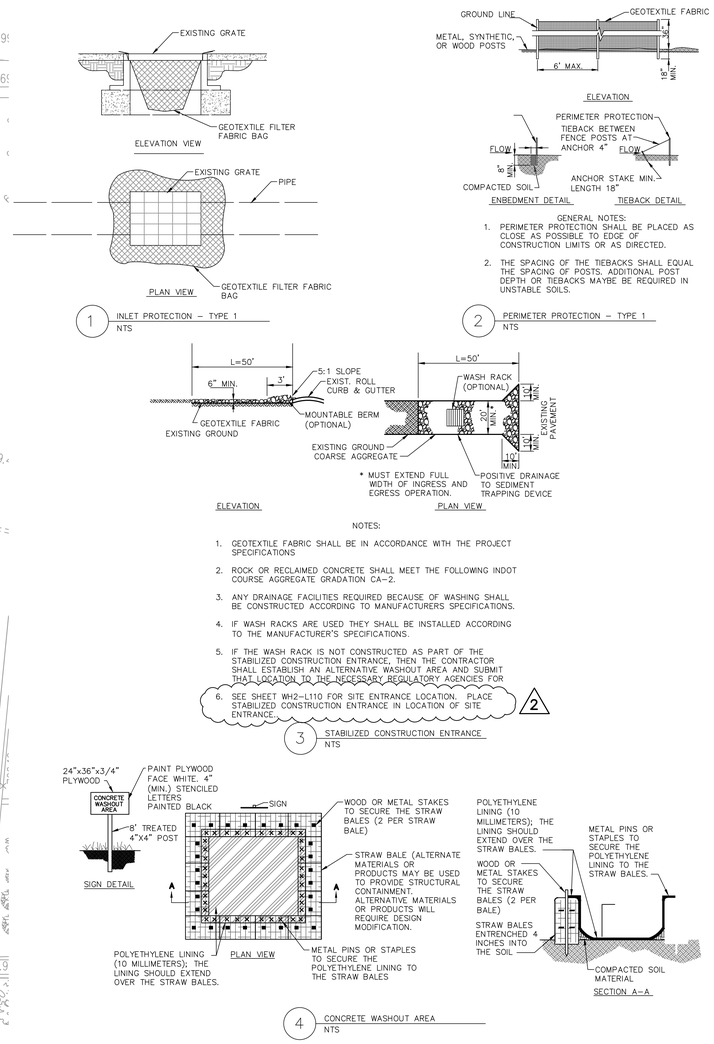

CONSTRUCTION BMP MAINTENANCE GUIDELINES

PERIMETER PROTECTION

1. IF FENCE FABRIC OR COIR LOG IS BREACHED, STARTS TO DECOMPOSE OR IN ANY WAY BECOMES INEFFECTIVE, THE CONTRACTOR SHALL REPLACE THE AFFECTED PORTION IMMEDIATELY.
2. REMOVE THE DEPOSITED SEDIMENT WHEN IT REACHES HALF THE HEIGHT OF THE PERIMETER PROTECTION MEASURE AT ITS LOWEST POINT, OR IF IT CAUSING THE PERIMETER PROTECTION MEASURE TO BULGE.
3. TAKE CARE TO AVOID UNDERMINING THE PERIMETER PROTECTION MEASURE DURING CLEAN OUT.
4. THE CONTRACTOR SHALL BE RESPONSIBLE FOR INSPECTING THE PERIMETER PROTECTION MEASURES WITHING 24 HOURS OF ANY MEASURABLE PRECIPITATION.

INLET PROTECTION

1. REPLACE GEOTEXTILE FILTER FABRIC BAGS WHEN THEY BECOME THREE QUARTERS FULL, OR WHEN THE SEDIMENT IMPEDES THE PASSAGE OF STORMWATER INTO THE SYSTEM.
2. INLET PROTECTION SHALL BE INSPECTED AND CLEANED AFTER EVERY RAIN EVENT, OR AT LEAST ONCE A WEEK.

TEMPORARY CONSTRUCTION ENTRANCE

1. THE ENTRANCE SHALL BE MAINTAINED IN A CONDITION WHICH WILL PREVENT TRACKING OR FLOW OF SEDIMENT ONTO PUBLICH RIGHT OF WAY. THIS MAY REQUIRE PERIODIC TOP DRESSING WITH ADDITIONAL STORE OR THE WASHING AND REWORKING OF EXISTING STONE AS CONDITIONS DEMAND AS WELL AS THE REPAIR AND CLEANOUT OF STRUCTURES USED TO TRAP SEDIMENT.
2. INSPECTIONS SHALL BE MADE AT LEAST ONCE EVERY 7 DAYS AND AFTER ANY STORM EVENT OF GREATER THAN 0.5 INCHES OF PRECIPITATION DURING ANY 24 HOUR PERIOD.
3. ALL MATERIALS SPILLED, DROPPED, WASHED OR TRACKED FROM VEHICLES ONTO ROADWAYS OR INTO STORM DRAINS MUST BE REMOVED IMMEDIATELY. THE USE OF WATER TRUCKS TO REMOVE MATERIALS DROPPED, WASHED OR TRACKED ONTO ROADWAYS WILL NOT BE PERMITTED UNDER ANY CIRCUMSTANCES.
4. THE CONSTRUCTION ENTRANCE SHALL NOT BE REMOVED FROM THE SITE AND MAINTENANCE SHALL NOT CEASE UNTIL THE SITE CONSTRUCTION IS SUFFICIENTLY COMPLETE SUCH THAT EXTING TRAFFIC WILL NO LONGER TRACK MATERIAL ONTO THE PUBLIC STREET OR PAVED AREA. ALL FILTER FABRIC, STONE SURFACING AND ANY OTHER MATERIALS USED IN THE CONSTRUCTION OF THE ENTRANCE SHALL BE COMPLETELY REMOVED FROM THE SITE AND DISPOSED OF PROPERLY.

N

SCALE: 1"=10'
10' 0 10'

ESKENAZI WOMEN'S GARDEN
INDIANAPOLIS, INDIANA

Owner
Health & Hospital Corporation d.b.a. Eskenazi Health
720 Eskenazi Avenue
Indianapolis, IN 46202
(317)880-0000

Architect
RATIO Architects, Inc.
101 South Pennsylvania Street
Indianapolis, Indiana 46204
(317) 633-4040

Civil Engineer
VS Engineering, Inc.
203 Main St., Suite 102
Evansville, Indiana 47708
(812) 401-0303

Electrical Engineer
Biaggi Chance Cummins London and Titzer (BCCLT)
300 Northwest Second Street
Evansville, Indiana 47708
(812) 423-4407

Irrigation Design
Irrigation Design Source
112 Shadowlawn Drive
Fishers, Indiana 46038
(317) 842-3123

Structural Engineer
American Structurepoint, Inc.
7260 Shadeland Station
Indianapolis, IN 46256
(317)-547-5580

SEAL | DATE 04/20/18

NICHOLAS R. JAHN REGISTERED NO. 10910591 STATE OF INDIANA PROFESSIONAL ENGINEER

SHEET ISSUE		
1	BID SET	04/05/18
2	ADDENDUM NO. 2	04/20/18

RATIO

COPYRIGHT NOTICE: THIS ARCHITECTURAL AND ENGINEERING DRAWING IS GIVEN IN CONFIDENCE AND SHALL BE USED ONLY PURSUANT TO THE AGREEMENT WITH RATIO ARCHITECTS, INC. NO OTHER USE, DISSEMINATION OR DUPLICATION MAY BE MADE WITHOUT PRIOR WRITTEN CONSENT OF RATIO ARCHITECTS, INC. ALL COMMON LAW RIGHTS OF COPYRIGHT AND OTHERWISE ARE HEREBY SPECIFICALLY RESERVED.

PROJECT NO. 17038.000

SHEET TITLE
EROSION CONTROL DETAILS

SHEET NUMBER
WH2-C000