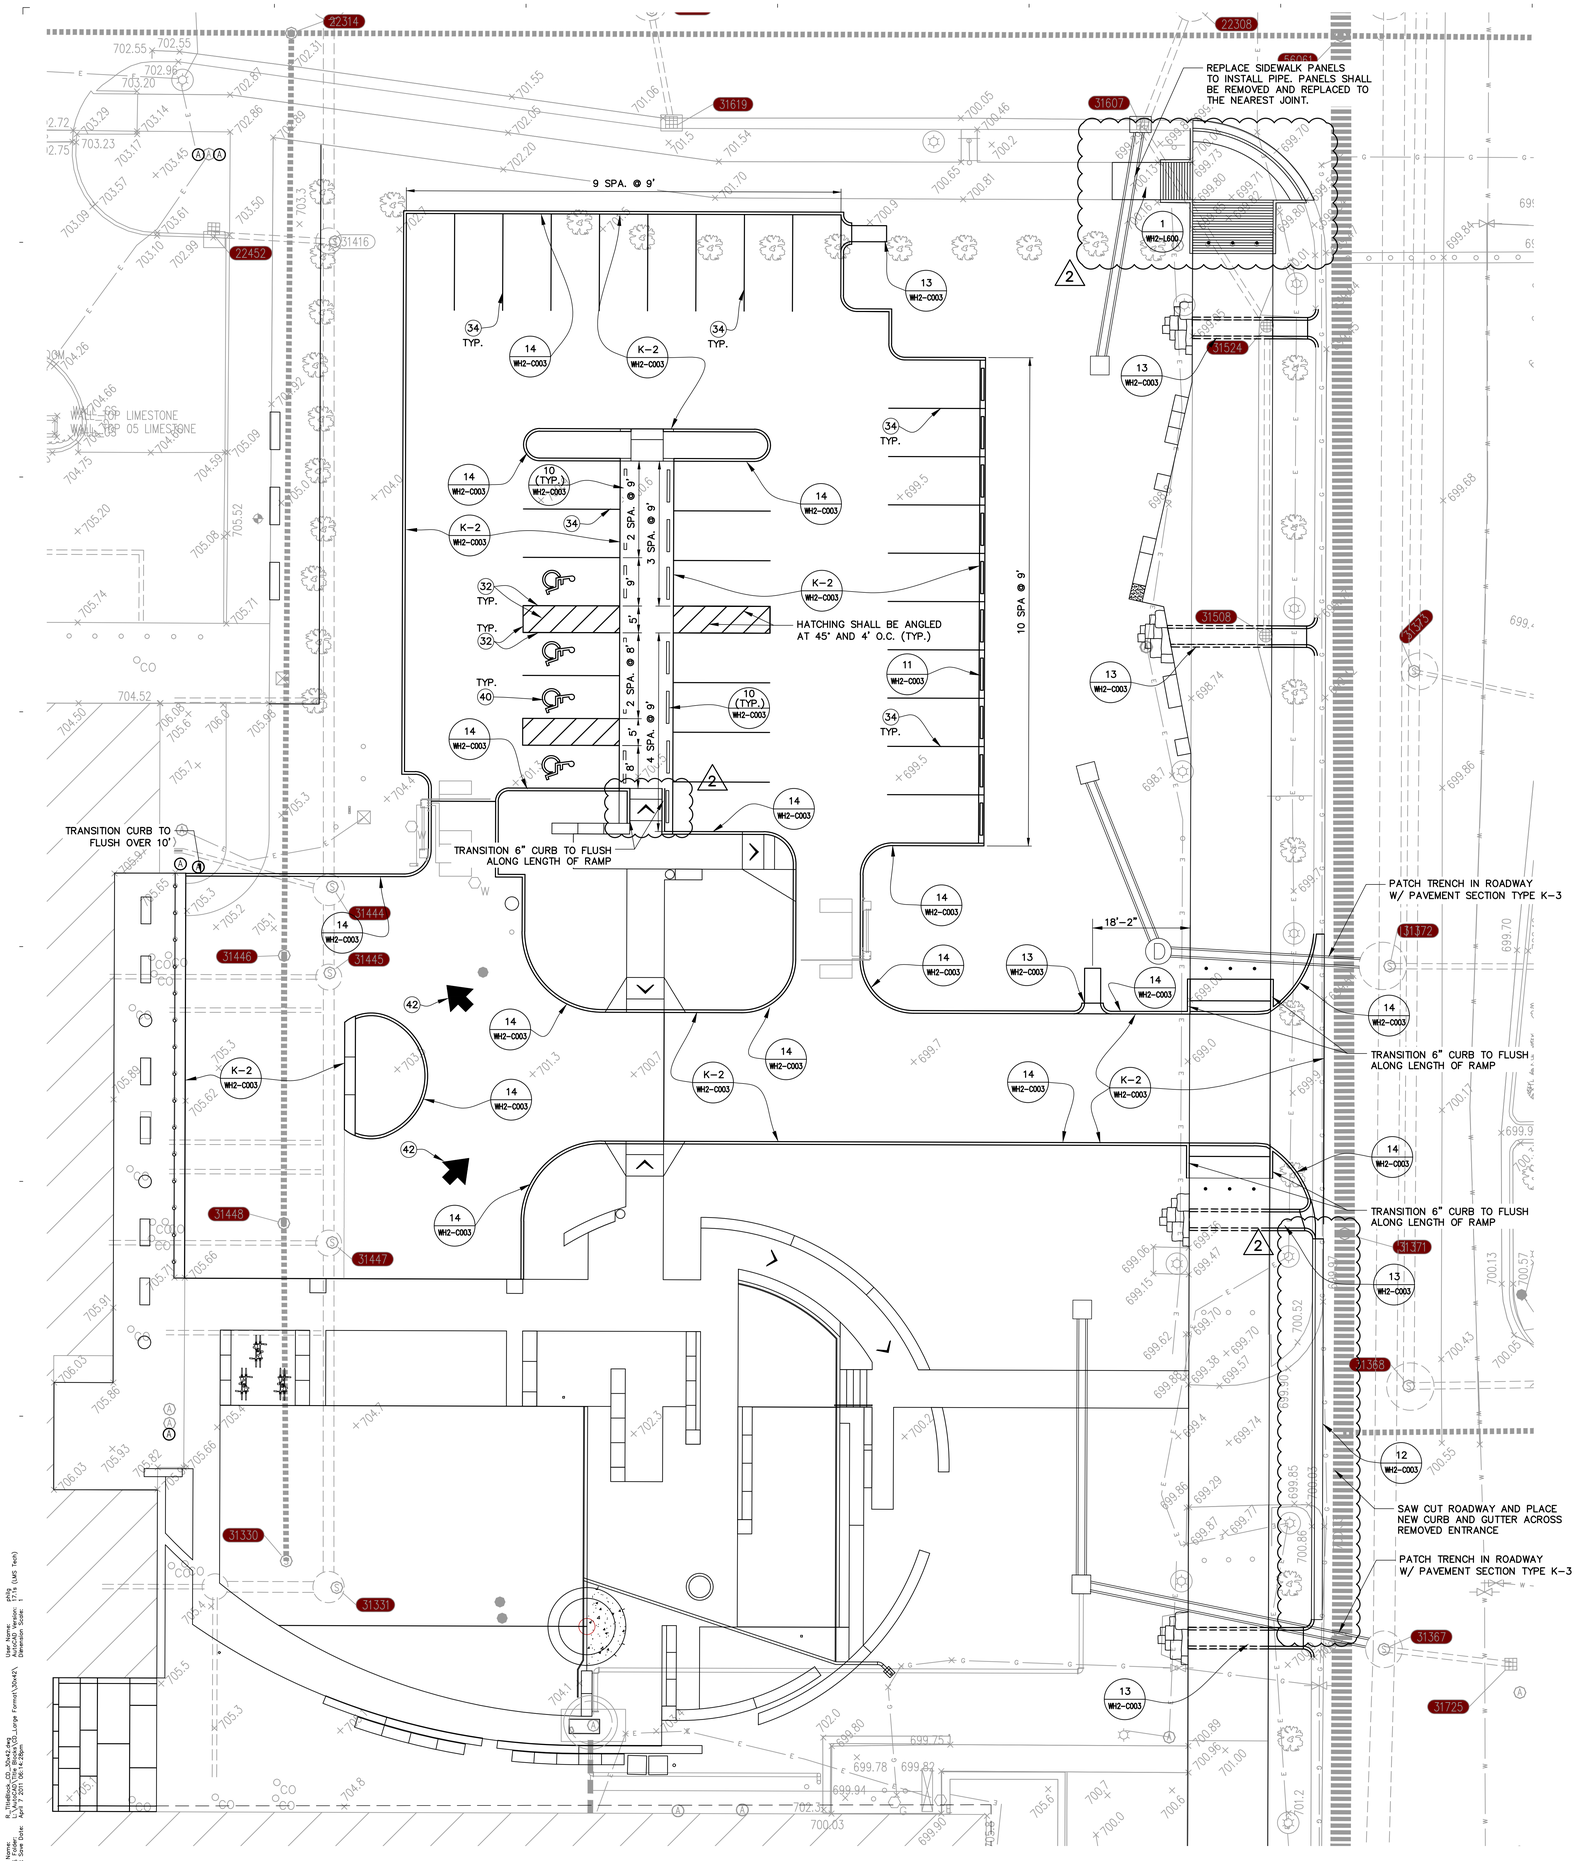

PAVEMENT MARKING LEGEND

- (32) LINE, SOLID, BLUE, 4"
- (34) LINE, SOLID, WHITE, 4"
- (35) LINE, SOLID, YELLOW, 4"
- (36) LINE, BROKEN, WHITE, 4" (10' LINE, 30' GAP)
- (39) TRANSVERSE MARKING, STOP LINE, WHITE, 24"
- (40) PAVEMENT MARKING, SYMBOL, HANDICAP
- (41) TRANSVERSE MARKING, CROSSWALK, WHITE, 6"
- (42) PAVEMENT MARKING, SYMBOL, FLOW INDICATION ARROW, PARKING LOT
- (44) PAVEMENT MARKING, SYMBOL, LANE INDICATION ARROW, ROADWAY
- (49) LINE, SOLID, YELLOW, 8"
- (50) PAVEMENT MARKING, SYMBOL, FUEL EFFICIENT VEHICLE (FEV)
- (51) PAVEMENT MARKING, SYMBOL, HIGH OCCUPANCY VEHICLE (HOV)

2

PAVEMENT MARKING NOTES

1. DIMENSIONS SHOWN ARE FEET AND INCHES.
3. SEE LANDSCAPE PLANS FOR CROSS WALK TREATMENTS NOT DENOTED ON PAVEMENT MARKING SHEETS.
4. DO NOT PLACE PAVEMENT MARKINGS ACROSS CROSS WALK TREATMENTS.
5. ALL PAVEMENT MARKINGS TO BE PAINT UNLESS OTHERWISE NOTED
6. A MINIMUM DISTANCE OF 4' SHALL BE MAINTAINED BETWEEN BETWEEN OUTSIDE EDGE OF STOP BARS AND CROSS WALK LINE.
7. CONTRACTOR SHALL MARK ALL PAVEMENT MARKING LOCATIONS WITH SPRAY PAINT PRIOR TO PLACEMENT OF PERMANENT MARKINGS. ALL SPRAY PAINTED PAVEMENT MARKING LOCATIONS SHALL BE APPROVED BY PM/CM TEAM PRIOR PLACEMENT OF PERMANENT MARKINGS.

GENERAL NOTES

1. ALL DIMENSIONS SHALL BE MEASURED TO BACK OF CURB. IF NO CURB IS PRESENT DIMENSION SHALL BE MEASURED TO THE EDGE OF PAVEMENT
2. ALL COORDINATES GIVEN CORRESPOND TO BACK OF CURB. IF NO CURB IS PRESENT COORDINATES SHALL BE MEASURED TO THE EDGE OF PAVEMENT.
3. DIMENSIONS SHOWN ARE FEET AND DECIMAL PARTS THEREOF.
4. DO NOT SCALE FROM THESE PLANS FOR SURVEY FIELD LOCATIONS.
5. END OF ALL CURBS TO BE CHAMFERED.
6. SEE RECORD SURVEYS FOR DETAILED INFORMATION REGARDING BOUNDARY, EASEMENTS AND RIGHTS-OF-WAY.
7. SEE ARCHITECTURAL PLANS FOR BUILDING DIMENSIONS AND DOOR LOCATIONS.
8. SEE LANDSCAPE PLANS FOR SIDEWALK CONSTRUCTION, PLANTING MATERIALS AND GARDEN DETAILS.
9. SEE STRUCTURAL PLANS FOR RETAINING WALL LOCATIONS AND DETAILS.
10. SEE ON-SITE PARKING LOT GRADING PLANS, GRADING DETAIL SHEETS AND ON-SITE ROADWAY PLAN AND PROFILES FOR PROPOSED ELEVATION INFORMATION.
11. SITE UTILITIES AND STORM SEWERS INSTALLED BY PREVIOUS BID PACKAGE AND ARE SHOWN FOR REFERENCE PURPOSES ONLY. CONTRACTOR SHALL BE RESPONSIBLE FOR VERIFYING ELEVATIONS AND LOCATIONS OF ALL SITE UTILITIES AND STORM SEWERS (INCLUDING TOPS OF CASTINGS) PRIOR TO CONSTRUCTION.

MAINTENANCE OF TRAFFIC NOTES

1. CONTRACTOR MAY CLOSE OFF SOUTHBOUND LANE OF ESKENAZI AVE. IN ORDER TO CONNECT PROPOSED STORM SEWER SYSTEM WITH EXISTING STORM SEWER SYSTEM AND COMPLETE SURFACE RESTORATION.
2. A MINIMUM OF 2-10' LANES SHALL BE MAINTAINED AT ALL TIMES UNLESS OTHERWISE APPROVED IN WRITING BY THE OWNER.
3. ALL TRAFFIC CONTROL DEVICES SHALL BE IN ACCORDANCE WITH THE MANUAL ON UNIFORM TRAFFIC CONTROL DEVICES, LATEST EDITION AND THE INDIANA DEPARTMENT OF TRANSPORTATION STANDARD SPECIFICATIONS AND STANDARD DRAWINGS, LATEST REVISION.
4. CONTRACTOR SHALL SUBMIT SHOP DRAWINGS DETAILING LANE CLOSURE TO ENGINEER FOR APPROVAL A MINIMUM OF TWO WEEKS PRIOR TO THE DESIRED LANE CLOSURE.
5. CONTRACTOR SHALL INCLUDE ALL COSTS REQUIRED TO TEMPORARILY SHIFT TRAFFIC IN BIDS. THESE COSTS SHALL INCLUDE ALL SIGNAGE, DELINEATORS, TEMPORARY PAVEMENT MARKINGS, ARROWBOARDS, ETC. NECESSARY TO TEMPORARILY SHIFT TRAFFIC AS REQUIRED BY THE MANUAL ON UNIFORM TRAFFIC CONTROL DEVICES, LATEST EDITION AND THE INDIANA DEPARTMENT OF TRANSPORTATION STANDARD SPECIFICATIONS AND STANDARD DRAWINGS, LATEST REVISION.

N

SCALE: 1"=10'

ESKENAZI WOMEN'S GARDEN
INDIANAPOLIS, INDIANA

Owner
Health & Hospital Corporation d.b.a. Eskenazi Health
720 Eskenazi Avenue
Indianapolis, IN 46202
(317)880-0000

Architect
RATIO Architects, Inc.
101 South Pennsylvania Street
Indianapolis, Indiana 46204
(317) 633-4040

Civil Engineer
VS Engineering, Inc.
203 Main St., Suite 102
Evansville, Indiana 47708
(812) 401-0303

Electrical Engineer
Biaggi Chance Cummins London and Titzer (BCCLT)
300 Northwest Second Street
Evansville, Indiana 47708
(812) 423-4407

Irrigation Design
Irrigation Design Source
112 Shadowlawn Drive
Fishers, Indiana 46038
(317) 842-3123

Structural Engineer
American Structurepoint, Inc.
7260 Shadeland Station
Indianapolis, IN 46256
(317)-547-5580

SEAL | DATE 04/20/18

NICHOLAS R. JAHN REGISTERED NO. 10910591 STATE OF INDIANA PROFESSIONAL ENGINEER

SHEET ISSUE

1	BID SET	04/05/18
2	ADDENDUM NO. 2	04/20/18

RATIO

COPYRIGHT NOTICE: THIS ARCHITECTURAL AND ENGINEERING DRAWING IS GIVEN IN CONFIDENCE AND SHALL BE USED ONLY PURSUANT TO THE AGREEMENT WITH RATIO ARCHITECTS, INC. NO OTHER USE, DISSEMINATION OR DUPLICATION MAY BE MADE WITHOUT PRIOR WRITTEN CONSENT OF RATIO ARCHITECTS, INC. ALL COMMON LAW RIGHTS OF COPYRIGHT AND OTHERWISE ARE HEREBY SPECIFICALLY RESERVED.

PROJECT NO. 17038.000

SHEET TITLE
PARKING LOT AND ACCESS DRIVE MATERIALS PLAN

SHEET NUMBER
WH2-C001

File Name: R_TitleBlock_CD_30x42.dwg
File Type: AutoCAD Release 2007 - Large Format(30x42)
Last Save Date: April 7 2011 06:14:28pm
