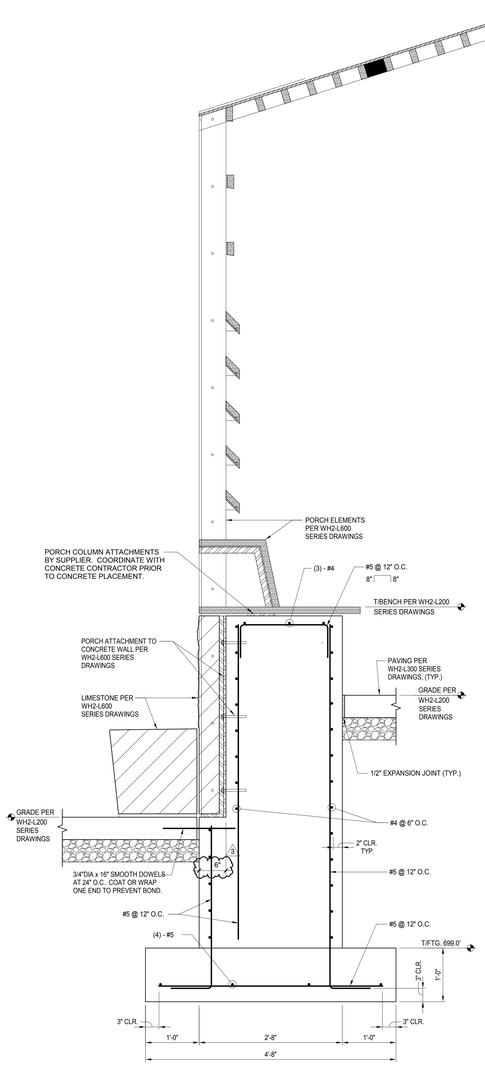

1 WH2-S421 **THE PORCH**
N.T.S.

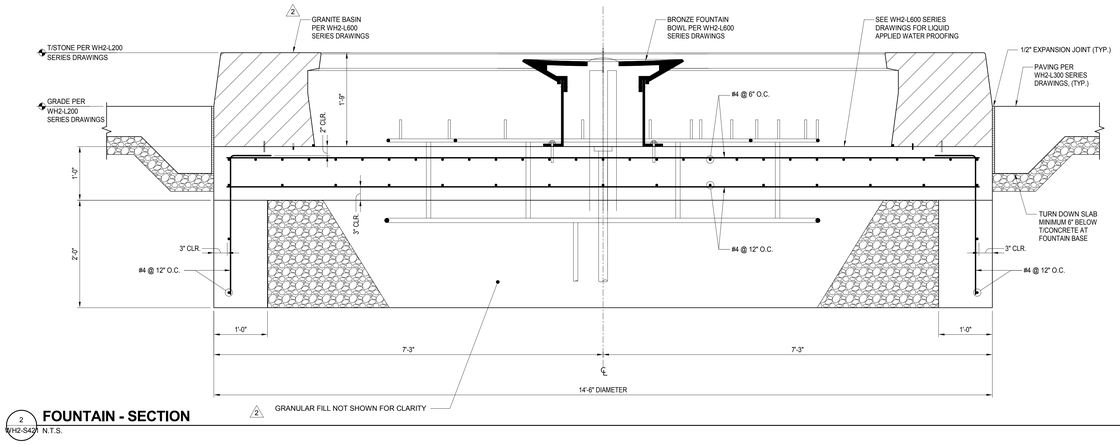

2 WH2-S421 **FOUNTAIN - SECTION**
N.T.S.

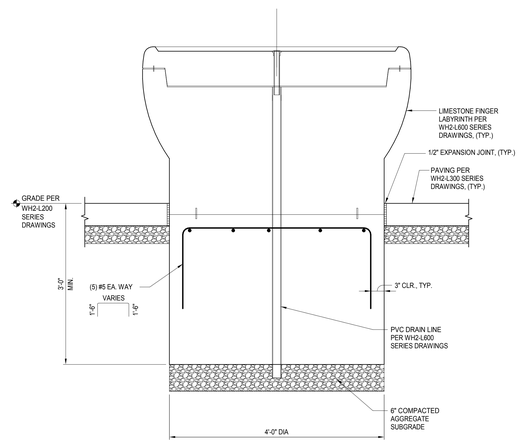

3 WH2-S421 **LARGE FINGER LABYRINTH: SECTION**
N.T.S.

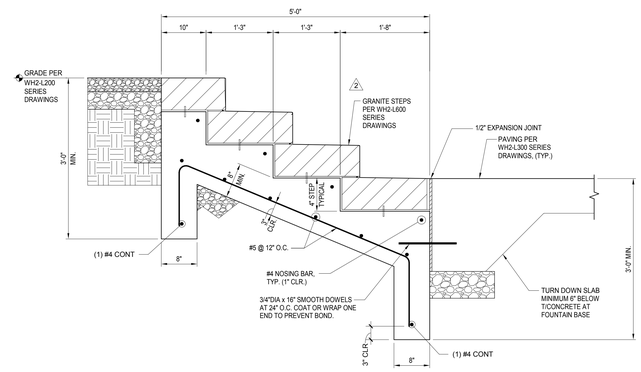

4 WH2-S421 **SECTION AT PORCH STEPS**
N.T.S.

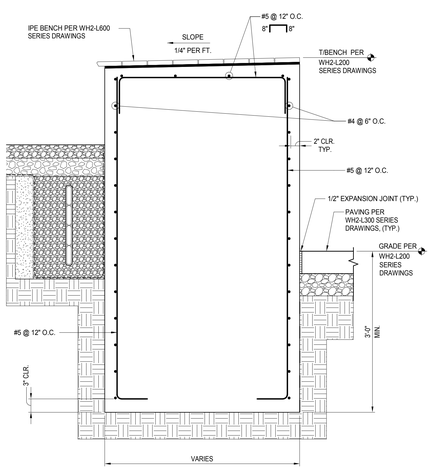

5 WH2-S421 **BENCH AT STAIR: SECTION**
N.T.S.

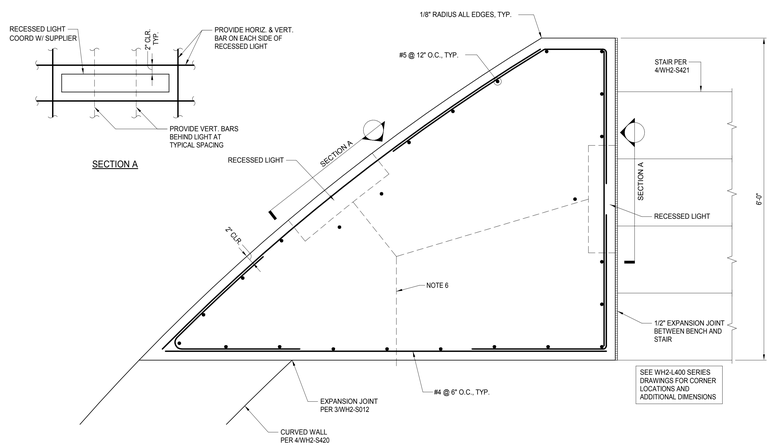

6 WH2-S421 **BENCH AT STAIR: PLAN**
N.T.S.

ESKENAZI WOMEN'S GARDEN

INDIANAPOLIS, INDIANA

Owner
Health & Hospital Corporation d.b.a Eskenazi Health
720 Eskenazi Avenue
Indianapolis, In 46202
(317)880-0000

Architect
RATIO Architects, Inc.
101 South Pennsylvania Street
Indianapolis, Indiana 46204
(317) 633-4040

Civil Engineer
VS Engineering, Inc.
203 Main St., Suite 102
Evansville, Indiana 47708
(812) 401-0303

Electrical Engineer
Biaggi Chance Cummins London and Titzer (BCCLT)
300 Northwest Second Street
Evansville, Indiana 47708
(812) 423-4407

Irrigation Design
Irrigation Design Source
112 Shadowlawn Drive
Fishers, Indiana 46038
(317) 842-3123

Structural Engineer
American Structurepoint, Inc.
7260 Shadeland Station
Indianapolis, IN 46256
(317)-547-5580

SEAL | DATE

REGISTERED No. 11500704 STATE OF INDIANA BRADLEY D. CURTIS

04/20/2018

SHEET ISSUE

1	BID SET	04/05/18
2	ADDENDUM #1	04/13/18
3	ADDENDUM #2	04/20/18

RATIO

COPYRIGHT NOTICE: THIS ARCHITECTURAL AND ENGINEERING DRAWING IS GIVEN IN CONFIDENCE AND SHALL BE USED ONLY FOR THE PURPOSES INTENDED BY RATIO ARCHITECTS, INC. OTHER USE OR REPRODUCTION WITHOUT PRIOR WRITTEN CONSENT OF RATIO ARCHITECTS, INC. IS STRICTLY PROHIBITED. NO ALL COMMON LAW RIGHTS OF COPYRIGHT AND OTHERWISE ARE HEREBY SPECIFICALLY RESERVED.

PROJECT NO. 2018.00351

SHEET TITLE

STRUCTURAL SECTIONS AND DETAILS - WOMEN'S GARDEN

SHEET NUMBER

WH2-S421