



A D D E N D U M

Project No.: 2401110

Project: EACS HS Classroom Renovations

Addendum No: 02

Date: 12-18-2024

TO: ALL BIDDERS OF RECORD

ADDENDUM NO. 02, to Drawings and Specifications dated 11-27-2024, for the HS Classroom Renovations for the East Allen County Schools; as prepared by ELEVATUS Architecture, 111 E. Wayne Street, Suite 555, Fort Wayne, IN 46802

This ADDENDUM shall hereby be and become a part of the Contract Documents the same as if originally bound thereto.

The following clarifications, amendments, additions, revisions, changes, and modifications change the original Contract Documents only in the amount and to the extent hereinafter specified and set forth in this ADDENDUM.

Each Bidder shall acknowledge receipt of this ADDENDUM on the Bid Form.

PROJECT MANUAL:

ITEM NO. 1.01 - PROJECT MANUAL, 00 25 13, Pre-Bid Conference

- A. Revise location of Pre-Bid conference to reflect change to Notice to Bidders in Addendum #1

ITEM NO. 1.02 - PROJECT MANUAL, 10 14 00, Identifying Devices

- A. Article 1.3, paragraph B; revise to read in Braille **per applicable state and local ADA Building Codes**

DRAWINGS HERITAGE JR/SR HIGH SCHOOL:

ITEM NO. 2.01 - DRAWING NO. AD101 Architectural Demolition Plan – Second Floor

- A. Removal of Demolition Plan Notes 3.07 from Second Floor Architectural Demolition Plan.
- B. Removal of note 3.07 from Demolition Plan Notes.

ITEM NO. 2.02 - DRAWING NO. A-111 Architectural Notation Plan – Second Floor

- C. Addition of Floor Plan Note 4.01 to rooms 204, 205, 206, 207, 208, 209.
- D. Addition of note 4.01 to Floor Plan Notes.
- E. Removal of Floor Plan Note 9.01 from Second Floor Architectural Notation Plan
- F. Removal of note 9.01 from Floor Plan Notes.
- G. Removal of Door Elevation – Transom Infill #2.
- H. Removal HM Frame Transom Infill Detail #3.

ITEM NO. 2.03 - DRAWING NO. A-141 Finishes Plan – Second Floor

- A. Revision to Elevation - Typ. Classroom Casework #2
- B. Revision to Elevation - Classroom Instruction Wall #4

DRAWINGS WOODLAN JR/SR HIGH SCHOOL:

ITEM NO. 2.04 - DRAWING NO. AD101 Architectural Demolition Plan – Second Floor In response to RFI #B-03

- A. Addition of note 3.13 to Demolition Plan Notes.
- B. Addition of Demolition Plan Note 3.13 to Hallway 200.

ITEM NO. 2.05 - DRAWING NO. A-111 Architectural Notation Plan – Second Floor In response to RFI #B-03

- A. Addition of note 11.03 to Floor Plan Notes.
- B. Addition of Floor Plan Note 11.03 to Second Floor Architectural Notation Plan

ITEM NO. 2.06 - DRAWING NO. A-141 Finishes Plan – Second Floor

- A. Revision of Finish Plan Note 1.

ITEM NO. 2.07 – MEP Addendum #2

- A. Refer to attached MEP Addendum

Submitted By:


Abigail Redick, WELL AP

ELEVATUS
ARCHITECTURE

cc: File: Document1
 Owner:
 Contractor:
 Consultant:
 Consultant:



Primary Engineering, Inc.
2828 Lake Ave.
Fort Wayne, Indiana 46805
260-424-0444 ph
www.primary-eng.com

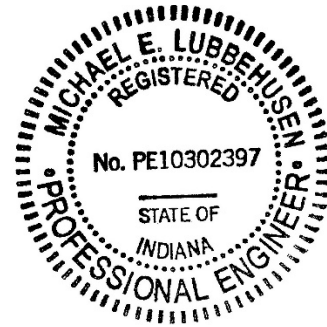

Addendum: **#2**

Date: **12/18/2024**

Project: **EACS HS Classroom Renovations**

Comm #: **24667**

The following items shall be incorporated into the specifications and drawings and are considered to be integral to the bid documents for the project. Acknowledgement of receipt of this addendum is required on the bid form.

Item #1: General Clarifications.

A. Alternates:

- Alternate #1 - Leo HS - Classroom 156
- Alternate #2 - Leo HS - Classroom 142
- Alternate #3 - Heritage HS - Classroom 205
- Alternate #4 - Heritage HS - Classroom 204
- Alternate #5 - Woodlan HS - Classroom 207B
- Alternate #36 - Woodlan HS- Classroom 207A

- B. Heritage HS: Remove existing finned tube radiation complete including all associated mounting devices, piping, electrical, controls and cover panels. Cap piping below slab. Coordinate with GC to patch to match adjacent surroundings.**

Item #2: Woodland HS: Drawing Sheet M001, "Mechanical Information Sheet":

- A. Added Diffuser and Grille Schedule. Refer to drawing sheet M001 labeled Addendum #2 for more information.**

Item #3: Woodland HS: Drawing Sheet M101, "Second Floor Mechanical Plan":

- A. Added transfer grilles and openings above ceilings. Refer to drawing sheet M101 labeled Addendum #2 for more information.**

Item #4: Leo HS: Drawing sheet E001, "Electrical Information sheet":

- A. Revise Light Fixture Schedule, added emergency exit fixture. Refer to sheet E001.**

Item #5: Leo HS: Drawing sheet E001, "Lighting Plan":

- A. Added emergency exit light fixtures in classroom 142. Refer to sheet E301.**

SECTION 00 25 13 - PRE-BID CONFERENCE

PRE-BID CONFERENCE
for the

EACS HS Classroom Renovations at
Leo Jr/Sr High School
Heritage Jr/Sr High School
Woodlan High School

There will be a pre-bid conference held on at 10:00 AM (local time) Thursday December 05, 2024 at the EACS Annex Building, 800 Homestead Drive EACS Service Center Conference Room, 1322 Green Road, New Haven, IN 46774, consisting of review of the project. At this time the Owner's representatives and Architect will discuss the project requirements and procedures. Contractors are highly encouraged to attend. Failure to attend does not relieve the bidder from the responsibility to carry out the work in the manner discussed at the conference. This pre-bid conference does not relieve the bidders to the on-site inspection of the project requirements.

END OF SECTION

THIS PAGE INTENTIONALLY LEFT BLANK

PART 1 - GENERAL

1.1 SUMMARY

- A. Provide labor, materials, and equipment necessary for the complete installation of identifying devices as indicated on the Drawings and specified herein.
 - 1. Interior signage

1.2 SUBMITTALS

- A. Furnish required shop drawings and other submittals as required for Architect selection in accordance with Division 01 requirements.
- B. Product data sheets including installation instructions for each item specified.

1.3 QUALITY ASSURANCE

- A. Each door to each occupied space shall have a room sign installed.
- B. All room signage and life safety signage shall be in Braille per applicable state and local ADA Building Codes<%Codes%>.

1.4 AMERICANS WITH DISABILITIES ACT (ADA) REQUIREMENTS

- A. Signage shall be provided to conform with ADA requirements. ADA requirements superseded Technical Specifications in this Section. Manufacturer shall conform to tactile, Braille, letter size, and other requirements as may be required by ADA Accessibility Guidelines for Buildings and Facilities, Section 4.30, Signage, and other applicable sections; and State and Local Codes and Regulations.

PART 2 - PRODUCTS

2.1 INTERIOR SIGNAGE

- A.. Interior Room Name and Number Signs:
 - 1. Match existing.
 - 2. Mounting: Mount to walls with concealed mechanical fasteners or adhesive as recommended by the manufacturer.
 - 3. Material: 1/8 inch thick matte polycarbonate with all edges eased.

PART 3 - EXECUTION


3.1 INSTALLATION

- A. Install interior signage in accordance with approved shop drawings, ADA requirements, and at locations indicated on the Architect's Drawings and in conformance with manufacturer's instructions using only approved materials and methods

END OF SECTION

DEMOLITION GENERAL NOTES



- DEMOLITION PLANS SHALL SERVE TO AID IN EVALUATION OF THE WORK AND EXTENT OF DEMOLITION BUT SHALL NOT BE HELD TO BE ALL INCLUSIVE. FIELD VERIFY EXISTING CONDITIONS, DEMOLITION AND REMOVALS AS REQUIRED FOR INSTALLATION OF THE NEW WORK AND FINISHES INDICATED WHETHER OR NOT SPECIFICALLY NOTED IN THESE DRAWINGS.
- SCHEDULE DEMOLITION WORK EFFECTING OCCUPIED AREAS OF THE FACILITY IN ADVANCE WITH THE OWNER THROUGH CONSTRUCTION PROJECT MANAGER. REFER TO SPECIFICATIONS.
- FINISH REMOVAL NOTES APPLY TO PARTITIONS/WALLS THAT REMAIN. REMOVE ALL FINISHES FROM WALLS THAT REMAIN WITHIN THE LIMIT OF CONSTRUCTION, UNLESS NOTED OTHERWISE.
- WHERE WALLS, PARTITIONS, FLOORING, ACCESSORIES OR OTHER TYPES OF CONSTRUCTION ARE REMOVED, PATCH AND REPAIR ADJACENT AREAS AS REQUIRED TO RECEIVE NEW CONSTRUCTION OR FINISHES AND TO MATCH ADJACENT SURFACES. MAINTAIN ALL EXISTING AND REQUIRED FIRE RATED CONSTRUCTION THROUGHOUT.
- WHERE NEW FLOOR FINISHES ARE SCHEDULED OR INDICATED, REMOVE ALL EXISTING FLOOR FINISHES AND PREPARE & CLEAN SLAB TO RECEIVE NEW FLOOR FINISHES IN ACCORDANCE WITH THE NEW FLOOR FINISH MANUFACTURER'S WRITTEN RECOMMENDATIONS UNLESS NOTED OTHERWISE. PROPER PREPARATION OF EXISTING SURFACES SHALL INCLUDE, BUT NOT BE LIMITED TO, REMOVAL OF ACCUMULATED ADHESIVES & MASTICS, FILLING AND REPAIR OF CRACKS & VOIDS, SURFACE RESTORATION, THOROUGH CLEANING, ETC. & OTHER PROCEDURES AS MAY BE RECOMMENDED BY MANUFACTURER OF NEW FLOORING.
- UNLESS NOTED OTHERWISE, REMOVE ALL EXISTING ACCESSORIES & HARDWARE. PATCH & REPAIR ALL SURFACES TO RECEIVE NEW FINISHES.
- OFFER REMOVED ITEMS TO OWNER BEFORE REMOVAL FROM THE SITE. DETERMINE SALVAGE ITEMS WITH THE OWNER BEFORE DEMOLITION BEGINS. ALL ITEMS NOT DESIRED BY OWNER SHALL BECOME PROPERTY OF THE CONTRACTOR AND SHALL BE LEGALLY DISPOSED OF OFF SITE.
- PROTECT ALL ITEMS TO REMAIN AND REPAIR/REPLACE ANY DAMAGED ITEMS OR CONSTRUCTION. GENERAL CONTRACTOR IS RESPONSIBLE FOR COORDINATING THE WORK WITH OTHER TRADES.
- CONTRACTOR SHALL PROVIDE TEMPORARY SHORING AS NECESSARY TO COMPLETE THE WORK.
- HOLES LEFT IN CONCRETE FLOORS FROM REMOVED ITEMS SHALL BE PATCHED BY GENERAL CONTRACTOR.
- REFER TO ENGINEERING DRAWINGS FOR RELATED WORK AND ITEMS TO BE REMOVED OR RE-INSTALLED IN NEW CONSTRUCTION. COORDINATE TEMPORARY LIGHTING, COMMUNICATION AND MECHANICAL SYSTEMS WITH OTHER TRADES. MAINTAIN ALL LIFE SAFETY DEVICES.
- REMOVE ABANDONED UTILITY SERVICES, SUCH AS ELECTRICAL, PLUMBING, GAS LINES, AND MECHANICAL DUCTWORK, DISCOVERED AND NOT SCHEDULED FOR REUSE BACK TO THEIR SOURCE INCLUDING ALL HANGERS, STRAPS, WIRES, ETC.). MAINTAIN ANY SYSTEM SERVING ADJACENT BUILDING AREAS THAT ARE NOT INCLUDED IN THE CONTRACT, REROUTE AS REQUIRED. SEE ENGINEERING DRAWINGS FOR ADDITIONAL INFORMATION.
- PROVIDE ALL NECESSARY DEMOLITION OF EXISTING CONSTRUCTION FOR NEW UTILITY SERVICES AS REQUIRED.

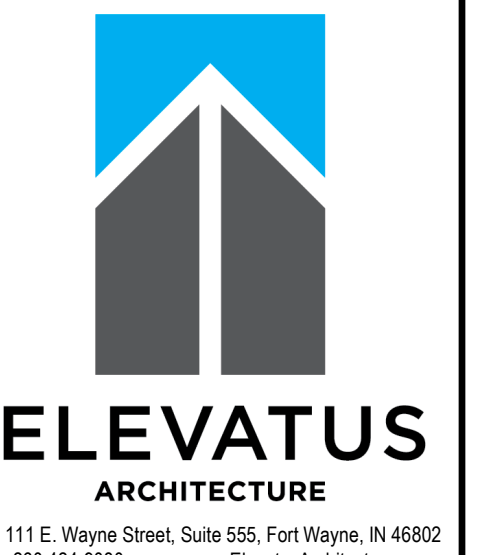

111 E. Wayne Street, Suite 555, Fort Wayne, IN 46802
266.424.9500
ElevatusArchitecture.com

CONFIDENTIAL CONTRACT 2024
ELEVATUS ARCHITECTURE


1.01	DEMOLITION PLAN NOTES
TAG	DESCRIPTION
CEILING DEMOLITION	
1.01	REMOVE ACOUSTICAL LAY-IN CEILING SYSTEM, PANELS, GRID, SUSPENSION SYSTEM AND ALL RELATED HANGERS AND SUPPORTS.
1.03	ACOUSTICAL LAY-IN CEILING SYSTEM TO REMAIN. PROTECT DURING CONSTRUCTION. REPAIR ALL DAMAGED AREAS AT CONCLUSION OF THE WORK.
FLOORING DEMOLITION	
2.01	REMOVE VINYL COMPOSITION TILE FLOORING AND ALL RELATED MASTIC/ADHESIVE. CLEAN/PREP SUBFLOOR TO ACCEPT NEW FLOORING AS SCHEDULED.
2.05	FLOOR FINISH TO REMAIN. PROTECT FLOORING DURING CONSTRUCTION. REPLACE DAMAGED FLOORING AND PATCH/REPAIR AT CONCLUSION OF THE WORK.
PARTITION DEMOLITION	
3.01	REMOVE RESILIENT WALL BASE. PATCH/REPAIR WALL SURFACE TO ACCEPT NEW FINISHES AS SCHEDULED.
3.09	DOORS AND FRAME TO REMAIN. PROTECT DURING CONSTRUCTION. REPAIR/REPLACE DAMAGED COMPONENTS AT CONCLUSION OF THE WORK.
3.10	WINDOW AND WINDOW SILL TO REMAIN. PROTECT DURING CONSTRUCTION.
FURNITURE DEMOLITION	
4.05	TECHNOLOGY EQUIPMENT IS TO BE REMOVED BY OWNER.
4.06	REMOVE ALL WINDOW TREATMENTS SUCH AS MINI-BLINDS, CURTAINS, AND RELATED HANGERS. PATCH AND REPAIR ANY HOLES IN WALLS AT CONCLUSION OF WORK TO PREP FOR NEW BLINDS. OFFER TO OWNER BEFORE DISPOSING.
4.07	REMOVE BASE CABINET(S), COUNTERTOP AND WALL CABINET(S). PATCH AND REPAIR ANY HOLES IN WALLS AT CONCLUSION OF WORK. OFFER TO OWNER BEFORE DISPOSING.
4.08	REMOVE TACKBOARDS, TACK STRIPS, MARKERBOARDS, ETC. PATCH AND REPAIR ANY HOLES IN WALLS AT CONCLUSION OF WORK. OFFER TO OWNER BEFORE DISPOSING.
4.09	REMOVE ALL REMAINING FURNITURE AND EQUIPMENT IN SPACE. OFFER TO OWNER BEFORE DISPOSING.
UTILITY DEMOLITION	
5.03	HVAC UNIT TO REMAIN. PROTECT DURING CONSTRUCTION. REPAIR/REPLACE DAMAGED COMPONENTS AT CONCLUSION OF THE WORK. - SEE MECHANICAL DOCUMENTS FOR MORE INFORMATION.
5.06	EXISTING AIR SUPPLY RETURN VENTILATION GRILL WITH IN BASE CABINETS TO BE REMOVED IN ITS ENTIRETY. EXISTING CONNECTIONS TO MECHANICAL UNIT TO BE SEALED. SEE MECHANICAL DRAWINGS FOR RELATED WORK. GENERAL CONTRACTOR TO PATCH REMAINING HOLES THROUGH FLOOR DECK FLUSH WITH EXISTING.

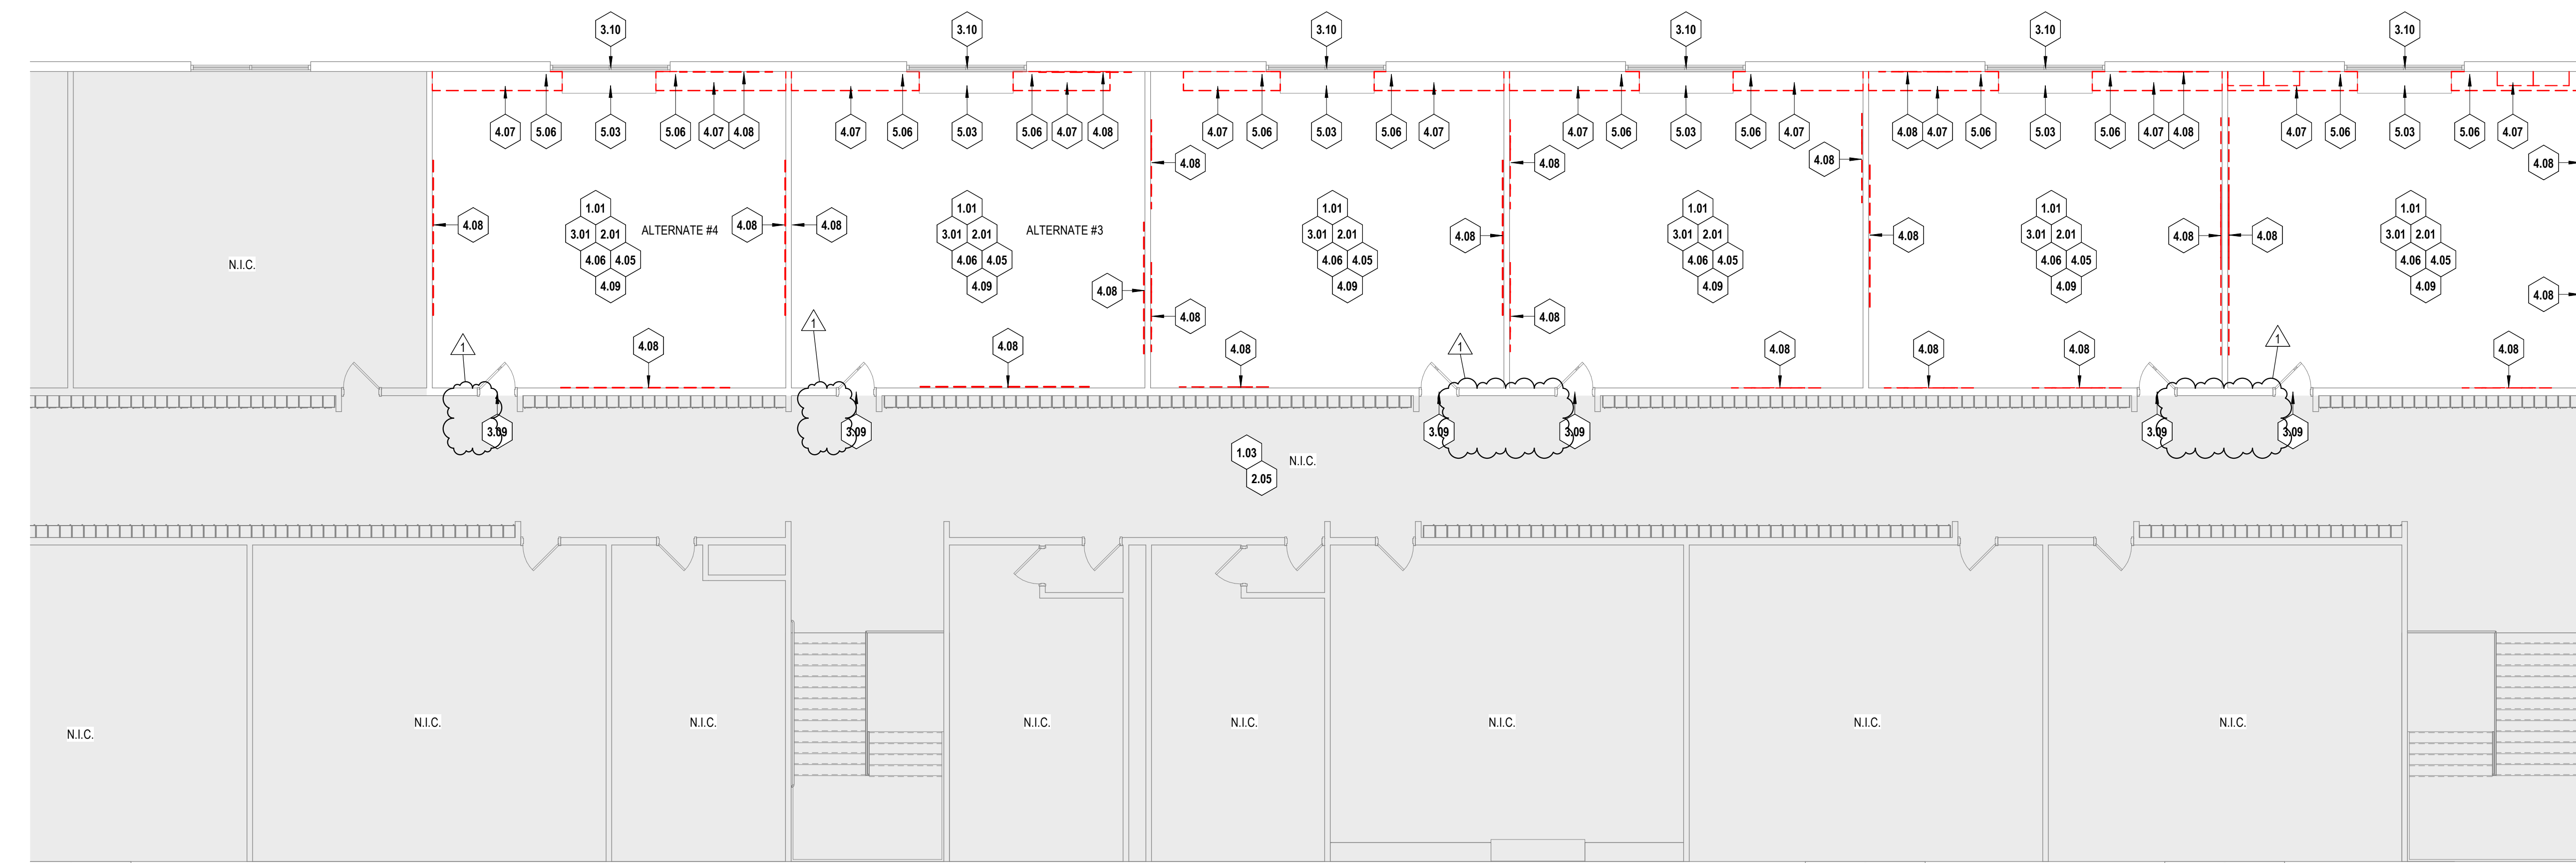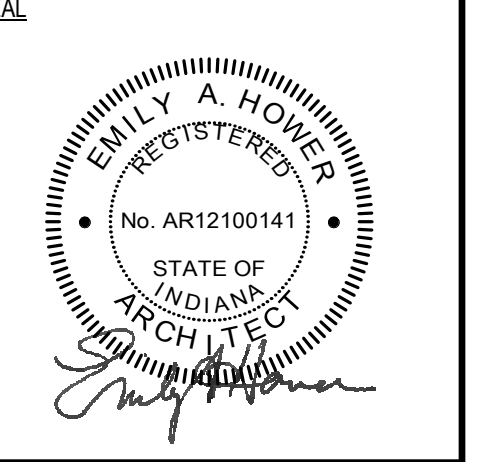


PLAN NORTH
1 Second Floor Architectural Demolition Plan
 1/8" = 1'-0"

REVISIONS		
NO.	DESCRIPTION	DATE
1	ADDENDA #02	12-18-2024

PROJECT NO. 2401110
 ISSUE DATE November 27, 2024
 SUBMITTAL
 Issue for Bids, Permits, and Construction

Architectural Demolition Plan - Second Floor

AD101

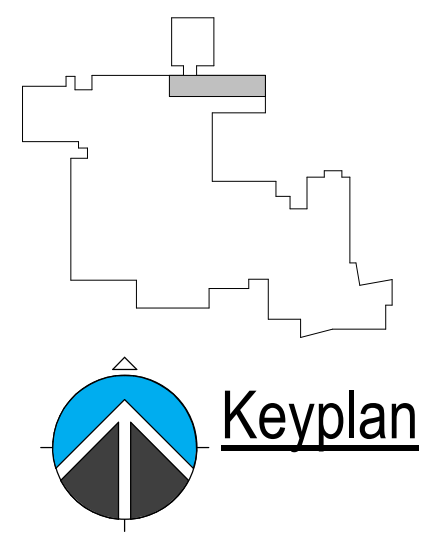




12/18/2024 9:15:46 AM
 Addenda Doc: E:\2401110 - Classroom Renovations\2401110\2401110-2\Classroom\2401110-2.dwg

FLOOR PLAN GENERAL NOTES


- GENERAL CONTRACTOR SHALL TAKE RESPONSIBILITY FOR COORDINATING REQUIRED WORK WITH ALL TRADES BASED UPON A COMPLETE SET OF CONSTRUCTION DOCUMENTS.
- EACH CONTRACTOR SHALL VERIFY ALL DIMENSIONS AND OPENINGS SHOWN ON THE DRAWINGS AND OBTAIN ALL MEASUREMENTS REQUIRED FOR PROPER EXECUTION OF WORK. WHEN VERIFICATION OF EXISTING DIMENSIONS IS REQUIRED, THE CONTRACTOR REQUIRING SAID VERIFICATION FOR THE CONSTRUCTION OR FABRICATION OF HIS MATERIAL SHALL BE THE CONTRACTOR RESPONSIBLE FOR THE PROCUREMENT OF THE FIELD INFORMATION.
- WRITTEN DIMENSIONS TAKE PRECEDENCE OVER SCALED MEASUREMENTS. DO NOT SCALE DRAWINGS.
- DETAILED DRAWINGS AND LARGER SCALE DRAWINGS TAKE PRECEDENCE OVER SMALL SCALE DRAWINGS.
- UNLESS NOTED OTHERWISE, PLAN DIMENSIONS ARE TAKEN FROM FACE OF STUD, CMU, CONCRETE OR EXISTING FINISH TO FACE OF STUD, CMU OR CONCRETE.
- REPAIR ALL SURFACES DAMAGED BY RENOVATION AND NEW CONSTRUCTION TO MATCH EXISTING ADJACENT OR CONTIGUOUS FINISH.
- ALL CUTTING AND PATCHING AS A RESULT OF NEW CONSTRUCTION OR DEMOLITION SHALL BE PERFORMED IN A WORKMANLIKE MANNER, AND SHALL MATCH IN COLOR, SHAPE, SIZE AND TEXTURE ADJACENT AND/OR CONTIGUOUS FINISHED SURFACES.
- PATCH ALL CRACKS AND RESEAL JOINTS IN EXISTING SUBSTRATES SCHEDULED TO RECEIVE NEW FINISHES.
- PROVIDE ALL BLOCKING NECESSARY FOR THE ATTACHMENT OF MISCELLANEOUS EQUIPMENT INCLUDING BUT NOT LIMITED TO CASEWORK, MILLWORK, AND ELECTRICAL DEVICES.
- ALL INTERIOR WOOD BLOCKING SHALL BE FIRE RETARDANT TREATED.
- DOORS NOT OTHERWISE DIMENSIONED SHALL BE 8" FROM FACE OF ADJACENT CMU OR CONCRETE WALL TO ROUGH DOOR OPENING, AND 4" FROM FACE OF ADJACENT STUD WALL TO ROUGH DOOR OPENING.
- THE TRANSITION OF DIFFERENT FLOORING MATERIALS AT A DOORWAY SHALL OCCUR AT THE CENTERLINE OF DOOR UNLESS NOTED OTHERWISE.
- ALL WALL SURFACES AND DOOR FRAMES SHALL RECEIVE PAINT WHEN PAINT IS INDICATED ON THE FINISH SCHEDULE OR FINISH PLANS. PAINT SURFACES BEHIND MOVABLE EQUIPMENT AND FURNITURE SAME AS SIMILAR EXPOSED SURFACES. PAINT SURFACES BEHIND PERMANENTLY FIXED EQUIPMENT OR CASEWORK WITH PRIME COAT ONLY BEFORE FINAL INSTALLATION OF EQUIPMENT. PAINT ALL MECHANICAL AND ELECTRICAL EQUIPMENT EXPOSED IN FINISHED SPACES UNLESS NOTED OTHERWISE.
- FOR CONSTRUCTION DETAILS NOT SHOWN, USE THE PRODUCT MANUFACTURER'S WRITTEN INSTALLATION INSTRUCTIONS AND STANDARD DETAILS, IN STRICT ACCORDANCE WITH THE PROJECT SPECIFICATION REQUIREMENTS AND DESIGN INTENT.
- PROVIDE FIRE EXTINGUISHERS (FE) AND FIRE EXTINGUISHER CABINETS (FEC) AS INDICATED ON THE PLANS. PROVIDE TYPE AND SIZE AS SPECIFIED. MOUNT AT 42" AFF TO TOP OF FE AND 48" AFF TO TOP OF FEC.
- UNLESS NOTED OTHERWISE, NEW WALLS TO BE 3 5/8" METAL STUDS @ 16" O.C. WITH (1) LAYER OF 5/8" TYPE "X" GYPSUM BOARD EACH SIDE. EXTEND STUD AND GYPSUM BOARD TO MINIMUM 6" ABOVE FINISHED CEILING. SEAL AS REQUIRED FOR WALL RATINGS INDICATED.

CONFIDENTIAL COPYRIGHT 2024


FLOOR PLAN NOTES	
TAG	DESCRIPTION
3.01	
DIV 4 - MASONRY	
4.01	WHERE RECESSED WALL SPEAKER IS REMOVED PATCH, REPAIR OR INFILLING EXISTING MASONRY EXPOSED TO VIEW. "TOOTH-IN" NEW MASONRY TO MATCH EXISTING ADJACENT MASONRY COURSING.
DIV 10 - SPECIALTIES	
10.01	PROVIDE A 6" W X 4" H MARKERBOARD (MB-1). PROVIDE ALUMINUM FINISH TRIM ON ALL EDGES. REFER TO SPECIFICATIONS FOR MORE INFORMATION.
10.02	PROVIDE A 10" W X 4" H MARKERBOARD (MB-2). PROVIDE ALUMINUM FINISH TRIM ON ALL EDGES. REFER TO SPECIFICATIONS FOR MORE INFORMATION.

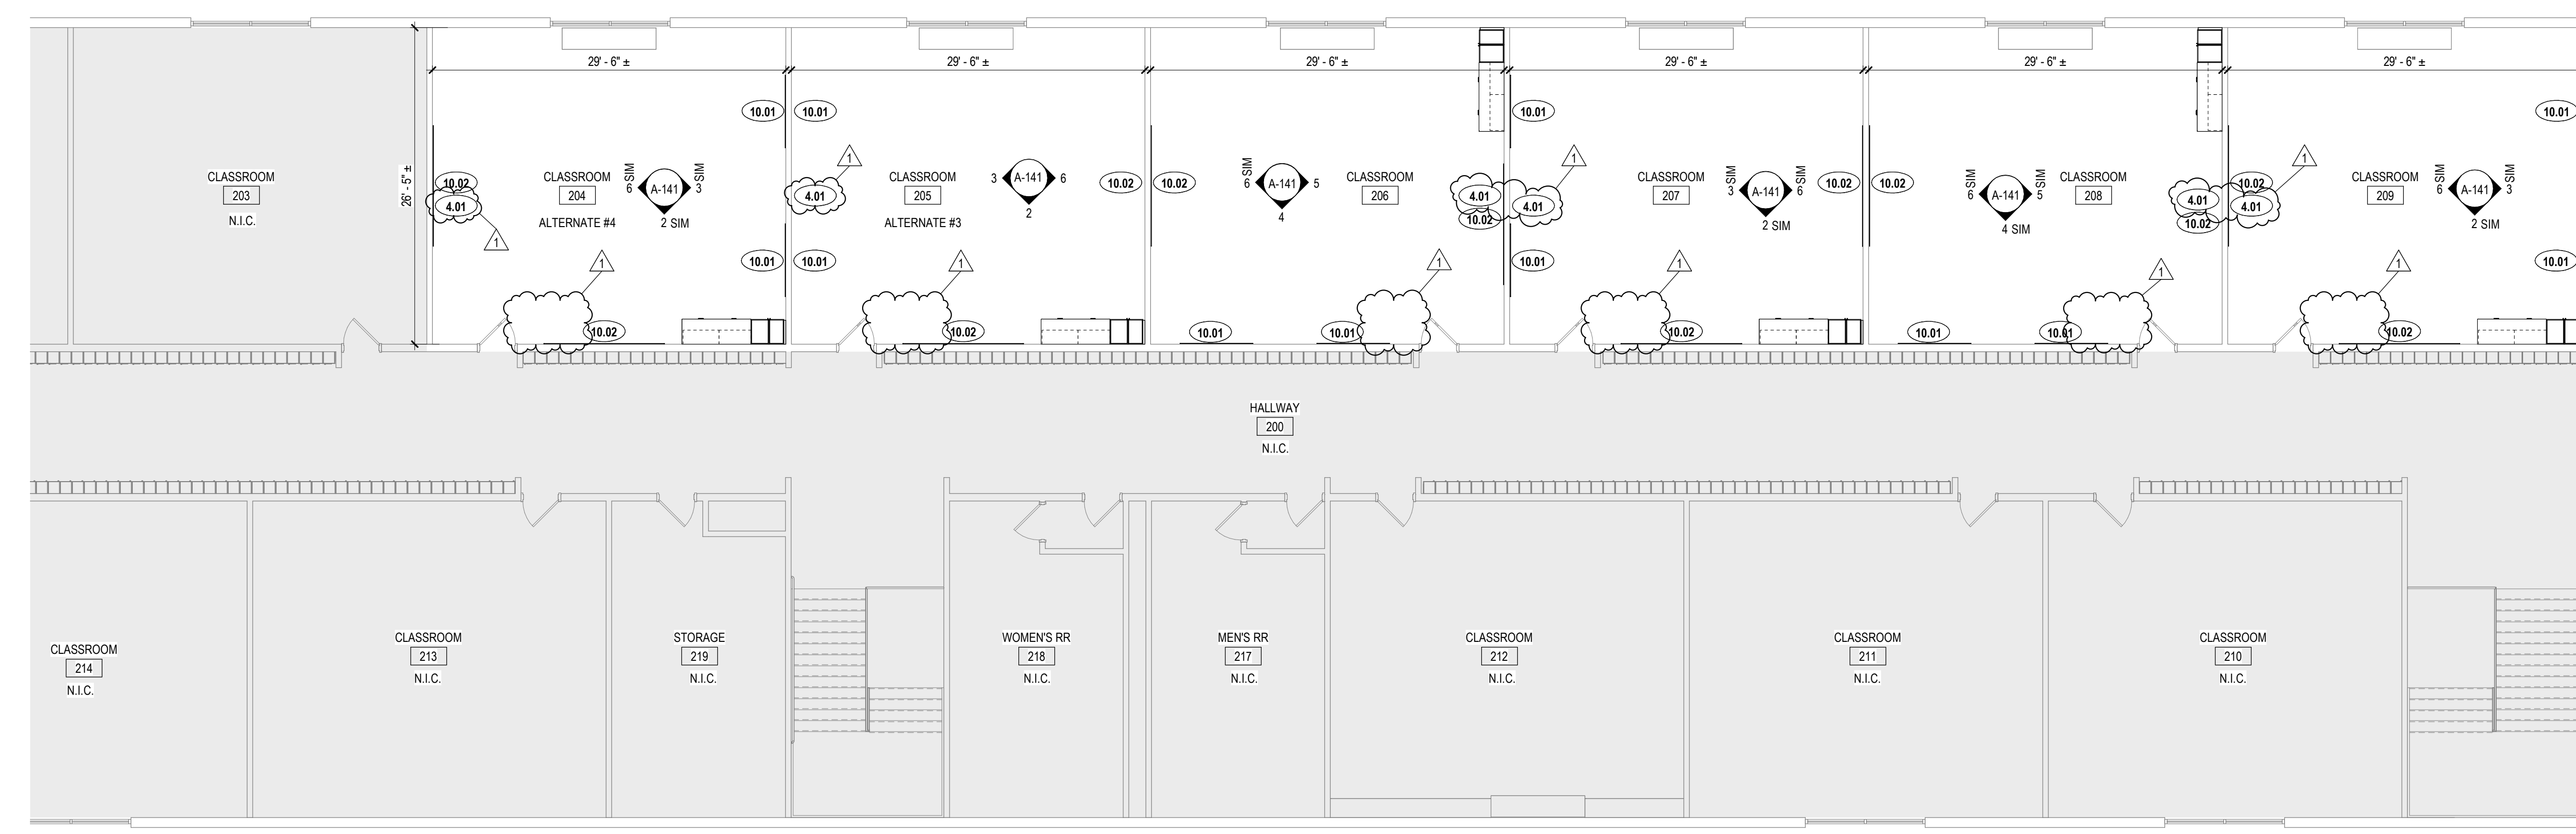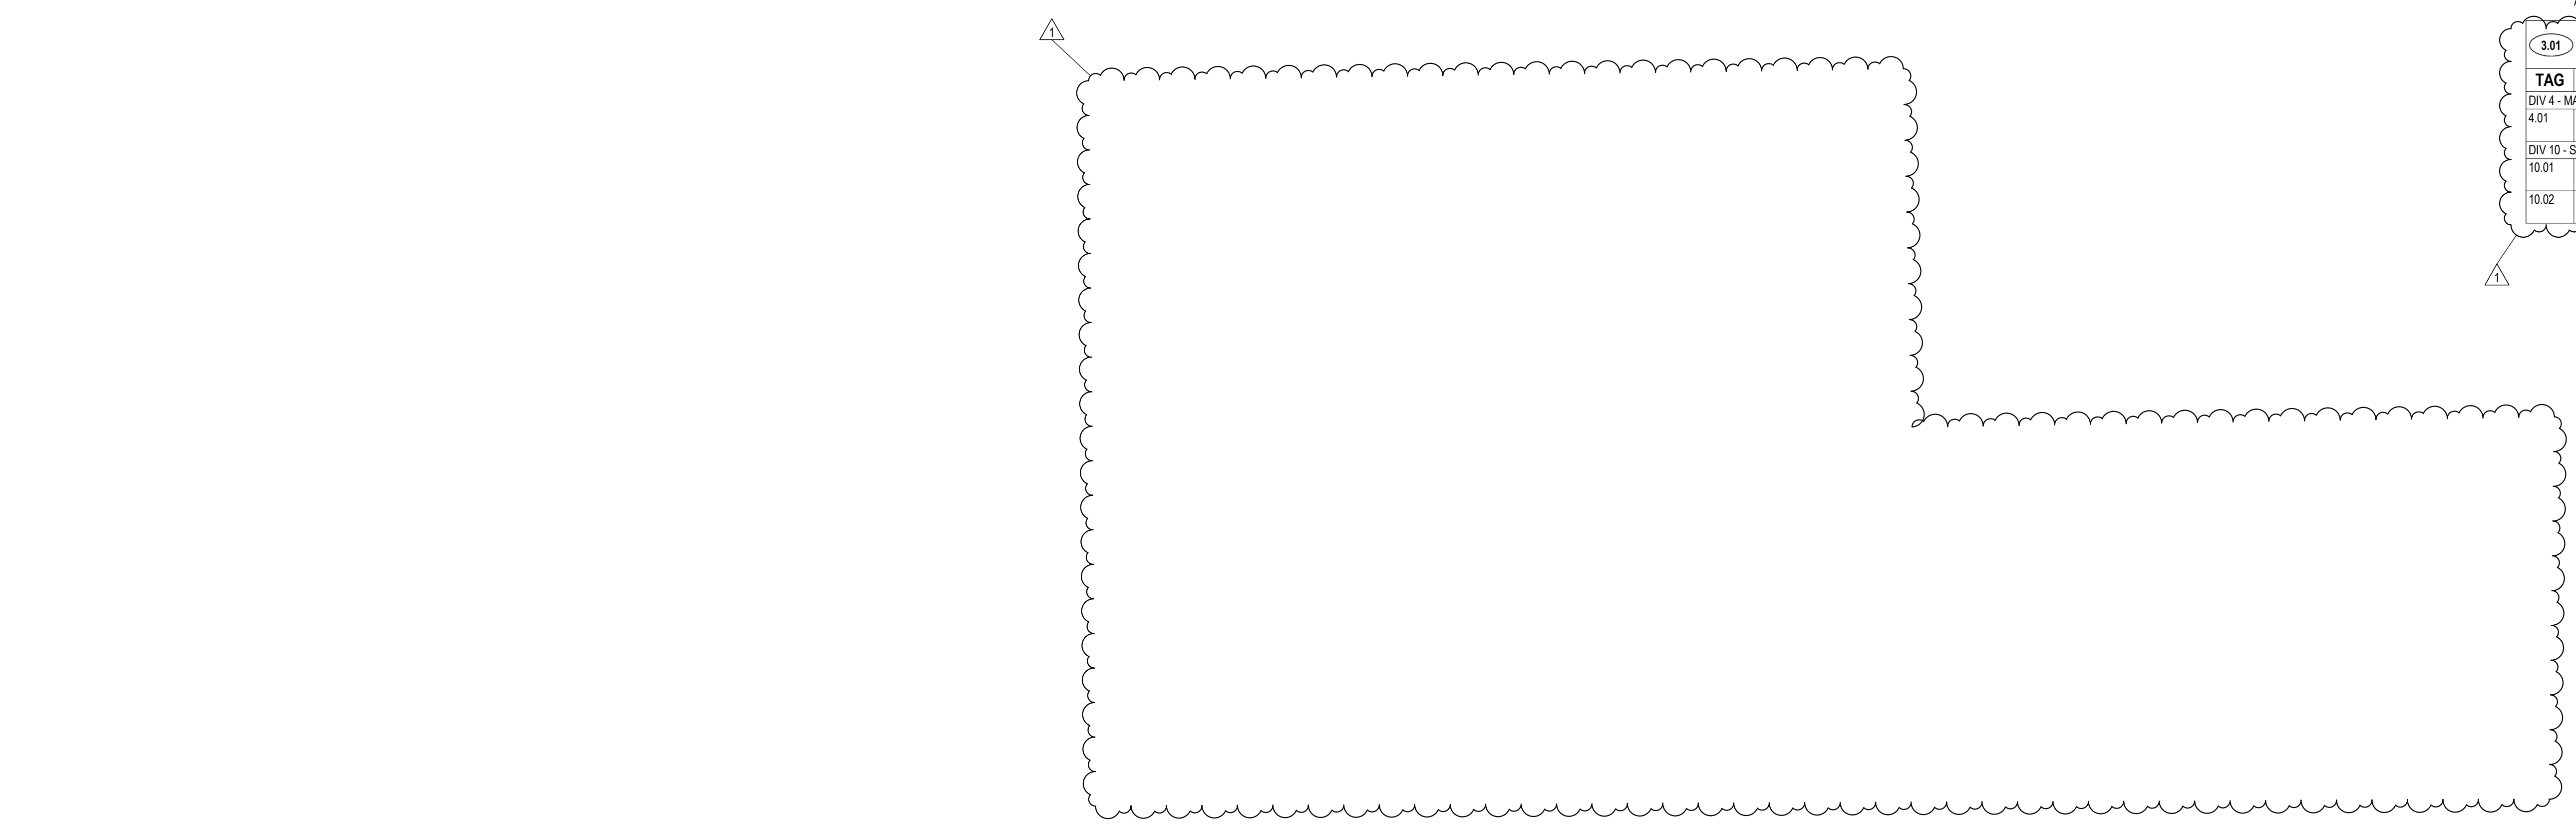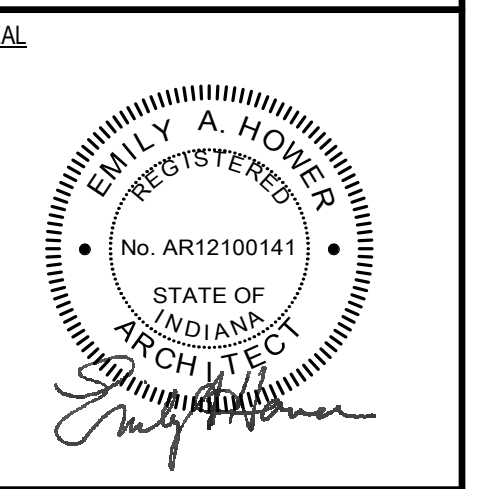

PLAN NORTH
1 Second Floor Architectural Notation Plan
1/8" = 1'-0"

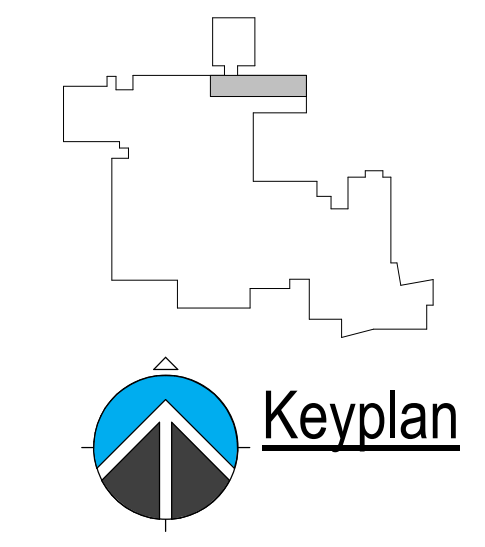

EACS
EACS Heritage Jr/Sr High School
Classroom Renovations
13808 Monroeville Rd,
Monroeville, IN 46773

REVISIONS		
NO.	DESCRIPTION	DATE
1	ADDENDA #02	12-18-2024

PROJECT NO. 2401110
ISSUE DATE November 27, 2024
SUBMITTAL Issue for Bids, Permits, and Construction

Architectural Notation Plan - Second Floor

A-111

ROOM FINISH SCHEDULE

Room No.	Room Name	Floor	Base	Wall				Comments
				North	East	South	West	
SECOND FLOOR								
204	CLASSROOM	QVT-1, QVT-2, QVT-3	RB-1	P-1	P-1	P-1	P-1	
205	CLASSROOM	QVT-1, QVT-2, QVT-3	RB-1	P-1	P-1	P-1	P-1	
206	CLASSROOM	QVT-1, QVT-2, QVT-3	RB-1	P-1	P-1	P-1	P-1	
207	CLASSROOM	QVT-1, QVT-2, QVT-3	RB-1	P-1	P-1	P-1	P-1	
208	CLASSROOM	QVT-1, QVT-2, QVT-3	RB-1	P-1	P-1	P-1	P-1	
209	CLASSROOM	QVT-1, QVT-2, QVT-3	RB-1	P-1	P-1	P-1	P-1	

FINISH LEGEND

- (06.41.10) MILLWORK/CASEWORK**
 PL-1 MFG: FORMICA
 TYPE: PLASTIC LAMINATE
 COLOR: 961 FOG
 FINISH: MATTE
- SS-1** MFG: CORIAN
 TYPE: SOLID SURFACE
 COLOR: CARBON AGGREGATE
- (09.91.13) ACOUSTICAL PANEL CEILING**
 APC-1 MFG: USG
 STYLE: RADAR
 EDGE STYLE: SQUARE LAY-IN
 SIZE: 24" X 48" X 5/8"
 GRID DOWN DTL: 15/16"
 TILE GRID COLOR: FLAT WHITE (050)
- (09.65.19) RESILIENT TILE FLOORING**
 QVT-1 MFG: KAHRIS
 TYPE: UPOFLOOR QUARTZ VINYL TILE
 COLLECTION: MOSAIC
 COLOR: 8315 LAVA GREY
 SIZE: 24" X 24"
 THICKNESS: 1/8"
 INSTALL METHOD: MONOLITHIC
- QVT-2** MFG: KAHRIS
 TYPE: UPOFLOOR QUARTZ VINYL TILE
 COLLECTION: MOSAIC
 COLOR: 8359 ENHANCED DUMORTIERITE
 SIZE: 24" X 24"
 THICKNESS: 1/8"
 INSTALL METHOD: MONOLITHIC
- QVT-3** MFG: KAHRIS
 TYPE: UPOFLOOR QUARTZ VINYL TILE
 COLLECTION: MOSAIC
 COLOR: 83M SCORIA GREY
 SIZE: 24" X 24"
 THICKNESS: 1/8"
 INSTALL METHOD: MONOLITHIC
- RB-1** MFG: TARKETT
 TYPE: RUBBER WALL BASE
 STYLE: BASEWORKS THERMOSET - WITH TOE
 COLOR: BLACK
 SIZE: 6"H
 THICKNESS: 0.125
- (09.91.00) PAINTING**
 P-1 MFG: SHERWIN WILLIAMS
 COLOR: SW 7757 HIGH REFLECTIVE WHITE (FIELD WALLS)
- P-2** MFG: SHERWIN WILLIAMS
 COLOR: MATCH EXISTING (DOOR FRAMES)
- (10.11.00) VISUAL DISPLAY UNITS**
 MB-1 MFG: CLARIDGE PRODUCTS
 TYPE: SERIES 2
 WRITING SURFACE: WHITEBOARD PORCELAIN BRILLIANT WHITE
 TACK SURFACE: CLARIDGE CORK GRAPHITE
 TRAY: BOX TRAY
 SIZE: 48" X 72"
 THICKNESS: 1/2"
 NOTE: INSTALL USING ADHESIVE ONLY
- MB-2** MFG: CLARIDGE PRODUCTS
 TYPE: SERIES 2
 WRITING SURFACE: WHITEBOARD PORCELAIN BRILLIANT WHITE
 TACK SURFACE: CLARIDGE CORK GRAPHITE
 TRAY: BOX TRAY
 SIZE: 48" X 120"
 THICKNESS: 1/2"
 NOTE: INSTALL USING ADHESIVE ONLY

FINISH PLAN LEGEND









- #### FLOORING MATERIAL LEGEND
- | TYPE | DESCRIPTION |
|-------|--|
| QVT-1 | 24" X 24" UPOFLOOR QUARTZ VINYL TILE. SEE SPECIFICATIONS AND FINISH LEGEND FOR TYPE. |
| QVT-2 | 24" X 24" UPOFLOOR QUARTZ VINYL TILE. SEE SPECIFICATIONS AND FINISH LEGEND FOR TYPE. |
| QVT-3 | 24" X 24" UPOFLOOR QUARTZ VINYL TILE. SEE SPECIFICATIONS AND FINISH LEGEND FOR TYPE. |
| EXIST | EXISTING FLOOR TO REMAIN. |

FINISH GENERAL NOTES

- SCHEDULED MATERIALS AND FINISHES SHALL NOT BE ORDERED OR INSTALLED BEFORE THE CONTRACTOR'S PHYSICAL SAMPLE SUBMITTALS HAVE BEEN APPROVED AS CALLED FOR IN THE SPECIFICATIONS.
- FLOORING CONTRACTOR TO PROVIDE APPROPRIATE VINYL TRANSITIONS AND REDUCERS BETWEEN VARYING FLOORING MATERIALS.
- FLOOR FINISH TRANSITIONS SHALL BE CENTERED BELOW DOORS IN THE CLOSED POSITION, UNLESS NOTED OTHERWISE.
- CONCRETE SLAB TO REMAIN PROTECTED AND COVERED. REFER TO SPECIFICATIONS.
- HOLLOW METAL FRAMES TO BE PAINTED P-2, UNLESS NOTED OTHERWISE.
- CASEWORK TO BE P-1, UNLESS NOTED OTHERWISE.
- COUNTERTOPS TO BE SS-1, UNLESS NOTED OTHERWISE.
- GYPSONUM BOARD TO BE PAINTED P-1, UNLESS NOTED OTHERWISE.

CASEWORK GENERAL NOTES


- ALL CASEWORK SHALL COMPLY WITH THE FOLLOWING REQUIREMENTS UNLESS NOTED OTHERWISE.
- WALL CABINETS SHALL BE 12" DEEP.
- BASE CABINETS SHALL BE 24" DEEP.
- COUNTERTOPS SHALL EXTEND 1" BEYOND THE DEPTH OF THE BASE CABINETS BELOW.
- COUNTERTOPS WITH EXPOSED OUTSIDE CORNERS SHALL HAVE THE CORNERS EASED.
- COUNTERTOPS SHALL BE SOLID SURFACE.
- COUNTERTOPS SHALL HAVE 1" HIGH SIDE SPLASHES AND INTEGRAL BACKSPLASHES SCRIBED TO CONFORM TO THE SURFACES OF ABUTTING WALLS AT BACKS AND ENDS OF THE COUNTERTOP. TOPS OF SIDE SPLASHES SHALL BE FLUSH WITH TOP OF BACKSPLASH.
- SHELVING UP TO 30" WIDE SHALL BE 3/4" THICK AND ADJUSTABLE. SHELVING OVER 30" WIDE SHALL BE 1" THICK AND HAVE INTERMEDIATE ADJUSTABLE SUPPORTS ALONG THE INSIDE BACK OF CABINET.
- MAXIMUM CABINET DOOR WIDTHS SHALL BE 2'-0".
- HINGES AND RELATED HARDWARE SHALL BE FIVE KNUCKLE.
- EXPOSED CABINET SIDES SHALL RECEIVE FINISHED END PANELS.
- FILE DRAWERS TO ACCEPT LETTER-SIZED FOLDERS WITH TALL FILE TABS AND HOLDERS. MINIMUM CASEWORK DIMENSIONS SHALL BE FIELD VERIFIED PRIOR TO SUBMITTING SHOP DRAWINGS. DO NOT SCALE DRAWINGS.
- THE CONTRACTOR SHALL PROVIDE SOLID BLOCKING AS REQUIRED FOR WALL MOUNTED CASEWORK AND ACCESSORIES.
- THE CONTRACTOR SHALL VERIFY AND COORDINATE CLEAR DIMENSIONS REQUIRED FOR OWNER FURNISHED EQUIPMENT WHICH IS LOCATED WITHIN OR ADJACENT TO ANY PIECE OF CASEWORK.
- CASEWORK FABRICATOR AND INSTALLER SHALL COORDINATE WITH APPROPRIATE SUBCONTRACTORS FOR INSTALLATION OF SINKS WITH ASSOCIATED PIPING AND FITTINGS, AND FOR INSTALLATION OF ELECTRICAL RECEPTACLES, LIGHT FIXTURES, VOICEDATA OUTLETS, ETC. WITHIN THE CASEWORK.
- FLOORING CONTRACTOR TO PROVIDE SCHEDULED BASE ALONG BOTTOM OF EXPOSED FRONTS, BACKS, SIDES AND ENDS OF ALL FIXED CASEWORK, WARDROBES, END PANELS, VERTICAL SUPPORTS, KNEE SPACES, ETC.
- INDIVIDUAL WALL CABINET WIDTHS SHALL BE ALIGNED WITH INDIVIDUAL BASE CABINET WIDTHS BELOW.
- THE CONTRACTOR SHALL COORDINATE WITH THE OWNER IN CONFLICTS BETWEEN THE PROPOSED EQUIPMENT SUPPLIED BY THE OWNER AND THE CASEWORK FOUND WITHIN THE CONSTRUCTION DOCUMENTS AND SHALL REPORT AT ONCE TO THE ARCHITECT ANY ERROR, INCONSISTENCY, OR OMISSION THAT MAY BE DISCOVERED DURING THIS COORDINATION.
- PROVIDE (1) LOCKED DOORS AND DRAWERS IN AREAS SHOWN.

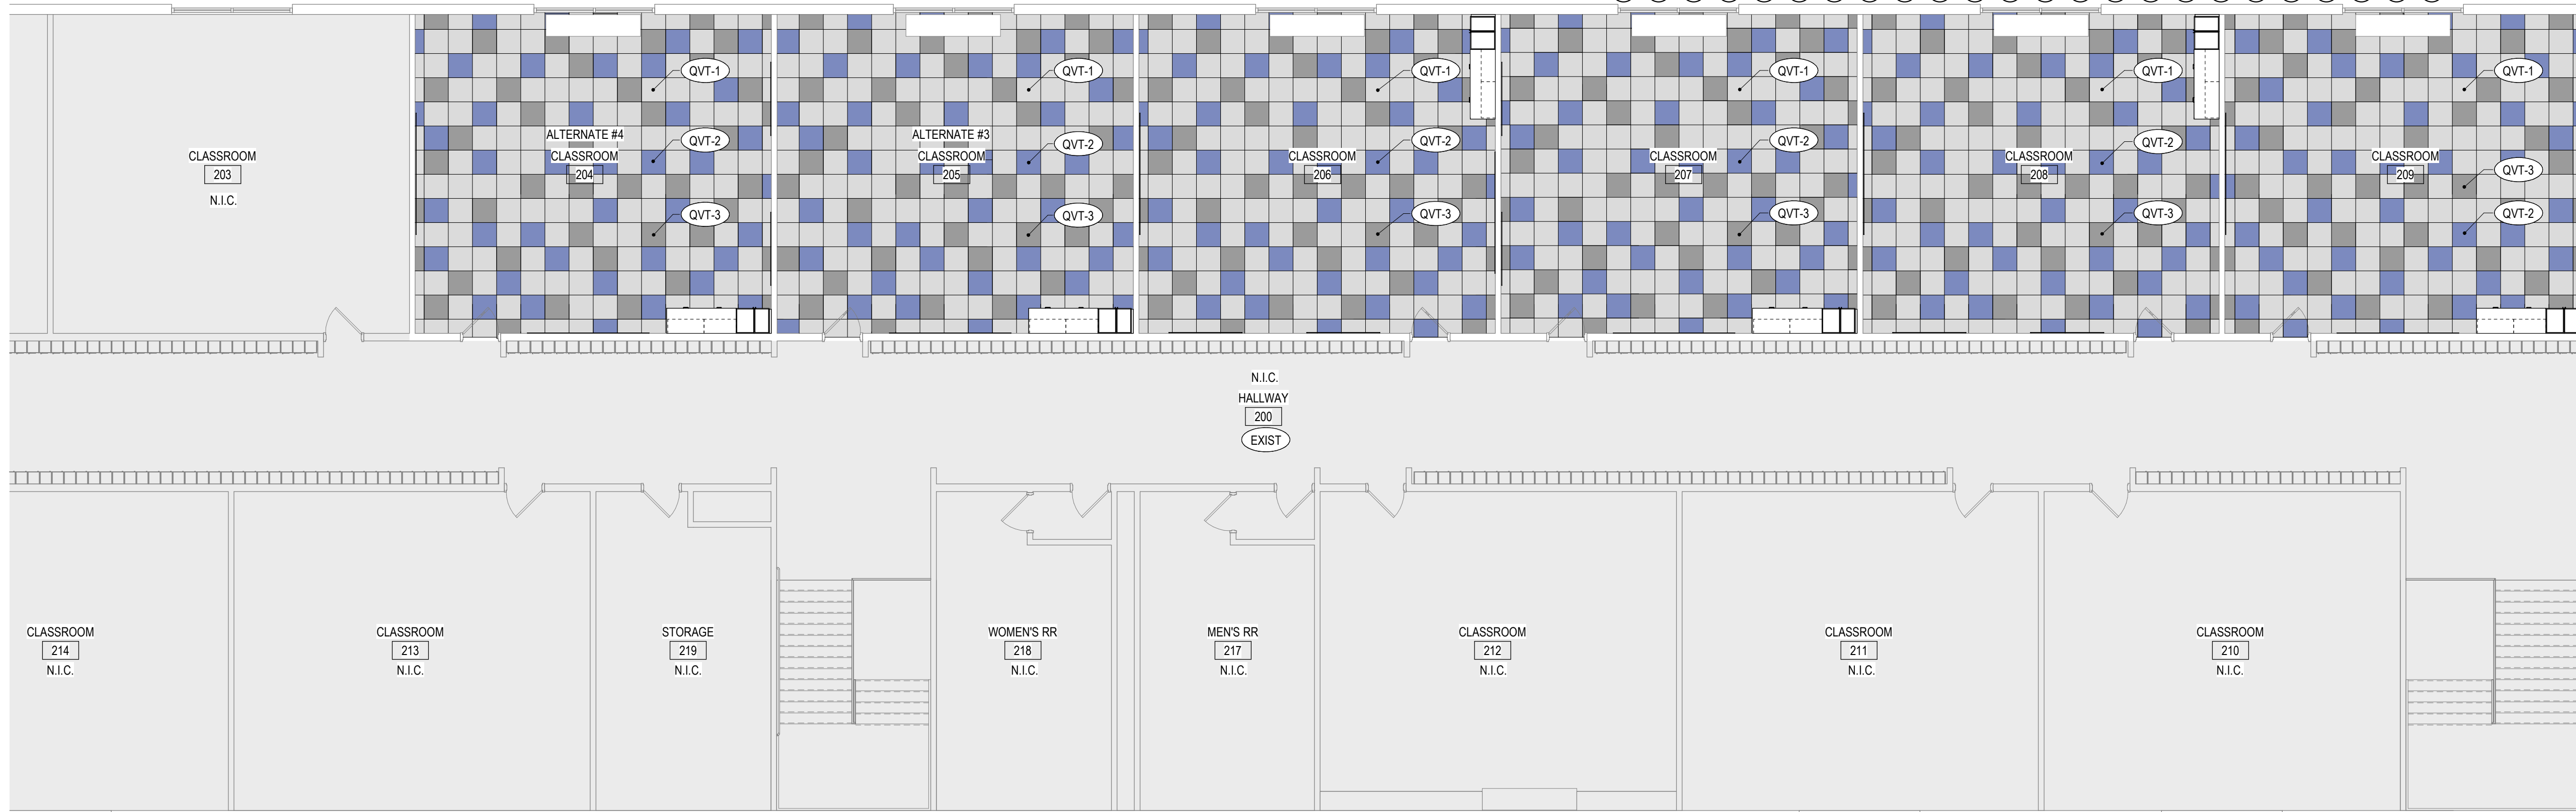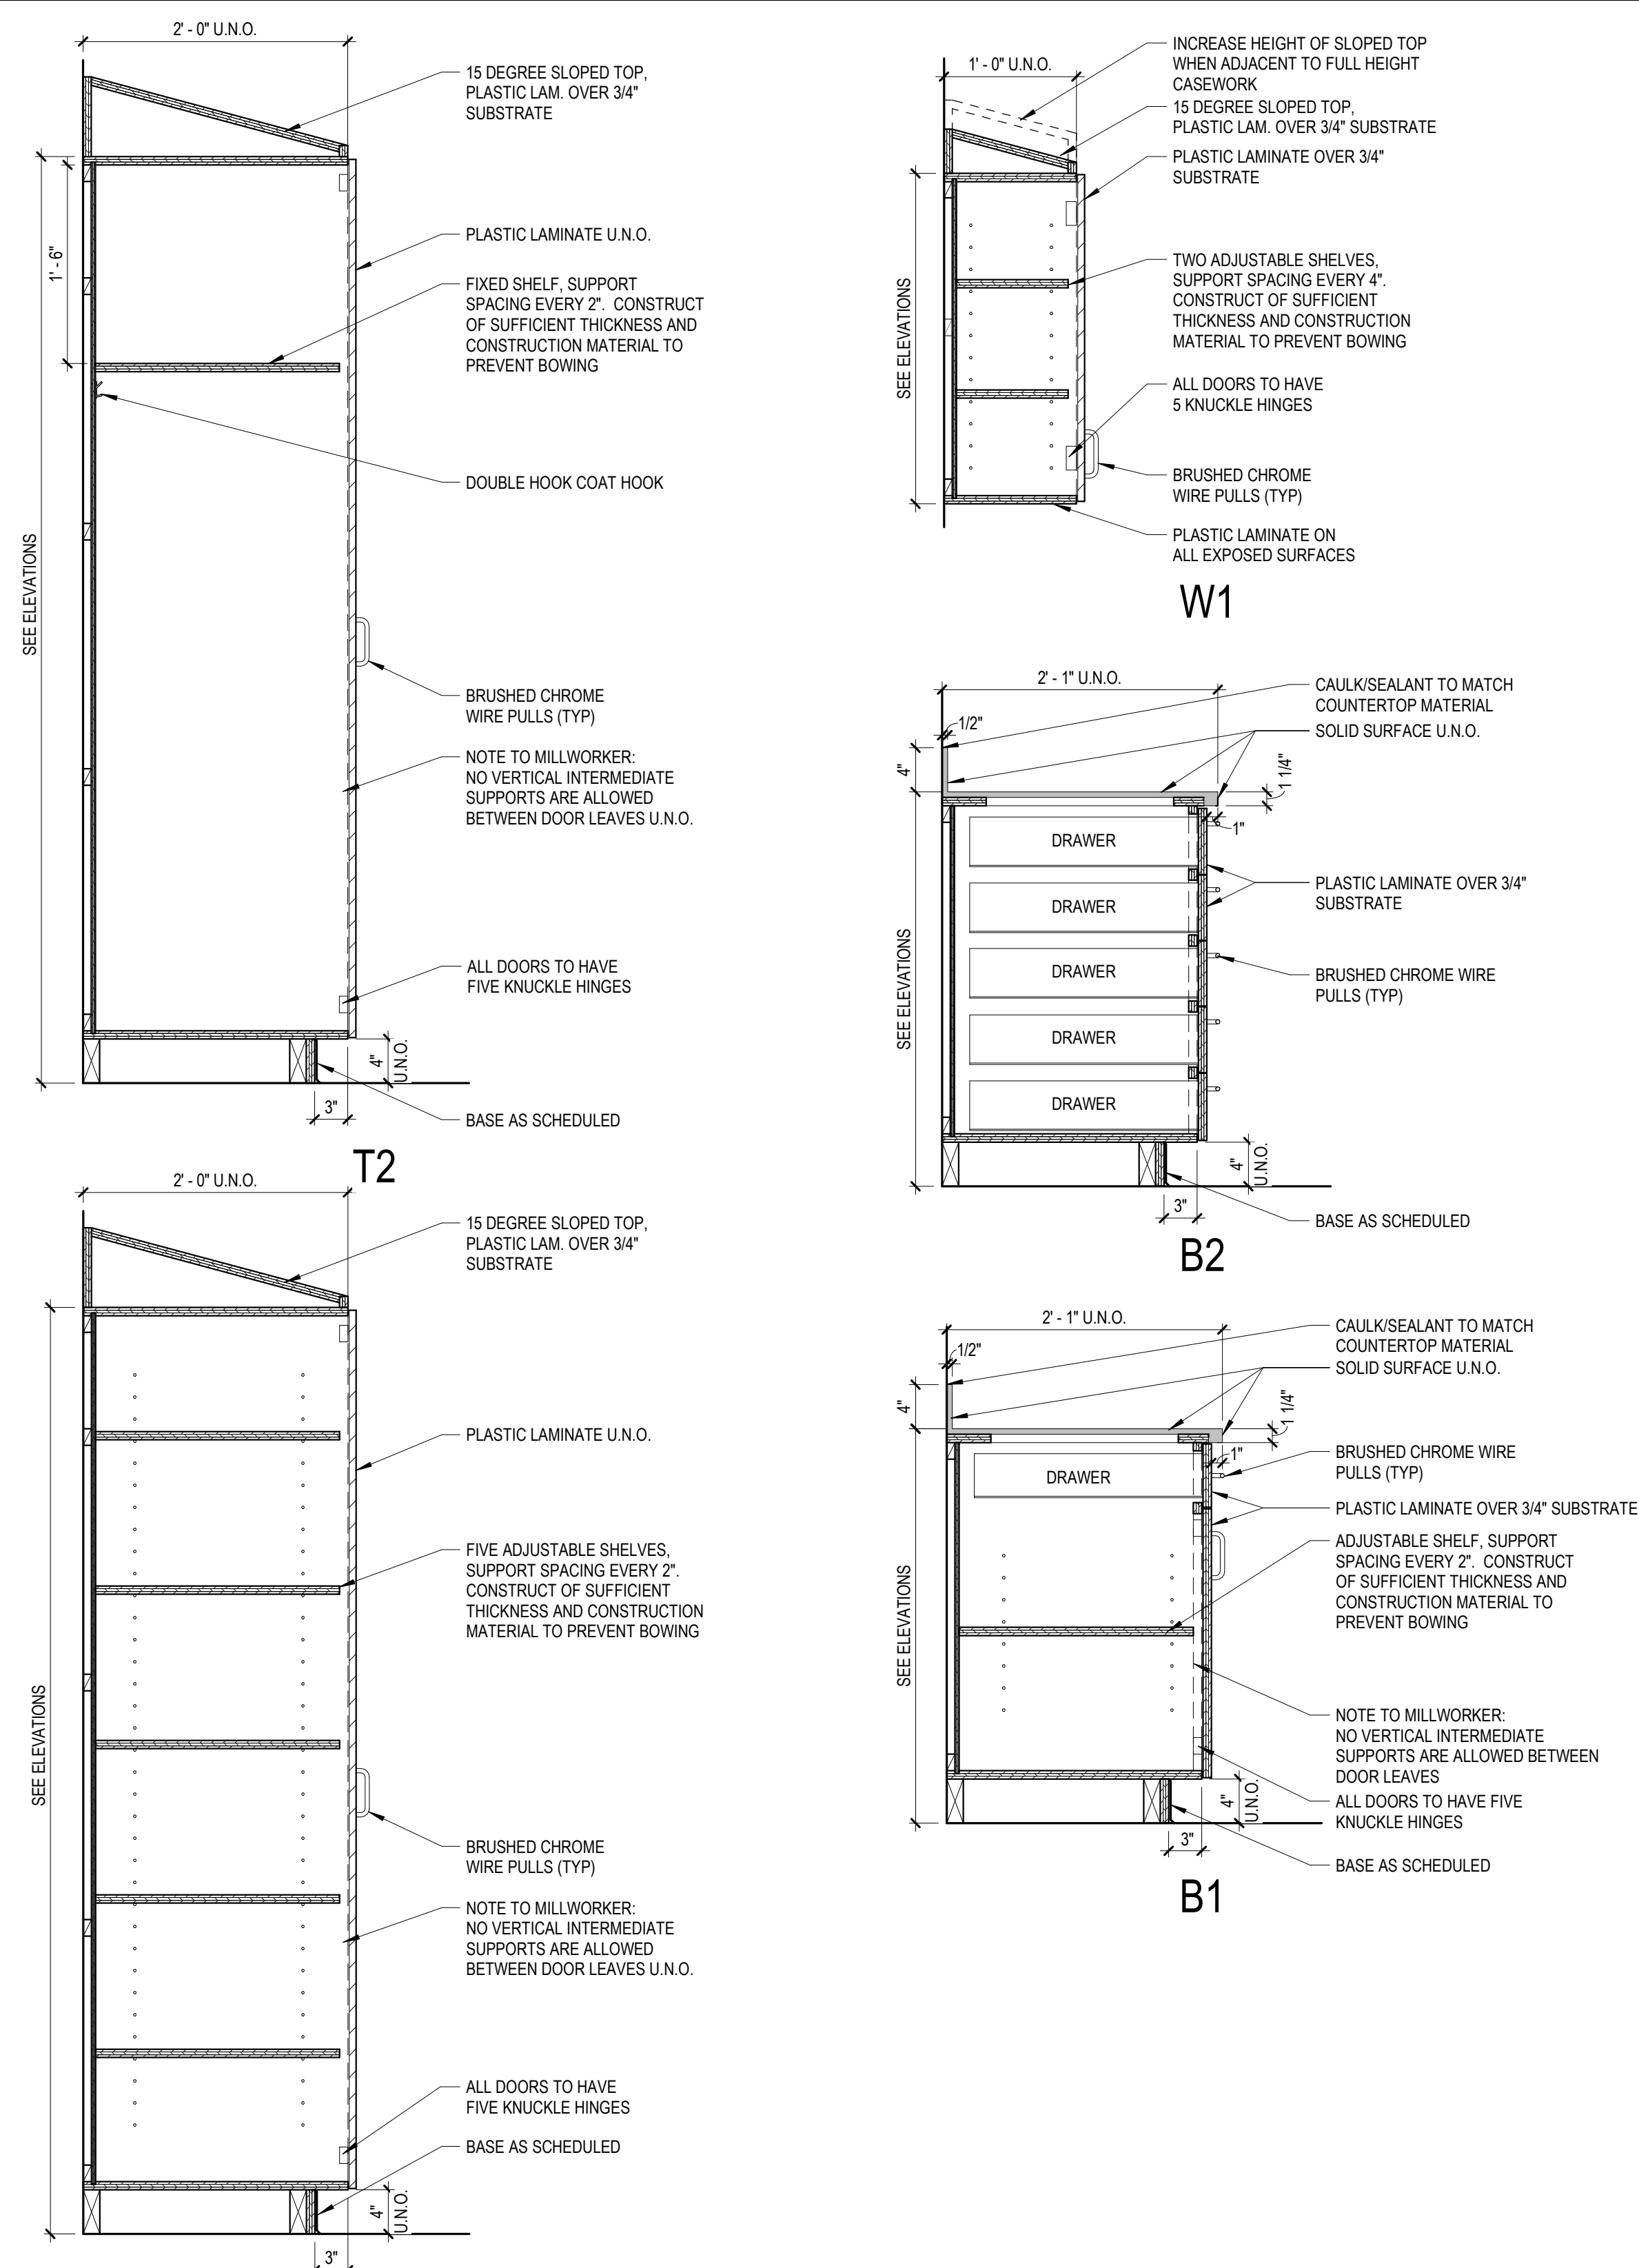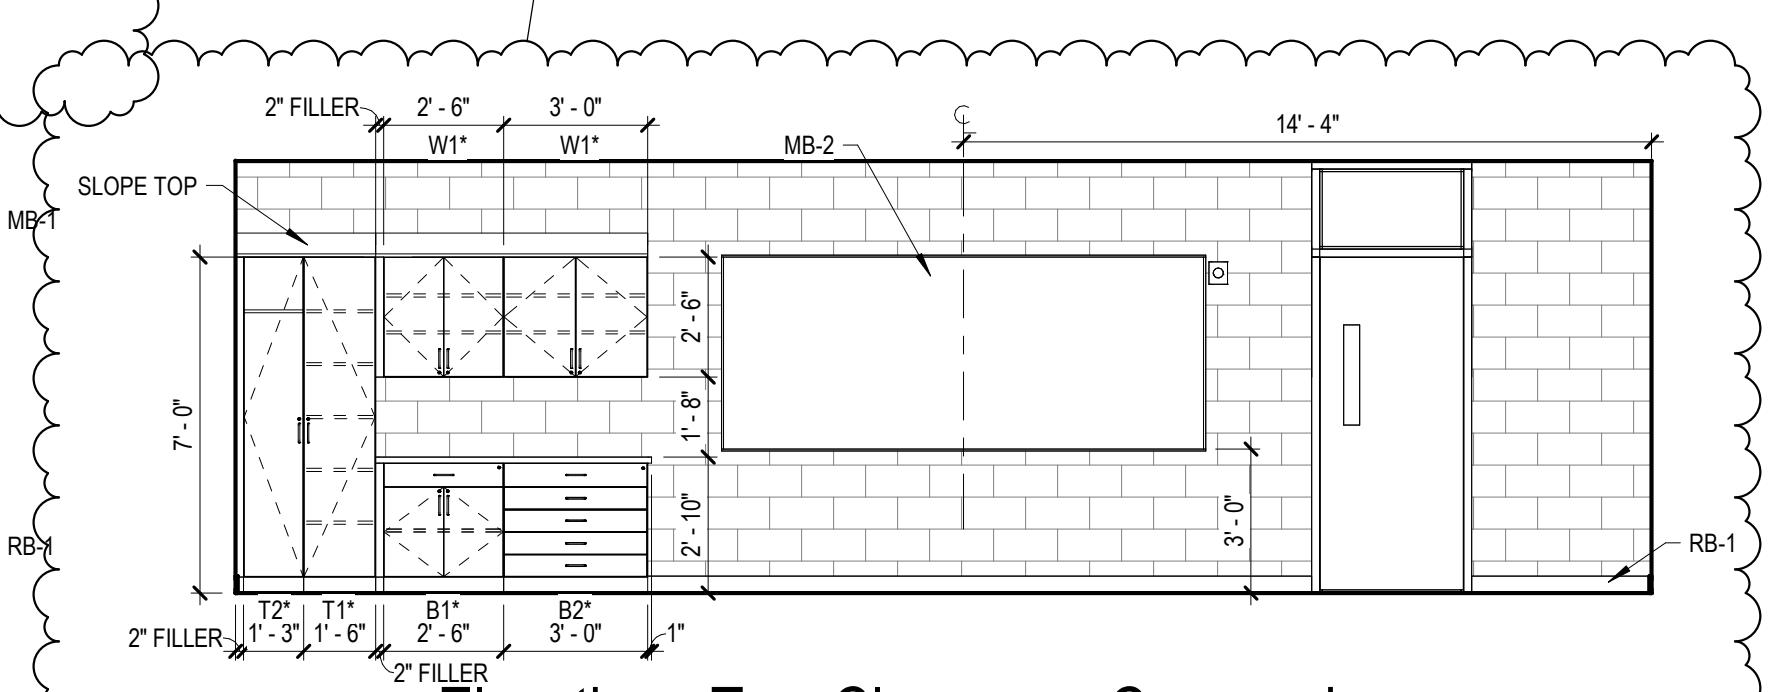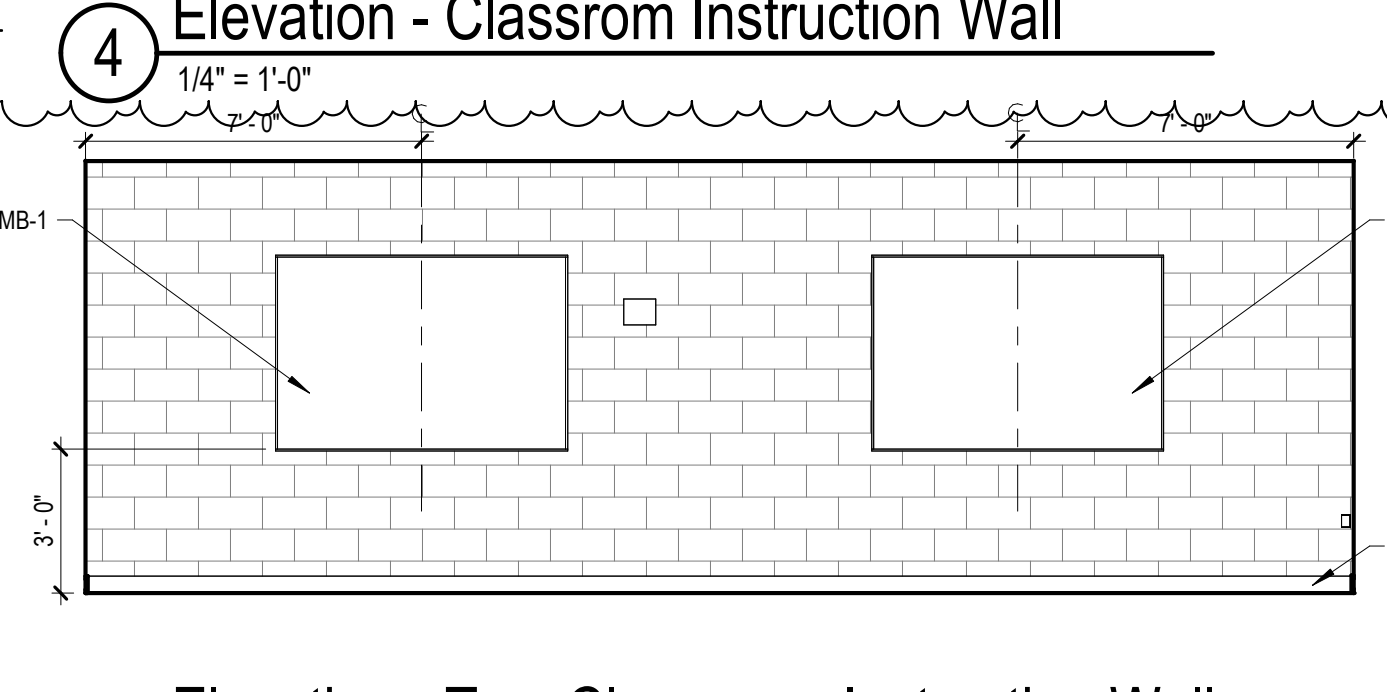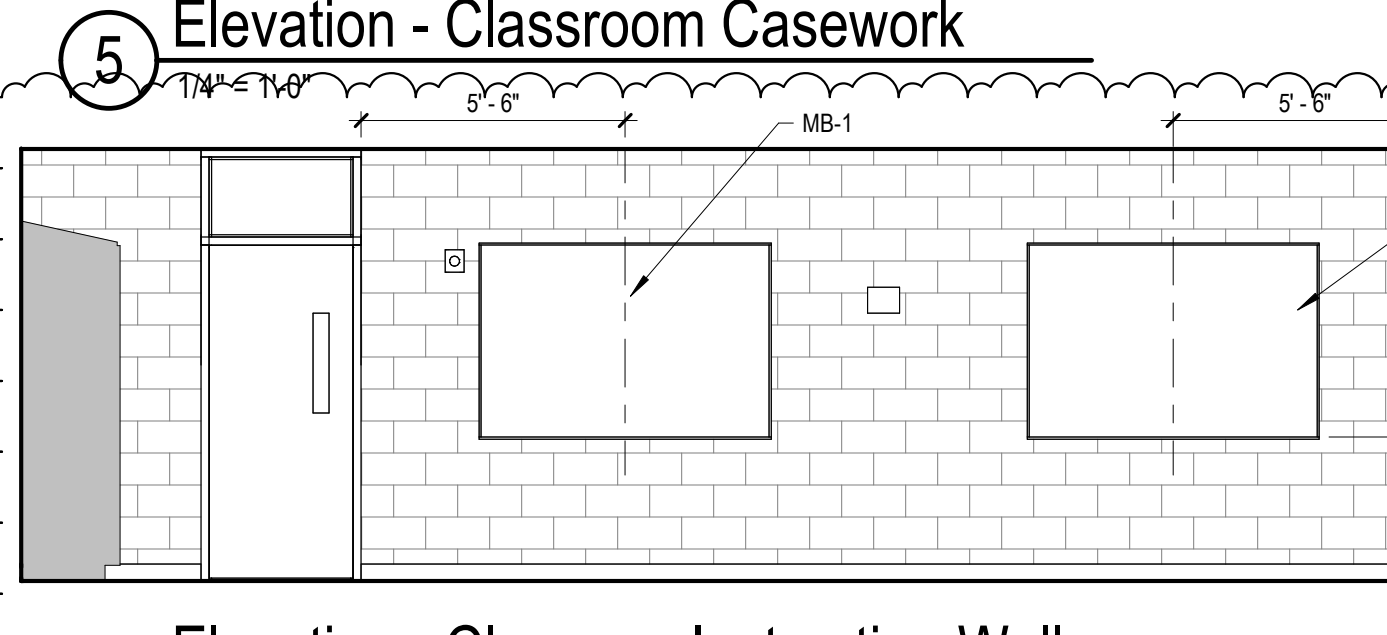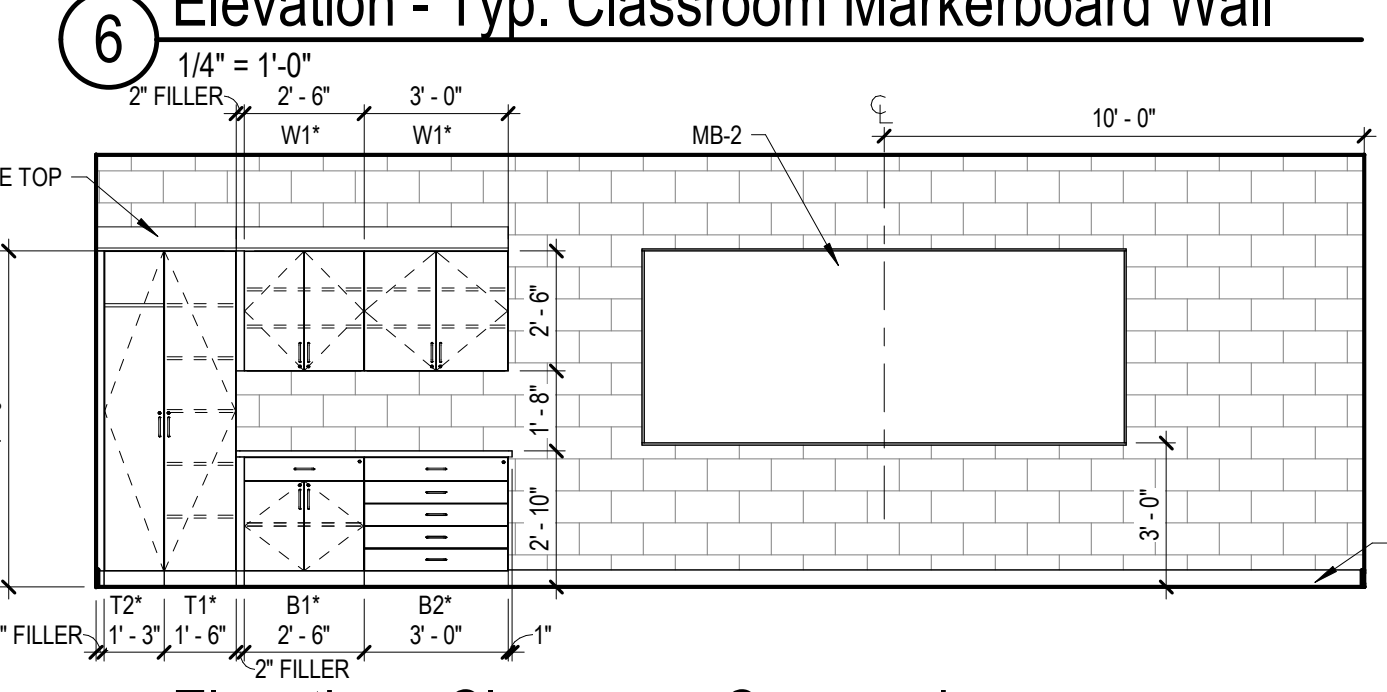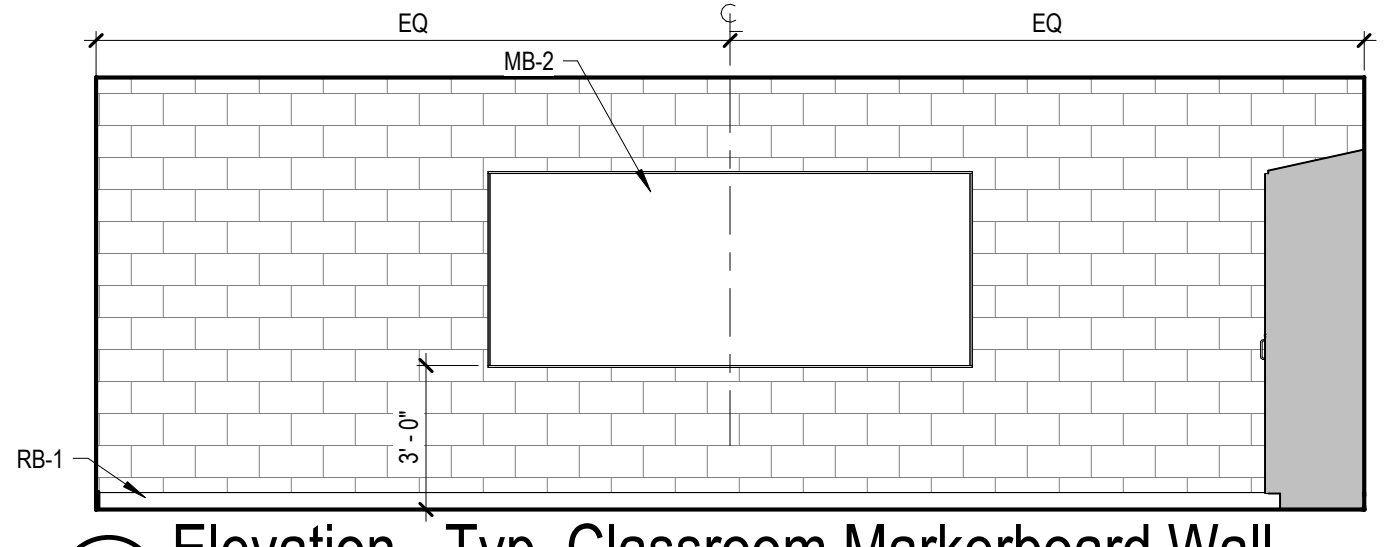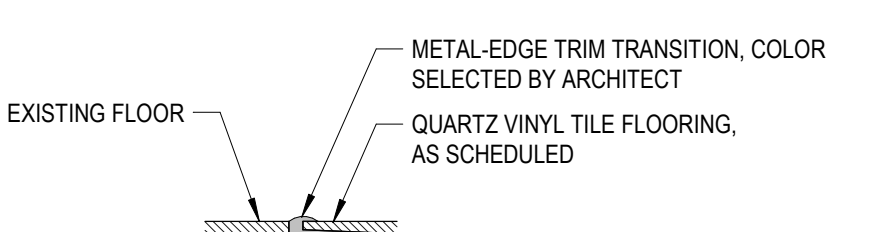

1 Second Floor Finishes Plan
1/8" = 1'-0"





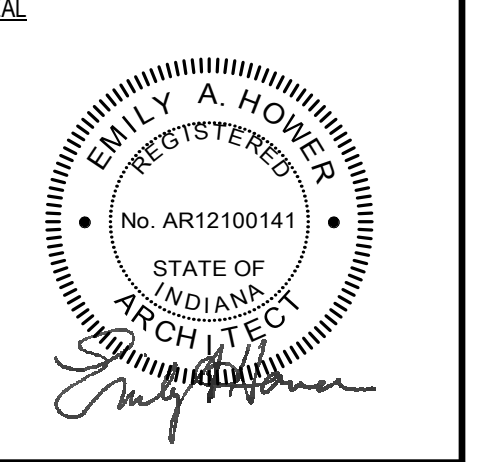

EACS Heritage Jr/Sr High School Classroom Renovations
 13808 Monroeville Rd,
 Monroeville, IN 46773



REVISIONS		
NO.	DESCRIPTION	DATE
1	ADDENDA #02	12-18-2024

PROJECT NO. 2401110
ISSUE DATE November 27, 2024
SUBMITTAL
 Issue for Bids, Permits, and Construction


Finishes Plan - Second Floor





111 E. Wayne Street, Suite 555, Fort Wayne, IN 46802
266-424-9500
ElevatusArchitecture.com



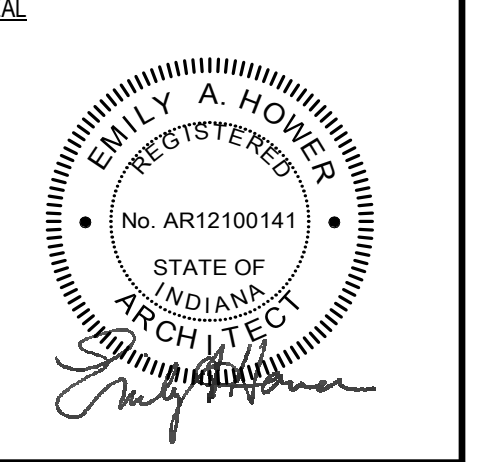


DEMOLITION GENERAL NOTES

- DEMOLITION PLANS SHALL SERVE TO AID IN EVALUATION OF THE WORK AND EXTENT OF DEMOLITION BUT SHALL NOT BE HELD TO BE ALL INCLUSIVE. FIELD VERIFY EXISTING CONDITIONS, DEMOLITION AND REMOVALS AS REQUIRED FOR INSTALLATION OF THE NEW WORK AND FINISHES INDICATED WHETHER OR NOT SPECIFICALLY NOTED IN THESE DRAWINGS.
- SCHEDULE DEMOLITION WORK EFFECTING OCCUPIED AREAS OF THE FACILITY IN ADVANCE WITH THE OWNER THROUGH CONSTRUCTION PROJECT MANAGER. REFER TO SPECIFICATIONS.
- FINISH REMOVAL NOTES APPLY TO PARTITIONS/WORK THAT REMAIN. REMOVE ALL FINISHES FROM WALLS THAT REMAIN WITHIN THE LIMIT OF CONSTRUCTION, UNLESS NOTED OTHERWISE.
- REMOVE INTERIOR WALLS/PARTITIONS ENTIRELY FROM DECK ABOVE TO DECK BELOW.
- WHERE WALLS, PARTITIONS, FLOORING, ACCESSORIES OR OTHER TYPES OF CONSTRUCTION ARE REMOVED, PATCH AND REPAIR ADJACENT AREAS AS REQUIRED TO RECEIVE NEW CONSTRUCTION OR FINISHES AND TO MATCH ADJACENT SURFACES. MAINTAIN ALL EXISTING AND REQUIRED FIRE RATED CONSTRUCTION THROUGHOUT.
- WHERE NEW FLOOR FINISHES ARE SCHEDULED OR INDICATED, REMOVE ALL EXISTING FLOOR FINISHES AND PREPARE A CLEAN SLAB TO RECEIVE NEW FLOOR FINISHES IN ACCORDANCE WITH THE NEW FLOOR FINISH MANUFACTURERS WRITTEN RECOMMENDATIONS UNLESS NOTED OTHERWISE. PROPER PREPARATION OF EXISTING SURFACES SHALL INCLUDE, BUT NOT BE LIMITED TO, REMOVAL OF ACCUMULATED ADHESIVES & MASTICS, FILLING AND REPAIR OF CRACKS & VOIDS, SURFACE RESTORATION, THOROUGH CLEANING, ETC. & OTHER PROCEDURES AS MAY BE RECOMMENDED BY MANUFACTURER OF NEW FLOORING.
- UNLESS NOTED OTHERWISE, REMOVE ALL EXISTING ACCESSORIES & HARDWARE. PATCH & REPAIR ALL SURFACES TO RECEIVE NEW FINISHES.
- OFFER REMOVED ITEMS TO OWNER BEFORE REMOVAL FROM THE SITE. DETERMINE SALVAGE ITEMS WITH THE OWNER BEFORE DEMOLITION BEGINS. ALL ITEMS NOT DESIRED BY OWNER SHALL BECOME PROPERTY OF THE CONTRACTOR AND SHALL BE LEGALLY DISPOSED OF OFF SITE.
- PROTECT ALL ITEMS TO REMAIN AND REPAIR/REPLACE ANY DAMAGED ITEMS OR CONSTRUCTION.
- GENERAL CONTRACTOR IS RESPONSIBLE FOR COORDINATING THE WORK WITH OTHER TRADES.
- CONTRACTOR SHALL PROVIDE TEMPORARY SHORING AS NECESSARY TO COMPLETE THE WORK.
- CAP AND REROUTE EXISTING UTILITY SERVICES LOCATED IN WALLS, CEILING, OR FLOORS TO BE REMOVED, AS REQUIRED FOR NEW CONDITIONS AND IN ACCORDANCE WITH APPLICABLE CODES. SEE ENGINEERING DRAWINGS FOR ADDITIONAL INFORMATION.
- HOLES LEFT IN CONCRETE FLOORS FROM REMOVED ITEMS SHALL BE PATCHED BY GENERAL CONTRACTOR.
- REFER TO ENGINEERING DRAWINGS FOR RELATED WORK AND ITEMS TO BE REMOVED OR RE-INSTALLED IN NEW CONSTRUCTION. COORDINATE TEMPORARY LIGHTING, COMMUNICATION AND MECHANICAL SYSTEMS WITH OTHER TRADES. MAINTAIN ALL LIFE SAFETY DEVICES.
- REMOVE ABANDONED UTILITY SERVICES, SUCH AS ELECTRICAL, PLUMBING, GAS LINES, AND MECHANICAL DUCTWORK, DISCOVERED AND NOT SCHEDULED FOR REUSE BACK TO THEIR SOURCE (INCLUDING ALL HANGARS, STRAPS, WIRES, ETC.). MAINTAIN ANY SYSTEM SERVICING ADJACENT BUILDING AREAS THAT ARE NOT INCLUDED IN THE CONTRACT; REROUTE AS REQUIRED. SEE ENGINEERING DRAWINGS FOR ADDITIONAL INFORMATION.
- PROVIDE ALL NECESSARY DEMOLITION OF EXISTING CONSTRUCTION FOR NEW UTILITY SERVICES AS REQUIRED.

DEMOLITION PLAN NOTES

TAG	DESCRIPTION
CEILING DEMOLITION	
1.01	REMOVE ACOUSTICAL LAY-IN CEILING SYSTEM, PANELS, GRID AND ALL RELATED HANGERS AND SUPPORTS.
1.03	ACOUSTICAL LAY-IN CEILING SYSTEM TO REMAIN. PROTECT DURING CONSTRUCTION. REPAIR ALL DAMAGED AREAS AT CONCLUSION OF THE WORK.
FLOORING DEMOLITION	
2.01	REMOVE VINYL COMPOSITION TILE FLOORING AND ALL RELATED MASTIC/ADHESIVE. CLEAN/PREP SUBFLOOR TO ACCEPT NEW FLOORING AS SCHEDULED.
2.05	FLOOR FINISH TO REMAIN. PROTECT FLOORING DURING CONSTRUCTION. REPLACE DAMAGED FLOORING (MATCH EXISTING) AT CONCLUSION OF THE WORK.
PARTITION DEMOLITION	
3.01	REMOVE RESILIENT WALL BASE. PATCH/REPAIR WALL SURFACE TO ACCEPT NEW FINISHES AS SCHEDULED.
3.02	REMOVE PARTITION IN ITS ENTIRETY, INCLUDING INTERIOR WINDOWS AND WALL BASE. VERIFY STRUCTURAL INTEGRITY OF PARTITION PRIOR TO REMOVAL.
3.03	REMOVE VINYL WALL COVERING ABOVE DOOR. PATCH/REPAIR WALL SURFACE TO ACCEPT NEW FINISHES AS SCHEDULED.
3.06	REMOVE DOOR(S) AND FRAME. OFFER DOOR(S) AND HARDWARE TO OWNER BEFORE DISPOSING.
3.09	DOOR(S) AND FRAME TO REMAIN. PROTECT DURING CONSTRUCTION. REPAIR/REPLACE DAMAGED COMPONENTS AT CONCLUSION OF THE WORK.
3.10	WINDOW AND WINDOW SILL TO REMAIN. PROTECT DURING CONSTRUCTION.
3.11	REMOVE PARTITION OF WALL PARTITION CONSTRUCTION OF NEW OPENING AS REQUIRED.
3.13	REMOVE PARTITION IN ITS ENTIRETY INCLUDING WALL COVERINGS, WALL BASES, AND ANY DOORS/DOOR FRAMES WITHIN.
EXTERIOR DEMOLITION	
4.04	REMOVE LOCKERS. SALVAGE FOR REINSTALLATION. OFFER TO OWNER BEFORE DISPOSING.
4.05	TECHNOLOGY EQUIPMENT IS TO BE REMOVED BY OWNER.
4.06	REMOVE ALL WINDOW TREATMENTS SUCH AS MINI-BLINDS, CURTAINS, AND RELATED HANGERS. PATCH AND REPAIR ANY HOLES IN WALLS AT CONCLUSION OF WORK TO PREP FOR NEW BLINDS BY OWNER. OFFER TO OWNER BEFORE DISPOSING.
4.07	REMOVE BASE CABINET(S), COUNTERTOP AND WALL CABINET(S). PATCH AND REPAIR ANY HOLES IN WALLS AT CONCLUSION OF WORK. OFFER TO OWNER BEFORE DISPOSING.
4.08	REMOVE TACKBOARDS, TACK STRIPS, MARKERBOARDS, ETC. PATCH AND REPAIR ANY HOLES IN WALLS AT CONCLUSION OF WORK. OFFER TO OWNER BEFORE DISPOSING.
4.09	REMOVE ALL REMAINING FURNITURE AND EQUIPMENT IN SPACE. OFFER TO OWNER BEFORE DISPOSING.
UTILITY DEMOLITION	
5.03	HVAC UNIT TO REMAIN. PROTECT DURING CONSTRUCTION. REPAIR/REPLACE DAMAGED COMPONENTS AT CONCLUSION OF THE WORK. - SEE MECHANICAL DOCUMENTS FOR MORE INFORMATION.
5.07	HVAC UNIT TO BE REMOVED. SEE MECHANICAL DOCUMENTS FOR MORE INFORMATION.

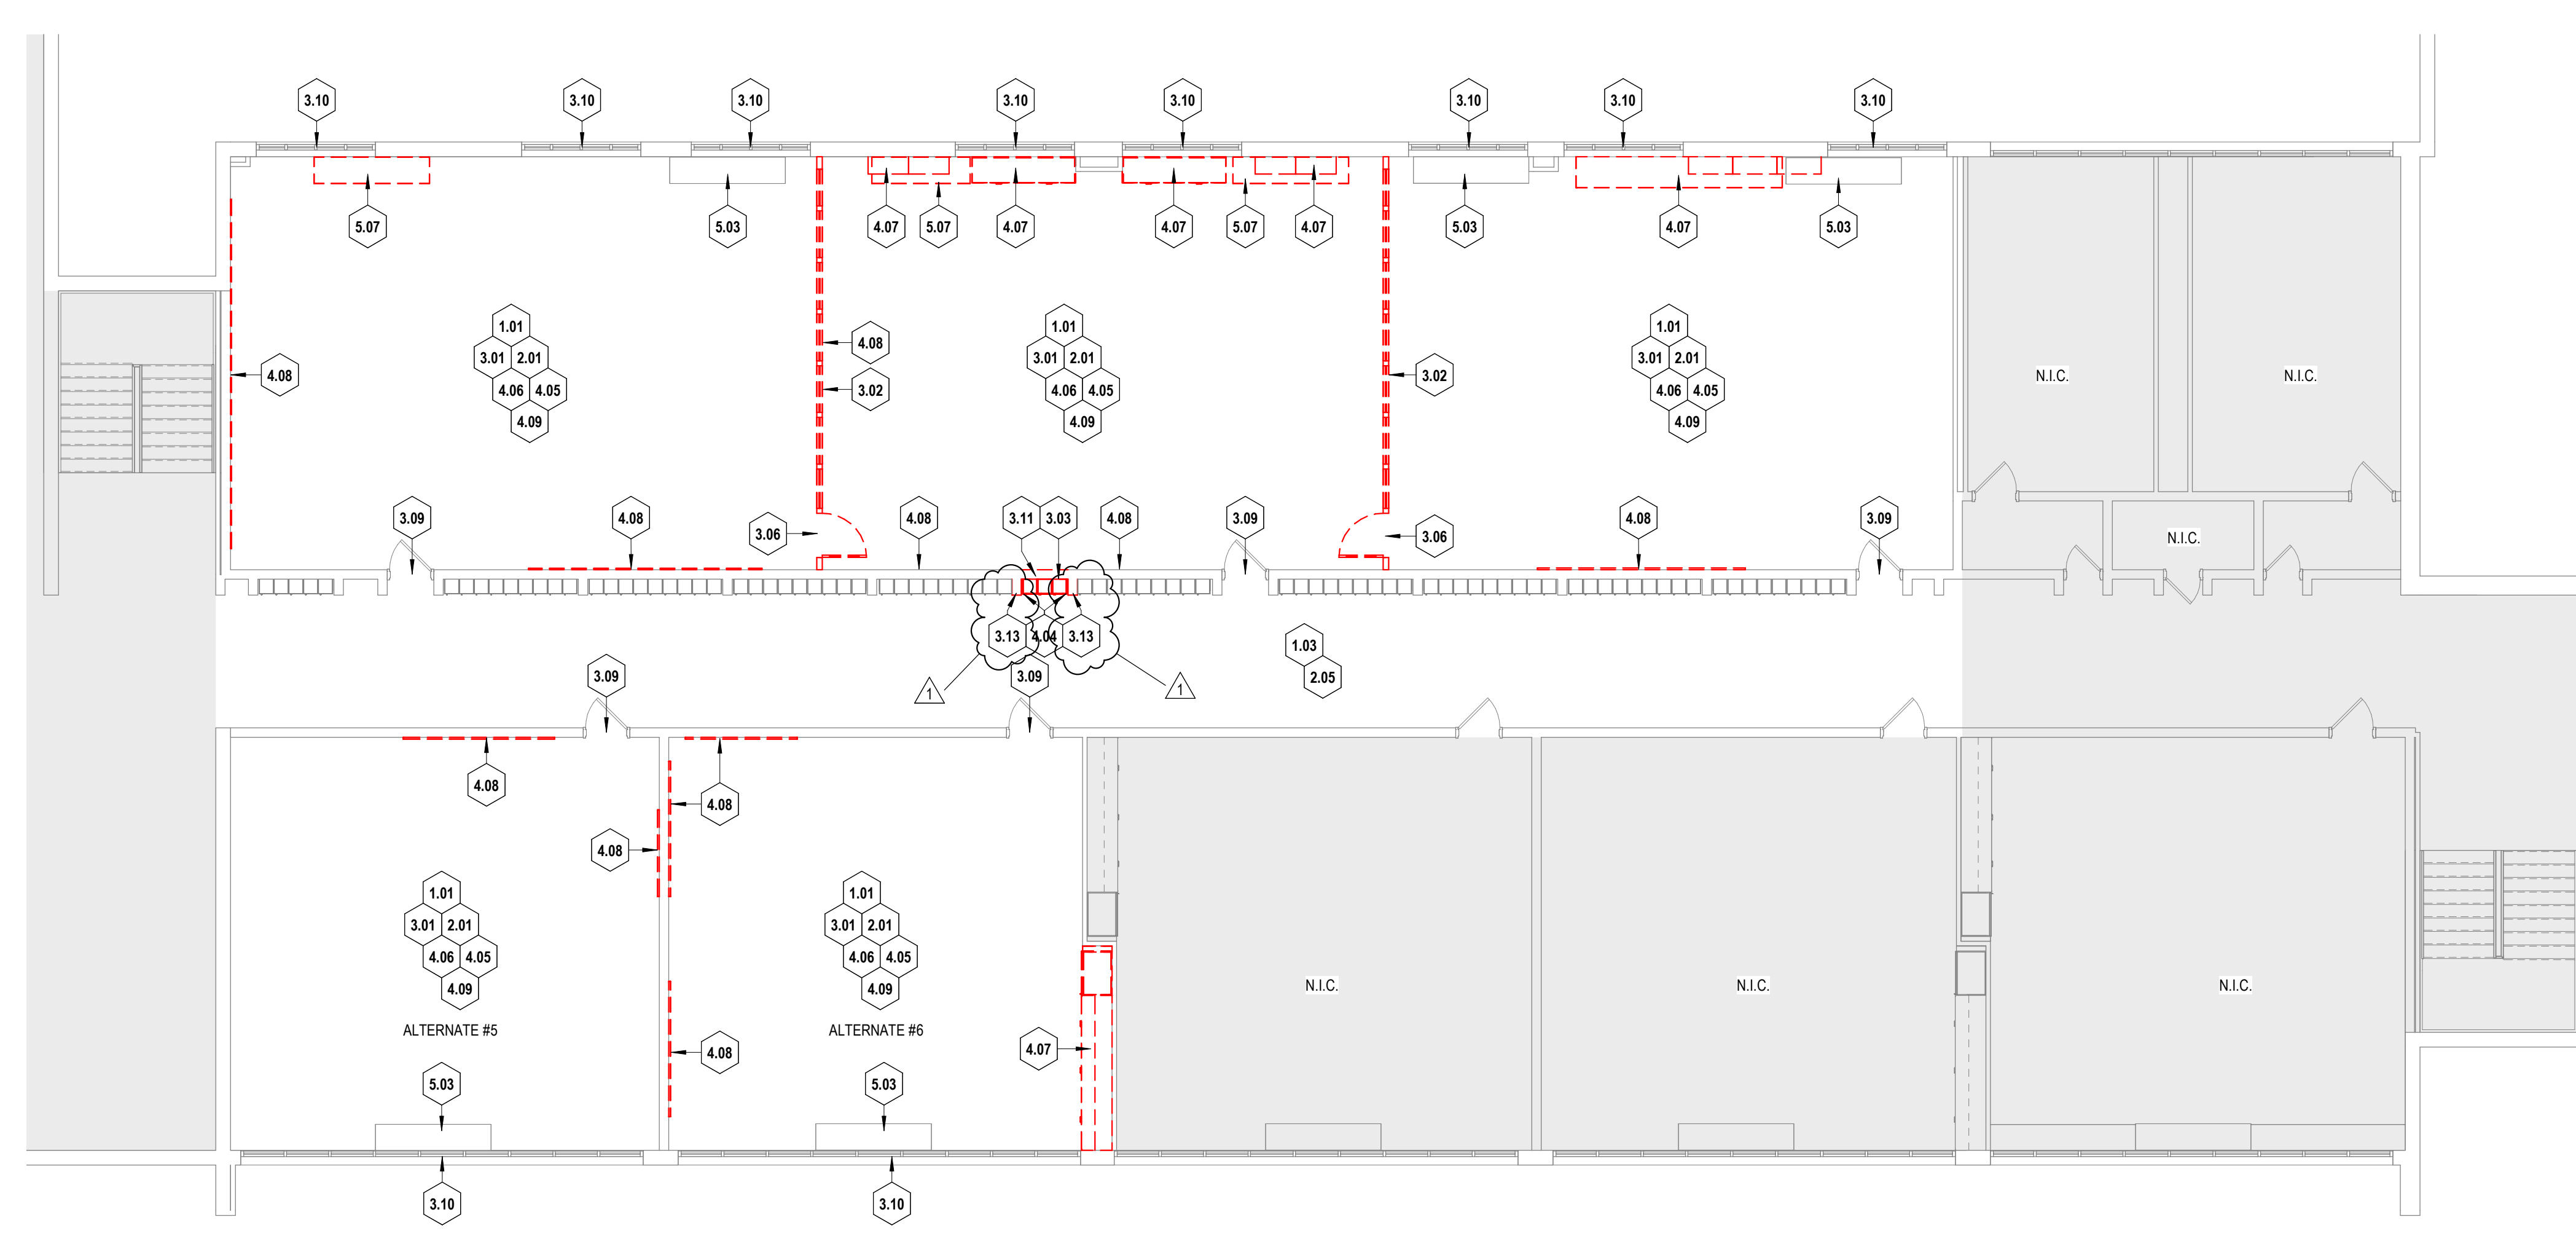

PLAN NORTH
1 Second Floor Architectural Demolition Plan
 1/8" = 1'-0"


EACS Woodlan High School
 Classroom Renovation
 17215 Woodburn Rd,
 Woodburn, IN 46797

REVISIONS		
NO.	DESCRIPTION	DATE
1	ADDENDUM #02	12-18-2024

PROJECT NO. 2401110
 ISSUE DATE November 27, 2024
 SUBMITTAL
 Issue for Bids, Permits, and Construction

Architectural Demolition
 Plan - Second Floor

AD101

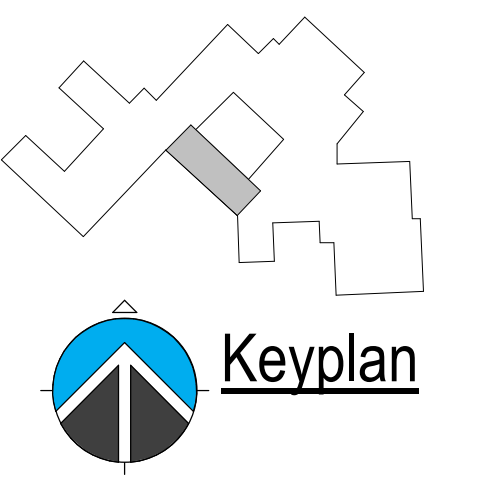

12/18/2024 10:23:04 AM
 Addendum 02 (EACS) - Classroom Renovation (EACS) - Woodlan High School - Woodburn, IN

DOOR SCHEDULE														
Door No.	Qty	Width	Height	Thick.	Type	Material	Frame Type	Material	Head	Jamb	Sill	Fire Rating	Hardware Set	Comments
1	1	2'-10"	7'-0"	1 3/4"	N	WD	1	HM	3/A-111	2/A-111	-	20 MIN	001	FIELD VERIFY DOOR OPENING

DOOR SCHEDULE NOTES

HM - HOLLOW METAL (PAINT)
 HPC - HIGH-PERFORMANCE COATING
 SMOKE - DOOR TO RECEIVE SMOKE SEALS
 WD - SOLID CORE WOOD (STAIN TO MATCH EXISTING)





DOOR NOTES
 1. ALL GLAZING TO BE CLEAR U.N.O.

FLOOR PLAN GENERAL NOTES

- GENERAL CONTRACTOR SHALL TAKE RESPONSIBILITY FOR COORDINATING REQUIRED WORK WITH ALL TRADES BASED UPON A COMPLETE SET OF CONSTRUCTION DOCUMENTS.
- EACH CONTRACTOR SHALL VERIFY ALL DIMENSIONS SHOWN ON THE DRAWINGS AND OBTAIN ALL MEASUREMENTS REQUIRED FOR PROPER EXECUTION OF WORK. WHEN VERIFICATION OF EXISTING DIMENSIONS IS REQUIRED, THE CONTRACTOR REQUIRING SAID VERIFICATION FOR THE CONSTRUCTION OR FABRICATION OF HIS MATERIAL SHALL BE THE CONTRACTOR RESPONSIBLE FOR THE PROCUREMENT OF THE FIELD INFORMATION.
- WRITTEN DIMENSIONS TAKE PRECEDENCE OVER SCALED MEASUREMENTS. DO NOT SCALE DRAWINGS.
- DETAILED DRAWINGS AND LARGER SCALE DRAWINGS TAKE PRECEDENCE OVER SMALL SCALE DRAWINGS.
- UNLESS NOTED OTHERWISE, PLAN DIMENSIONS ARE TAKEN FROM FACE OF STUD, CMU, CONCRETE OR EXISTING FINISH TO FACE OF STUD, CMU OR CONCRETE.
- REPAIR ALL SURFACES DAMAGED BY RENOVATION AND NEW CONSTRUCTION TO MATCH EXISTING ADJACENT OR CONTIGUOUS FINISH.
- GENERAL CONTRACTOR TO PATCH ALL CONCRETE SLAB MECH/ELEC PENETRATIONS. PATCH SLAB FLUSH WITH EXISTING SLAB AND PROVIDE #4 DOWELS INTO EXISTING SLAB AS REQUIRED.
- ALL CUTTING AND PATCHING AS A RESULT OF NEW CONSTRUCTION OR DEMOLITION SHALL BE PERFORMED IN A WORKMANLIKE MANNER AND SHALL MATCH IN COLOR, SHAPE, SIZE AND TEXTURE ADJACENT AND/OR CONTIGUOUS FINISHED SURFACES.
- WHERE PATCHING, REPAIRING OR INFILLING EXISTING MASONRY EXPOSED TO VIEW, "TOOTH-IN" NEW MASONRY TO ADJACENT EXISTING MASONRY TO REMAIN.
- PATCH ALL CRACKS AND REPAIR JOINTS IN EXISTING SUBSTRATES SCHEDULED TO RECEIVE NEW FINISHES.
- PROVIDE ALL BLOCKING NECESSARY FOR THE ATTACHMENT OF MISCELLANEOUS EQUIPMENT INCLUDING BUT NOT LIMITED TO CASEWORK, MILLWORK, TOILET ACCESSORIES, GRAB BARS, HANDRAILS, DOOR HARDWARE, ELECTRICAL DEVICES AND LABORATORY EQUIPMENT.
- ALL INTERIOR WOOD BLOCKING SHALL BE FIRE-RETARDANT TREATED. ALL EXTERIOR WOOD BLOCKING SHALL BE PRESSURE TREATED.
- PROVIDE FIRE-BLOCKING AND DRAFT-STOPPING IN COMBUSTIBLE CONCEALED WALLS AT 10'-0" O.C. MAX. HORIZONTALLY & VERTICALLY.
- DOORS NOT OTHERWISE DIMENSIONED SHALL BE 8" FROM FACE OF ADJACENT CMU OR CONCRETE WALL TO ROUGH DOOR OPENING, AND 4" FROM FACE OF ADJACENT STUD WALL TO ROUGH DOOR OPENING.
- THE TRANSITION OF DIFFERENT FLOORING MATERIALS AT A DOORWAY SHALL OCCUR AT THE CENTERLINE OF DOOR UNLESS NOTED OTHERWISE.
- ALL WALL SURFACES, DOOR FRAMES, BULKHEADS AND CEILINGS SHALL RECEIVE PAINT WHEN PAINT IS INDICATED ON THE FINISH SCHEDULE OR FINISH PLANS. PAINT SURFACES BEHIND MOVABLE EQUIPMENT AND FURNITURE SAME AS SIMILAR EXPOSED SURFACES. PAINT SURFACES BEHIND PERMANENTLY FIXED EQUIPMENT OR FURNITURE WITH PRIME COAT ONLY BEFORE FINAL INSTALLATION OF EQUIPMENT. PAINT ALL MECHANICAL AND ELECTRICAL EQUIPMENT EXPOSED IN FINISHED SPACES UNLESS NOTED OTHERWISE.
- FOR CONSTRUCTION DETAILS NOT SHOWN, USE THE PRODUCT MANUFACTURER'S WRITTEN INSTALLATION INSTRUCTIONS AND STANDARD DETAILS, IN STRICT ACCORDANCE WITH THE PROJECT SPECIFICATION REQUIREMENTS AND DESIGN INTENT.
- REFER TO LIFE SAFETY PLANS FOR RATED PARTITIONS AND ASSEMBLIES.
- UNLESS NOTED OTHERWISE, NEW WALLS TO BE 3/8" METAL STUDS @ 16" O.C. WITH (1) LAYER OF 5/8" TYPE "X" GYPSUM BOARD EACH SIDE. EXTEND STUD AND GYPSUM BOARD TO MINIMUM 6" ABOVE FINISHED CEILING. SEAL AS REQUIRED FOR WALL RATINGS INDICATED.



DOOR HARDWARE NOTES

HARDWARE SET SET #001	MCKINNEY SARGENT BEST SARGENT ROCKWOOD H.B. IVES CO.	TA2714 4 1/2 X 4 1/2 70 8238 LNL 1C7-COMB 281 P10 K1859 8" x 3" W596/407CCV 2525 B-20 20"	26D 26D 626 EN US32D US32D IV NA	MC SA MBS SA RO IV NA
------------------------------	---	---	---	---

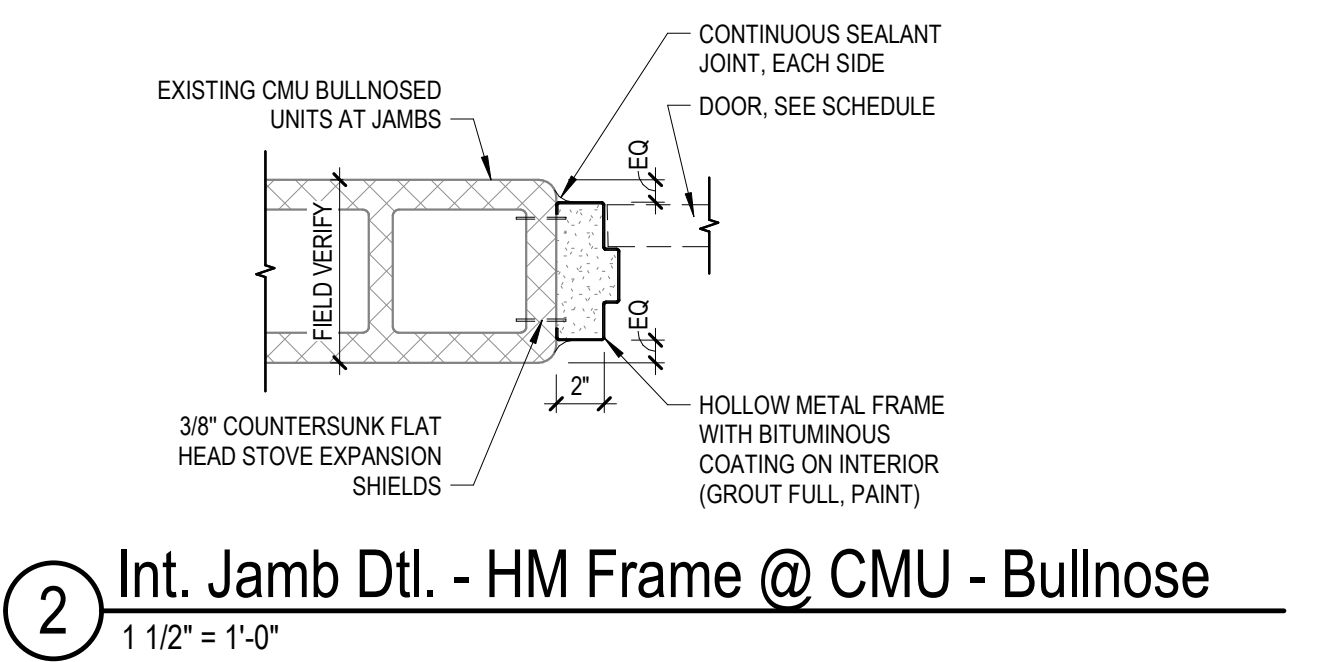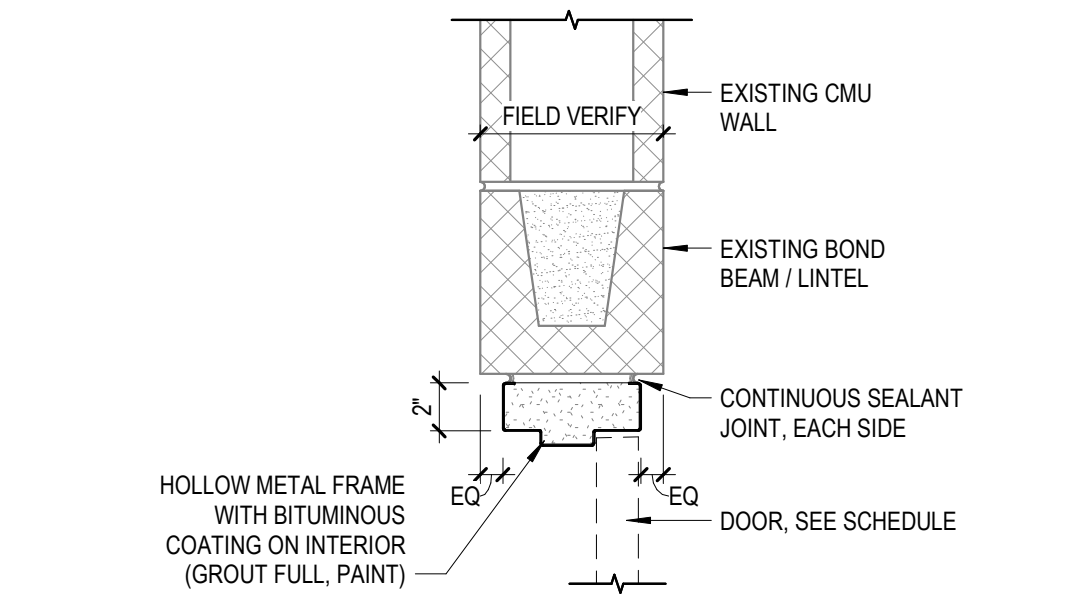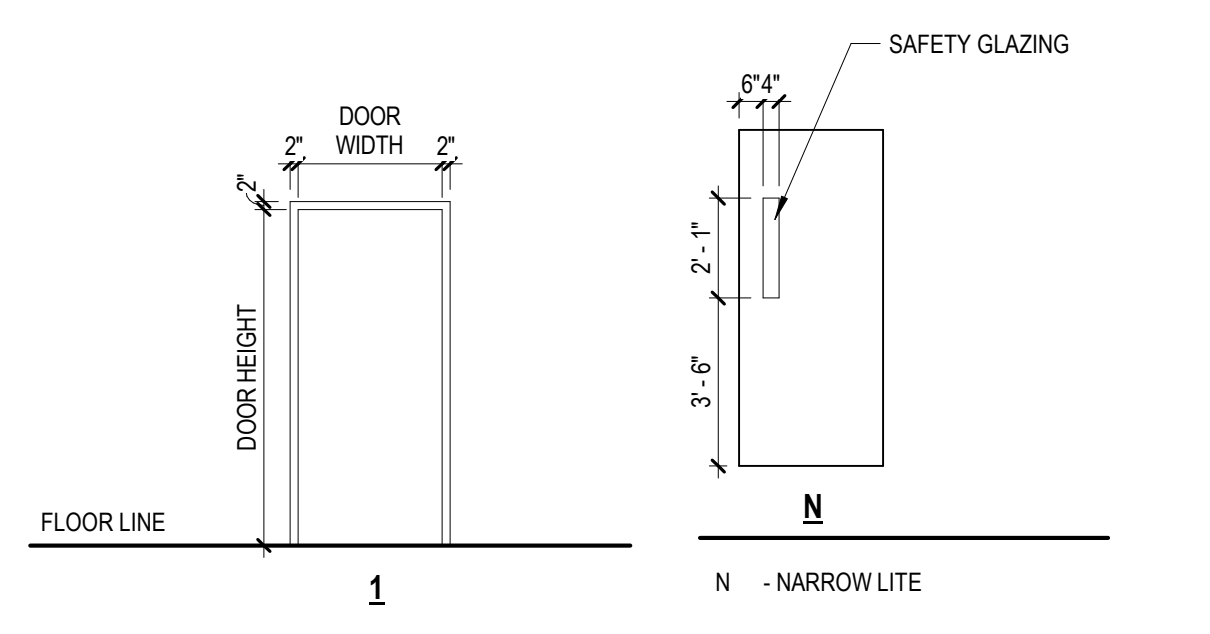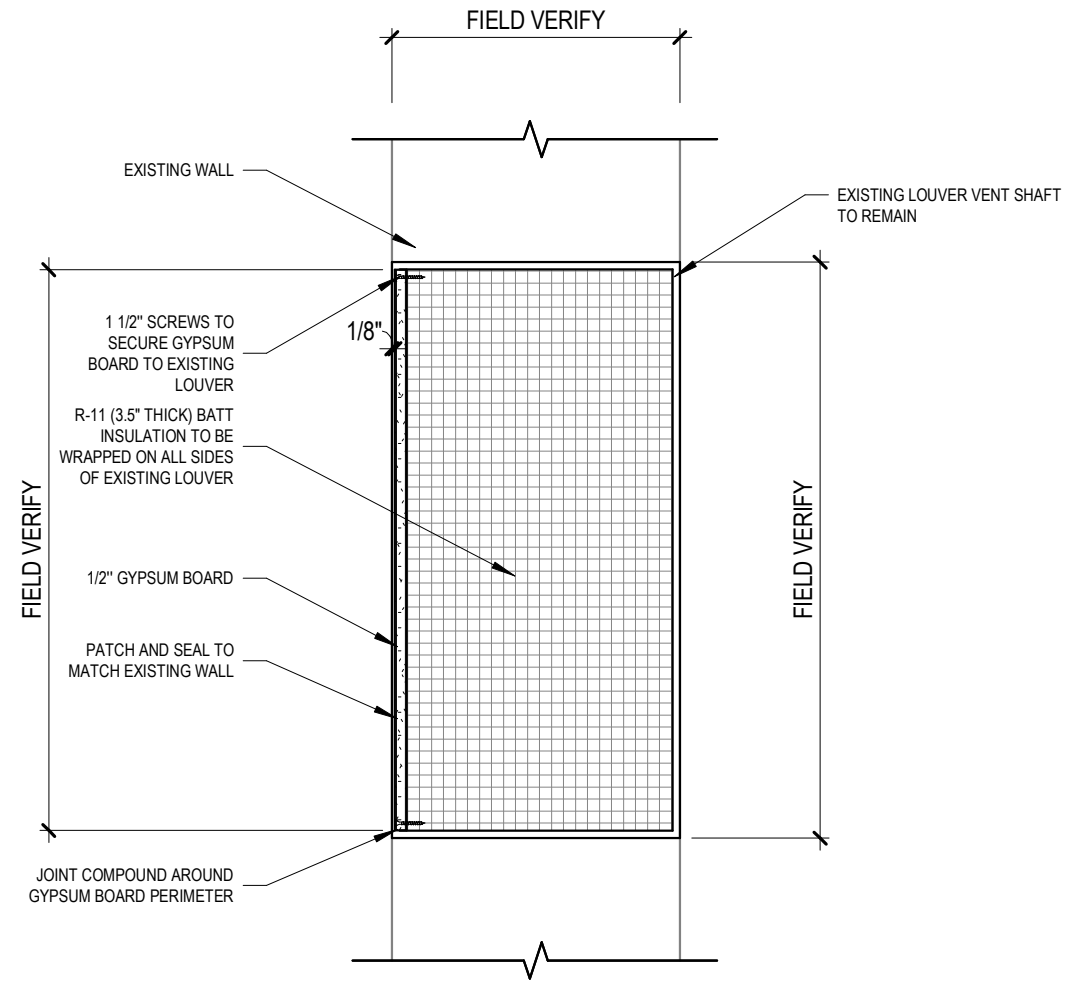


FLOOR PLAN NOTES

TAG	DESCRIPTION
10.01	PROVIDE A 6"X 4" H MARKERBOARD (MB-1). PROVIDE ALUMINUM FINISH TRIM ON ALL EDGES. REFER TO SPECIFICATIONS FOR MORE INFORMATION.
10.02	PROVIDE A 10" X 4" H MARKERBOARD (MB-2). PROVIDE ALUMINUM FINISH TRIM ON ALL EDGES. REFER TO SPECIFICATIONS FOR MORE INFORMATION.
11.01	REINSTALL SALVAGED LOCKERS TO FIT EXISTING OPENING. USE FILLER TO CENTER LOCKERS WITHIN OPENING.
11.02	REMOVE AND REINSTALL LOCKER NUMBER PLATES IN NUMERICAL ORDER.
11.03	PROVIDE METAL LOCKER END CAP FOR EXPOSED LOCKER ENDS AT CONCLUSION OF WORK. MATCH FINISH TO EXISTING LOCKERS.
22.01	CAP EXISTING PLUMBING IN WALL.
23.01	EXISTING LOUVER TO BE SEALED. SEE DETAIL 4/A-111.

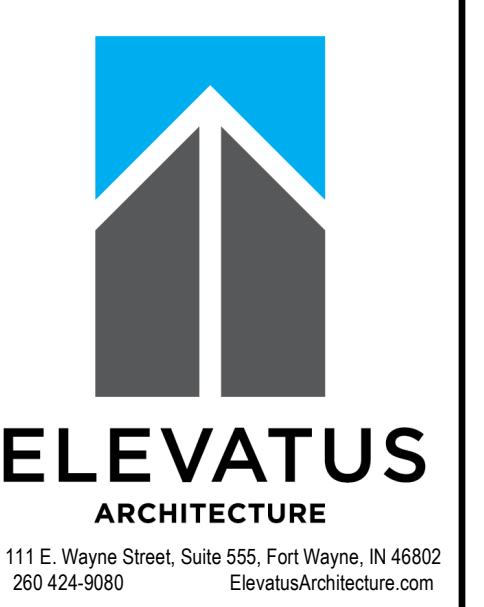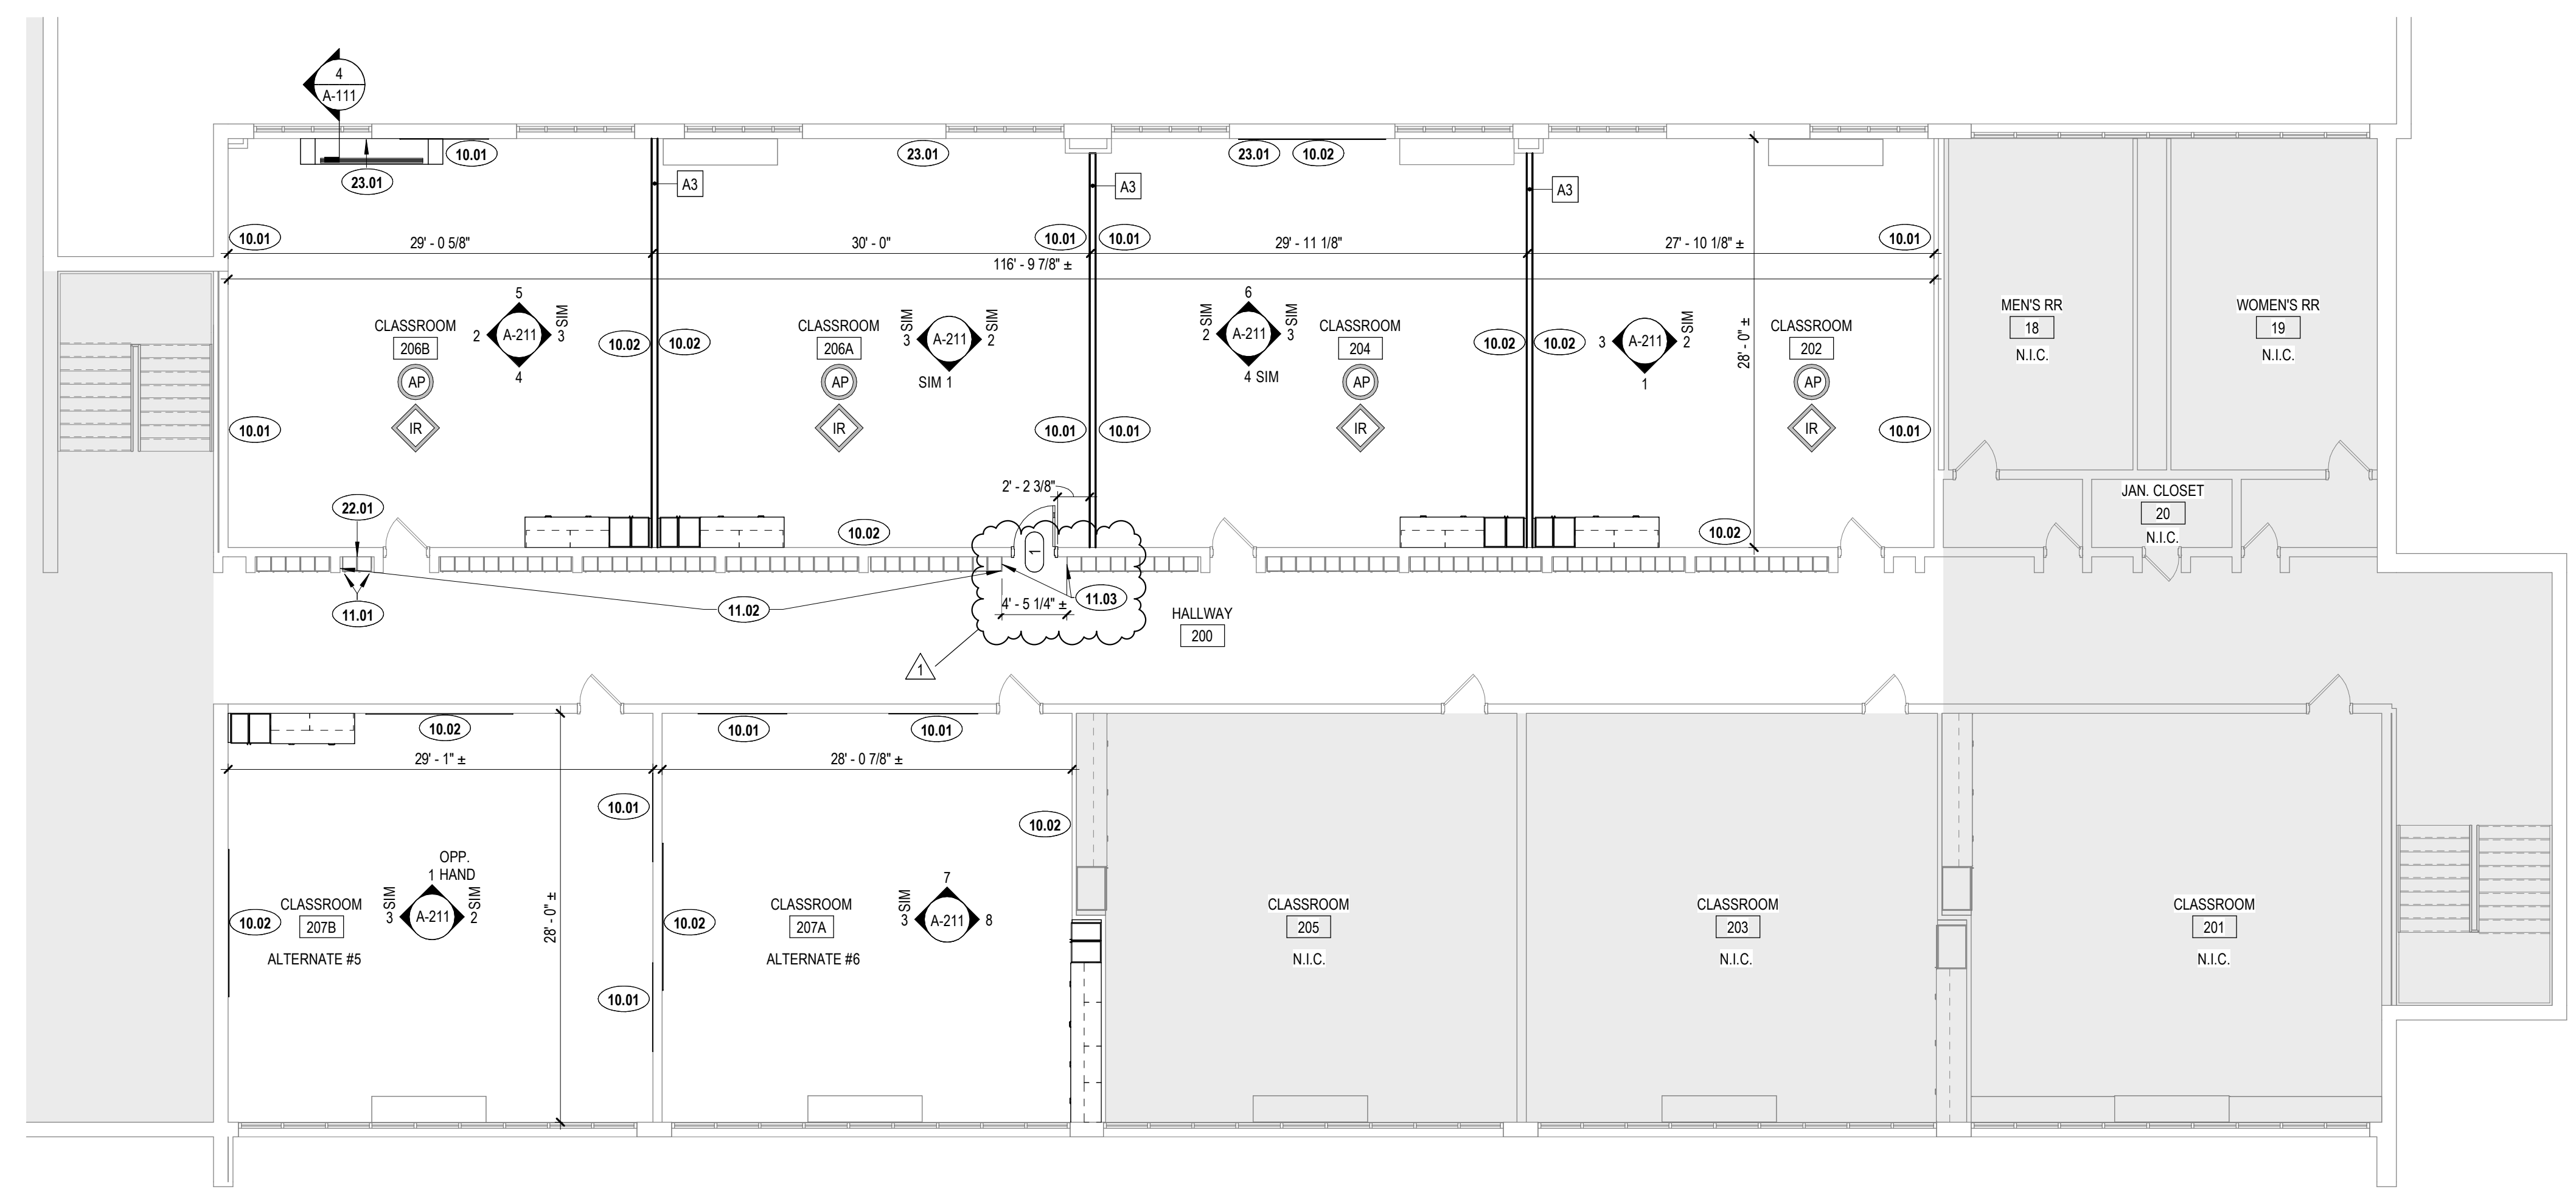

CONFIDENTIAL COPYRIGHT 2024
 SLAB ARCHITECTS, LLC AND ELEVATUS ARCHITECTURE
 ALL RIGHTS RESERVED. NO PART OF THIS DOCUMENT MAY BE REPRODUCED OR TRANSMITTED IN ANY FORM OR BY ANY MEANS, ELECTRONIC OR MECHANICAL, INCLUDING PHOTOCOPYING, RECORDING, OR BY ANY INFORMATION STORAGE AND RETRIEVAL SYSTEM, WITHOUT THE WRITTEN PERMISSION OF SLAB ARCHITECTS, LLC AND ELEVATUS ARCHITECTURE.

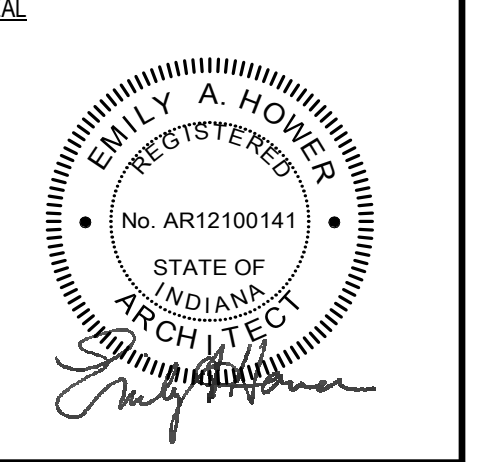

EACS Woodlan High School Classroom Renovation
 17215 Woodburn Rd., Woodburn, IN 46797

REVISIONS


NO.	DESCRIPTION	DATE
1	ADDENDUM #02	12-18-2024

PROJECT NO. 2401110
 ISSUE DATE November 27, 2024

SUBMITTAL
 Issue for Bids, Permits, and Construction

Architectural Notation Plan - Second Floor

A-111

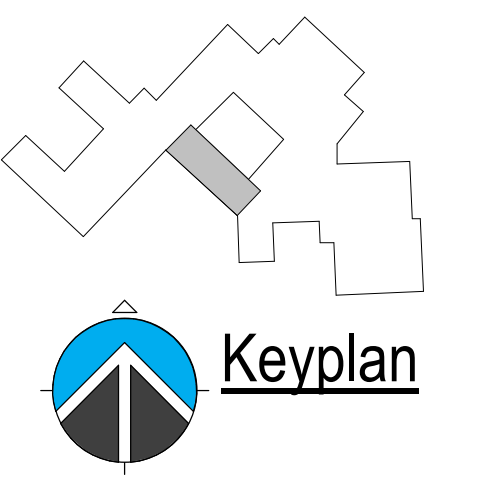

12/18/2024 10:52:27 AM
 Addendum #02 EACS Woodlan High School Classroom Renovation.rvt
 User: emily.ahoyer

ROOM FINISH SCHEDULE

Room No.	Room Name	Floor	Base	Wall				Comments
				North	East	South	West	
SECOND FLOOR								
202	CLASSROOM	QVT-1, QVT-2, QVT-3	RB-1	P-1	P-1	P-1	P-1	
204	CLASSROOM	QVT-1, QVT-2, QVT-3	RB-1	P-1	P-1	P-1	P-1	
206A	CLASSROOM	QVT-1, QVT-2, QVT-3	RB-1	P-1	P-1	P-1	P-1	
206B	CLASSROOM	QVT-1, QVT-2, QVT-3	RB-1	P-1	P-1	P-1	P-1	
207A	CLASSROOM	QVT-1, QVT-2, QVT-3	RB-1	P-1	P-1	P-1	P-1	
207B	CLASSROOM	QVT-1, QVT-2, QVT-3	RB-1	P-1	P-1	P-1	P-1	

FINISH LEGEND

- (06.41.10) MILLWORK/CASEWORK**
 PL-1 MFG: FORMICA
 TYPE: PLASTIC LAMINATE
 COLOR: 961 FOG
 FINISH: MATTE
- SS-1**
 MFG: CORIAN
 TYPE: SOLID SURFACE
 COLOR: CARBON AGGREGATE
- (08.14.16) WOOD DOORS**
 D-1 MFG: MASONITE ARCHITECTURAL
 SPECIES: RED OAK
 CUT: MATCH EXISTING
 STAIN COLOR: CUSTOM MATCH EXISTING
- (09.91.13) ACOUSTICAL PANEL CEILING**
 APC-1 MFG: USG
 STYLE: RADAR
 EDGE STYLE: SQUARE LAY-IN
 SIZE: 24" X 48" X 5/8"
 GRID DOWN DIM: 15/16"
 TILE GRID COLOR: FLAT WHITE (050)
- (09.85.19) RESILIENT TILE FLOORING**
 QVT-1 MFG: KAHRIS
 TYPE: UPOFLOOR QUARTZ VINYL TILE
 COLLECTION: MOSAIC
 COLOR: 8315 LAVIA GREY
 SIZE: 24" X 24"
 THICKNESS: 1/8"
 INSTALL METHOD: MONOLITHIC
- QVT-2 MFG: KAHRIS
 TYPE: UPOFLOOR QUARTZ VINYL TILE
 COLLECTION: MOSAIC
 COLOR: 8359 ENHANCED DUMORTIERITE
 SIZE: 24" X 24"
 THICKNESS: 1/8"
 INSTALL METHOD: MONOLITHIC
- QVT-3 MFG: KAHRIS
 TYPE: UPOFLOOR QUARTZ VINYL TILE
 COLLECTION: MOSAIC
 COLOR: 8304 SCORIA GREY
 SIZE: 24" X 24"
 THICKNESS: 1/8"
 INSTALL METHOD: MONOLITHIC
- RB-1 MFG: TARKETT
 TYPE: RUBBER WALL BASE
 STYLE: BASEWORKS THERMOSET - WITH TDE
 COLOR: BLACK
 SIZE: 6"H
 THICKNESS: 0.125
- (09.91.00) PAINTING**
 P-1 MFG: SHERWIN WILLIAMS
 COLOR: SW 757 HIGH REFLECTIVE WHITE
 (FIELD WALLS)
- P-2 MFG: SHERWIN WILLIAMS
 COLOR: MATCH EXISTING
 (DOOR FRAMES)
- (10.11.00) VISUAL DISPLAY UNITS**
 MB-1 MFG: CLARIDGE PRODUCTS
 TYPE: SERIES 2
 WRITING SURFACE: WHITEBOARD PORCELAIN BRILLIANT WHITE
 TACK SURFACE: CLARIDGE CORK GRAPHITE
 TRAY: BOX TRAY
 SIZE: 48" X 72"
 THICKNESS: 1/2"
 NOTE: INSTALL USING ADHESIVE ONLY
- MB-2 MFG: CLARIDGE PRODUCTS
 TYPE: SERIES 2
 WRITING SURFACE: WHITEBOARD PORCELAIN BRILLIANT WHITE
 TACK SURFACE: CLARIDGE CORK GRAPHITE
 TRAY: BOX TRAY
 SIZE: 48" X 120"
 THICKNESS: 1/2"
 NOTE: INSTALL USING ADHESIVE ONLY

FINISH PLAN LEGEND



- FLOORING MATERIAL LEGEND**
- | TYPE | DESCRIPTION |
|-------|--|
| QVT-1 | 24" X 24" UPOFLOOR QUARTZ VINYL TILE. SEE SPECIFICATIONS AND FINISH LEGEND FOR TYPE. |
| QVT-2 | 24" X 24" UPOFLOOR QUARTZ VINYL TILE. SEE SPECIFICATIONS AND FINISH LEGEND FOR TYPE. |
| QVT-3 | 24" X 24" UPOFLOOR QUARTZ VINYL TILE. SEE SPECIFICATIONS AND FINISH LEGEND FOR TYPE. |
| EXIST | EXISTING FLOOR TO REMAIN. |

FINISH GENERAL NOTES

- SCHEDULED MATERIALS AND FINISHES SHALL NOT BE ORDERED OR INSTALLED BEFORE THE CONTRACTOR'S PHYSICAL SAMPLE SUBMITTALS HAVE BEEN APPROVED AS CALLED FOR IN THE SPECIFICATIONS.
- FLOORING CONTRACTOR TO PROVIDE APPROPRIATE VINYL TRANSITIONS AND REDUCERS BETWEEN VARYING FLOORING MATERIALS.
- FLOOR FINISH TRANSITIONS SHALL BE CENTERED BELOW DOORS IN THE CLOSED POSITION, UNLESS NOTED OTHERWISE.
- CONCRETE SLAB TO REMAIN PROTECTED AND COVERED. REFER TO SPECIFICATIONS.
- DOORS TO BE MASONITE. MATCH EXISTING.
- HOLLOW METAL FRAMES TO BE PAINTED P-2, UNLESS NOTED OTHERWISE.
- CASEWORK TO BE PL-1, UNLESS NOTED OTHERWISE.
- COUNTERTOPS TO BE SS-1, UNLESS NOTED OTHERWISE.

FINISH PLAN NOTES


- | TAG | DESCRIPTION |
|-----|---|
| 1 | INFILL FINISH FLOOR TO MATCH EXISTING WHERE EXISTING FLOOR IS DAMAGED BY WORK. REPAIR PATCH WALL SURFACES TO RECEIVE PAINT ALL EXPOSED WALL SURFACES AT CONCLUSION OF WORK. INSTALL BASE TO MATCH EXISTING AT CONCLUSION OF WORK. |

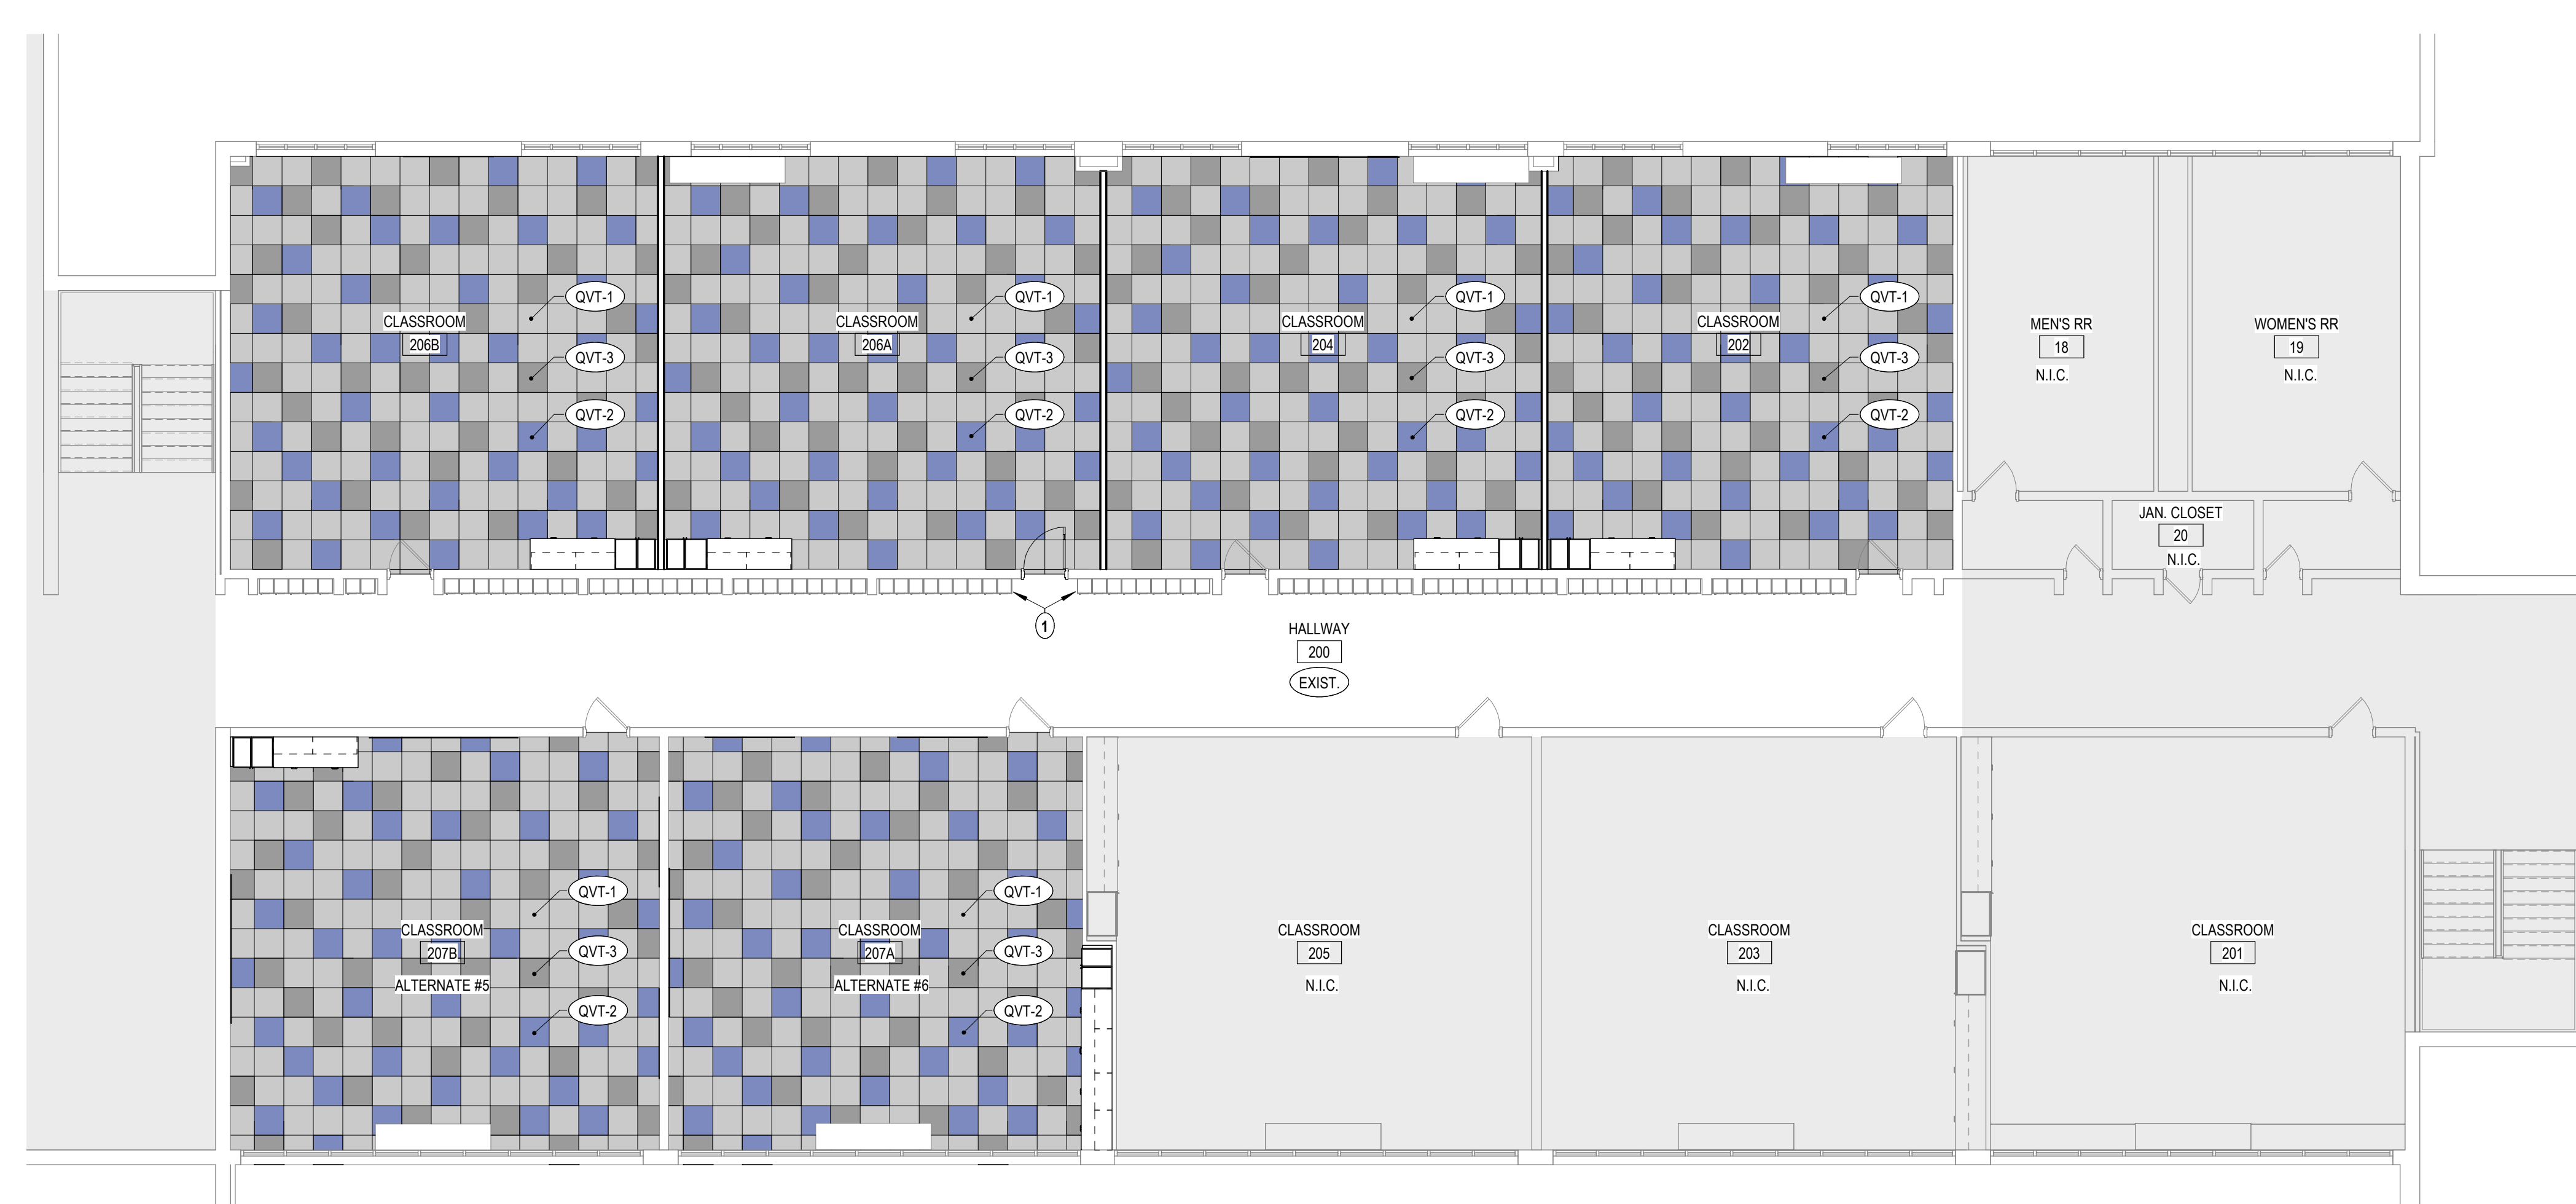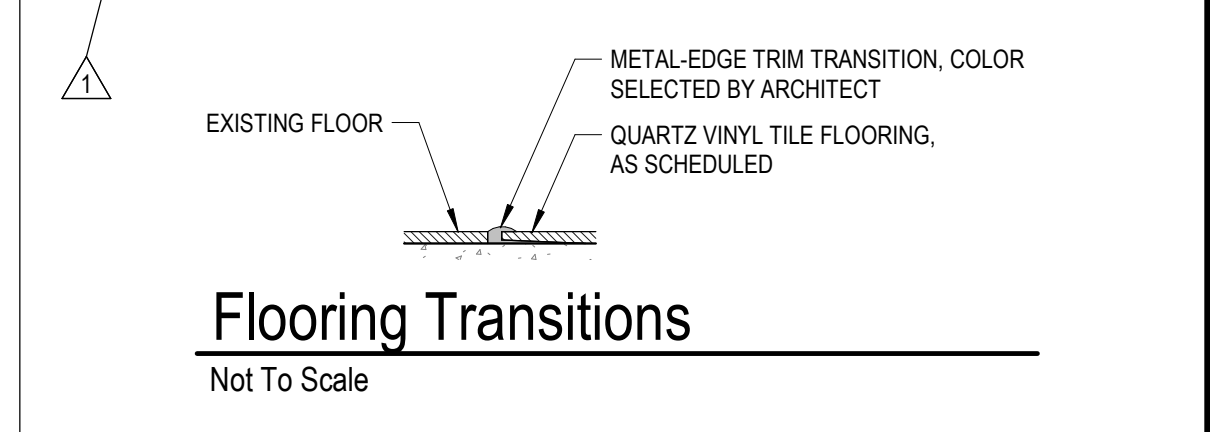

PLAN NORTH
1 Second Floor Finishes Plan
 1/8" = 1'-0"






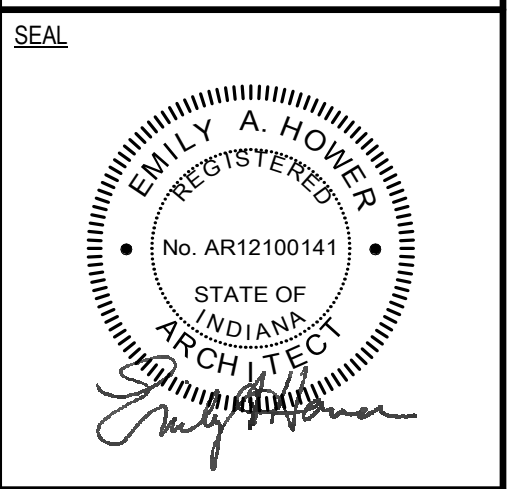

EAACS Woodlan High School Classroom Renovation
 17215 Woodburn Rd., Woodburn, IN 46797

REVISIONS		
NO.	DESCRIPTION	DATE
1	ADDENDUM #02	12-18-2024

PROJECT NO. 2401110 ISSUE DATE November 27, 2024
 SUBMITTAL Issue for Bids, Permits, and Construction
 Finishes Plan - Second Floor

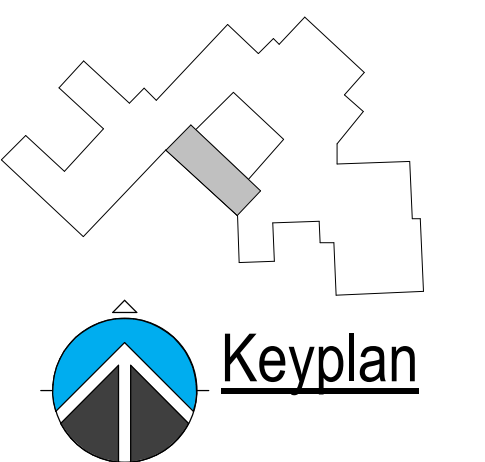

GENERAL DEMOLITION NOTES

- ALL EXISTING PENETRATIONS FROM DUCT PIPE WIRE/ CONDUIT THAT IS REMOVED SHALL BE PATCHED BY PROPER TRADES TO MATCH SURROUNDINGS UNLESS PENETRATION IS TO BE REUSED. PATCH ALL FLOOR AND WALL PENETRATIONS TO MAINTAIN FIRE RATED CONSTRUCTION.
- ALL ROOF PENETRATIONS NOT BEING REUSED SHALL BE PATCHED TO MAINTAIN EXISTING ROOF WARRANTY. EXISTING CURBS TO BE ABANDONED SHALL BE CAPPED WITH ALUMINUM HOOD PAINTED WITH "N.I.S." (NOT IN SERVICE). INSULATE CAVITY BELOW CAP WITH TIGHT FITTING 2" FOAM BOARD WRAPPED WITH SHEET METAL.
- ALL PIPE SHALL BE REMOVED TO WITHIN AREAS THAT ARE INACCESSIBLE SUCH AS WALL CAVITIES AND BELOW SLAB. IN FINISHED SPACES REMOVE BELOW SURFACE, CAP WATER TIGHT, AND PATCH SURFACE TO MATCH SURROUNDINGS.
- ALL PATCHING OF WALLS SHALL MATCH MATERIALS AND WHEN COMPLETE SHALL NOT LOOK LIKE A PATCH.
- TOOTH-IN NEW BRICK/ BLOCK WITH FULL UNITS. DO NOT CUT FILLER PIECES.
- PRIOR TO CUTTING EXISTING SLAB ON GRADE, CONTRACTOR SHALL VERIFY EXISTENCE OF EXISTING UTILITIES SUCH AS PIPING, CONDUIT, WIRE, ETC. BY MEANS OF GROUND PENETRATING RADAR TO LOCATE AND DETERMINE DEPTH OF BURY. TAKE PRECAUTIONS TO DEENERGIZE POWER TO CIRCUITS AND CAREFULLY CUT AND REMOVE SLAB. ANY UTILITIES THAT WERE LOCATED AND SUBSEQUENTLY DAMAGED SHALL BE REPAIRED BY THE CONTRACTOR AT NO ADDED COST TO THE OWNER.

GENERAL MECHANICAL NOTES

- DUCT AND PIPING LAYOUTS ARE SCHEMATIC IN NATURE. ADDITIONAL TRANSITIONS, ELBOWS, OFFSETS, AND FITTINGS SHALL BE ADDED AS REQUIRED TO COORDINATE WITH OBSTRUCTIONS AND OTHER TRADES.
- COORDINATE ALL WORK WITH OTHERS TRADES AND EXISTING WORK TO PERMIT ACCESS AND SERVICE CLEARANCES TO ALL SYSTEMS. COORDINATE DUCT WITH ELECTRICAL J-BOXES TO PREVENT OBSTRUCTIONS.
- DO NOT SCALE DRAWINGS FOR DIMENSIONS. REFER TO DIMENSIONED DRAWINGS.
- ALL GRILLES, DIFFUSERS, AND REGISTERS SHALL HAVE A VOLUME CONTROL DAMPER UNLESS NOTED OTHERWISE. DAMPER SHALL BE IN AN ACCESSIBLE LOCATION.
- REFER TO DETAIL SHEETS FOR ADDITIONAL INFORMATION ON INSTALLATION METHODS.
- DEVIATIONS FROM BASIS OF DESIGN THAT AFFECT OTHER TRADES ARE THE RESPONSIBILITY OF THIS CONTRACTOR. ADDITIONAL COSTS TO PROVIDE LARGER ELECTRICAL CIRCUITS, MORE FLOOR SPACE, ADDITIONAL SUPPORTS, ADDITIONAL MATERIALS, ETC. SHALL BE BORNE BY THIS CONTRACTOR. COORDINATE WITH OTHER TRADES.
- ALL THERMOSTATS/HUMIDITY SENSORS WITH ADJUSTMENT BUTTONS/ SLIDERS/ KNOBS/ DISPLAYS, ETC. SHALL BE MOUNTED WITH THE TOP OF THE DEVICE NO MORE THAN 48 AFF. IN COMPLIANCE WITH LOCAL AND FEDERAL ADA WHEELCHAIR REACH DISTANCE GUIDELINES. PROVIDE ADDITIONAL SURFACE RACEWAY, BOXES, CONDUIT, ETC AS REQUIRED TO OFFSET AROUND EXISTING DEVICES IN RENOVATION WORK.
- ALL DUCT SIZES LISTED ARE FOR INTERIOR FREE AREA. ANY DUCTS DESIGNATED OR SPECIFIED TO BE DOUBLE WALL OR INTERNALLY LINED SHALL HAVE OUTER DIMENSIONS ENLARGED TO ACCOMMODATE THE LINER OR INTERSTITIAL INSULATION.

MECHANICAL SYMBOL SCHEDULE

PIPING SYMBOLS			MECHANICAL LINE TYPES		
	AUTOMATIC FLOW CONTROL VALVE			EXISTING DUCT TO REMAIN	
	AIR SEPARATOR			NEW SUPPLY DUCT	
	AUTOMATIC AIR VENT			NEW RETURN DUCT	
	BALL VALVE			NEW OUTSIDE AIR DUCT	
	BUTTERFLY VALVE			DUCT TO BE REMOVED	
	CHECK VALVE			LOW WATER SUPPLY PIPE	
	DOUBLE CHECK BACKFLOW PREVENTER			HOT WATER RETURN PIPE	
	FLOW METER			CHILLED WATER SUPPLY PIPE	
	FLUSH VALVE			CHILLED WATER RETURN PIPE	
	GAS OUTLET TURRET			GLYCOL PIPE	
	GAS COOK			LOW PRESSURE STEAM SUPPLY	
	GATE VALVE			LOW PRESSURE STEAM RETURN	
	GLOBE VALVE			HIGH PRESSURE STEAM RETURN	
	HOSE THREAD END WITH CAP			HIGH PRESSURE STEAM SUPPLY	
	IN-LINE PIPE DROP			STEAM CONDENSATE	
	IN-LINE PIPE RISE			CONDENSER WATER SUPPLY	
	MANUAL FLOW CONTROL VALVE			CONDENSER WATER RETURN	
	MANUAL AIR VENT				
	METER				

MECHANICAL SYMBOLS			GENERAL LINE TYPES		
	BACKDRAFT DAMPER		EXISTING TO REMAIN LINE WEIGHT		
	COMBINATION SMOKE/FIRE DAMPER			EXISTING TO BE DEMOLISHED LINE TYPE AND WEIGHT	
	CONTROL DAMPER ACTUATOR			NEW DUCT LINE WEIGHT	
	DOUBLE WALL DUCTWORK			NEW PIPING LINE WEIGHT	
	DUCT CAP			NEW EQUIPMENT LINE WEIGHT	
	DUCT MOUNTED COIL				
	DUCTWORK WITH DUCT LINER				
	DUCTWORK WITHOUT DUCT LINER				
	FAN POWERED VAV BOX WITH REHEAT				
	FIRE DAMPER				

GENERAL SYMBOLS			MECHANICAL CONTROL SYMBOLS		
	EXTENT OF DEMOLITION			THERMOSTAT	
	TIE-IN OF NEW TO EXISTING			THERMOSTAT (LINE VOLTAGE)	
				THERMOSTAT WITH HUMIDISTAT AND CO2 SENSOR	
				HUMIDISTAT	
				DIFFERENTIAL PRESSURE SENSOR	

HORIZONTAL UNIT VENTILATOR SCHEDULE

TAG	MFR.	MODEL	STYLE	HW/CHW CONNECTION	SERVICE	COOLING		HEATING COIL		CONTROL VALVE	EAT (DEG F)	LAT (DEG F)	EWT/LWT (DEG F)	FLOW (GPM)	WPD (FT)	ROWS	CONTROL VALVE	ELEC V (VPH)	ELEC MCA	ELEC IBC	FILTER TYPE	REMARKS									
						AIRFLOW (CFM)	MIN O.A. (CFM)	FAN SPEED (RPM)	ESP (IN. W.C.)														TOTAL CAP. (MBH)	SENS. CAP. (MBH)	EDB/EBW (DEG F)	LAT (DEG F)	EWT/LWT (DEG F)	FLOW (GPM)	WPD (FT)	ROWS	CONTROL VALVE
LV-1	TRANE	VUVE 1251	VERTICAL	LEFT/RIGHT	CLASSROOM 208A	1250	450	HIGH	0.25	0	43.7	30.9	80.7 / 67.3 / 59.5 / 57.0	45 / 95	8.60	4.8	4	3-WAY	91.0	48.0	104	180 / 180	610	262	2-WAY	120/1	9	15	3	MERV 11	1, 2, 3, 4, 5

REMARKS:





- PROVIDE AND INSTALL WITH FACTORY WIRED ELECTRICAL DISCONNECT AT UNIT WIRING CONTROL BOX.
- SUPPLY FAN SHALL BE ECM WITH ON BOARD SPEED CONTROL KNOB.
- ACCESS DOORS SHALL HAVE ALLEN SCREW WITH INTEGRAL DOOR POWER KILL SWITCH.
- ARCHITECT SHALL SELECT FROM STANDARD COLORS TO MATCH EXISTING.
- PROVIDE WITH 12" EXTENDED PIPING COMPARTMENTS ON BOTH LEFT AND RIGHT SIDE.
- PROVIDE WITH TRANE CONTROLS WITH BACNET INTERFACE TO EXISTING BMS. INCLUDE REMOTE WALL SENSOR, PROGRAMMING, GRAPHICS, WIRING, ETC.

DIFFUSER AND GRILLE SCHEDULE

TAG	MFR.	MODEL	NECK SIZE (IN)	FACE SIZE (IN)	THROW PATTERN	MAX CFM	MAX APD (IN)	THRO (FT)	MAX IBC	MATERIAL	REMARKS
TG-1	TITUS	45F	4	22x22	45 DEG EGG	1600	0.10	9	37	ALUMINUM	1, 2

REMARKS:

- COLOR SHALL BE WHITE.
- PROVIDE AND INSTALL WITH FRAME FOR LAY-IN INSTALLATION.

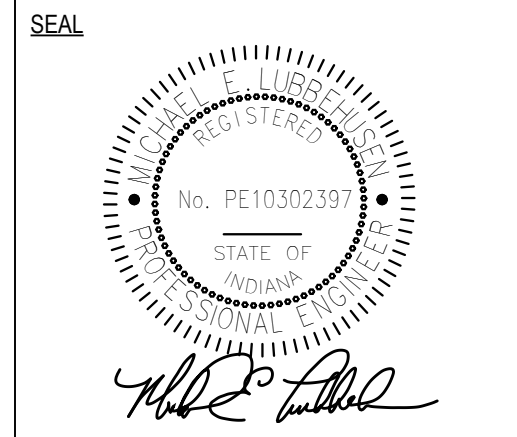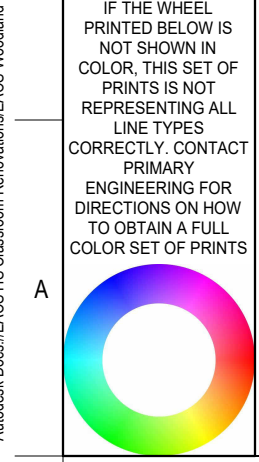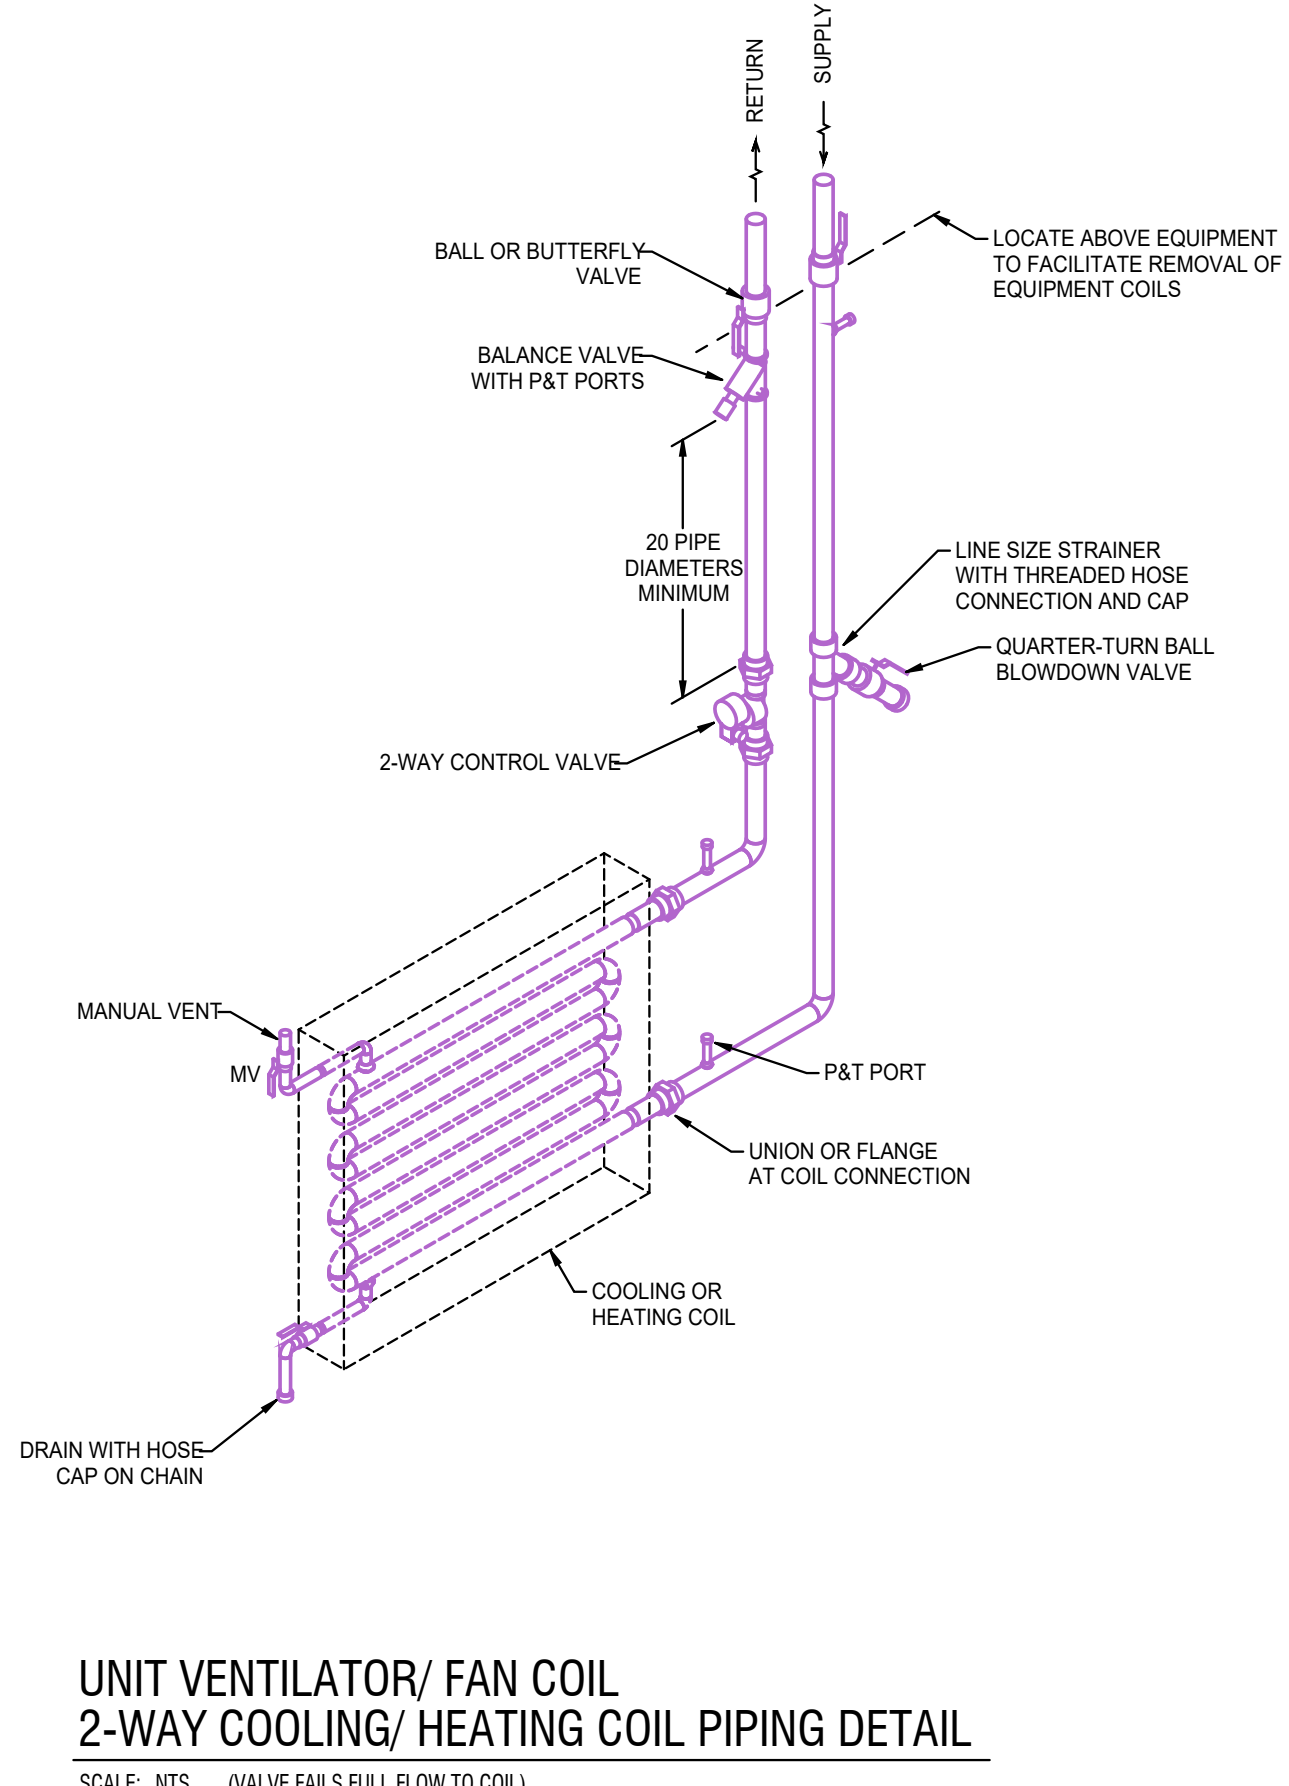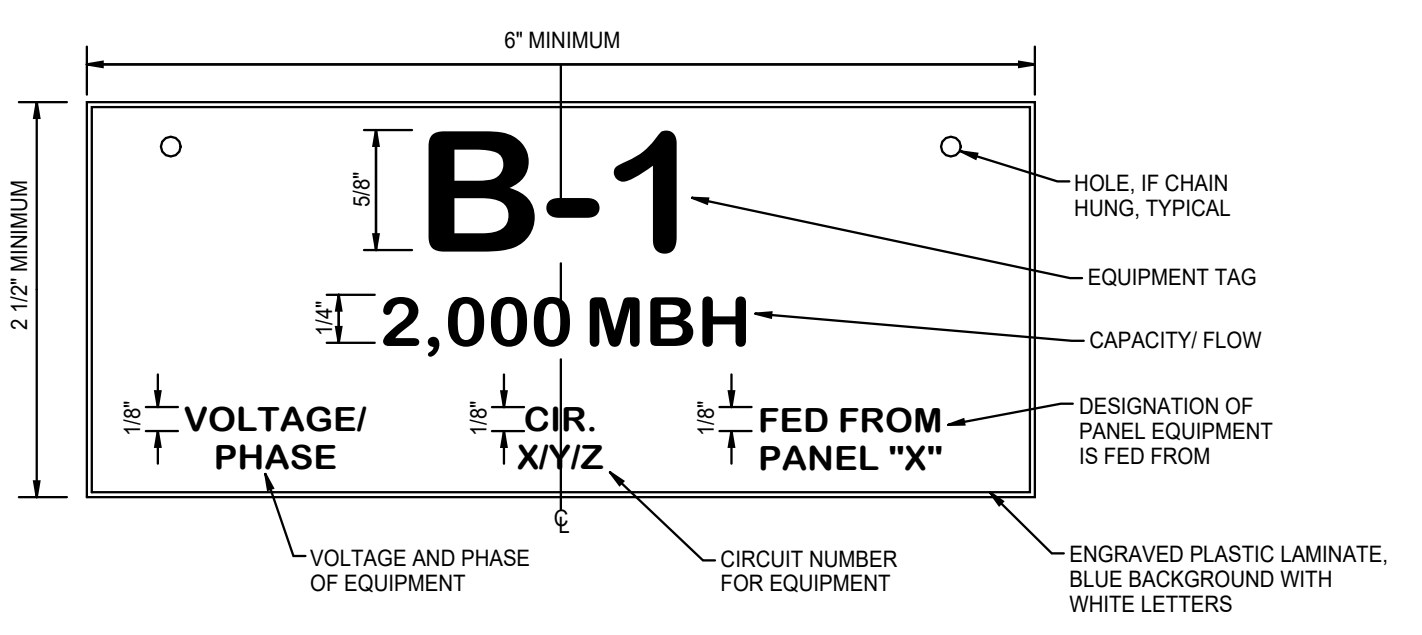

EACS
EACS Woodlan High School Classroom Renovation
 17215 Woodburn Rd., Woodburn, IN 46797

REVISIONS		
NO.	DESCRIPTION	DATE
1	ADDENDUM #2	12/18/24

PROJECT NO: 240110 ISSUE DATE: November 27, 2024
 SUBMITTAL Issue for Bids, Permits, and Construction

MECHANICAL INFORMATION SHEET

M001

Primary_C08 8/28/23 P01.13




- DEMOLITION PLAN NOTES**
- EXISTING HORIZONTAL UNIT VENT SHALL REMAIN. PROTECT DURING CONSTRUCTION FROM DEBRIS FALLING IN TOP OPENING WITH PLYWOOD.
 - EXISTING WALL SENSOR TO REMAIN. PROTECT DURING CONSTRUCTION.
 - REMOVE CONTROL FROM WALL SENSOR TO UNIT VENT AND PREPARE FOR REPROGRAMMING.
 - CAREFULLY REMOVE UNIT VENTILATOR COMPLETE AND TURN OVER TO OWNER FOR SALVAGE. DISCONNECT ASSOCIATED HW CHW PIPES IN CONCEALED LOCATION AND CAP. FILL ALL PENETRATIONS WITH GROUT. DISCONNECT AND SALVAGE CONTROLS. FILL OUTSIDE AIR LOUVER SLEEVE WITH ALUMINUM METAL AND SEAL PENETRATION AIR/WATER TIGHT.
 - REMOVE EXISTING UNIT VENT COMPLETE ANDS PREPARE FOR NEW UNIT IN SAME LOCATION. REMOVE EXISTING WALL SENSOR AND SAVE FOR REUSE IN NEW LOCATION.
 - REMOVE EXISTING TRANSFER GRILLE COMPLETE INCLUDING ALL ASSOCIATED HANGING DEVICES.

- PLAN NOTES**
- INSTALL NEW UNIT VENT AND TIE-IN TO EXISTING O.A. INTAKE LOUVER. SEAL UNIT TO WALL WITH GASKET TAPE. EXTEND HW CHW PIPING AND CONNECT TO UNIT IN EXTENDED PIPE COMPARTMENTS. MODIFY EXISTING PIPE CHASE ON WALL AS NEEDED.
 - INSTALL SALVAGED WALL SENSOR AND PROVIDE NEW WIRING/ PROGRAMMING TO EXISTING UNIT VENT.
 - ROUTE/ EXTEND CONTROL WIRING FROM EXISTING WALL SENSOR TO EXISTING UNIT VENT.
 - INSTALL NEW OPENING ABOVE CEILING MINIMUM 2" ABOVE CEILING.

PLAN NORTH
Second Floor Mechanical Demolition Plan
 1/8" = 1'-0"


PLAN NORTH
Second Floor Mechanical Plan
 1/8" = 1'-0"

IF THE SHEET PRINTED BELOW IS NOT SHOWN IN COLOR, THIS SET OF PRINTS DOES NOT REPRESENT ALL LINE TYPES. CORRECTLY CONTACT PRIMARY ENGINEERING FOR INSTRUCTIONS ON HOW TO OBTAIN A FULL-COLOR SET OF PRINTS.

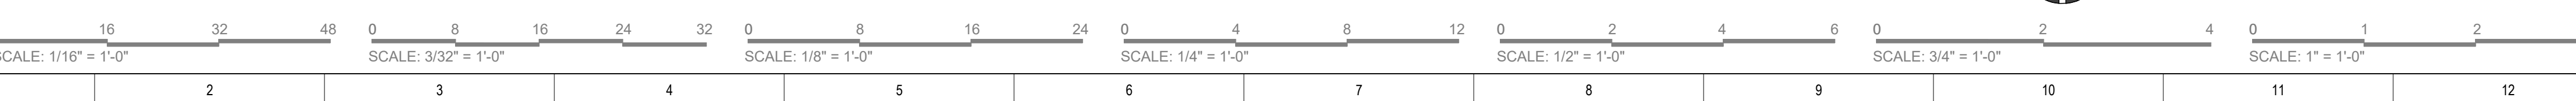

PRIMARY ENGINEERING INC
 Fort Wayne Indianapolis

All concepts, ideas, plans, and details as shown on this document are the sole property of Primary Engineering, Inc. and shall not be used for any other purposes without their expressed written consent. The project owner shall be permitted to retain copies for information and reference purposes.
 2024 © Primary Engineering, Inc.

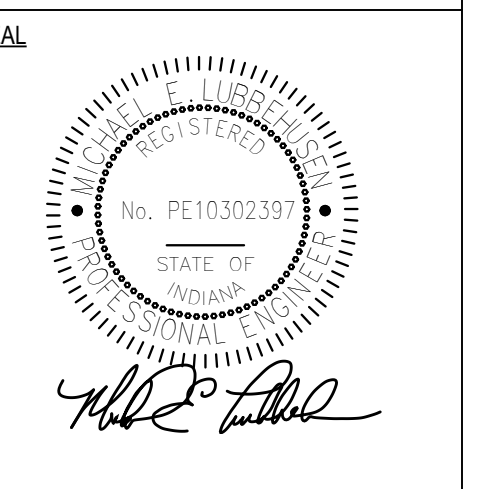


EACS
EACS Woodlan High School Classroom Renovation
 17215 Woodburn Rd.
 Woodburn, IN 46797

REVISIONS		
NO.	DESCRIPTION	DATE
1	ADDENDUM #2	12/18/24

PROJECT NO. 2401110
 SUBMITTAL Issue for Bids, Permits, and Construction



ISSUE DATE November 27, 2024
SECOND FLOOR MECHANICAL PLAN

M101

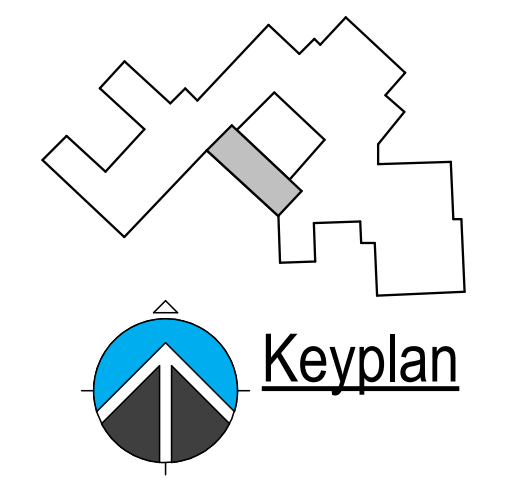



- PLAN NOTES**
1. PROVIDE AND INSTALL NEW LIGHT FIXTURES. EXTEND EXISTING BRANCH CIRCUIT AS REQUIRED TO CONNECT NEW LIGHTING AND LIGHTING CONTROL DEVICES IN THIS AREA. TYPICAL OF ALL FIXTURES AND CONTROLS IN THIS ROOM.
 2. PROVIDE AND INSTALL 0-10V DIMMING CONTROL CABLING WITH EXISTING BRANCH CIRCUIT FROM DIMMER SWITCH TO LIGHT FIXTURES IN THIS ROOM.
 3. PROVIDE AND INSTALL 0-10V DIMMER SWITCHES IN EXISTING DEVICE BOX. EXTEND EXISTING BRANCH CIRCUIT, AS REQUIRED, TO CONNECT TO NEW DIMMER SWITCHES. PROVIDE AND INSTALL NEUTRAL CONDUCTOR, AS REQUIRED, TO ALL FOR INSTALLATION OF DIMMER SWITCHES.
 4. PROVIDE AND INSTALL NEW SWITCH IN EXISTING DEVICE BOX. EXTEND EXISTING BRANCH CIRCUIT, AS REQUIRED, TO CONNECT TO NEW SWITCH. PROVIDE AND INSTALL NEUTRAL, AS REQUIRED.
 5. CONNECT TO ALL EMERGENCY LIGHT FIXTURES TO EXISTING LIGHTING CIRCUIT SERVING AREA AHEAD OF ANY SWITCHES, SENSORS AND RELAYS.

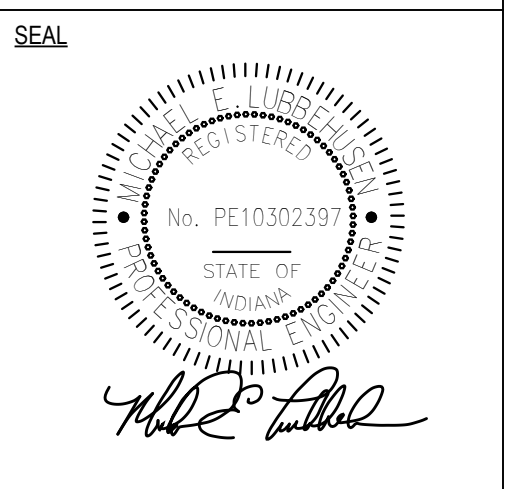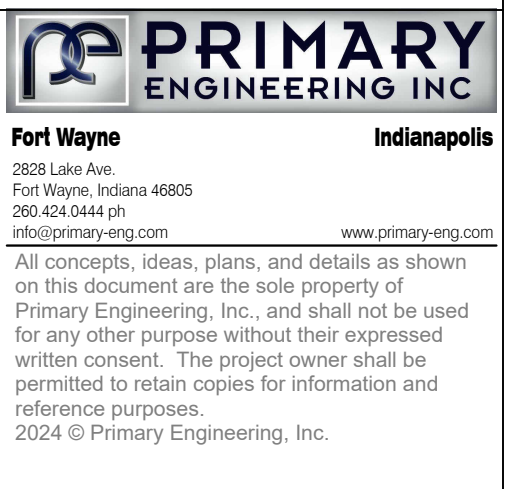

EACS East Allen County Schools
 HS Classroom Renovations
 14800 Amstutz Rd.
 Leo, IN 46765

REVISIONS		
NO.	DESCRIPTION	DATE
1	ADDENDUM #2	12/18/24


PROJECT NO. 2401110
 SUBMITTAL
 Issue for Bids, Permits, and Construction

ISSUE DATE November 27, 2024

LIGHTING PLAN

E-301

IF THE SHEET IS PRINTED BELOW IS NOT SHOWN IN COLOR, THIS SET OF PRINTS DOES NOT REPRESENT ALL THE TYPES. CORRECTLY CONTACT PRIMARY ENGINEERING FOR DIRECTIONS ON HOW TO OBTAIN A FULL COLOR SET OF PRINTS.

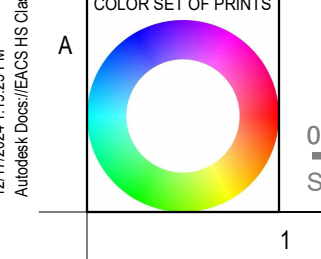

PLAN NORTH
FIRST FLOOR LIGHTING PLAN
 1/8" = 1'-0"

