

ADDENDUM NO. 2

To the Contract Document and Project Specifications for the

Wayne High School Baseball Field
Fort Wayne Community Schools (FWCS)
Fort Wayne, Indiana
March 6, 2025

To: All holders of the contract documents for the above project.

The items in this addendum are to become a part of the original documents as if included therein. The remainder of the original contract document is to remain in its entirety. This Addendum modifies the Contract Documents and Specifications as follows:

- Part 1 – General Clarifications
- Part 2 – Specifications
- Part 3 – Construction Drawings/Details
- Part 4 – Questions

PART 1 – GENERAL CLARIFICATIONS

1. This addendum includes plan and specifications updates listed below

PART 2 – SPECIFICATIONS (Replace - See Attached)

1. Section 000132 – “Fort Wayne Community Schools **supports participation of minority owned businesses** as a goal and encourages bidders to solicit bids from MBE, WBE and EBE contractors.” has been added as a language in this section.

SECTION 000132 – EBE/MBE/WBE INFORMATION

Following is a list of the Emerging Business Enterprise owners, Women’s Business Enterprise owners, and Minority Business Enterprise owners currently certified by the City of Fort Wayne. Fort Wayne Community Schools sets 10% participation as a goal and encourages bidders to solicit bids from MBE, WBE and EBE contractors. There is no requirement or quota for MBE, WBE and EBE participation on this project. We are encouraging participation to the extent possible. Bidders are requested to submit the names of the firms which they have contacted on the Bid Form provided in these specifications.

Fort Wayne Community Schools supports participation of minority owned businesses as a goal and encourages bidders to solicit bids from MBE, WBE and EBE contractors.]


END OF SECTION

2. Section 073113-6
 - a. Replace section 2.2.A. “Three-Tag-Strip Shingles” with “Laminated-Strip Asphalt Shingles.”
 - b. Remove section 2.1.C. “Energy Performance, ENERGY STAR.”
 - c. Add section 3.3 “EXTRA METERIALS.”
3. Section 076200-10


- a. Section 2.5.A.1.b and 2.5.A.1.c – updated material thicknesses to 0.034 inches thick.
- 4. Section 077100-8
 - a. Section 2.2.A.2. Metallic-Coated Steel Sheet Fascia Covers – “nominal 0.034-inch thickness” has been added to material description.
 - b. Section 2.2.A.3. Formed Aluminum Sheet Fascia Covers – “nominal 0.050-inch thickness” has been added to material description.
 - c. Section 2.3.B.2. “Aluminum Sheet” – Aluminum gutter thickness is to be 0.032”. Strike other values.

PART 3 – CONSTRUCTION DRAWING / DETAILS (Replace - See Attached)


- 1. C201 – 4’ padded guardrail with mesh screening in front of dugouts has been reduced in length to allow 3’ of space to enter on both sides of the fence.

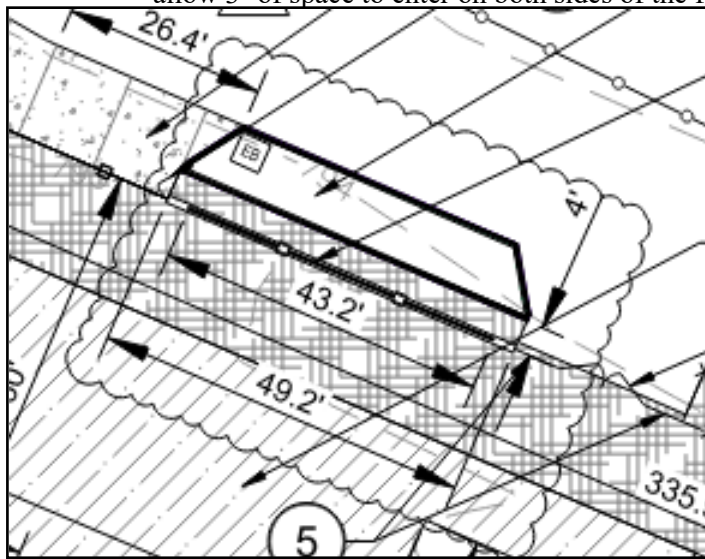


- 2. C201 – Dimensions for proposed warning track has been added to improve clarity

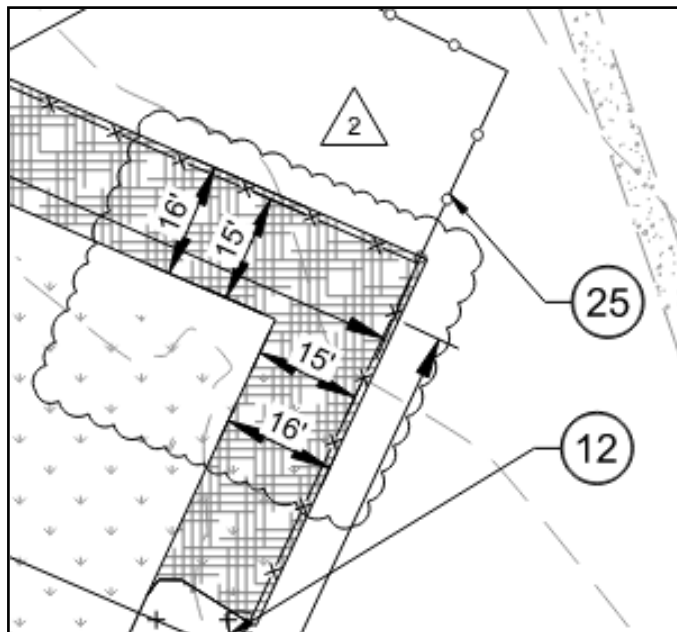


3. C301 – Spot elevations around equipment shed and field material corral have been added to improve clarity.

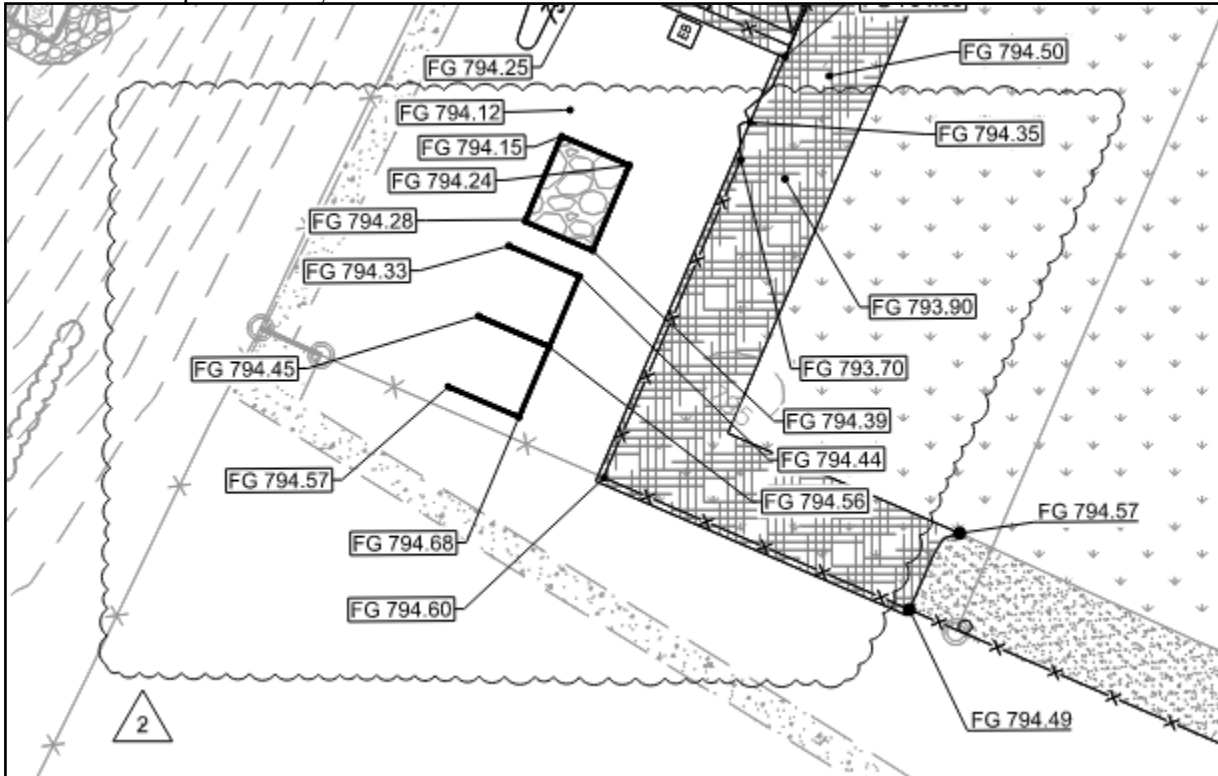


4. SD102 – Detail 1 on sheet SD102 has been updated to show smooth tile red PEXCO safety top cap instead of corrugated tile

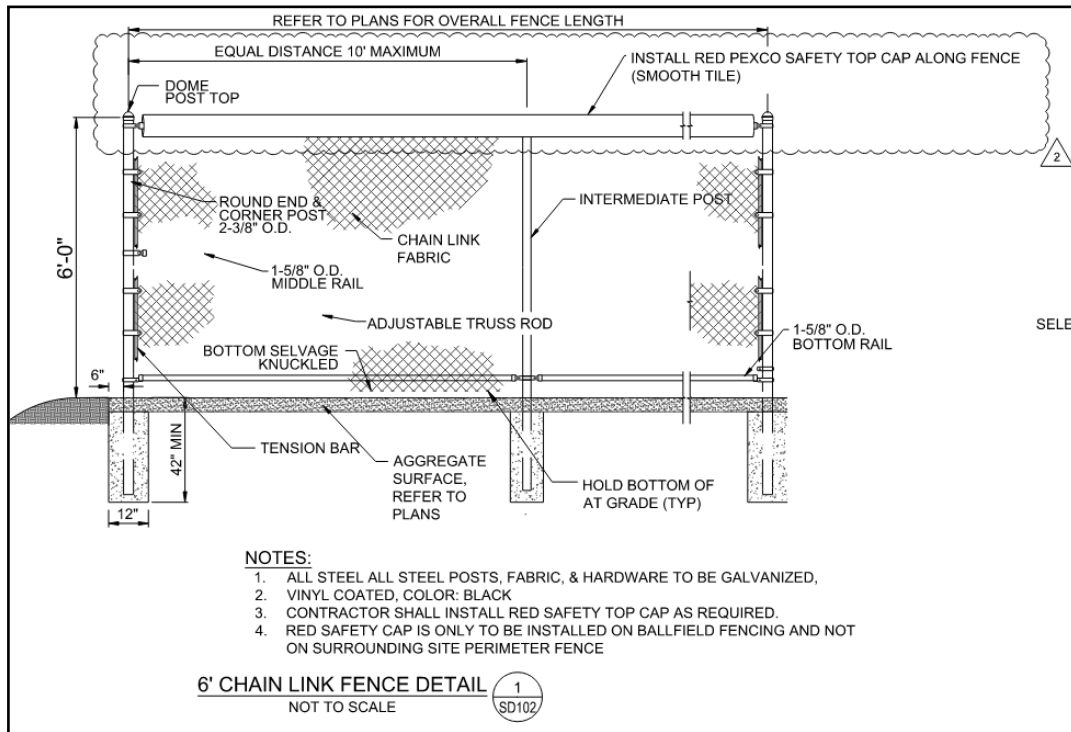

5. SD102 – Detail 6 on sheet SD102 has been updated to show the direct embed foundation as mentioned in Part 4.

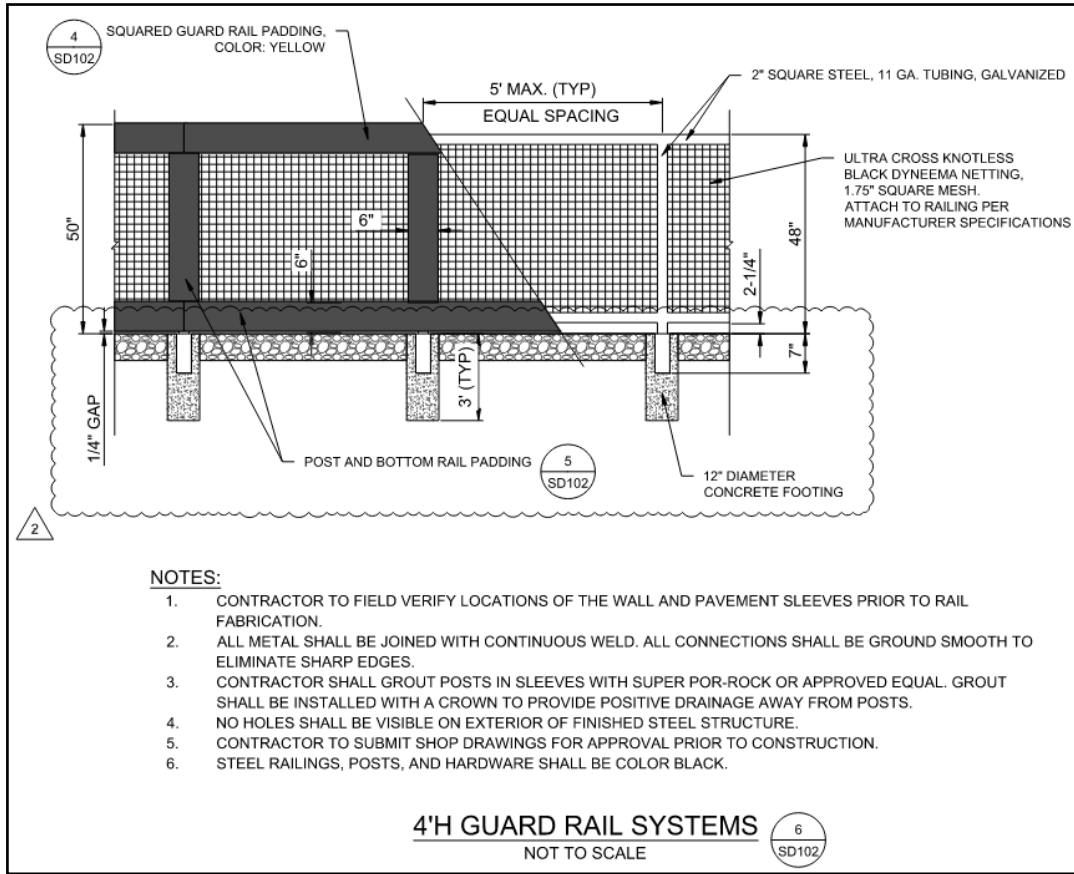

6. SD103 – Detail 6 on sheet SD103 has been added to specify the flag pole and installation

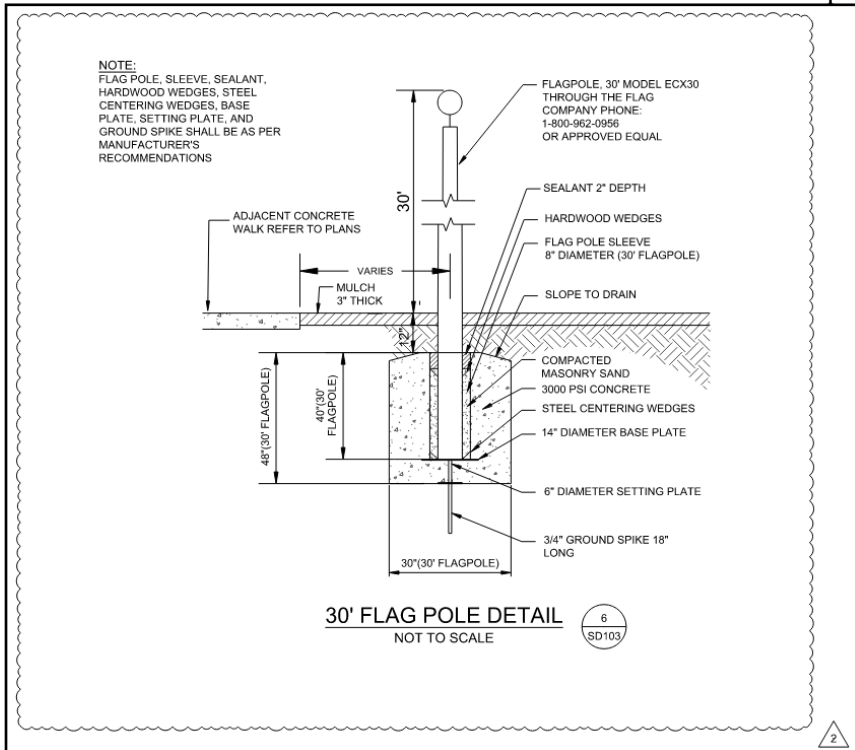

PART 4 – QUESTIONS

1. We are having a hard time finding the red corrugated fence topper?
Please utilize the PEXCO smooth red safety cap
2. Should the dugout fence/railing system be surface mount or direct embed?
The dugout fence/railing should be directly embedded.
3. What is quoted is a three tab Certainteed shingle with an Energy Star rating. To get the Energy Star, it would have to be a Certainteed Landmark Solaris shingle. – is this acceptable?
Shingles are to be of Dimensional/Laminated type using the Basis-of-Design as provided on the drawings. No ENERGY STAR rating is required. The specs incorrectly list a Three-Tab shingle with an ENERGY STAR performance requirement.
4. The Warranty for the shingles would be a 40 year, 20 year non prorated material and labor, 110 mph wind warranty and a 10 year algae warranty. – Is this acceptable?
See Item #1. Warranty will change with product change.
5. What is the thickness of prefinished aluminum required for the gutter? The spec lists all thicknesses
Aluminum gutter thickness is to be 0.032". Spec section 077100-8 has been updated.
6. Is the fascia wrap and drip edge/rake edge to be .050 prefinished aluminum
Yes, aluminum fascia wrap and drip edge/rake edge to be .050" prefinished. Spec section 077100-8 has been updated.

J:\Projects\2024 Projects\2024-01350 Wayne HS Baseball\14_Bidding\Addenda\Addendum 2\Addendum #2 -FWCS Wayne High School Baseball Field 2025-03-06.doc