

ADDENDUM NO. 2

PHM Science and Space Exploration Center

Penn-Harris-Madison School Corporation
Mishawaka, Indiana

Project No. 225001.00

Index of Contents

Addendum No. 2, 2 items, 1 page
Revised Drawing Sheets: A-601, AF11A, AF602, E-001, ED100, EL110, EP110, EF100, E-501, E-601, E-602, E-701, and E-702

August 21, 2025

I hereby certify that this Addendum was prepared by me or under my direct supervision and that I am a duly registered Architect/Engineer under the Laws of the State of Indiana.

FANNING/HOWEY ASSOCIATES, INC.
ARCHITECTS/ENGINEERS/CONSULTANTS



Paul A. Miller, License No. AR10800161
Expiration Date: 12/31/2025

TO: ALL BIDDERS OF RECORD

ADDENDUM NO. 2 to Drawings and Project Manual, dated June 30, 2025, for Penn-Harris-Madison School Corporation, 55900 Bittersweet Road, Mishawaka, Indiana 46545; as prepared by Fanning/Howey Associates, Inc., Indianapolis, Indiana.

This Addendum shall hereby be and become a part of the Contract Documents the same as if originally bound thereto.

The following clarifications, amendments, additions, revisions, changes, and modifications change the original Contract Documents only in the amount and to the extent hereinafter specified in this Addendum.

Each bidder shall acknowledge receipt of this Addendum in his proposal or bid.

NOTE: Bidders are responsible for becoming familiar with every item of this Addendum. (This includes miscellaneous items at the very end of this Addendum.)

RE: ALL BIDDERS

ITEM NO. 1. PROJECT MANUAL, SECTION 08 71 00 – DOOR HARDWARE







A. Article 3.05: Replace Door Hardware Group No. 18 as follows:

Hardware Group No. 18

For use on Door #(s):

101

Provide each OPENING with the following:

QTY		DESCRIPTION	CATALOG NUMBER		FINISH	MFR
<u>2</u>	<u>EA</u>	<u>CONT. HINGE</u>	<u>112XY</u>		<u>628</u>	<u>IVE</u>
<u>1</u>	<u>SET</u>	<u>DEADBOLT, 2-PT, ALD</u>	<u>MS1850S X 4085 HEADER BOLT</u>		<u>628</u>	<u>ADA</u>
<u>1</u>	<u>EA</u>	<u>MORTISE ADA CYL TURN, AR CAM</u>	<u>09-9XX NH 118 XB11-720(ADA) B502-292(AR CAM) X COLLAR AS REQ'</u>		<u>626</u>	<u>SCH</u>
2	EA	MORTISE CYL HOUSING (SFIC)	80-110 (W/ DISP CONST CORE)		626	SCH
<u>1</u>	<u>EA</u>	<u>MORTISE CYL HOUSING (SFIC), AR CAM</u>	<u>80-111 (W/ DISP CONST CORE)</u>		<u>626</u>	<u>SCH</u>
1 (2)	EA	PERMANENT CORE	MATCH EXISTING SYSTEM		626	MBS
<u>2</u>	<u>EA</u>	<u>DOOR PULL, 3/4" RND</u>	<u>8102HD 6" STD (MOUNT BELOW DEADBOLT)</u>		<u>630</u>	<u>IVE</u>
<u>2</u>	<u>EA</u>	<u>OH STOP</u>	<u>100S</u>		<u>630</u>	<u>GLY</u>

ITEM NO. 2. REVISED DRAWING SHEETS:

A. Drawing Sheets: A-601, AF11A, AF602, E-001, ED100, EL110, EP110, EF100, E-501, E-601, E-602, E-701, and E-702 have been revised, dated 8/21/25, and are included with and hereby made a part of this Addendum. These Drawings supersede the original documents.

END OF ADDENDUM

PHM Science and Space Exploration Center

55860 BITTERSWEET RD,
MISHAWAKA, IN 46545

PENN-HARRIS-MADISON
SCHOOL CORPORTATION




ARCHITECT

FANNING
HOWEY

317.848.0966 WWW.FHAI.COM
350 E NEW YORK ST #500, INDIANAPOLIS, IN 46204

CONSTRUCTION DOCUMENTS

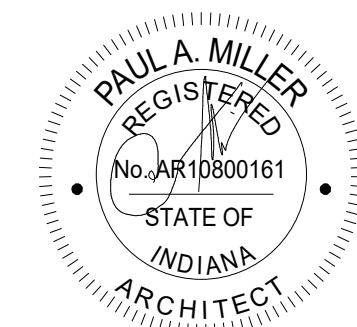

PROJECT MANAGER: MKS
DRAWN BY: AMS,BS,RLG
PROJECT NUMBER: 225001.00
PROJECT ISSUE DATE: 06.30.2025


REV. NO.	DESCRIPTION	DATE
2	ADDENDUM 2	08/??/2025

DOOR AND FRAME SCHEDULE

A-601

DOOR AND FRAME SCHEDULE														
DOOR MARK	DOORS			FRAME						FIRE RATING	HARDWARE		REMARKS	DOOR MARK
	DOOR SIZE (WxH)	DOOR TYPE	FRAME MATERIAL	FRAME ELEVATION	JAMB DEPTH	HEAD	DETAILS							
							JAMB	SILL						
100	PR 3'-0" x 7'-2"	FGAL2	AL	SF2	4 1/2"	H3	J6,J8,J9	S2,S5			14	EXT	ELECTRONIC ACCESS, REMOVEABLE MULLION	100
100A	PR 3'-0" x 7'-2"	FGAL2	AL	SF8	4 1/2"	H2	J2	S4		01	103			100A
101	PR 3'-0" x 7'-2"	FGAL	AL	SF7	4 1/2"	H8	J7,J8	S4		18	100			101
102	3'-0" x 7'-2"	F WD	HM	HM-3	8 3/8"	H5	J3	S6		05	103			102
103	3'-0" x 7'-2"	FWD	HM	HM-2	8"	H5	J3	S6		13	103		ELECTRONIC ACCESS	103
104	3'-0" x 7'-2"	F WD	HM	HM-1	5 3/4"	H5	J3			12	103		ELECTRONIC ACCESS	104
105	3'-0" x 7'-2"	F WD	HM	HM-1	5 3/4"	H5	J3			04	110			105
106	3'-0" x 7'-2"	F WD	HM	HM-1	5 3/4"	H5	J3			04	110			106
108	3'-0" x 7'-2"	F WD	HM	HM-1	5 3/4"	H5	J3			04	110			108
109	3'-0" x 7'-2"	F WD	HM	HM-1	5 3/4"	H5	J3			04	110			109
111A	3'-6" x 7'-2"	F WD	HM	-	5 3/4"	H4	-	-		02	111		SEE SPECS AND KEYNOTE 3 ON SHEET A-11A	111A
111B	3'-6" x 7'-2"	F WD	HM	-	5 3/4"	H4	-	-		02	111		SEE SPECS AND KEYNOTE 3 ON SHEET A-11A	111B
112	3'-0" x 7'-2"	F WD	HM	HM-1	5 3/4"	H5	J3			09	110			112
113	3'-0" x 7'-2"	F WD	HM	HM-1	5 3/4"	H5	J3			08	113			113
114	PR 3'-0" x 7'-2"	F FRP	AL	SF9	4 1/2"	H1	J1	S5		15	EXT		ELECTRONIC ACCESS, REMOVEABLE MULLION	114
115	3'-0" x 7'-2"	F HM	HM	HM-1	1'-0 3/4"	H7	J5			3-HR	16	115		115
115A	3'-0" x 7'-2"	F HM	HM	HM-1	1'-0 3/4"	H7	J5			3-HR	06	112		115A
115B	3'-0" x 7'-2"	F WD	HM	HM-1	8 3/8"	H5	J3	-		13	116		ELECTRONIC ACCESS	115B
116A	PR 2'-10" x 7'-2"	F HM	HM	HM-4	1'-0 3/4"	H6	J4			3-HR	17	EXT	ELEC WALL MAGS	116A
201A	3'-0" x 7'-0"	F HM	HM	HM-1	1'-0 3/4"	H7	J5			3-HR	07	201		201A
203	PR 3'-0" x 7'-2"	F HM	HM	HM-4	5 3/4"	H5	J3				03	201		203
204	PR 3'-0" x 7'-2"	F HM	HM	HM-4	5 3/4"	H5	J3				11	201		204

WOOD DOORS	FRP DOORS	ALUMINUM DOORS	OTHER
 F WD FLUSH DOOR	 F FRP FLUSH DOOR	 FGAL FULL GLASS	 DCGD DISPLAY CASE GLASS DOOR
 N WD NARROW LITE		 FGAL2 FULL GLASS 2	 F HM FLUSH DOOR (HOLLOW METAL 3-HR)
 FG2 WD FULL GLASS 2 WOOD			

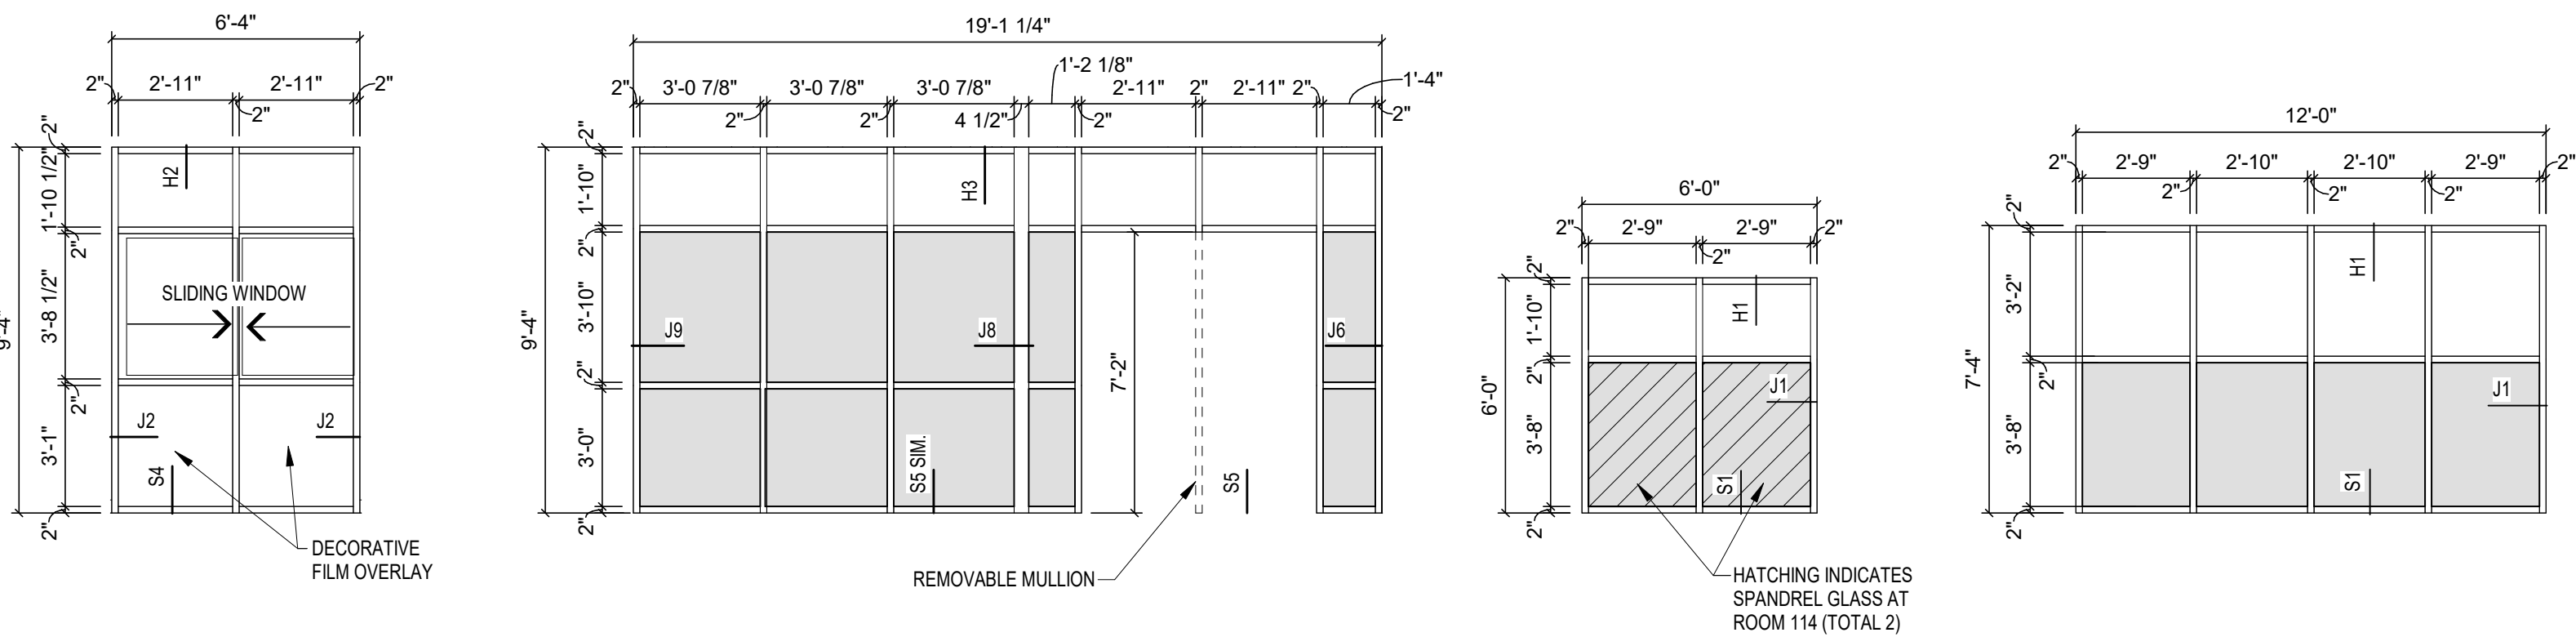

SF1

SCALE: 1/4" = 1'-0"

SF2


SCALE: 1/4" = 1'-0"

SF3

SCALE: 1/4" = 1'-0"

SF4

SCALE: 1/4" = 1'-0"

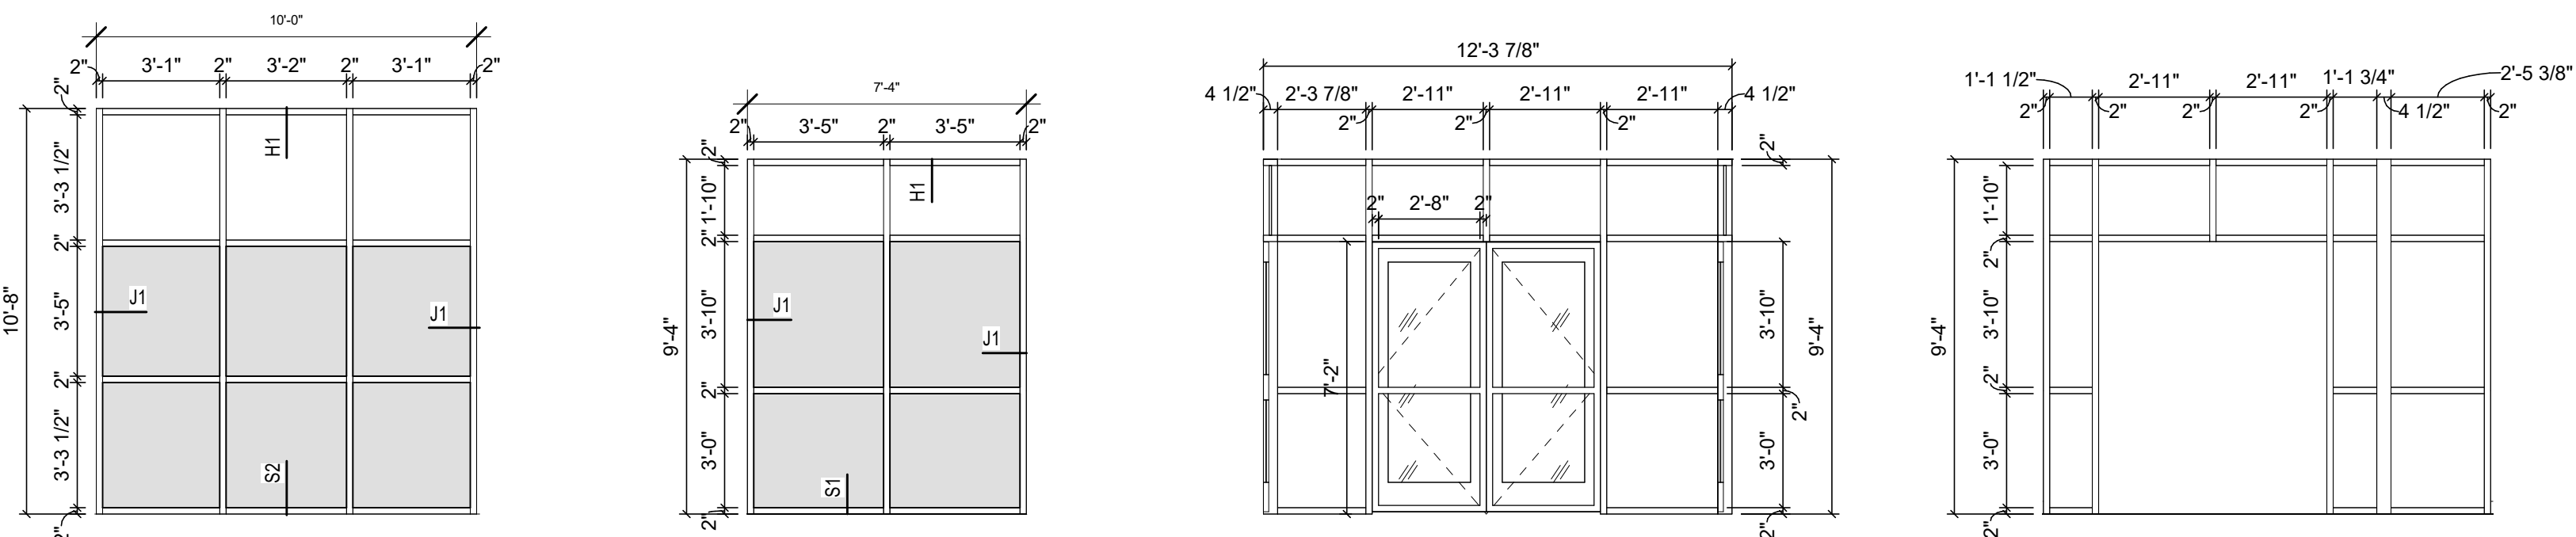

SF5

SCALE: 1/4" = 1'-0"

SF6


SCALE: 1/4" = 1'-0"

SF7

SCALE: 1/4" = 1'-0"


SF8

SCALE: 1/4" = 1'-0"

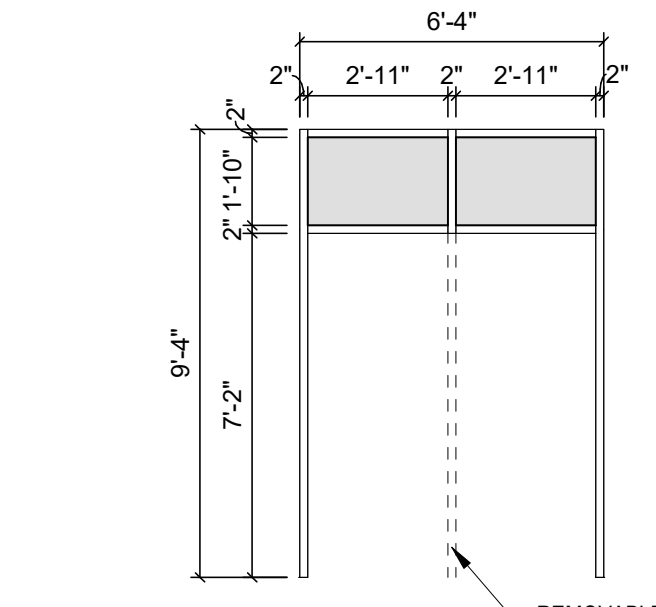


SF9

SCALE: 1/4" = 1'-0"

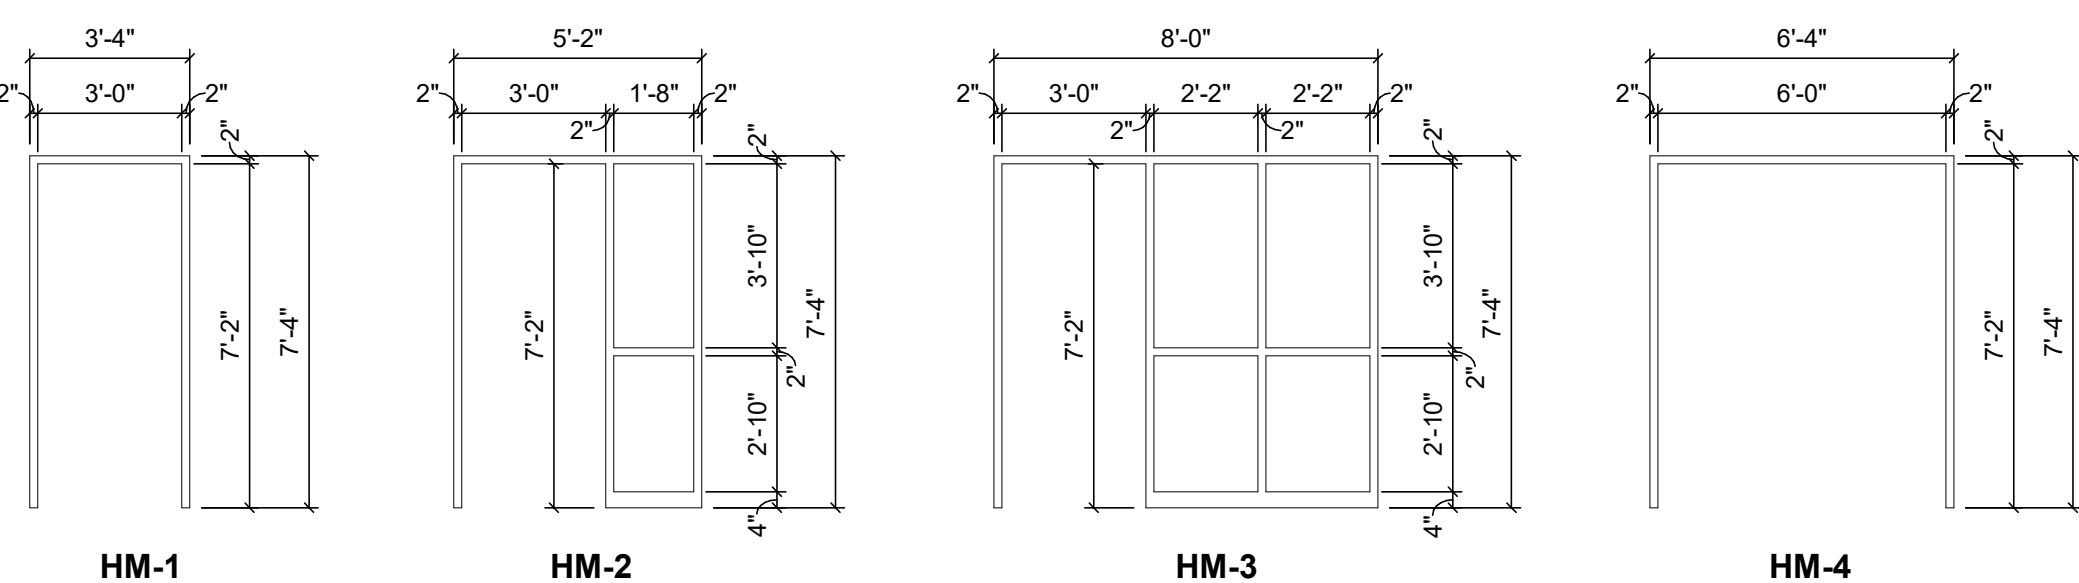


(HM) HOLLOW METAL FRAME ELEVATIONS

SCALE: 1/4" = 1'-0"

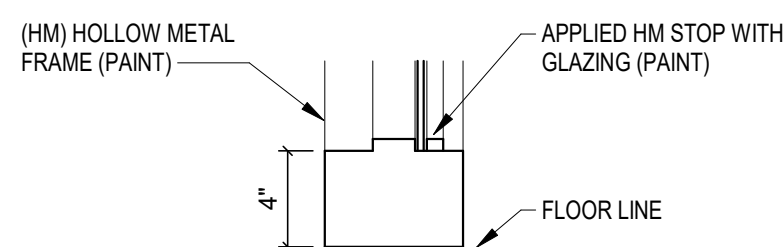


S6

SILL - HOLLOW METAL
SCALE: 1 1/2" = 1'-0"

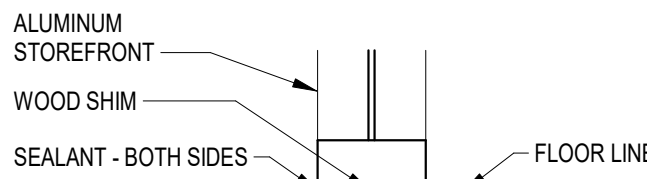


S4

SILL - STOREFRONT
SCALE: 1 1/2" = 1'-0"

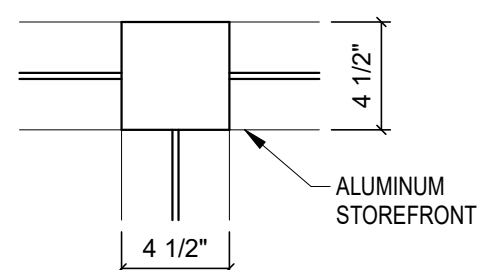


J7

JAMB - STOREFRONT
SCALE: 1 1/2" = 1'-0"

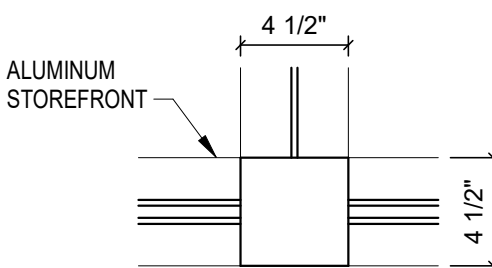


J8

JAMB - STOREFRONT
SCALE: 1 1/2" = 1'-0"

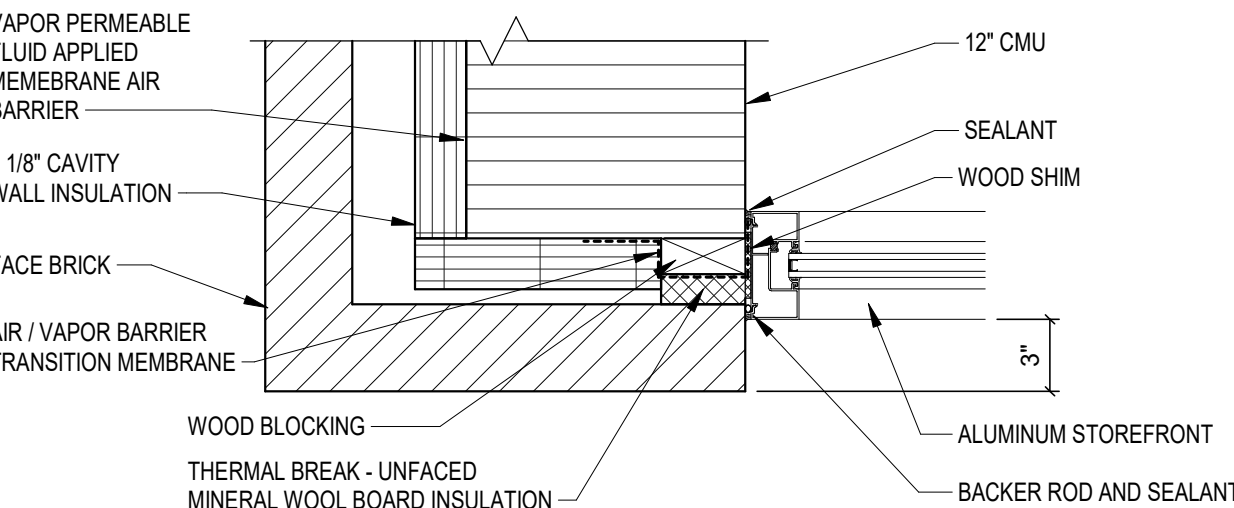


J9

JAMB - STOREFRONT
SCALE: 1 1/2" = 1'-0"

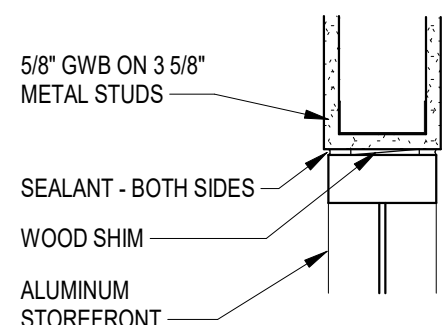


H8

HEAD - STOREFRONT
SCALE: 1 1/2" = 1'-0"

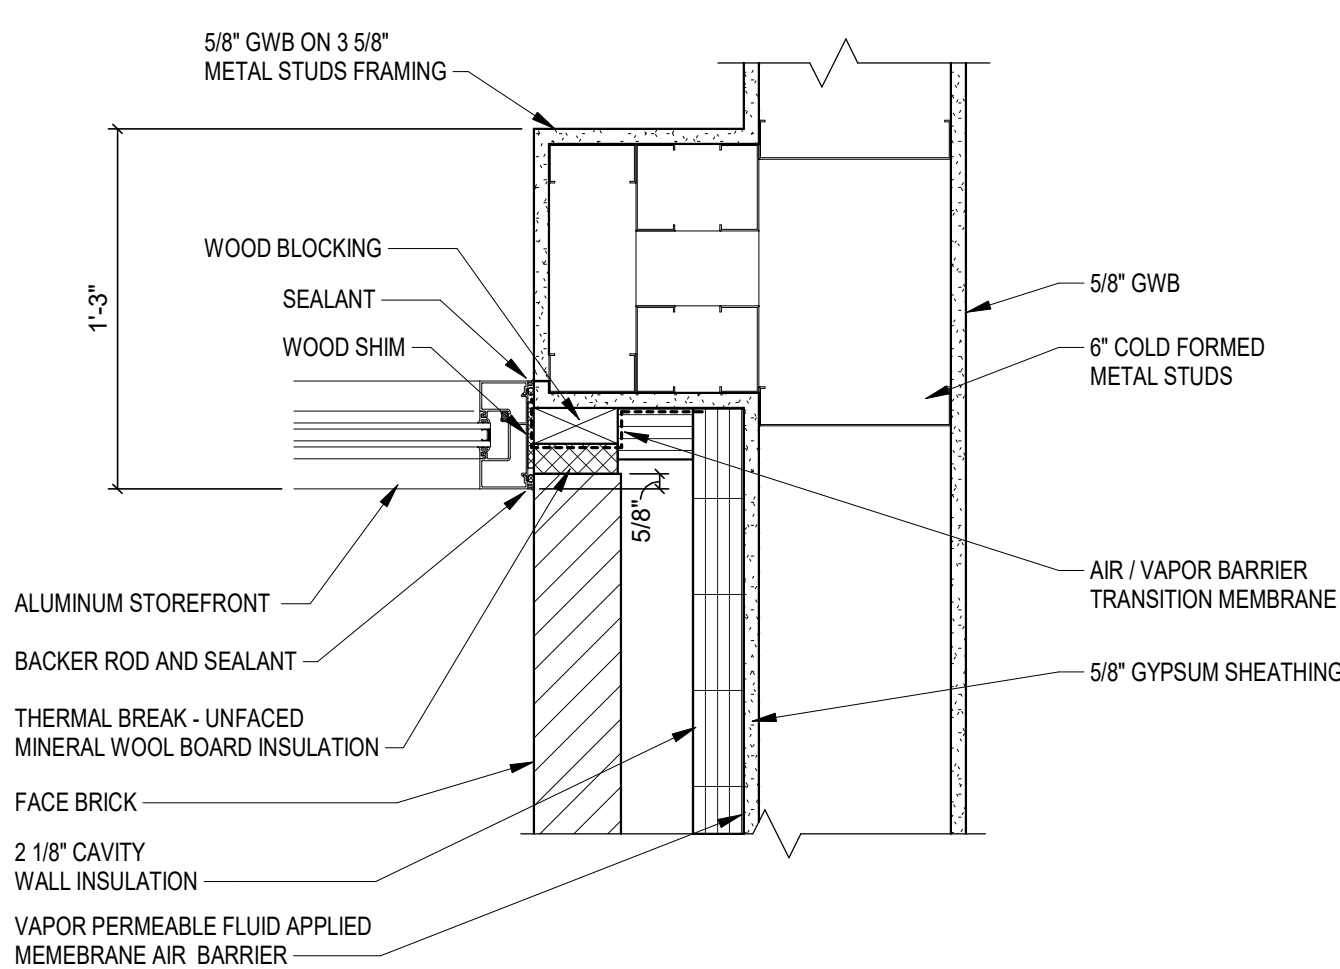

J6


JAMB - STOREFRONT
SCALE: 1 1/2" = 1'-0"

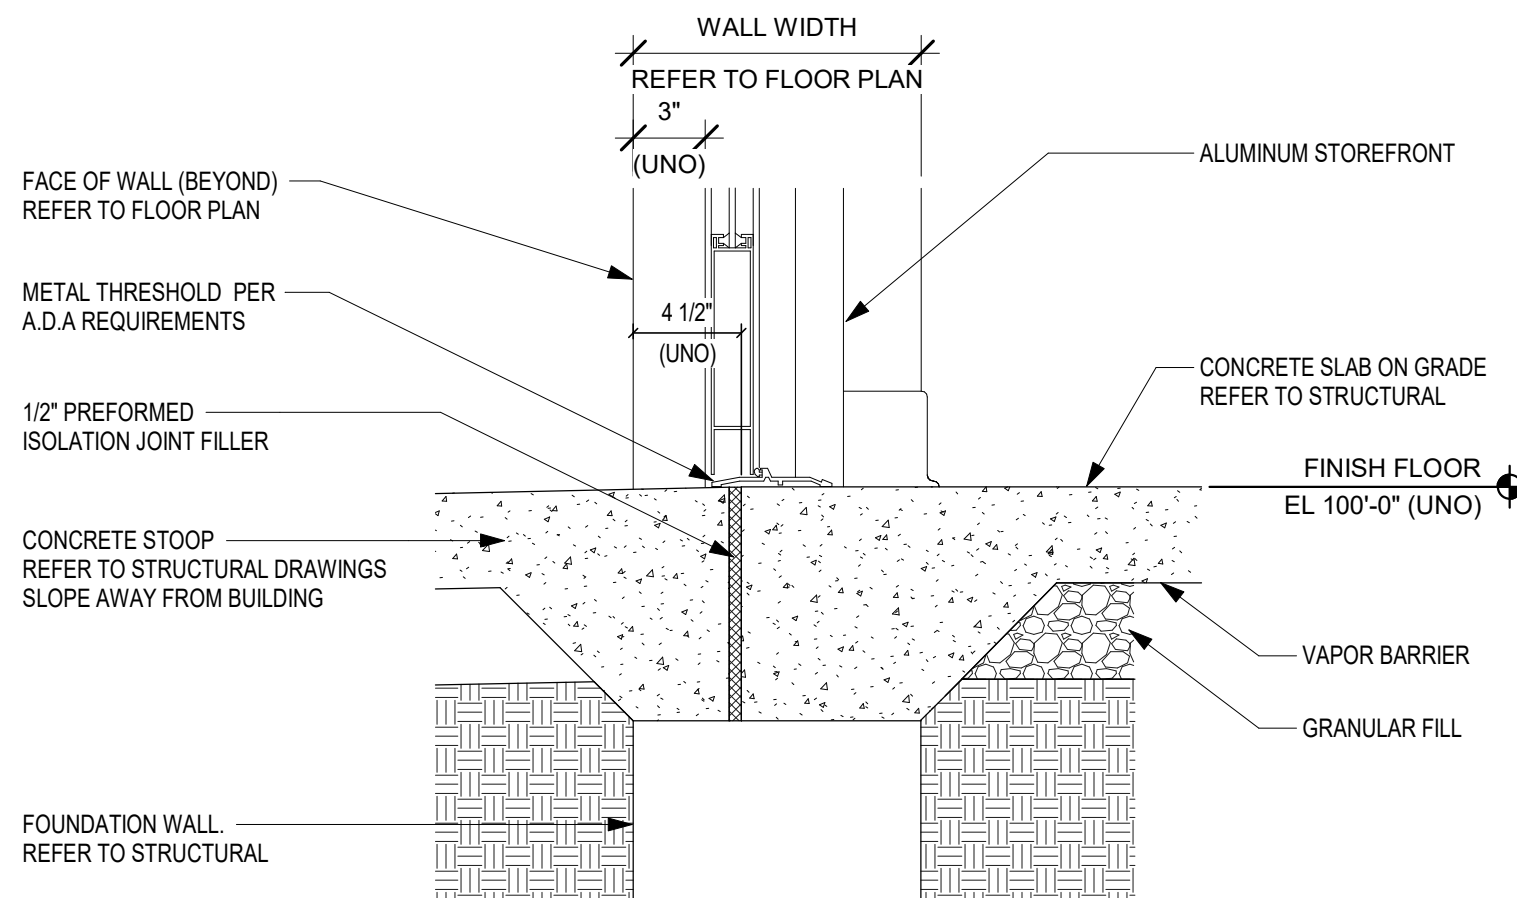

S5

JAMB - STOREFRONT
SCALE: 1 1/2" = 1'-0"

\\d:\info\profiles\mhamming\my documents\2023_ARCH1_Bittersweet_ES_mhamming\DXL1.rvt
8/20/2025 3:55:13 PM

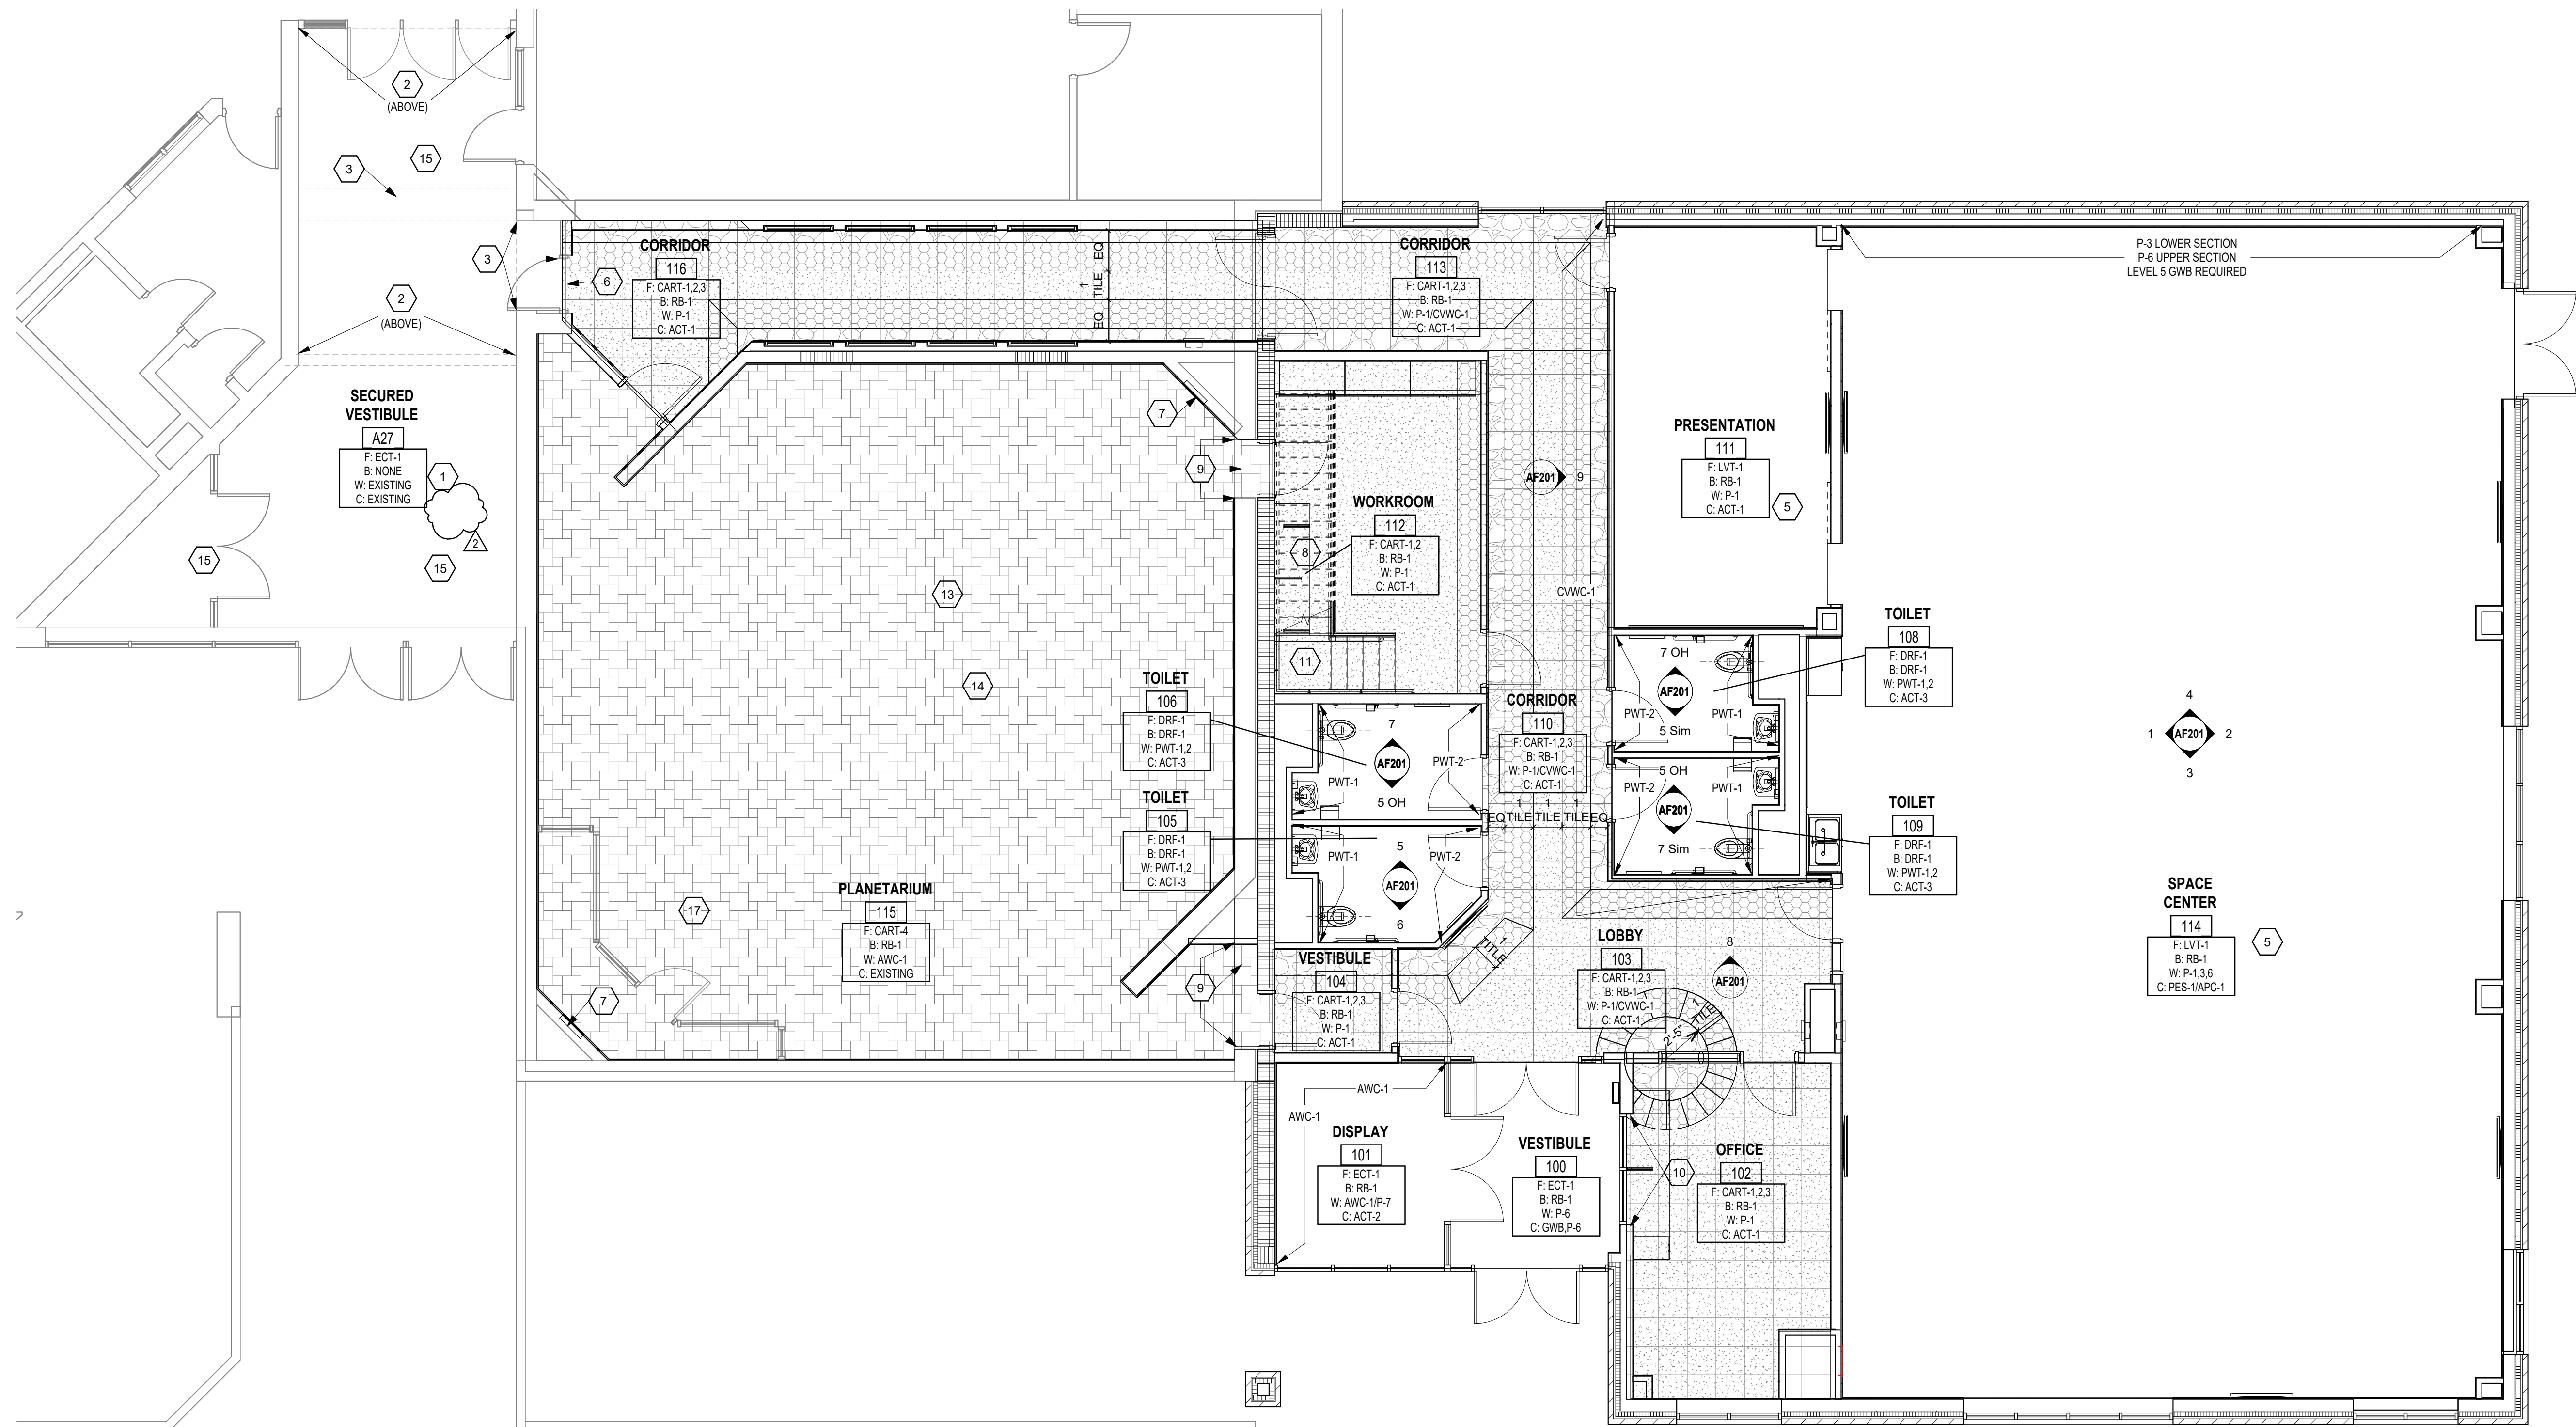

1 FIRST FLOOR FINISH PLAN - UNIT A
SCALE: 3/16" = 1'-0"

GENERAL FINISH NOTES

- A. FIXED CASEWORK AND TACKBOARDS SHALL REMAIN IN PLACE (UNO). NEW WALL FINISHES SHALL BE INSTALLED AROUND THESE ITEMS.
- B. SEALANT SHALL BE APPLIED AT ALL MATERIAL TRANSITIONS, BACKSPASHES, AND DOOR FRAMES. ALL LOCATIONS WHERE NEW FINISH ABUTS A DISSIMILAR MATERIAL.
- C. REMOVE AND REINSTALL EXISTING DEVICE FACEPLATES, SWITCH FACEPLATES, TECHNOLOGY FACEPLATES, AND CLOCKS.
- D. EXISTING ITEMS TO REMAIN AND NEW FINISHES APPLIED AROUND INCLUDE BUT NOT LIMITED TO THERMOSTATS, AND FIRE EXTINGUISHER CABINETS (UNO).
- E. RESILIENT TRANSITION STRIP BETWEEN NEW FLOOR FINISH AND EXISTING FLOOR FINISH.
- F. PROVIDE NEW RESILIENT TRANSITION STRIPS AT EXPOSED EDGE OF NEW FLOOR FINISH TO EXISTING FLOOR FINISH. PAINT ALL SIDES (VERT. AND HORZ.) OF BULKHEAD/SOFT COLOR INDICATED (UNO).
- H. EXISTING INTERIOR DOOR FRAMES ARE TO REMAIN. DO NOT PAINT, UNLESS NOTED OTHERWISE.
- I. PAINT ALL NEW INTERIOR DOOR FRAMES TO MATCH EXISTING DOOR FRAME COLOR. PAINT ON ALL FACES (PAINT CODE #6-12).
- J. PATCH AND REPAIR ALL HOLES AND IMPERFECTIONS, TO RECEIVE NEW FINISHES.

FLOOR PATTERN/FINISH KEY NOTES

NO. DESCRIPTION

1. PAINT ALL EXISTING CONDUIT IN THIS ROOM TO MATCH ADJACENT SURFACE.
2. EXISTING MURAL TO REMAIN. DO NOT PAINT.
3. REPAINT ALL SIDES OF GWB BULKHEAD P-5. IF MURAL IS PRESENT DO NOT PAINT OVER MURAL.
4. NO FINISH WORK.
5. ALTERNATE: FLOORING TO BE POLISHED CONCRETE.
6. PAINT THIS SIDE OF FRAME P-2.
7. PAINT OUTSIDE AND VISIBLE PORTION OF INSIDE OF MECHANICAL CHASE P-7.
8. CONTINUE CART-1 UNDER STAIRS.
9. WRAP AWC AROUND ALL SIDES AND TOP OF OPENING. CARPET TRANSITION TO OCCUR UNDER DOOR.
10. DFO. SEE S/AQ11A.
11. INSTALL RTR/RFT/RSA AT STAIRS.
12. PAINT THIS SIDE OF DOOR AND FRAME P-6.
13. REMOVE EXISTING SEATING AND REINSTALL AFTER FLOOR FINISH IS COMPLETED.
14. COORDINATE FLOOR FINISH WITH EXISTING FLOOR BOXES TO REMAIN.
15. PROVIDE SELF-LEVELING UNDERLAYMENT TO FLUSH EXISTING QUARRY TILE FLOOR FOR ECT INSTALLATION.
16. NOT USED
17. AWC TO ABUT EXISTING DISPLAY FRAME TO REMAIN.

COPYRIGHT 2025 BY FANNINGHOWEY ASSOCIATES, INC.

PHM Science and Space Exploration Center

55860 BITTERSWEET RD,
MISHAWAKA, IN 46545

PENN-HARRIS-MADISON
SCHOOL CORPORATION




ARCHITECT



317.848.0966 WWW.FHAI.COM
350 E NEW YORK ST #300, INDIANAPOLIS, IN 46204

CONSTRUCTION DOCUMENTS

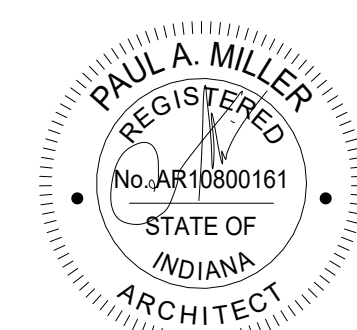

PROJECT MANAGER: MKS
DRAWN BY: MKH
PROJECT NUMBER: 225001.00
PROJECT ISSUE DATE: 06.30.2025

REV. NO.	DESCRIPTION	DATE
2	ADDENDUM 2	08/17/2025

FIRST FLOOR FINISH PLAN - UNIT A

AF11A

\\slader\c\mccaffries\sladen\mccaffries\documents\2025_ELEC_Bittersweet ES_sadenburn.vnt
8/13/2025 3:32:15 PM

ELECTRICAL ABBREVIATIONS

ABBREVIATIONS USED ON THE CONTRACT DOCUMENTS, INCLUDE BUT ARE NOT LIMITED TO THOSE LISTED BELOW

#	(N/P/NW)	NUMBER NUMBER OF POLES, NUMBER OF WIRES
ACU		AIR CONDITIONING UNIT
AF		AMP FRAME
AF		ABOVE FINISHED COUNTERTOP
AF		ABOVE FINISHED FLOOR
AF		ABOVE FINISHED GRADE
AF		AIR HANDLER UNIT
AC		AMPERE INTERRUPTING CAPACITY
AD		ADDRESSABLE INTERFACE DEVICE
AR		AS REQUIRED
AT		AMP TRIP
ATS		AUTOMATIC TRANSFER SWITCH
AWG		AMERICAN WIRE GAUGE
AV		AUDIO VISUAL
B		BLANK
BPS		BOLTED-PRESSURE CONTACT SWITCH
C		CONDUIT (GENERIC TERM FOR RACEWAY, PROVIDE AS SPECIFIED)
CA		CAMERA
CD		CANDELA
CKT		CIRCUIT
CL		LIGHTING CONTACTOR
CLG		CEILING MOUNTED
COL		COLUMN
CMF		COMBINATION MOTOR FUSIBLE STARTER
CUH		CABINET UNIT HEATER
D		DEMO TABLE
DC		DIRECT CURRENT
DEF		DETERMINED BASE ON INDIVIDUAL BRANCH CIRCUIT
DA		DUAL FACE
DI		DIMETER
DISTR		DISTRIBUTION
DPST		DOUBLE POLE SINGLE THROW
DPDT		DOUBLE POLE DOUBLE THROW
DT		DUST-TIGHT
EBJ		EQUIPMENT BONDING JUMPER ON LOAD SIDE OF AN OVER-CURRENT DEVICE
EC		ELECTRICAL CONTRACTOR
EM		WIRED ON EMERGENCY CIRCUIT
EOL		END OF LINE
ETR		EXISTING TO REMAIN
EW		ELECTRIC WATER COOLER
EX		EXISTING
F		FLUSH
F		FUSED AT
FA		FIRE ALARM
FBO		FURNISHED BY OTHERS
FCU		FAN COIL UNIT
FBN		FOUNDATION
FDB		FAN POWERED BOX
FR		FIBERGLASS REINFORCED EPOXY CONDUIT
FLW		FLOW SWITCH
H-O-A		HAND-OFF-AUTO
HTP		HEAT PUMP
KEC		KITCHEN EQUIPMENT CONTRACTOR
K/O		KNOCK-OUT
LFMC		LIQUIDTIGHT FLEXIBLE METALLIC CONDUIT
LFNC		LIQUIDTIGHT FLEXIBLE NONMETALLIC CONDUIT
LS		LIMIT SWITCH
LSIG		LONG TIME, SHORT TIME, INSTANTANEOUS AND GROUND FAULT TRIP ADJUSTMENTS TO BE PROVIDED ON A CIRCUIT BREAKER
LV		LOW VOLTAGE
MBJ		MAIN BONDING JUMPER
MCEIR		MAIN CROSS-CONNECTEQUIPMENT ROOM
MCB		MAIN CIRCUIT BREAKER
MCC		MOTOR CONTROL CENTER
MDP		MAIN DISTRIBUTION PANEL
M.H.		MANHOLE (ON SITE PLAN)
MH		MOUNTING HEIGHT (ON PLAN), ALL MOUNTING HEIGHTS FOR DEVICE BOXES ARE FROM FINISHED FLOOR TO BOTTOM OF BOX, UNO, VERIFY OUTLET LOCATIONS WITH OTHER TRADES BEFORE PROCEEDING WITH WORK
MLO		MAIN LUGS ONLY
MOD		MOTOR OPERATED DISCONNECT SWITCH
MCCP		MAXIMUM OVER-CURRENT PROTECTION
MSB		MAIN SWITCHBOARD
MSC		MOTOR STARTER CENTER
MTD		MOUNTED
MTG		MOUNTING
MTS		MANUAL TRANSFER SWITCH
MV		MEDIUM VOLTAGE
MZU		MULTI-ZONE HVAC UNIT
N		GROUNDING CIRCUIT CONDUCTOR (NEUTRAL)
NA		INDICATES MOUNTING HEIGHT IN TO BOTTOM OF DEVICE FROM FINISH FLOOR, UNO
NC		NOT APPLICABLE
NC		NORMALLY CLOSED
NFS		NONFUSIBLE SWITCH
NC		NOT IN CONTRACT
NL		NIGHT LIGHT
NM		NONMETALLIC SHEATHED CABLE
NO		NORMALLY OPEN
NRTL		NATIONALLY RECOGNIZED TESTING LAB
NTS		NOT TO SCALE
OC		ON CENTER
OC		OVER-CURRENT PROTECTIVE DEVICE
PA		PUBLIC ADDRESS SYSTEM
PB		PULL BOX
PE		PNEUMATIC/ELECTRIC
PH		PROPELLER HEATER
PV		POST INDICATING VALVE
PR		PAIR
PUH		PROPELLER UNIT HEATER
R		RELEASE
RAF		RETURN AIR FAN
RT		RAIN-TIGHT
RVS		REDUCE VOLTAGE STARTER
S		SURFACE
SBJ		SYSTEM BONDING JUMPER
SG		SIGNAL
SN		SOLID NEUTRAL
SP		SPARE
SPL		SPLICE
SPDT		SINGLE POLE DOUBLE THROW
SPDT		SINGLE POLE SINGLE THROW
SS		STAINLESS STEEL
SSBJ		SUPPLY-SIDE BONDING JUMPER
ST		SHUNT TRIP
STP		SHIELDED TWISTED PAIR
STL		CARBON STEEL
SUSP		SUSPENDED
SW		SWITCH
SWBD		SWITCHBOARD
TC		TELEPHONE CABINET
TCP		TEMPERATURE CONTROL PANEL
TEL		TELEPHONE DATA
TEL		TELEPHONE
TERM		TERMINAL(S)
TGB		TELECOMMUNICATIONS GROUNDING BUSBAR
TMBG		TELECOMMUNICATIONS MAIN GROUNDING BUSBAR
TTB		TELEPHONE TERMINATION BOARD
UEF		UTILITY EXHAUST FAN
UG		UNDERGROUND
UNO		UNLESS NOTED OTHERWISE
UV		UNIT VENTILATOR
VG		VANDAL GUARD
VF		VERIFY IN FIELD
VT		VAPOR-TIGHT
WG		WIRE GUARD
WTH		WATTHOUR
WM		WALL MOUNTED
WP		WEATHERPROOF
WT		WATER-TIGHT
XFMR		TRANSFORMER

POWER SYMBOLS

SYMBOL	DESCRIPTION	MOUNTING HEIGHT TO BOTTOM
	CONDUIT CONCEALED ABOVE CEILING OR IN WALL	
----	CONDUIT CONCEALED IN OR BELOW FLOOR, OR UNDER GROUND	
⊖ X 1AL1-1	20 AMP, 125 VOLT, NEMA 5-20R DUPLEX RECEPTACLE WITH COMMON COVER PLATE MOUNTED VERTICALLY +16" TO BOTTOM, LETTERS IN FRONT INDICATES LOAD TYPE, SEE BELOW, SINGLE LINE INDICATES HORIZONTAL MOUNTING, DOUBLE LINE INDICATE QUAD, DARK CENTER INDICATES ABOVE COUNTERTOP MOUNTING (44") NEMA 5-20R, UNO, CIRCUIT NUMBER (e.g. "1AL1-1") ADJACENT TO THE SYMBOL, ON PLANS INDICATES PANELBOARD/CIRCUIT NUMBER SERVING RECEPTACLE, UNO	
⊖	GF GROUND FAULT CIRCUIT INTERRUPTING TYPE	
⊖	M MONITOR, -60" AFF	
⊖	T TECHNOLOGY RACK	
⊖	VP WALL MOUNTED VOLT PROJECTOR, 96" AFF UNO	
⊖	WC ELECTRIC WATER COOLER, FEED FROM 5 mA GFCI BREAKER IN PANELBOARD	
⊖	WF WASHFOUNTAIN/LAVATORY, CONNECT TO NEAREST THROUGH FEED GFCI RECEPTACLE	
⊖	WP WEATHER RESISTANT GFCI WITH IN-USE TYPE WEATHERPROOF COVER HINGED AT TOP	

⊖	20 AMP SINGLE RECEPTACLE, NEMA 5-20R	16"
⊖-30	SINGLE STRAIGHT BLADE RECEPTACLE, 30A, 125 VOLT, NEMA 5-30R	16"
⊖-C	15 AMP SINGLE RECEPTACLE, SEMI-RECESSED WALL MOUNTED WITH CLOCK HANGER, NEMA 5-15R	76"
⊖	20 AMP DUPLEX RECEPTACLE FLUSH CEILING MOUNTED, NEMA 5-20R	CLG
⊖	SINGLE FLUSH BOX WITH FOUR USE CHARGING PORTS, WITH DECORA STYLE COVER PLATE, MOUNTED ABOVE COUNTERTOP HEIGHT, UNO	44"
⊖	SPECIAL POWER RECEPTACLE, AMPS, VOLTS AND NEMA CONFIGURATION AS DEFINED ON PLANS BY CODED NOTE	16"
⊖	SINGLE STRAIGHT BLADE, SPECIAL RECEPTACLE, 20A, 125/250 VOLT, 3P, 4W, NEMA 14-20R	16"
⊖ W	SINGLE STRAIGHT BLADE, WELDING RECEPTACLE, 60A, 250 VOLT, 3P, 3W, NEMA 15-60R	44"
⊖ R	SINGLE STRAIGHT BLADE, RANGE RECEPTACLE, 50A, 125/250 VOLT, 3P, 4W, NEMA 14-50R	8"
⊖ D	SINGLE STRAIGHT BLADE, GROUNDED DRYER RECEPTACLE, 30A, 125/250 VOLT, 3P, 4W, NEMA 14-30R	32"
⊖ T	30 AMP, 120 VOLT, SINGLE TWIST LOCK RECEPTACLE, UNO, NEMA 15-30R	16"
⊖ F	20 AMP DUPLEX RECEPTACLE IN FLUSH FLOOR MOUNTED BOX, NEMA 5-20R, USE A CAST BOX AT GRADE LEVEL, USE A STAMPED STEEL BOX FOR UPPER FLOORS, REFER TO SPECIFICATIONS FOR REQUIREMENTS.	-
⊖ F	20 AMP DUPLEX RECEPTACLE IN FIRE RATED POKE-THRU FLOOR DEVICE, NEMA 5-20R, REFER TO SPECIFICATIONS FOR REQUIREMENTS.	-
⊖ P	20 AMP DUPLEX RECEPTACLE IN PEDESTAL MOUNTED ABOVE FLOOR SERVICE FITTING, NEMA 5-20R, REFER TO SPECIFICATIONS FOR REQUIREMENTS.	-
⊖	HIGH CAPACITY FLOOR BOX WITH A DUPLEX RECEPTABLE, NEMA 5-20R, UNO FOR POWER AND DATA, REFER TO SPECIFICATIONS FOR REQUIREMENTS	-
⊖	COMMUNICATIONS/POWER POLE PRE-WIRED WITH 2 DUPLEX RECEPTABLES, WITH TWO J BOX ABOVE CEILING, REFER TO SPECIFICATIONS FOR REQUIREMENTS	-
⊖	TWO 20 AMP DUPLEX RECEPTABLES IN BOX WITH COVER PLATE, PENDANT MOUNTED WITH 3/8", 5/8" CORD AND STRAIN RELIEF GRIPS	84"
⊖	2 CHANNEL MULTIOUTLET SURFACE RACEWAY ASSEMBLY WITH DUPLEX RECEPTABLES AND DATA OUTLETS, SEE TECHNOLOGY DRAWINGS, QUANTITY AS SHOWN OR PER SPEC.	-
⊖	SINGLE CHANNEL MULTIOUTLET SURFACE RACEWAY PRE-WIRED ASSEMBLY WITH SINGLE RECEPTABLES, QUANTITY PER SPEC.	-

FIRE ALARM SYMBOLS

SYMBOL	DESCRIPTION	MH
⊖	ADDRESSABLE INTERFACE DEVICE	-
⊖	HEAT DETECTOR, 160 DEGREES F FIXED TEMPERATURE (UNO), CEILING MOUNTED	CLG
⊖	ROUND INDICATES CEILING MOUNTED, SQUARE INDICATES DUCT MOUNTED, PHOTOELECTRIC SMOKE DETECTOR	
⊖	FIRE ALARM ANNUNCIATION PANEL	56"
⊖	FIRE ALARM POWER SUPPLY	-
⊖	FIRE ALARM CONTROL PANEL	-
⊖	AUDIBLE AND VISIBLE NOTIFICATION APPLIANCE (HORN/STROBE), CEILING MOUNTED, EXTRA LINE INDICATES WALL MOUNTING AT 80" AFF	CLG
⊖	VOICE/ALARM COMMUNICATION AUDIBLE AND VISIBLE NOTIFICATION DEVICE (SPEAKER/STROBE), CEILING MOUNTED, EXTRA LINE INDICATES WALL MOUNTING AT 80" AFF	CLG
⊖	VOICE/ALARM COMMUNICATIONS LOUDSPEAKER, CEILING MOUNTED, EXTRA LINE INDICATES WALL MOUNTING AT 96" AFF	CLG
⊖	MANUAL FIRE ALARM PULL STATION, AND AUDIBLE AND VISIBLE NOTIFICATION APPLIANCE ABOVE (HORN/STROBE), WALL MOUNTED	44"/80"
⊖	MANUAL FIRE ALARM PULL STATION, WALL MOUNTED	44"
⊖	VOICE/ALARM COMMUNICATIONS HORN TYPE LOUDSPEAKER, CEILING MOUNTED, EXTRA LINE INDICATES WALL MOUNTING AT 96" AFF	CLG
⊖	SMOKE DETECTOR BEAM TRANSMITTER	-
⊖	SMOKE DETECTOR BEAM RECEIVER	-
⊖	SMOKE DAMPER ACTUATOR AND ASSOCIATED SMOKE DETECTOR, TYPE PER PLANS	-
⊖	WATER FLOW SWITCH CONNECTION	-
⊖	SUPERVISORY VALVE TAMPER SWITCH CONNECTION	-
⊖	SURFACE FIRE ALARM MAGNETIC DOOR HOLDER	6" BELOW TOP OF DOOR
⊖	SURFACE SECURITY ALARM MAGNETIC DOOR HOLDER	6" BELOW TOP OF DOOR
⊖	ELECTRONIC RELEASE DOOR CLOSER	-
⊖	FIRE ALARM BELL, WALL MOUNTED, WEATHERPROOF WHERE EXTERIOR MOUNTED	96"
⊖	MICRO SWITCH IN KITCHEN HOOD FOR FIRE SUPPRESSION SYSTEM, SUPPLIED BY OTHERS, WIRED BY EC.	HOOD
⊖	POST INDICATOR VALVE TAMPER SWITCH	-

POWER SYMBOLS

SYMBOL	DESCRIPTION	MH
⊖	DISTRIBUTION PANEL, SEE ONE LINE DIAGRAM	-
⊖	SURFACE CIRCUIT BREAKER PANELBOARD, SEE ONE LINE DIAGRAM	-
⊖	FLUSH MOUNTED CIRCUIT BREAKER PANELBOARD, SEE ONE LINE DIAGRAM	-
⊖	UTILITY METER	-
⊖	RECESSED ADA PUSH BUTTON FOR AUTOMATIC DOOR OPERATOR, FURNISHED BY OTHERS, INSTALLED BY DIV. 26	44"
⊖	RECESSED ADA DOUBLE PUSH BUTTON FOR DUAL AUTOMATIC DOOR OPERATORS, FURNISHED BY OTHERS, INSTALLED BY DIV. 26	44"
⊖	RED MUSHROOM ABORT SWITCH, WALL MOUNTED	44"
⊖	CIRCUIT BREAKER DISCONNECT SWITCH, 30A - 3 POLE, UNO	48"
⊖	NON-FUSED DISCONNECT, 3 POLE, NEMA 1, UNO, 30 AMP UNO, -WP SUFFIX DESIGNATES NEMA 3R ENCLOSURE, -WPX SUFFIX DESIGNATES NEMA 4X STAINLESS STEEL ENCLOSURE.	48"
⊖	FUSED DISCONNECT, 3 POLE, NEMA 1, UNO, 30 AMP UNO, -WP SUFFIX DESIGNATES NEMA 3R ENCLOSURE, -WPX SUFFIX DESIGNATES NEMA 4X STAINLESS STEEL ENCLOSURE.	48"
⊖	MAGNETIC STARTER, 30 AMP - 3 POLE, NEMA SIZE 1, UNO WITH H-O-A SWITCH AND RED PILOT LIGHT (RUNNING).	48"
⊖	COMBINATION MAGNETIC MOTOR STARTER, WITH 30 AMP - 3 POLE CIRCUIT BREAKER DISCONNECT SWITCH, NEMA SIZE 1, UNO WITH H-O-A SWITCH AND RED PILOT LIGHT (RUNNING).	48"
⊖	COMBINATION MAGNETIC MOTOR STARTER, WITH 30 AMP - 3 POLE MOTOR CIRCUIT PROTECTOR (MCP) DISCONNECT SWITCH, NEMA SIZE 1, UNO WITH H-O-A SWITCH AND RED PILOT LIGHT (RUNNING).	48"
⊖	COMBINATION MAGNETIC MOTOR STARTER, WITH 30 AMP - 3 POLE FUSED DISCONNECT SWITCH, NEMA SIZE 1, UNO, WITH H-O-A SWITCH AND RED PILOT LIGHT (RUNNING).	48"
⊖ MP	MANUAL MOTOR STARTER WITH THERMAL OVERLOAD PROTECTION AND PILOT LIGHT, UNO, FLUSH MOUNTED IN FINISH SPACES.	44"
⊖ M	MANUAL MOTOR STARTER WITH THERMAL OVERLOAD PROTECTION, UNO, FLUSH MOUNTED IN FINISH SPACES.	44"
⊖ C	CONTROL SWITCH FOR DEVICES SUCH AS MOTORIZED SHADES, SOLAR LIGHT TUBES, PROJECTION SCREENS, ETC, FURNISHED BY OTHERS, INSTALLED FLUSH MOUNTED WITH COVER PLATE AND WIRED BY DIV. 26	44"
⊖	ELECTRICALLY HELD CONTACTOR WITH H-O-A SWITCH, 30A - 3P, UNO, REFER TO SPECIFICATION FOR REQUIREMENTS.	48"
⊖	COMBINATION ELECTRICALLY HELD CONTACTOR, WITH H-O-A SWITCH AND 30 AMP - 3P CIRCUIT BREAKER DISCONNECT SWITCH, UNO, REFER TO SPECIFICATION FOR REQUIREMENTS.	48"
⊖	DIGITAL TIME CLOCK SWITCH	60"
⊖	AUTOMATIC TRANSFER SWITCH, REFER TO SINGLE LINE DIAGRAM, COORDINATE FINAL MOUNTING HEIGHT, REFER TO SPECIFICATIONS FOR REQUIREMENTS	60"
⊖	THERMOSTAT	-
⊖	MOTOR	-
⊖	DRY TYPE TRANSFORMER	-
⊖	SURGE PROTECTIVE DEVICE, REFER TO SPECIFICATION FOR REQUIREMENTS.	-
⊖	JUNCTION BOX, PGITAL INDICATED FLEXIBLE CONDUIT CONNECTION TO EQUIPMENT	-

LIGHTING SYMBOLS

SYMBOL	DESCRIPTION	MH
⊖	OCCUPANCY SENSOR - CEILING MOUNTED (UNO), HIGH BAY INFRARED, 360 DEGREE PATTERN, 36" DIA. COVERAGE PATTERN (MIN.) AT 20' MOUNTING HEIGHT, PROVIDE WITH RELAY OPTION.	CLG
⊖	OCCUPANCY SENSOR - CEILING MOUNTED, ULTRASONIC AND INFRARED SENSOR FOR CORRIDOR & HALLWAY APPLICATIONS, 36X16" (MIN.) RECTANGULAR SHAPED COVERAGE PATTERN, PROVIDE WITH RELAY OPTION, "X" PORTION OF SYMBOL INDICATES AIMING OF ULTRASONIC SENSORS.	CLG
⊖	OCCUPANCY SENSOR - CEILING MOUNTED, DUAL TECHNOLOGY, 360 DEGREE PATTERN, 2000 S.F. COVERAGE, PROVIDE WITH RELAY OPTION, "X" PORTION OF SYMBOL INDICATES AIMING OF ULTRASONIC SENSORS.	CLG
⊖	OCCUPANCY SENSOR - CEILING MOUNTED, INFRARED, DIRECTIONAL/180 DEGREE PATTERN, 1200 S.F. COVERAGE (MIN.), PROVIDE WITH RELAY OPTION, PROVIDE WITH CEILING MOUNTING BRACKET ACCESSORY IF NOT SUPPLIED AS STANDARD WITH SENSOR, "X" PORTION OF SYMBOL INDICATES AIMING.	CLG
⊖	OCCUPANCY SENSOR - WALL MOUNTED, DUAL TECHNOLOGY, 180 DEGREE PATTERN, 1200 S.F. COVERAGE (MIN.), PROVIDE WITH RELAY OPTION.	96"
⊖	OCCUPANCY SENSOR - WALL MOUNTED, INFRARED, 180 DEGREE PATTERN, 1200 S.F. COVERAGE (MIN.), PROVIDE WITH RELAY OPTION.	96"
⊖	OCCUPANCY SENSOR - WALL SWITCH TYPE, DUAL TECHNOLOGY WITH MANUAL OVERRIDE SWITCH	44"
⊖	OCCUPANCY SENSOR - WALL SWITCH TYPE, INFRARED WITH MANUAL OVERRIDE SWITCH	44"
⊖	DAYLIGHT SENSOR	CLG
⊖ K	KEY OPERATED SWITCH, NUMBER INDICATES NUMBER OF POLES, 27V, 20A, FLUSH UNO	44"
⊖ 3	SWITCH, NUMBER INDICATES NUMBER OF POLES, 27V, 20A, FLUSH UNO	44"
⊖ a	SINGLE POLE SWITCH, 27V, 20A, FLUSH UNO TYPICAL, SUBSCRIPT a, b, c INDICATES WHICH LUMINAIRE THAT WILL BE CONTROLLED VIA SWITCH LEG	44"
⊖ d	WALL BOX DIMMER 27V, 1200 WATT MINIMUM, FLUSH UNO, PROVIDE WATTAGE SIZE TO EXCEED CIRCUIT LOAD	44"
⊖	LIGHTING CONTACTOR, MECHANICALLY HELD, 30A - 3P WITH H-O-A SWITCH, UNO	48"
⊖	COMBINATION LIGHTING CONTACTOR, MECHANICALLY HELD, WITH H-O-A SWITCH AND 30A - 3P CIRCUIT BREAKER, UNO	48"
⊖	LIGHTING RELAY PANEL	-
⊖	DOWNLIGHT LUMINAIRE, APPROXIMATE SIZE INDICATED	-
⊖	DOWNLIGHT LUMINAIRE CONNECTED TO EMERGENCY SYSTEM AS INDICATED	-
⊖	WALL SCONCE LUMINAIRE	-
⊖	WALL MOUNTED EXIT SIGN, DIRECTIONAL ARROWS AS SHOWN	96"
⊖	CEILING MOUNTED EXIT SIGN, SHADED PORTIONS INDICATES SINGLE OR DOUBLE FACE	CLG
⊖	TRACK HEAD LUMINAIRE	-
⊖	EMERGENCY LIGHTING UNIT WITH 2 HEADS	76"
⊖	WALL-BRACKET LUMINAIRE, APPROXIMATE SIZE INDICATED	-
⊖	WALL-BRACKET LUMINAIRE CONNECTED TO EMERGENCY SYSTEM AS INDICATED	-
⊖	RECESSED LUMINAIRE, APPROXIMATE SIZE INDICATED, (NL) INDICATES NIGHT LIGHT FIXTURES	CLG
⊖	RECESSED LUMINAIRE CONNECTED TO EMERGENCY SYSTEM AS INDICATED	CLG
⊖	SURFACE OR PENDANT MOUNTED LUMINAIRE, APPROXIMATE SIZE INDICATED	CLG
⊖	SURFACE OR PENDANT MOUNTED LUMINAIRE CONNECTED TO EMERGENCY SYSTEM AS INDICATED	CLG
⊖	PENDANT LUMINAIRE, APPROXIMATE SIZE INDICATED	CLG
⊖	PENDANT LUMINAIRE CONNECTED TO EMERGENCY SYSTEM AS INDICATED	CLG
⊖	AIMABLE LUMINAIRE, CARROT INDICATING DIRECTION OF AIMING	-

ELECTRICAL GENERAL NOTES


- THE TERM "PROVIDE" INDICATES CONTRACTOR SHALL FURNISH AND INSTALL ITEMS AND CONNECT AS REQUIRED TO OBTAIN A COMPLETE AND OPERABLE SYSTEM.
- COORDINATE DEVICE LOCATIONS WITH ARCHITECTURAL PLANS, CASEWORK, WINDOWS, WALL FINISHES, EQUIPMENT, AND OTHER TRADES PRIOR TO ROUGH IN. DEVICES ARE INTENDED TO BE ACCESSIBLE, DO NOT INSTALL BEHIND CASEWORK, DOORS OR EQUIPMENT UNLESS INDICATED ON PLANS. NOTIFY ARCHITECT IN WRITING OF CONFLICTS PRIOR TO PROCEEDING WITH WORK.
- WORK SHALL BE IN ACCORDANCE WITH THE LATEST EDITION OF ALL LOCAL, STATE, AND NATIONAL CODES INCLUDING, BUT NOT LIMITED TO NFPA 70 (NATIONAL ELECTRIC CODE), NFPA 72, NFPA 101, INTERNATIONAL BUILDING CODE, ETC.
- CONFLICTS BETWEEN THE APPLICABLE CODES, STANDARDS, AND THE PLANS AND SPECIFICATIONS SHALL BE SUBMITTED TO THE ARCHITECT IN WRITING PRIOR TO PROCEEDING WITH WORK.
- REFER TO TECHNOLOGY PLANS FOR COMMUNICATIONS, SECURITY AND ACCESS CONTROL.
- CONTRACTOR SHALL FOLLOW SEISMIC RESTRAINT AND DESIGN REQUIREMENTS CONTAINED IN LATEST ADOPTED STATE AND INTERNATIONAL BUILDING CODES WITH ALL AMENDMENTS AS ADOPTED.
- ADDITIONAL ELECTRICAL REQUIREMENTS MAY BE SHOWN ON PLANS FROM OTHER DISCIPLINES IN THIS SET. IT IS THE CONTRACTOR'S RESPONSIBILITY TO REVIEW ALL PLANS AND SPECIFICATIONS FOR A COMPLETE UNDERSTANDING OF THE PROJECT REQUIREMENTS.
- WHERE CONFLICTS ARE FOUND BETWEEN DRAWINGS, DETAILS, OR SPECIFICATIONS, THE MORE STRINGENT REQUIREMENT SHALL APPLY. NOTIFY ARCHITECT OF DISCREPANCY IN WRITING.
- INITIATING WORK CONSTITUTES CONTRACTOR ACCEPTANCE OF THE EXISTING CONDITIONS ASSOCIATED WITH THE WORK IN QUESTION.
- CONTRACTOR SHALL CONTACT UTILITIES AND VERIFY UTILITY REQUIREMENTS PRIOR TO COMMENCING CONSTRUCTION. CONFLICTS BETWEEN UTILITY REQUIREMENTS AND THE PLANS OR SPECIFICATIONS SHALL BE SUBMITTED TO THE ARCHITECT IN WRITING PRIOR TO PROCEEDING WITH WORK. CONTRACTOR SHALL ARRANGE A PRE-CONSTRUCTION MEETING WITH THE UTILITY COMPANY TO REVIEW REQUIREMENTS, INCOMING SERVICE CONDUITS AND SUBSTRUCTURES SHALL BE INSTALLED PER UTILITY COMPANY STANDARDS.
- THESE DRAWINGS AND SPECIFICATIONS DO NOT INDICATE METHODS OF CONSTRUCTION. THE CONTRACTOR SHALL ADVISE AND DIRECT THE WORK AND IS RESPONSIBLE FOR CONSTRUCTION MEANS, METHODS, TECHNIQUES, SEQUENCES, PROCEDURES, AND SAFE PRACTICES.
- DRAWINGS ARE DIAGRAMMATIC IN NATURE AND CANNOT SHOW EVERY CONNECTION, JUNCTION BOX, WIRE, AND CONDUIT, ETC. THE EXACT LOCATIONS AND ARRANGEMENT OF PARTS SHALL BE DETERMINED AS THE WORK PROGRESSES. ITEMS NOT INDICATED ON DRAWINGS REASONABLY INFERRRED TO BELONG TO THE WORK DESCRIBED SHALL BE FURNISHED AND INSTALLED TO PROVIDE A COMPLETE AND OPERATIONAL SYSTEM.
- WORK SHALL BE COORDINATED WITH EXISTING CONDITIONS, NEW CONSTRUCTION, OWNER'S VENDORS, OTHER TRADES, AND THEIR DOCUMENTS. THE CONTRACTOR SHALL VISIT THE SITE BEFORE SUBMITTING HIS BID. CONTRACTOR SHALL CONTACT OWNER FOR AN APPOINTMENT TO VISIT THE SITE.
- AN INSULATED GROUND CONDUCTOR SIZED PER NEC SHALL BE PROVIDED WITH EACH FEEDER AND BRANCH CIRCUIT.
- PROVIDE A DEDICATED NEUTRAL FOR EACH LINE TO NEUTRAL CIRCUIT. MULTI-WIRE BRANCH CIRCUITS ARE NOT PERMITTED UNLESS SPECIFICALLY INDICATED ON PLANS.
- MINIMUM WIRE SIZE IS #12 AWG. SEE SPECIFICATIONS FOR MINIMUM CONDUIT SIZE.
- CONDUIT SHALL BE CONCEALED WHERE POSSIBLE ABOVE CEILINGS, INSIDE WALLS, OR UNDER FLOOR SLAB UNLESS SHOWN ON DRAWINGS. IN AREAS WITH NO CEILING, RUN EXPOSED CONDUIT AS HIGH AS POSSIBLE AND PARALLEL TO NEARBY SURFACES OR EXISTING RACEWAYS. CONDUIT SHALL NOT BE INSTALLED IN FLOOR SLAB UNLESS SPECIFICALLY INDICATED ON PLANS AND WHERE APPROVED BY STRUCTURAL ENGINEER. DO NOT INSTALL MC CABLE IN EXPOSED LOCATIONS.
- CONTRACTOR SHALL PROVIDE A DEDICATED NEUTRAL TO FACILITATE PATHWAYS THROUGH FULL HEIGHT WALLS FOR ELECTRICAL AND TELECOMMUNICATION WIRING.
- PROVIDE TEMPORARY OR PERMANENT END CAPS FOR STUBBED CONDUITS. PROVIDE INSULATED THROAT BUSINGS FOR CONDUITS INTENDED TO REMAIN OPEN ENDED. SEE ARCHITECTURAL PLANS FOR LOCATIONS OF FIRE RATED ASSEMBLIES AND SMOKE BARRIERS. SEAL PENETRATIONS IN ACCORDANCE WITH UL AND PROJECT SPECIFICATIONS.
- MOUNTING HEIGHTS FOR WALL MOUNTED DEVICES INDICATED ABOVE FINISHED FLOOR ARE TO BOTTOM OF DEVICE UNO. MOUNTING HEIGHTS TO CEILING SUBSUNED DEVICES ARE TO BOTTOM OF DEVICE UNO.
- PROVIDE SOUND INSULATING PUTTY AROUND DEVICES INSTALLED ON OPPOSITE SIDE OF A WALL IN THE SAME VERTICAL CHANNEL. IF DEVICES ARE LOCATED AT LEAST 1' HORIZONTALLY APART NO SOUND INSULATING PUTTY IS REQUIRED.
- COORDINATE CEILING MOUNTED DEVICES WITH MECHANICAL AND ARCHITECTURAL REFLECTED CEILING PLANS. NOTIFY ARCHITECT IN WRITING OF CONFLICTS PRIOR TO PROCEEDING WITH WORK.
- JUNCTION BOXES LOCATED ABOVE ACCESSIBLE CEILINGS SHALL BE LOCATED NO MORE THAN 36" ABOVE CEILING LEVEL. LABEL EACH BOX IN AREA OF WORK WITH A PERMANENT MARKER OR IN ACCORDANCE WITH SPECIFICATIONS, WHICHEVER IS MORE STRINGENT.
- CONDUITS DESIGNATED AS EMPTY OR FUTURE SHALL BE PROVIDED WITH A #12 PULL LINE. OPEN ENDED CONDUITS SHALL BE PROVIDED WITH INSULATED THROAT BUSHINGS.
- FOR LUMINAIRES, CIRCUIT NUMBER IS SHOWN ONLY ONCE IN EVERY ROOM. PROVIDE CIRCUIT INDICATED TO EVERY LIGHT FIXTURE INDICATED IN SAME ROOM UNLESS OTHERWISE INDICATED.
- QUANTITY AND LOCATION OF TAMPER AND FLOW SWITCHES IS FOR BIDDING PURPOSES ONLY. VERIFY EXACT QUANTITY AND LOCATIONS WITH ARCHITECT. CONTRACTOR PRIOR TO FIRE ALARM SHOP DRAWING SUBMITTAL.
- ELECTRICAL PANELS INCLUDING BUT NOT LIMITED TO FIRE ALARM CONTROL PANELS, LIGHTING CONTROL PANELS, POWER DISTRIBUTION WILL HAVE A MAX DEVICE HEIGHT OF 72" AFF.
- PROVIDE GROUNDING TYPE EXPANSION FITTINGS OR OTHER APPROVED METHODS TO ALLOW FOR EXPANSION, CONTRACTION, AND DEFLECTION WHERE CONDUITS CROSS BUILDING EXPANSION JOINTS.
- PROVIDE SEPARATE RACEWAY FOR EMERGENCY SYSTEM WIRING PER NEC ARTICLE 700. MINIMUM WIRE SIZE 10 AWG.
- ALL CONDUITS SHALL INCLUDE AN INSULATED GROUND WIRE, SIZED PER N.E.C.
- AUTODOORS AND WHEELCHAIR LIFT PROVIDED AND INSTALLED BY OTHERS, PROVIDE CONDUIT AND BOX ROUGH-INS FOR MOTORS AND PUSHBUTTONS. MAKE FINAL POWER CONNECTIONS. ALL CONTROL WIRING BY OTHERS.
- MASONRY LOAD-BEARING WALLS AND MASONRY SHEAR WALLS:** DO NOT PENETRATE CMU WALLS INDICATED AS BEARING WALLS AND SHEAR WALLS ON STRUCTURAL DRAWINGS UNLESS NOTED OTHERWISE ON PLAN. DO NOT CORE THROUGH CMU BOND BEAMS OR LITELS. DO NOT CUT ANY VERTICAL REINFORCING IN CMU WALLS. OBTAIN PRIOR APPROVAL FROM ENGINEER BEFORE PENETRATING ANY OF THE STRUCTURAL ELEMENTS LISTED ABOVE.
- CONCRETE BEARING WALLS AND BEAMS:** DO NOT PENETRATE CONCRETE WALLS INDICATED AS BEARING WALLS AND SHEAR WALLS ON STRUCTURAL DRAWINGS UNLESS NOTED OTHERWISE ON PLAN. DO NOT CORE THROUGH CONCRETE BEAMS, GIRDERS, OR COLUMNS. DO NOT CUT ANY VERTICAL REINFORCING IN CONCRETE WALLS. OBTAIN PRIOR APPROVAL FROM STRUCTURAL ENGINEER BEFORE PENETRATING ANY OF THE STRUCTURAL ELEMENTS LISTED ABOVE.
- STEEL FRAMING:** DO NOT CUT OR CORE THROUGH ANY STRUCTURAL STEEL BEAMS, GIRDERS, OR COLUMNS UNLESS NOTED OTHERWISE ON PLAN. NOTIFY ENGINEER OF POTENTIAL CONFLICTS BETWEEN FRAMING AND ELECTRICAL WORK.
- CONCRETE FLOOR SYSTEMS (APPLIES TO CONCRETE BLDG. OR STEEL WITH CONCRETE DECK, MASONRY W/ CONC. FLOOR):** DO NOT CUT HOLES OR CORE THROUGH CONCRETE FLOOR SLAB UNLESS NOTED OTHERWISE ON PLAN OR IN TYPICAL STRUCTURAL DETAILS. PENETRATIONS THROUGH EXISTING SLABS SHALL BE X-RAYED PRIOR TO CORING HOLES. NO EXISTING REINFORCEMENT SHALL BE CUT WITHOUT PERMISSION OF THE STRUCTURAL ENGINEER. PENETRATIONS THROUGH EXISTING BEAMS AND COLUMNS IS NOT PERMITTED.
- PROVIDE THE FOLLOWING ADDITIONAL DEVICES: INSTALL WHERE DIRECTED BY ARCHITECT/ENGINEER. INCLUDE CONDUIT AND WIRE AND CONNECT TO NEAREST PANELBOARD OR APPLICABLE SYSTEM AS REQUIRED. PROVIDE CUTTING AND PATCHING, AND ALL REQUIRED ACCESSORIES, AT PROJECT COMPLETION. TURN OVER ALL UNUSED DEVICES FROM LIST BELOW AND INCLUDE ON OWNER SIGN-OFF RECEIPT FOR EXTRA MATERIALS.
 - (1) FIRE-ALARM SYSTEM MANUAL FIRE-ALARM BOXES
 - (1) FIRE-ALARM SYSTEM SMOKE OR HEAT DETECTORS
 - (1) FIRE-ALARM SYSTEM DUCT SMOKE DETECTORS
 - (1) FIRE-ALARM SYSTEM VISIBLE NOTIFICATION APPLIANCES
 - (1) FIRE-ALARM SYSTEM COMBINATION HORN AND VISIBLE NOTIFICATION APPLIANCES
 - (1) FIRE-ALARM SYSTEM ADDRESSABLE INTERFACE DEVICES AND CONNECT TO INITIATE OR MONITOR DEVICES OR EQUIPMENT AS REQUIRED.
 - (2) 20 AMP CIRCUITS WITH 8 RECEPTABLES EACH, CONDUIT, WIRE, COVER PLATES, DEVICE BOXES AND CIRCUIT BREAKERS CONNECTED WITH #10, 3/4-INCH CONDUIT LOCATED WITHIN 120-FEET OF NEAREST 120V PANELBOARD.
 - (2) MOTOR CONNECTIONS, EACH WITH 30A, 2 POLE FUSIBLE SWITCH, WITH 120- FEET 3/4" IN 3/4-INCH CONDUIT.
 - (1) EXIT SIGNS.
 - (1) OCCUPANCY SENSORS, ANY TYPE AS DIRECTED BY ARCHITECT/ENGINEER.

COPYRIGHT 2025 BY FANNINGHOWEY ASSOCIATES, INC.

PHM Science and Space Exploration Center

55860 BITTERSWEET RD,
MISHAWAKA, IN 46545

\\data\chicago\files\aed\ed\humbury\documents\2025_ELEC_Bittersweet ES_aed\ed\humbury.dwg
8/13/2025 3:52:18 PM

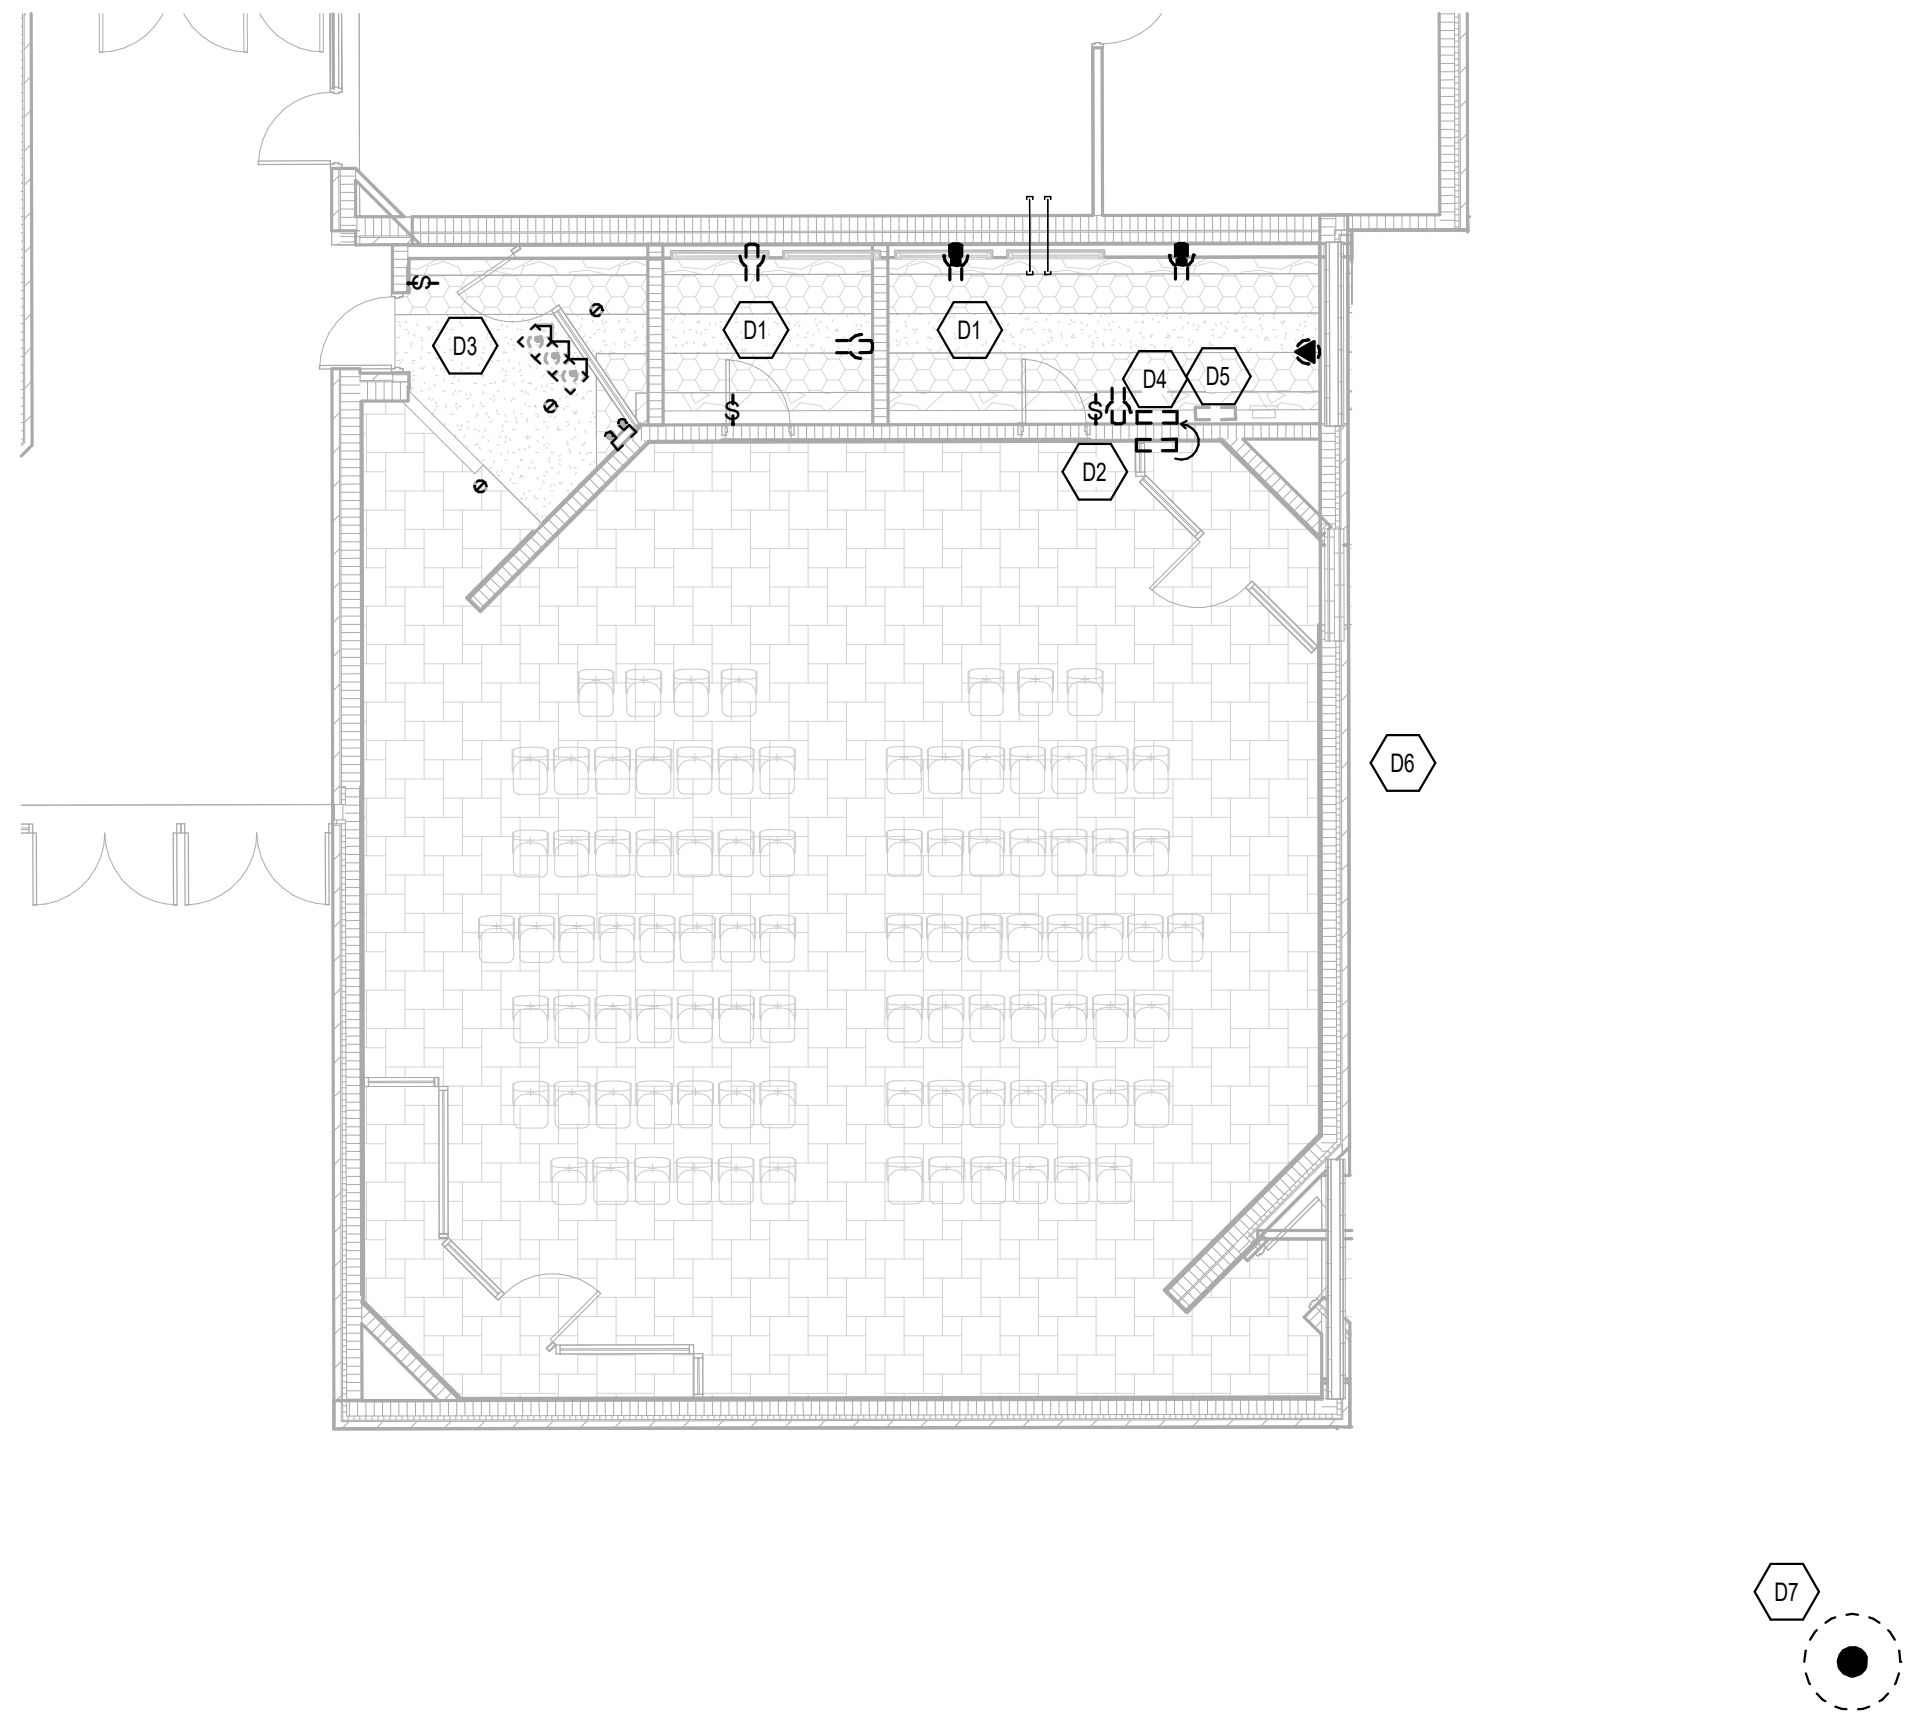

FIRST FLOOR ELECTRICAL DEMOLION PLAN

SCALE: 1/8" = 1'-0"

DEMOLITION PLAN GENERAL NOTES

1. REFER TO ELECTRICAL SPECIFICATION SECTION 260005 "ELECTRICAL DEMOLITION" FOR ADDITIONAL REQUIREMENTS REGARDING THIS DRAWING SHEET.

DEMOLITION PLAN NOTES

(ALL NOTES MAY NOT BE INDICATED ON THIS SHEET)

SHEET KEYNOTES

- | | |
|----|--|
| D1 | DISCONNECT AND REMOVE ALL EXISTING LIGHT FIXTURES, RECEPTACLES, AND THE ASSOCIATED LIGHT SWITCH IN THIS ROOM. REMOVE ALL CONDUCTORS AND CONDUITS BACK TO SOURCE. |
| D2 | DISCONNECT AND REMOVE SWITCHES FOR THE PLANETARIUM IN EXISTING WORKROOM AND EXTEND CONDUCTORS TO NEW LOCATION ON OPPOSITE SIDE OF THE WALL. SEE SHEET "E1110" FOR NEW LOCATION. |
| D3 | DISCONNECT AND REMOVE ALL EXISTING LIGHT FIXTURES, RECEPTACLES, AND LIGHT SWITCHES IN THIS ENTRYWAY THAT WILL BECOME A CORRIDOR. REMOVE ALL CONDUCTORS AND CONDUITS BACK TO SOURCE. |
| D4 | DISCONNECT AND REMOVE EXISTING PANELBOARDS "P1" AND "P1-1". EXTEND EXISTING FEEDERS TO NEW PANELBOARD LOCATIONS. SEE SHEET "E1110" FOR NEW LOCATIONS. |
| D5 | REMOVE EXISTING 12 INCH DEEP PULL BOX. RELOCATE PULL BOX ADJACENT TO NEW PANELBOARD "P1" AND "P1-1" LOCATIONS. EXTEND EXISTING CIRCUITS AND CONDUITS TO NEW LOCATION CONCEALED WITHIN NEW STUD WALL. |
| D6 | DISCONNECT AND REMOVE ANY EXISTING RECEPTACLES ON EAST-FACING EXTERIOR WALL OF PLANETARIUM. REMOVE ALL CONDUCTORS AND CONDUITS BACK TO SOURCE. |
| D7 | DISCONNECT AND REMOVE ALL WIRING TO EXISTING LIGHT POLE AT THIS LOCATION. REMOVE LIGHT FIXTURE AND POLE AND DISPOSE OF IN ACCORDANCE WITH SPEC SECTION 26 00 00. REMOVE POLE FOUNDATION AND CONDUIT TO 1'-0" BELOW GRADE. REMOVE ALL CONDUIT FROM SOURCE TO BUILDING PENETRATION. CAP AND ABANDON CONDUIT IN PLACE. MARK EXISTING BREAKER AS SPARE AND UPDATE PANEL DIRECTORY. |

VERIFICATION NOTE

CONTRACTOR SHALL VERIFY ALL DIMENSIONS AND CLEARANCES AND ALL EXISTING FIELD CONDITIONS BEFORE STARTING CONSTRUCTION. COMMENCEMENT OF WORK CONSTITUTES ACCEPTANCE OF CONDITIONS.

SHOULD DIFFERENT CONDITIONS BE ENCOUNTERED, CONTACT THE ARCHITECT BEFORE PROCEEDING WITH WORK.

COPYRIGHT 2025 BY FANNINGHOWEY ASSOCIATES, INC.

PHM Science and Space Exploration Center

55860 BITTERSWEET RD,
MISHAWAKA, IN 46545

PENN-HARRIS-MADISON SCHOOL CORPORTATION



ARCHITECT

FANNING
HOWEY



317.848.0966

350 E NEW YORK ST #300,
INDIANAPOLIS, IN 46204

WWW.FHAI.COM

EXISTING
PLANETARIUM

ADDITION

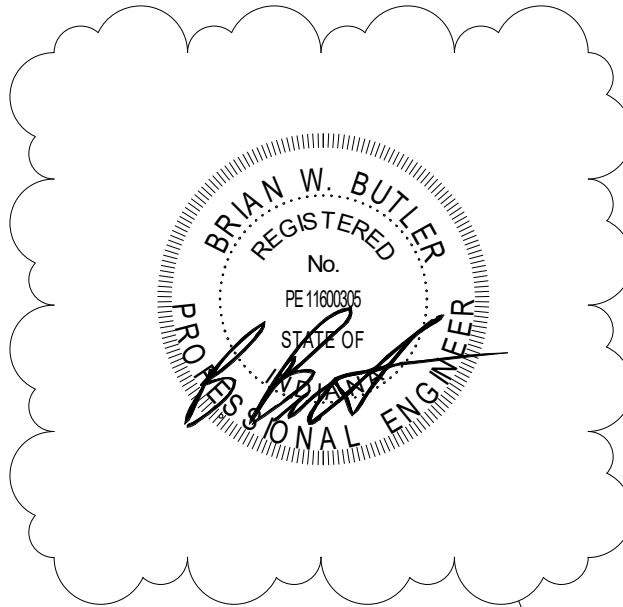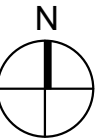

DRAWN BY: ANE

PROJECT NUMBER: 225001.00

PROJECT ISSUE DATE: 06.30.2025

REV. NO.	DESCRIPTION	DATE
2	Addendum 2	08/21/2025

ELECTRICAL DEMOLITION PLAN

ED100



LIGHTING PLAN GENERAL NOTES

- PHM Science and
Space Exploration
Center**

**PENN-HARRIS-MADISON
SCHOOL CORPORATION**

**FANNING
HOWEY**

WWW.FHAI.COM



- (ALL NOTES MAY NOT BE INDICATED ON THIS SHEET)

L1	FIXTURE TYPE "LG48-B" TO BE MOUNTED TO STRUCTURAL STEEL ABOVE AT 8'-6" AFF. MOUNTING HEIGHT MEASURED FROM BOTTOM OF STRUCTURE.
L2	FIXTURE TYPE "LG15-M" TO BE MOUNTED TO STRUCTURAL STEEL ABOVE AT 8'-6" AFF. PROVIDE UNIFORM SPACING AND MOUNTING HEIGHT MEASURED FROM BOTTOM OF STRUCTURE.
L3	ALL ROUND AND RING SURFACE MOUNTED LIGHT FIXTURES TO BE MOUNTED TO OCTAGONAL JUNCTION BOX WITH TIE BRIDGE.
L4	ALL LIGHTS IN THIS ROOM TO BE SUSPENDED FROM STRUCTURAL STEEL ABOVE UNLESS OTHERWISE NOTED.
L5	PROVIDE UNISTRUT FOR GLOBE LIGHTS IN THIS ROOM TO BE SUSPENDED FROM STRUCTURAL STEEL ABOVE.
L6	MOUNT ALL AUTOMATED FIXTURES "TLA" TO VERTICAL FACE OF COLUMNS AND EXTERIOR WALLS, 1'-0" UP FROM TOP OF GLOBE SHELF. MOUNT FIXTURES WITH UNISTRUT AND P1000 SERIES UNISTRUT TO MESA STUDS.
L7	MOUNT ALL GLOBE LIGHT FIXTURES IN THIS ROOM TO BE MOUNTING HEIGHT MEASURED FROM CENTER OF GLOBE.
L8	MOUNT ALL "TRK1", "TRK2", AND "TRK3" LIGHT TRACKS AT 10'-0" AFF.
L9	MOUNT ALL "TR12" LIGHT TRACKS IN THIS ROOM AT 15'-0" AFF.
L10	MOUNT LIGHT FIXTURE "LR32" AT 17'-0" AFF.
L11	MOUNT LIGHT FIXTURE "LP1" LIGHT FIXTURES IN THIS ROOM AT 17'-0" AFF. MOUNTING HEIGHT MEASURED FROM BOTTOM OF AFF.
L12	MOUNT LIGHT FIXTURE "LR2" AT 9'-0" AFF.
L13	MOUNT "TR12" LIGHT TRACK AT 10'-0" AFF.
L14	MOUNT "L15" SUSPENDED LIGHT FIXTURES AT 8'-0" AFF FROM CONDUIT STEMS. COORDINATE EXACT LOCATION WITH OTHER DISCIPLINES TO AVOID EQUIPMENT.
L15	MEASURE SWITCH MOUNTING HEIGHT FROM STAIR LANDINGS.
L16	PROVIDE SAME FIXTURE AS NON-EMERGENCY FIXTURES, BUT CIRCUIT ALL EMERGENCY FIXTURES (MARKED "EM") IN CORRIDORS, BATHROOMS, OFFICE WALK-IN AND MEZZANINE STAIRS, AND STAIRS. (CIRCUIT "EM" TO INCLUDE ALL EXIT SIGNS, AND PROVIDE A GENERATOR TRANSFER DEVICE FOR THE CIRCUIT TO TRANSFER TO EMERGENCY POWER.)
L17	PROVIDE SAME FIXTURE AS NON-EMERGENCY FIXTURES, BUT CIRCUIT ALL EMERGENCY FIXTURES (MARKED "EM") IN THIS ROOM TO EMERGENCY PANEL "EM1" IN L1 AND PROVIDE EMERGENCY BYPASS CONTROLLER "TBC" - SEE NOTE ON PANEL SCHEDULE.
L18	PROVIDE SAME FIXTURE AS NON-EMERGENCY FIXTURES, BUT CIRCUIT ALL EMERGENCY FIXTURES (MARKED "EM") IN THIS ROOM TO EMERGENCY PANEL "EM2" IN L1 ALONG WITH EMERGENCY BYPASS AND GENERATOR TRANSFER DEVICE. SEE NOTE ON PANEL SCHEDULE.
L19	LIGHTS IN THIS ROOM TO BE CONTROLLED VIA BUTTON STATION AND TIME/LOCK INSTEAD OF OCCUPANCY SENSOR. SEE DETAIL 1.10 ON SHEET "E-601".
L20	NEW LOCATION FOR REMOVED SWITCHES ON OPPOSITE SIDE OF WALL REFER TO EXISTING "E-602" ON SHEET "E-601".
L21	CONNECT NEW WALL MOUNTED EXTERIOR LIGHT FIXTURE SUCCESSFULLY TO EXISTING "E-602" ON SHEET "E-601". PROVIDE "E-602" ON SHEET "E-601" TO EXTERIOR LIGHTS TO CIRCUIT 2 OF PANEL "SC3" PROVIDE LIGHTING CONTRACTOR AND CONTROLS COMPATIBLE WITH EXISTING BUILDING MANAGEMENT SYSTEMS. CONTRACTOR SHALL CONNECT NEW FIXTURES SUCH THAT IN AUTOMATIC MODE THE BMS CONTROLS THE OPERATION OF THE EXTERIOR LIGHTS THROUGH INTERFACE SIGNAL, DURING LOSS OF NORMAL POWER, FIXTURE WILL COME ON TO 100% OUTPUT.
L22	MOUNT EXIST POWER SIGN TO BOTTOM OF GLOBE SHELF

REV. NO.△	DESCRIPTION	DATE
1	Addendum 1	08/12/2025
2	Addendum 2	08/21/2025

SWITCHLEG AND BRANCH CIRCUIT CONNECTIONS SHOWN GRAPHICALLY ON DRAWINGS ONLY WHERE NECESSARY FOR CLARITY. ALL LIGHT FIXTURES IN EACH ROOM ARE CONTROLLED BY SWITCH(ES) AND OCCUPANCY SENSOR(S) LOCATED IN ROOM, UNLESS OTHERWISE INDICATED. CONNECT LIGHT FIXTURES TO BRANCH CIRCUIT INDICATED BY CIRCUIT DESIGNATION IN EACH ROOM ON THE DRAWINGS, UNLESS OTHERWISE INDICATED.

DEVICES SHALL BE INSTALLED AT LOCATIONS SHOWN ON DRAWINGS. LOCATIONS OF DEVICES SHALL BE COORDINATED WITH OTHER ELECTRICAL DEVICES/CASEWORK/ARCHITECTURAL FEATURES AND OTHER TRADES PRIOR TO ROUGH-IN. IF RELOCATION OF DEVICES IS REQUIRED DUE TO LACK OF COORDINATION BETWEEN ELECTRICAL DRAWINGS AND OTHER TRADES, ANY ASSOCIATED COSTS SHALL BE RESPONSIBILITY OF ELECTRICAL CONTRACTOR.

VERIFICATION NOTE

CONTRACTOR SHALL VERIFY ALL DIMENSIONS AND CLEARANCES AND ALL EXISTING FIELD CONDITIONS BEFORE STARTING CONSTRUCTION. COMMENCEMENT OF WORK CONSTITUTES ACCEPTANCE OF CONDITIONS.


SHOULD DIFFERENT CONDITIONS BE ENCOUNTERED, CONTACT THE ARCHITECT BEFORE PROCEEDING WITH WORK.

LIGHTING PLANS


EL110

\\data\chicago\collins\aederburn\my documents\2025_ELEC_Bittersweet ES_aederburn.rvt
8/13/2025 3:52:34 PM

ROOM LEGEND			
ROOM NO.	OWNER ROOM NO.	ROOM NAME	AREA (SF)
100		VESTIBULE	117 SF
101		DISPLAY	113 SF
102		OFFICE	204 SF
103		LOBBY	222 SF
104		VESTIBULE	40 SF
105		TOILET	63 SF
106		TOILET	66 SF
108		TOILET	57 SF
109		TOILET	57 SF
110		CORRIDOR	206 SF
111		PRESENTATION	284 SF
112		WORKROOM	223 SF
113		CORRIDOR	135 SF
114		SPACE CENTER	2553 SF
115		PLANETARIUM	1486 SF
116		CORRIDOR	271 SF
201		STORAGE	1037 SF
202		STORAGE	136 SF
203		DISPLAY	177 SF
204		MECHANICAL	222 SF
205		STORAGE	204 SF
A26		OFFICE	694 SF
A27		SECURED VESTIBULE	503 SF
A28		CONFERENCE	172 SF
A29		PRINCIPAL	150 SF
A34		PE OFFICE	103 SF
A38		COURTYARD	796 SF

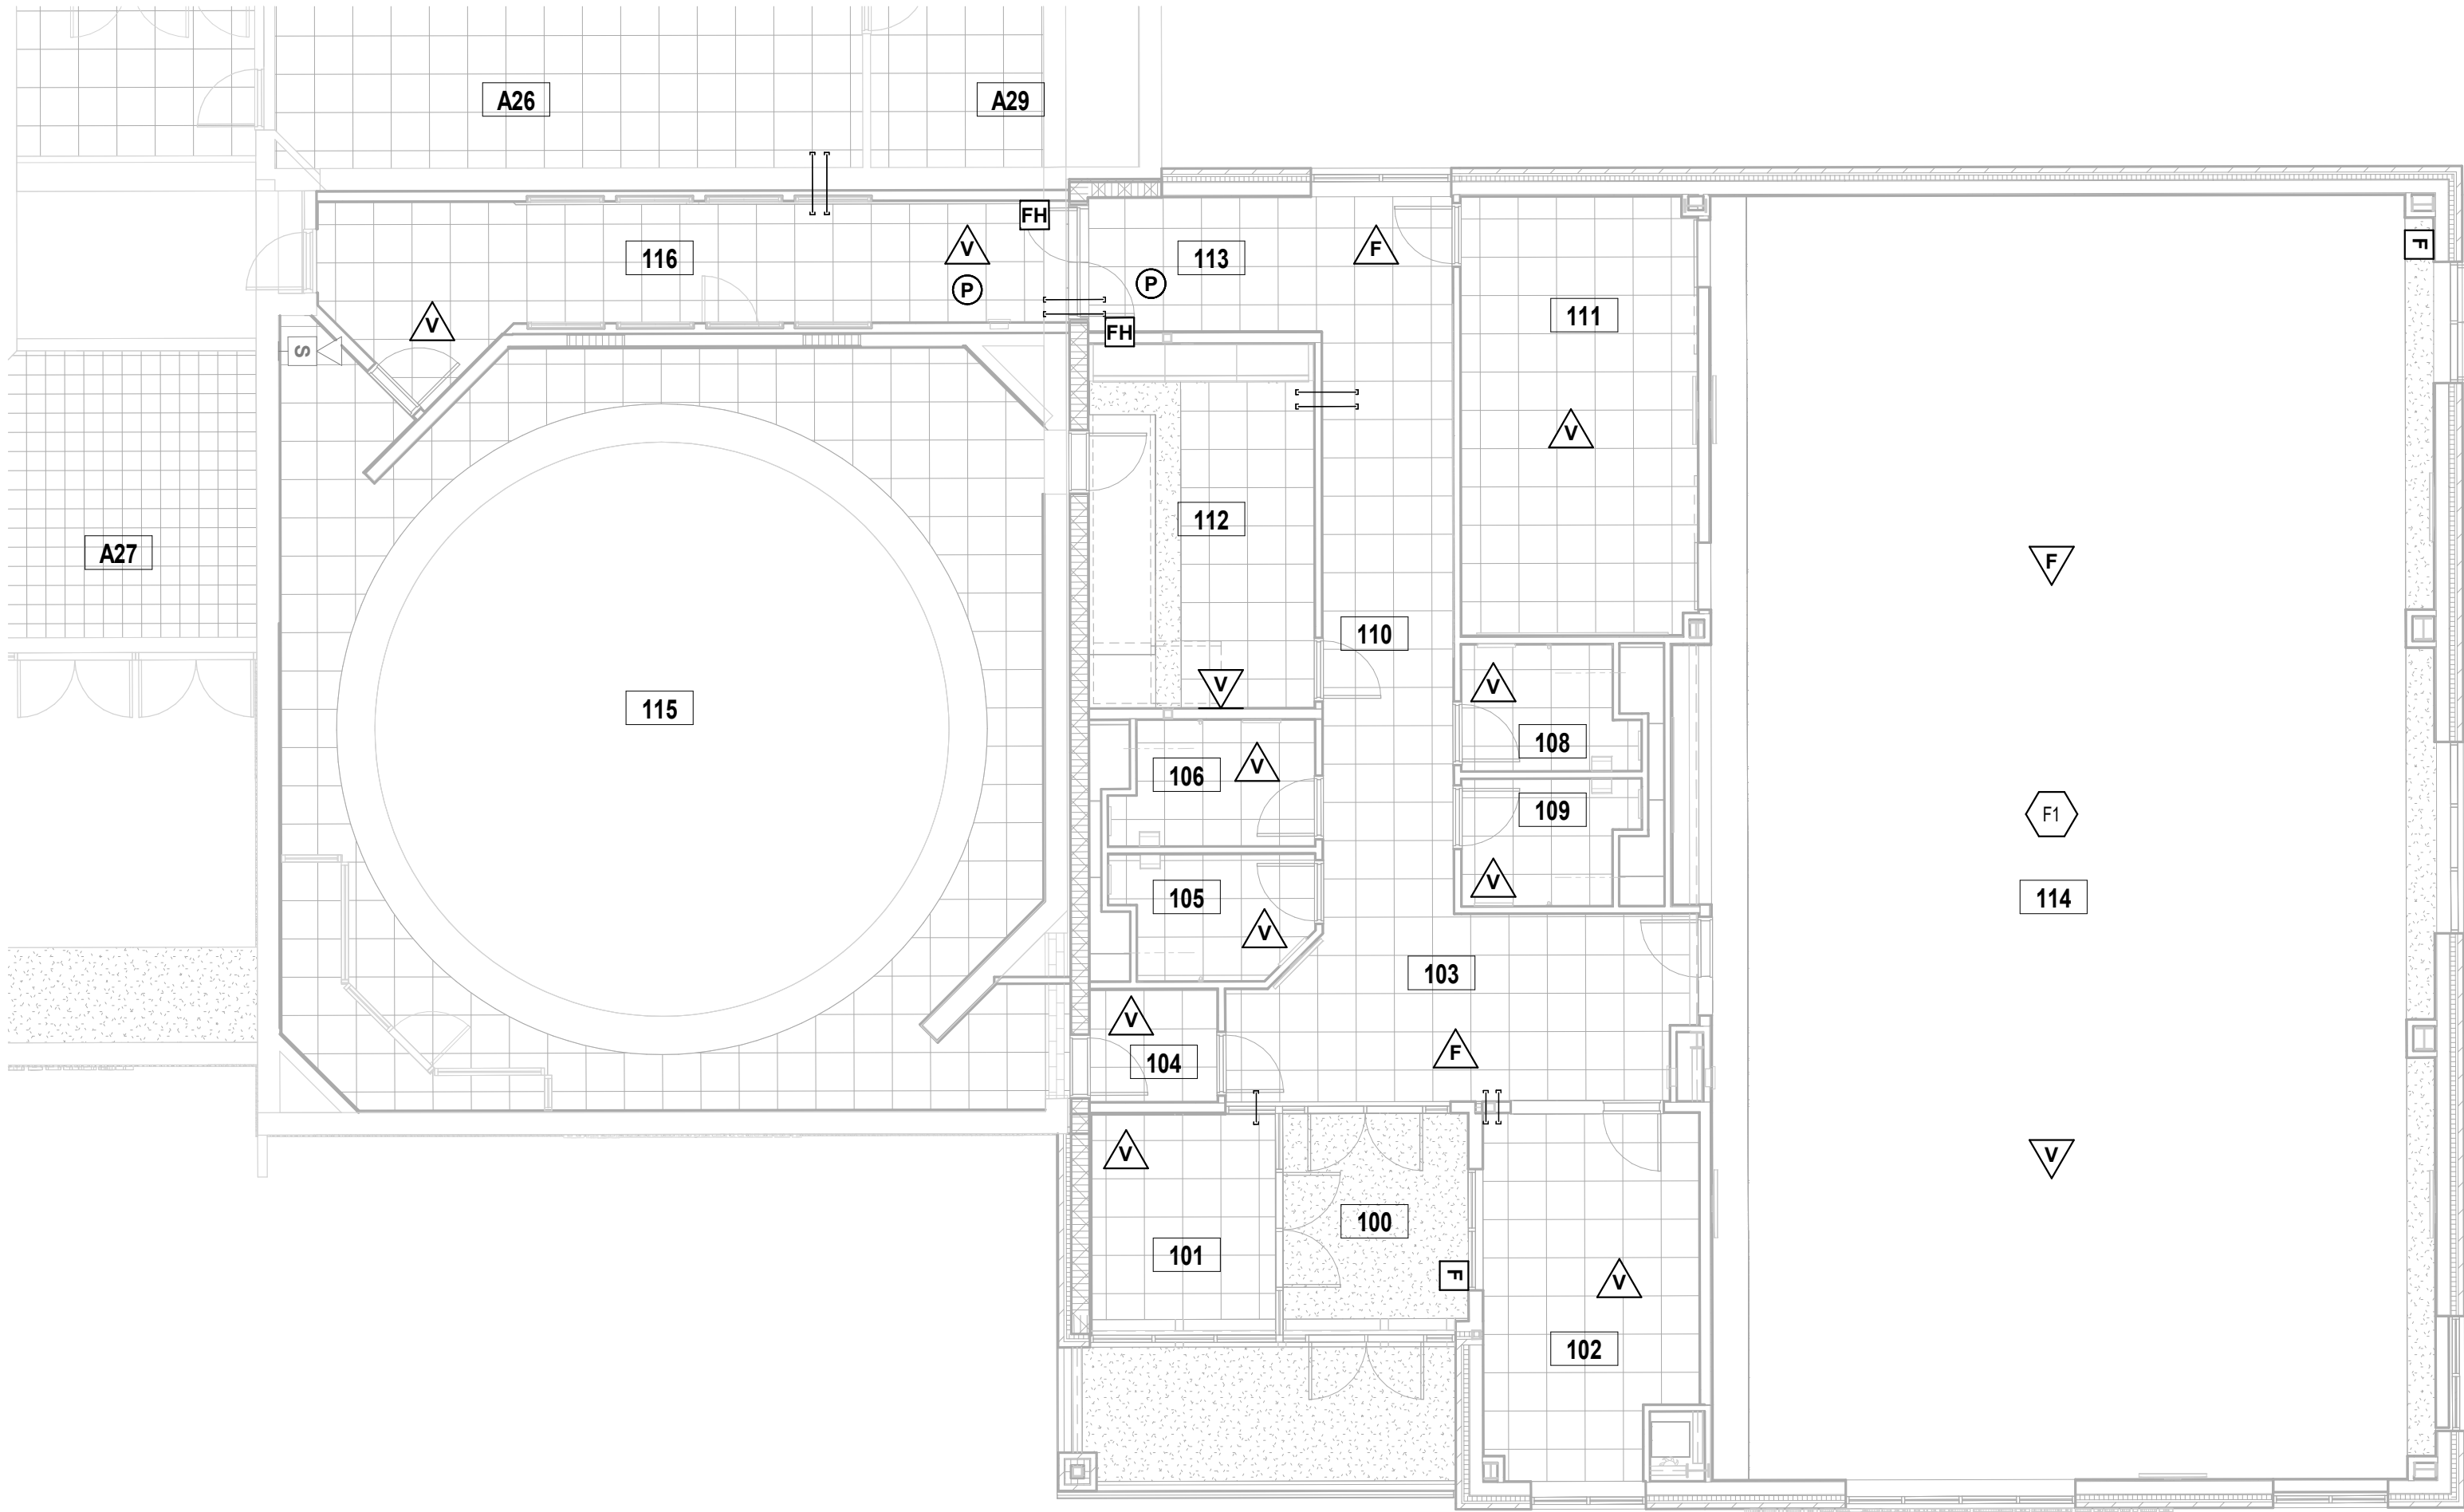

1 FIRST FLOOR FIRE ALARM PLAN
SCALE: 1/8" = 1'-0"

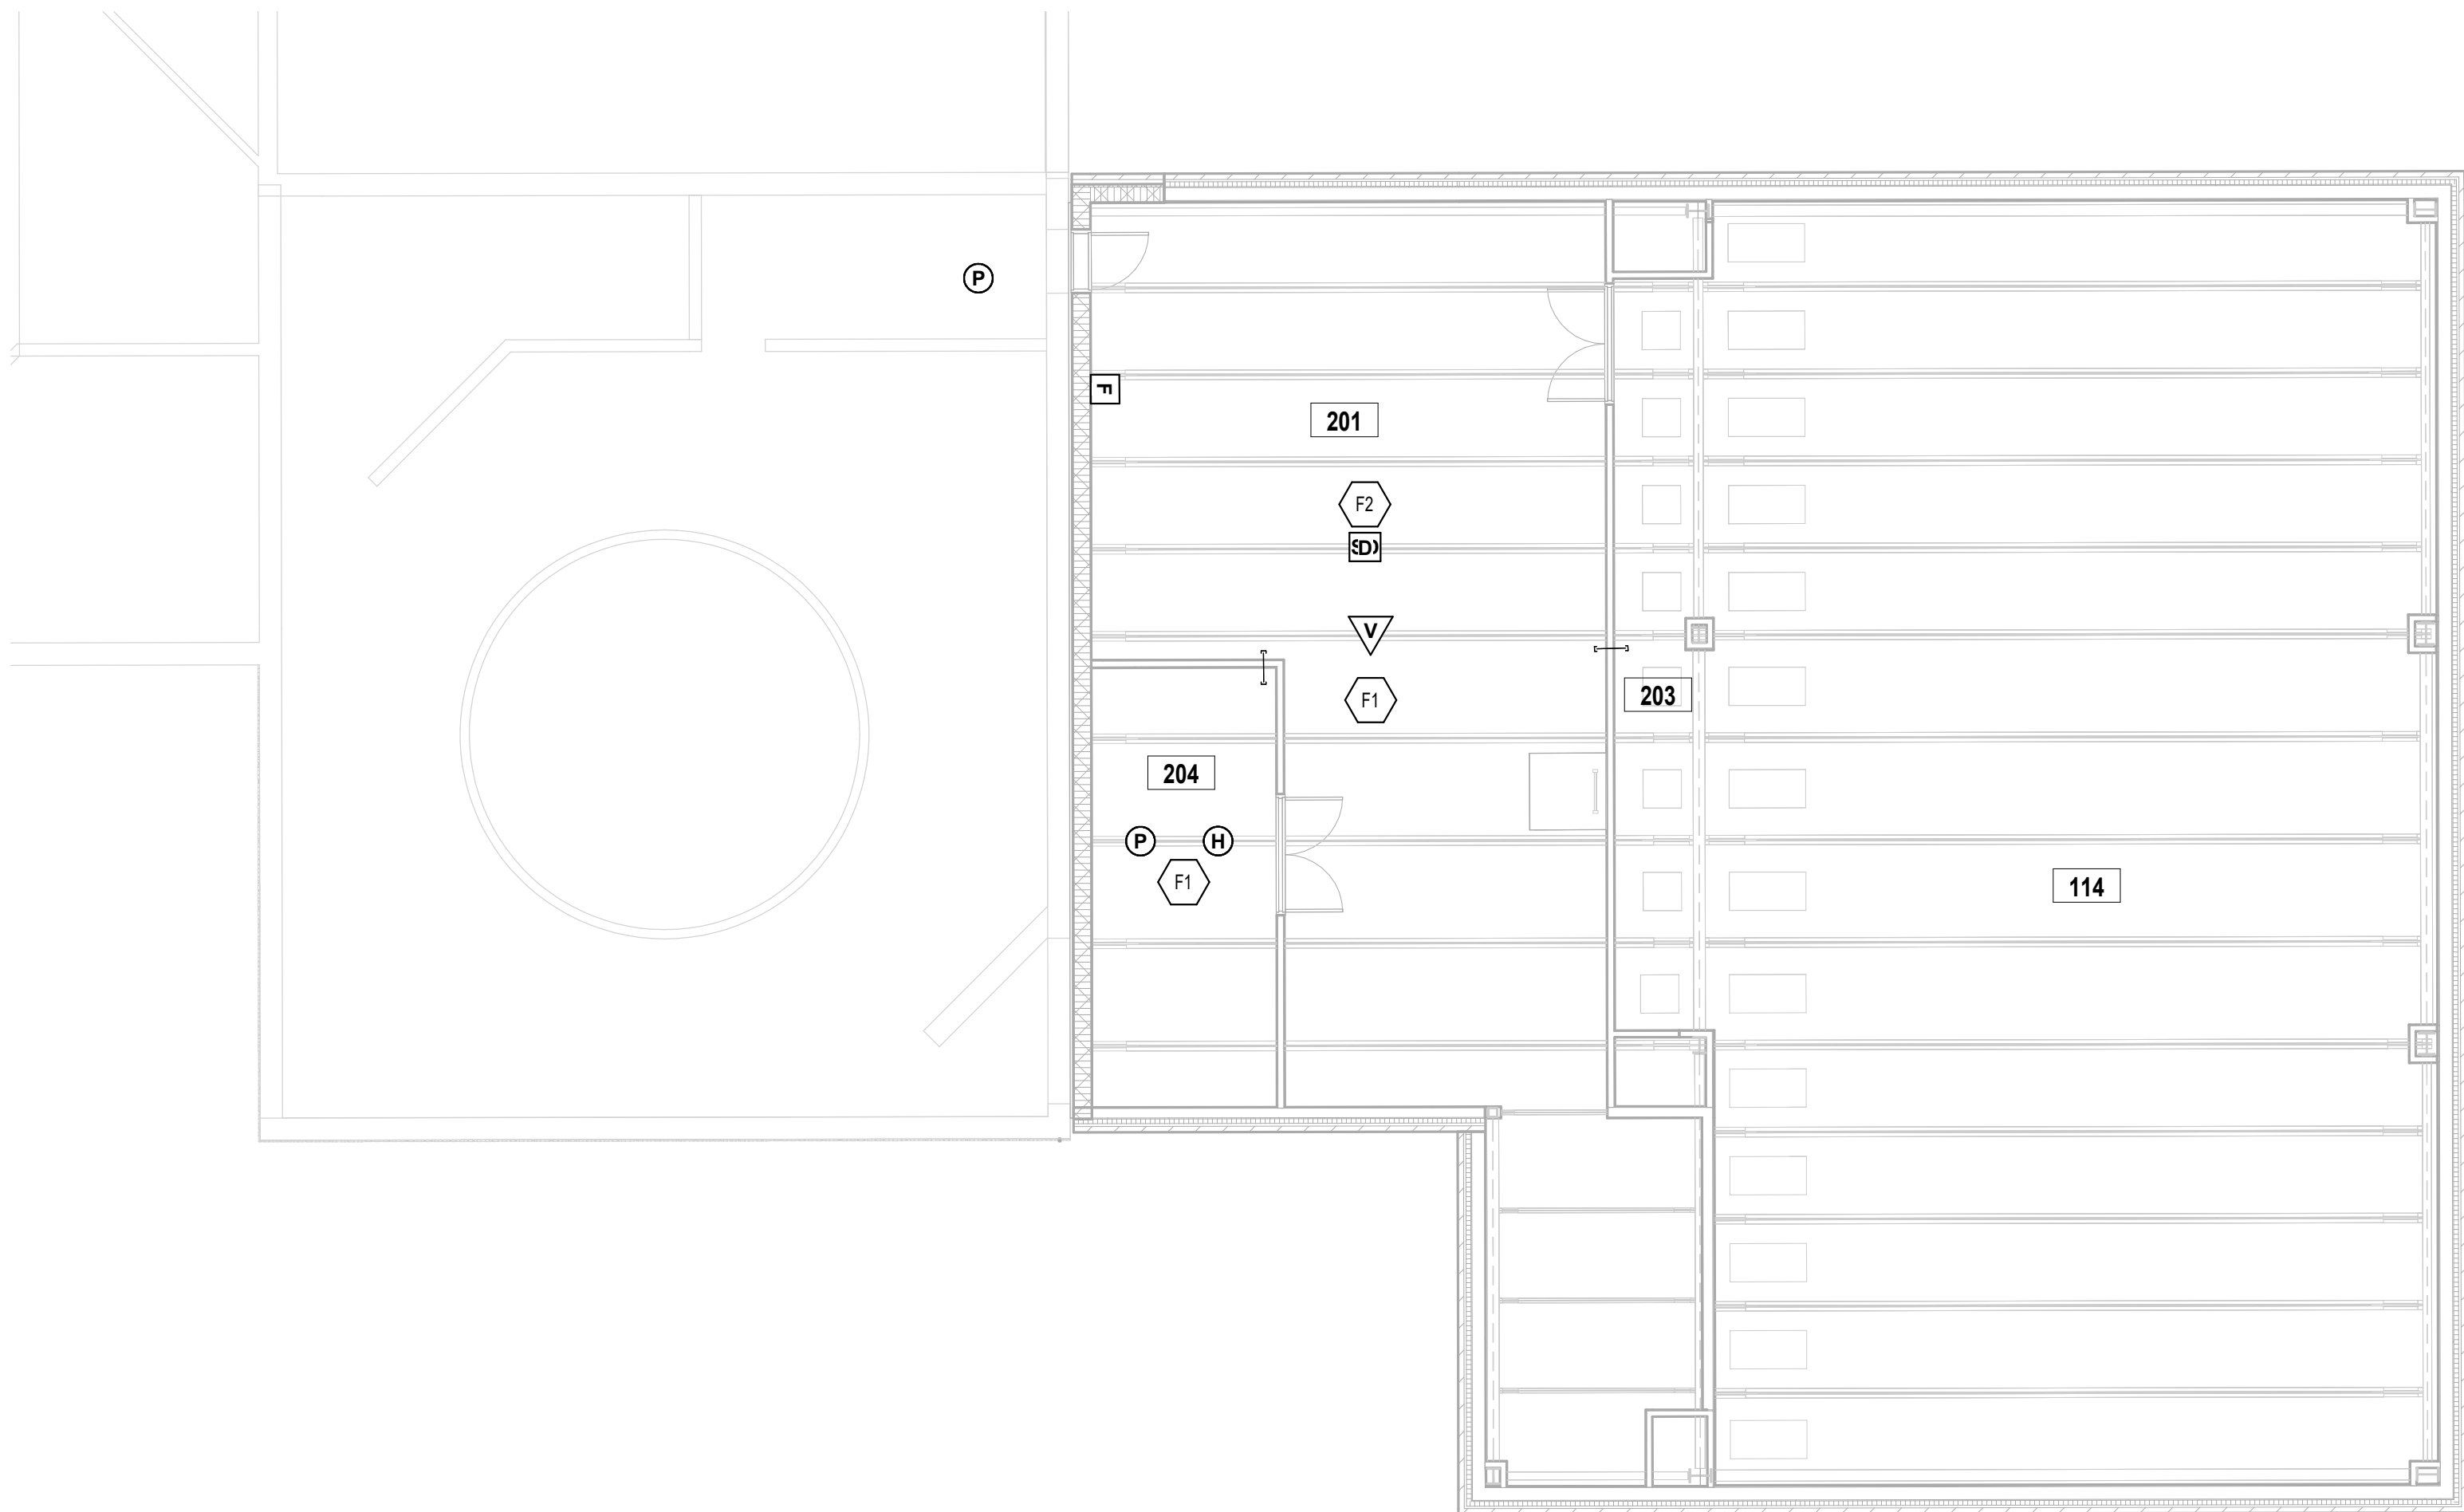

2 SECOND FLOOR FIRE ALARM PLAN
SCALE: 1/8" = 1'-0"

FIRE ALARM PLAN GENERAL NOTES

- QUANTITY AND LOCATION OF TAMPER AND FLOW SWITCHES IS FOR BIDDING PURPOSES ONLY. VERIFY EXACT QUANTITY AND LOCATIONS WITH SPRINKLER CONTRACTOR PRIOR TO FIRE ALARM SHOP DRAWING SUBMITTAL.
- NEW FIRE ALARM DEVICES TO BE CONNECTED TO EXISTING SIMPLEX FIRE ALARM PANEL.

FIRE ALARM NOTES

(ALL NOTES MAY NOT BE INDICATED ON THIS SHEET)

SHEET KEYNOTES

- | | |
|----|---|
| F1 | MOUNT FIRE ALARM DEVICES IN THIS ROOM TO BOTTOM OF STRUCTURAL JOISTS. |
| F2 | PROVIDE DUCT DETECTOR IN SUPPLY DUCT OF RTU-1. COORDINATE FINAL LOCATION WITH DIVISION 23 CONTRACTOR. |

COPYRIGHT 2025 BY FANNINGHOWEY ASSOCIATES, INC.

PHM Science and Space Exploration Center

55860 BITTERSWEET RD,
MISHAWAKA, IN 46545

PENN-HARRIS-MADISON
SCHOOL CORPORTATION






ARCHITECT

**FANNING
HOWEY**

317.848.0966

WWW.FHAI.COM

350 E NEW YORK ST #300,
INDIANAPOLIS, IN 46204

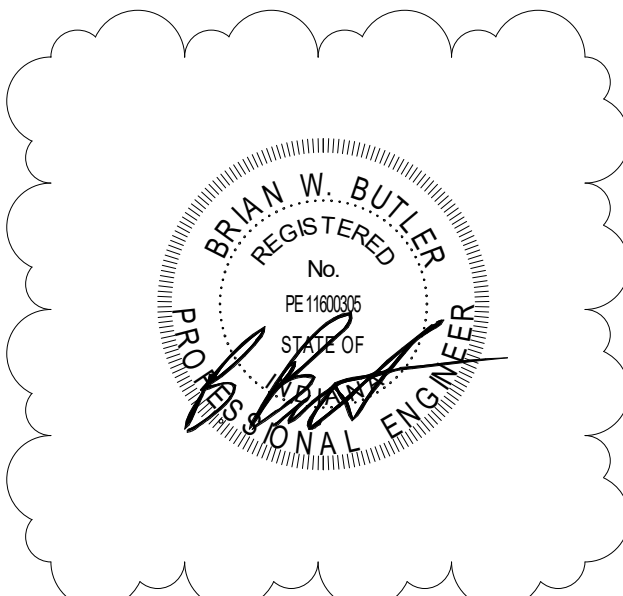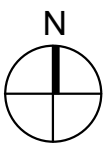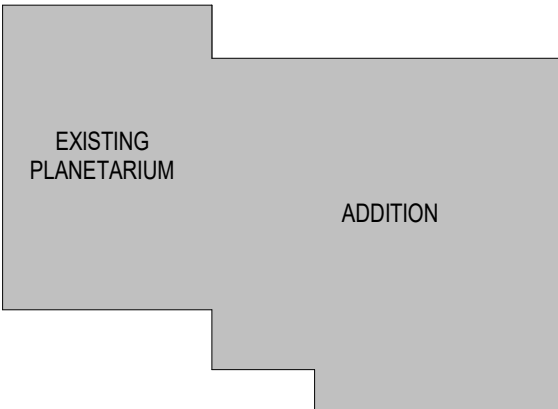

DRAWN BY: ANE

PROJECT NUMBER: 225001.00

PROJECT ISSUE DATE: 06.30.2025

REV. NO.	DESCRIPTION	DATE
2	Addendum 2	08/21/2025

VERIFICATION NOTE

CONTRACTOR SHALL VERIFY ALL DIMENSIONS AND CLEARANCES AND ALL EXISTING FIELD CONDITIONS BEFORE STARTING CONSTRUCTION. COMMENCEMENT OF WORK CONSTITUTES ACCEPTANCE OF CONDITIONS.

SHOULD DIFFERENT CONDITIONS BE ENCOUNTERED, CONTACT THE ARCHITECT BEFORE PROCEEDING WITH WORK.


FIRE ALARM PLANS

EF100


1. PROVIDE RELAY PACKS AS REQUIRED TO PERFORM NECESSARY SEQUENCE OF OPERATIONS FOR EACH LISTED.
2. PROVIDE LOW VOLTAGE WIRING PER MANUFACTURERS RECOMMENDATION.
3. ALL SWITCHES SHALL BE DECOR STYLE.
4. WHERE MULTIPLE CONTROL SWITCHES ARE IN THE SAME LOCATION, THEY SHALL BE IN THE SAME BACK BOX WITH SINGLE FACE PLATE
5. QUANTITY OF OCCUPANCY/VACANCY SENSORS, DAYLIGHT SENSORS AND SWITCHES SHALL BE PER PLANS.

1. PROVIDE RELAY PACKS AS REQUIRED TO PERFORM NECESSARY SEQUENCE OF OPERATIONS FOR EACH LISTED.
2. PROVIDE LOW VOLTAGE WIRING PER MANUFACTURERS RECOMMENDATION.
3. ALL SWITCHES SHALL BE DECOR STYLE.
4. WHERE MULTIPLE CONTROL SWITCHES ARE IN THE SAME LOCATION, THEY SHALL BE IN THE SAME BACK BOX WITH SINGLE FACE PLATE
5. QUANTITY OF OCCUPANCY/VACANCY SENSORS, DAYLIGHT SENSORS AND SWITCHES SHALL BE PER PLANS.


1. SYSTEM SHALL BE SET UP SUCH THAT LIGHTING IS CONTROLLED BY A TIME/CLOCK, ALLOWING FOR AUTOMATIC SHUT OFF OF FIXTURES OVERNIGHT. EXACT TIMES TO BE COORDINATED WITH OWNER.
2. A DEFAULT PRESET WILL BE SET IN COORDINATION WITH THE CONSULTANT AND ADDITIONAL PRESETS AND SEQUENCES WILL BE PLAYABLE VIA THE TOUCH SCREENS AND CONTROL STATIONS.
3. EMERGENCY FIXTURES SHALL OPERATE AS DESCRIBED ABOVE DURING NORMAL OPERATIONS. IN EMERGENCY SCENARIO TRIGGERED BY NORMAL POWER LOSS, FIXTURES WILL COME ON AT 100% OUTPUT. THIS WILL BE ACHIEVED WITH AN EMERGENCY BYPASS DETECTION KIT AND CONTROLLER AS SHOWN IN THE LIGHTING CONTROL RISER DIAGRAM ON SHEET "E-702".

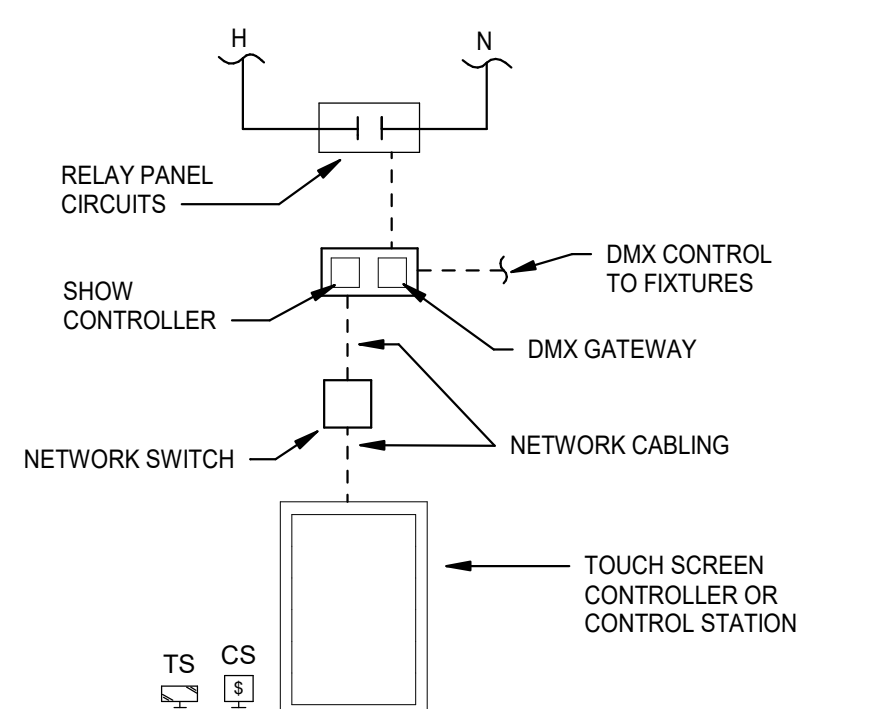


1. SYSTEM SHALL BE SET UP SUCH THAT LIGHTING SHALL OPERATE WITH THE CONTROLS OF THE NORMAL LIGHTING IN THE SPACE. IN AN EMERGENCY SCENARIO TRIGGERED BY NORMAL POWER LOSS, THE EMERGENCY FIXTURES WILL COME ON AT 100%.
2. THE DIAGRAM BELOW INDICATES WIRING FOR EMERGENCY FIXTURES NOT CONTROLLED BY THE SPACE CENTER SHOW CONTROL SYSTEM SHOWN ON SHEET 'E-702'.

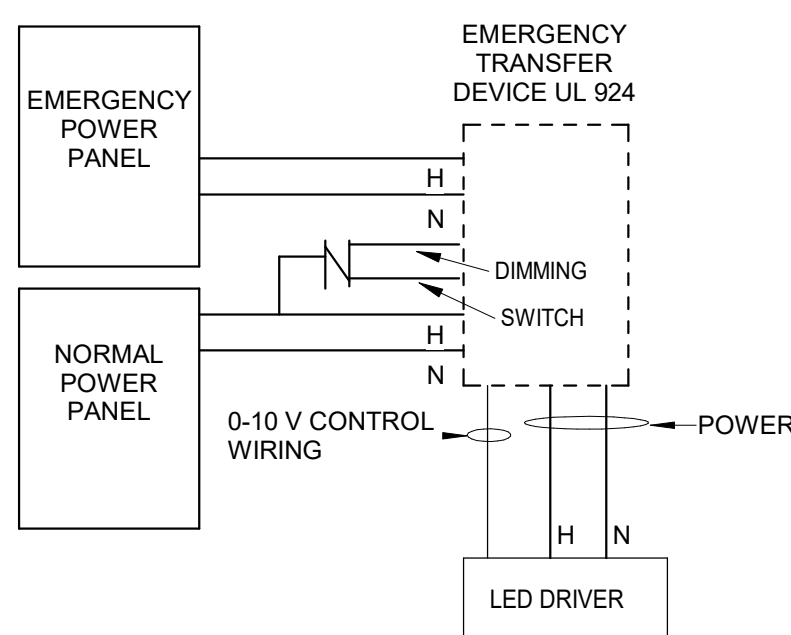

1. SYSTEM SHALL BE SET UP SUCH THAT LIGHTING IS AUTOMATICALLY SWITCHED ON BY OCCUPANCY SENSOR THEN SWITCHED OFF BY OCCUPANCY SENSOR AFTER 15 MINUTES OF ROOM VACANCY.
2. WALL SWITCH SHALL OVERRIDE FIXTURES ON/OFF FOR 15 MINUTES, AT WHICH TIME OCCUPANCY SENSORS WILL REIGN PRECEDENCE.
3. ONCE LIGHTING IS SWITCHED ON, LIGHTS MAY BE DIMMED THROUGH RAISE/LOWER BUTTONS OR WALL SWITCH.
4. EMERGENCY FIXTURES SHALL OPERATE AS DESCRIBED ABOVE DURING NORMAL OPERATIONS. IN AN EMERGENCY SCENARIO TRIGGERED BY NORMAL POWER LOSS, FIXTURES WILL COME ON AT 100% OUTPUT. THIS SHALL BE ACHIEVED WITH FULL CIRCUIT GENERATOR TRANSFER DEVICE.

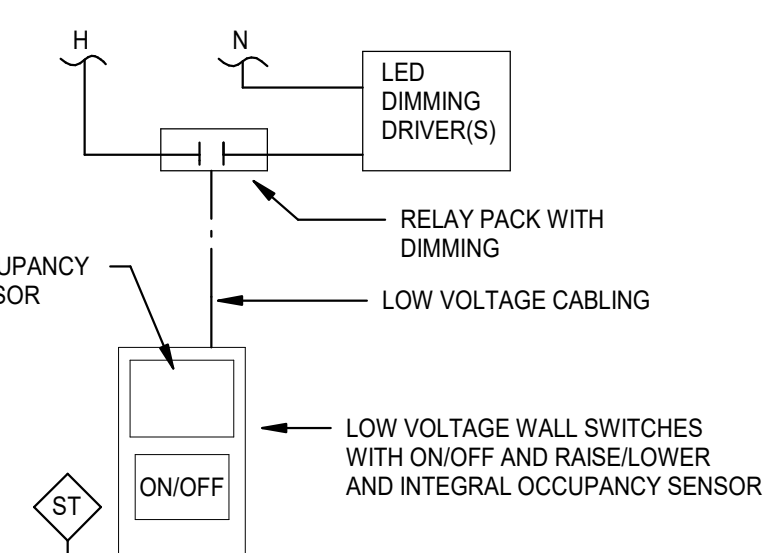


1. SYSTEM SHALL BE SET UP SUCH THAT LIGHTING IS AUTOMATICALLY SWITCHED ON BY OCCUPANCY SENSOR THEN SWITCHED OFF AFTER 15 MINUTES OF VACANCY.
2. HALLWAY LIGHTS SHALL BE CONTROLLED IN ZONES WITH ONE OCCUPANCY SENSOR PER ZONE.
3. WALL SWITCH SHALL OVERRIDE FIXTURES ON/OFF FOR 15 MINUTES, AT WHICH TIME OCCUPANCY SENSORS WILL REGAIN PRECEDENCE.
4. EMERGENCY FIXTURES SHALL OPERATE AS DESCRIBED ABOVE DURING NORMAL OPERATIONS. IN AN EMERGENCY SCENARIO TRIGGERED BY NORMAL POWER LOSS, FIXTURES WILL COME ON AT 100% OUTPUT. THIS CAN BE ACHIEVED WITH FULL CIRCUIT GENERATOR TRANSFER DEVICE.

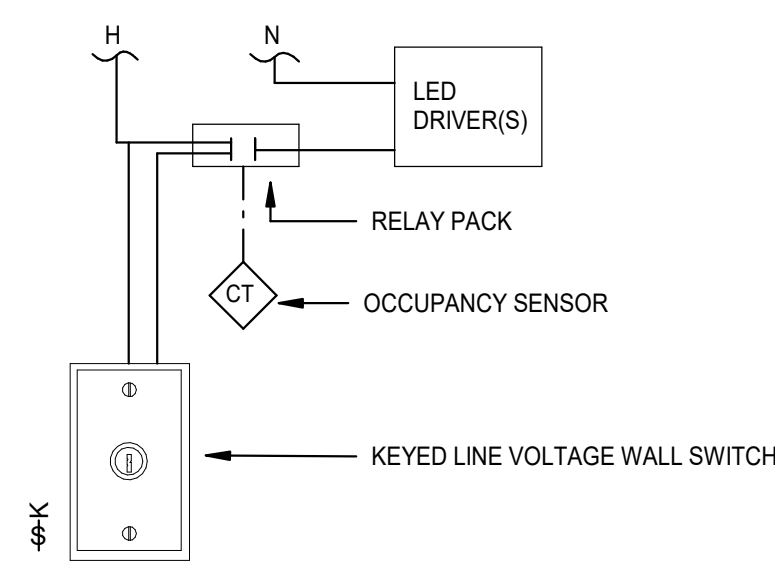


2 LIGHTING CONTROLS - EMERGENCY

4 LIGHTING CONTROLS - CORRIDORS & LOBBIES

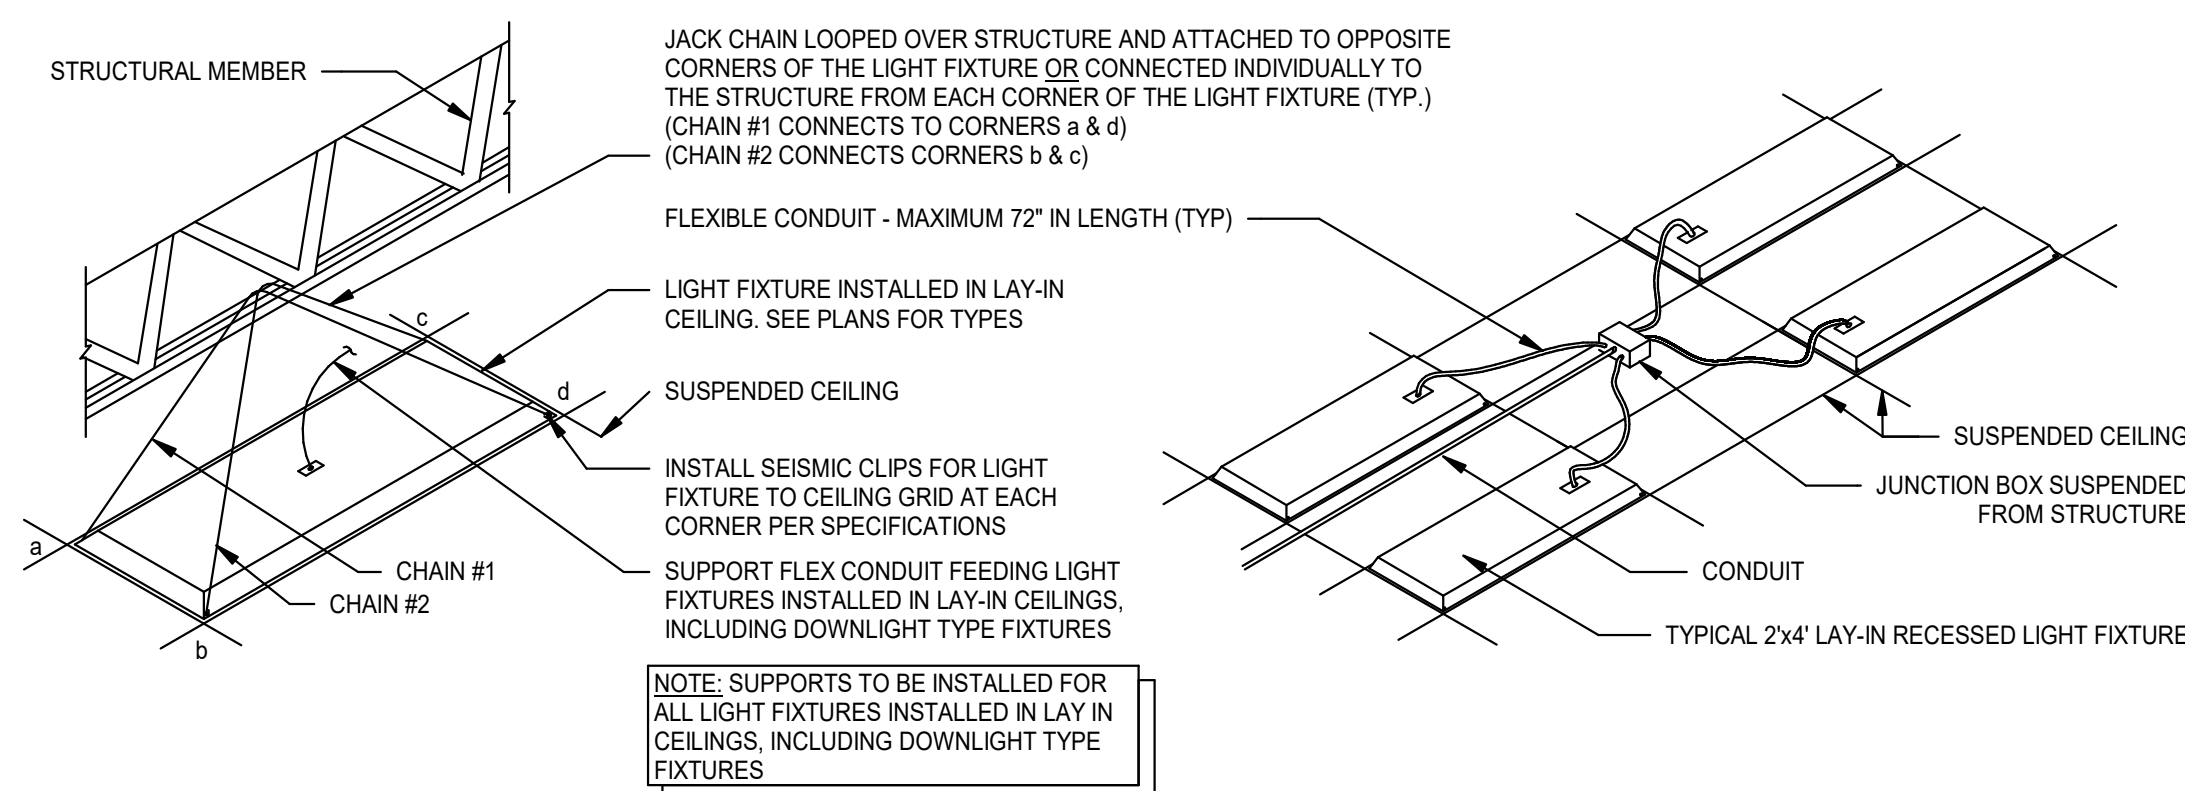


6 2.5" & UP CONDUIT SUPPORT DETAIL

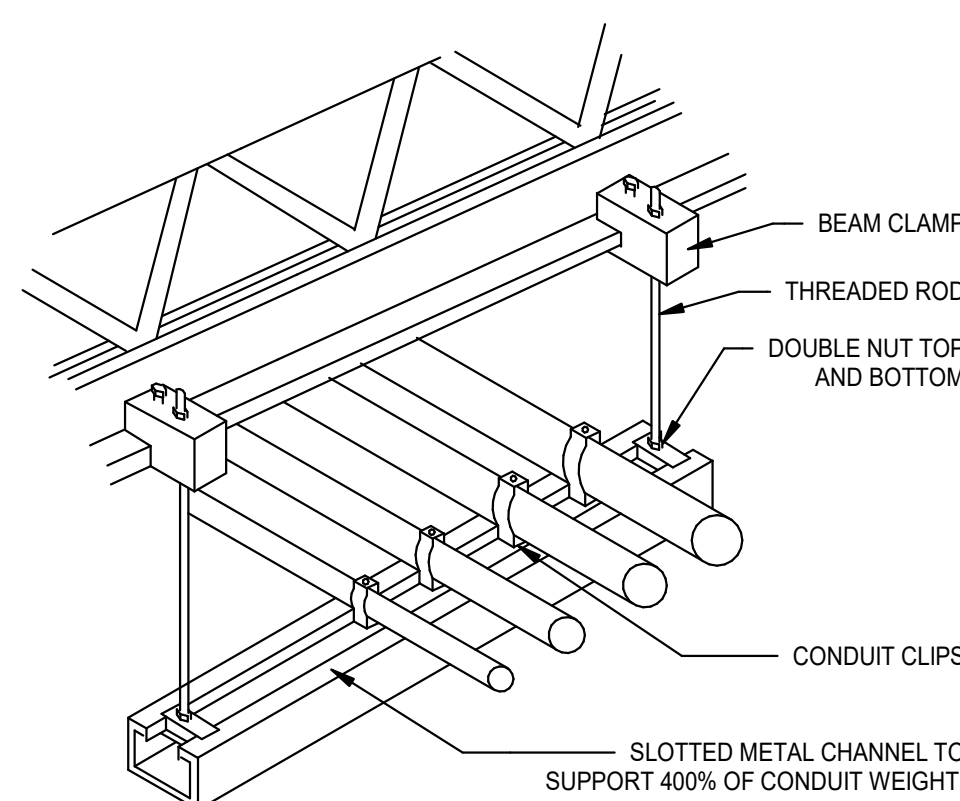


#	NOTE
---	------

- A GROUNDING ELECTRODE CONDUCTOR, BARE, TINNED, STRANDED,
COPPER-CONDUCTOR, (30 INCHES BELOW GRADE, MIN.) (24 INCHES FROM
MINIMUM 1/8" MIN. AIR SPACE) TO THE MAIN SERVICE PANEL, USE #6
AWG. FOR ELECTRICAL SERVICE GREATER THAN 800 AMP USE #4WG AWG.
- B GROUNDING CONDUCTOR, 20 AWG BARE, TINNED, STRANDED,
COPPER-CONDUCTOR
- C IRREVERSIBLE COPPER COMPRESSION CONNECTOR (CABLE TO CABLE)
- H PROVIDE UL 467 LISTED COMPRESSION CONNECTORS, TWO-HOLE LUGS.
SYSTEM BONDING JUMPER CONDUCTOR, SYSTEM BONDING JUMPER
CONDUCTOR, (SEE DIAGRAM FOR LOCATION OF SYSTEM BONDING CONNECTORS
BETWEEN TRANSFORMER AND MAIN SECONDARY DISTRIBUTION. (REFER TO
ONE LINE DIAGRAM FOR SIZE).
USED IF PROVIDED WITH PROTECTIVE COATING.
- M EQUIPMENT GROUNDING CONDUCTOR (REFER TO ONE LINE DIAGRAM FOR
CONDUCTOR SIZE).
- N TELECOMMUNICATIONS BONDING BACKBONE (#40 AWG STRANDED BARE)
FLUOR POLYMER GROUNDING CONDUCTORS IN A 464L CONDUIT.
- R PROVIDE UL 467 LISTED, ELECTRO-TIN PLATED COPPER BUSBAR, 2" x 12" x 1/4"
WITH (12-INCH INSULATED STANDING SUPPORTS) PROVIDED ENGRAVED
TWO-HOLE TAPPED SIDEWAYS. SECURELY CLAMP ALL WIRING TO THE BAR
ENDING, "IF THESE CONNECTORS OR CABLES ARE LOOSE OR MUST BE
REMOVED, REUSE CABLE CLAMP OR TELECOM TERMINAL BLOCK WHEN NEARBY."
- T CONTACTS, UNSUPPLIED BONDING CONDUCTOR FOR TELECOMMUNICATIONS
20 AWG BARE, TINNED, STRANDED, COPPER-CONDUCTOR IN CABLE TRAYS.
PROVIDE WRAP AROUND PLASTIC LABEL ON EACH CONDUCTOR AT GROUND

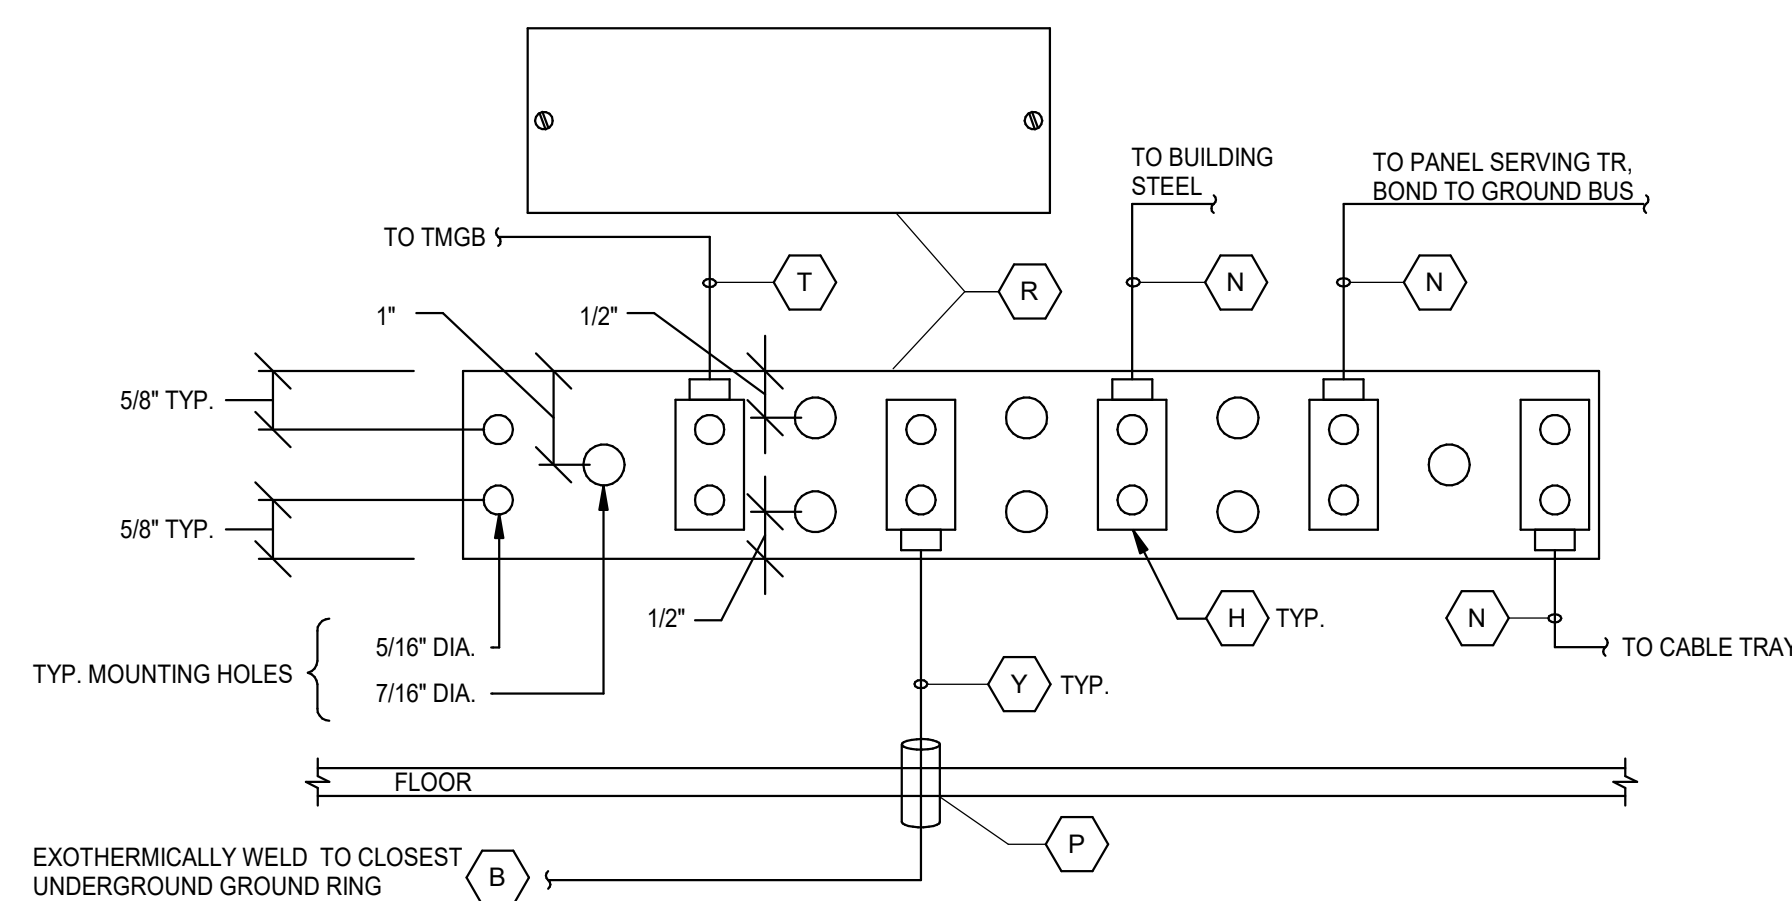

8 DISTRIBUTION TRANSFORMER GROUNDING
DETAIL
NOT TO SCALE

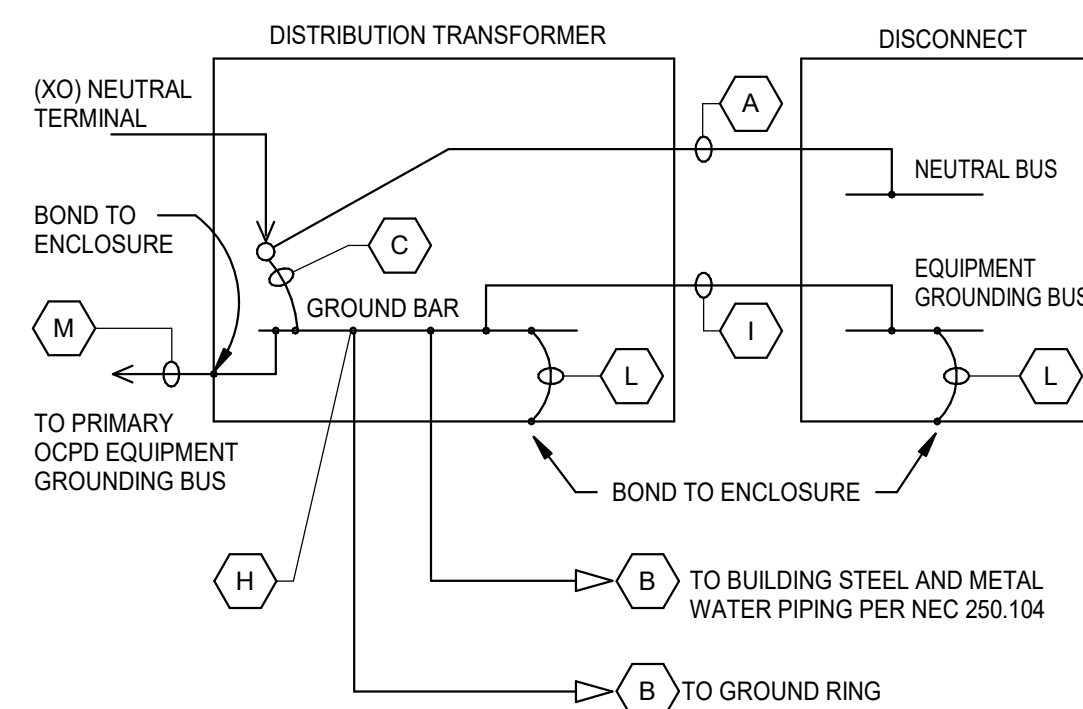

8 DETAIL
NOT TO SCALE

COPYRIGHT 2025 BY FANNING/HOWEY ASSOCIATES, INC.

55860 BITTERSWEET RD,
MISHAWAKA, IN 46545

**PENN-HARRIS-MADISON
SCHOOL CORPORTATION**



ARCHITECT

**FANNING
HOWEY**

317 848 0966

WWW.FHAI.COM

350 E NEW YORK ST #300
INDIANAPOLIS, IN 46204

DRAWN BY: ANE

PROJECT NUMBER: 225001.00

PROJECT ISSUE DATE: 06/30/2025

[illegible]

ELECTRICAL DETAILS AND SEQUENCE OF OPERATIONS

E-501

\\data\chrisproffice\baedenshurn\documents\2023_ELEC_Bittersweet ES_aedenshurn.rvt
8/20/2025 12:29:37 PM

LUMINAIRE SCHEDULE								
LABEL	QTY	MOUNTING	DESCRIPTION	MANUFACTURER & SERIES	ACCESSORIES	FIXTURE SPECS		
						LUMENS	VOLTAGE	VA LOAD
BP2X	1	SURFACE WALL	LED EMERGENCY LIGHTING UNIT WITH BARREL SHAPED ALUMINUM HOUSING AND SELF-DIAGNOSTICS. BLACK	SURE-LITES ATLITE SELAM OR A/E APPROVED EQUAL		0 lm	277 V	11 VA
LD6	4	SURFACE CEILING	6 INCH DIAMETER ROUND DISC FIXTURE WITH ALUMINUM BASE AND FLAT ACRYLIC LENS, 80+ CRI, 4000K CCT, 0-10VDC DIMMING.	CAMMAN LIGHTING HEINZ MARK ARCHITECTURAL LIGHTING	ABOVE CEILING JUNCTION BOX TILE BRIDGE	2000 lm	277 V	20 VA
LD6-2	9	SURFACE CEILING	6 INCH DIAMETER ROUND DISC FIXTURE WITH 2" DEEP (MAX.) BASE AND FLAT ACRYLIC LENS, 90+ CRI, 4000K CCT, 0-10VDC DIMMING.	CAMMAN LIGHTING MARK ARCHITECTURAL LIGHTING OR A/E APPROVED EQUAL	ABOVE CEILING JUNCTION BOX TILE BRIDGE	2000 lm	120 V	20 VA
LD8	1	SURFACE CEILING	8 INCH DIAMETER ROUND DISC FIXTURE WITH ALUMINUM BASE AND FLAT ACRYLIC LENS, 80+ CRI, 4000K CCT, 0-10VDC DIMMING.	CAMMAN LIGHTING HEINZ MARK ARCHITECTURAL LIGHTING	ABOVE CEILING JUNCTION BOX TILE BRIDGE	2000 lm	277 V	20 VA
LD10	2	SURFACE CEILING	10 INCH DIAMETER ROUND DISC FIXTURE WITH ALUMINUM BASE AND FLAT ACRYLIC LENS, 80+ CRI, 4000K CCT, 0-10VDC DIMMING.	CAMMAN LIGHTING HEINZ MARK ARCHITECTURAL LIGHTING	ABOVE CEILING JUNCTION BOX TILE BRIDGE	2000 lm	277 V	25 VA
LD12	2	SURFACE CEILING	14 INCH DIAMETER ROUND DISC FIXTURE WITH ALUMINUM BASE AND FLAT ACRYLIC LENS, 80+ CRI, 4000K CCT, 0-10VDC DIMMING.	CAMMAN LIGHTING HEINZ MARK ARCHITECTURAL LIGHTING	ABOVE CEILING JUNCTION BOX TILE BRIDGE	2000 lm	277 V	25 VA
LD14	3	SURFACE CEILING	14 INCH DIAMETER ROUND DISC FIXTURE WITH ALUMINUM BASE AND FLAT ACRYLIC LENS, 80+ CRI, 4000K CCT, 0-10VDC DIMMING.	CAMMAN LIGHTING HEINZ MARK ARCHITECTURAL LIGHTING	ABOVE CEILING JUNCTION BOX TILE BRIDGE	2000 lm	277 V	30 VA
LD16	4	SURFACE CEILING	16 INCH DIAMETER ROUND DISC FIXTURE WITH ALUMINUM BASE AND FLAT ACRYLIC LENS, 80+ CRI, 4000K CCT, 0-10VDC DIMMING.	CAMMAN LIGHTING HEINZ MARK ARCHITECTURAL LIGHTING	ABOVE CEILING JUNCTION BOX TILE BRIDGE	2000 lm	277 V	35 VA
LD18	3	SURFACE CEILING	18 INCH DIAMETER ROUND DISC FIXTURE WITH ALUMINUM BASE AND FLAT ACRYLIC LENS, 80+ CRI, 4000K CCT, 0-10VDC DIMMING.	CAMMAN LIGHTING HEINZ MARK ARCHITECTURAL LIGHTING	ABOVE CEILING JUNCTION BOX TILE BRIDGE	2000 lm	277 V	40 VA
LD20	4	SURFACE CEILING	20 INCH DIAMETER ROUND DISC FIXTURE WITH ALUMINUM BASE AND FLAT ACRYLIC LENS, 80+ CRI, 4000K CCT, 0-10VDC DIMMING.	CAMMAN LIGHTING HEINZ MARK ARCHITECTURAL LIGHTING	ABOVE CEILING JUNCTION BOX TILE BRIDGE	2000 lm	277 V	55 VA
LD22	3	SURFACE CEILING	22 INCH DIAMETER ROUND DISC FIXTURE WITH ALUMINUM BASE AND FLAT ACRYLIC LENS, 80+ CRI, 4000K CCT, 0-10VDC DIMMING.	CAMMAN LIGHTING HEINZ MARK ARCHITECTURAL LIGHTING	ABOVE CEILING JUNCTION BOX TILE BRIDGE	2000 lm	277 V	70 VA
LD24	1	SURFACE CEILING	24 INCH DIAMETER ROUND DISC FIXTURE WITH ALUMINUM BASE AND FLAT ACRYLIC LENS, 80+ CRI, 4000K CCT, 0-10VDC DIMMING.	CAMMAN LIGHTING HEINZ MARK ARCHITECTURAL LIGHTING	ABOVE CEILING JUNCTION BOX TILE BRIDGE	2000 lm	277 V	85 VA
LD61	6	RECESSED	6-INCH ROUND APERTURE OPEN REFLECTOR LED DOWNLIGHT, MEDIUM DISTRIBUTION, CLEAR SPECULAR FINISH, SELF-FLANGED, 4000K CCT, 80+ CRI, 0-10VDC DIMMING	PORTFOLIO LS6C LITHONIA LDN6	BAR HANGER ACCESSORY	2000 lm	277 V	22 VA
LDW61	3	RECESSED	6-INCH ROUND APERTURE LED WET RATED LIGHT WITH REGRESSED LENS REFLECTOR, BLACK REFLECTOR AND TRIM, SELF-FLANGED, IP65 WET LOCATION LISTED.	PORTFOLIO LS6C LITHONIA LDN6		1500 lm	277 V	15 VA
LG2	1	PENDANT	2 INCH DIAMETER LED GLOBE FIXTURE, STEM HUNG, RGBW OR ORANGE TINTED DIFFUSER, 90+ CRI, DMX OR 1% 0-10VDC DIMMING.	CAMMAN LIGHTING MASON II	ALL CABLE AND EQUIPMENT NECESSARY FOR COMPLETE INSTALLATION	500 lm	120 V	5 VA
LG2-2	1	PENDANT	2 INCH DIAMETER LED GLOBE FIXTURE, STEM HUNG, RGBW OR RED TINTED DIFFUSER, 90+ CRI, DMX OR 1% 0-10VDC DIMMING.	CAMMAN LIGHTING MASON II	ALL CABLE AND EQUIPMENT NECESSARY FOR COMPLETE INSTALLATION	500 lm	120 V	5 VA
LG3	1	PENDANT	3 INCH DIAMETER LED GLOBE FIXTURE, STEM HUNG, RGBW OR WARN WHITE TINTED DIFFUSER, 90+ CRI, DMX OR 1% 0-10VDC DIMMING.	CAMMAN LIGHTING MASON II	ALL CABLE AND EQUIPMENT NECESSARY FOR COMPLETE INSTALLATION	500 lm	120 V	5 VA
LG4	1	PENDANT	4 INCH DIAMETER LED GLOBE FIXTURE, STEM HUNG, RGBW OR BLUE TINTED DIFFUSER, 90+ CRI, DMX OR 1% 0-10VDC DIMMING.	CAMMAN LIGHTING MASON II	ALL CABLE AND EQUIPMENT NECESSARY FOR COMPLETE INSTALLATION	500 lm	120 V	5 VA
LG12-M	1	PENDANT	1FT DIAMETER LED GLOBE FIXTURE, STEM HUNG, RGBW OR WARM WHITE TINTED DIFFUSER, 90+ CRI, DMX OR 1% 0-10VDC DIMMING.	CAMMAN LIGHTING MASON II	ALL CABLE AND EQUIPMENT NECESSARY FOR COMPLETE INSTALLATION	1000 lm	120 V	15 VA
LG14	1	PENDANT	14 INCH DIAMETER LED GLOBE FIXTURE, STEM HUNG, RGBW OR BLUE TINTED DIFFUSER, 90+ CRI, DMX OR 1% 0-10VDC DIMMING.	CAMMAN LIGHTING MASON II	ALL CABLE AND EQUIPMENT NECESSARY FOR COMPLETE INSTALLATION	1000 lm	120 V	25 VA
LG15	1	PENDANT	15 INCH DIAMETER LED GLOBE FIXTURE, STEM HUNG, RGBW OR COOL WHITE TINTED DIFFUSER, 90+ CRI, DMX OR 1% 0-10VDC DIMMING.	CAMMAN LIGHTING MASON II	ALL CABLE AND EQUIPMENT NECESSARY FOR COMPLETE INSTALLATION	1000 lm	120 V	25 VA
LG35	1	PENDANT	35 INCH DIAMETER LED GLOBE FIXTURE, STEM HUNG, RGBW OR YELLOW TINTED DIFFUSER, 90+ CRI, DMX OR 1% 0-10VDC DIMMING.	CAMMAN LIGHTING MASON II	ALL CABLE AND EQUIPMENT NECESSARY FOR COMPLETE INSTALLATION	2000 lm	120 V	120 VA
LG40	1	PENDANT	40 INCH DIAMETER LED GLOBE FIXTURE, STEM HUNG, RGBW OR ORANGE TINTED DIFFUSER, 90+ CRI, DMX OR 1% 0-10VDC DIMMING.	CAMMAN LIGHTING MASON II	ALL CABLE AND EQUIPMENT NECESSARY FOR COMPLETE INSTALLATION	2000 lm	120 V	150 VA
LG48-E	1	PENDANT	4FT DIAMETER LED GLOBE FIXTURE, STEM HUNG, RGBW OR BLUE TINTED DIFFUSER, 90+ CRI, DMX OR 1% 0-10VDC DIMMING.	CAMMAN LIGHTING MASON II	ALL CABLE AND EQUIPMENT NECESSARY FOR COMPLETE INSTALLATION	4000 lm	120 V	160 VA
LP6	28	PENDANT	6-INCH DIAMETER LED CYLINDER DOWNLIGHT, WIDE DISTRIBUTION, RGBW CAPABLE, DMX CONTROLLED.	AQUARI VIANITE OR A/E APPROVED EQUAL	ALL CABLE AND EQUIPMENT NECESSARY FOR COMPLETE INSTALLATION	4000 lm	120 V	100 VA
LR5	2	SURFACE CEILING	5FT DIAMETER LED RING DOWN LIGHT WITH ALUMINUM BASE AND ACRYLIC LENS, 80+ CRI, 4000K CCT, 0-10VDC DIMMING.	CAMMAN LIGHTING AVALON 4	ABOVE CEILING JUNCTION BOX TILE BRIDGE	2000 lm	277 V	50 VA
LR12	5	SUSPENDE	12FT DIAMETER LED SUSPENDED RING DOWN LIGHT. RGBW CAPABLE, DMX DRIVER	TMB FLOPPYFLEX LARGE CAMMAN LIGHTING AVALON 4	ALL CABLE AND EQUIPMENT NECESSARY FOR COMPLETE INSTALLATION	15000 lm	120 V	75 VA
LR33	1	SUSPENDE	33FT DIAMETER LED SUSPENDED RING DOWN LIGHT. RGBW CAPABLE, DMX DRIVER	TMB FLOPPYFLEX LARGE CAMMAN LIGHTING AVALON 4	ALL CABLE AND EQUIPMENT NECESSARY FOR COMPLETE INSTALLATION	40000 lm	120 V	120 VA
LS4	19	SUSPENDE	4-FOOT WRAP AROUND FIXTURE, ACRYLIC PRISMATIC DIFFUSER, 0-10VDC DIMMING.	METALUX 4AWS LITHONIA SBL		4000 lm	277 V	48 VA
LT4	4	RECESSED	2 BY 4 FOOT LED FLAT PANEL FIXTURE WITH SATIN WHITE LENS, ALUMINUM FRAME, 4000K CCT, 80+ CRI, ADJUSTABLE LUMEN OUTPUT, 0-10VDC DIMMING	METALUX CGT LITHONIA CPX	(2) JACK CHAINS SEISMIC CLIPS	3900 lm	277 V	45 VA
LTK	50	TRACK	MINI LED ZOOM SPOT TRACK FIXTURE WITH FRAMING. TRACK LENGTHS AND CONFIGURATIONS AS SHOWN ON DRAWINGS.	ETC IRIDEON FPZ	ONETRACK ADAPTER	1000 lm	120 V	25 VA
LV2	4	SURFACE WALL	2FT ALUMINUM WALL BRACKET, 50% UP, 50% DOWN, VANITY LIGHT,80+ CRI, 4000K CCT, 0-10 VDC DIMMING.	LIGHTWAY CWPQ-LED LITHONIA VANITY		2500 lm	277 V	12 VA
M-3X	1	SURFACE WALL	LED WALL MOUNTED LUMINAIRE, WEDGE SHAPED HOUSING, MEDIUM DISTRIBUTION, 4000K CCT, 80+ CRI, DARK BRONZE FINISH. VANDAL RESISTANT.	MCGRAW-EDISON GKO LITHONIA WDGE2	JUNCTION BOX FOR MOUNTING	3200 lm	277 V	32 VA
TLA	8	SURFACE WALL	AUTOMATED, MOVING HEAD, LED SPOT FIXTURE, BLACK.	HIGH END SYSTEMS MINISTAR	MOUNTING BRACKET (4) UNI-BOLTS (2) 2FT UNISTRUT P1000 SERIES CHANNELS POWER AND DATA CONNECTION CABLES CUSTOM GOBOS (SEE SPEC SECTION 28 55 00)	10000 lm	120 V	450 VA
XC	5	SURFACE CEILING	CAST ALUMINUM AC ONLY EXIT SIGN, SINGLE FACE, DIRECTIONAL ARROWS INDICATED, WHITE HOUSING. REFER TO PROJECT MANUAL FOR ADDITIONAL REQUIREMENTS.	SURE-LITES CX LITHONIA SIGNATURE		0 lm	277 V	3 VA
XW	1	SURFACE WALL	CAST ALUMINUM AC ONLY EXIT SIGN, SINGLE FACE, DIRECTIONAL ARROWS INDICATED, WHITE HOUSING. REFER TO PROJECT MANUAL FOR ADDITIONAL REQUIREMENTS.	SURE-LITES CX LITHONIA SIGNATURE		0 lm	277 V	3 VA

SHOW EQUIPMENT SCHEDULE					
LABEL	QTY	DESCRIPTION	INCLUDE	MANUFACTURER	MODEL
Electrical Equipment					
DIN	1	14 INCH DIN RAIL ENCLOSURE WITH (2) HORIZONTAL RAILS	ENCLOSURE CONTENTS: NETWORK SWITCH MOSAIC CONTROLLER MOSAIC REMOTE AUDIO MOSAIC REMOTE I/O	ETC	DIN28
EBC	1	EMERGENCY BYPASS DMX CONTROLLER, SURFACE MOUNT		ETC	DEBC
EBD	1	EMERGENCY BYPASS DETENTION		ETC	EBDK
SC-2	1	RELAY PANEL, 208Y/120V THREE-PHASE, 24 CIRCUIT	60A MAIN CIRCUIT BREAKER, 22KA SCCR BREAKERS AS INDICATED ON PANEL SCHEDULE SURFACE MOUNT DOOR 0-10V DIMMING CONTROL	ETC	SENSOR IQ 24 CKT
SCX	1	RELAY PANEL, MULTI-VOLT FEED-THROUGH, 4 CIRCUIT, SURFACE MOUNT	20A SINGLE-POLE BREAKERS 0-10V DIMMING CONTROL VOLTAGE DIVIDER KIT	ETC	FOUNDRY MINI PANEL
SNB	1	8-PORT NETWORK SWITCH IN SURFACE MOUNT ENCLOSURE		ETC	SNB
Lighting Devices					
CS	2	PUSH BUTTON LIGHTING CONTROL STATION, WHITE	LOCKING COVER OR PASSCODE LOCK	ETC	SMALL MOSAIC TOUCH SCREEN
TRK1	5	4FT BY 4FT "L" SHAPED TRACK, (2) 120V CIRCUITS, DMX DATA BUS, BLACK	ALL NECESSARY EQUIPMENT FOR COMPLETE STRUCTURAL STEEL SUSPENSION INSTALLATION	ETC	ONETRACK
TRK2	1	10FT DIAMETER CIRCULAR OR 8FT BY 8FT SQUARE TRACK, (2) 120V CIRCUITS, DMX DATA BUS, BLACK	ALL NECESSARY EQUIPMENT FOR COMPLETE STRUCTURAL STEEL SUSPENSION INSTALLATION	ETC	ONETRACK
TRK3	1	8FT LINEAR TRACK, (2) 120V CIRCUITS, DMX DATA BUS, BLACK	ALL NECESSARY EQUIPMENT FOR COMPLETE STRUCTURAL STEEL SUSPENSION INSTALLATION	ETC	ONETRACK
TRK4	1	12FT LINEAR TRACK, (2) 120V CIRCUITS, DMX DATA BUS, BLACK	ALL NECESSARY EQUIPMENT FOR COMPLETE STRUCTURAL STEEL SUSPENSION INSTALLATION	ETC	ONETRACK
TS	2	7 INCH TOUCH SCREEN LIGHTING CONTROL STATION	LOCKING COVER OR PASSCODE LOCK	ETC	MOSAIC TOUCH SCREEN

LUMINAIRE SCHEDULE - GENERAL NOTES		
1.	SEE SPECIFICATIONS FOR DRIVER REQUIREMENTS.	
2.	FOR ALL DOWNLIGHTING FIXTURES, PROVIDE REQUIRED MOUNTING HARDWARE FOR MOUNTING IN LAY-IN TYPE CEILINGS.	
3.	CONTRACTOR TO VERIFY TYPES AND QUANTITY OF LIGHT FIXTURES REQUIRING EMERGENCY TRANSFER DEVICES AND PROVIDE REQUIRED QUANTITY OF EMERGENCY TRANSFER DEVICES, LABOR, MATERIAL, ETC. IN THE PROJECT BID FOR FIELD INSTALLATION OF EMERGENCY TRANSFER DEVICES.	
4.	LIGHT FIXTURE SUBMITTALS TO INCLUDE DATA SHEETS FOR ALL FIXTURE TYPES, INCLUDING ADDITIONAL DATA SHEETS FOR DRIVER COMBINATIONS REQUIRED TO MEET THE INSTALLATION REQUIREMENTS OF THE VARIOUS FIXTURE TYPES INDICATED IN THE REMARKS COLUMN OF THE FIXTURE SCHEDULES OR ON THE DRAWINGS. SUBMITTALS SHALL ALSO INDICATE COLOR FOR ANY CUSTOM COLOR LIGHT FIXTURES.	

COPYRIGHT 2025 BY FANNINGHOWEY ASSOCIATES, INC.

PHM Science and Space Exploration Center

55860 BITTERSWEET RD,
MISHAWAKA, IN 46545

PENN-HARRIS-MADISON SCHOOL CORPORTATION




ARCHITECT



317.848.0966

350 E NEW YORK ST #300,
INDIANAPOLIS, IN 46204

WWW.FHAI.COM

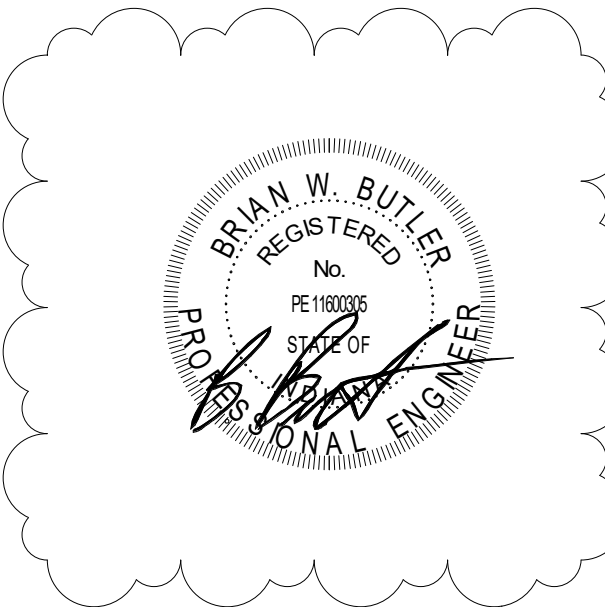

DRAWN BY: ANE

PROJECT NUMBER: 225001.00

PROJECT ISSUE DATE: 06.30.2025

REV. NO.	DESCRIPTION	DATE
1	Addendum 1	08/12/2025
2	Addendum 2	08/21/2025

LUMINAIRE AND EQUIPMENT SCHEDULES

E-601

\\data\chicago\files\aed\enb\m\my documents\2025_ELEC_Bittersweet ES_aedenbun.mxd
8/13/2025 3:52:38 PM


Branch Panel: LSC																	
Location: STORAGE 202							Volts: 480/277 Wye					A.I.C. Rating: 65,000					
Supply From: MSWB							Phases: 3					Mains Type: MCB					
Mounting: Surface							Wires: 4					Mains Rating: 400 A					
Enclosure: Type 1							MCB Rating: 400 A										
Notes:																	
CKT	Circuit Description				Trip	Poles	A		B		C		Poles	Trip	Circuit Description		CKT
1	Transformer T-SC, 75 KVA				125 A	3	14222...	768 VA					1	20 A	MEZZANINE LTG		2
3	--	--	--	--	--	--			14116...	1048 VA			1	20 A	FIRST FLOOR LTG - All but SC		4
5	--	--	--	--	--	--					14362...	3334 VA	3	20 A	VVR-101, RM.204 (Note 1)		6
7	VVR-103, RM.204 (Note 1)				20 A	3	1458 VA	3334 VA					--	--			8
9	--	--	--	--	--	--			1458 VA	3334 VA			--	--			10
11	--	--	--	--	--	--					1458 VA	7499 VA	3	30 A	VVR-114B, RM.201 (Note 2)		12
13	VVR-111, RM.201 (Note 1)				20 A	3	4168 VA	7499 VA					--	--			14
15	--	--	--	--	--	--			4168 VA	7499 VA			--	--			16
17	--	--	--	--	--	--					4168 VA	2915 VA	3	20 A	VVR-201, RM.201 (Note 1)		18
19	VVR-114A, RM.201 (Note 2)				30 A	3	7499 VA	2915 VA					--	--			20
21	--	--	--	--	--	--			7499 VA	2915 VA			--	--			22
23	--	--	--	--	--	--					7499 VA	26019...	3	110 A	RTU-1, ROOF MOUNTED, RM.201 (Note 4)		24
25	RS-1, RM.201 (Note 3)				50 A	3	10720...	26019...					--	--			26
27	--	--	--	--	--	--			10720...	26019...			--	--			28
29	--	--	--	--	--	--					10720...	0 VA	1	20 A	SPARE		30
31	SPARE				20 A	3	0 VA	0 VA					1	20 A	SPARE		32
33	--	--	--	--	--	--			0 VA	0 VA			1	20 A	SPARE		34
35	--	--	--	--	--	--					0 VA	0 VA	1	20 A	SPARE		36
37	SPARE				20 A	3	0 VA	0 VA					1	20 A	SPARE		38
39	--	--	--	--	--	--			0 VA	0 VA			1	20 A	SPARE		40
41	--	--	--	--	--	--					0 VA	0 VA	1	20 A	SPARE		42
							Total Load:	78602 VA	78776 VA	77974 VA							
							Total Amps:	284 A	285 A	281 A							
Legend:																	
Load Classification				Connected Load		Demand Factor		Estimated Demand		Panel Totals							
Motor				173735 VA		111.23%		193249 VA									
Other				34460 VA		100.00%		34460 VA		Total Conn. Load: 235351 VA							
Spare				10 VA		100.00%		10 VA		Total Est. Demand: 253327 VA							
Lighting				8646 VA		125.00%		10808 VA		Total Conn.: 283 A							
Receptacle - Convenience				18500 VA		80.00%		14800 VA		Total Est. Demand: 305 A							
Notes:																	
1. 4 #12, #12 G IN 3/4" C																	
2. 4 #10, #10 G IN 3/4" C																	
3. 4 #6, #10 G IN 3/4" C																	
4. 4 #1, #6 G IN 3/4" C																	

Branch Panel: SC-1																	
Location: STORAGE 202					Volts: 120/208 Wye												
Supply From: T-SC					Phases: 3												
Mounting: Surface					Wires: 4												
Enclosure: Type 1					A.I.C. Rating: 42,000												
					Mains Type: MCB												
					Mains Rating: 250 A												
					MCB Rating: 250 A												
Notes:																	
CKT	Circuit Description			Trip	Poles	A		B		C		Poles	Trip	Circuit Description			CKT
1	Receptacles - Rm 101			20 A	1	540 VA	1340 VA					1	20 A	SC Receptacle - SW Corner			2
3	Receptacles - Office			20 A	1			1080 VA	1160 VA			1	20 A	SC Receptacles - SE Corner			4
5	Receptacles - Workroom			20 A	1					900 VA	1040 VA	1	20 A	SC Receptacles - N Wall			6
7	Receptacles - Corridor			20 A	1	1120 VA	940 VA					1	20 A	SC Receptacles - E Wall			8
9	Receptacles - Bathrooms			20 A	1			900 VA	1120 VA			1	20 A	SC Receptacles - Presentation			10
11	Receptacles - Planetarium			20 A	1					900 VA	1160 VA	1	20 A	SC Receptacles - Work Area			12
13	Receptacle - AV Rack			20 A	1	360 VA	1440 VA					1	20 A	SC Receptacles - S Floor			14
15	Receptacle - IDF			20 A	1			360 VA	1080 VA			1	20 A	SC Receptacles - Center Floor			16
17	Receptacles - Ceiling			20 A	1					360 VA	540 VA	1	20 A	Receptacle - Mezz. Display			18
19	Receptacles - Mezzanine			20 A	1	720 VA	1080 VA					1	20 A	SC Receptacles - N Floor			20
21	EUH-204, RM.204 (Note 2)			20 A	3			3267 VA	250 VA			1	20 A	WINDOW SHADES, RM.114 (Note 1)			22
23	--			--	--					3267 VA	360 VA	1	20 A	Receptacles - Exterior Wall			24
25	--			--	--	3267 VA	200 VA					1	20 A	TCP (Note 1)			26
27	PANEL FEED: SC-2 (Note 3)			60 A	3			2945 VA	1944 VA			1	20 A	EF-1, EF-2, RM. 204 (Note 1)			28
29	--			--	--					2770 VA	3065 VA	1	20 A	DWH-1, DWCP-1, RM.204 (Note 1)			30
31	--			--	--	3215 VA	0 VA					1	20 A	SPARE			32
33	THTR SENSE FEED			20 A	1			10 VA	0 VA			1	20 A	SPARE			34
35	SPARE			20 A	1					0 VA	0 VA	1	20 A	SPARE			36
37	SPARE			20 A	1	0 VA	0 VA					1	20 A	SPARE			38
39	SPARE			20 A	1			0 VA	0 VA			1	20 A	SPARE			40
41	SPARE			20 A	1					0 VA	0 VA	1	20 A	SPARE			42
				Total Load:		14222 VA		14116 VA		14362 VA							
				Total Amps:		119 A		116 A		120 A							
Legend:																	
Load Classification				Connected Load		Demand Factor		Estimated Demand		Panel Totals							
Motor				15059 VA		108.30%		16309 VA									
Other				1480 VA		100.00%		1480 VA		Total Conn. Load: 42699 VA							
Spare				10 VA		100.00%		10 VA		Total Est. Demand: 42162 VA							
Lighting				7650 VA		125.00%		9563 VA		Total Conn.: 119 A							
Receptacle - Convenience				18500 VA		80.00%		14800 VA		Total Est. Demand: 117 A							
Notes:																	
1. 2 #12, #12 G IN 3/4" C																	
2. 4 #12, #12 G IN 3/4" C																	
3. 4 #6, #10 G IN 3/4" C																	

**PENN-HARRIS-MADISON
SCHOOL CORPORATION**




317.848.0966 **WWW.FHAI.COM**
350 E NEW YORK ST #300,
INDIANAPOLIS, IN 46204

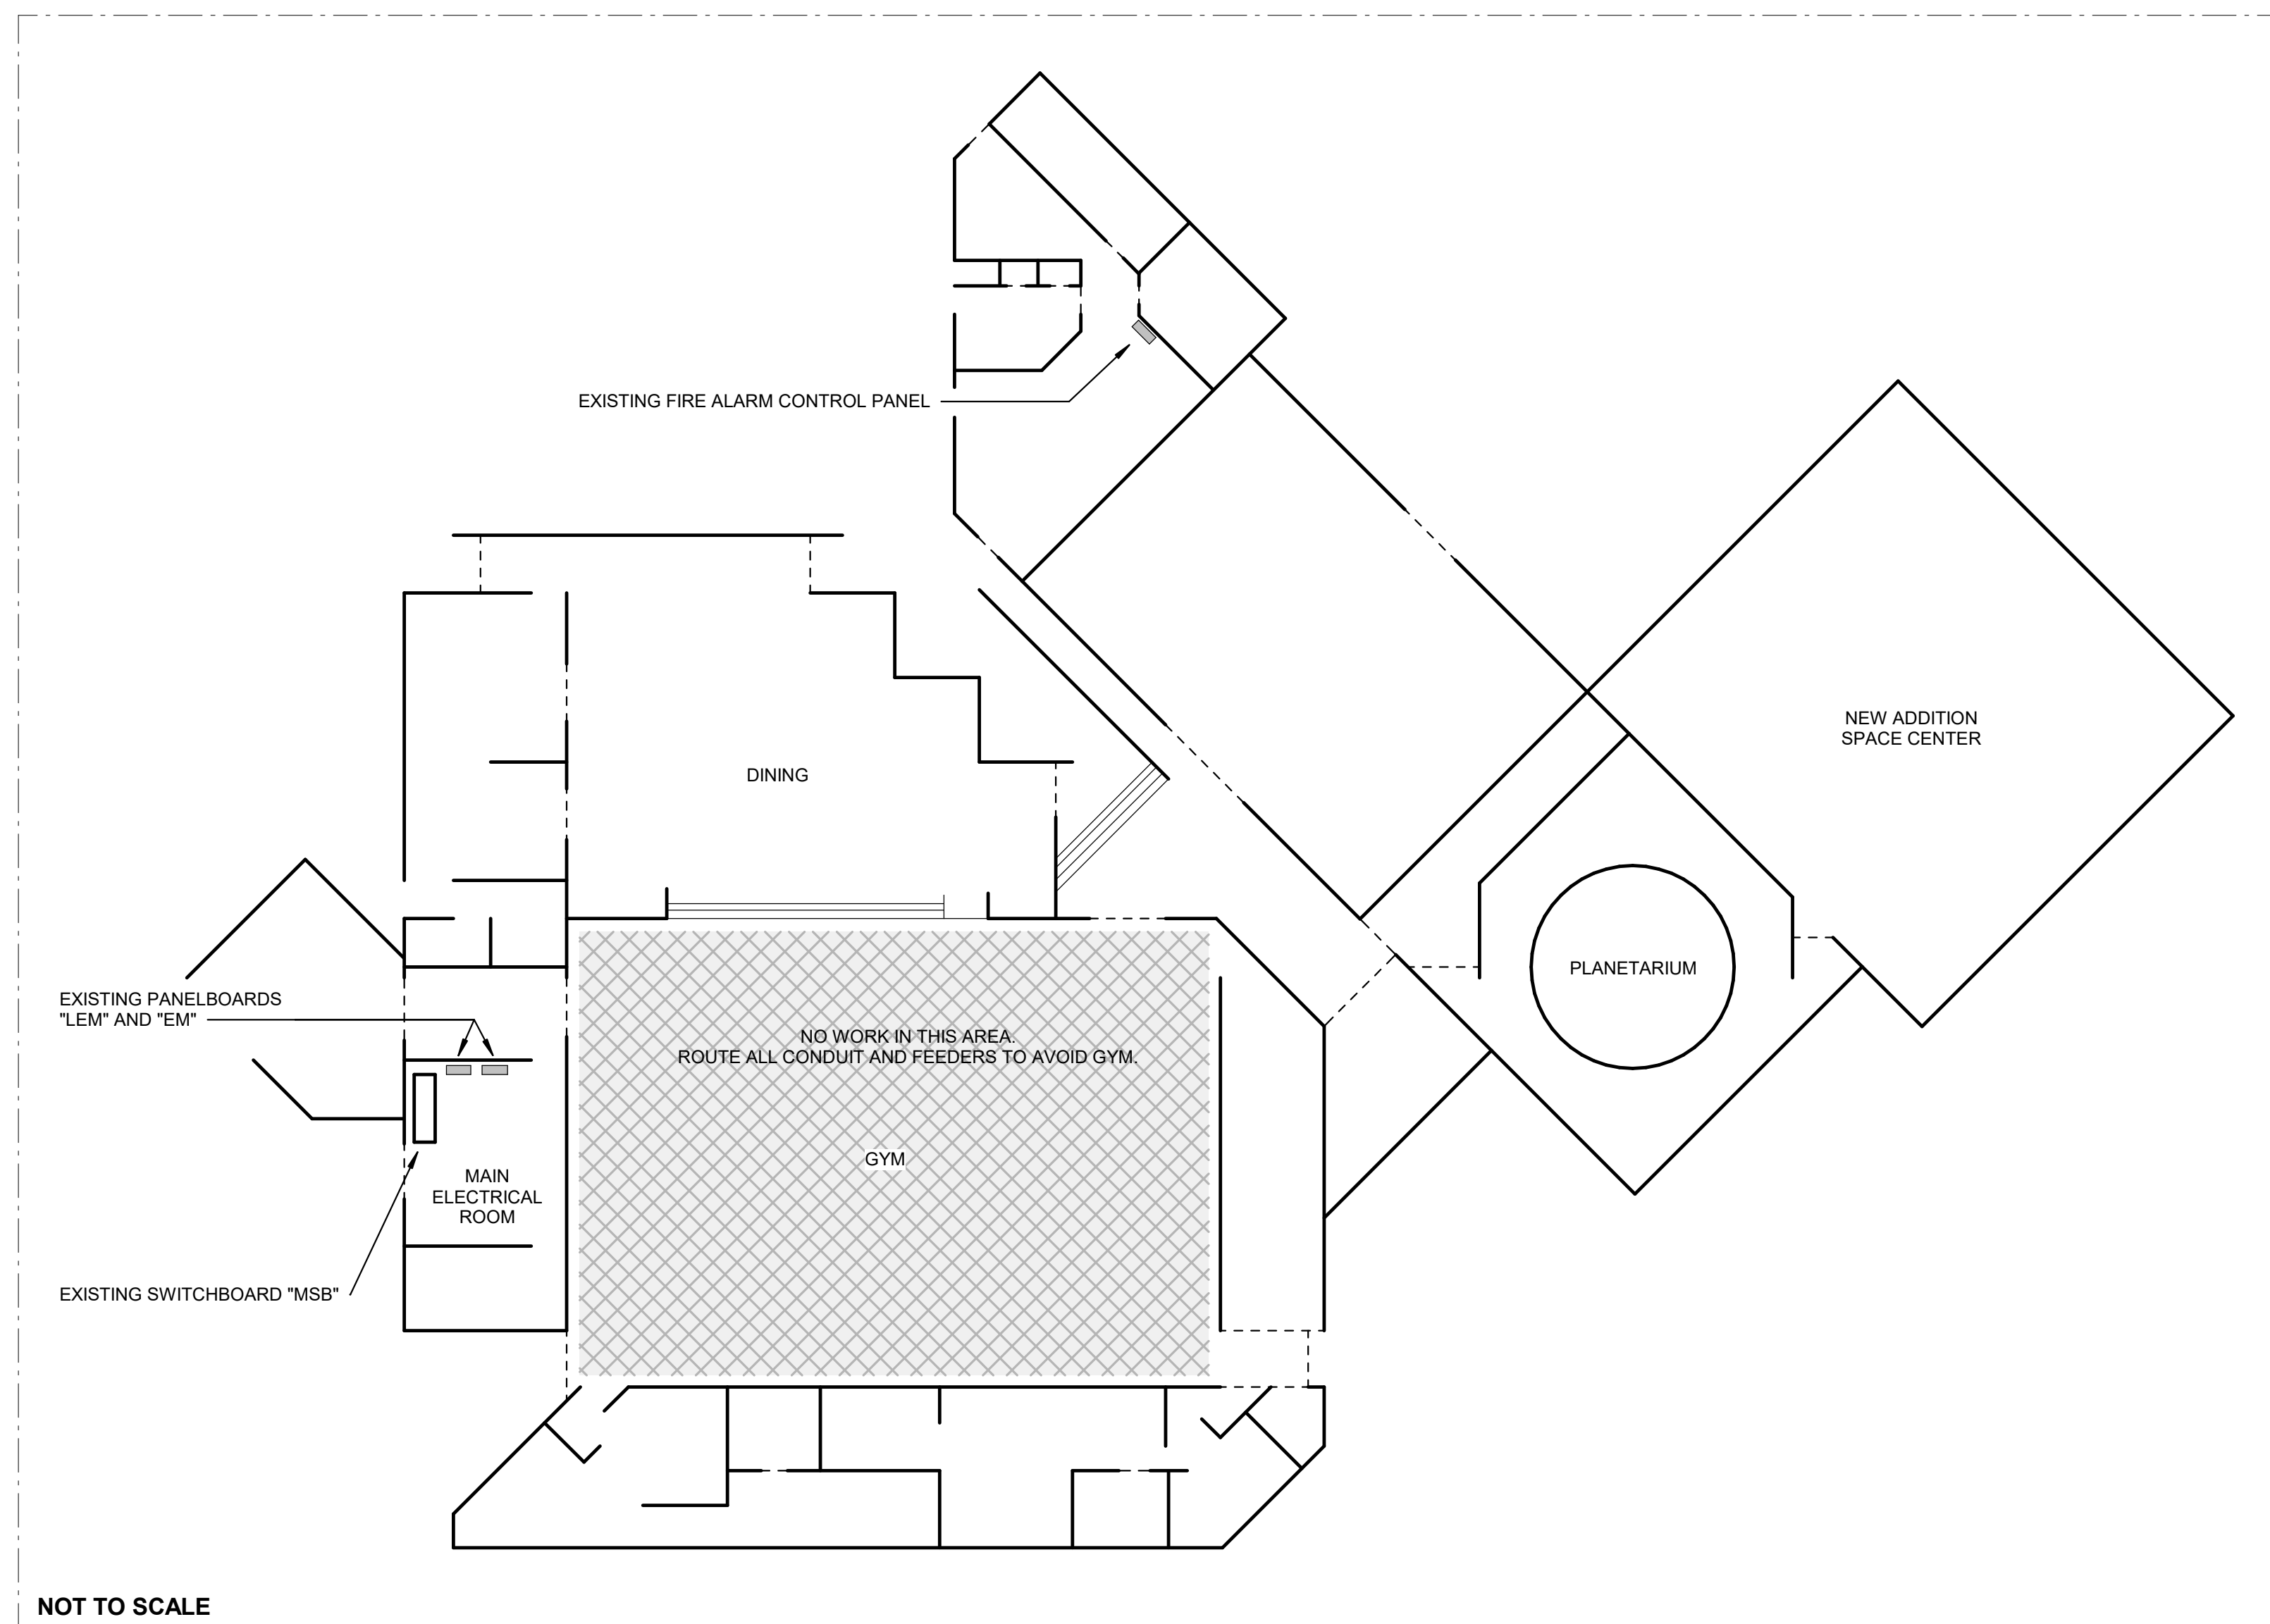[illegible][illegible]

E-701

\\data1\chris\profiles\jared\humbury\documents\2025_ELEC_Bittersweet ES_aedenbun.rvt
8/13/2025 3:52:40 PM

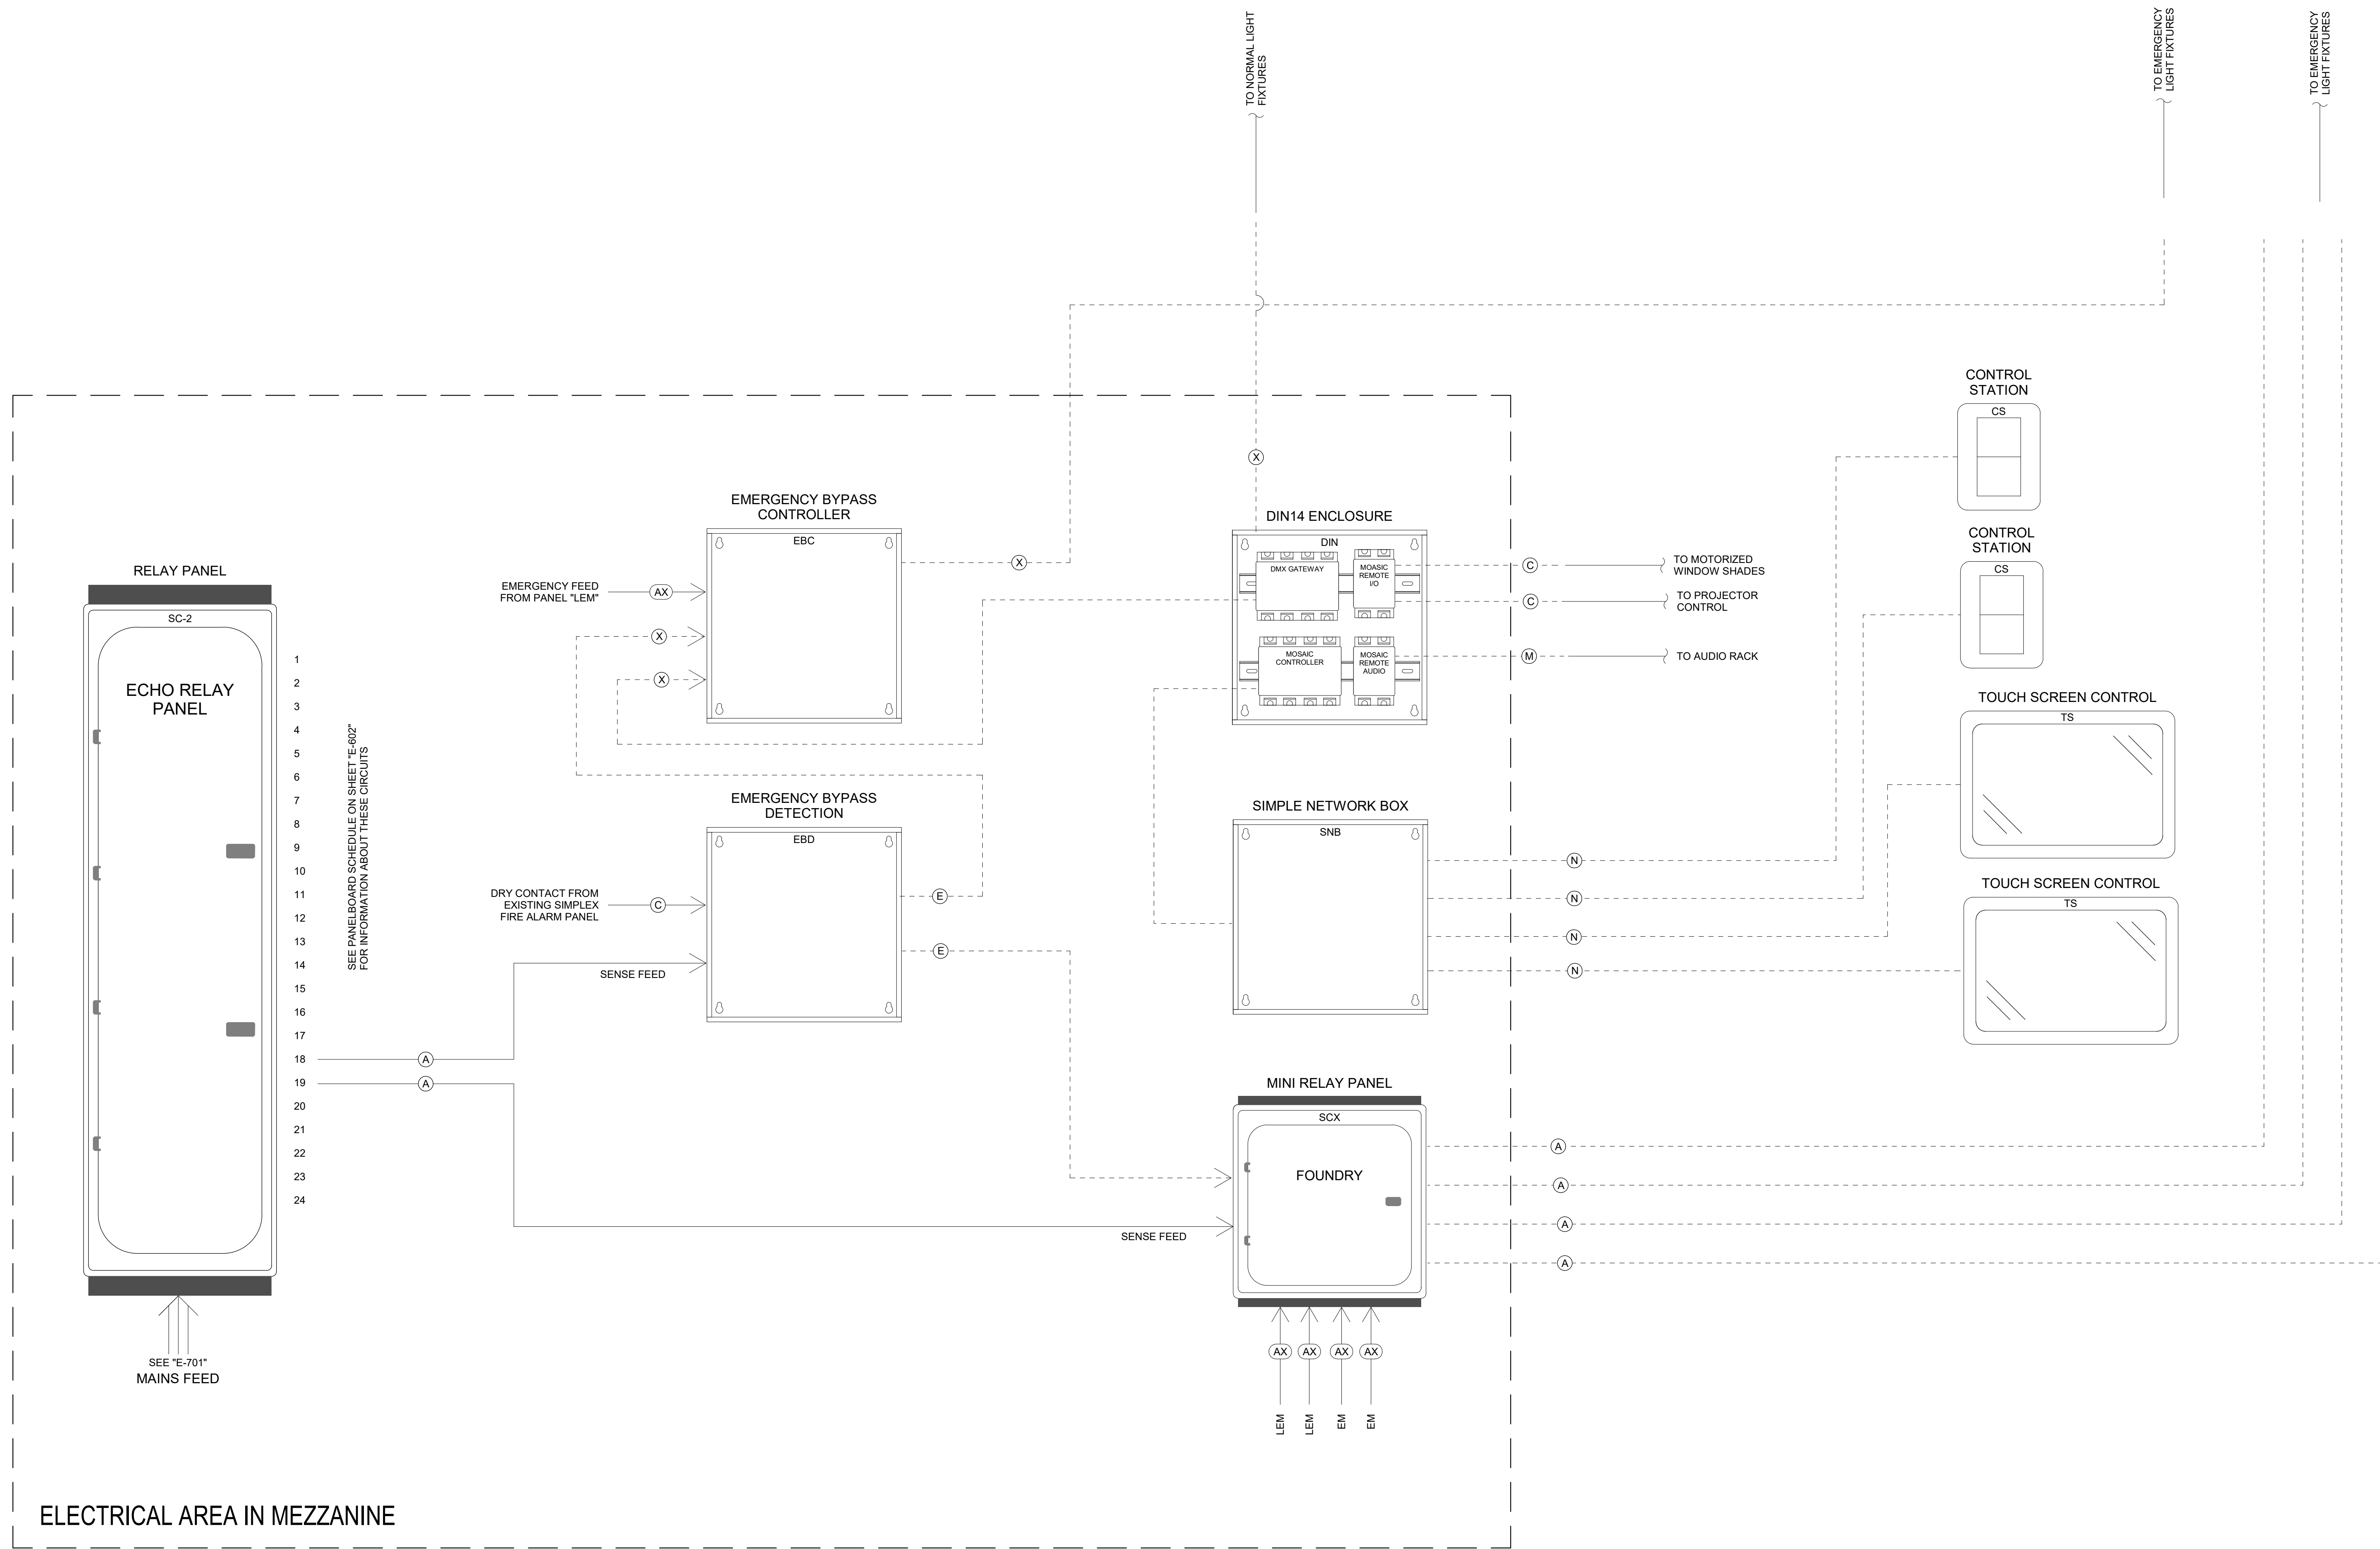

SPACE CENTER SHOW CONTROL RISER

SCALE: 1/8" = 1'-0"

WIRE SYMBOL LEGEND		
A	NORMAL POWER	(2) #12, #12G UNO
AX	EMERGENCY POWER	(2) #12, #12G UNO
C	DRY CONTACT	(2) #16
E	EMERGENCY CONTROL	(2) #16
M	MIDI CONTROL	(1) CAT6A PER DIV 27 SPECS
N	NETWORK	(1) CAT6A PER DIV 27 SPECS
X	DMX	(1) TMB PROPLEX PC244T

COPYRIGHT 2025 BY FANNINGHOWEY ASSOCIATES, INC.

PHM Science and Space Exploration Center

55860 BITTERSWEET RD,
MISHAWAKA, IN 46545

PENN-HARRIS-MADISON
SCHOOL CORPORTATION



ARCHITECT

**FANNING
HOWEY**

317.848.0966

350 E NEW YORK ST #300,
INDIANAPOLIS, IN 46204

WWW.FHAI.COM



DRAWN BY: ANE

PROJECT NUMBER: 225001.00

PROJECT ISSUE DATE: 06.30.2025

REV. NO.	DESCRIPTION	DATE
2	Addendum 2	08/21/2025

SHOW CONTROL RISER DIAGRAM

E-702