

ADDENDUM NO. 21

Date: 09.11.2026

Project:

**Westfield Washington School Corporation
Bid Package 06, Bid Item #33
SR32 & Centennial Road New Roundabout Construction
17707 Centennial Road,
Westfield, IN. 46074**

Owner:

**C/O Westfield Washington School Corporation
19500 Tomlinson Road
Westfield, IN 46074**



Construction Manager:

**Hagerman, Inc
10315 Allisonville Road
Fishers, IN 46038**

TO: All Interested Bidders of Record

This Addendum #21, Dated 09.11.2026, forms part of the contract documents and modifies the original Bidding Documents Dated 09.04.2026. Please acknowledge receipt of this Addendum in the space provided on the Bid Form. Failure to acknowledge this Addendum may subject the Bidder to disqualification.

The Hagerman, Inc portion of this Addendum consists of the following information:

I. GENERAL INFORMATION

1. This is for Addendum #21 Dated 09.11.2026. (Please note this is really Addendum #01 for the SR 32 and Centennial Road New Round About Project) but is sequentially Addendum #21 on the overall Westfield Washington School New Middle School West Project, so we will refer to it as Addendum #21.

II. CHANGES TO THE PROJECT CONTRACT MANUAL

1. All contractors shall review the attached A&F Engineering (and CSO Architects) Addendum #21 Dated 09.11.2026 and incorporate the changes made to the drawings and specifications into the respective bid item scope of bid.

2. All Bidders shall review the updated Section 00 01 15 List of Drawings.
3. Bid Item #33 SR 32 and Centennial Road New Round Contractor shall review the revised Drawing #2 of 47 for changes and include in your bid for this project.
4. Bid Item #33 SR 32 and Centennial Road New Round Contractor shall review the revised Drawing #24 of 47 for changes. This drawing adds the light pole specifications and the lighting service Point and the Lighting Cabinet Details and include in your bid for this project.
5. Bid Item #33 SR 32 and Centennial Road New Round Contractor shall coordinate this Lighting Information with the City of Westfield Lighting Standards and the INDOT 2026 Specs.

III. DESIGN INFORMATION

1. A&F Engineering and CSO Addendum #21 Dated 09.11.2026

END OF SECTION

ADDENDUM

ADDENDUM NO. 21

RE: Westfield Middle School – West

Date: September 11, 2026

By: Jeff Hill, A&F Engineering Company



This Addendum is issued in accordance with the provisions of “The General Conditions of the Contract for Construction,” Article 1, “Contract Documents” and becomes a part of the Contract Documents as provided therein. This Addendum includes:

Addendum Pages: 1-2

Attached Documents: None

Attached Drawing Sheets: 2, 24 of 47

PART 1 – GENERAL INFORMATION

1.1 Quantities

- A. See attached sheets to be used for bidding purposes. Additional information has been provided for the roundabout decorative lighting. The pay items in the itemized quantities are for these decorative lighting items.

PART 2 – BIDDING REQUIREMENTS

2.1 Refer to the Hagerman Inc. Project Contract Manual

PART 3 – SPECIFICATIONS

3.1 Refer to the Hagerman Inc. Project Contract Manual, City of Westfield Standards, and INDOT 2026 Specifications

PART 4 – DRAWINGS

4.1 Drawing Sheet 2 of 47 - Index and General Notes

A. Reissue attached sheet.

4.2 Drawing Sheet 24 of 47

A. Revised sheet now includes City of Westfield decorative lighting information for use in preparation of bids.

PART 5 – QUESTIONS AND ANSWERS

5.1 None

END ADDENDUM NO. 21

UTILITIES		
UTILITY	OWNER	ADDRESS
Gas	Citizen's Energy Group	Rich Miller 317-927-4684 rmiller@citizensenergygroup.com 2150 Dr. Martin Luther King Jr. Street Indianapolis, IN 46202
Sanitary	Citizen's Energy Group	David Clark 317-429-3993 dclark@citizensenergygroup.com 2150 Dr. Martin Luther King Jr. Street Indianapolis, IN 46202
Water	Citizen's Energy Group	Scott Ritter 317-927-4434 sritter@citizensenergygroup.com 2150 Dr. Martin Luther King Jr. Street Indianapolis, IN 46202
Electric	Duke Energy Group	Frank Hancock 765-524-7945 frank.hancock@duke-energy.com 4535 Jane Blvd New Castle, IN 47362
Communications	Comcast	BSM Groups LLC 812-271-2400 comcastrelocate@bsmgroups.com 1600 West Fountain Dr Bloomington, IN 47404
	Crown Castle Fiber	Craig Brown 317-819-8648 craig.brown@crowncastle.com 800 Oliver Ave. Suite 1 Indianapolis, IN 46225
	Duke Fiber	Charlotte Seegrist 513-287-1105 DukeFiberMW@Duke-Energy.com 139 E. 4th Street Cincinnati, OH 45202
	Frontier Communication	Dan Koch 260-415-9328 daniel.koch@ftr.com 4027 Beckwith Drive Fort Wayne, IN 46808
	Metronet	Doug Reckart 317-809-8067 doug.reckart@metronet.com 8036 Cole Wood Blvd. Indianapolis, IN 46239
	Spectrum Communications	Byron Posey 317-538-2016 byron.posey@charter.com 3030 Roosevelt Ave Indianapolis, IN 46218
	Verizon/MCI	Rolland Craig 317-498-1242 dennis.craig@verizon.com 6835 Hillsdale Ct. Indianapolis, IN 46250
	Zayo Group	Waylon Higgins 765-341-1199 waylon.higgins@zayo.com 9209 Castlegate Dr Indianapolis, IN 46256


[illegible]

INDEX	
SHEET NO.	SHEET DESIGNATION
1	Title
2	Index and General Notes
3-4	Typical Sections
5	Plat No. 1
6	Geometric Tie-Up Sheet
7	Traffic Maintenance Details
8-10	Detour Route Details
11- 20	Plan and Profile
21-22	Spot Elevation Details
23	Erosion Control Details
24	Lighting
25	Pavement Markings and Sign Details
26	Sheet Sign Table
27	Pavement Markings Table
28	Structure Data Table
29- 47	Cross Sections

VERIFICATION NOTE

Contractor shall verify all dimensions and clearances and all existing filed conditions before starting construction. Commencement of work constitutes acceptance of conditions.

Should different conditions be encountered, contact the engineer or designer before proceeding with work.

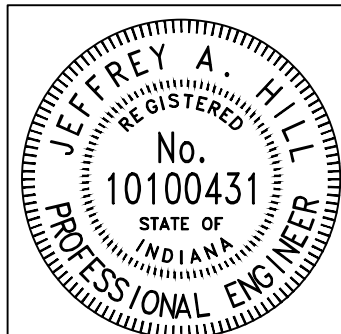


RECOMMENDED FOR APPROVAL		09/01/2026
DESIGN ENGINEER		DATE
DESIGNED: _____ MCN	DRAWN: _____ MCN	
CHECKED: _____ JAH	CHECKED: _____ JAH	

INDIANA
DEPARTMENT OF TRANSPORTATION

INDEX AND GENERAL NOTES

HORIZONTAL SCALE	BRIDGE FILE		
N/A	N/A		
VERTICAL SCALE	DESIGNATION		
N/A	--		
	SHEETS		
	2	of	47
	CONTRACT		
	--		

Z:\2024\240787-CONTEXT DESIGN-TRAFFIC SIGNAL, SR 32-CENTENNIAL RD PH 5 1\DWG\RAB\24078P-RAB-LIGHTING AND LANDSCAPING.DWG

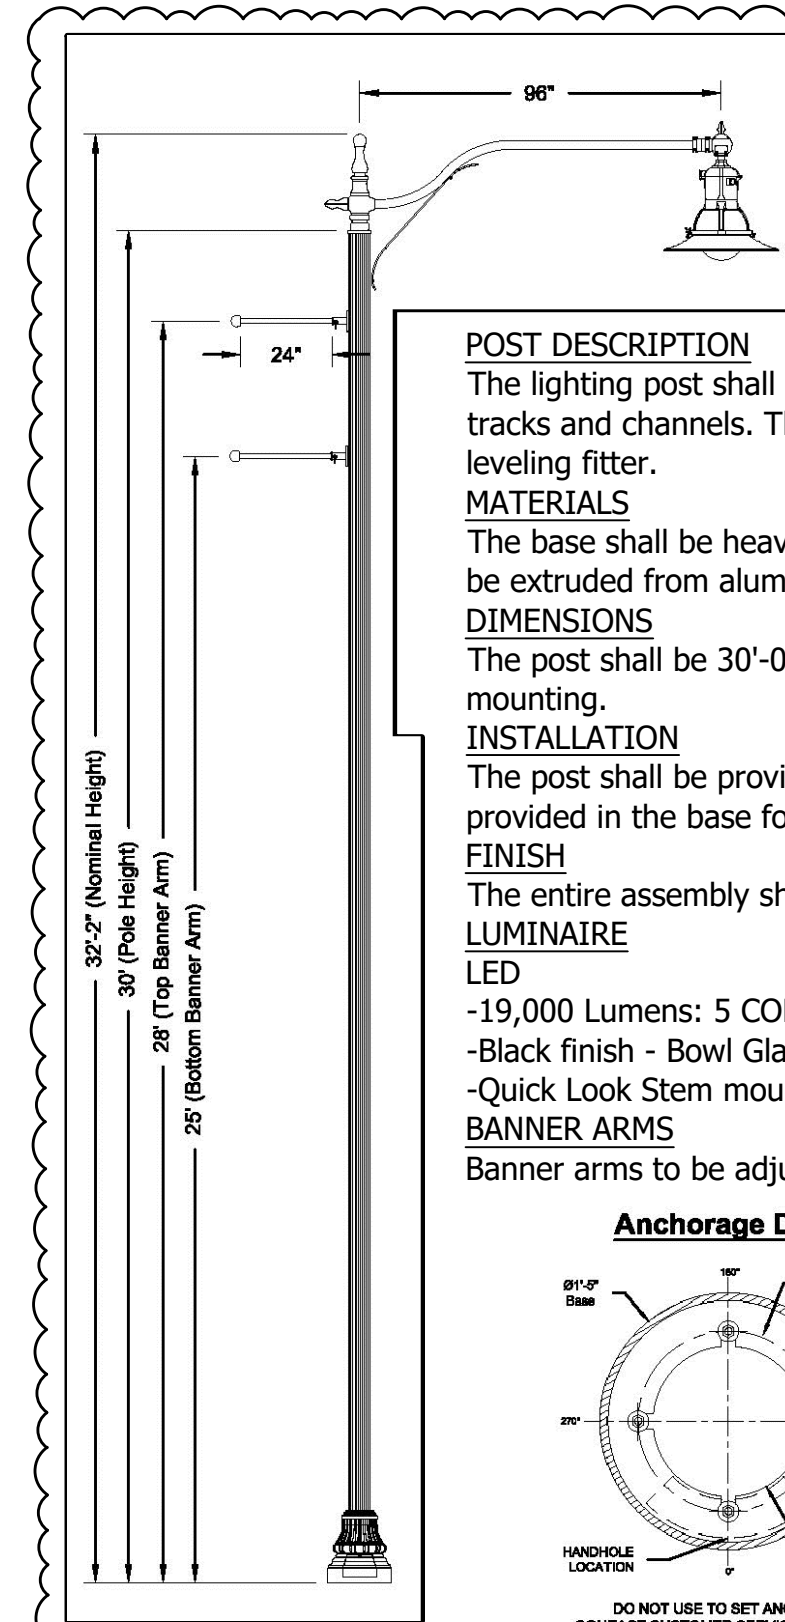

Specifications

POST DESCRIPTION

The lighting post shall be all aluminum construction with a decorative fluted cast aluminum base. Shaft profile shall consist of four mounting tracks and channels. The post shall be provided with (1) single roadway arm, 96" from post to luminaire center, (2) banner arms, and (1) leveling fitter.

MATERIALS

The base shall be heavy wall, cast aluminum produced from certified ASTM 356.1 ingot per ASTM B-179-95a or ASTM B26-95. The shaft shall be extruded from aluminum, ASTM 6061 alloy. All hardware shall be stainless steel. Anchor bolts to be completely hot dip galvanized.

DIMENSIONS

The post shall be 30'-0" in height with a $\phi 17"$ base. A hand hole shall be provided for access. A $\phi 3 \times 5"$ tall tenon shall be provided for luminaire mounting.

INSTALLATION

The post shall be provided with four, hot dip galvanized L-type anchor bolts to be installed on a 12" diameter bolt circle. A door shall be provided in the base for anchorage and wiring access. A grounding screw shall be provided inside the base apposite the door.

FINISH

The entire assembly shall have a standard black finish.

LUMINAIRE


LED

- 19,000 Lumens: 5 COBs - 4000 Series CCT - Auto-Sensing Voltage
- Black finish - Bowl Glass and Door - Type 3 Asymmetric Distribution
- Quick Look Stem mount - $\phi 30"$ Shallow Skirt for Cutoff Requirement


BANNER ARMS

Banner arms to be adjustable in the field.

Anchorage Detail

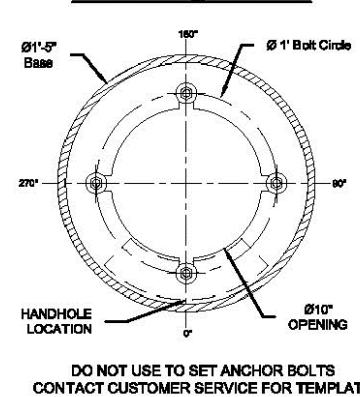


LIGHT POLE DETAILS

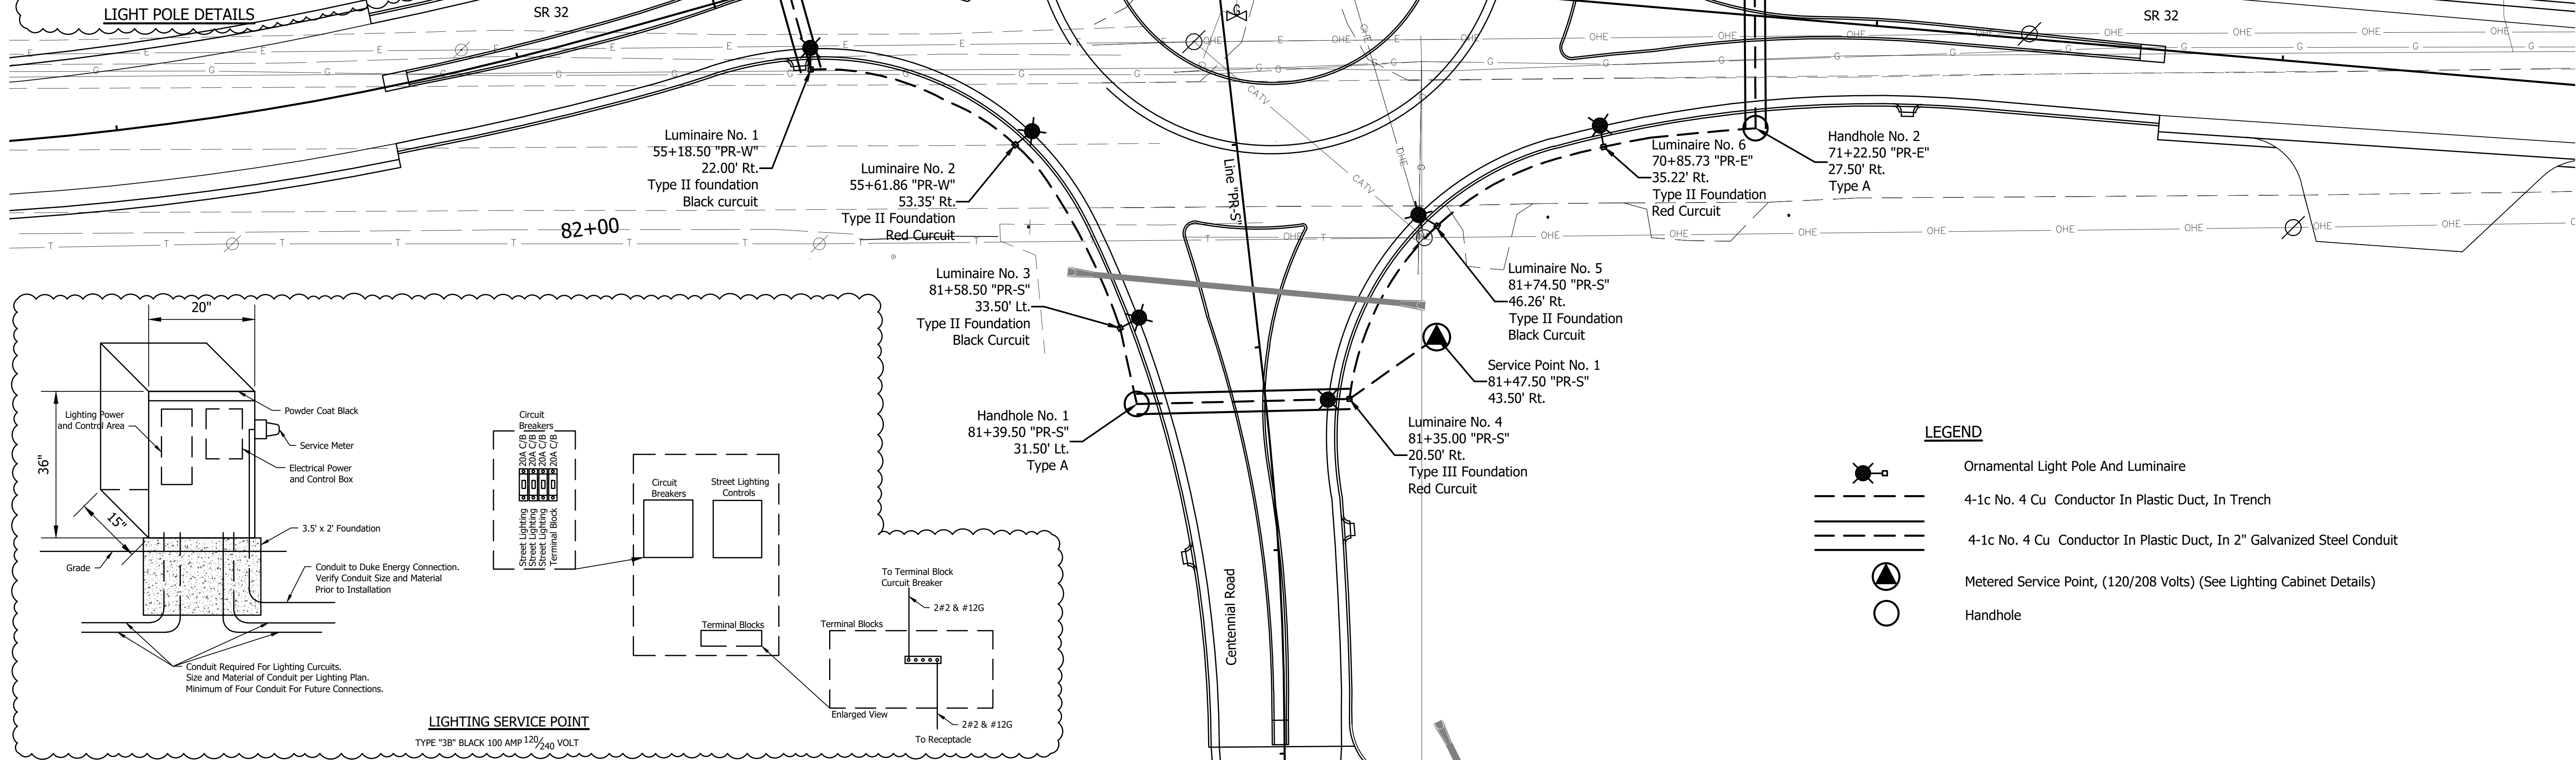

LIGHTING SERVICE POINT

TYPE "3B" BLACK 100 AMP 120/240 VOLT

LEGEND

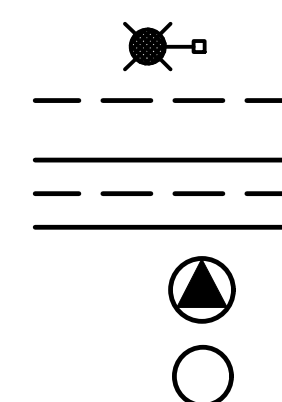

Ornamental Light Pole And Luminaire

4-1c No. 4 Cu Conductor In Plastic Duct, In Trench


4-1c No. 4 Cu Conductor In Plastic Duct, In 2" Galvanized Steel Conduit

Metered Service Point, (120/208 Volts) (See Lighting Cabinet Details)

Handhole

REVISIONS


DATE	ITEM
09-10-2026	Lighting Pole and Service Point Details Added

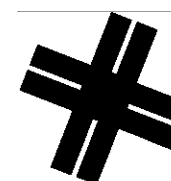

A&F ENGINEERING
Transportation & Site Engineering

Creating Order Since 1966

8365 Keystone Crossing, Suite 201, Indianapolis, IN. 46240 (317) 202-0864

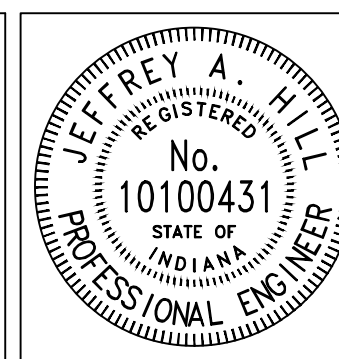

RECOMMENDED
FOR APPROVAL

JAH

DESIGN ENGINEER

09/01/2026
DATE

DESIGNED:

MCN

DRAWN:

MCN

CHECKED:

JAH

CHECKED:

JAH

INDIANA
DEPARTMENT OF TRANSPORTATION

LIGHTING DETAILS

HORIZONTAL SCALE

1" = 20'

VERTICAL SCALE

N/A

BRIDGE FILE

N/A

DESIGNATION

--

SHEETS

24

of

47

CONTRACT

--

**WWS NEW MIDDLE SCHOOL WEST
SR32 & Centennial Road Roundabout
Construction Work
LIST OF DRAWINGS**

DRAWINGS			
No.	Drawing Title	Drawing Date	Revisions
1 of 47	Title	9/1/2026	
2 of 47	Index and General Notes	9/11/2026	Addendum #21
3 of 47	Typical Sections	9/1/2026	
4 of 47	Typical Sections	9/1/2026	
5 of 47	Plat No. 1	9/1/2026	
6 of 47	Geometric Tie-Up	9/1/2026	
7 of 47	Maintenance of Traffic	9/1/2026	
8 of 47	Maintenance of Traffic Local Detour	9/1/2026	
9 of 47	Maintenance of Traffic State Route Detour	9/1/2026	
10 of 47	Maintenance of Traffic	9/1/2026	
11 of 47	Plan – Line “PR-W” STA. 50+00.00 to STA. 56+00.00	9/1/2026	
12 of 47	Profile – Line “PR-W” STA. 50+00.00 to STA. 56+00.00	9/1/2026	
13 of 47	Plan – Line “PR-E” STA. 70+00.00 to STA. 76+00.00	9/1/2026	
14 of 47	Profile – Line “PR-E” STA. 70+00.00 to STA. 76+00.00	9/1/2026	
15 of 47	Plan – Line “PR-S” STA. 77+00.00 to STA. 83+00.00	9/1/2026	
16 of 47	Profile – Line “PR-S” STA. 77+00.00 to STA. 83+00.00	9/1/2026	
17 of 47	Plan – Line “PR-N” STA. 10+00.00 to STA. 16+00.00	9/1/2026	
18 of 47	Profile – Line “PR-N” STA. 10+00.00 to STA. 16+00.00	9/1/2026	
19 of 47	Plan – Line “PR-R” STA. 500+00.00 to STA. 503+00.00	9/1/2026	
20 of 47	Profile – Line “PR-R” STA. 500+00.00 to STA. 560+00.00	9/1/2026	
21 of 47	Spot Elevation Details	9/1/2026	
22 of 47	Spot Elevation Details	9/1/2026	
23 of 47	Erosion Control	9/1/2026	
24 of 47	Lighting Details	9/11/2026	Addendum #21

WWS NEW MIDDLE SCHOOL WEST
SR32 & Centennial Road Roundabout
Construction Work
LIST OF DRAWINGS

25 of 47	Pavement Markings and Sign Details	9/1/2026	
26 of 47	Sheet Sign Table	9/1/2026	
27 of 47	Pavement Markings Table	9/1/2026	
28 of 47	Structure Data Table	9/1/2026	
29 of 47	Cross Sections Line "PR-W"	9/1/2026	
30 of 47	Cross Sections Line "PR-W"	9/1/2026	
31 of 47	Cross Sections Line "PR-W"	9/1/2026	
32 of 47	Cross Sections Line "PR-W"	9/1/2026	
33 of 47	Cross Sections Line "PR-E"	9/1/2026	
34 of 47	Cross Sections Line "PR-E"	9/1/2026	
35 of 47	Cross Sections Line "PR-E"	9/1/2026	
36 of 47	Cross Sections Line "PR-E"	9/1/2026	
37 of 47	Cross Sections Line "PR-E"	9/1/2026	
38 of 47	Cross Sections Line "PR-S"	9/1/2026	
39 of 47	Cross Sections Line "PR-S"	9/1/2026	
40 of 47	Cross Sections Line "PR-S"	9/1/2026	
41 of 47	Cross Sections Line "PR-S"	9/1/2026	
42 of 47	Cross Sections Line "PR-N"	9/1/2026	
43 of 47	Cross Sections Line "PR-N"	9/1/2026	
44 of 47	Cross Sections Line "PR-N"	9/1/2026	
45 of 47	Cross Sections Line "PR-R"	9/1/2026	
46 of 47	Cross Sections Line "PR-R"	9/1/2026	
47 of 47	Cross Sections Line "PR-R"	9/1/2026	

**WWS NEW MIDDLE SCHOOL WEST
SR32 & Centennial Road Roundabout
Construction Work
LIST OF DRAWINGS**

**Drawings included for reference and
coordination ONLY:**

1 of 48	COVER SHEET	8/11/2025	
2 of 48	INDEX AND GENERAL NOTES	8/11/2025	
3 of 48	TYPICAL SECTIONS	8/11/2025	
4 of 48	PLAT NO. 1	8/11/2025	
5 of 48	MAINTENANCE OF TRAFFIC	8/11/2025	
6 of 48	MAINTENANCE OF TRAFFIC	8/11/2025	
7 of 48	MAINTENANCE OF TRAFFIC	8/11/2025	
8 of 48	MAINTENANCE OF TRAFFIC	8/11/2025	
9 of 48	MAINTENANCE OF TRAFFIC	8/11/2025	
10 of 48	PLAN – LINE “PR-B” STA. 10+00.00 TO STA. 16+00.00	8/11/2025	
11 of 48	PROFILE – LINE “PR-B” STA. 10+00.00 TO STA. 16+00.00	8/11/2025	
12 of 48	PLAN – LINE “PR-B” 16+00.00 TO 22+00.00	8/11/2025	
13 of 48	PROFILE – LINE “PR-B” STA. 16+00.00 TO STA. 22+00.00	8/11/2025	
14 of 48	PLAN – LINE “PR-B” 22+00.00 TO 28+00.00	8/11/2025	
15 of 48	PROFILE – LINE “PR-B” STA. 22+00.00 TO STA. 25+38.59	8/11/2025	
16 of 48	PLAN – LINE “PR-A” STA. 62+00.00 TO STA. 68+00.00	8/11/2025	
17 of 48	PLAN – LINE “PR-A” STA. 68+00.00 TO STA. 74+00.00	8/11/2025	
18 of 48	CURB RAMP DETAILS	8/11/2025	
19 of 48	EROSION CONTROL DETAIL	8/11/2025	
20 of 48	EROSION CONTROL DETAIL	8/11/2025	
21 of 48	PAVEMENT MARKING DETAILS	8/11/2025	
22 of 48	SHEET SIGN & POST SUMMARY TABLE	8/11/2025	
23 of 48	PAVEMENT MARKINGS SUMMARY OF QUANTITIES	8/11/2025	
24 of 48	MISCELLANEOUS DETAIL	8/11/2025	
25 of 48	PAVEMENT QUANTITIES AND APPROACH TABLE	8/11/2025	

WWS NEW MIDDLE SCHOOL WEST
SR32 & Centennial Road Roundabout
Construction Work
LIST OF DRAWINGS

26 of 48	STRUCTURE DATA TABLE	8/11/2025	
27 of 48	CROSS SECTIONS LINE "PR-B"	8/11/2025	
28 of 48	CROSS SECTIONS LINE "PR-B"	8/11/2025	
29 of 48	CROSS SECTIONS LINE "PR-B"	8/11/2025	
30 of 48	CROSS SECTIONS LINE "PR-B"	8/11/2025	
31 of 48	CROSS SECTIONS LINE "PR-B"	8/11/2025	
32 of 48	CROSS SECTIONS LINE "PR-B"	8/11/2025	
33 of 48	CROSS SECTIONS LINE "PR-B"	8/11/2025	
34 of 48	CROSS SECTIONS LINE "PR-B"	8/11/2025	
35 of 48	CROSS SECTIONS LINE "PR-B"	8/11/2025	
36 of 48	CROSS SECTIONS LINE "PR-B"	8/11/2025	
37 of 48	CROSS SECTIONS LINE "PR-B"	8/11/2025	
38 of 48	CROSS SECTIONS LINE "PR-B"	8/11/2025	
39 of 48	CROSS SECTIONS LINE "PR-A"	8/11/2025	
40 of 48	CROSS SECTIONS LINE "PR-A"	8/11/2025	
41 of 48	CROSS SECTIONS LINE "PR-A"	8/11/2025	
42 of 48	CROSS SECTIONS LINE "PR-A"	8/11/2025	
43 of 48	CROSS SECTIONS LINE "PR-A"	8/11/2025	
44 of 48	CROSS SECTIONS LINE "PR-A"	8/11/2025	
45 of 48	CROSS SECTIONS LINE "PR-A"	8/11/2025	
46 of 48	CROSS SECTIONS LINE "PR-A"	8/11/2025	
47 of 48	CROSS SECTIONS LINE "PR-A"	8/11/2025	
48 of 48	CROSS SECTIONS LINE "PR-A"	8/11/2025	
10F12	Topographic Survey	8/18/2023	BP 03
20F12	Topographic Survey	8/18/2023	BP 03
30F12	Topographic Survey	8/18/2023	BP 03

WWS NEW MIDDLE SCHOOL WEST
SR32 & Centennial Road Roundabout
Construction Work
LIST OF DRAWINGS

40F12	Topographic Survey	8/18/2023	BP 03
50F12	Topographic Survey	8/18/2023	BP 03
60F12	Topographic Survey	8/18/2023	BP 03
70F12	Topographic Survey	8/18/2023	BP 03
80F12	Topographic Survey	8/18/2023	BP 03
90F12	Topographic Survey	8/18/2023	BP 03
100F12	Topographic Survey	8/18/2023	BP 03
110F12	Topographic Survey	8/18/2023	BP 03
120F12	Topographic Survey	8/18/2023	BP 03
C100	COVER SHEET	8/8/2025	ASI 26 - Trans Pipe Outlet
C101	EXISTING CONDITIONS & DEMOLITION PLAN	1/22/2025	ASI 09 - Civil TAC Updates
C102	EXISTING CONDITIONS & DEMOLITION PLAN	6/17/2024	BP 03
C250	Index and Typ	6/21/2024	BP 03
C251	PLAN "PR-A" STA. 00+00 TO STA. 5+80	1/22/2025	ASI 09 - Civil TAC Updates
C252	PROFILE "PR-A" STA. 00+00 TO STA. 05+80	1/22/2025	ASI 09 - Civil TAC Updates
C253	PLAN "PR-A" STA. 05+50 TO STA. 11+00	1/22/2025	ASI 09 - Civil TAC Updates
C254	PROFILE "PR-A" STA. 05+50 TO STA. 11+00	1/22/2025	ASI 09 - Civil TAC Updates
C255	PLAN "PR-A" STA. 11+00 TO STA. 15+39	1/22/2025	ASI 09 - Civil TAC Updates
C256	PROFILE "PR-A" STA. 11+00 TO STA. 15+39	1/22/2025	ASI 09 - Civil TAC Updates
C257	PLAN "PR-B" STA. 00+00 TO STA. 05+00	1/22/2025	ASI 09 - Civil TAC Updates
C258	PROFILE "PR-B" STA. 00+00 TO STA. 5+50	6/17/2024	BP 03
C259	PLAN "PR-B" STA. 05+00 TO STA. 07+91	1/22/2025	ASI 09 - Civil TAC Updates
C260	PROFILE "PR-B" STA. 05+50 TO STA. 7+91	6/17/2024	BP 03
C261	PLAN "PR-C" STA. 00+00 TO STA. 06+00	1/22/2025	ASI 09 - Civil TAC Updates
C262	PROFILE "PR-C" STA. 00+00 TO STA. 06+00	6/17/2024	BP 03
C263	PLAN "PR-C" STA. 06+00 TO STA. 12+00	1/22/2025	ASI 09 - Civil TAC Updates
C264	PROFILE "PR-C" STA. 06+00 TO STA. 12+00	6/17/2024	BP 03

WWS NEW MIDDLE SCHOOL WEST
SR32 & Centennial Road Roundabout
Construction Work
LIST OF DRAWINGS

C265	PLAN "PR-C" STA. 12+00 TO STA. 17+00	1/22/2025	ASI 09 - Civil TAC Updates
C266	PROFILE "PR-C" STA. 12+00 TO STA. 18+00	6/17/2024	BP 03
C267	PLAN "PR-C" STA. 17+00 TO STA. 23+00	1/22/2025	ASI 09 - Civil TAC Updates
C268	PROFILE "PR-C" STA. 18+00 TO STA. 24+00	6/17/2024	BP 03
C269	PLAN "PR-C" STA. 23+00 TO STA. 29+79	1/22/2025	ASI 09 - Civil TAC Updates
C270	PROFILE "PR-C" STA. 24+00 TO STA. 29+52	9/26/2024	ASI 02 - Civil Updates
C300	OVERALL GRADING PLAN	1/22/2025	ASI 09 - Civil TAC Updates
C301	GRADING PLAN	1/22/2025	ASI 09 - Civil TAC Updates
C302	GRADING PLAN	1/22/2025	ASI 09 - Civil TAC Updates
C303	GRADING PLAN	1/22/2025	ASI 09 - Civil TAC Updates
C304	GRADING PLAN	1/22/2025	ASI 09 - Civil TAC Updates
C305	GRADING PLAN	1/22/2025	ASI 09 - Civil TAC Updates
C306	GRADING PLAN	1/22/2025	ASI 09 - Civil TAC Updates
C307	GRADING PLAN	1/22/2025	ASI 09 - Civil TAC Updates
C401	SWPPP PLAN (INITIAL)	6/17/2024	BP 03
C402	SWPPP PLAN (INITIAL)	6/17/2024	BP 03
C403	SWPPP PLAN (CONST.)	1/22/2025	ASI 09 - Civil TAC Updates
C404	SWPPP PLAN (CONST.)	1/22/2025	ASI 09 - Civil TAC Updates
C405	SWPPP PLAN (FINAL)	1/22/2025	ASI 09 - Civil TAC Updates
C406	SWPPP PLAN (FINAL)	1/22/2025	ASI 09 - Civil TAC Updates
C407	SWPPP PLAN (DETAILS)	6/17/2024	BP 03
C408	SWPPP PLAN (DETAILS)	6/17/2024	BP 03
C409	SWPPP PLAN (INFORMATION)	6/21/2024	BP 03
C410	SWPPP PLAN (INFORMATION)	1/22/2025	ASI 09 - Civil TAC Updates
C500	STRUCTURE DATA TABLE	1/22/2025	ASI 09 - Civil TAC Updates
C500A	PIPE DATA TABLE	1/22/2025	ASI 09 - Civil TAC Updates

WWS NEW MIDDLE SCHOOL WEST
SR32 & Centennial Road Roundabout
Construction Work
LIST OF DRAWINGS

C501	UTILITY PLAN	2/28/2025	ASI 13 - Site Utility Modifications
C502	UTILITY PLAN	2/28/2025	ASI 13 - Site Utility Modifications
C503	UTILITY PLAN	2/28/2025	ASI 13 - Site Utility Modifications
C504	UTILITY PLAN	2/28/2025	ASI 13 - Site Utility Modifications
C505	UTILITY PLAN	1/22/2025	ASI 09 - Civil TAC Updates
C506	UTILITY PLAN	8/20/2025	ASI 26 - Trans Pipe Outlet
C601	SANITARY PLAN & PROFILE	2/28/2025	ASI 13 - Site Utility Modifications
C700	OVERALL UTILITY PLAN	1/22/2025	ASI 09 - Civil TAC Updates
C701	STORM PLAN & PROFILE	1/22/2025	ASI 09 - Civil TAC Updates
C702	STORM PLAN & PROFILE	1/22/2025	ASI 09 - Civil TAC Updates
C703	STORM PLAN & PROFILE	1/22/2025	ASI 09 - Civil TAC Updates
C704	STORM PLAN & PROFILE	2/28/2025	ASI 13 - Site Utility Modifications
C705	STORM PLAN & PROFILE	1/22/2025	ASI 09 - Civil TAC Updates
C706	STORM PLAN & PROFILE	1/22/2025	ASI 09 - Civil TAC Updates
C707	STORM PLAN & PROFILE	1/22/2025	ASI 09 - Civil TAC Updates
C708	STORM PLAN & PROFILE	1/22/2025	ASI 09 - Civil TAC Updates
C709	STORM PLAN & PROFILE	1/22/2025	ASI 09 - Civil TAC Updates
C710	STORM PLAN & PROFILE	1/22/2025	ASI 09 - Civil TAC Updates
C711	STORM PLAN & PROFILE	1/22/2025	ASI 09 - Civil TAC Updates
C712	STORM PLAN & PROFILE	1/22/2025	ASI 09 - Civil TAC Updates
C713	STORM PLAN & PROFILE	1/22/2025	ASI 09 - Civil TAC Updates
C901	SITE DETAILS	1/22/2025	ASI 09 - Civil TAC Updates

WWS NEW MIDDLE SCHOOL WEST
SR32 & Centennial Road Roundabout
Construction Work
LIST OF DRAWINGS

C902	SITE DETAILS	6/17/2024	BP 03
C903	SITE DETAILS	6/21/2024	BP 03
C904	SITE DETAILS	1/22/2025	ASI 09 - Civil TAC Updates
C905	SITE DETAILS	1/22/2025	ASI 09 - Civil TAC Updates
C906	SITE DETAILS	9/26/2024	ASI 02 - Civil Updates
C907	SITE DETAILS	2/28/2025	ASI 13 - Site Utility Modifications
L010	TREE PRESERVATION PLAN	12/6/2024	Conformed Set (12/06/2024)
L100	REFERENCE PLAN	12/6/2024	Conformed Set (12/06/2024)
L101	MATERIALS & NOTES	12/6/2024	Conformed Set (12/06/2024)
L102	MATERIALS & NOTES	12/6/2024	Conformed Set (12/06/2024)
L103	MATERIALS & NOTES	12/6/2024	Conformed Set (12/06/2024)
L104	MATERIALS & NOTES	12/6/2024	Conformed Set (12/06/2024)
L105	MATERIALS & NOTES	12/6/2024	Conformed Set (12/06/2024)
L106	MATERIALS & NOTES	12/6/2024	Conformed Set (12/06/2024)
L107	MATERIALS & NOTES	12/6/2024	Conformed Set (12/06/2024)
L108	MATERIALS & NOTES	12/6/2024	Conformed Set (12/06/2024)
L201	LAYOUT PLAN	12/6/2024	Conformed Set (12/06/2024)
L202	LAYOUT PLAN	12/6/2024	Conformed Set (12/06/2024)
L203	LAYOUT PLAN	12/6/2024	Conformed Set (12/06/2024)
L204	LAYOUT PLAN	12/6/2024	Conformed Set (12/06/2024)
L205	LAYOUT PLAN	12/6/2024	Conformed Set (12/06/2024)
L206	LAYOUT PLAN	12/6/2024	Conformed Set (12/06/2024)
L207	LAYOUT PLAN	12/6/2024	Conformed Set (12/06/2024)
L208	LAYOUT PLAN	12/6/2024	Conformed Set (12/06/2024)

WWS NEW MIDDLE SCHOOL WEST
SR32 & Centennial Road Roundabout
Construction Work
LIST OF DRAWINGS

L301	ENLARGED ATHLETIC PLANS	12/6/2024	Conformed Set (12/06/2024)
L302	ENLARGED ATHLETIC PLANS	12/6/2024	Conformed Set (12/06/2024)
L303	ENLARGED ATHLETIC PLANS	11/22/2024	ASI 04 - Irrigation Room Dugout
L304	ENLARGED ATHLETIC PLANS	12/6/2024	Conformed Set (12/06/2024)
L305	ENLARGED ATHLETIC PLANS	12/6/2024	Conformed Set (12/06/2024)
L306	ENLARGED ATHLETIC PLANS	12/6/2024	Conformed Set (12/06/2024)
L307	ENLARGED ATHLETIC PLANS	12/6/2024	Conformed Set (12/06/2024)
L308	BLEACHER AND PRESS BOX PLANS & DETAILS	12/6/2024	Conformed Set (12/06/2024)
L309	BLEACHER AND PRESS BOX PLANS & DETAILS	12/6/2024	Conformed Set (12/06/2024)
L310	BLEACHER AND PRESS BOX PLANS & DETAILS	12/6/2024	Conformed Set (12/06/2024)
L311	BLEACHER AND PRESS BOX PLANS & DETAILS	12/6/2024	Conformed Set (12/06/2024)
L312	BLEACHER AND PRESS BOX PLANS & DETAILS	12/6/2024	Conformed Set (12/06/2024)
L313	BLEACHER AND PRESS BOX PLANS & DETAILS	12/6/2024	Conformed Set (12/06/2024)
L314	BLEACHER AND PRESS BOX PLANS & DETAILS	12/6/2024	Conformed Set (12/06/2024)
L315	BLEACHER AND PRESS BOX PLANS & DETAILS	12/6/2024	Conformed Set (12/06/2024)
L316	BLEACHER AND PRESS BOX PLANS & DETAILS	12/6/2024	Conformed Set (12/06/2024)
L317	BLEACHER AND PRESS BOX PLANS & DETAILS	12/6/2024	Conformed Set (12/06/2024)
L318	BLEACHER AND PRESS BOX PLANS & DETAILS	12/6/2024	Conformed Set (12/06/2024)
L401	PLANTING PLAN	12/6/2024	Conformed Set (12/06/2024)
L402	PLANTING PLAN	12/6/2024	Conformed Set (12/06/2024)
L403	PLANTING PLAN	12/6/2024	Conformed Set (12/06/2024)
L404	PLANTING PLAN	7/26/2024	Conformed Set (12/06/2024)
L405	PLANTING PLAN	7/26/2024	Conformed Set (12/06/2024)
L406	PLANTING PLAN	7/26/2024	Conformed Set (12/06/2024)

**WWS NEW MIDDLE SCHOOL WEST
SR32 & Centennial Road Roundabout
Construction Work
LIST OF DRAWINGS**

L407	PLANTING PLAN	7/26/2024	Conformed Set (12/06/2024)
L408	PLANTING PLAN	7/26/2024	Conformed Set (12/06/2024)
L500	SITE DETAILS	12/6/2024	Conformed Set (12/06/2024)
L501	SITE DETAILS	12/6/2024	Conformed Set (12/06/2024)
L502	SITE DETAILS	12/6/2024	Conformed Set (12/06/2024)
L510	ATHLETIC DETAILS	12/6/2024	Conformed Set (12/06/2024)
L511	ATHLETIC DETAILS	12/6/2024	Conformed Set (12/06/2024)
L512	ATHLETIC DETAILS	12/6/2024	Conformed Set (12/06/2024)

END OF SECTION